

**Baseline Monitoring Document
and
As built Report
Draft**

**UT to Lilliput Creek (Hog Branch Ponds) Stream and Wetland
Restoration Project**

SCO No. 04-06351-01A

DENR Contract No. D05053S-1

EEP Project No. 290

Brunswick County

North Carolina

Data Collection: March 1st through December 6th 2010

Submission Date: September 16, 2011



Prepared for:



North Carolina Department of Environment and Natural Resources
Ecosystem Enhancement Program
2728 Capital Boulevard, Suite 1H-103
Raleigh, NC 27606

**Baseline Monitoring Document
and
As built Report
Draft**

**UT to Lilliput Creek (Hog Branch Ponds) Stream and Wetland
Restoration Project**

SCO No. 04-06351-01A

DENR Contract No. D05053S-1

EEP Project No. 290

Brunswick County

North Carolina

Data Collection: March 1st through December 6th 2010

Submission Date: September 16, 2011

Prepared by:



Rummel, Klepper & Kahl, LLP
900 Ridgefield Drive
Suite 350
Raleigh, NC 27609

2.0 Table of Contents

1.0 Title Page.....	i
2.0 Table of Contents.....	ii
3.0 Executive Summary/Project Abstract.....	1
4.0 Project Goals, Background and Attributes.....	2
5.0 Success Criteria.....	4
6.0 Monitoring Plan Guidelines.....	5
7.0 Maintenance and Contingency Plans.....	6
8.0 As-Built Conditions (Baseline).....	6
9.0 References.....	6

Appendix A. General Tables and Figures

Appendix B. Morphological Summary Data and Plots

Appendix C. Vegetation Data

Appendix D. As-Built Plan Sheets

3.0 Executive Summary/Project Abstract

The UT to Lilliput Creek (Hog Branch Ponds) Stream and Wetland Restoration Site is located in Boiling Spring Lakes, Brunswick County. The restoration project is located on a 516.73 acre tract purchased (fee simple) by the State of North Carolina (Ecosystem Enhancement Program) in December 2004. The UT Lilliput Stream and Wetland Restoration Site was previously owned by International Paper and used in rotation as a pine plantation. Pine plantations in southeastern North Carolina are typically characterized by major site alterations constructed to provide sufficient surface and groundwater drainage in wet conditions which allows planted pine trees to grow and cultivate. Site alterations also destroy ecological function, decrease water quality and disrupts habitat for wildlife, including federally threatened and endangered species.

The goal for the UT to Lilliput Creek (Hog Branch Ponds) Stream and Wetland Restoration Site is to restore ecological function, improve overall water quality, and enhance native wildlife habitat. This goal will be accomplished by two main objectives. The first objective is restoration of channelized tributaries to the headwater outer coastal plain stream type, as described in the “Information Regarding Stream Restoration in the Outer Coastal Plain of North Carolina” guidance document (COE 2005). The stream restoration will re-establish the riparian vegetation zone, re-connect flood plain areas, and enhance wildlife habitat. These ecological functions have been non-existent for decades due to the previous ditch and drainage regime. The second objective is to restore and enhance the altered wetlands. The restoration and enhancement of wetlands onsite will generate longer soil saturation periods and the result is improved water quality. Restoring the native hydrologic characteristics will also restore the conditions that are beneficial for the longleaf pine community type that previously dominated the site before human intervention. The longleaf pine forest will also restore native habitat for the red-cockaded woodpecker.

The UT to Lilliput Creek (Hog Branch Ponds) Stream and Wetland Restoration Site was previously a pine plantation. Pine plantations in southeastern North Carolina are typically characterized by major site alterations that were made to eliminate much of the wet conditions. When modified, these sites provide sufficient surface and groundwater drainage that allow planted loblolly pine (*Pinus taeda*) and longleaf pine (*Pinus palustris*) trees to grow be cultivated. Foresters typically perform two major site alterations in preparation for a pine plantation: channelization of natural stream channels and bedding. These site alterations were utilized extensively throughout the project site. Restoring these alterations back to natural condition were key in both project design and implementation.

Stream Restoration and Stream Preservation are both components of this project (Table 1). Stream restoration for UT Lilliput is divided into two tributaries. The North Tributary (**1,535 linear feet**) and South Tributary (**1,703 linear feet**) were constructed utilizing the guidance entitled “Information Regarding Stream Restoration in the Outer Coastal Plain of North Carolina” (COE 2005). A total of **3,238 linear feet** of stream restoration will be provided in accordance with the enclosed plans. Stream Preservation areas will consist of **5,332 linear feet**. (See Table 1 for Project Components and Figure 2 for Component Location)

The wetland component of the UT to Lilliput Creek (Hog Branch Ponds) Stream and Wetland Restoration Site consists of non-riparian wetland preservation, restoration, enhancement, and riparian preservation. The non-riparian wetland preservation areas total **87.74 acres** and riparian wetland

preservation areas total **20.45 acres**. Non-riparian wetland enhancement totals **96.46 acres** and Non-riparian wetland restoration totals **7.83 acres** (See Table 1 for Project Components and Figure 2 for Component Location). Non-riparian wetland restoration was accomplished by removing spoil materials, re-grading to natural elevations, and replanting with native species. Wetland enhancement was accomplished on the eastern side of Boiling Springs Lake Road through the stream restoration process and planting. The stream restoration will enhance hydrology throughout the site and restore conditions that will enable the native plantings to flourish. Wetland enhancement on the west side of Boiling Springs Lake Road was accomplished by removing spoil material and re-grading to natural elevations to enhance hydrology to pre-altered conditions.

As-built conditions are congruent with design specifications and no major deviations have occurred. The stream restoration longitudinal profile and cross sections can be viewed in Appendix B. Baseline vegetation sampling yielded a site density of 709 stems per acre and species distribution was consistent with the planting plan specifications (Appendix C).

Monitoring for the UT to Lilliput Creek (Hog Branch Ponds) Stream and Wetland Restoration Site will be conducted annually for a five (5) year period. Headwater stream monitoring will be comprised of an annual channel centerline profile survey and eight (8) cross sections will be surveyed each year utilizing total station survey technology. Vegetation data will be compiled annually utilizing EEP-CVS Protocol Level 1 methods consisting of fifteen (15) vegetation monitoring plots and one (1) total stem count. The site will also be inspected visually and documented with photography. Hydrology will be monitored through a series of thirty-eight (38) total monitoring gauges. Of these, Twenty-eight (28) gauges are installed to monitor groundwater, eight (8) gauges will monitor surface water in the restored headwater stream channels and one (1) surface and four (4) groundwater monitoring gauges will be utilized for the reference areas.

UT to Lilliput Creek (Hog Branch Ponds) Stream and Wetland Restoration Site by design is a restoration of the Longleaf pine (*Pinus palustris*) community type. This design includes maintenance strategies that utilize controlled burning. EEP is currently working with The Nature Conservancy and the North Carolina Department of Agriculture and Consumer Sciences Plant Conservation Program to determine a maintenance schedule for controlled burning. It is recommended that controlled burns occur every three (3) to five (5) years or as needed. With regards to current site conditions, it is recommended that the initial controlled burn occur during 2011 to optimize longleaf pine mortality rates.

4.0 Project Goals, Background, and Attributes

The UT UT to Lilliput Creek (Hog Branch Ponds) Stream and Wetland Restoration Site is located in Boiling Spring Lakes, Brunswick County in the lower Coastal Plain of North Carolina (Figure 1). The Soil Survey for Brunswick County (USDA 1982) reveals elevations generally vary from 75 feet to sea level. Total annual precipitation ranges from 50 to 60 inches per year in the eight-digit hydrologic unit 03030005 and fourteen-digit hydrologic unit 03030005070010 of the Cape Fear River Basin. Adjacent landuse consists of mostly forested sandhill vegetation with roughly 10% of the area in residential development.

The goal for the UT to Lilliput Creek (Hog Branch Ponds) Stream and Wetland Restoration Site is to restore ecological function, improve overall water quality, and enhance native wildlife habitat. This goal will be accomplished by these main objectives.

- Restore lost ecological function
- Improve overall water quality
- Enhance and Improve native wildlife habitat and diversity
- Reduce erosion and sedimentation
- Restore the native longleaf pine community
- Restore headwater wetlands

The first objective is restoration of channelized tributaries to the headwater outer coastal plain stream type, as described in the “Information Regarding Stream Restoration in the Outer Coastal Plain of North Carolina” guidance document (COE 2005). The stream restoration will re-establish the riparian vegetation zone, re-connect flood plain areas, and enhance wildlife habitat. With proper stream restoration design, the project will also reduce erosion and sedimentation. These ecological functions have been non-existent for decades due to the previous ditch and drainage regime. The restoration and enhancement of wetlands onsite will generate longer soil saturation periods and the result is improved water quality. Restoring the native hydrologic characteristics will also restore the conditions that are beneficial for the longleaf pine community type that previously dominated the site before human intervention. The longleaf pine forest will also restore native habitat for the red-cockaded woodpecker.

The first component of the UT to Lilliput Creek (Hog Branch Ponds) Stream and Wetland Restoration Site is restoration of the headwater streams, as described in the “Information Regarding Stream Restoration in the Outer Coastal Plain of North Carolina” guidance by the USACE and DWQ (COE 2005). The second component is wetland restoration and enhancement. By accomplishing these two objectives, the site hydrology is restored to pre-altered conditions thereby improving water quality by increasing saturation periods, enhancing native wildlife habitat, and reestablishing lost ecological function.

Stream Restoration: The North Tributary (**1,535 linear feet**) and South Tributary (**1,703 linear feet**) were constructed utilizing the December 2005 USACE guidance “Information Regarding Stream Restoration in the Outer Coastal Plain of North Carolina”. The referenced document states that restoration of dimension, pattern and profile in accordance with the typical natural channel design is often not appropriate in environments similar to the project site. For headwater stream restoration, a width of 100 feet centered along the resulting valley will determine the area that can be considered for stream restoration (COE 2005). The resulting longitudinal profile and cross slopes of the stream valley will be largely dependent on the topography along each restoration reach. A total of **3,238 linear feet** of stream restoration has been accomplished.

Non-riparian wetland restoration (7.83 acres): The previous logging activities created large logging decks (discarded materials from the logging operation) which are areas that the harvested loblolly pine logs were de-limbed, cut, sorted, and loaded on trucks. The discarded material accumulated at three different areas across the site with depths reaching up to approximately eight feet in thickness. Non-riparian wetland restoration was accomplished by removing these logging decks, grading to pre-existing

elevation, and planting native species (Site 1, Site 2, and Site 3). Site 6 contained fill that originated from erosion created by a maintained power line right of way and an adjacent access road. This fill material was removed and replanted with native species (Figure 2). The south headwater and north headwater wetland restoration areas (Figure 2) were accomplished by filling the existing drainage ditched and re-grading to pre-existing elevations and planted with native species.

Non-riparian wetland enhancement (96.46 acres): Vegetative enhancement was provided by planting with native species and the hydrology was enhanced through the stream restoration process in the wetland enhancement areas west of SR 1539 (Figure 2). The restored stream raised the existing water table and generated longer saturation periods. Non-riparian enhancement areas Site 4, Site 5, and Site 7 are wetlands that have been ditched and drained. Enhancement on these areas was a result of plugging the existing ditches and enhancing hydrology (Figure 2).

In addition to the restored and enhanced areas described above, UT Lilliput Stream and Wetland Restoration Site also provided **5,332 linear feet** of stream preservation and **20.45 acres** of riparian wetland preservation (Figure 2). Guidance from the North Carolina Department of Water Quality (DWQ) was used for stream delineations and guidance from the US Army Corps of Engineers (COE) 1987 Manual was used in delineating wetlands. These jurisdictional features were GPS located with sub-meter GPS technology and cataloged for preservation credit. All jurisdictional features were reviewed and approved by agency representatives after field review.

5.0 Success Criteria

Stream Restoration for UT Lilliput utilized “Information Regarding Stream Restoration in the Outer Coastal Plain of North Carolina” guidance document (COE 2005), for both design and design implementation. Therefore, traditional stream success criteria accepted for natural channel design cannot be used for this project. Headwater stream restoration will employ a monitoring plan that is more consistent with that of a wetland monitoring strategy since there will not be a constructed channel with pattern, dimension, and profile. The constructed headwater stream areas will be monitored with annual surveys, photos, vegetation monitoring, and groundwater/surface water monitoring gauges.

To monitor the restored groundwater, Remote Data Systems (RDS) WM20 and WM40 groundwater monitoring gauges will be paired with a surface water monitoring gauge (RDS WM40), and placed every 500 feet in restored valley length. Likewise, one pair of gauges will be placed on every restored reach that does not measure a total of 500 feet in length. The data from these gauges will be compared to the reference site gauges.

Cross-section surveys will also occur. Although typical stream monitoring techniques will not be applied, these surveys will be used as a year-to-year comparison to as-built conditions. Migration of flow paths across cross section plots are expected from year to year. To be considered successful the overall cross section geometry should remain consistent without significant sediment aggradation or degradation.

Photographic documentation and visual monitoring will also be utilized to note success or problem areas throughout the monitoring period. Visual inspections along each of the stream valleys is intended to confirm the presence of a braided, diffuse flow pattern, plant success, and performance of the

woody structures. Problem areas will be documented in the annual monitoring reports and consultation with EEP will be carried out to reach a resolution.

Success criteria are based on overall performance of the designed headwater stream restoration so that no substantial aggradation, degradation, down-cutting, or erosion occurs in longitudinal profiles and cross sections. The hydrologic regime should demonstrate jurisdictional wetland hydrology for groundwater monitoring gauges within the constructed channel as recommended in the “Information Regarding Stream Restoration in the Outer Coastal Plain of North Carolina” guidance document (COE 2005). Surface gauges should demonstrate periods of intermittent surface flow and relevance to the reference conditions to be deemed successful.

Wetland monitoring gauges (RDS WM20 or WM40) will be used to monitor the groundwater levels in wetland restoration and enhancement areas. On-site reference gauge data can be used as a basis of comparison. Post construction monitoring gauge locations are shown in Figure 2.

Hydrologic success criteria for restored wetlands are based on specific site conditions to determine wetland hydroperiods. To meet the success criteria for hydrology, the area must be inundated or saturated (within 12 inches of the surface) by surface or groundwater for at least a consecutive 12% of the growing season. Areas inundated or saturated less than 12% can be classified as wetlands depending upon factors such as the presence of hydrophytic vegetation and hydric soils. The growing season start and end dates are based on the U.S. Army Corps of Engineers 1987 Wetland Delineation Manual criterion of five (5) years in ten (10) frequency having a twenty-eight (28) degrees Fahrenheit or lower temperature threshold. Therefore, UT Lilliput Stream and Wetland Restoration Site growing season will be defined as March 7th through November 28th. Hydroperiods should also demonstrate similar conditions to the reference monitoring gauges. Additional reference groundwater monitoring gauges were installed in July 2011 in both Murville and Leon soil types. The restored and enhanced non-riparian wetlands onsite are located on these soil types and additional reference data from these soils will aid in determining wetland restoration and enhancement success.

Wetland enhancement areas are monitored for hydrology as well. Although there is no standard protocol for success criteria in hydrologic wetland enhancement, the monitoring effort will demonstrate an improvement in hydroperiods over time and this improvement should be documented as it occurs. Improvements in hydroperiod can be determined by referencing current gauge location and data with pre-construction gauge location and data. The pre-construction gauge locations were determined to ascertain the effect of the ditching on the groundwater levels and effect on the surrounding wetland communities. In some areas, the post-construction gauges were installed on or near pre-construction locations. Groundwater monitoring gauge transects were also installed (December 2010 after MY1) perpendicular to the headwater stream channel to document improved groundwater hydroperiods.

Based upon CVS-EEP protocol for establishing vegetation monitoring plots, the UT to Lilliput Creek (Hog Branch Ponds) Stream and Wetland Restoration Site utilizes 15 vegetation monitoring plots throughout all zones. Because of its small size (0.043 acre) Site 6 will have a total stem count. CVS-EEP Level 1 monitoring protocol and Level 2 for MY2 through MY5. The vegetative restoration occurs in four (4) planting zones: Zone I - Coastal Plain Small Stream Swamp, Zone II – Wet Pine Flatwoods, Zone III – Pine Savanna, and Zone IV – Cypress Gum Swamp. See appendix D for planting plan.

Success Criteria state that there must be a minimum of 320 trees per acre surviving for three consecutive years. The required survival criterion will decrease by 10% per year after the third year of vegetation monitoring (i.e. 288 trees/acre for year 4, and 260 trees/acre for year 5). To meet success there should be at least 260 5 year-old trees per acre after year 5.

6.0 Monitoring Plan Guidelines

Hydrology – Hydrologic monitoring will be accomplished through a series of forty (40) monitoring gauges. Twenty-eight (28) monitoring gauges are installed to monitor groundwater, and eight (8) gauges will monitor surface water in the restored headwater stream channels. The reference site utilizes one (1) surface water monitoring gauge and three (3) groundwater monitoring gauges. Data will be collected monthly through the growing season March through November (Figure 2).

Dimension – Channel dimension will be surveyed once each year at 8 permanently established cross-sections; four (4) along the Northern Tributary and four (4) along the Southern tributary. Cross sections will be surveyed using total station methodology and the data will be analyzed and plotted using CADD and Microsoft Excel software packages (Figure 2).

Profile – Channel profile will be surveyed once each year using total station methodology to survey centerline and water surface elevations for both the Northern and Southern tributaries (thalweg survey is not applicable due to the braided nature of headwater stream type). Each profile survey must be taken down the centerline of each channel with start and stop points the same. All data will be analyzed and plotted using CADD and Microsoft Excel software packages (Figure 2).

Pattern - Channel pattern data will be collected as part of the channel profile survey.

Sediment Transport – Visual inspection and survey data will be used to confirm no significant aggradation or degradation of the constructed channels.

Visual Assessment – Visual assessment of the stream features will occur during the stream profile survey. Visual assessment will photographically document any feature that needs immediate attention by EEP (Figure 2).

Bank Stability Assessments – Headwater stream restoration does not incorporate typical channel and bank features normally associated with natural channel design. Therefore, BEHI and NBS are not applicable to this project.

Vegetation – Vegetation sampling will follow the 2008 CVS-EEP Protocol for Level 1 (Version 4.2). Fifteen (15) 100m² plots have been established and will be sampled every year to determine if vegetation survival is above or below the criteria that the U.S. Army Corps of Engineers require for a successful project. CVS-EEP Microsoft Access software package will be used for vegetation data analysis and reporting to EEP and CVS. Site 6 will require a total stem count (Figure 2).

Digital Photos – Digital photo documentation of each permanent cross section, each vegetation plot, each designated photo point, and representative stream photos shall occur annually. One representative photo

of each vegetation plot must be taken on the same day vegetative assessments are conducted. All photos should be taken during the same general time frame each year. Figure 2.

Other Parameters – There are currently one (1) surface water monitoring gauge and four (4) groundwater monitoring gauge located in reference areas. These gauges will require monthly data download throughout the growing season (March 7 through November 28).

7.0 Maintenance and Contingency Plans

EEP is currently working with The Nature Conservancy and the North Carolina Department of Agriculture and Consumer Sciences Plant Conservation Program to determine a maintenance schedule for controlled burning. It is recommended that controlled burns occur every three (3) to (5) years or as needed. The current site conditions will require an initial burning by the end of year 2011. If any problem should arise that will require remedial action, this problem should be immediately reported to EEP with photographic documentation and should include a brief description.

8.0 As-Built Conditions (Baseline)

A comparison of as-built site conditions and design plans reveals no significant changes have occurred. Cross section survey shows that channel dimensions are congruent with design and the longitudinal profile is holding grade. Stream dimension, pattern, and profile, plots are found in Appendix B and Appendix D. Monitoring features and location are noted in Figure 2.

EEP protocol requires baseline vegetation baseline data to be collected within twenty one (21) days of the completion of site planting. This requirement was met and an accurate baseline sample of planted stems was taken within CVS/EEP parameters. Vegetation sampling yielded a site density of 709 stems per acre and distribution was consistent with the planting plan. Vegetation data including plot photos are found in Appendix C.

9.0 References

Harrelson, C.C., C.L. Rawlins and J.P. Potyondy. 1994. Stream Channel Reference Sites: An Illustrated Guide to Field Technique. United States Department of Agriculture, Fort Collins, CO.

NCEEP. 2006. UT to Lilliput Stream and Wetland Restoration Project Restoration Plan. North Carolina Department of Environment and Natural Resources, Ecosystem Enhancement Program. Raleigh, NC. Version 3, October 16, 2006.

NCEEP. 2010. Content, Format and Data Requirements for EEP Baseline Monitoring Report. North Carolina Department of Environment and Natural Resources, Ecosystem Enhancement Program. Raleigh, NC. Version 2.0 October 14, 2010.

NCEEP. 2008. CVS-EEP Vegetation Sampling Protocol. North Carolina Department of Environment and Natural Resources, Ecosystem Enhancement Program. Raleigh, NC. Version 4.2, 2008.

Rosgen, D. 1996. Applied River Morphology. Wildland Hydrology, Pagosa Springs, CO.

U.S. Army Corps. Of Engineers. 1987. U.S. Army Corps. of Engineers. Tech Report Y-87-1, 1987 Wetland Delineation Manual, Washington, DC. AD/A176.

U.S. Army Corps. Of Engineers. 2005. U.S. Army Corps. of Engineers. Information Regarding Stream Restoration in the Outer Coastal Plain of North Carolina, Wilmington Regulatory Field Office.

APPENDIX A

General Tables and Figures

APPENDIX B

Morphological Summary Data, Plots, and Photos

APPENDIX C


Vegetation Data

APPENDIX D

As-Built Plan Sheets

APPENDIX A

General Tables and Figures

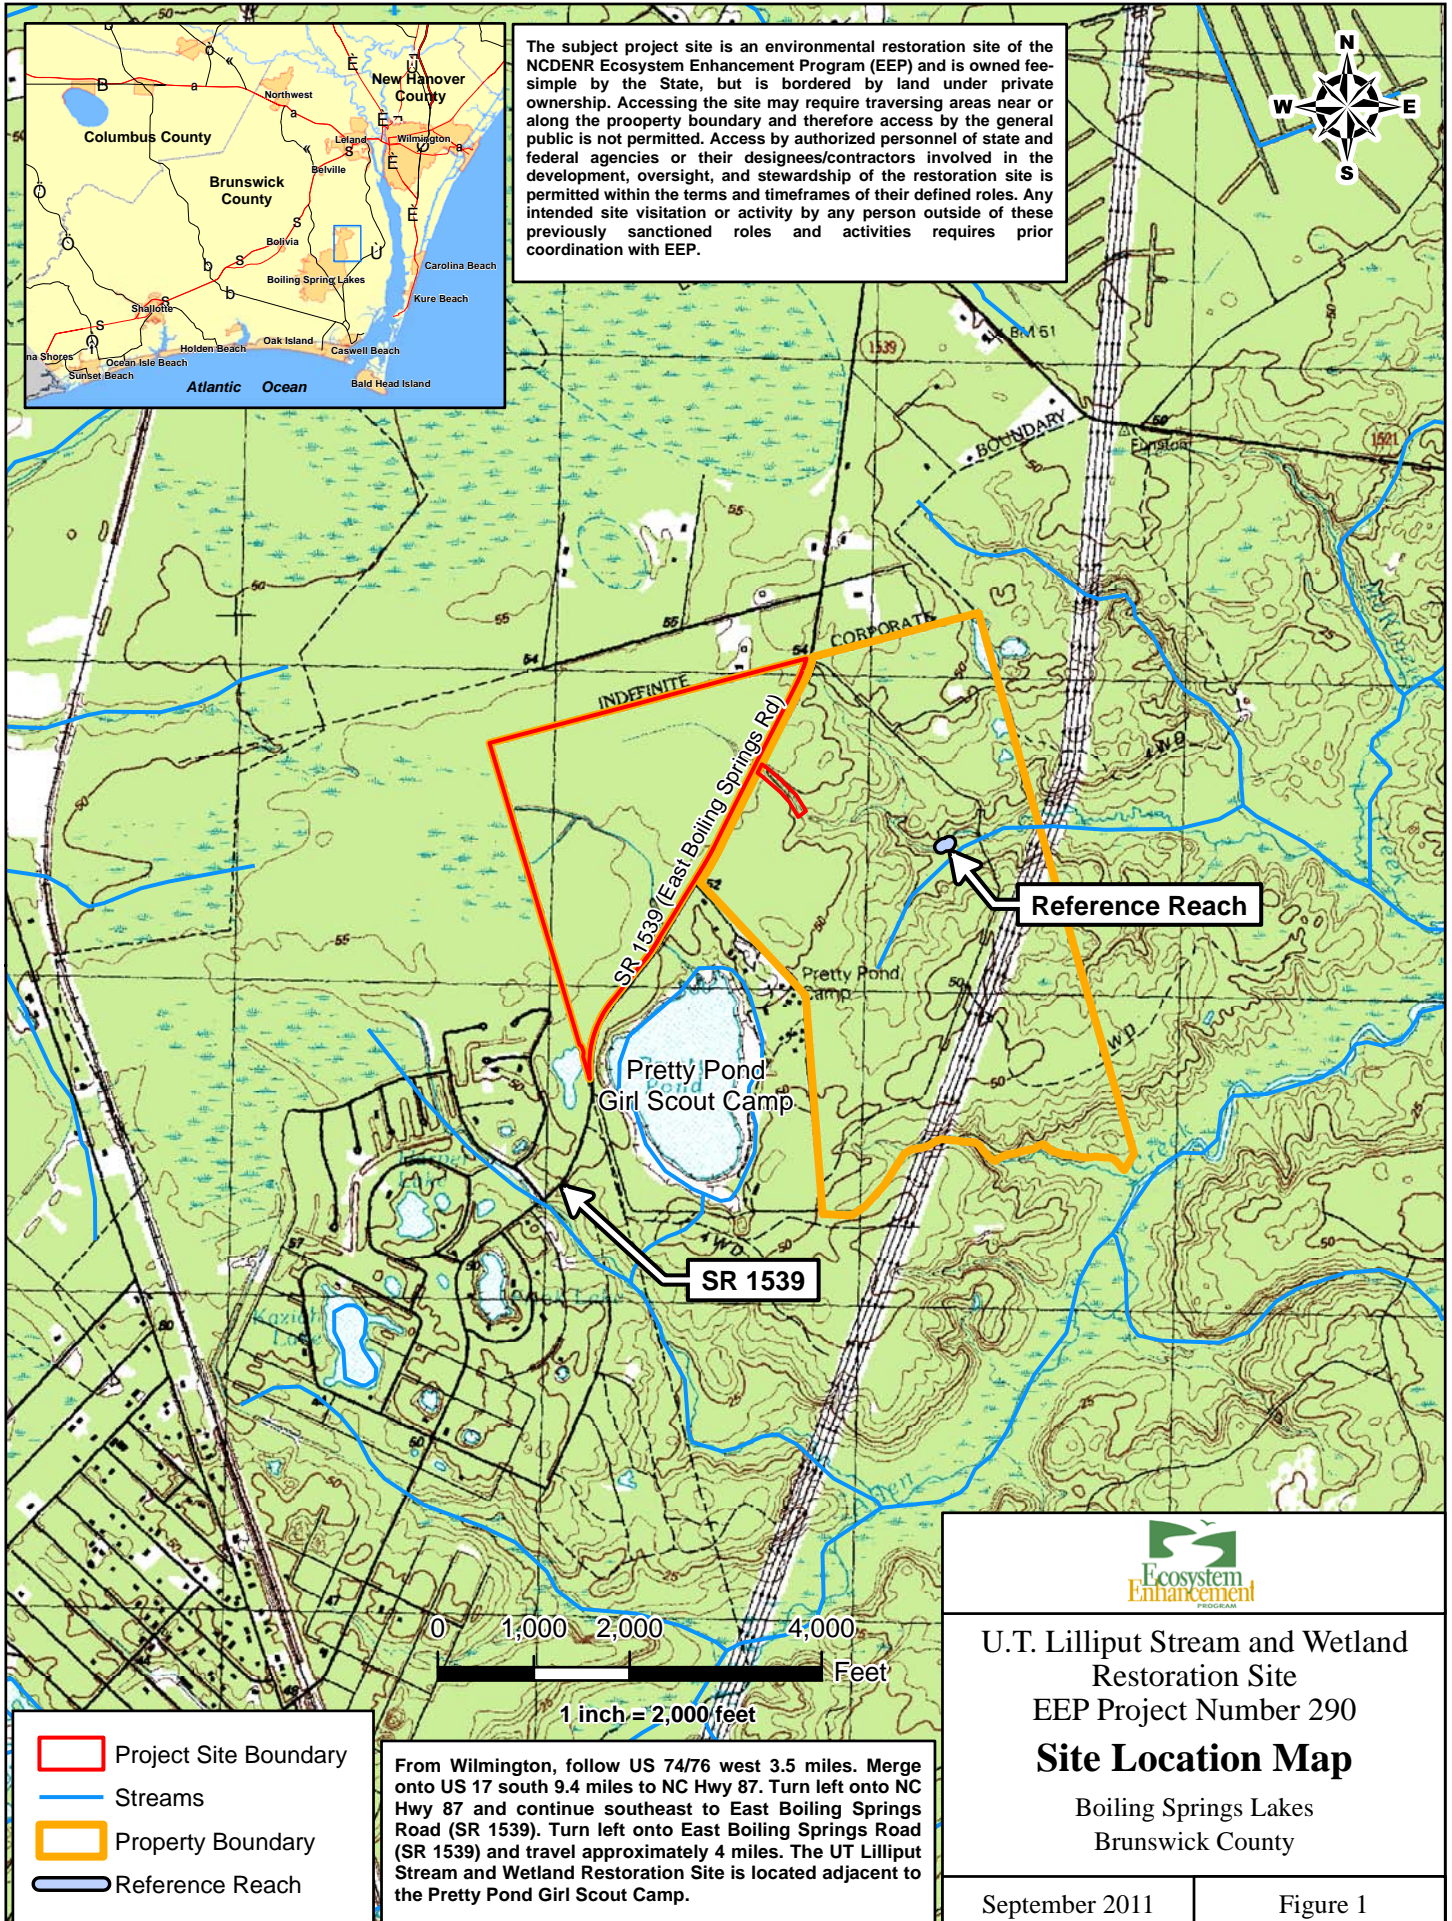

Source: USGS 7.5 Minute Quadrangle, Funston, NC

FIGURE 2




 
 



Project Components

U.T. Lilliput Stream and Wetland
Restoration Site
Project No: D05053S
EEP No. 290

Brunswick County

Legend

Restoration Plan Component

-  Property Boundary
-  Stream Restoration (7.23 Ac., 3238 LF.)
-  Non-Riparian Wetland Restoration (7.83 Ac.)
-  Non-Riparian Wetland Enhancement (96.46 Ac.)
-  Non-Riparian Wetland Preservation (87.74 Ac.)
-  Riparian Wetland Preservation (20.45 Ac.)
-  Wetland in Powerline ROW (4.54 Ac.)
-  Stream Preservation
(100' buffer, 8.67 Ac., 5332 LF)







 




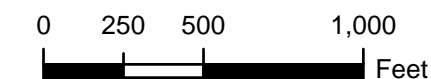

FIGURE 3




Monitoring Plan Features


U.T. Lilliput Stream and Wetland
Restoration Site
Project No: D05053S
EEP No. 290

Brunswick County

Legend

-  Vegetation Monitoring Plot
- Monitoring Gauges**
 -  Surface Gauges
 -  Groundwater Gauges
- Photo Monitoring**
 -  Photo Point and Direction
- Restoration Plan Component**
 -  Stream Restoration (7.23 Ac., 3238 LF.)
 -  Non-Riparian Wetland Restoration (7.83 Ac.)
 -  Non-Riparian Wetland Enhancement (96.46 Ac.)
 -  Property Boundary
 -  Surveyed Cross Sections
 -  Surveyed Longitudinal Profile

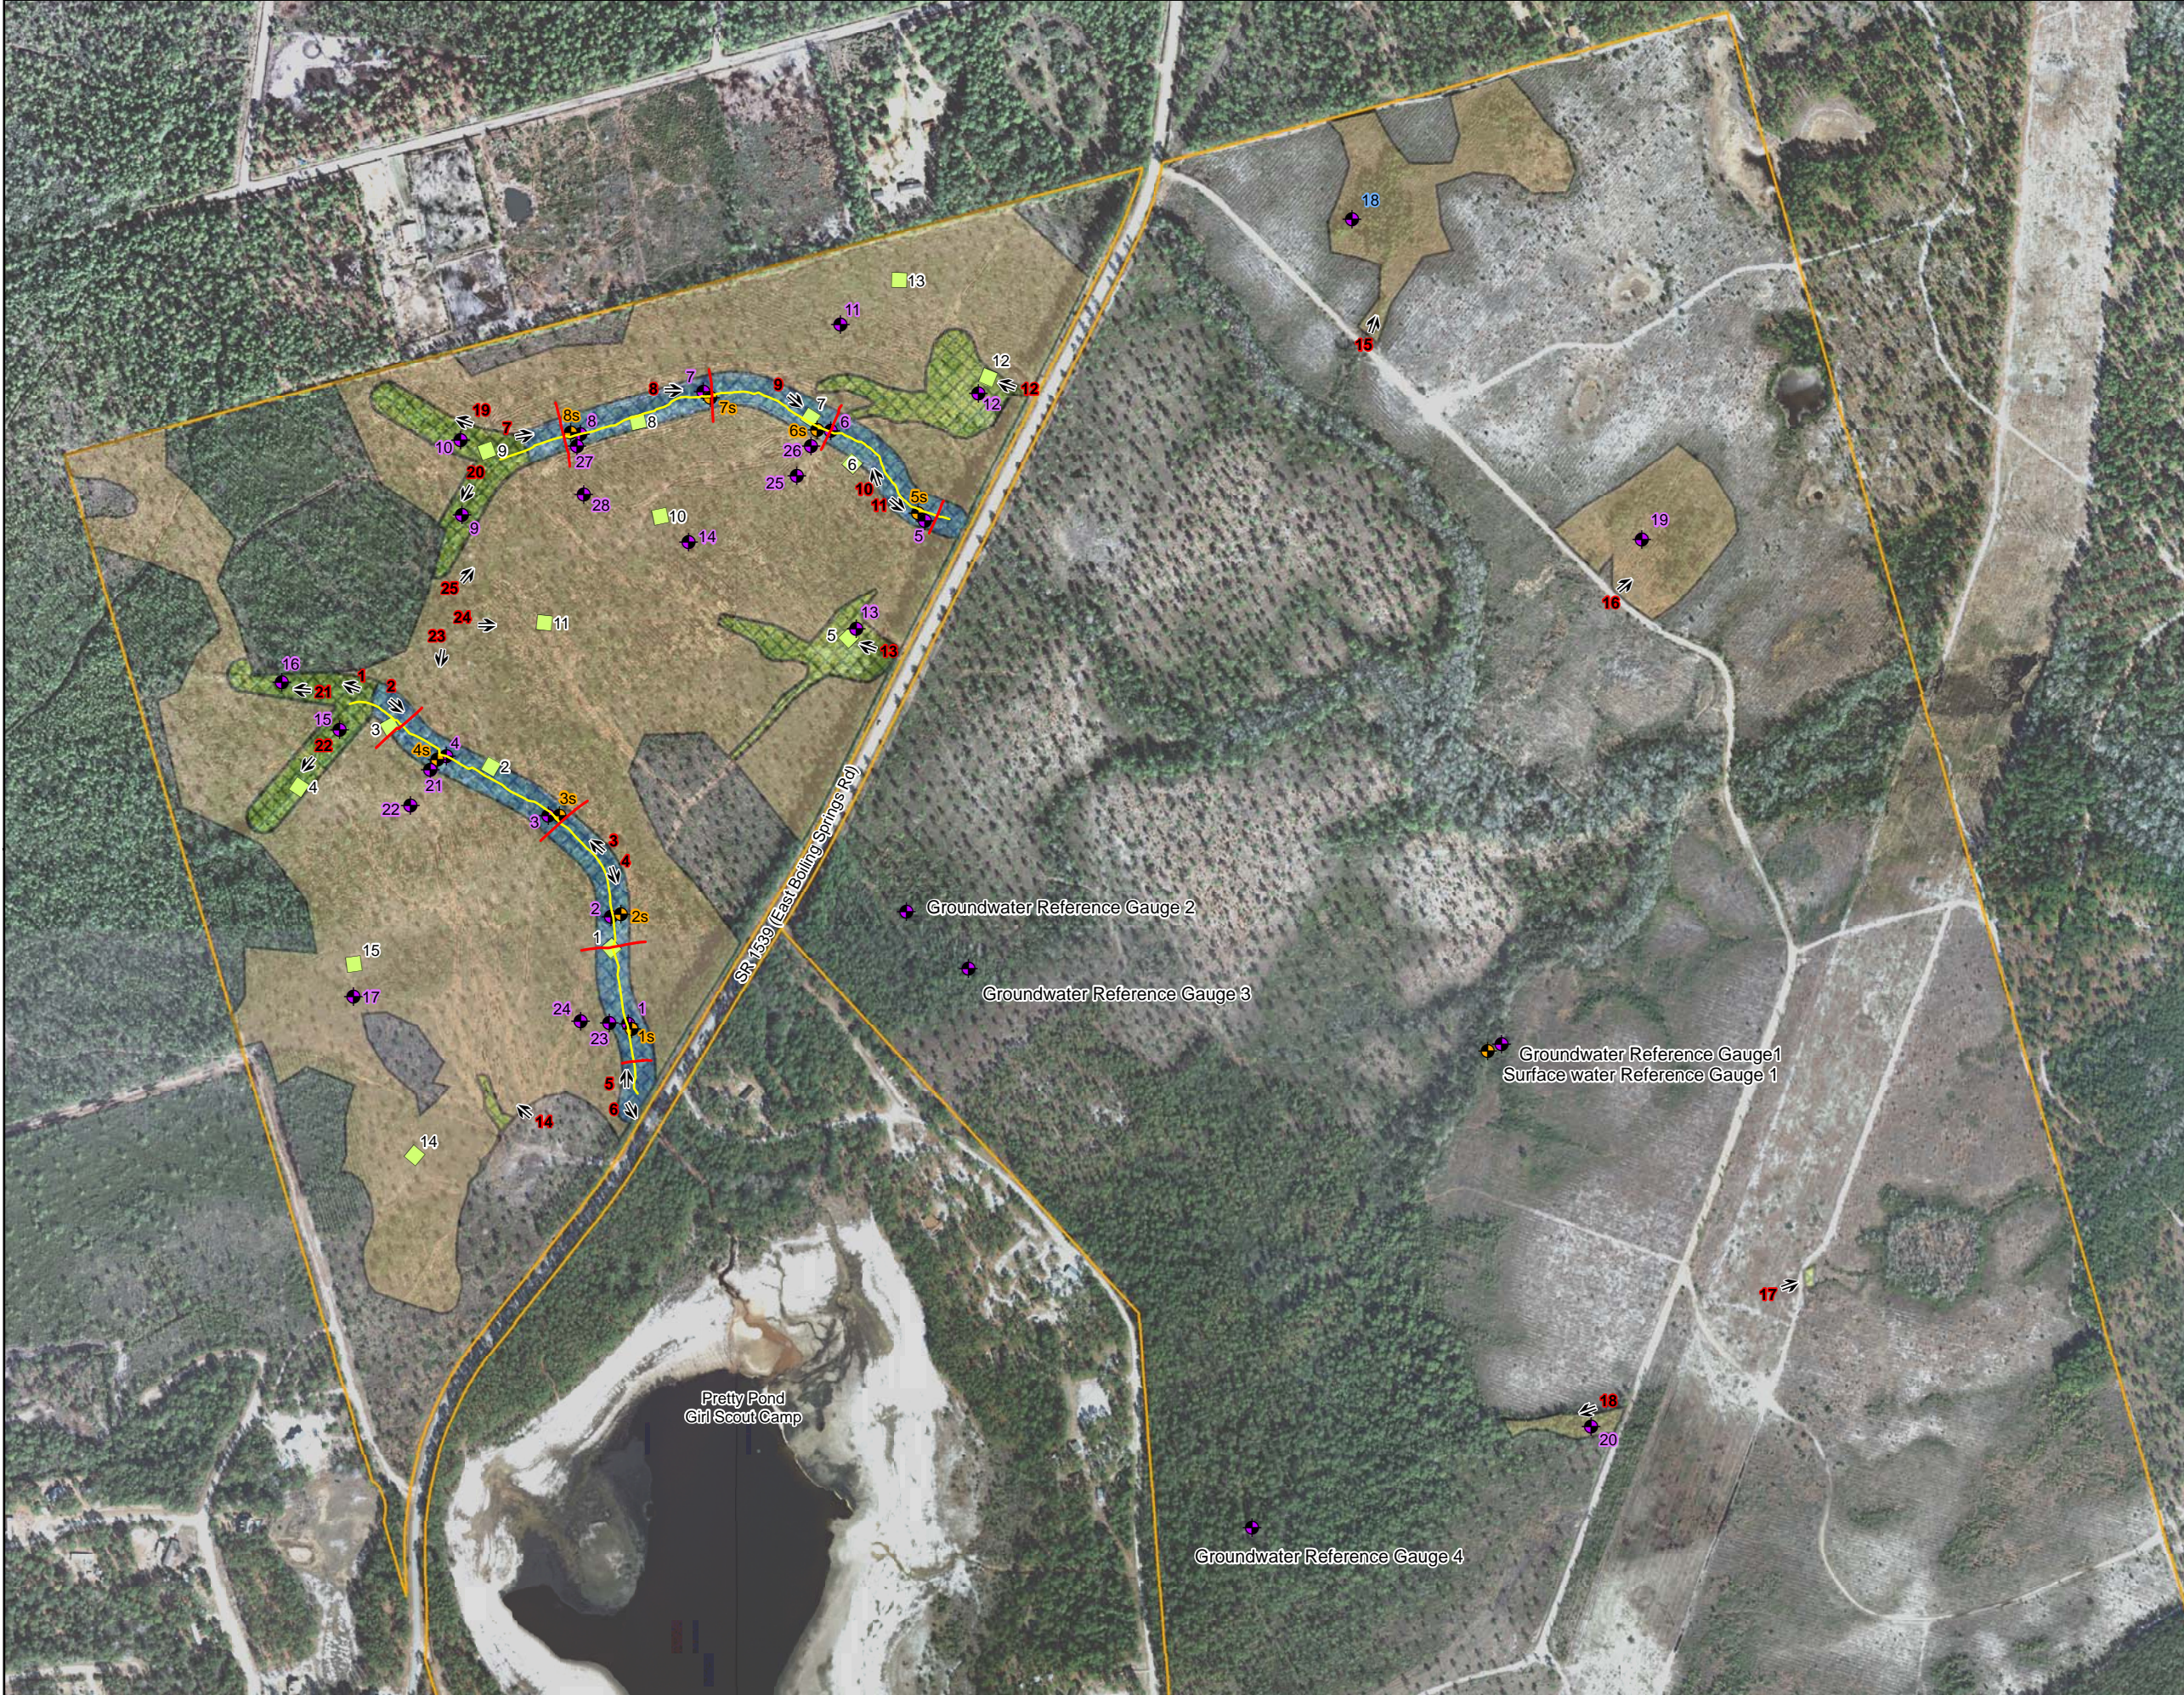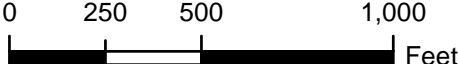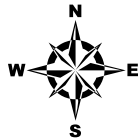

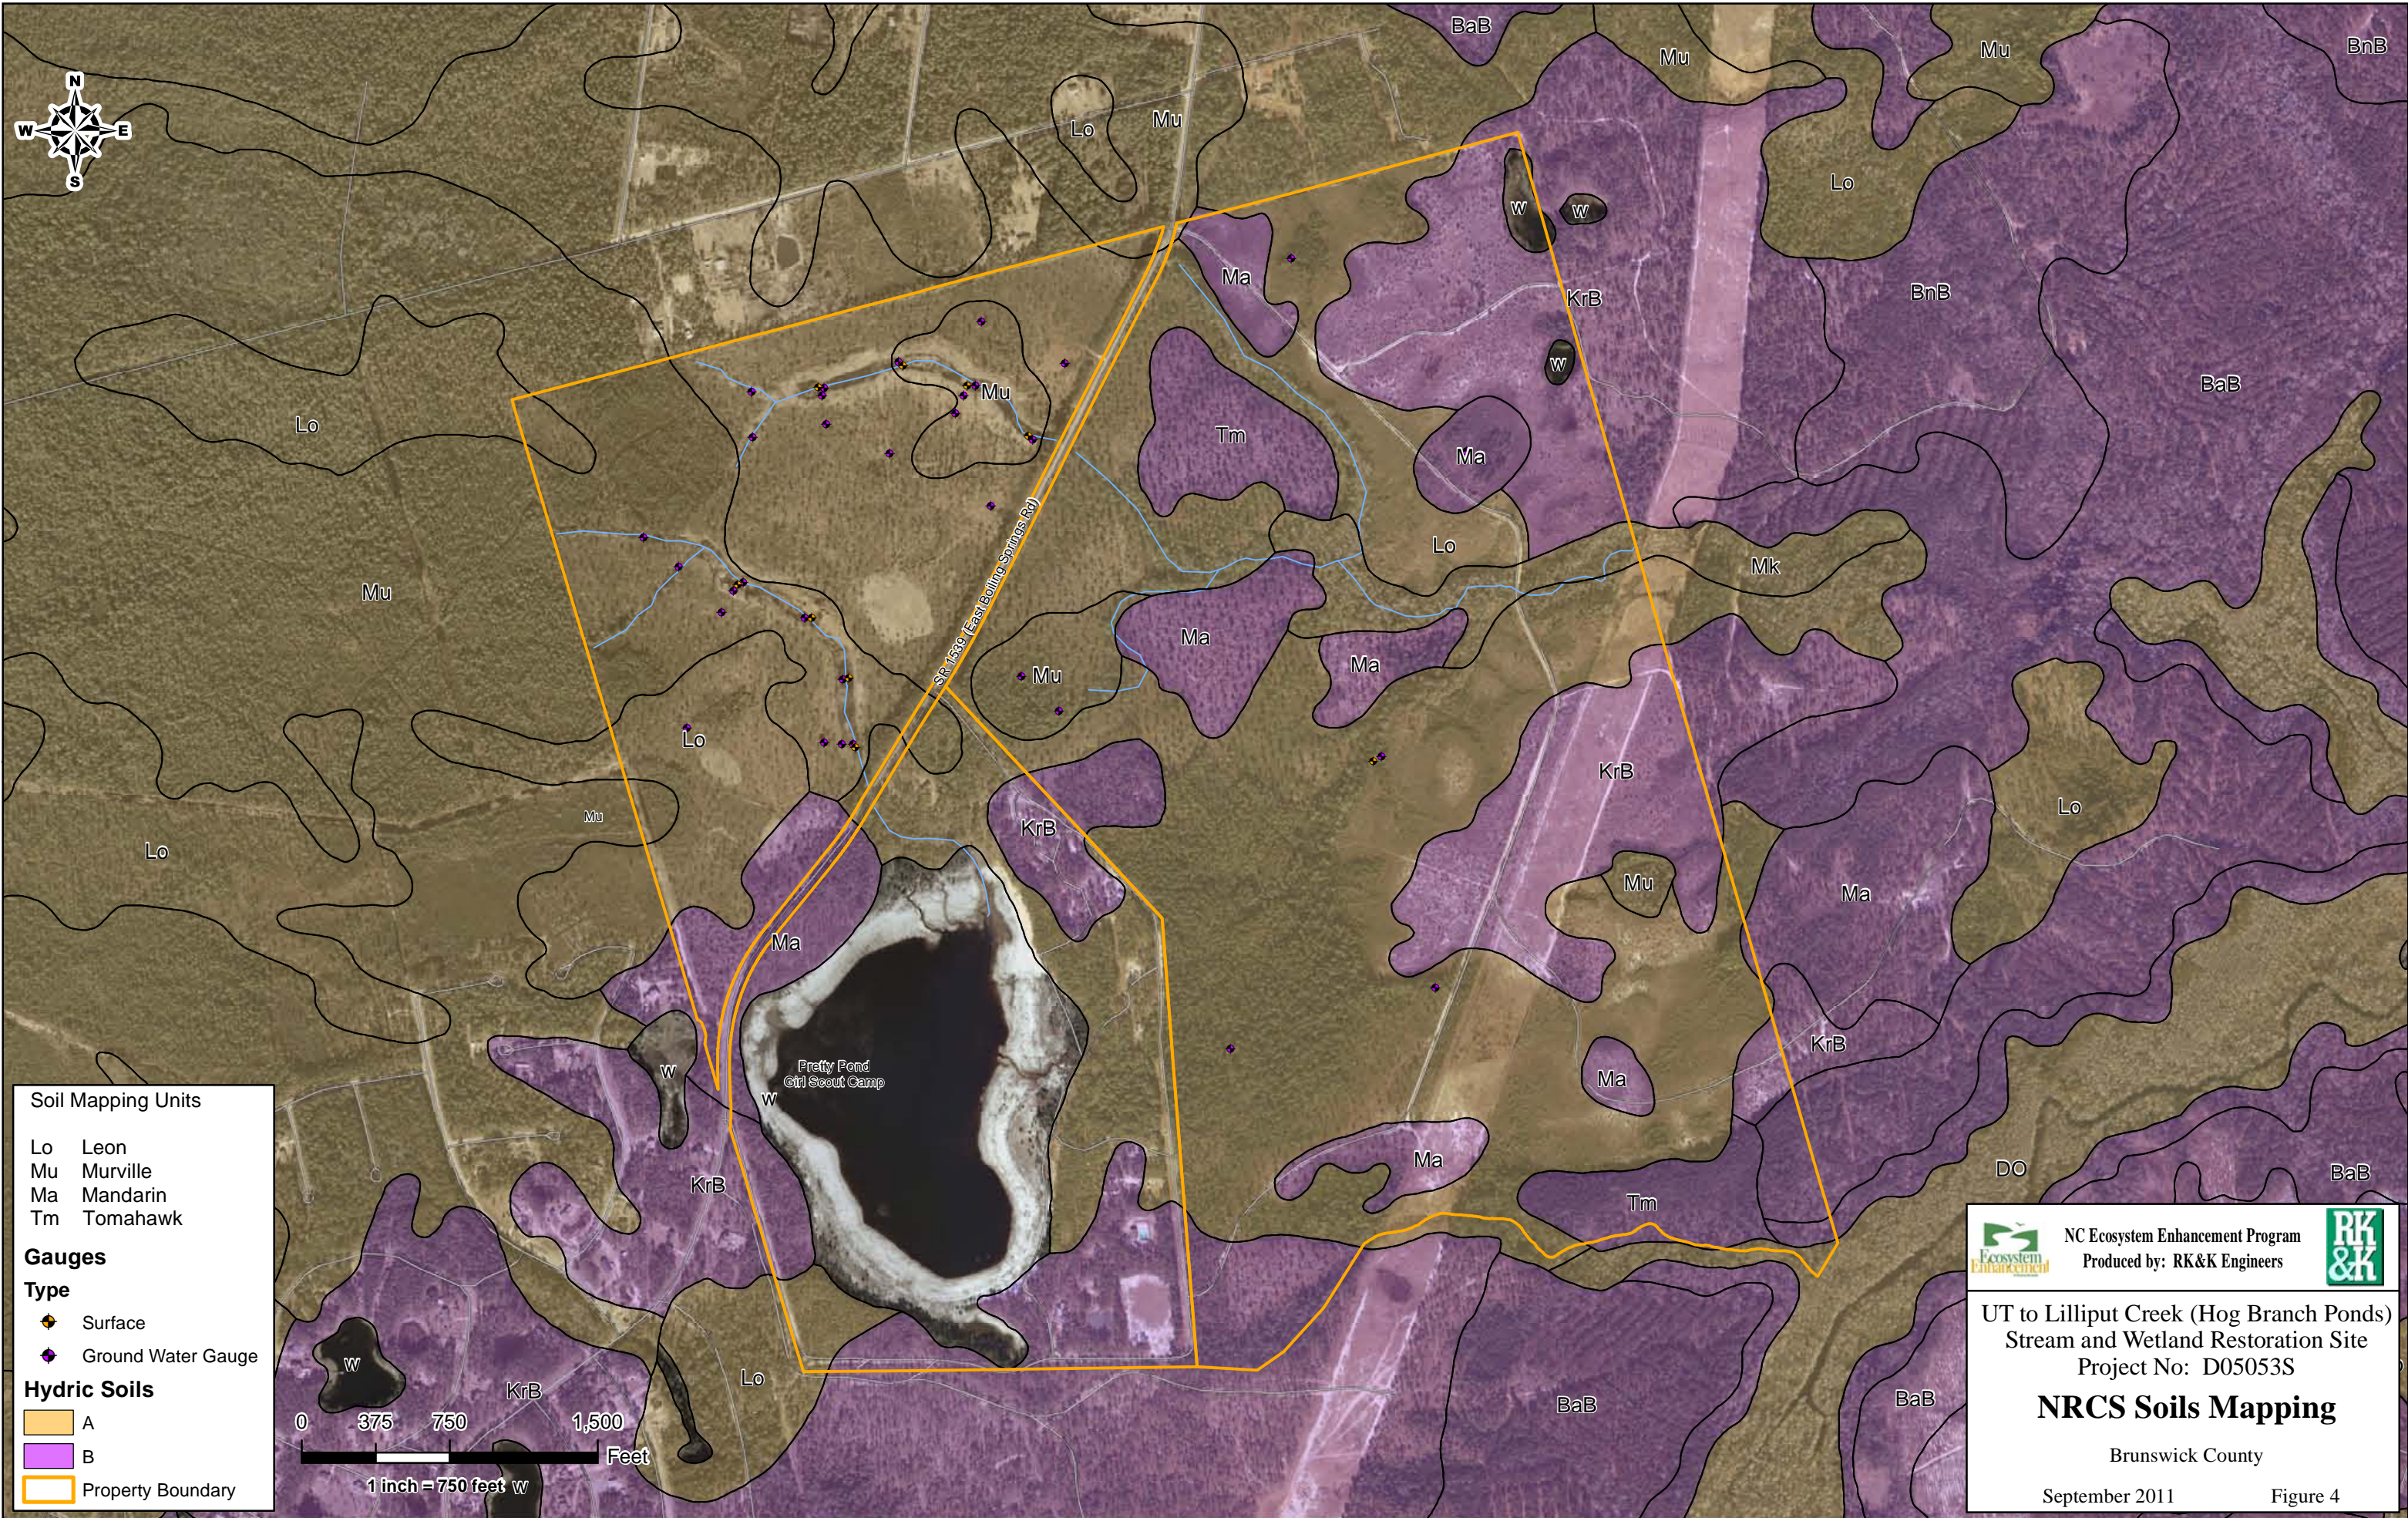

Soil Mapping Units

- Lo Leon
- Mu Murville
- Ma Mandarin
- Tm Tomahawk

Gauges


Type



- Surface
- Ground Water Gauge

Hydric Soils

- A
- B

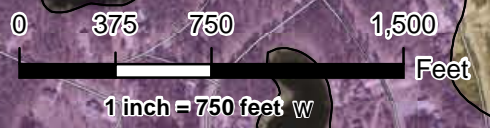Property Boundary




 NC Ecosystem Enhancement Program
 Produced by: RK&K Engineers
 

UT to Lilliput Creek (Hog Branch Ponds)
Stream and Wetland Restoration Site
 Project No: D05053S
NRCS Soils Mapping
 Brunswick County
 September 2011 Figure 4

**Table 1. Project Components and Mitigation Credits
UT Lilliput Stream and Wetland Restoration Project, EEP No. 290**

Mitigation Credits									
	Stream		Riparian Wetland		Non-Riparian Wetland		Buffer	Nitrogen Nutrient Offset	Phosphorous Nutrient Offset
Type	R	RE	R	RE	R	RE			
Totals	3,238	1,066.4		4.09	7.83	65.72			
Project Components									
Project Component	Stationing/Location		Existing Footage/Acreage	Approach	Restoration or Restoration Equivalent	Restoration Footage or Acreage	Mitigation Ratio		
0 to 1 st Order Stream Restoration	Northern Tributary		1,535 LF	Headwater Stream Restoration	Restoration	1,535 LF	1:1		
0 to 1 st Order Stream Restoration	Southern Tributary		1,703 LF	Headwater Stream Restoration	Restoration	1,703 LF	1:1		
Stream Preservation	See Figure 2		5,332 LF	Preservation	Preservation (RE)	5,332 LF	5:1		
Non-riparian Wetland Restoration	See Figure 2		7.83 acres	Restoration	Restoration	7.83 acres	1:1		
Non-riparian Wetland Enhancement	See Figure 2		96.46 acres	Enhancement	Enhancement (RE)	96.46 acres	2:1		
Non-riparian Wetland Preservation	See Figure 2		87.74 acres	Preservation	Preservation (RE)	87.74 acres	5:1		
Riparian Wetland Preservation	See Figure 2		20.45 acres	Preservation	Preservation (RE)	20.45 acres	5:1		
Component Summation									
Restoration Level	Stream (Linear Feet)		Riparian Wetland (acres)	Non-riparian Wetland (acres)	Buffer (acres)	Upland (acres)			
Restoration	3,238 LF			7.83 acres					
Enhancement				96.46 acres					
Enhancement I									
Enhancement II									
Creation									
Preservation	5,332 LF		20.45 acres	87.74 acres					
High Quality Preservation									
BMP Elements*									
Element	Location			Purpose/Function	Notes				

*BMP Elements are not part of the UT Lilliput Project

Table 2. Project Activity and Reporting History UT Lilliput Stream and Wetland Restoration Project - EEP Project No. 290		
Activity or Report	Data Collection Complete	Actual Completion or Delivery
Restoration Plan	NA	October 2006
Final Design – Construction Plans	NA	April 2008
Construction	NA	February 2010
Temporary S&E mix applied to entire project area	NA	March 2009
Permanent seed mix applied to entire project area	NA	March 2009
Containerized and B&B plantings	NA	February 2010
Baseline Monitoring Document (Year 0 Monitoring - baseline)	December 2010	December 2010
Year 1 Monitoring	December 2010	January 2011
Year 2 Monitoring		
Year 3 Monitoring		
Year 4 Monitoring		
Year 5 Monitoring		

Table 3. Project Contacts Table UT Lilliput Stream and Wetland Restoration Project - EEP Project No. 290	
Designer Primary project design POC	RK&K Engineers 900 Ridgefield Drive Suite 350 Raleigh, NC 27609 Pete Stafford (919)-878-9560
Construction Contractor Construction contractor POC	River Works Inc. 8000 Regency Parkway Cary, NC 27518 Will Pedersen (919)-459-9001
Planting Contractor Planting Contractor POC	River Works Inc. 8000 Regency Parkway Cary, NC 27518 Will Pedersen (919)-459-9001
Seeding Contractor Seeding Contractor POC	River Works Inc. 8000 Regency Parkway Cary, NC 27518 Will Pedersen (919)-459-9001
Seed Mix Sources	Contact River Works Inc.
Nursery Stock Suppliers	Contact River Works Inc.
Monitoring Performers (MY1)	Rummel, Klepper, and Kahl, LLP 900 Ridgefield Drive Suite 250 Raleigh, NC 27609
Stream Monitoring POC Vegetation Monitoring POC Wetland Monitoring POC	Pete Stafford (919)878-9560 Pete Stafford (919)878-9560 Pete Stafford (919)878-9560

**Table 4. Project Baseline Information and Attributes
UT Lilliput Stream and Wetland Restoration Project - EEP Project No. 290**








Project Information		
Project Name	UT Lilliput Stream and Wetland Restoration Project	
Project County	Brunswick	
Project Area	517 acres	
Project Coordinates (Lat and Long)	34.078043,-78.026662	
Project Watershed Summary Information		
Physiographic Region	Coastal Plain	
River Basin	Cape Fear	
USGS HUC 8 Digit 03020103	USGS HUC 14 Digit 03030005070010	
NCDWQ Subbasin	03-06-17	
Project Drainage Area	N/A	
Project Drainage impervious cover estimate (%)	< 5%	
CGIA Land Use Classification		
Reach Summary Information		
Parameters	North Tributary	South Tributary
Length of Reach	1,535 LF	1,703 LF
Valley Classification	0 to 1 st order	0 to 1 st order
Drainage Area	52.49 acres	66.94 acres
NCDWQ Stream Identification Score	N/A	N/A
NCDWQ Water Quality Classification	CNSW	CNSW
Morphological Description (stream type)	0 to 1 st order	0 to 1 st order
Evolutionary Trend	N/A	N/A
Underlying Mapped Soils	Leon	Murville
Drainage Class	Poorly Drained	Poorly Drained
Soil Hydric Status	Hydric A	Hydric A
Slope	.001	.001
FEMA Classification	Zone X	Zone X
Native Vegetation Community	N/A	N/A
Percent Composition Exotic Invasive Vegetation	< 1%	< 1%
Wetland Summary Information		
Parameter	Wetland 1	Wetland 2
Size (acres)	87.74	22.45
Wetland Type	Non-Riparian	Riparian
Mapped Soils Series	Murville and Leon	Muckalee
Drainage Class	Very Poorly Drained, Poorly drained	Very poorly drained
Soil Hydric Status	A	A
Source of Hydrology	Groundwater	Groundwater
Hydrologic Impairment	N/A	N/A
Native Vegetation Community	Long Leaf Pine	Coastal Plain Blackwater Small Stream
Percent of Exotic/Invasive Veg	<1%	<1%

Table 4. Continued
UT Lilliput Stream and Wetland Restoration Project - EEP Project No. 290

Regulatory Considerations			
Regulation	Applicable?	Resolved?	Supporting Documentation
Waters of the United States – Section 404	Yes	Yes	Upon Request
Waters of the United States – Section 401	Yes	Yes	Upon Request
Endangered Species Act	Yes	Yes	Upon Request
Historic Preservation Act	Yes	Yes	Upon Request
Coastal Zone Management Act (CZMA)	Yes	Yes	Upon Request
Coastal Area Management Act (CAMA)			
FEMA Floodplain Compliance	Yes	Yes	Upon Request
Essential Fisheries Habitat	No		

APPENDIX B

Morphological Summary Data, Plots, and Photos

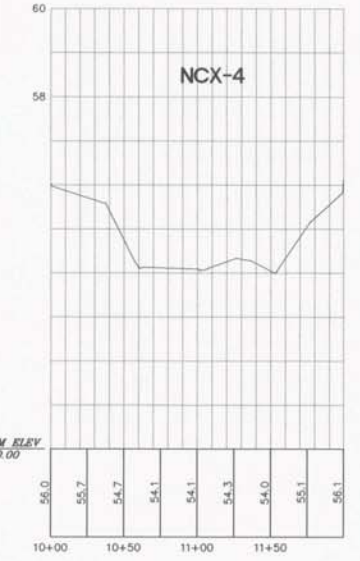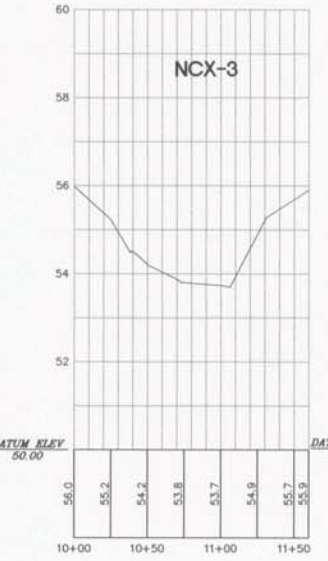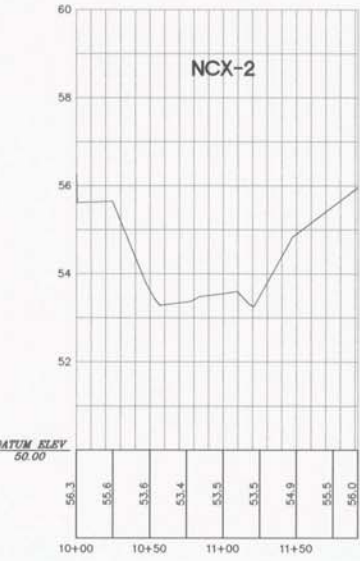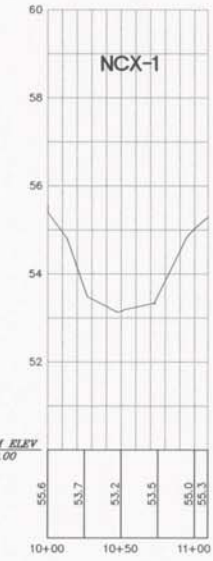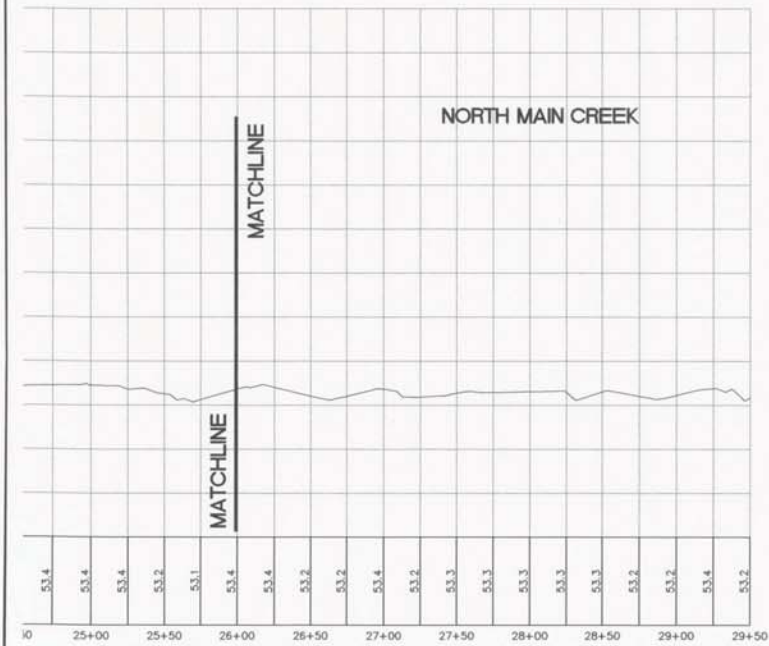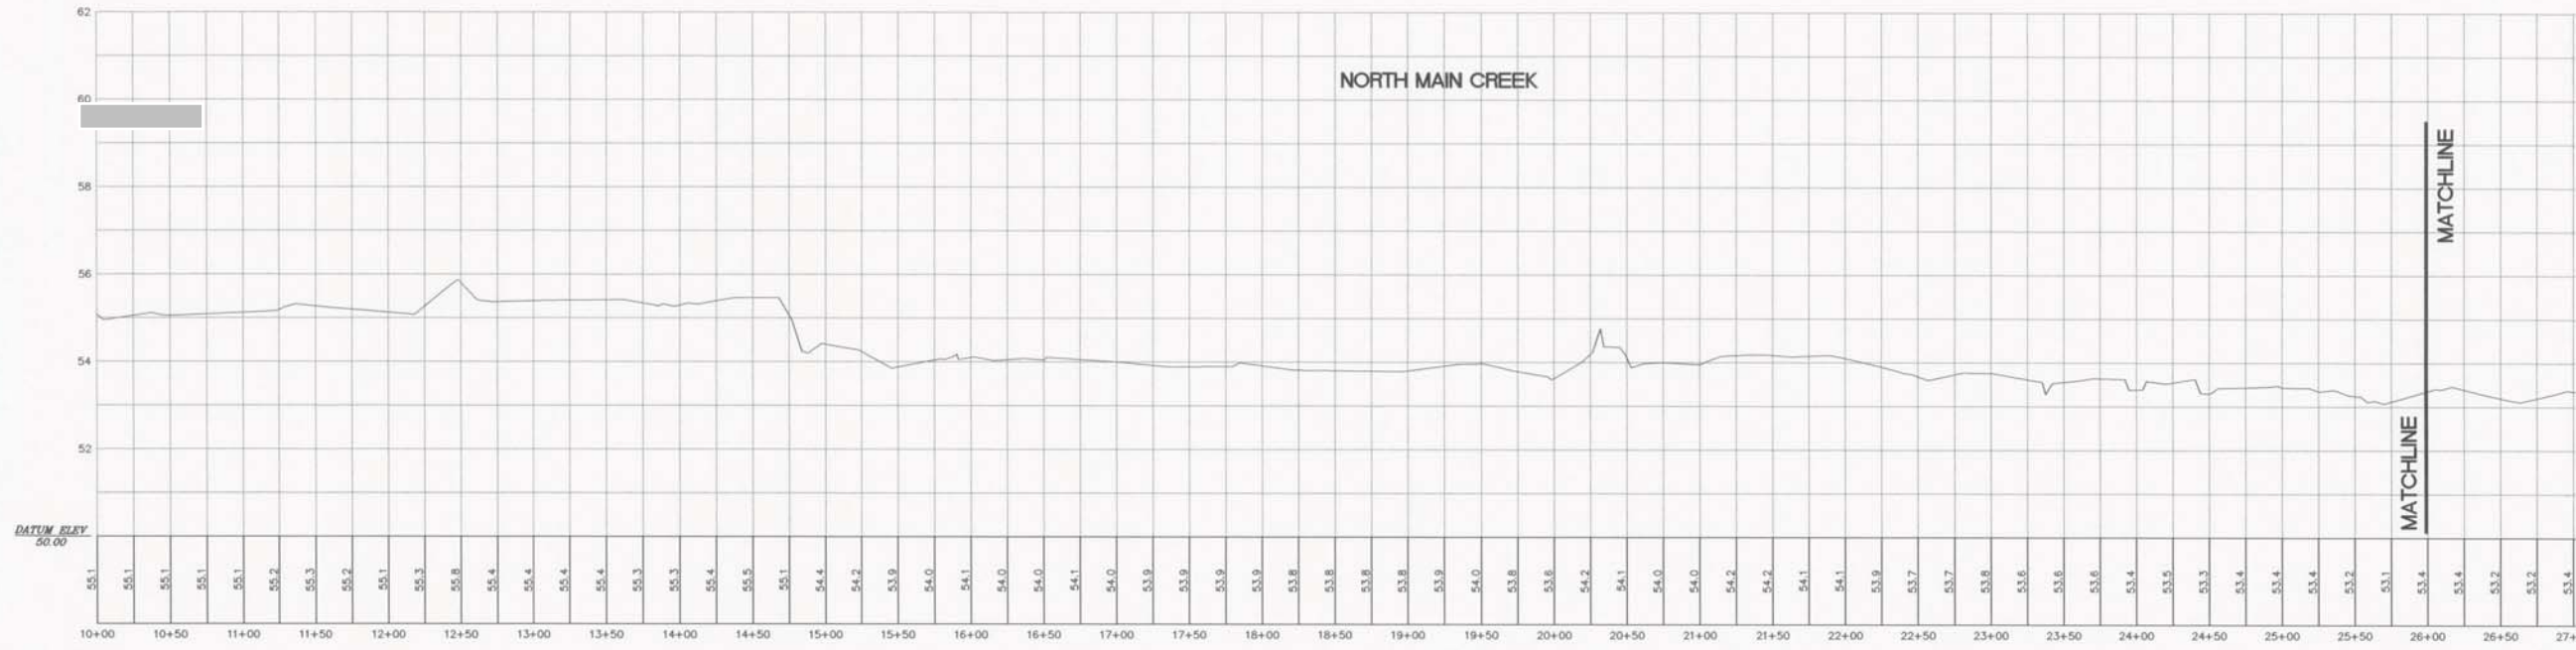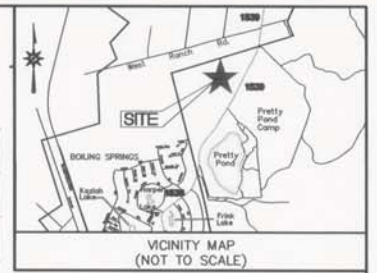

- SECTION LOCATION MARKER
- SURFACE GAUGE, ELEVATION SHOT AT CALIBRATION POINT
- IRON ROD FOUND AT CORNERS OF VEGETATION PLOTS
- ⊙ GROUNDWATER GAUGE
- FLOW DISRUPTER
- LIMITS OF GRADING
- LOG CURTIN

- NOTES:
- 1) ALL DISTANCES SHOWN ARE GROUND HORIZONTAL UNLESS OTHERWISE NOTED.
 - 2) HORIZONTAL DATUM IS NAD 83, 1986.
 - 3) VERTICAL DATUM IS NGVD 29.
 - 4) RECORD DRAWING— THE INFORMATION SHOWN HEREON IS TAKEN FROM CONTRACTOR RECORDS AND POST-CONSTRUCTION SURVEY.
 - 5) ALL CONTOURS SHOWN IN GREY SCALE AND DASHED ARE REFERENCED FROM PREVIOUS SURVEYS AND ARE FOR INFORMATIONAL PURPOSES ONLY.
 - 6) ENGINEER OF RECORD:
HOWARD T. WOODALL, III, PE
RUMMEL, KLEPPER & KAHL, LLP
900 RIDGEFIELD DRIVE, STE. 350
RALPHI, NC 27609
NC LICENSE NO. F-0112
 - 7) FIELD SURVEYS PERFORMED JUNE 2009.








DATE	REVISION	INITIAL

MCKIM & CREED
 3904 Bus. Hwy. 17 East
 Bolivia, North Carolina 28422
 Phone: (910)253-6622, Fax: (910)253-6634
 NC FIRM C-0342
 Internet Site: <http://www.mckimcreed.com>

DATE: _____

AS-BUILT SURVEY OF
**UNNAMED TRIBUTARY TO LILLIPUT STREAM
 AND WETLAND RESTORATION**
 FOR
RIVER WORKS, INC
 4117 PLEASANT GARDEN ROAD
 GREENSBORO, NC 27406
 DATE: JUNE 23, 2010 SCALE: 1" = 60'
 TOWNCREEK TOWNSHIP BRUNSWICK COUNTY NORTH CAROLINA

PROJECT #: 05631-0001
 PROJ. SVYR.: MRS
 DRAWN BY:
 FIELD BK.:
 COMP. FILE: VA101-056310001
 SHEET #: 8 OF 9
Appendix B
 DWG. #: VA101-056310001

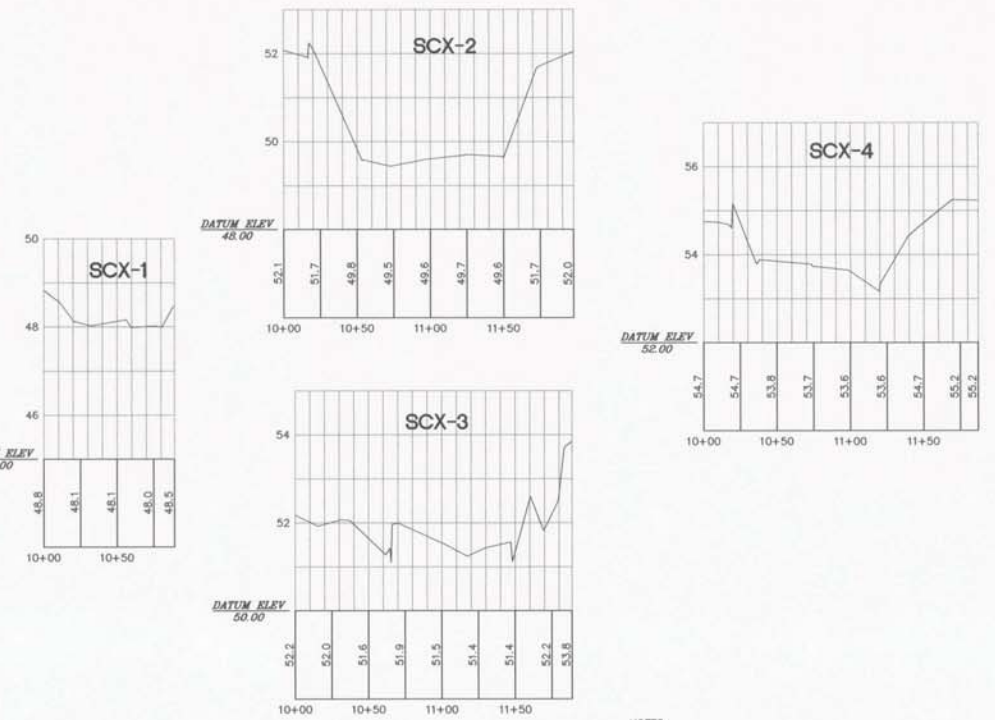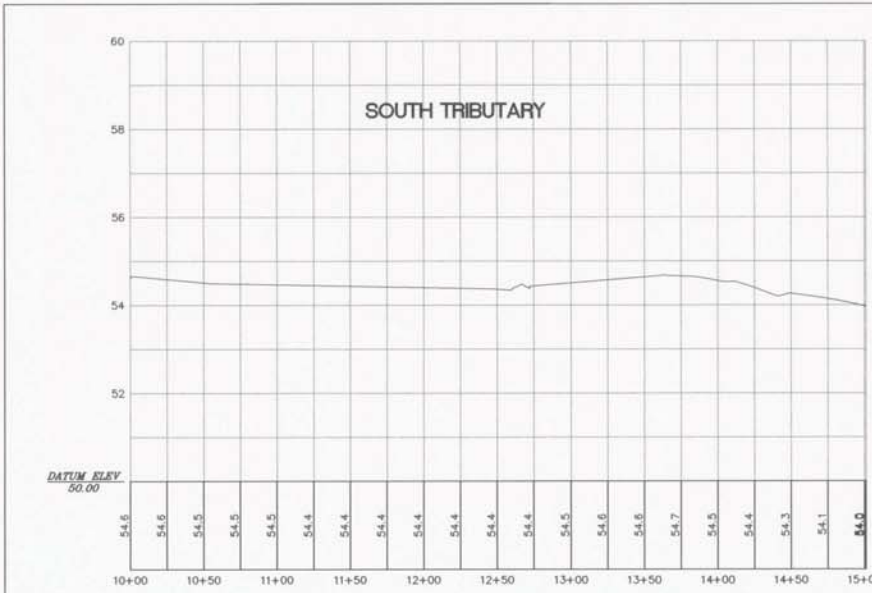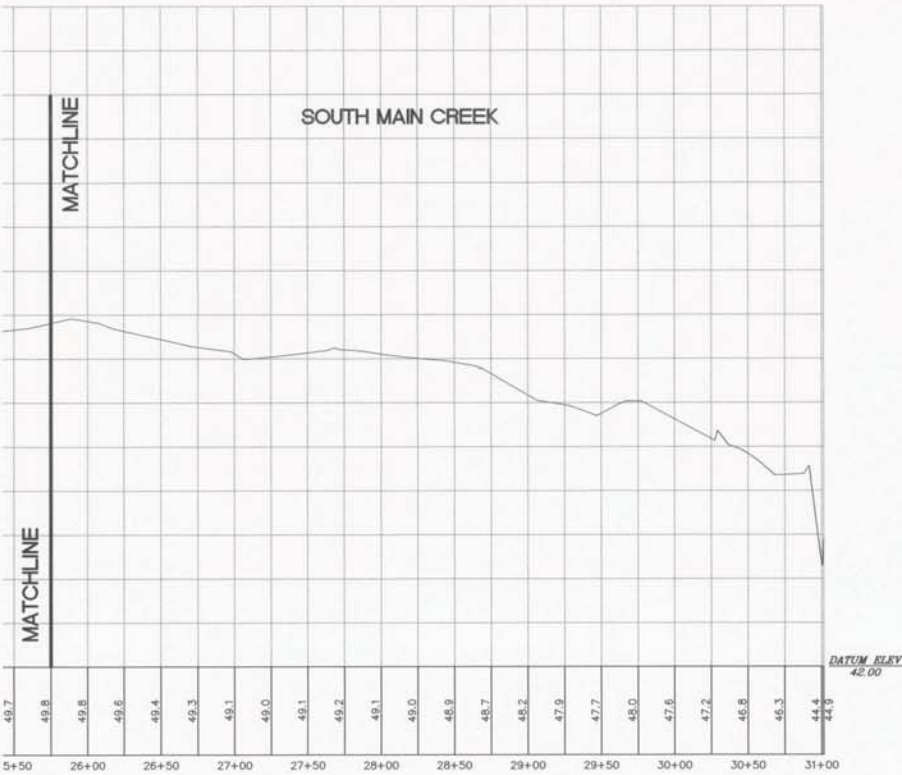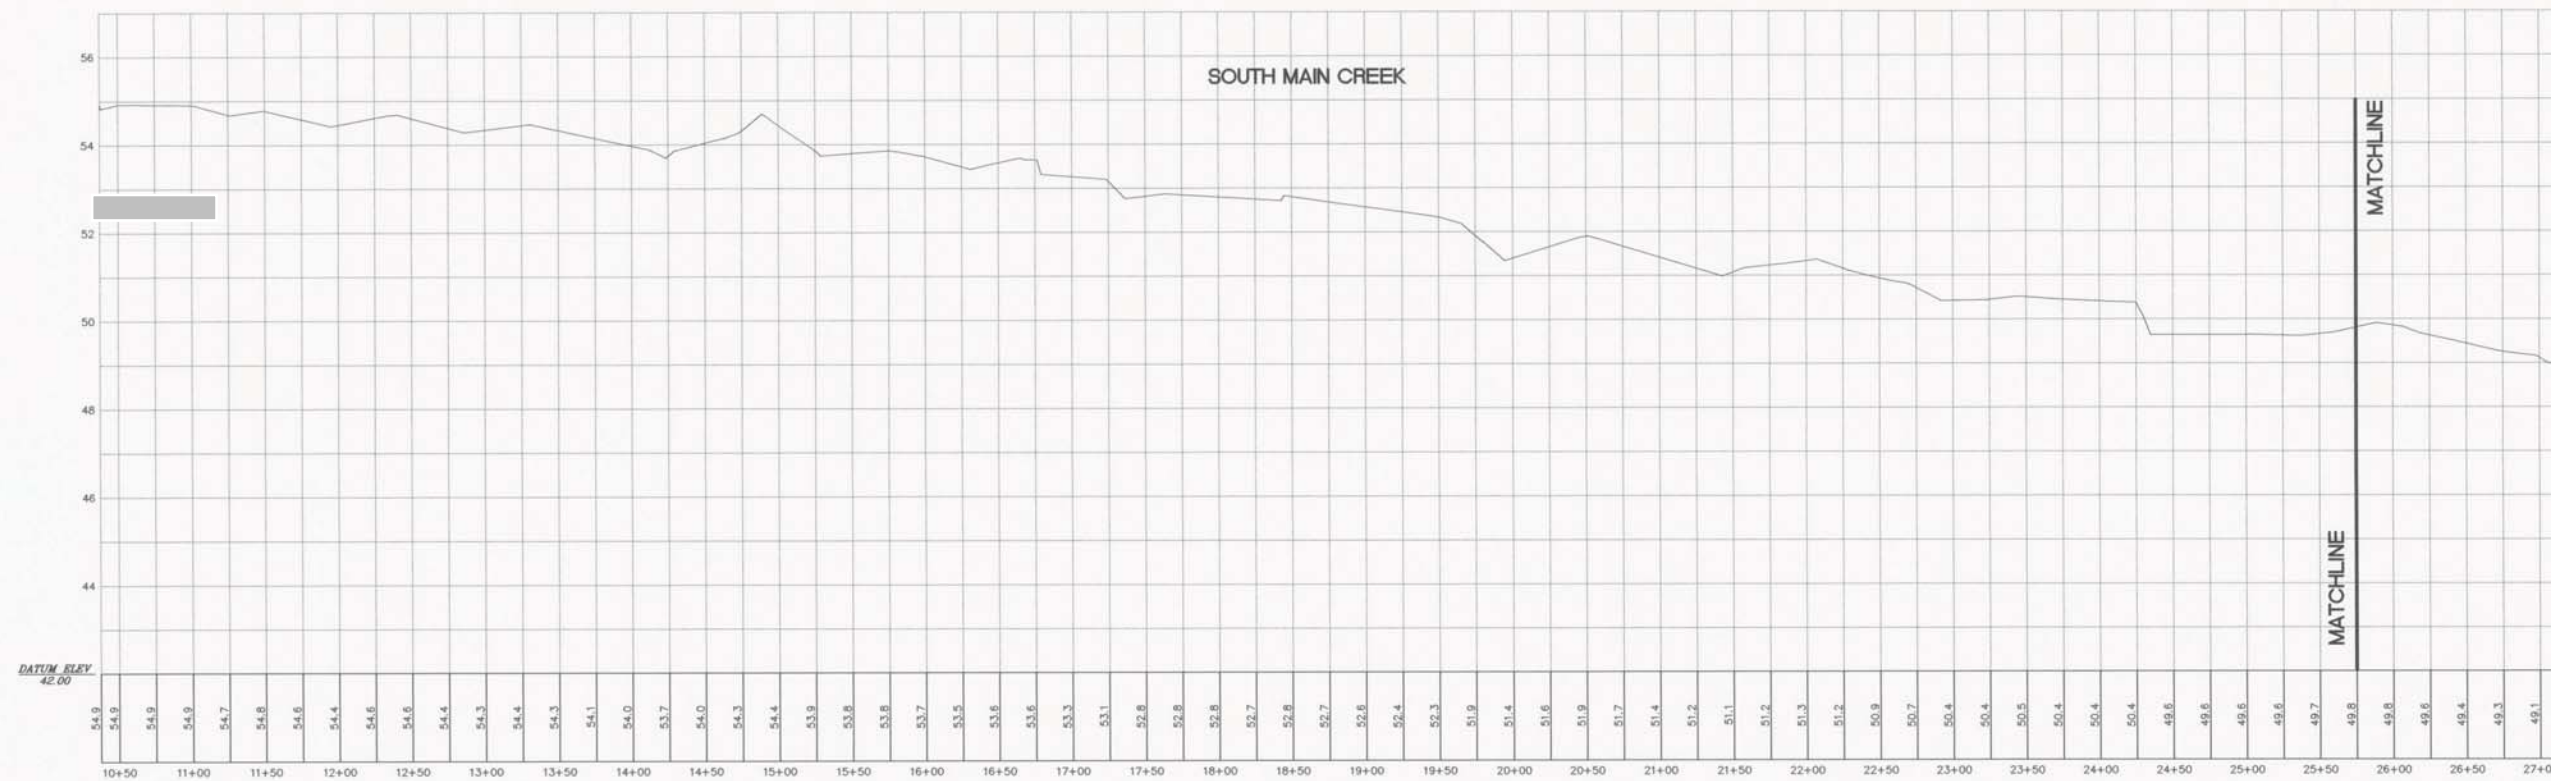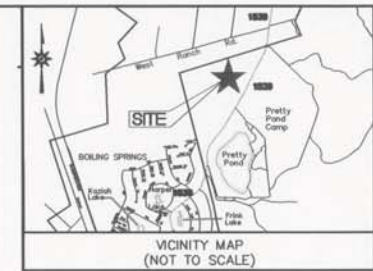

- NOTES:
- 1) ALL DISTANCES SHOWN ARE GROUND HORIZONTAL UNLESS OTHERWISE NOTED.
 - 2) HORIZONTAL DATUM IS NAD 83, 1986.
 - 3) VERTICAL DATUM IS NGVD 29.
 - 4) RECORD DRAWING - THE INFORMATION SHOWN HEREON IS TAKEN FROM CONTRACTOR RECORDS AND POST-CONSTRUCTION SURVEY.
 - 5) ALL CONTOURS SHOWN IN GREY SCALE AND DASHED ARE REFERENCED FROM PREVIOUS SURVEYS AND ARE FOR INFORMATIONAL PURPOSES ONLY.
 - 6) ENGINEER OF RECORD: HOWARD T. WOODALL, III, PE, RUMMEL, KLEPPER & KAHN, LLP, 900 RIDGEFIELD DRIVE, STE. 350, RALEIGH, NC 27609, NC LICENSE NO. F-0112.
 - 7) FIELD SURVEYS PERFORMED JUNE 2009.

- SECTION LOCATION MARKER
- SURFACE GAUGE, ELEVATION SHOT AT CALIBRATION POINT
- IRON ROD FOUND AT CORNERS OF VEGETATION PLOTS
- ⊕ GROUNDWATER GAUGE
- FLOW DISRUPTER
- LIMITS OF GRADING
- LOG CURTIN



DATE	REVISION	INITIAL

MCKIM & CREED
 3904 Bus. Hwy. 17 East
 Bolivia, North Carolina 28422
 Phone: (910)253-6622, Fax: (910)253-6634
 NC FIRM C-0342
 Internet Site: <http://www.mckimcreed.com>

DATE: _____

AS-BUILT SURVEY OF
**UNNAMED TRIBUTARY TO LILLIPUT STREAM
 AND WETLAND RESTORATION**
 FOR
RIVER WORKS, INC
 4117 PLEASANT GARDEN ROAD
 GREENSBORO, NC 27406
 DATE: JUNE 23, 2010 SCALE: 1" = 60'
 TOWNCREEK TOWNSHIP BRUNSWICK COUNTY NORTH CAROLINA

PROJECT #: 05631-0001
 PROJ. SVYR: MRS
 DRAWN BY:
 FIELD BK.:
 COMP. FILE: VA101-056310001
 SHEET #: 9 OF 9
Appendix B
 DWG. #: VA101-056310001

Appendix B - Stream and Cross Section Photos (all photos recorded on December 6, 2010)



Photo Station 1. Southern Tributary Station 15+00 – Looking upstream



Photo Station 2. Southern Tributary Station 15+00 – SCX4 - Looking downstream

Photos recorded on December 6, 2010



Photo Station 3. Southern Tributary Station 23+00 – SCX3 - Looking upstream



Photo Station 4. Southern Tributary Station 23+00 – SCX2 - Looking downstream

Photos recorded on December 6, 2010



Photo Station 5. Southern Tributary Station 29+00 – Looking upstream



Photo Station 6. Southern Tributary Station 29+00 – SCX1 - Looking downstream

Photos recorded on December 6, 2010



Photo Station 7. Northern Tributary Station 14+00 – NCX4 - Looking downstream



Photo Station 8. Northern Tributary Station 21+00 – NCX3 - Looking upstream

Photos recorded on December 6, 2010



Photo Station 9. Northern Tributary Station 21+00 – NCX2 - Looking downstream



Photo Station 10. Northern Tributary Station 28+25 – Looking upstream

Photos recorded on December 6, 2010



Photo Station 11. Northern Tributary Station 28+25 –NCX1 - Looking downstream



Photo Station 12. Site 1 Non-Riparian Wetland Restoration

Photos recorded on December 6, 2010



Photo Station 13. Site 2 Non-Riparian Wetland Restoration



Photo Station 14. Site 3 Non-Riparian Wetland Restoration

Photos recorded on December 6, 2010



Photo Station 15. Site 4 Non-Riparian Wetland Enhancement



Photo Station 16. Site 5 Non-Riparian Wetland Enhancement

Photos recorded on December 6, 2010



Photo Station 17. Site 6 Non-Riparian Wetland Restoration (Photo Recorded on 10/2010)



Photo Station 18. Site 7 Non-Riparian Wetland Enhancement

Photos recorded on December 6, 2010

UT to Lilliput Creek (Hog Branch Ponds) Stream and Wetland Restoration Site – EEP No. 290
RK&K – Draft Baseline Monitoring Document



Photo Station 19. Northern Headwater Wetland, Northern Prong



Photo Station 20. Northern Headwater Wetland, Southern Prong

Photos recorded on December 6, 2010



Photo Station 21. Southern Headwater Wetland, Northern Prong



Photo Station 22. Southern Headwater Wetland, Southern Prong

Photos recorded on December 6, 2010



Photo Station 23. Non-Riparian Wetland Enhancement Area, General Site Photos



Photo Station 24. Non-Riparian Wetland Enhancement Area, General Site Photos

Photos recorded on December 6, 2010



Photo Station 25. Non-Riparian Wetland Enhancement Area, General Site Photos

Photos recorded on December 6, 2010

UT to Lilliput Creek (Hog Branch Ponds) Stream and Wetland Restoration Site – EEP No. 290
RK&K – Draft Baseline Monitoring Document

APPENDIX C

Vegetation Data

Table 7. Planted and Total Stem Counts (Species by Plot with Annual Means)

		CURRENT DATA (Baseline 2010)																								ANNUAL MEANS							
		Plot 1		Plot 2		Plot 3		Plot 4		Plot 5		Plot 6		Plot 7		Plot 8		Plot 9		Plot 10		Plot 11		Plot 12		Plot 13		Plot 14		Plot 15		As Built (2010)	
Scientific Name	Common Name	Type	P	T*	P	T*	P	T*	P	T*	P	T*	P	T*	P	T*	P	T*	P	T*	P	T*	P	T*	P	T*	P	T*	P	T*	P	T*	
<i>Magnolia virginiana</i>	sweetbay	Tree	6		2		2						6		3		2															21	
<i>Nyssa biflora</i>	swamp tupelo	Tree													1																	1	
<i>Pinus palustris</i>	longleaf pine	Tree								7		8					20		18				12		18		17		18		118		
<i>Pinus serotina</i>	pond pine	Tree	7		7		7		3		6		12		6		12		4		20		18		12		9				73		
<i>Quercus sp.</i>	oak sp.	Tree	4		5		9		9						7		7		6												47		
<i>Quercus lyrata</i>	overcup oak	Tree																													3		
		Plot Area (a)	0.025		0.025		0.025		0.025		0.025		0.025		0.025		0.025		0.025		0.025		0.025		0.025		0.025		0.025		0.025		
* Not Applicable for Baseline	Species Count		3		3		3		2		2		2		3		4		4		1		1		1		1		1		6		
Type = Tree or Shrub	Stem Count		17		14		18		12		13		20		19		23		15		20		18		21		18		17		263		
P = Planted, T = Total	Stems/Acre		687.48		566.16		727.92		485.28		525.72		808.8		768.36		930.12		606.6		808.8		727.92		849.24		727.92		687.48		709		

APPENDIX D

As-Built Plan Sheets

09/08/99

DENR CONTRACT: D05053S SCO CONTRACT: 04-06351-01A

ECOSYSTEM ENHANCEMENT PROGRAM

UNNAMED TRIBUTARY TO LILLIPUT STREAM AND WETLAND RESTORATION BRUNSWICK COUNTY


STATE	DENR CONTRACT NO.	SHEET NO.	TOTAL SHEETS
N.C.	D05053S	1	52

SCO CONTRACT NO. 04-06351-01A

RECORD DRAWINGS


CONTRACTOR:
RIVER WORKS, INC.
LICENSE #54912

CONTACT:
WILL PEDERSON
3000 REGENCY PKWY, STE. 200
CARY, NC 27818
PHONE: 919-459-9001

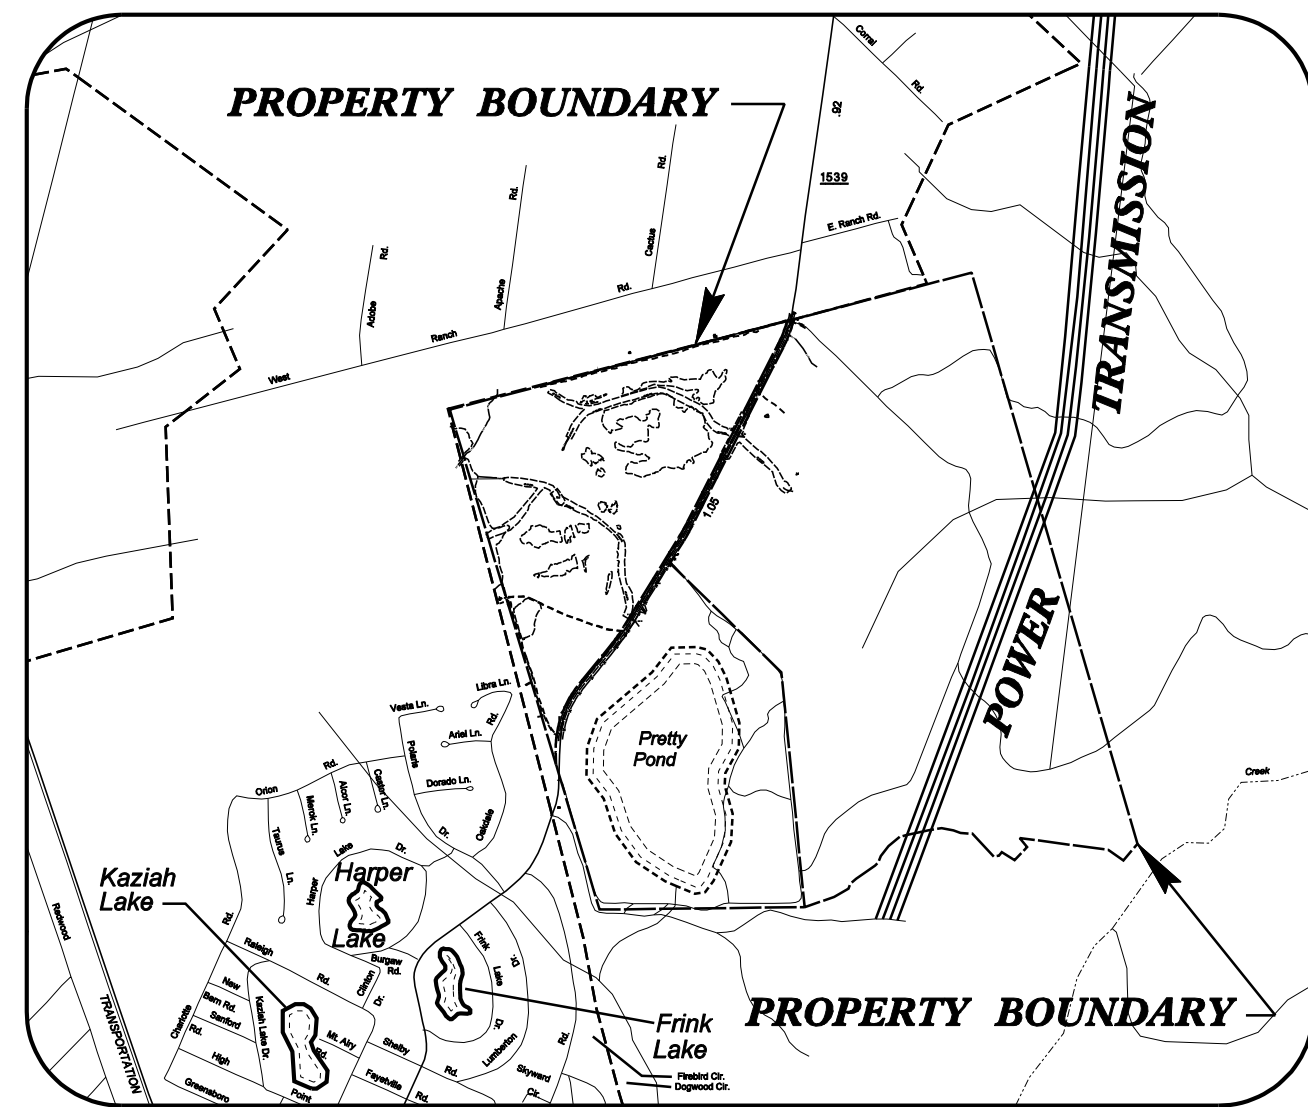


VICINITY MAP

LOCATION: SR 1539 (BOILING SPRING RD.)
TYPE OF WORK: STREAM & WETLAND RESTORATION

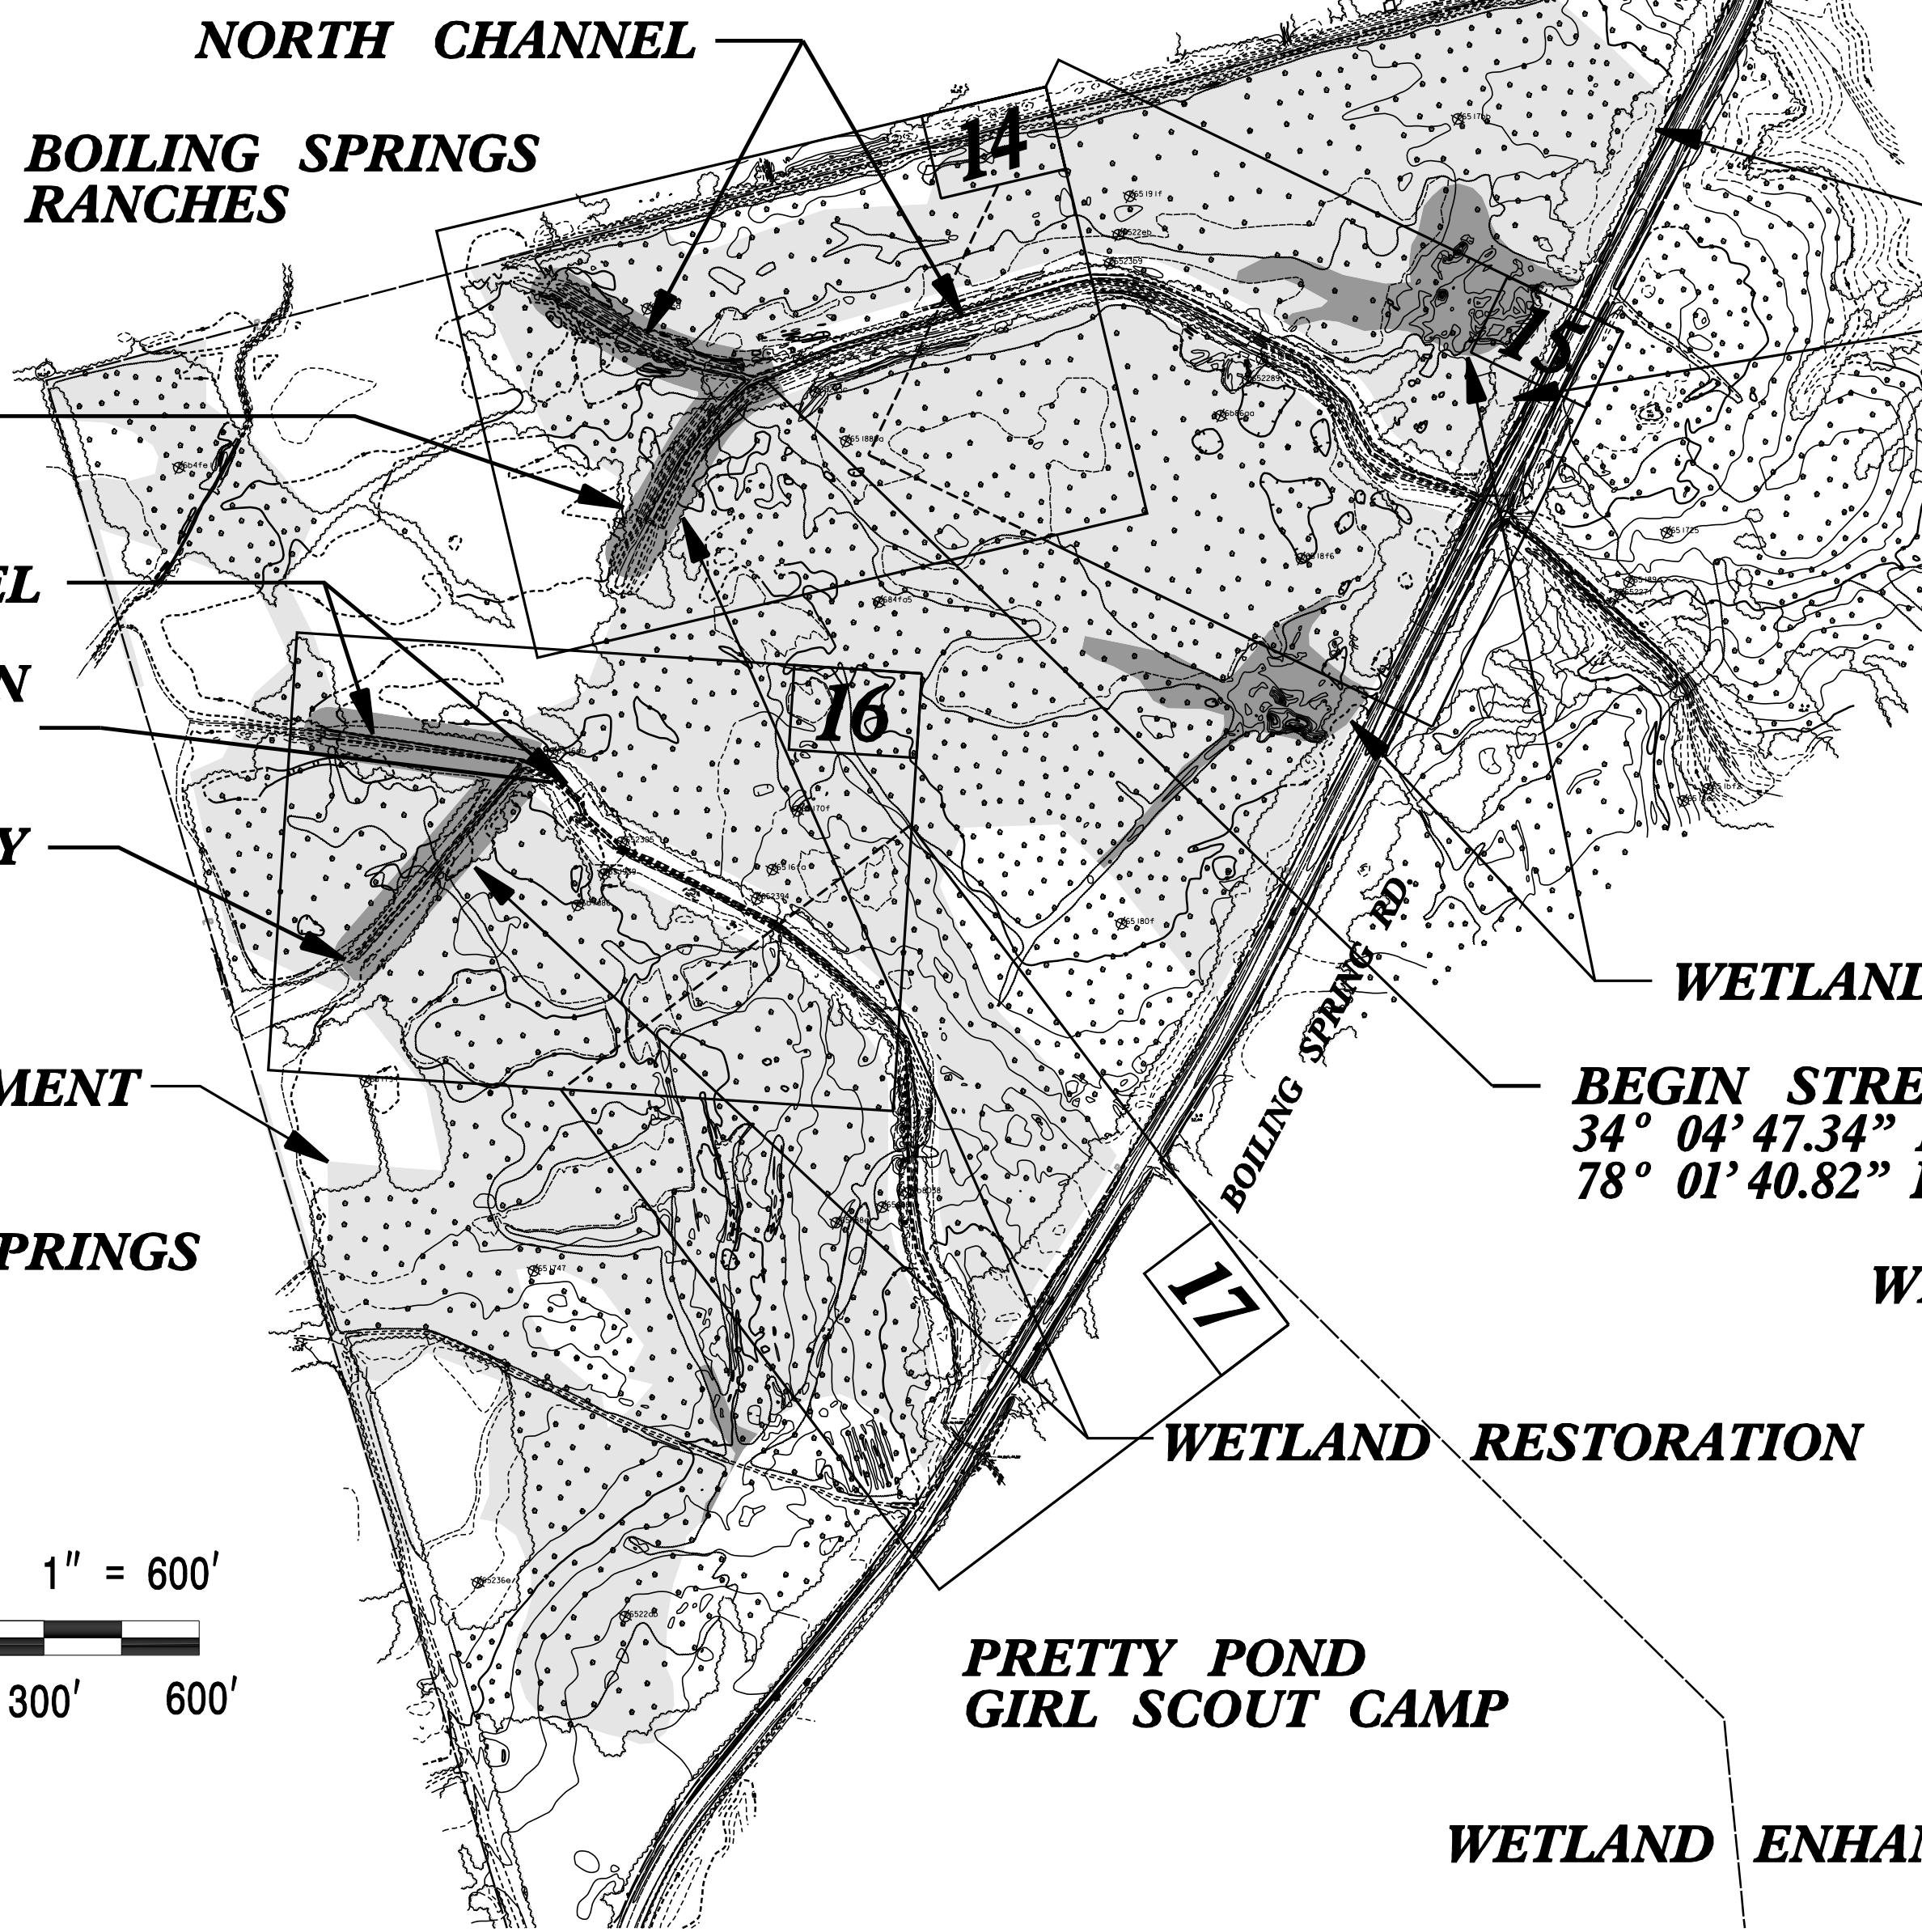

BEGIN STREAM RESTORATION
34° 04' 39.75" LATITUDE
78° 01' 46.79" LONGITUDE

BEGIN STREAM RESTORATION
34° 04' 47.34" LATITUDE
78° 01' 40.82" LONGITUDE

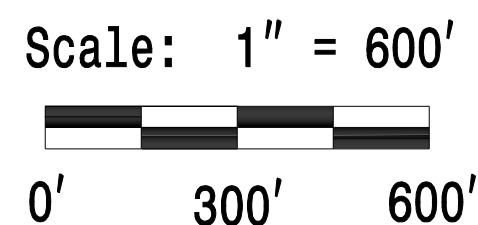

PROPERTY BOUNDARY (TYPICAL)

POWER EASEMENT



NOVEMBER 4, 2010

INDEX OF SHEETS	
SHEET NO.	DESCRIPTION
1	TITLE
2 THRU 2B	TYPICAL SECTION & DETAILS
3 THRU 6	EXISTING CONDITIONS
7 THRU 12	WETLAND RESTORATION & ENHANCEMENT
13 THRU 17	STREAM RESTORATION
18 THRU 19	PROFILE SHEETS
S-1 THRU S-9	AS-BUILT SURVEY
X-1 THRU X-30	CROSS SECTIONS

PROJECT DATA	
STREAM RESTORATION LENGTH	3,238 FT.
WETLAND RESTORATION	7.83 AC.
WETLAND ENHANCEMENT	96.46 AC.
TOTAL DISTURBED ACREAGE	19.83 AC




PLANS PREPARED BY :
RUMMEL • KLEPPER & KAHL, LLP
consulting engineers
900 RIDGEFIELD DRIVE SUITE 350
RALEIGH, NORTH CAROLINA 27609-3960
RKK.COM NC LICENSE No. F-0012 919-878-9560

FOR
ECOSYSTEM ENHANCEMENT PROGRAM

KRISTIN MIGUEZ
EEP PROJECT MANAGER

WYATT BROWN
EEP REVIEW COORDINATOR

DESIGN ENGINEER

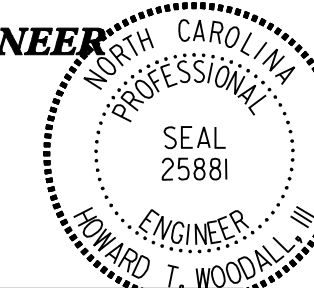

WILLIAM E. STAFFORD
PROJECT SCIENTIST

HOWARD T. WOODALL III, P.E.
PROJECT DESIGN ENGINEER

SIGNATURE:

12/17/2010 U:\COMMONS\304045\Proj\Record Drawings\Lilliput_strm_tsh.dgn bodey

STATE OF NORTH CAROLINA
DIVISION OF HIGHWAYS

RECORD DRAWINGS

*S.U.E = SUBSURFACE UTILITY ENGINEER

CONVENTIONAL SYMBOLS

ROADS & RELATED ITEMS

Edge of Pavement	-----
Curb	-----
Prop. Slope Stakes Cut	----- C
Prop. Slope Stakes Fill	----- F
Prop. Woven Wire Fence	-----
Prop. Chain Link Fence	-----
Prop. Barbed Wire Fence	-----
Prop. Wheelchair Ramp	-----
Curb Cut For Future Wheelchair Ramp	----- WCR ----- CCFR
Exist. Guardrail	-----
Prop. Guardrail	-----
Exist. Cable Guiderail	-----
Prop. Cable Guiderail	-----
Equality Symbol	-----
Pavement Removal	-----

RIGHT OF WAY

Baseline Control Point	-----
Existing Right of Way Marker	-----
Exist. Right of Way Line w/Marker	-----
Prop. Right of Way Line with Proposed	-----
RW marker (Iron Pin & Cap)	-----
Prop. Right of Way Line with Proposed	-----
(Concrete or Granite) R/w Marker	-----
Exist. Control of Access Line	-----
Prop. Control of Access Line	-----
Exist. Easement Line	-----
Prop. Temp. Construction Easement Line	-----
Prop. Temp. Drainage Easement Line	----- TDE
Prop. Perm. Drainage Easement Line	----- PDE

HYDROLOGY

Stream or Body of Water	-----
Flow Arrow	-----
Disappearing Stream	-----
Spring	-----
Swamp Marsh	-----
Shoreline	-----
Falls, Rapids	-----
Prop Lateral, Tail, Head Ditches	-----

STRUCTURES

MAJOR	
Bridge, Tunnel, or Box Culvert	----- CONC
Bridge Wing Wall, Head Wall and End Wall	----- CONC WW

MINOR	
Head & End Wall	----- CONC HW
Pipe Culvert	-----
Footbridge	-----
Drainage Boxes	----- CB
Paved Ditch Gutter	-----

UTILITIES

Exist. Pole	-----
Exist. Power Pole	-----
Prop. Power Pole	-----
Exist. Telephone Pole	-----
Prop. Telephone Pole	-----
Exist. Joint Use Pole	-----
Prop. Joint Use Pole	-----
Telephone Pedestal	-----
Cable TV Pedestal	-----
Hydrant	-----
Satellite Dish	-----
Exist. Water Valve	-----
Sewer Clean Out	-----
Power Manhole	-----
Telephone Booth	-----
Water Manhole	-----
Light Pole	-----
H-Frame Pole	-----
Power Line Tower	-----
Pole with Base	-----
Gas Valve	-----
Gas Meter	-----
Telephone Manhole	-----
Power Transformer	-----
Sanitary Sewer Manhole	-----
Storm Sewer Manhole	-----
Tank; Water, Gas, Oil	-----
Water Tank With Legs	-----
Traffic Signal Junction Box	-----
Fiber Optic Splice Box	-----
Television or Radio Tower	-----
Utility Power Line Connects to Traffic Signal Lines Cut Into the Pavement	----- TS

Recorded Water Line	----- W
Designated Water Line (S.U.E.*)	----- W
Sanitary Sewer	----- SS
Recorded Sanitary Sewer Force Main	----- FSS
Designated Sanitary Sewer Force Main(S.U.E.*)	----- FSS
Recorded Gas Line	----- G
Designated Gas Line (S.U.E.*)	----- G
Storm Sewer	----- S
Recorded Power Line	----- P
Designated Power Line (S.U.E.*)	----- P
Recorded Telephone Cable	----- T
Designated Telephone Cable (S.U.E.*)	----- T
Recorded U/G Telephone Conduit	----- TC
Designated U/G Telephone Conduit (S.U.E.*)	----- TC
Unknown Utility (S.U.E.*)	----- ?UTL
Recorded Television Cable	----- TV
Designated Television Cable (S.U.E.*)	----- TV
Recorded Fiber Optics Cable	----- FO
Designated Fiber Optics Cable (S.U.E.*)	----- FO
Exist. Water Meter	-----
U/G Test Hole (S.U.E.*)	-----
Abandoned According to U/G Record	----- ATTUR
End of Information	----- E.O.I.

BOUNDARIES & PROPERTIES

State Line	-----
County Line	-----
Township Line	-----
City Line	-----
Reservation Line	-----
Property Line	-----
Property Line Symbol	-----
Exist. Iron Pin	----- EIP
Property Corner	-----
Property Monument	----- ECM
Property Number	----- 123
Parcel Number	----- 6
Fence Line	----- WW & ISBW
Existing Wetland Boundaries	----- WLB
Proposed Wetland Boundaries	----- WLB
Existing Endangered Animal Boundaries	----- EAB
Existing Endangered Plant Boundaries	----- EPB

BUILDINGS & OTHER CULTURE

Buildings	-----
Foundations	-----
Area Outline	-----
Gate	-----
Gas Pump Vent or U/G Tank Cap	-----
Church	-----
School	-----
Park	-----
Cemetery	-----
Dam	-----
Sign	-----
Well	-----
Small Mine	-----
Swimming Pool	-----

TOPOGRAPHY

Loose Surface	-----
Hard Surface	-----
Change in Road Surface	-----
Curb	-----
Right of Way Symbol	----- R/W
Guard Post	----- GP
Paved Walk	-----
Bridge	-----
Box Culvert or Tunnel	-----
Ferry	-----
Culvert	-----
Footbridge	-----
Trail, Footpath	-----
Light House	-----

VEGETATION

Single Tree	-----
Single Shrub	-----
Hedge	-----
Woods Line	-----
Orchard	-----
Vineyard	----- VINEYARD

RAILROADS


Standard Gauge	-----
RR Signal Milepost	----- MILEPOST 35
Switch	----- SWITCH

REVISIONS

I:\172000\304945\Proj\Record Drawings\11\input_str.mxd
 11/17/2006 11:30 AM
 11/17/2006 11:30 AM


RECORD DRAWINGS

SPOIL MATERIAL FROM PREVIOUS CHANNEL EXCAVATION. PUSH SOIL AND VEGETATION INTO EXISTING CHANNEL AND COMPACT (TYP. BOTH SIDES).

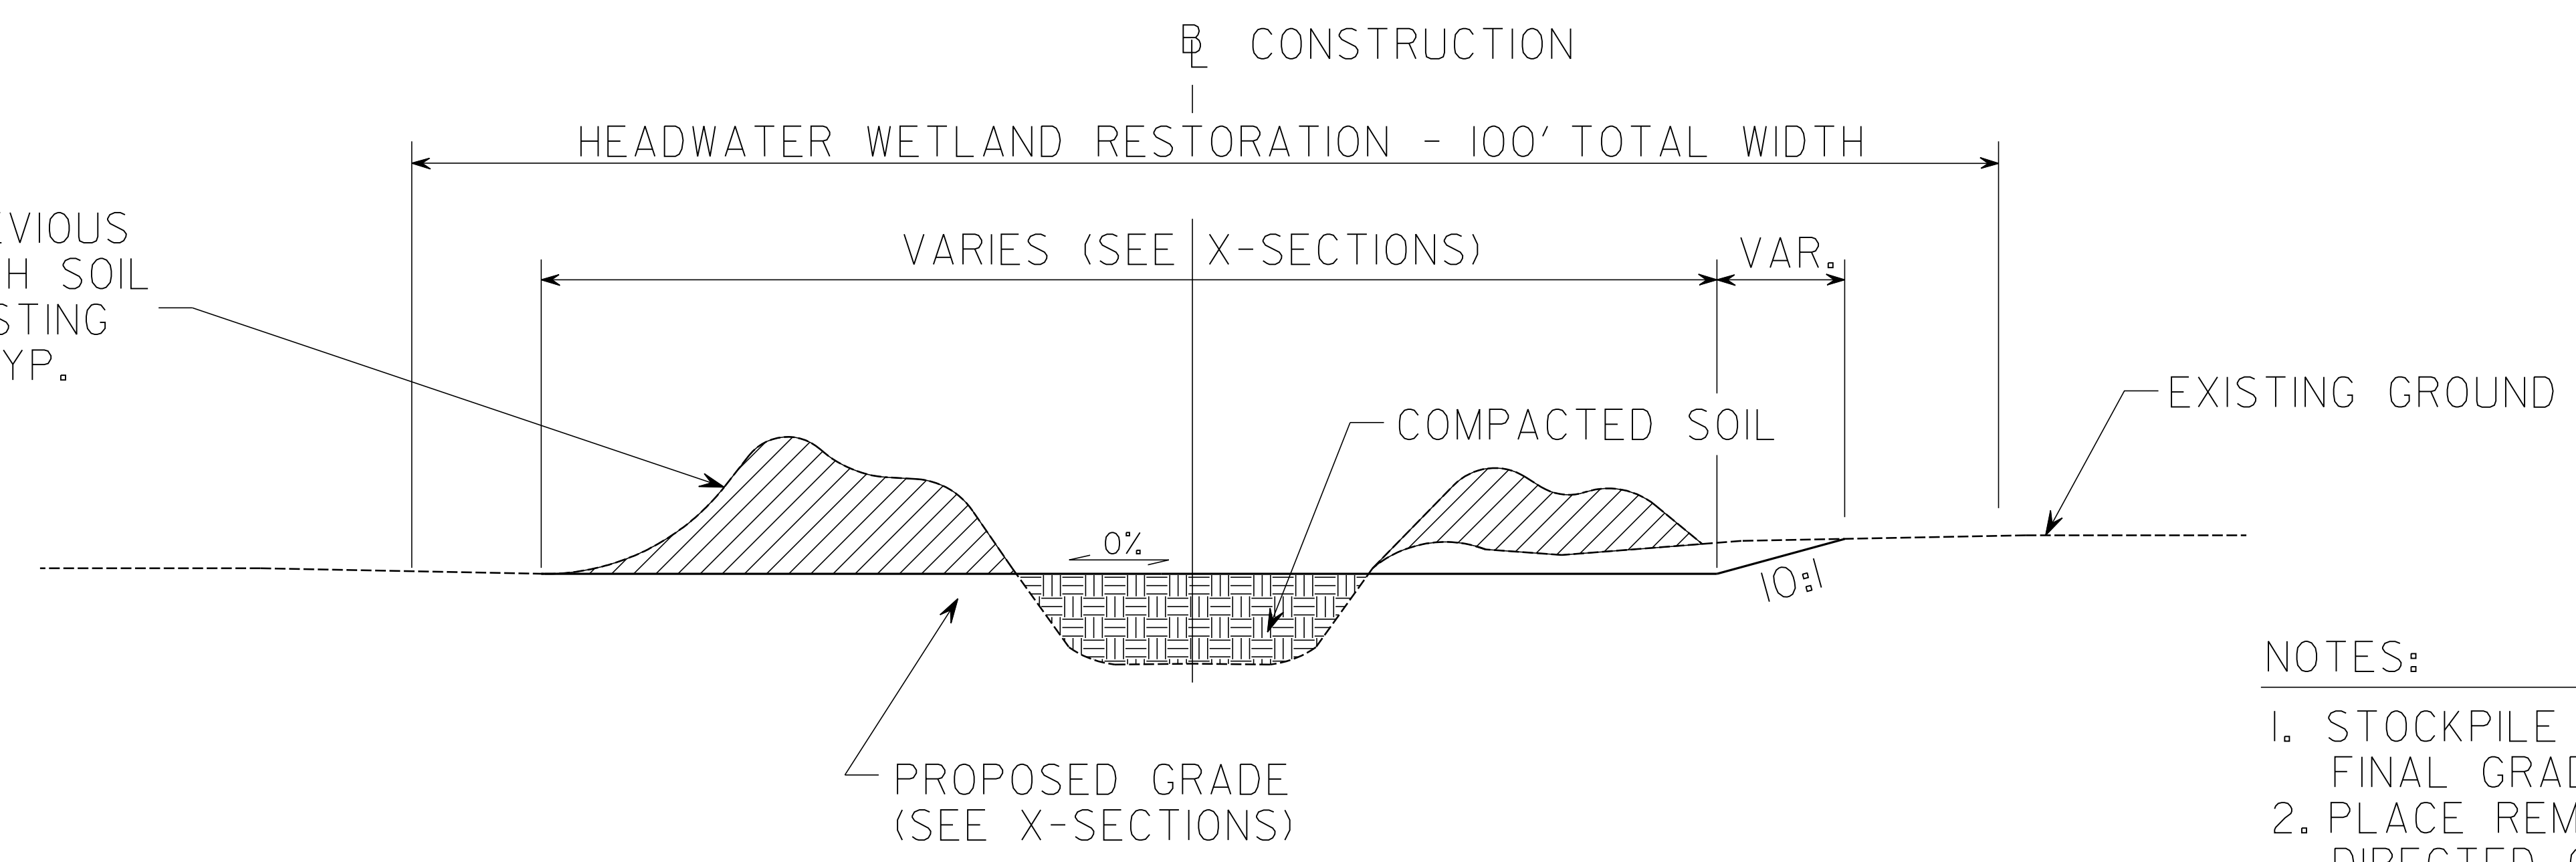

- NOTES:
1. STOCKPILE TOPSOIL FOR USE IN FINAL GRADING.
 2. PLACE REMOVED VEGETATION AS DIRECTED ON-SITE TO CREATE DEBRIS PILES. ALSO SEE PLAN.

TYPE 1 GRADING - LILLIPUT WETLAND RESTORATION TYPICAL SECTION
(Not to Scale)

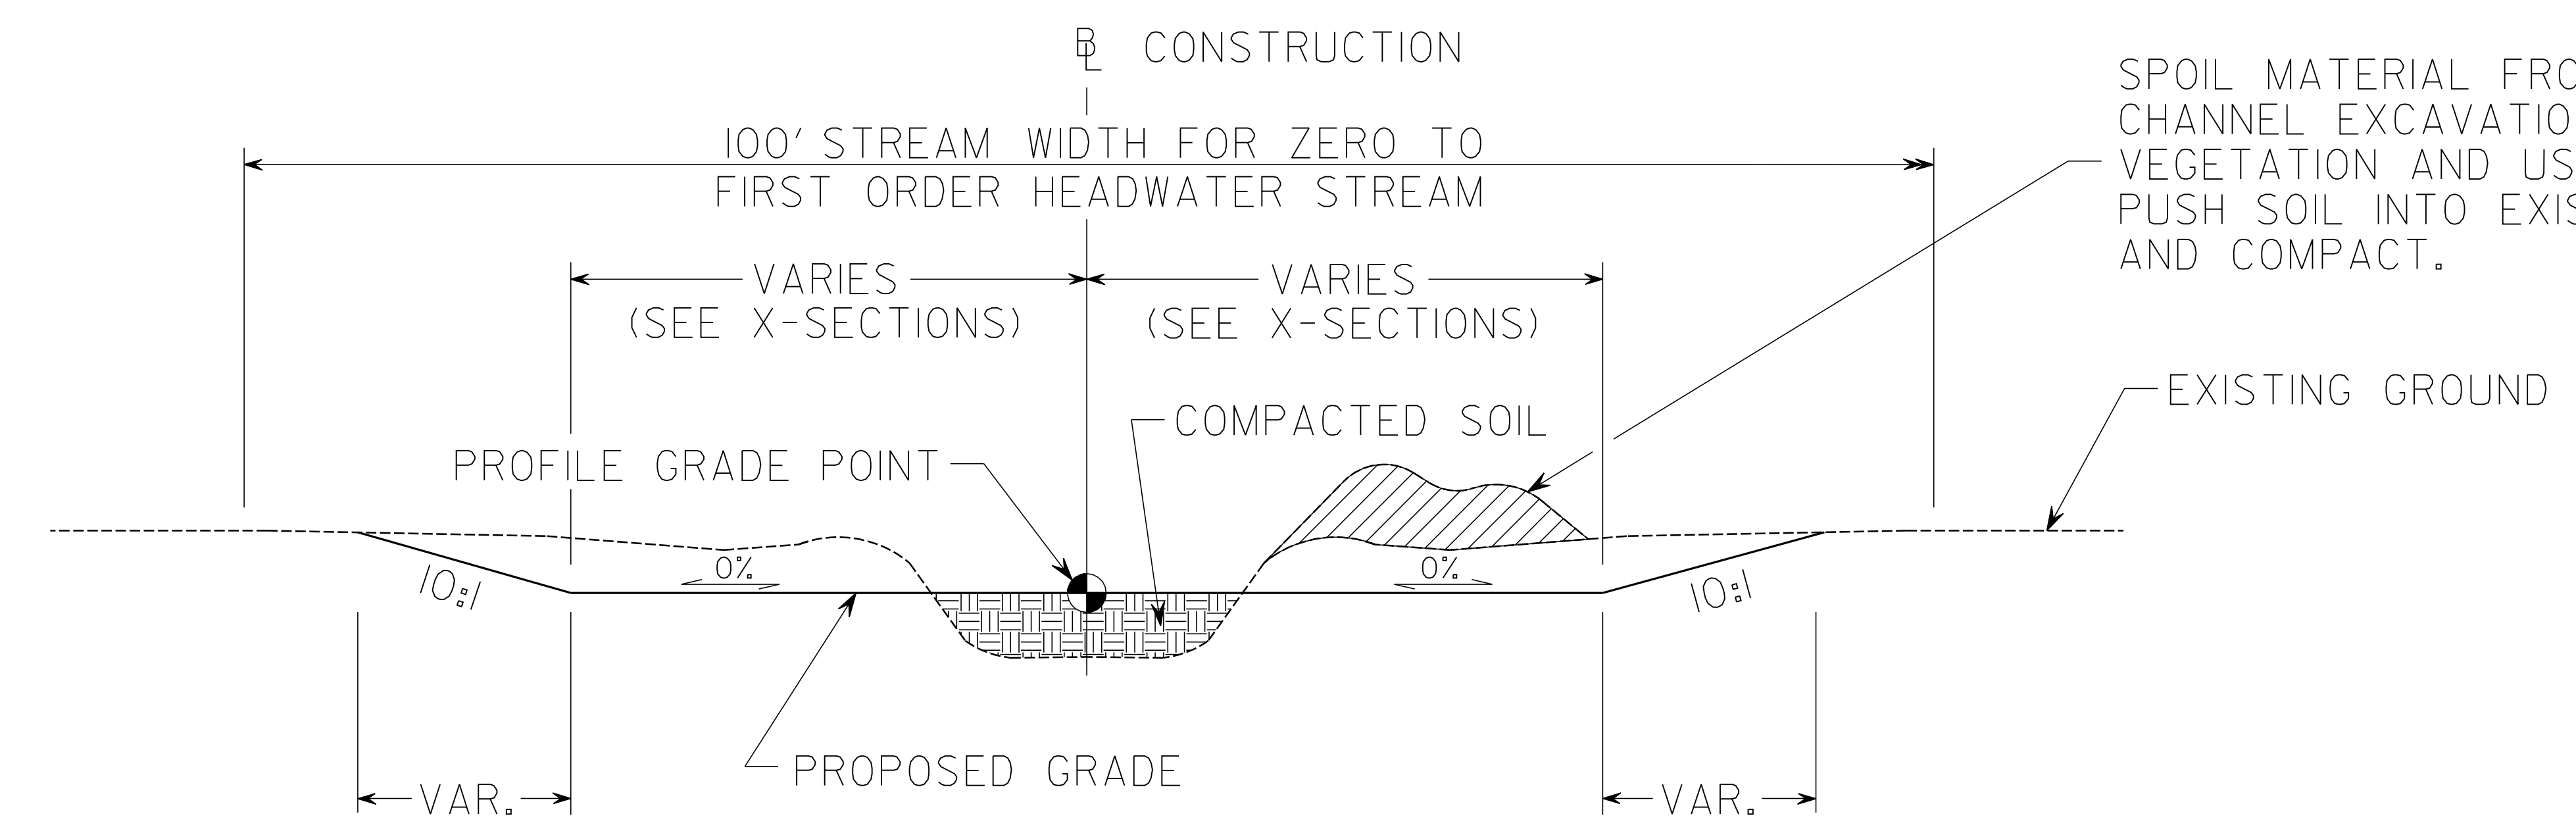

SPOIL MATERIAL FROM PREVIOUS CHANNEL EXCAVATION. SEPARATE VEGETATION AND USE AS DEBRIS PILES. PUSH SOIL INTO EXISTING CHANNEL AND COMPACT.


TYPE 2 GRADING - LILLIPUT STREAM RESTORATION TYPICAL SECTION
(Not to Scale)

REVISIONS


P:\172000
172000\05_304045\ProJ\Record Drawings\Lilliput_strm_1.up.dgn
8/17/20

PROJECT REFERENCE NO. D05053S	SHEET NO. 2A
R / W SHEET NO.	
HYDRAULICS ENGINEER NORTH CAROLINA PROFESSIONAL SEAL 25881 ENGINEER EDWARD T. WOODALL III	


RECORD DRAWINGS

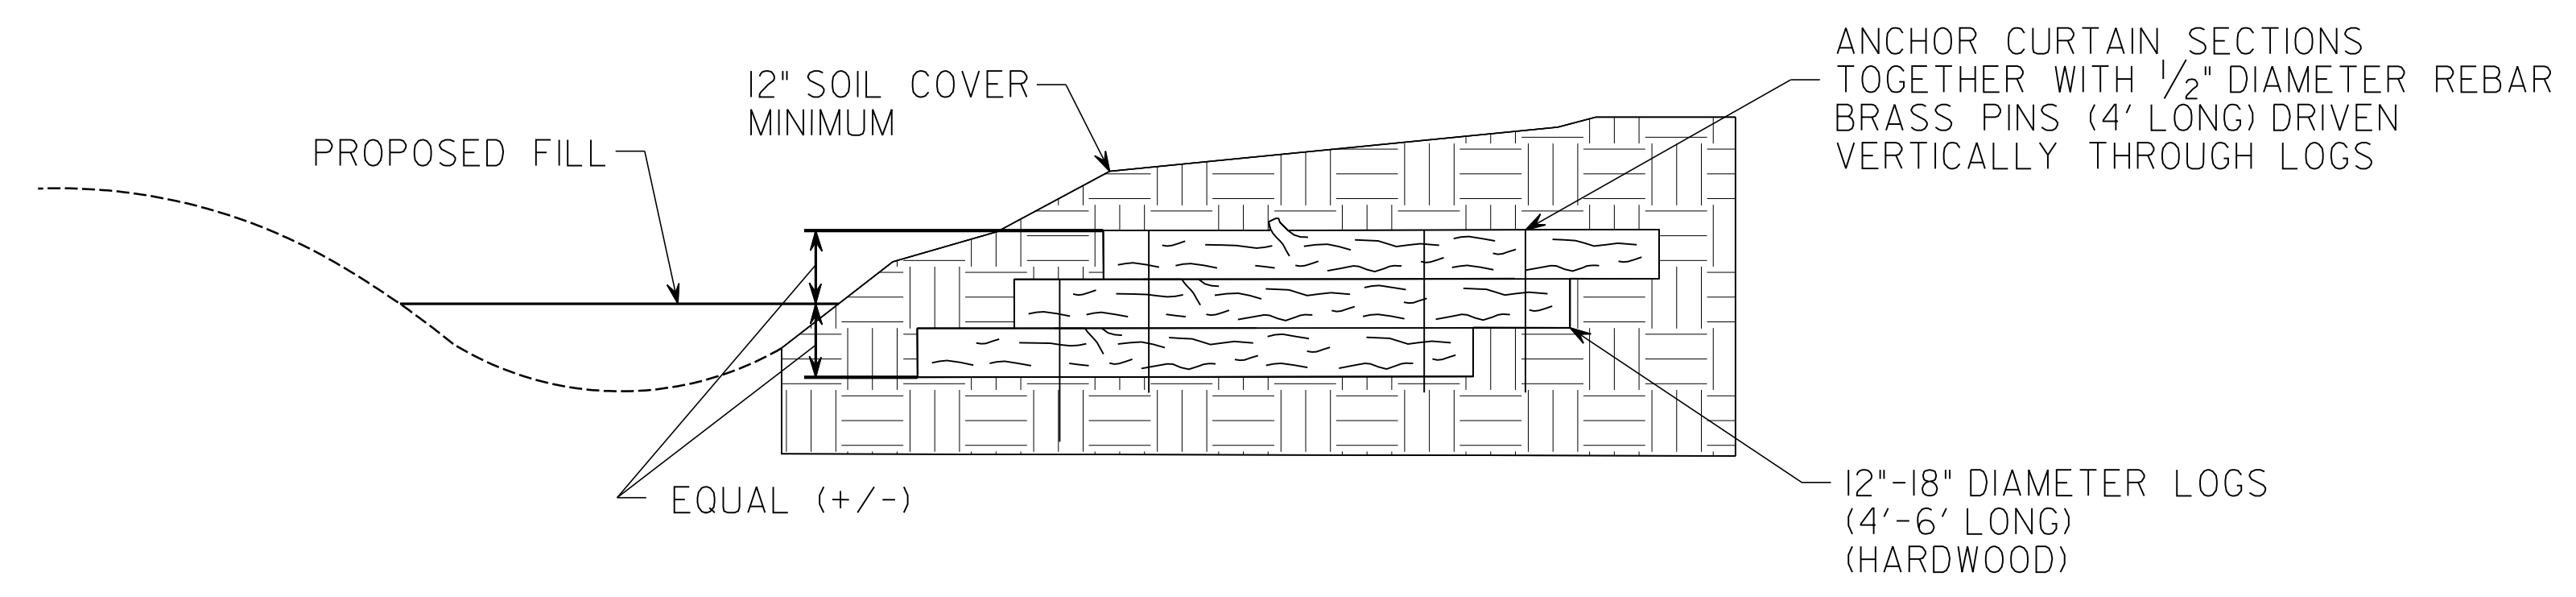

LOG CURTAIN
(Not to Scale)

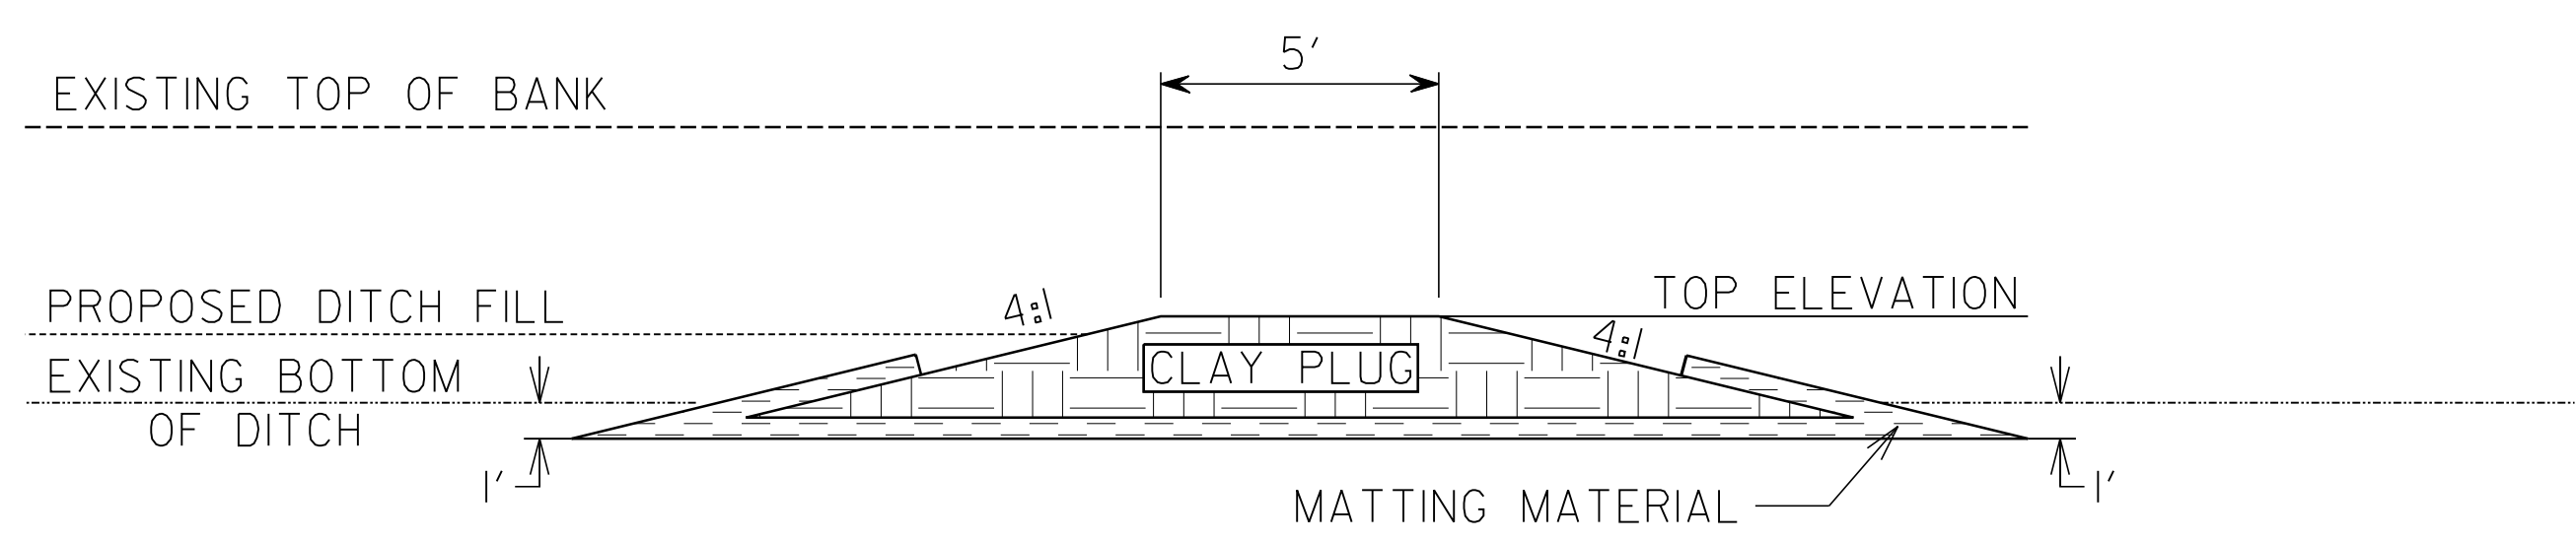

SECTION A-A

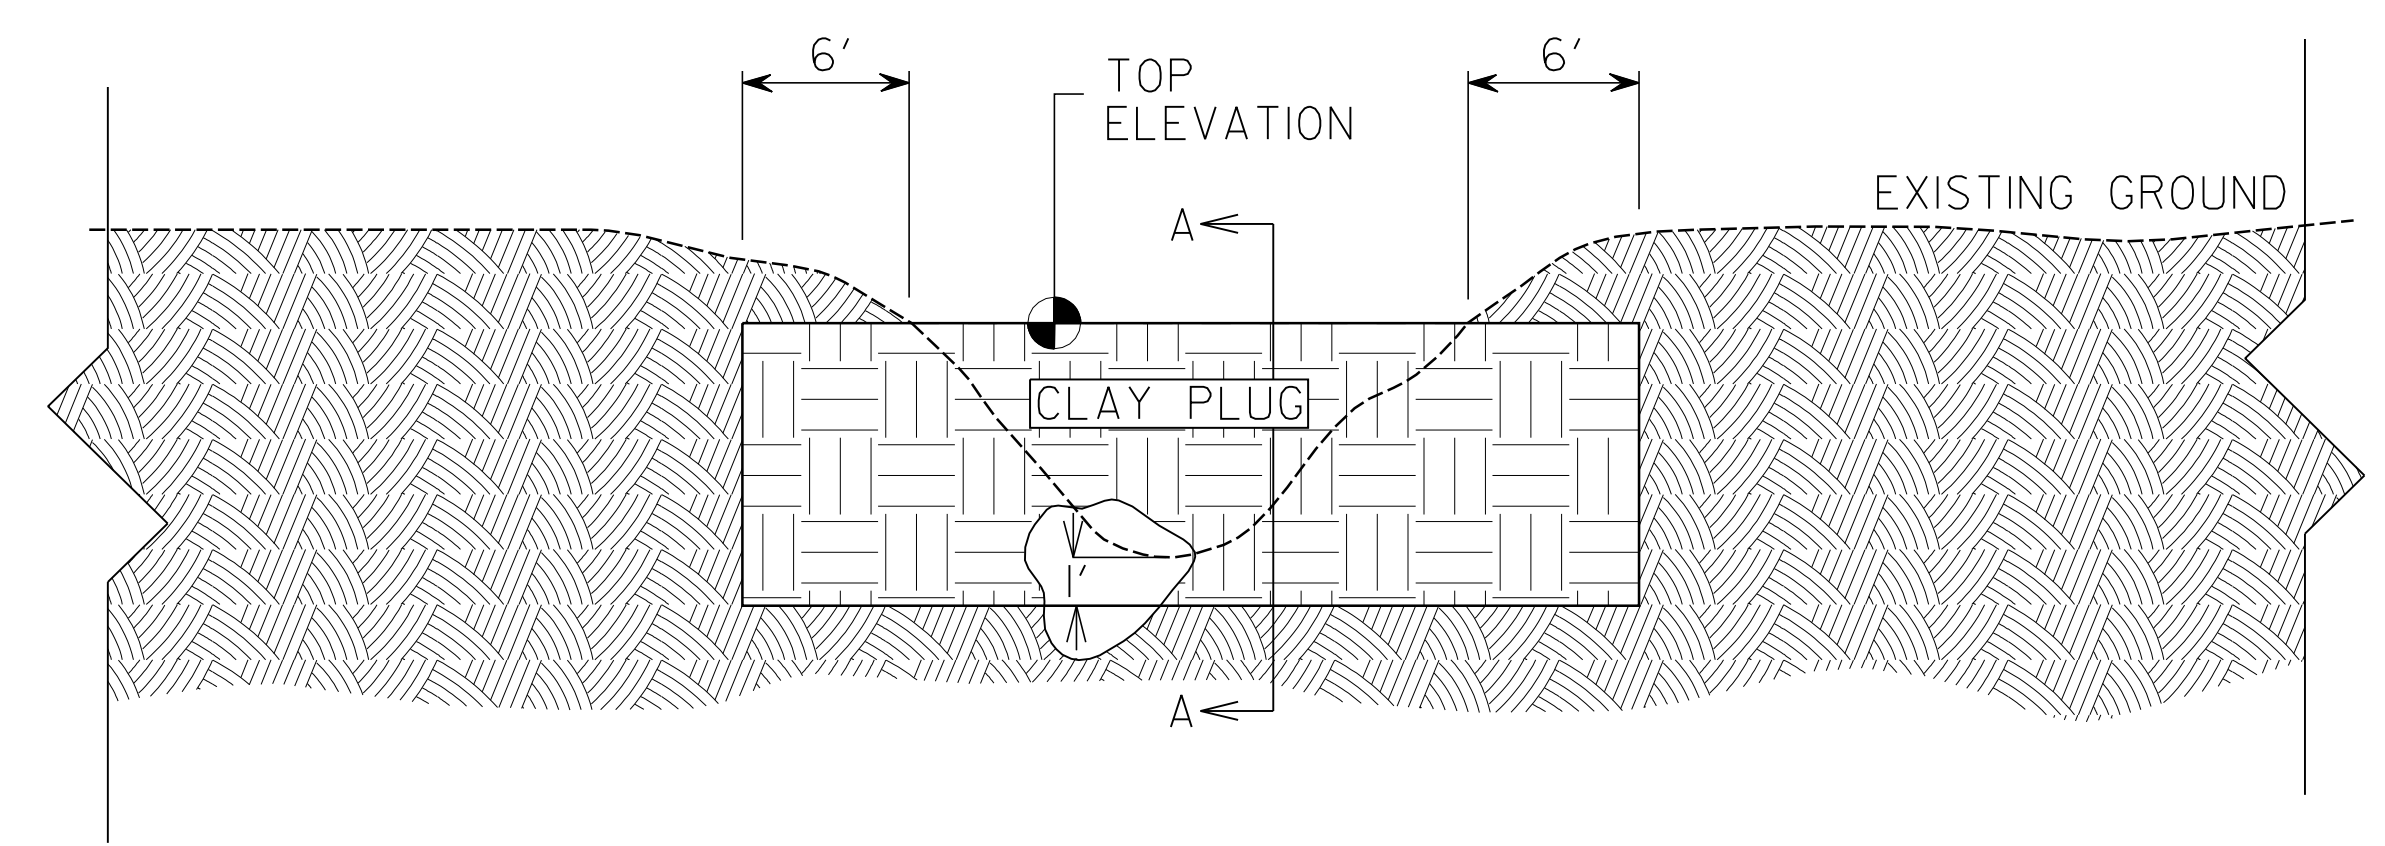


CROSS SECTION OF DITCH

DITCH PLUG
(Not to Scale)


REVISIONS

P:\17\2005\170605_304045\Proc\Record Drawings\111\out_strm_1.up.dgn
8/17/05


PLANS PREPARED BY :
RUMMEL KLEPPER & KAHL, LLP
consulting engineers
900 RIDGEFIELD DRIVE SUITE 350
RALEIGH, NORTH CAROLINA 27609-3960
NC LICENSE No. F-0112 (9/19) 878-9560
FOR
DENR-ECOSYSTEM ENHANCEMENT PROGRAM

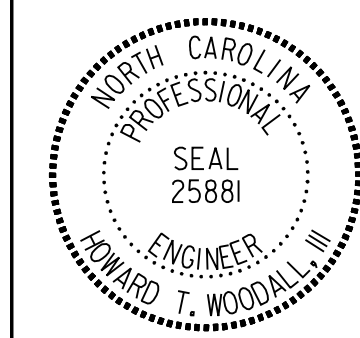PROJECT REFERENCE NO. D05053S	SHEET NO. 2B
R/W SHEET NO.	
HYDRAULICS ENGINEER	
	


RECORD DRAWINGS

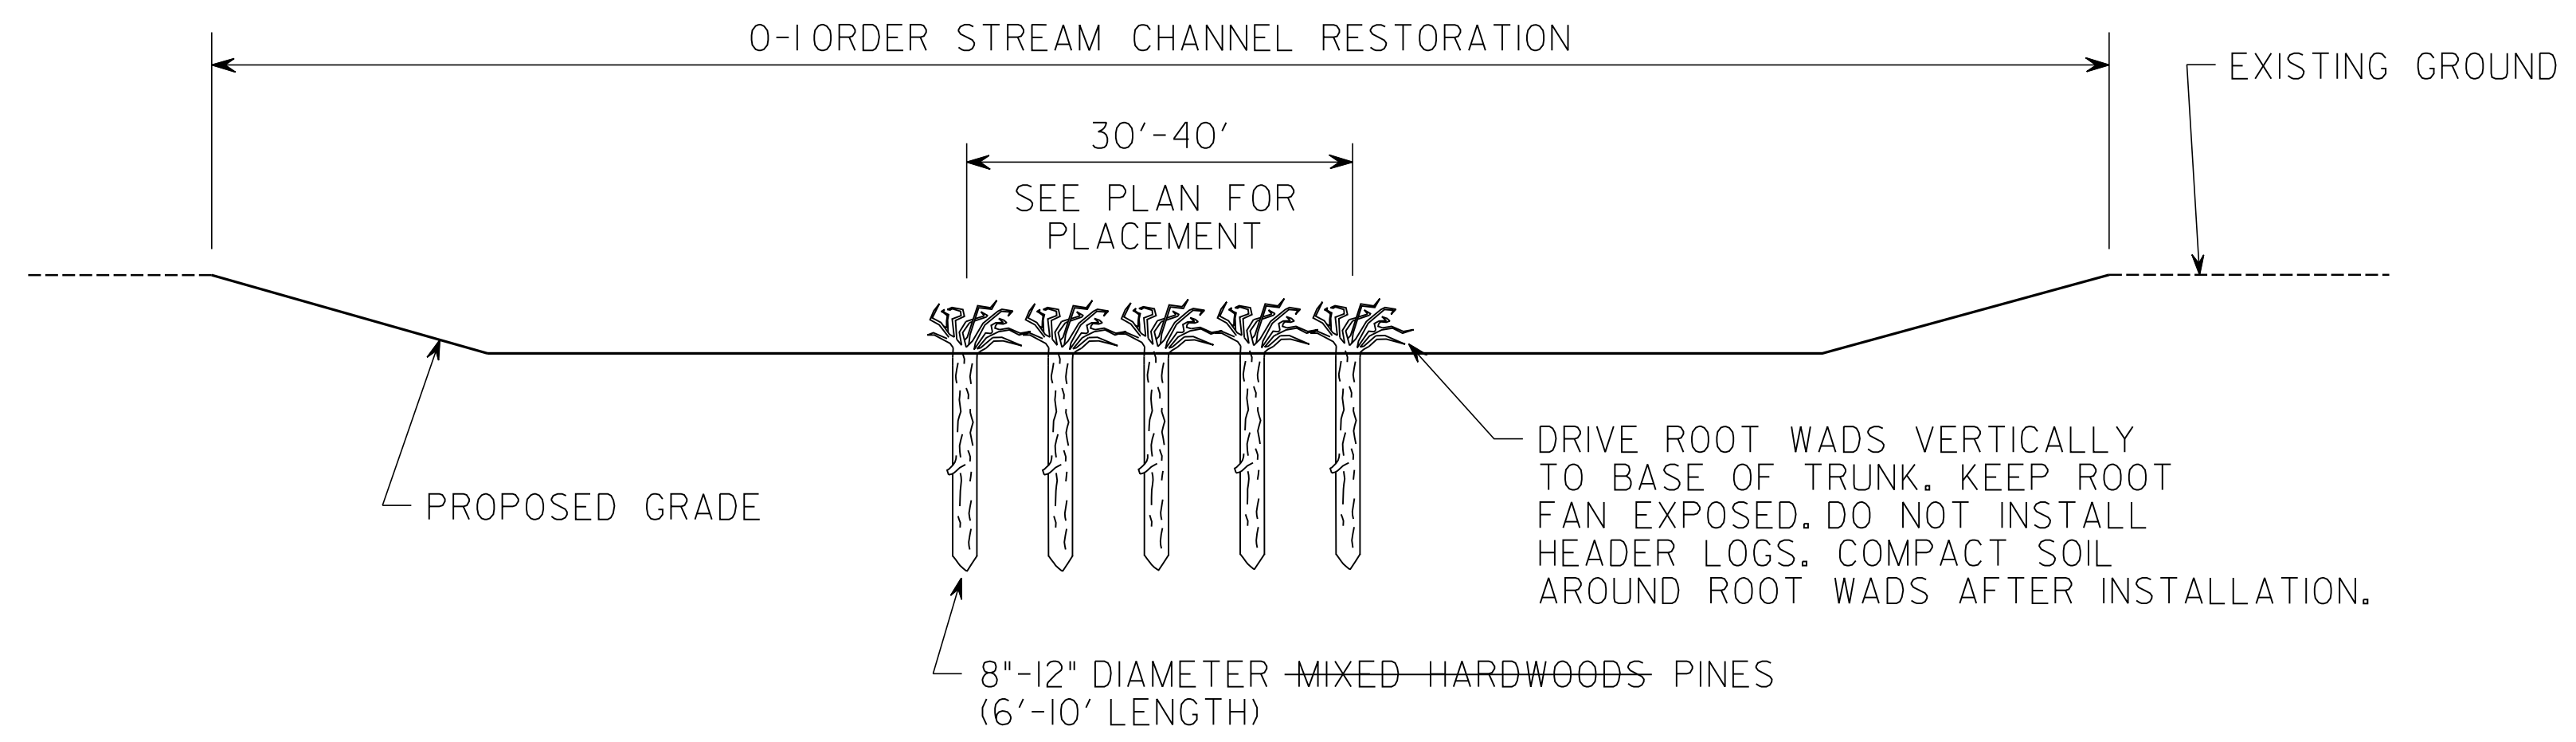

FLOW DISRUPTER
(Not to Scale)

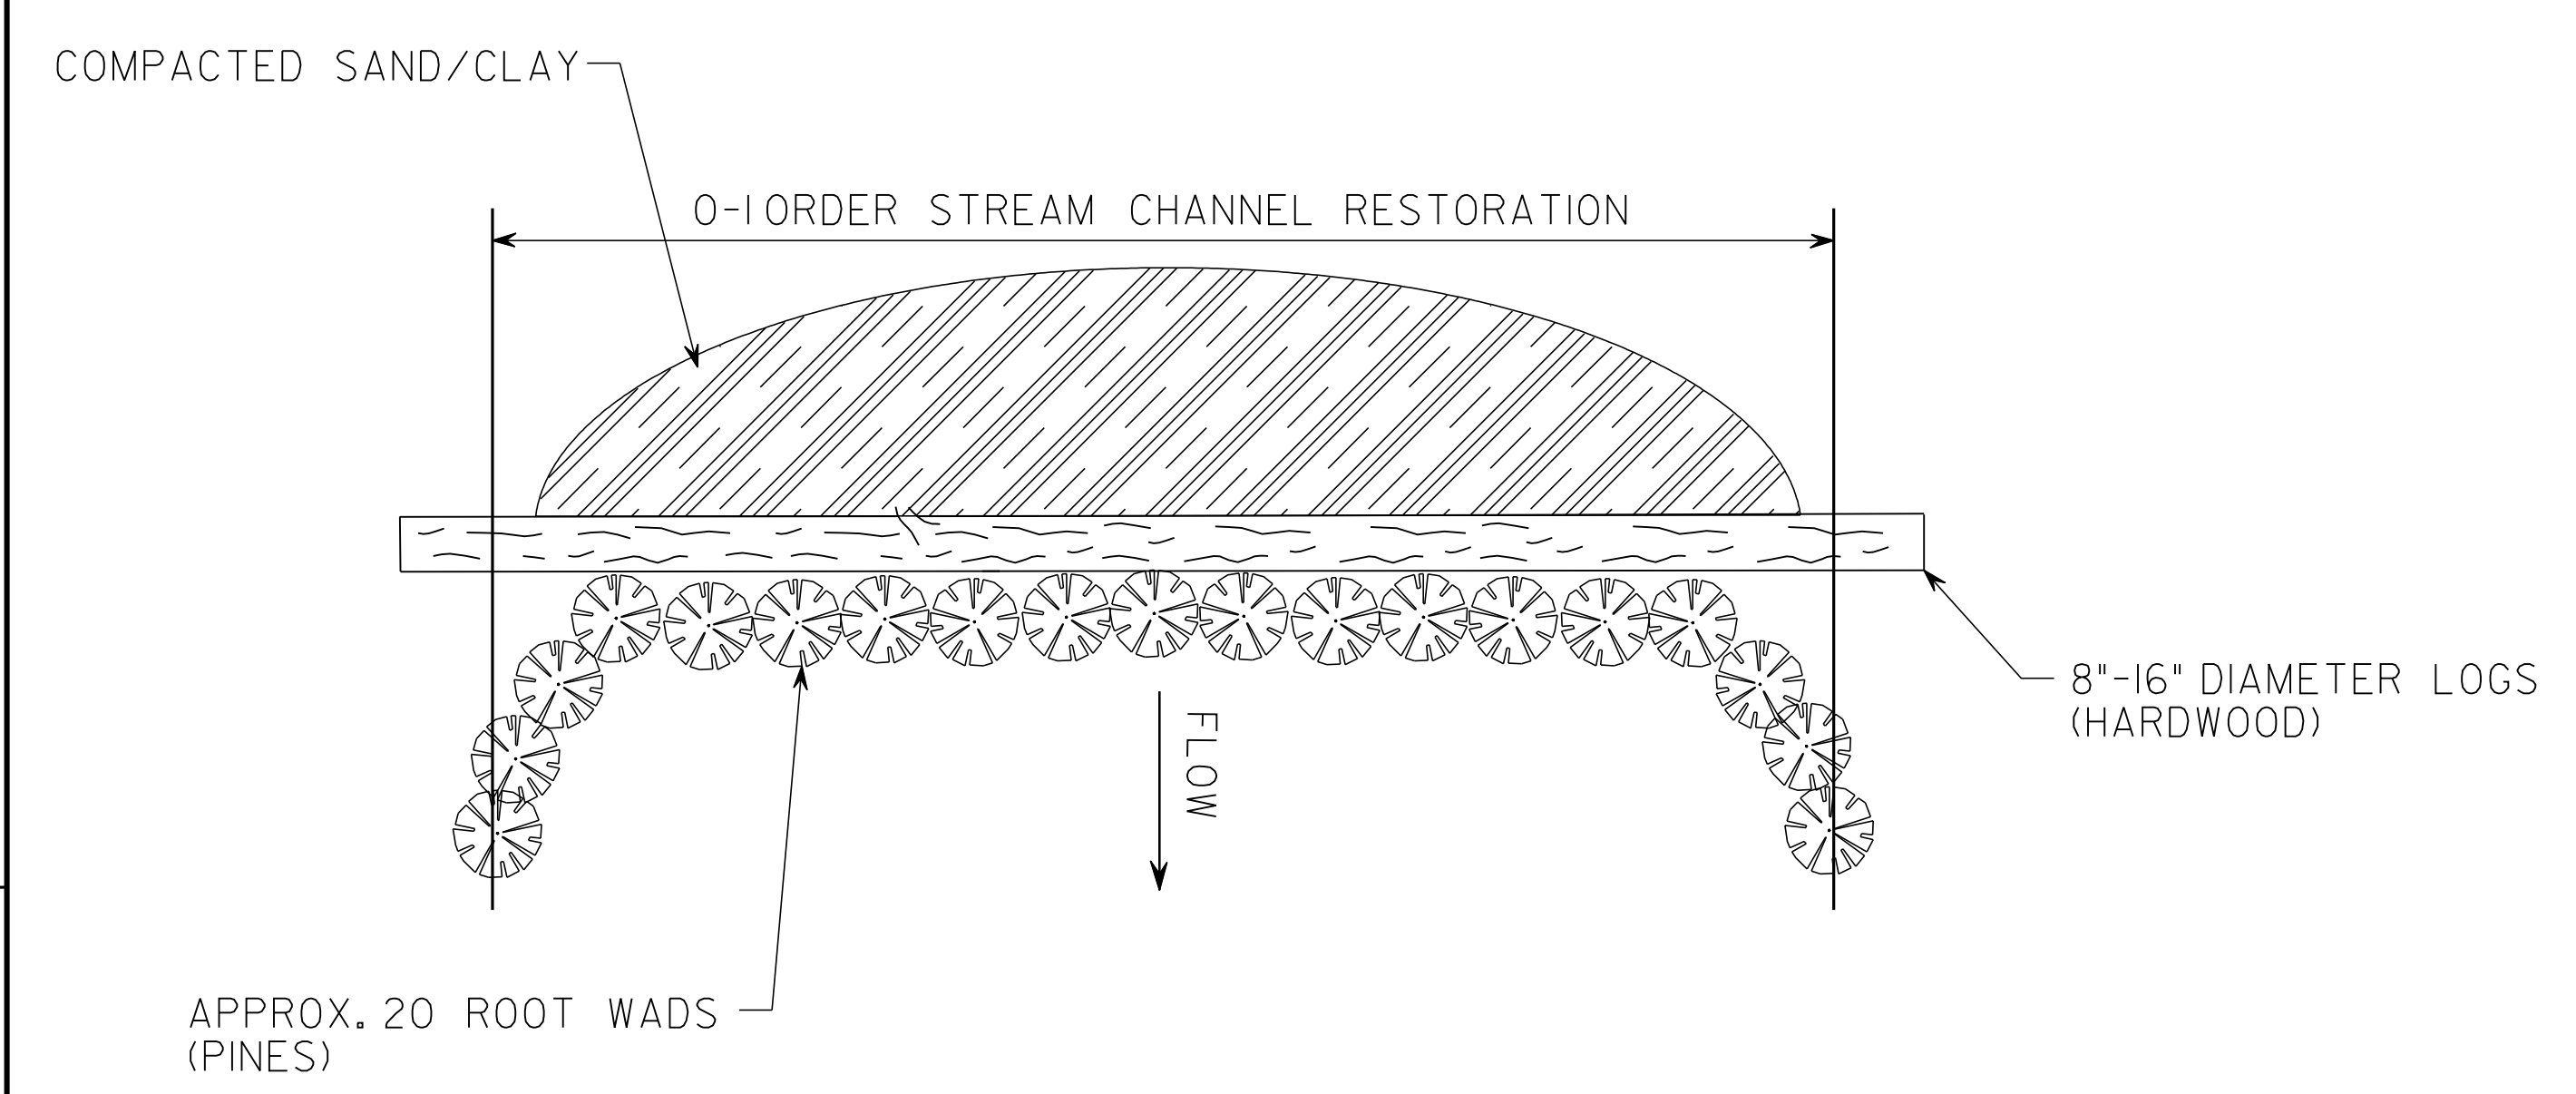


PLAN VIEW
(Not to Scale)

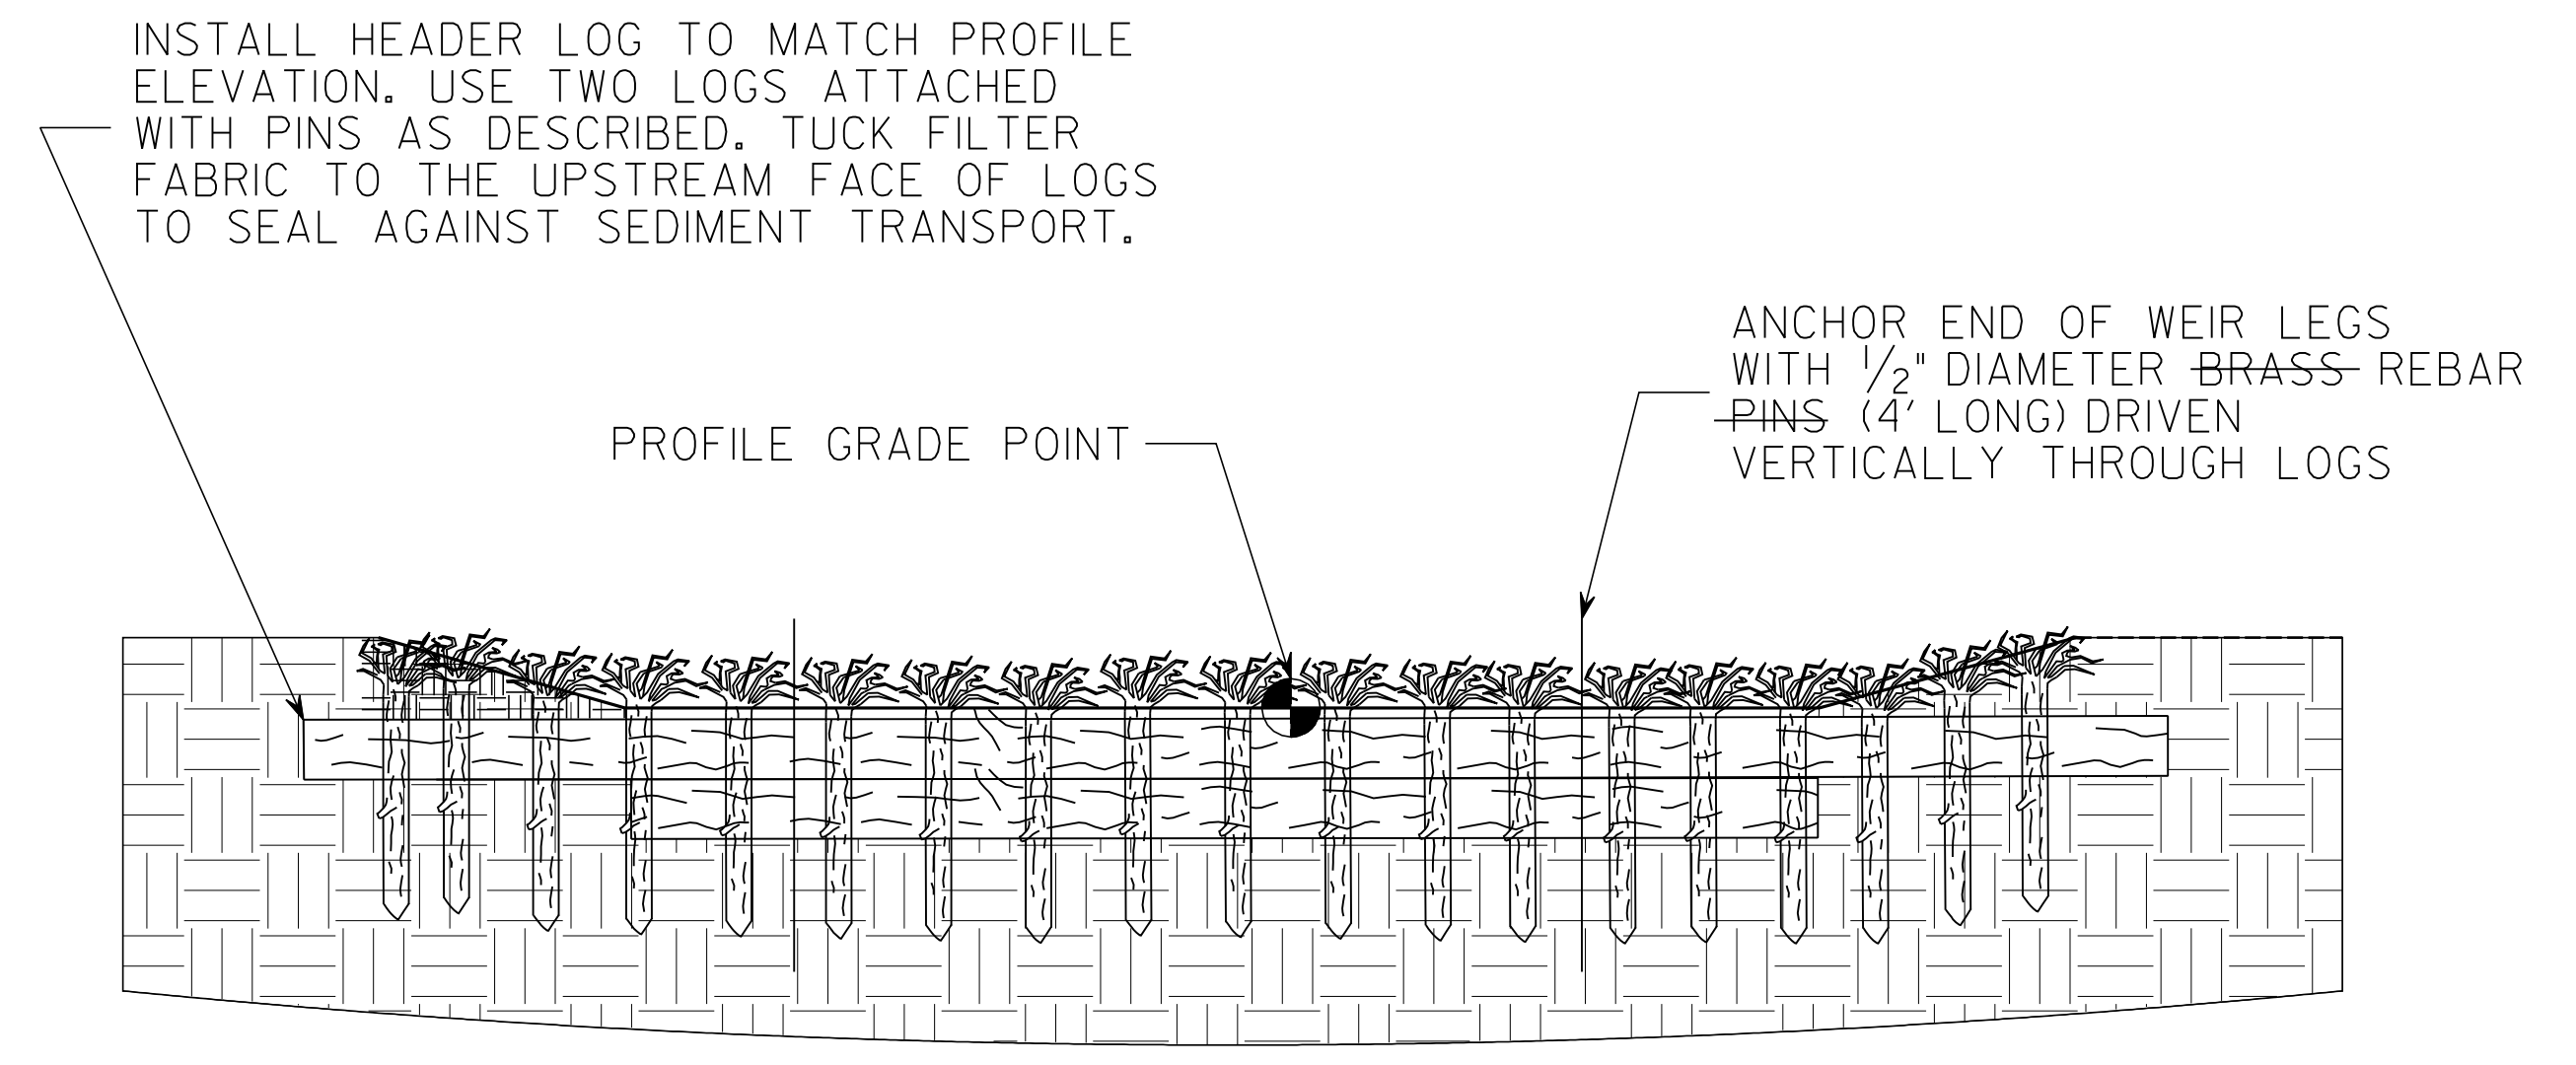

CROSS SECTION
(Not to Scale)

CONTROLLED STEP WEIR
(Not to Scale)


REVISIONS
 P:\17\2000\17-0006\05_304045\Proc\Record Drawings\11\11put.strm_ip.dgn
 8/17/20


PLANS PREPARED BY :
RUMMEL KLEPPER & KAHL, LLP
consulting engineers
 900 RIDGEFIELD DRIVE SUITE 350
 RALEIGH, NORTH CAROLINA 27609-3960
 NC LICENSE No. F-0112 (919) 878-9560
FOR
DENR-ECOSYSTEM ENHANCEMENT PROGRAM

PROJECT REFERENCE NO. D05053S	SHEET NO. 4
RW SHEET NO.	
HYDRAULICS ENGINEER NORTH CAROLINA PROFESSIONAL SEAL 25881 ENGINEER HOWARD T. WOODALL III	

RECORD DRAWINGS

PRECONSTRUCTION CONDITIONS

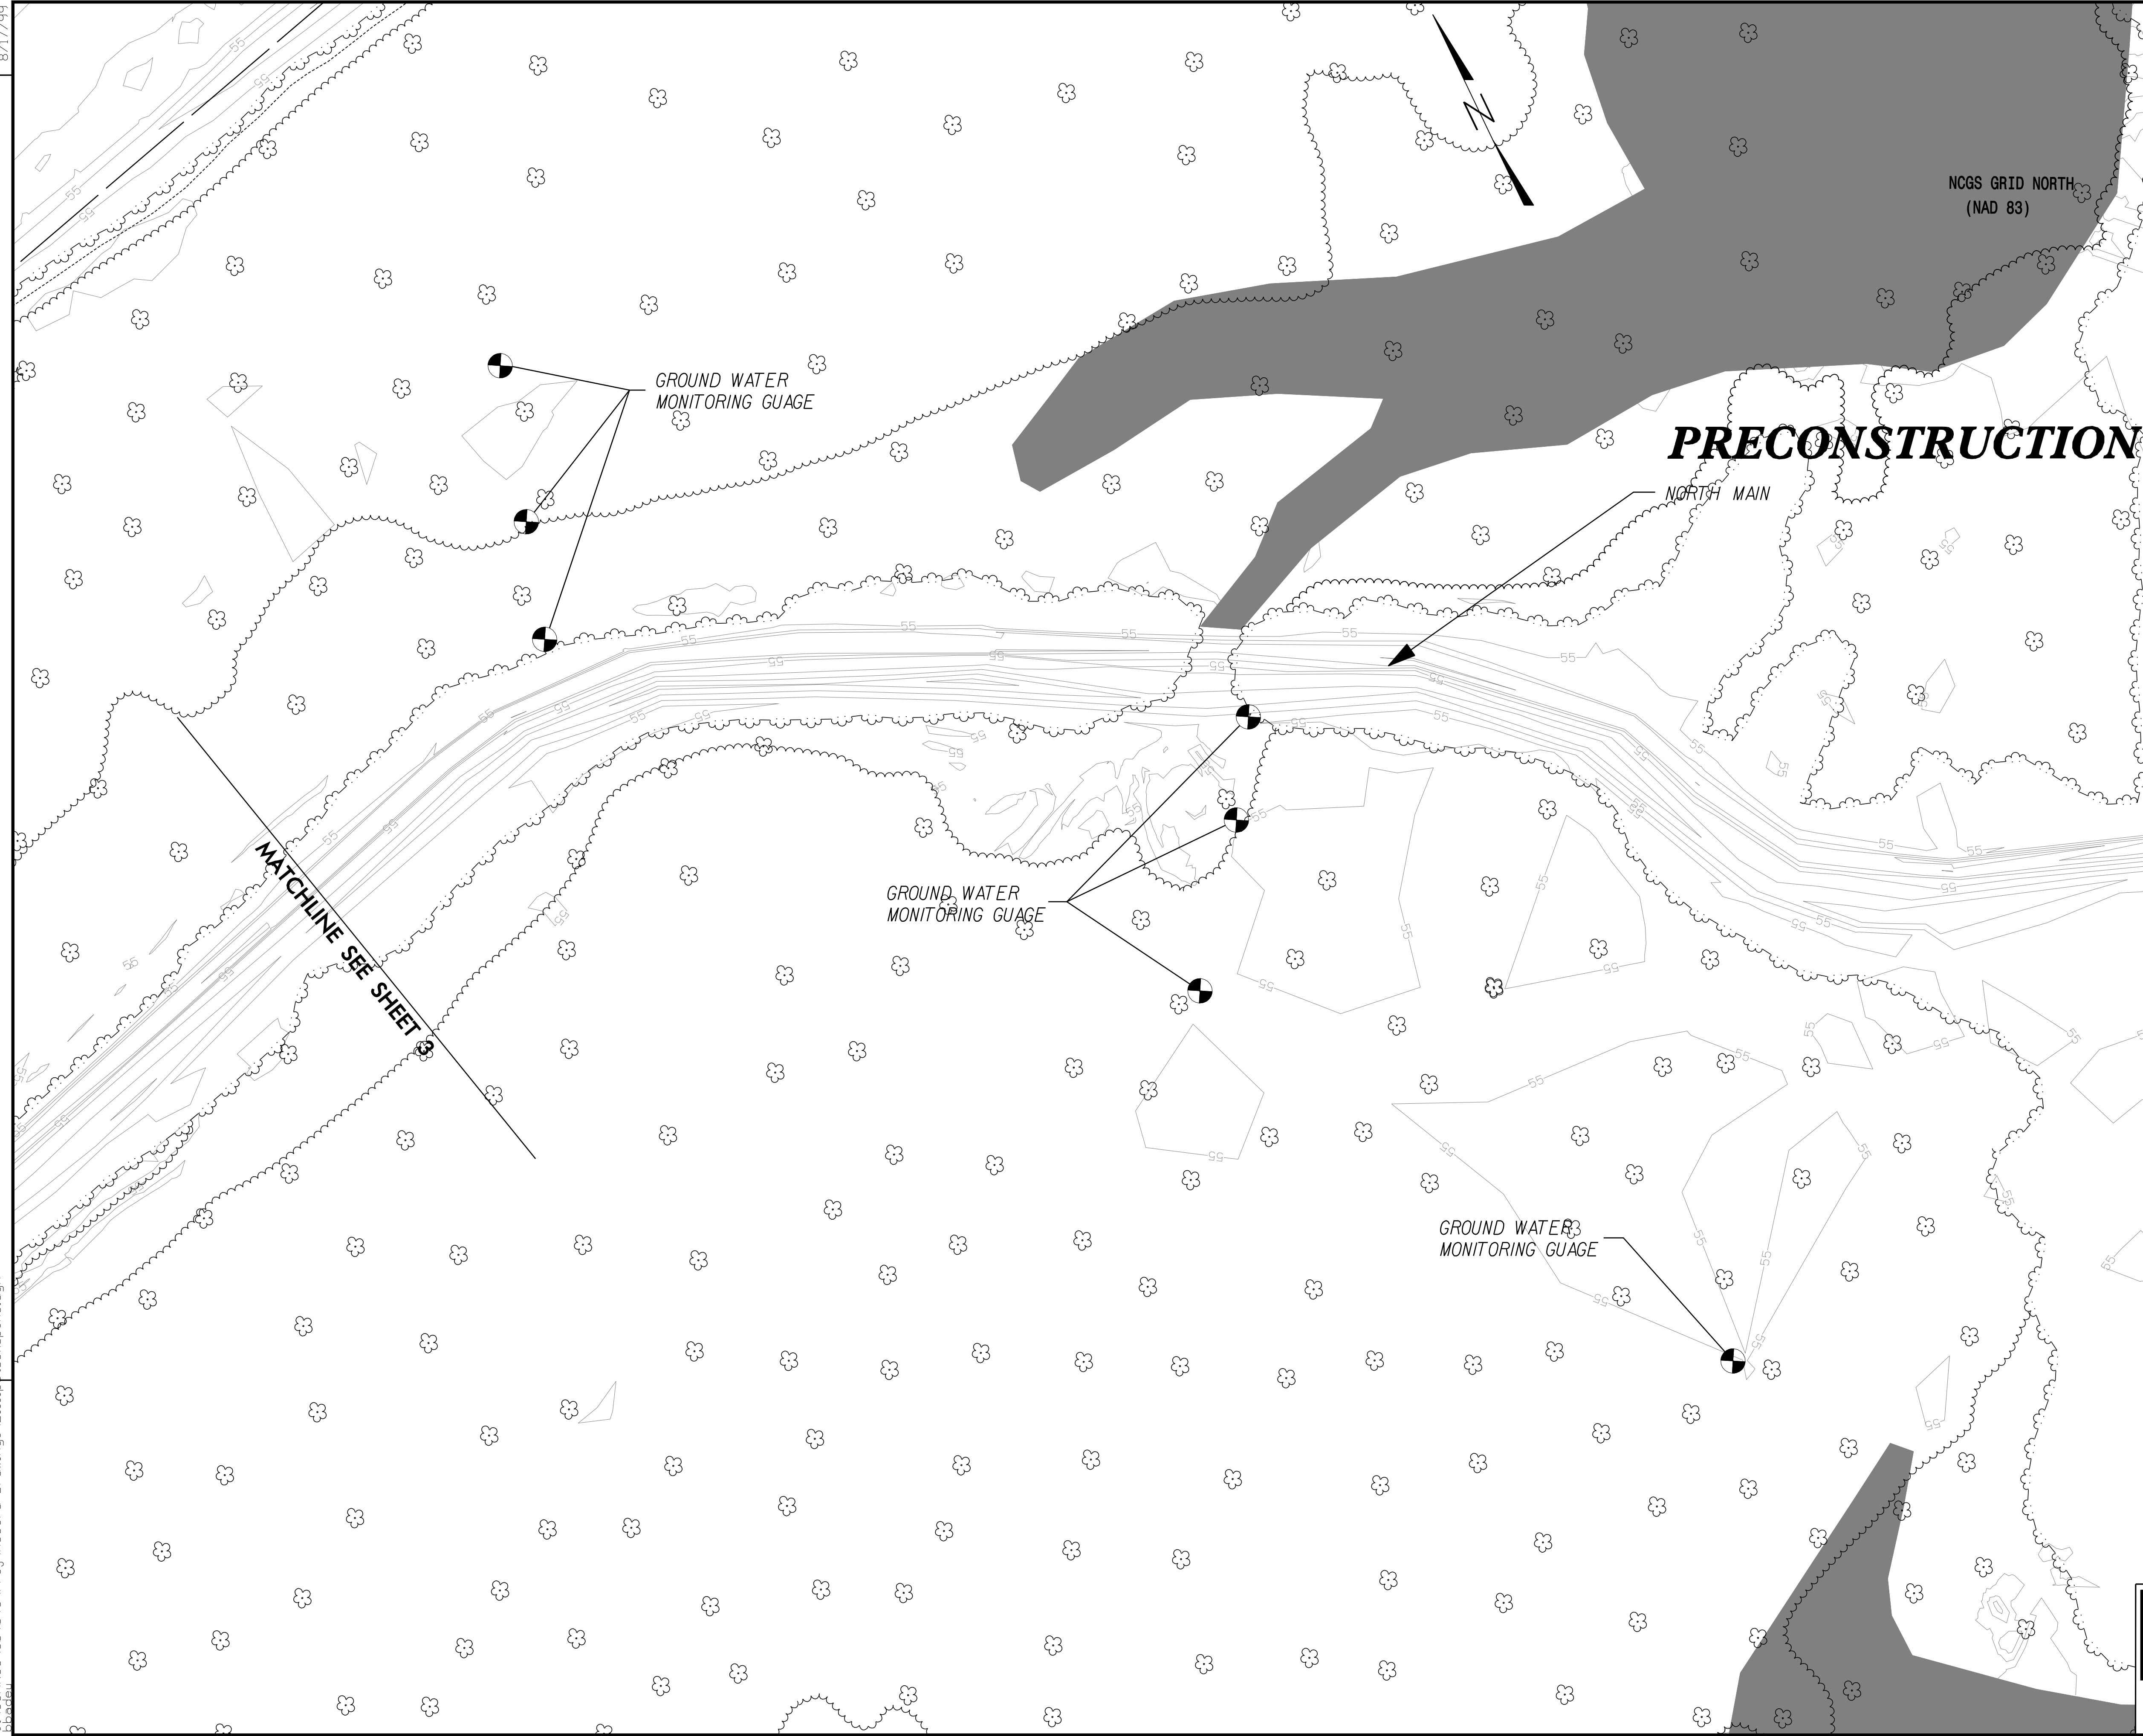

MATCHLINE SEE SHEET 3

GROUND WATER MONITORING GAUGE


GROUND WATER MONITORING GAUGE

GROUND WATER MONITORING GAUGE

NORTH MAIN

SR 1539 (BOILING SPRING RD.)

NGS GRID NORTH (NAD 83)

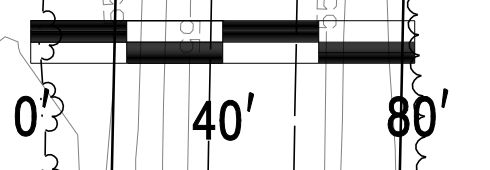

PLANS PREPARED BY :
RUMMEL KLEPPER & KAHL, LLP
consulting engineers
900 RIDGEFIELD DRIVE SUITE 350
RALEIGH, NORTH CAROLINA 27609-3960
NC LICENSE NO. F-0112 (919) 878-9560
FOR
DENR-ECOSYSTEM ENHANCEMENT PROGRAM

REVISIONS

8/17/99

\\C:\COMDS\304045\Proj\Record Drawings\Lilipit\ex_psh3.dgn
8/17/99


PROJECT REFERENCE NO. D05053S	SHEET NO. 5
RW SHEET NO.	
HYDRAULICS ENGINEER	
NORTH CAROLINA PROFESSIONAL SEAL 25881	
ENGINEER HOWARD T. WOODALL III	

RECORD DRAWINGS

PRECONSTRUCTION CONDITIONS

NCGS GRID NORTH (NAD 83)

MATCHLINE SEE SHEET 6

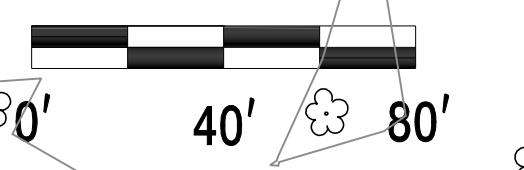


PLANS PREPARED BY :
RUMMEL KLEPPER & KAHL, LLP
consulting engineers
 900 RIDGEFIELD DRIVE SUITE 350
 RALEIGH, NORTH CAROLINA 27609-3960
 NC LICENSE NO. F-0112 (919) 878-9560
 FOR
DENR-ECOSYSTEM ENHANCEMENT PROGRAM

REVISIONS

8/17/99


\\COMINDS\304045\Proj\Record Drawings\Lilipit\ex_psh4.dgn

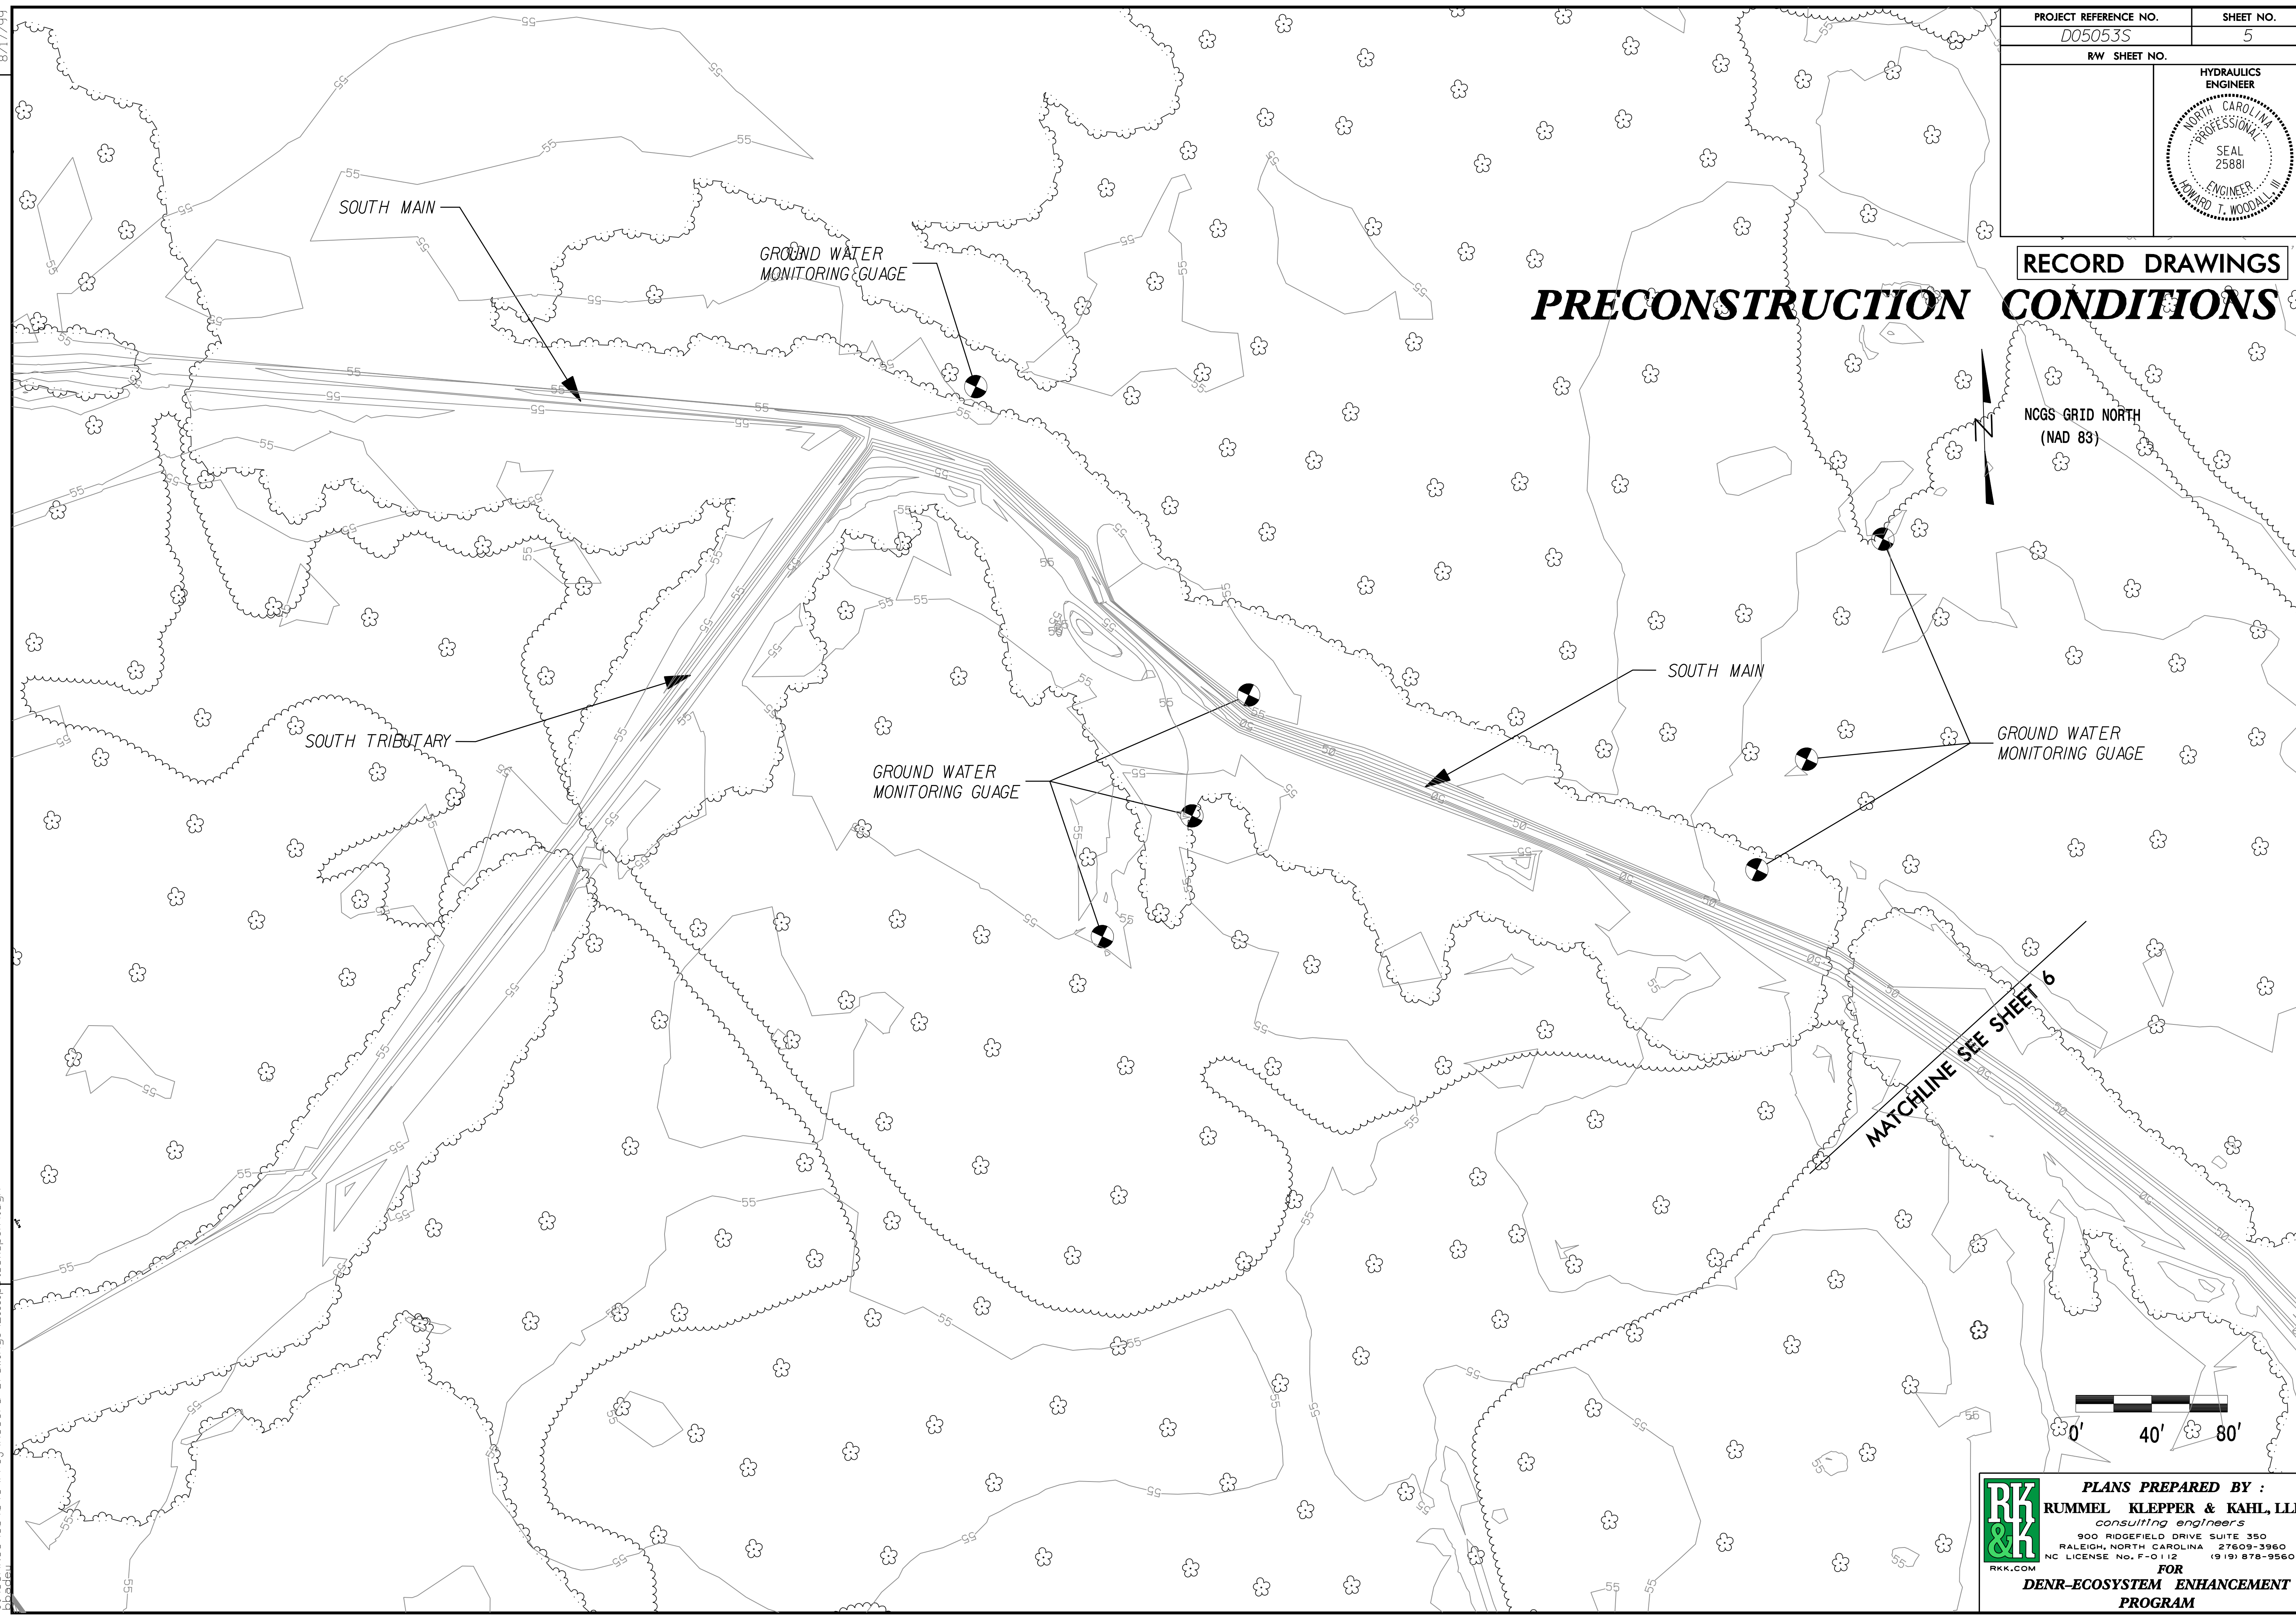


PROJECT REFERENCE NO. D05053S	SHEET NO. 6
RW SHEET NO.	
HYDRAULICS ENGINEER NORTH CAROLINA PROFESSIONAL SEAL 25681 ENGINEER HOWARD T. WOODALL III	

RECORD DRAWINGS

PRECONSTRUCTION CONDITIONS

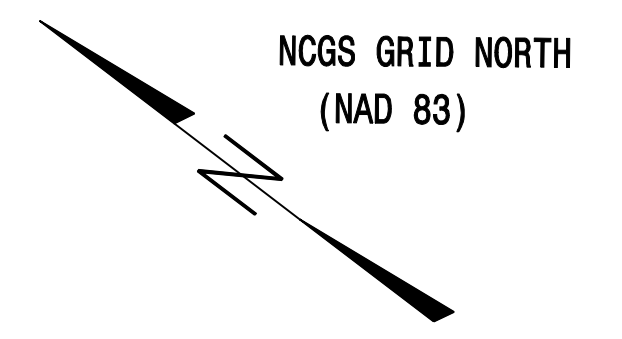

NCGS GRID NORTH
(NAD 83)

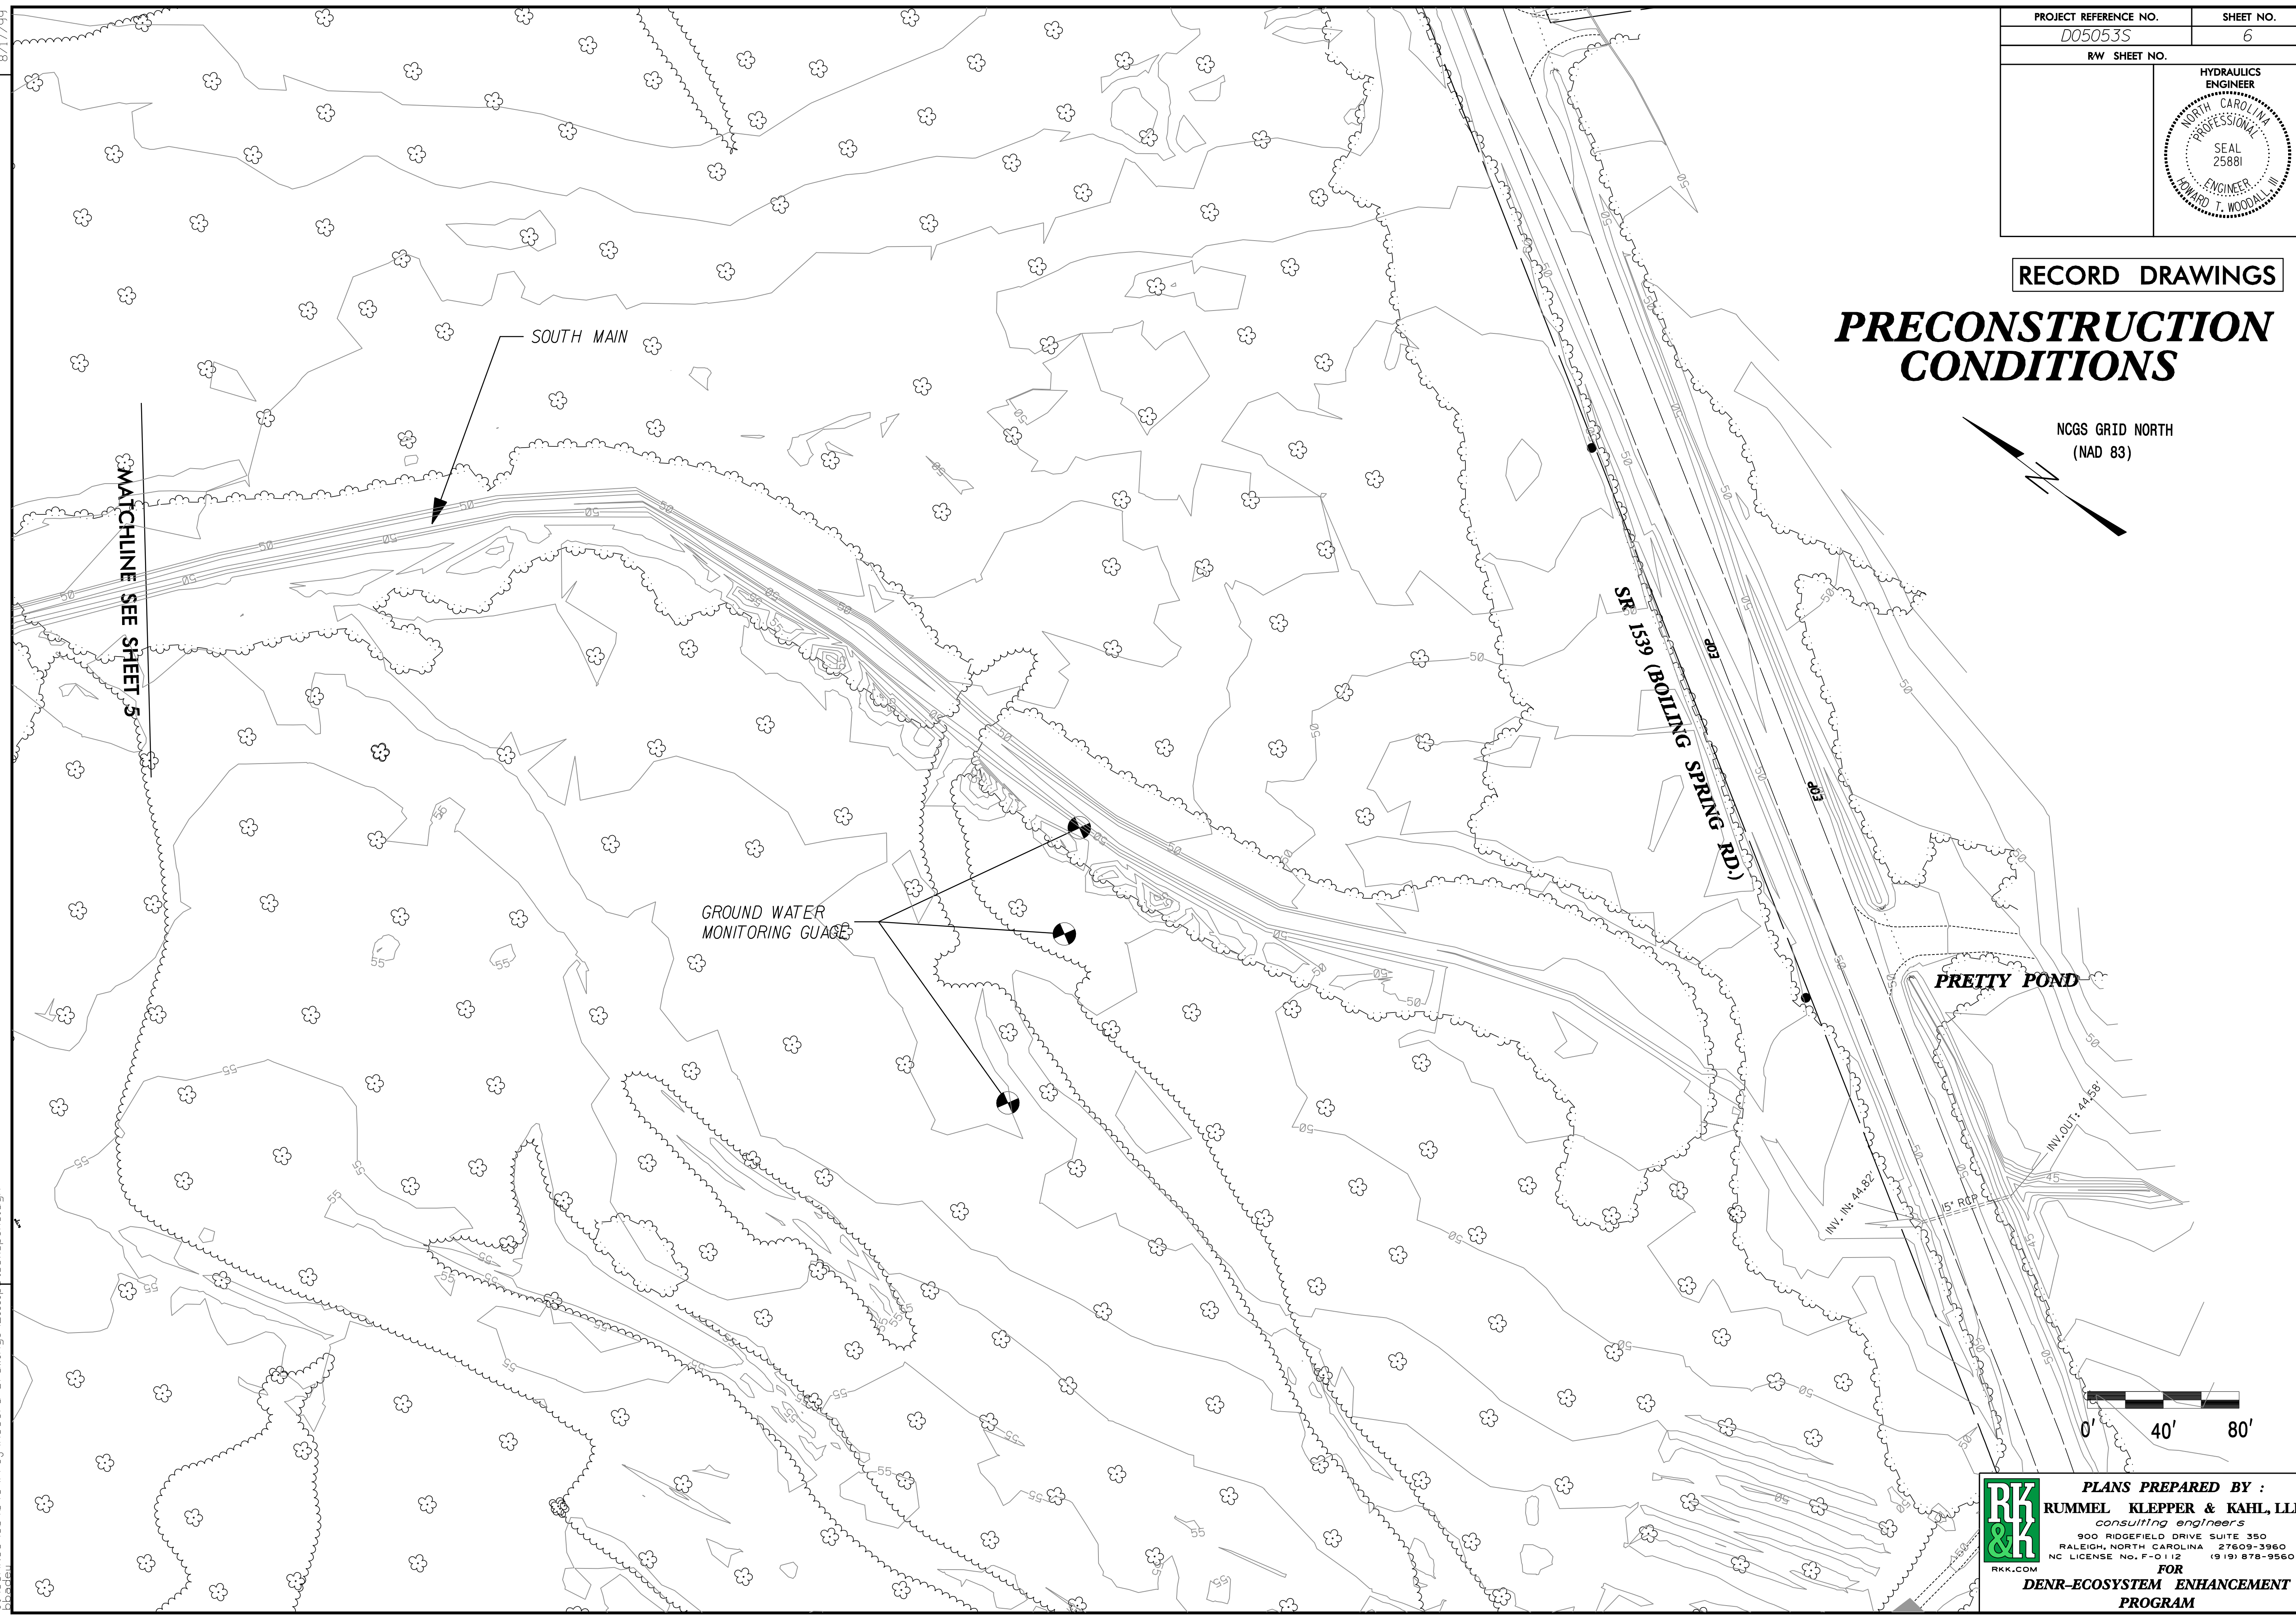


MATCHLINE SEE SHEET 5

GROUND WATER
MONITORING GAUGE

PRETTY POND

SR 1539 (BOILING SPRING RD.)

SOUTH MAIN

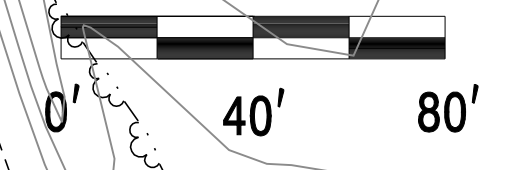

PLANS PREPARED BY :
RUMMEL KLEPPER & KAHL, LLP
consulting engineers
900 RIDGEFIELD DRIVE SUITE 350
RALEIGH, NORTH CAROLINA 27609-3960
NC LICENSE No. F-0112 (919) 878-9560
FOR
DENR-ECOSYSTEM ENHANCEMENT
PROGRAM




REVISIONS

8/17/99

C:\COMDS\304045\Proj\Record Drawings\Lilipit\ex_psh5.dgn


WETLAND ENHANCEMENT AND RESTORATION OVERVIEW

RECORD DRAWINGS

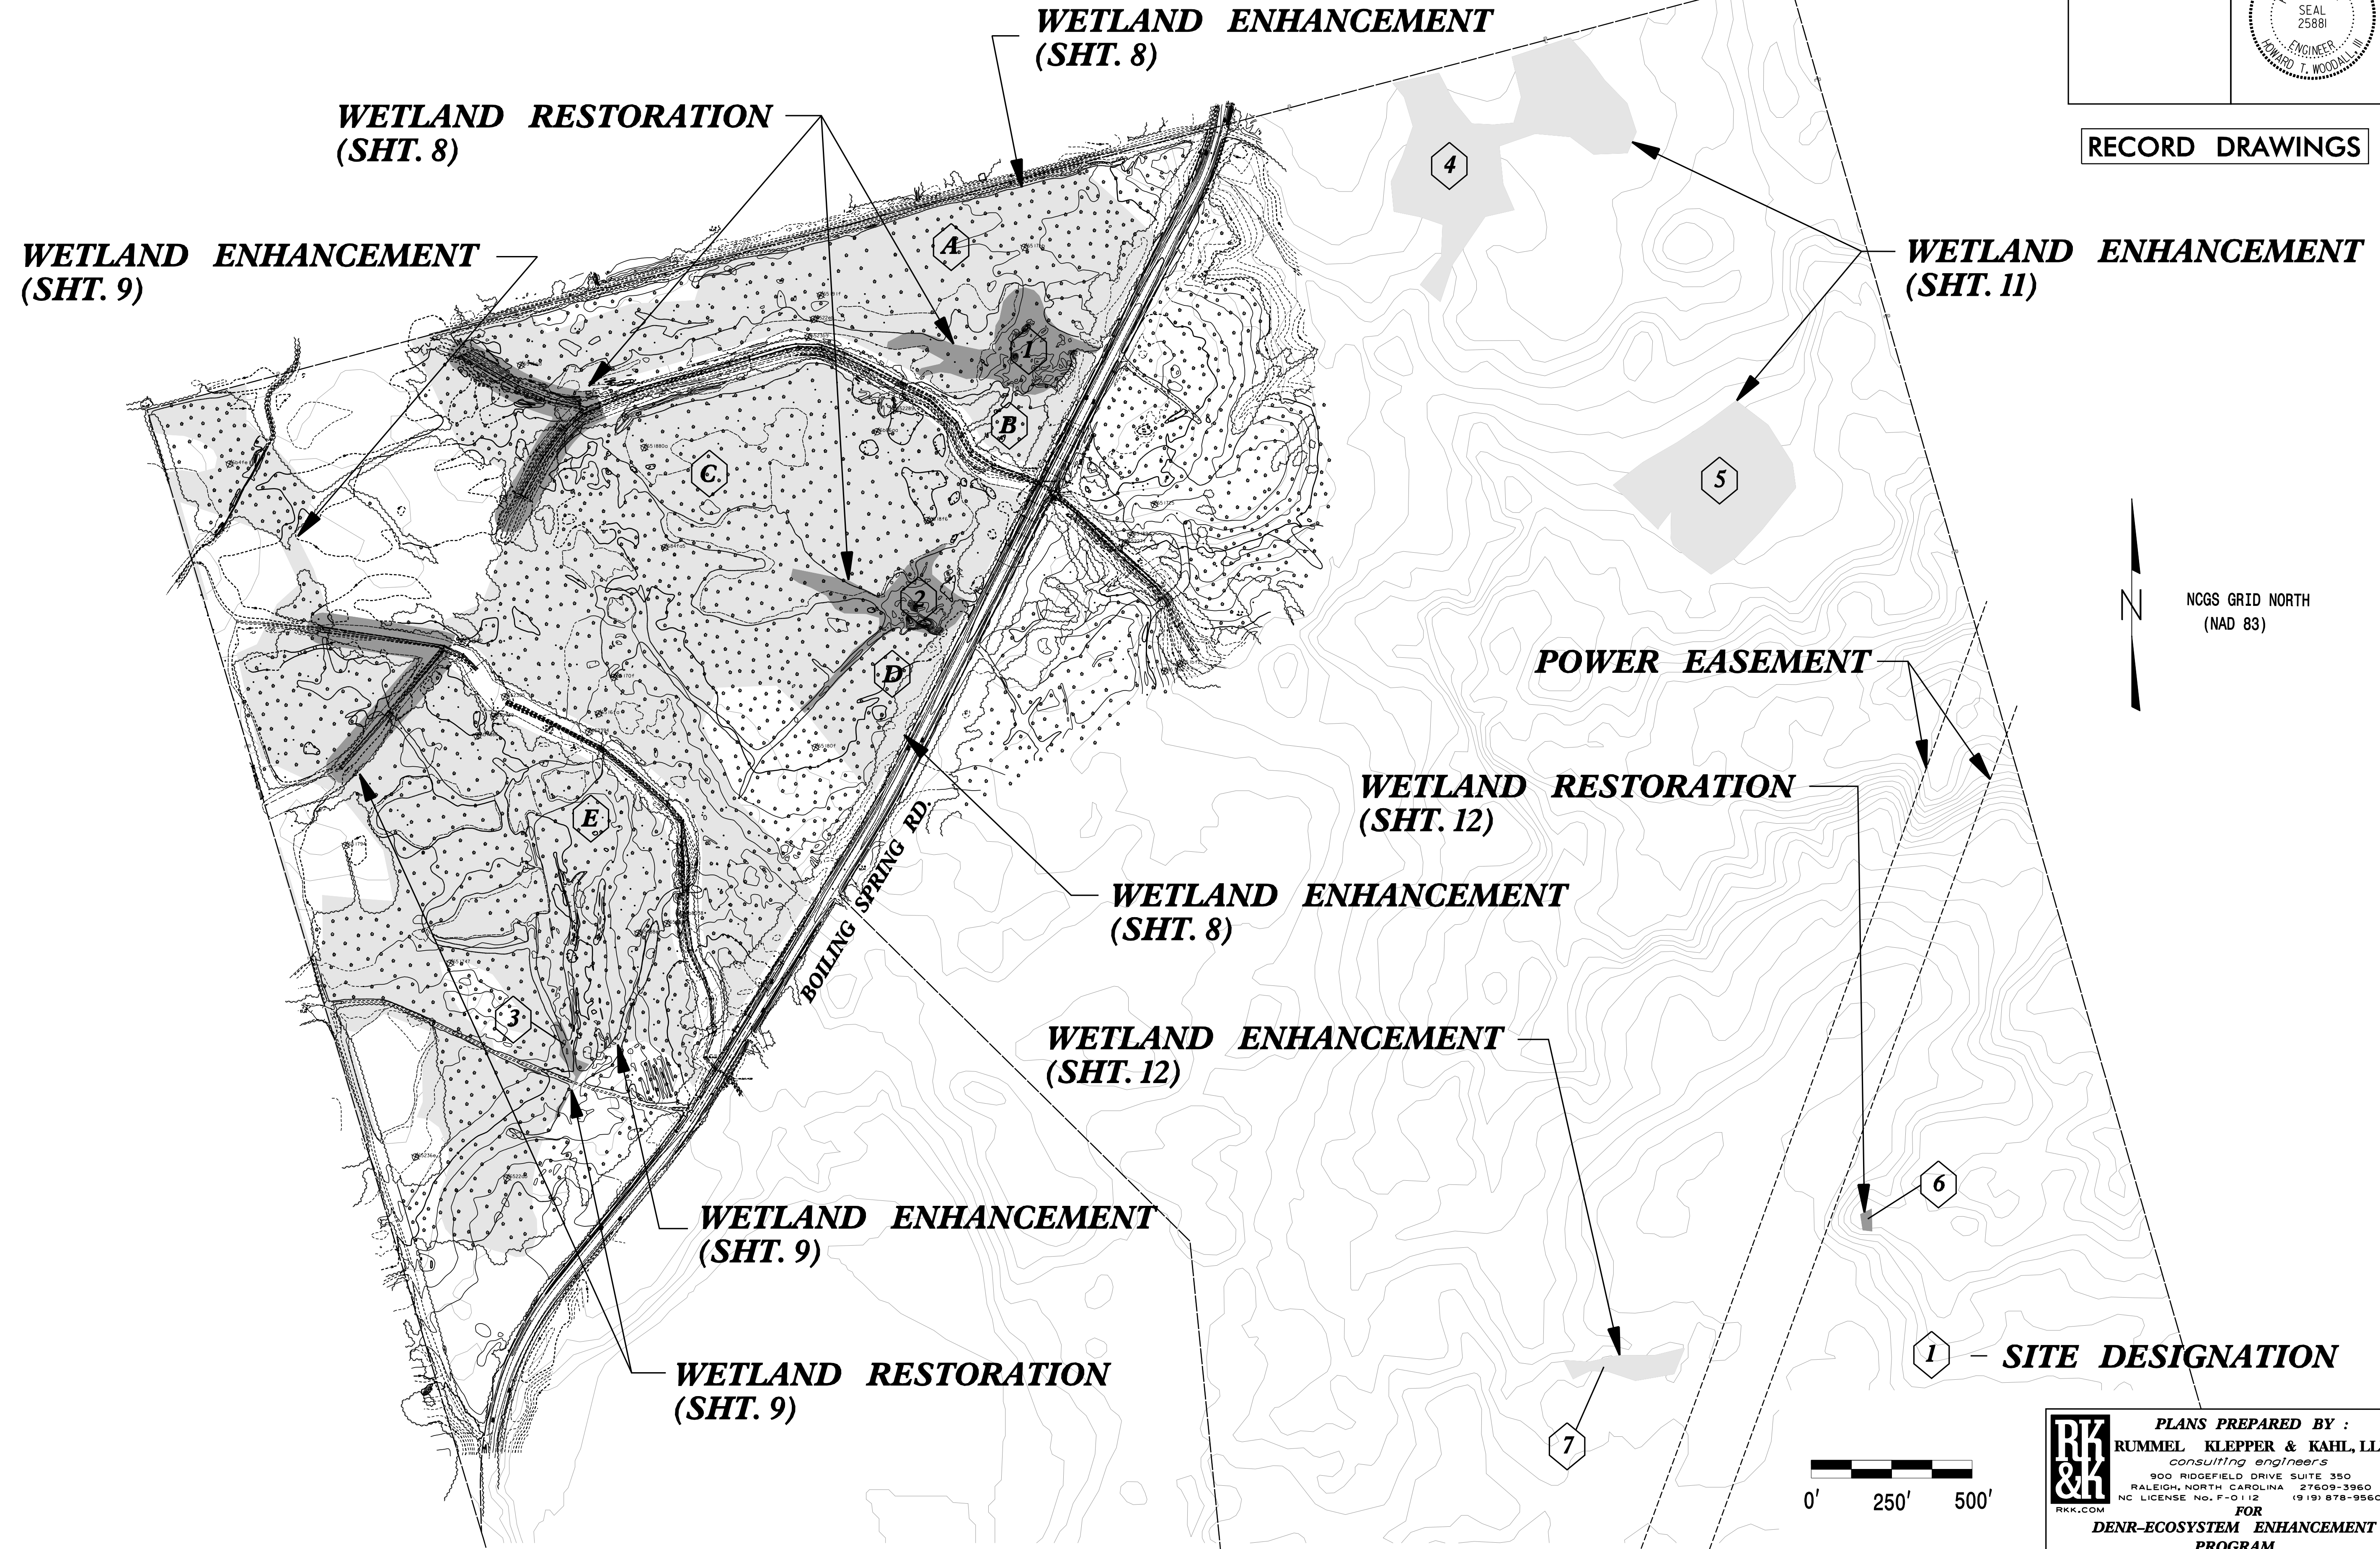



REVISIONS

8/17/99
 P:\76608\Drawings\304045\Proj\Record Drawings\L111\pl1.tstrm_over-view.dgn

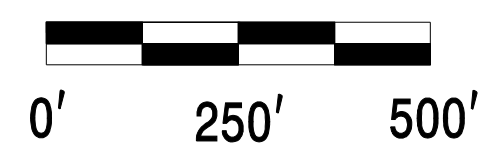


PLANS PREPARED BY :
RUMMEL KLEPPER & KAHL, LLP
consulting engineers
 900 RIDGEFIELD DRIVE SUITE 350
 RALEIGH, NORTH CAROLINA 27609-3960
 NC LICENSE NO. F-0112 (919) 878-9560
 FOR
DENR-ECOSYSTEM ENHANCEMENT PROGRAM

WETLAND RESTORATION & ENHANCEMENT

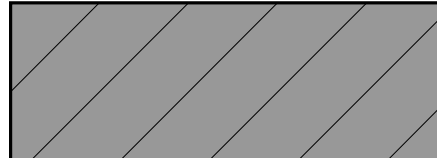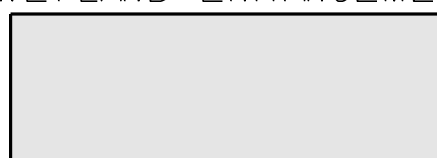WETLAND RESTORATION

WETLAND ENHANCEMENT


SITE 1		
POINT	NORTH (ft)	EAST (ft)
100	121,837.66	2,295,673.30
101	121,829.02	2,295,702.23
102	121,811.33	2,295,719.39
103	121,786.44	2,295,729.87
104	121,756.67	2,295,738.89
105	121,737.51	2,295,749.35
106	121,713.16	2,295,771.66
107	121,679.08	2,295,827.26
108	121,660.18	2,295,877.90
109	121,652.36	2,295,906.06
110	121,631.87	2,295,893.24
111	121,636.24	2,295,839.78
112	121,544.99	2,295,786.72
113	121,511.11	2,295,732.18
114	121,501.82	2,295,704.52
115	121,505.81	2,295,667.03
116	121,523.12	2,295,640.08
117	121,549.78	2,295,576.24
118	121,554.78	2,295,539.18
119	121,551.03	2,295,491.26
120	121,568.18	2,295,442.87
121	121,572.35	2,295,410.89
122	121,559.22	2,295,355.09
123	121,568.73	2,295,338.75
124	121,571.12	2,295,333.96
125	121,586.79	2,295,351.44
126	121,599.64	2,295,408.27
127	121,610.17	2,295,420.11
128	121,634.81	2,295,374.67
129	121,650.76	2,295,334.85
130	121,644.79	2,295,290.69
131	121,642.16	2,295,249.22
132	121,650.89	2,295,243.06
133	121,668.50	2,295,246.90
134	121,692.53	2,295,294.42
135	121,697.53	2,295,348.61
136	121,684.72	2,295,394.68
137	121,661.02	2,295,451.67
138	121,644.35	2,295,531.40
139	121,646.97	2,295,579.75
140	121,684.06	2,295,577.20
141	121,719.11	2,295,581.58
142	121,738.42	2,295,593.06
143	121,793.69	2,295,605.29
144	121,814.09	2,295,622.43
145	121,831.74	2,295,642.89

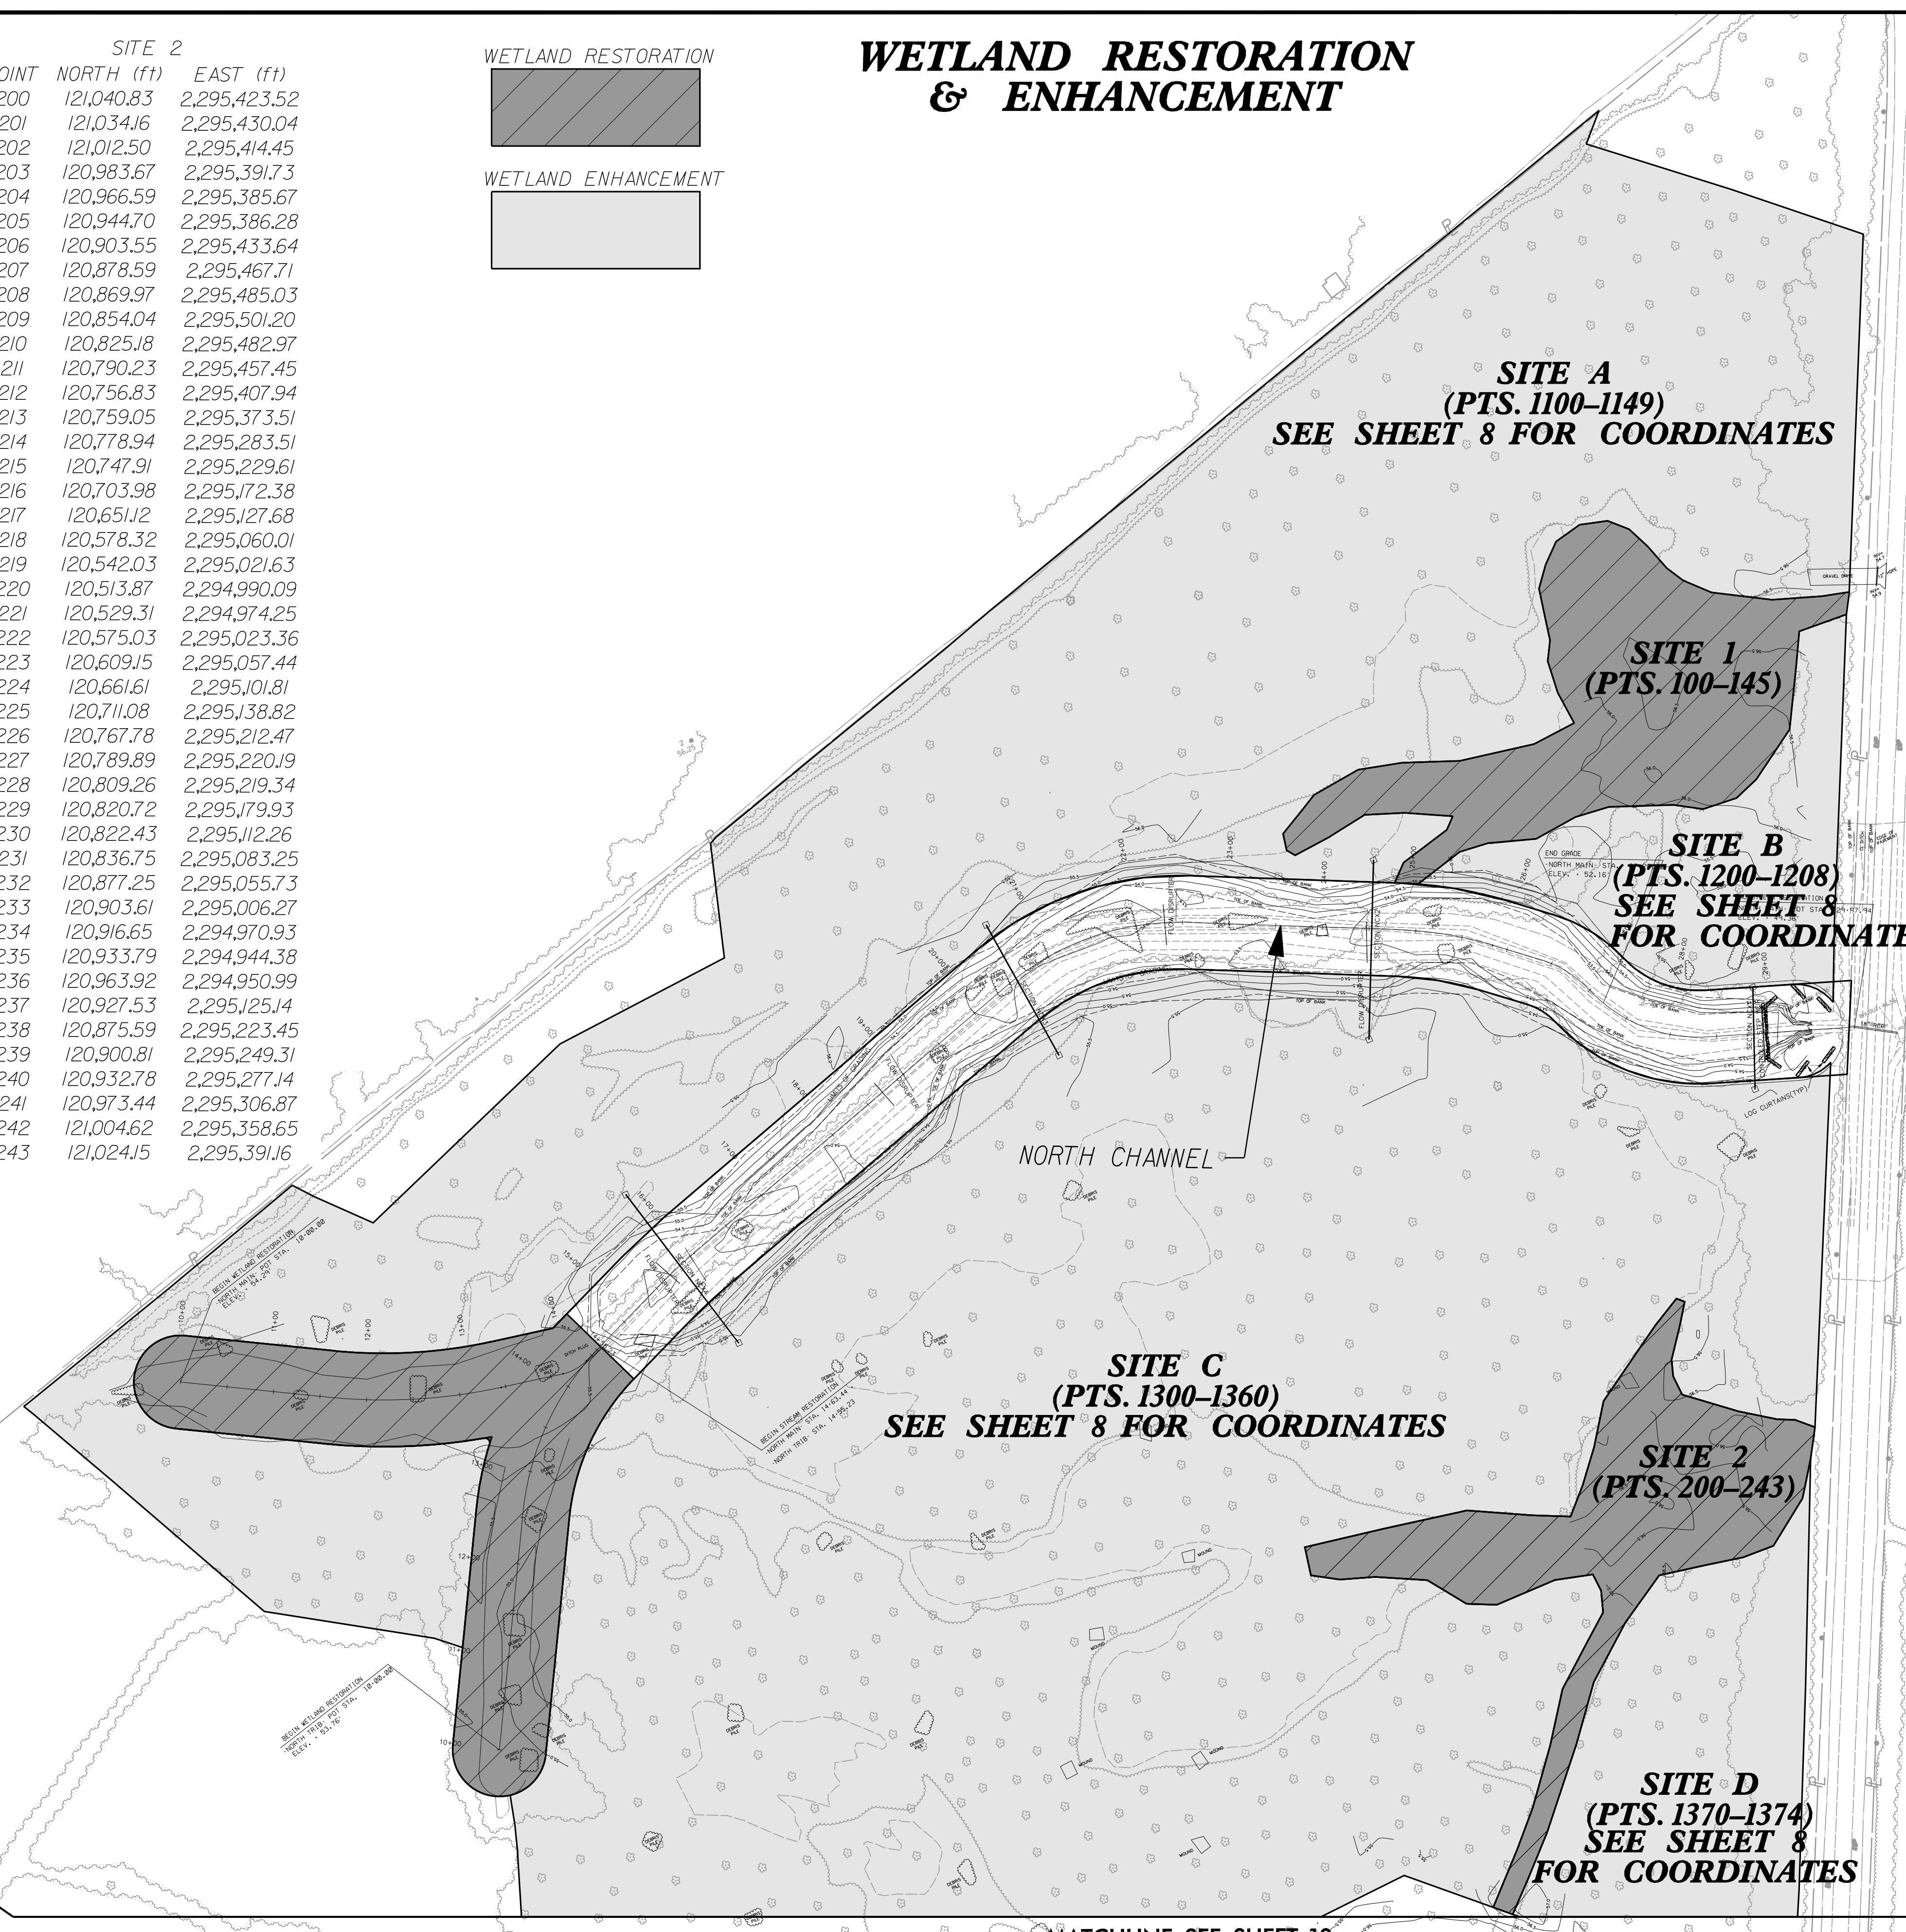SITE 2		
POINT	NORTH (ft)	EAST (ft)
200	121,040.83	2,295,423.52
201	121,034.16	2,295,430.04
202	121,012.50	2,295,414.45
203	120,983.67	2,295,391.73
204	120,966.59	2,295,385.67
205	120,944.70	2,295,386.28
206	120,903.55	2,295,433.64
207	120,878.59	2,295,467.71
208	120,869.97	2,295,485.03
209	120,854.04	2,295,501.20
210	120,825.18	2,295,482.97
211	120,790.23	2,295,457.45
212	120,756.83	2,295,407.94
213	120,759.05	2,295,373.51
214	120,778.94	2,295,283.51
215	120,747.91	2,295,229.61
216	120,703.98	2,295,172.38
217	120,651.12	2,295,127.68
218	120,578.32	2,295,060.01
219	120,542.03	2,295,021.63
220	120,513.87	2,294,990.09
221	120,529.31	2,294,974.25
222	120,575.03	2,295,023.36
223	120,609.15	2,295,057.44
224	120,661.61	2,295,101.81
225	120,711.08	2,295,138.82
226	120,767.78	2,295,212.47
227	120,789.89	2,295,220.19
228	120,809.26	2,295,219.34
229	120,820.72	2,295,179.93
230	120,822.43	2,295,112.26
231	120,836.75	2,295,083.25
232	120,877.25	2,295,055.73
233	120,903.61	2,295,006.27
234	120,916.65	2,294,970.93
235	120,933.79	2,294,944.38
236	120,963.92	2,294,950.99
237	120,927.53	2,295,125.14
238	120,875.59	2,295,223.45
239	120,900.81	2,295,249.31
240	120,932.78	2,295,277.14
241	120,973.44	2,295,306.87
242	121,004.62	2,295,358.65
243	121,024.15	2,295,391.16



REVISIONS

8/17/99


P:\176608\05_304045\Proj\Record Drawings\L11\p1.t-rest&enh.pshl.dgn
 12/17/2008 10:30:45 AM

PLANS PREPARED BY :
RUMMEL KLEPPER & KAHL, LLP
consulting engineers
 900 RIDGEFIELD DRIVE SUITE 350
 RALEIGH, NORTH CAROLINA 27609-3960
 NC LICENSE NO. F-0112 (919) 878-9560
 FOR
DENR-ECOSYSTEM ENHANCEMENT PROGRAM


RECORD DRAWINGS
WETLAND RESTORATION & ENHANCEMENT

NCGS GRID NORTH (NAD 83)


PRETTY POND GIRL SCOUT CAMP

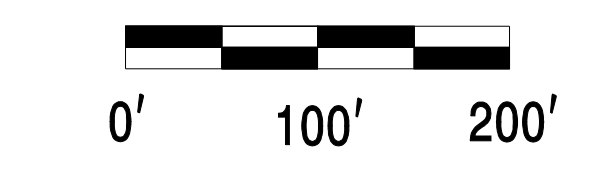

PLANS PREPARED BY :
RUMMEL KLEPPER & KAHL, LLP
consulting engineers
900 RIDGEFIELD DRIVE SUITE 350
RALEIGH, NORTH CAROLINA 27609-3960
NC LICENSE NO. F-0112 (919) 878-9560
FOR
DENR-ECOSYSTEM ENHANCEMENT PROGRAM

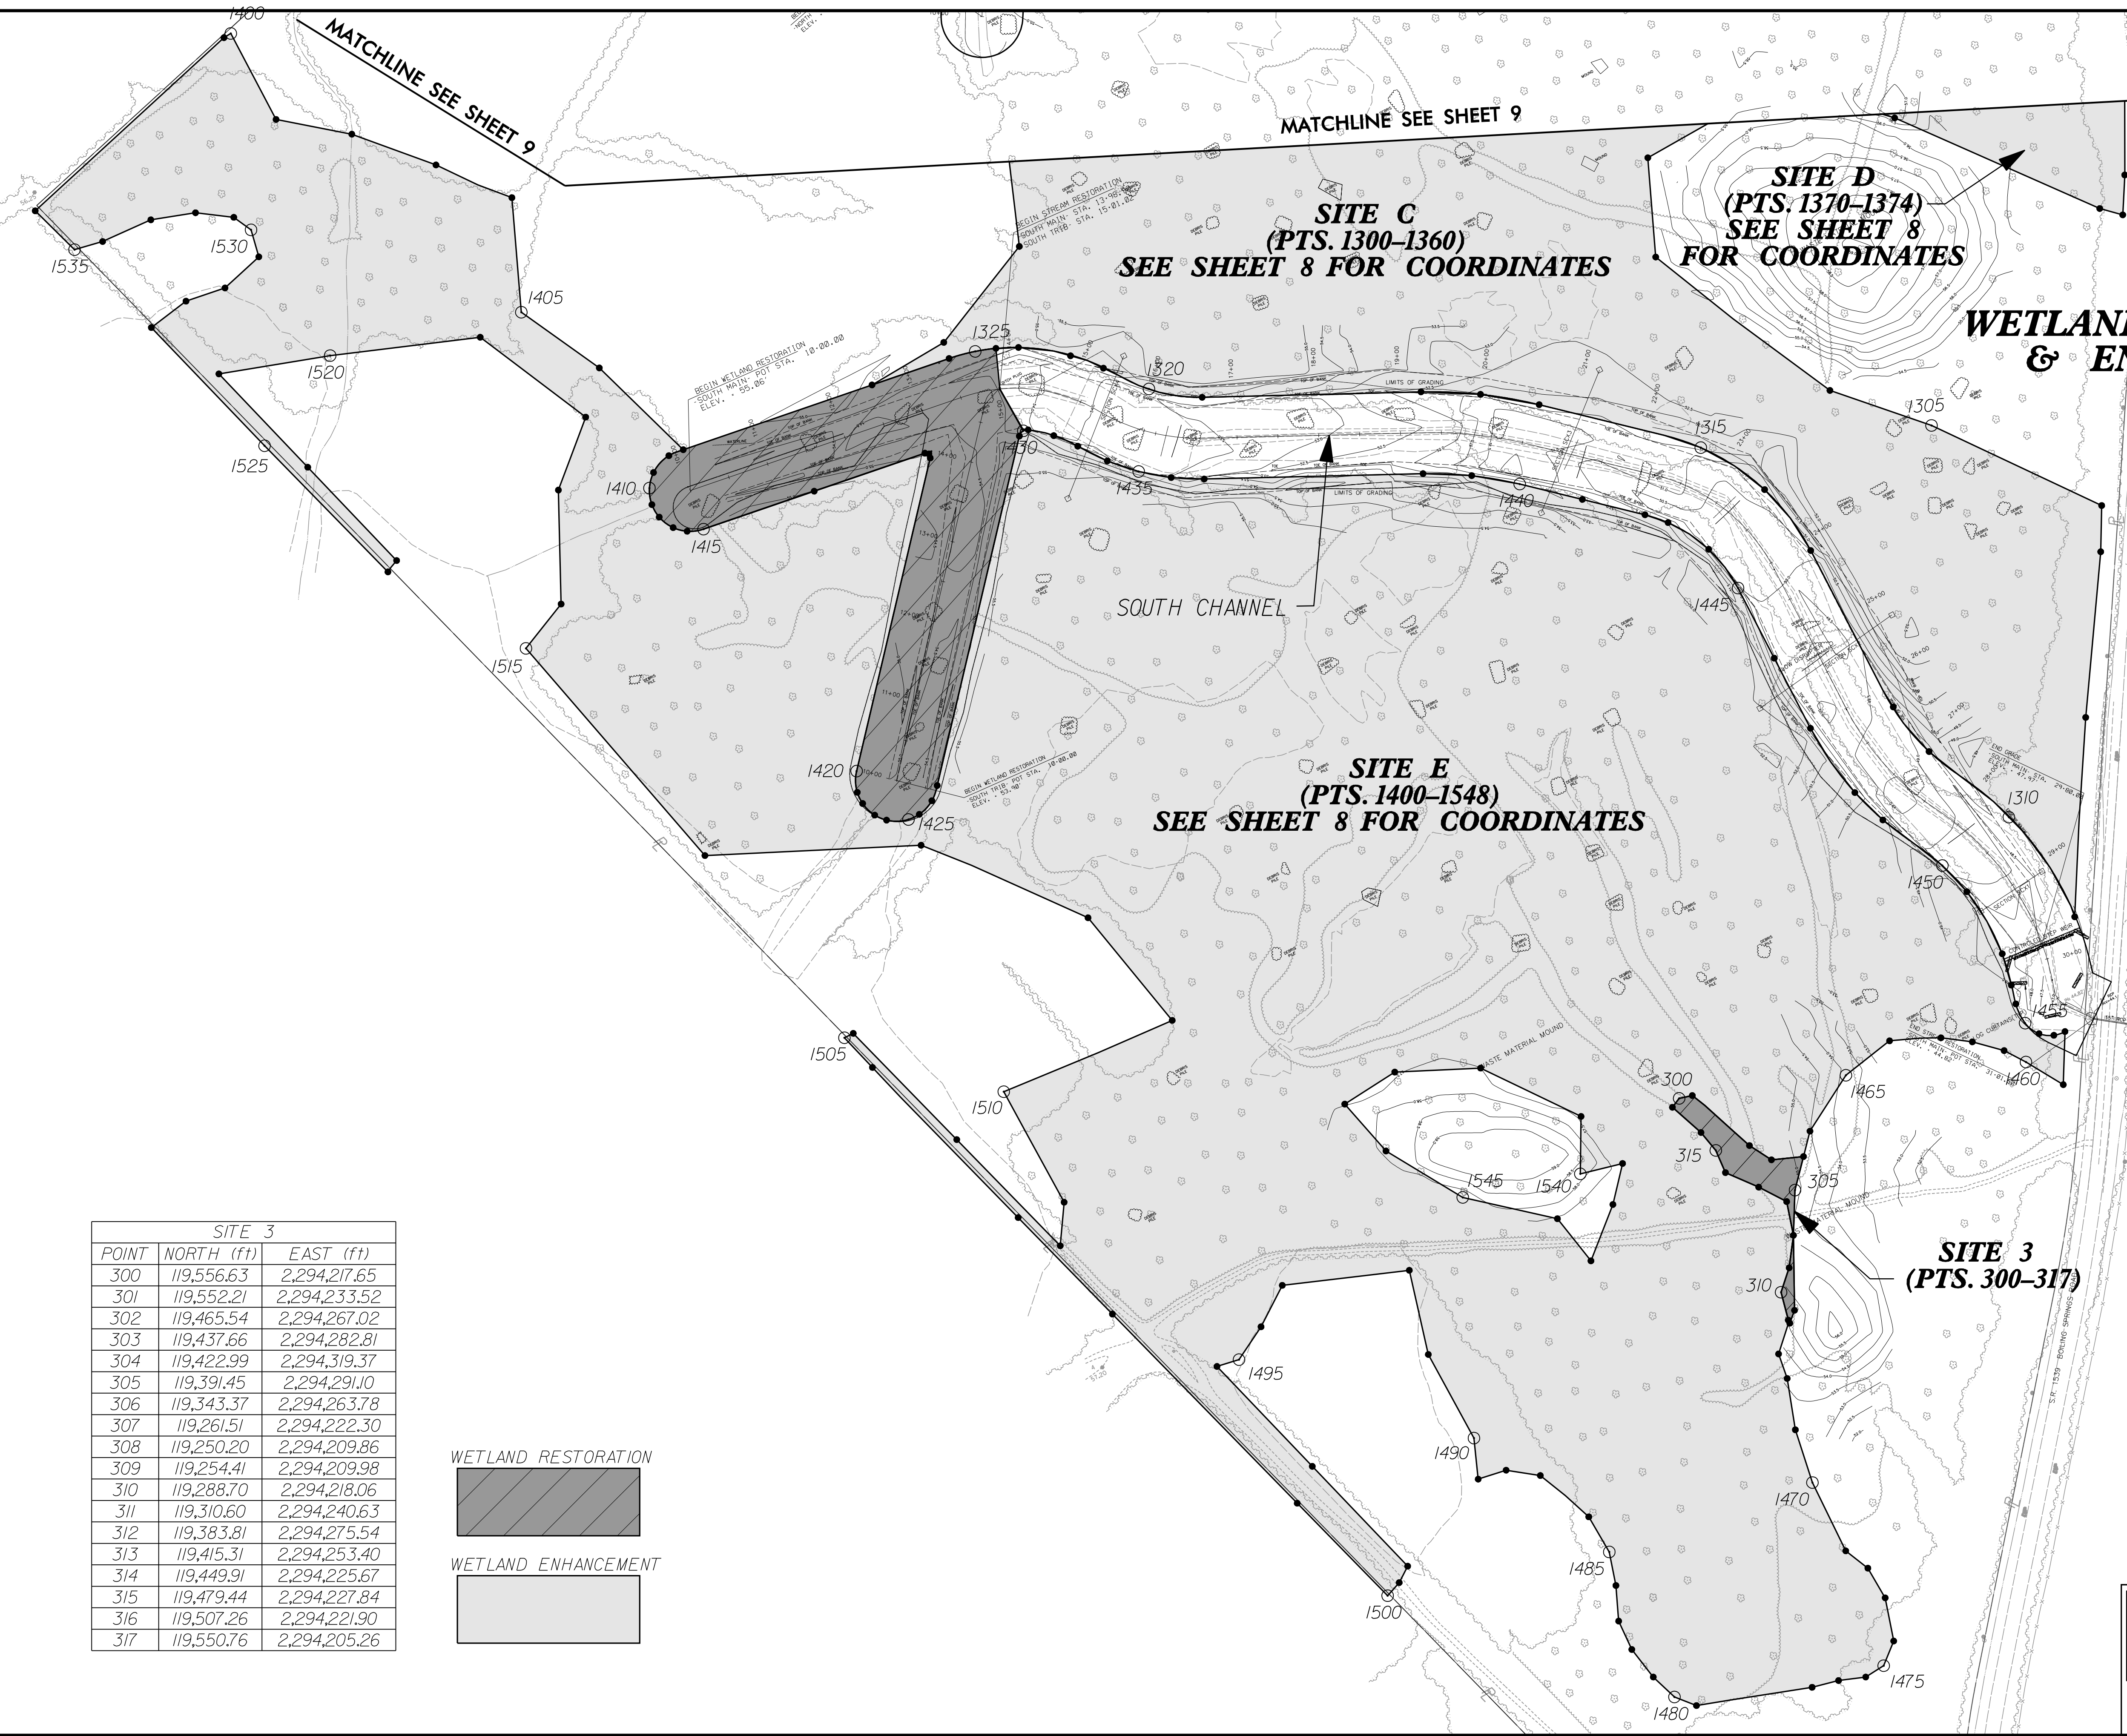


SITE 3		
POINT	NORTH (ft)	EAST (ft)
300	119,556.63	2,294,217.65
301	119,552.21	2,294,233.52
302	119,465.54	2,294,267.02
303	119,437.66	2,294,282.81
304	119,422.99	2,294,319.37
305	119,391.45	2,294,291.10
306	119,343.37	2,294,263.78
307	119,261.51	2,294,222.30
308	119,250.20	2,294,209.86
309	119,254.41	2,294,209.98
310	119,288.70	2,294,218.06
311	119,310.60	2,294,240.63
312	119,383.81	2,294,275.54
313	119,415.31	2,294,253.40
314	119,449.91	2,294,225.67
315	119,479.44	2,294,227.84
316	119,507.26	2,294,221.90
317	119,550.76	2,294,205.26

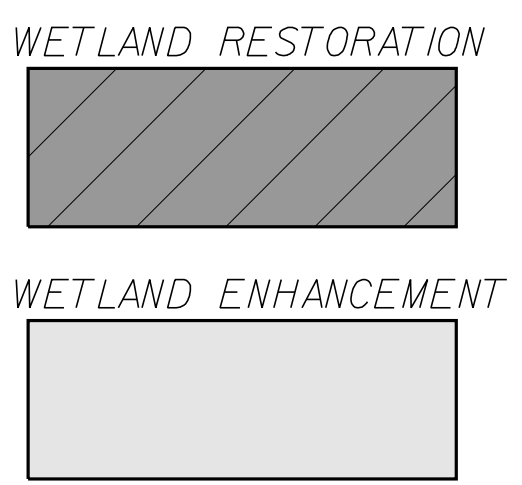


REVISIONS

8/17/99

P:\176608\05_304045\Proj\Record Drawings\11\11\pl_t_rest&enh_psh2.dgn
 11/17/2008 10:30:45 AM

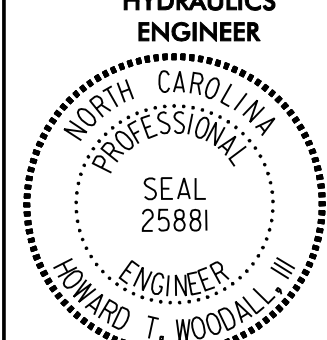PROJECT REFERENCE NO. D05053S	SHEET NO. II
RW SHEET NO.	
HYDRAULICS ENGINEER	
	




RECORD DRAWINGS

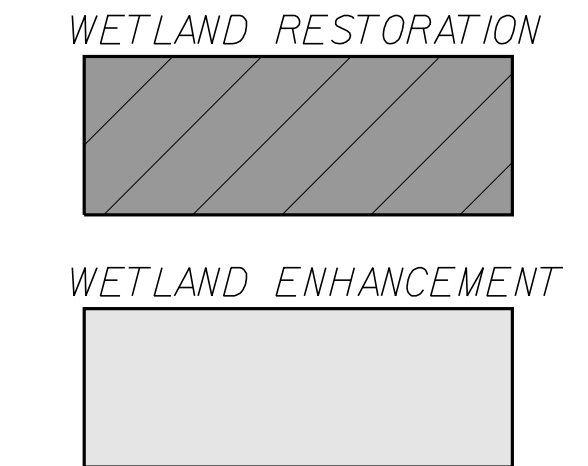

WETLAND RESTORATION & ENHANCEMENT

SITE 4		
POINT	NORTH (ft)	EAST (ft)
400	122,613.01	2,297,367.57
401	122,550.02	2,297,424.87
402	122,480.59	2,297,475.18
403	122,408.78	2,297,545.46
404	122,320.22	2,297,574.23
405	122,254.28	2,297,545.92
406	122,250.89	2,297,440.52
407	122,305.00	2,297,368.52
408	122,314.75	2,297,259.54
409	122,276.25	2,297,147.71
410	122,156.73	2,297,159.74
411	122,077.80	2,297,194.53
412	122,057.12	2,297,103.91
413	121,909.69	2,297,003.75
414	121,792.49	2,296,964.37
415	121,845.03	2,296,902.32
416	121,932.12	2,296,967.86
417	122,030.40	2,296,972.06
418	122,056.41	2,296,900.49
419	122,072.75	2,296,820.49
420	122,165.37	2,296,811.66
421	122,243.61	2,296,847.29
422	122,337.56	2,296,879.97
423	122,428.72	2,296,852.40
424	122,471.11	2,296,816.74
425	122,503.29	2,296,960.03
426	122,414.62	2,297,006.25
427	122,345.75	2,297,062.29
428	122,342.53	2,297,130.31
429	122,347.70	2,297,192.78
430	122,428.09	2,297,216.16
431	122,553.40	2,297,187.18

SITE 5		
POINT	NORTH (ft)	EAST (ft)
500	121,484.76	2,297,883.97
501	121,408.75	2,297,983.71
502	121,289.95	2,298,059.07
503	121,214.43	2,298,069.28
504	121,082.75	2,297,963.07
505	120,996.10	2,297,880.92
506	120,945.09	2,297,805.96
507	120,994.27	2,297,737.28
508	121,035.59	2,297,688.91
509	121,056.63	2,297,681.27
510	121,141.60	2,297,682.97
511	121,093.91	2,297,645.09
512	121,085.03	2,297,641.73
513	121,222.11	2,297,501.61
514	121,293.60	2,297,594.84
515	121,354.21	2,297,699.76
516	121,409.09	2,297,782.70

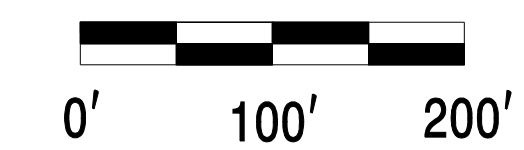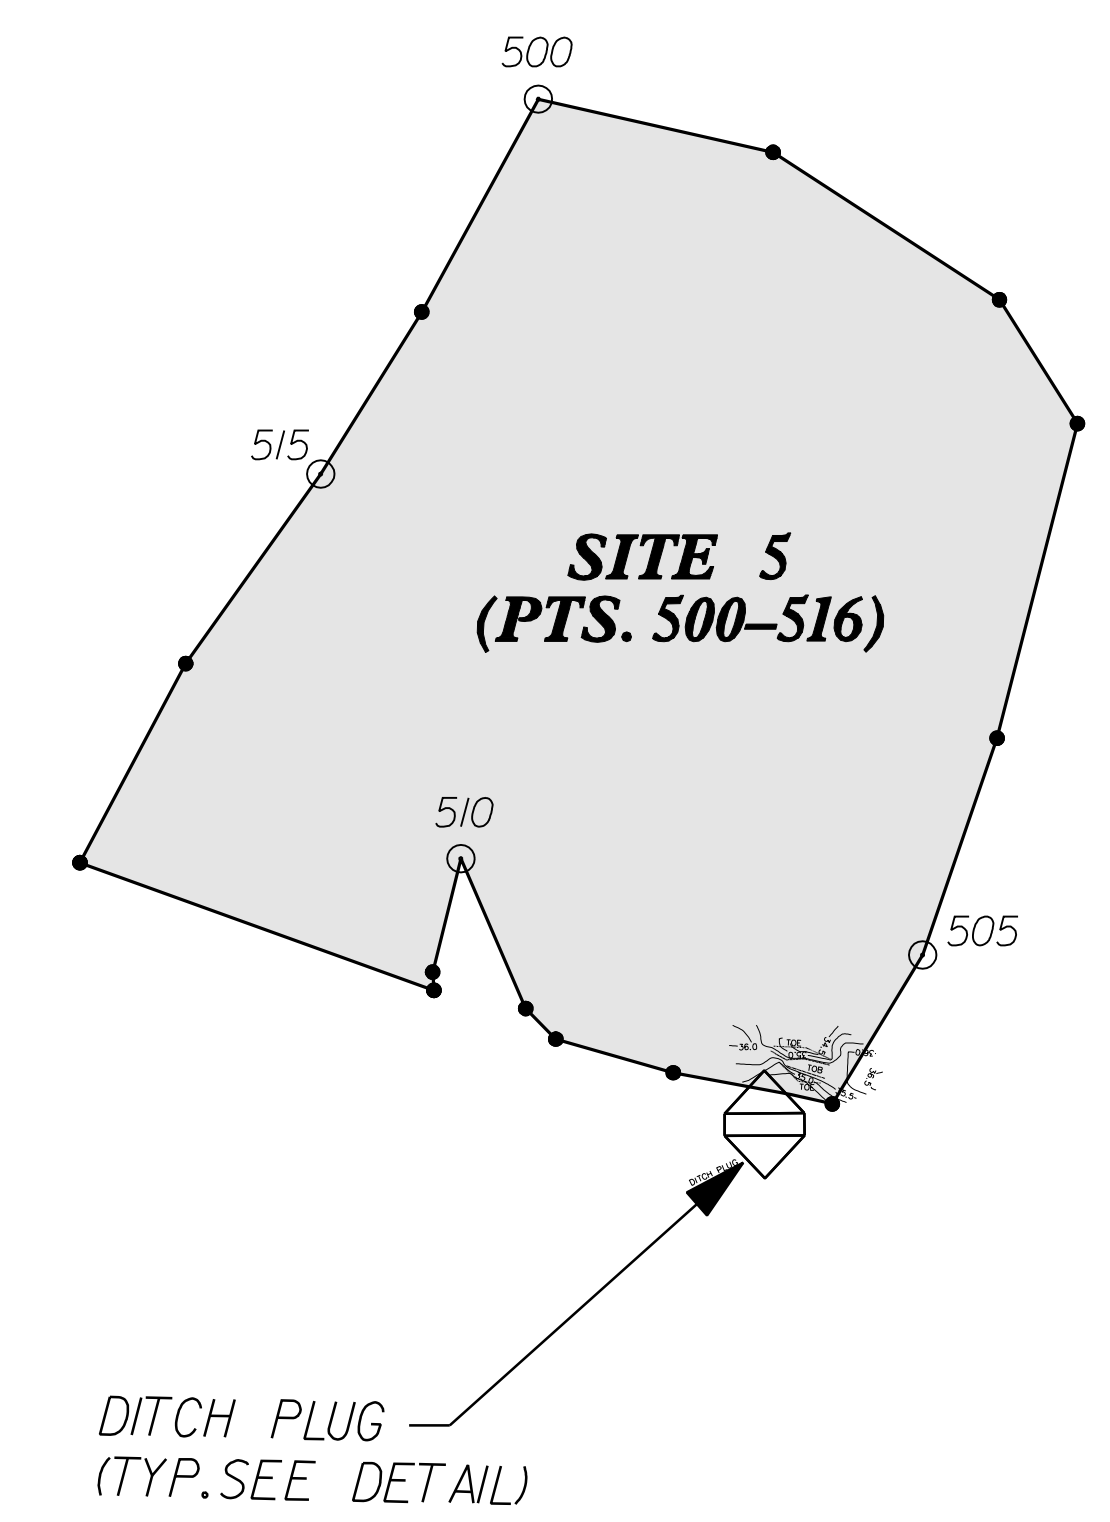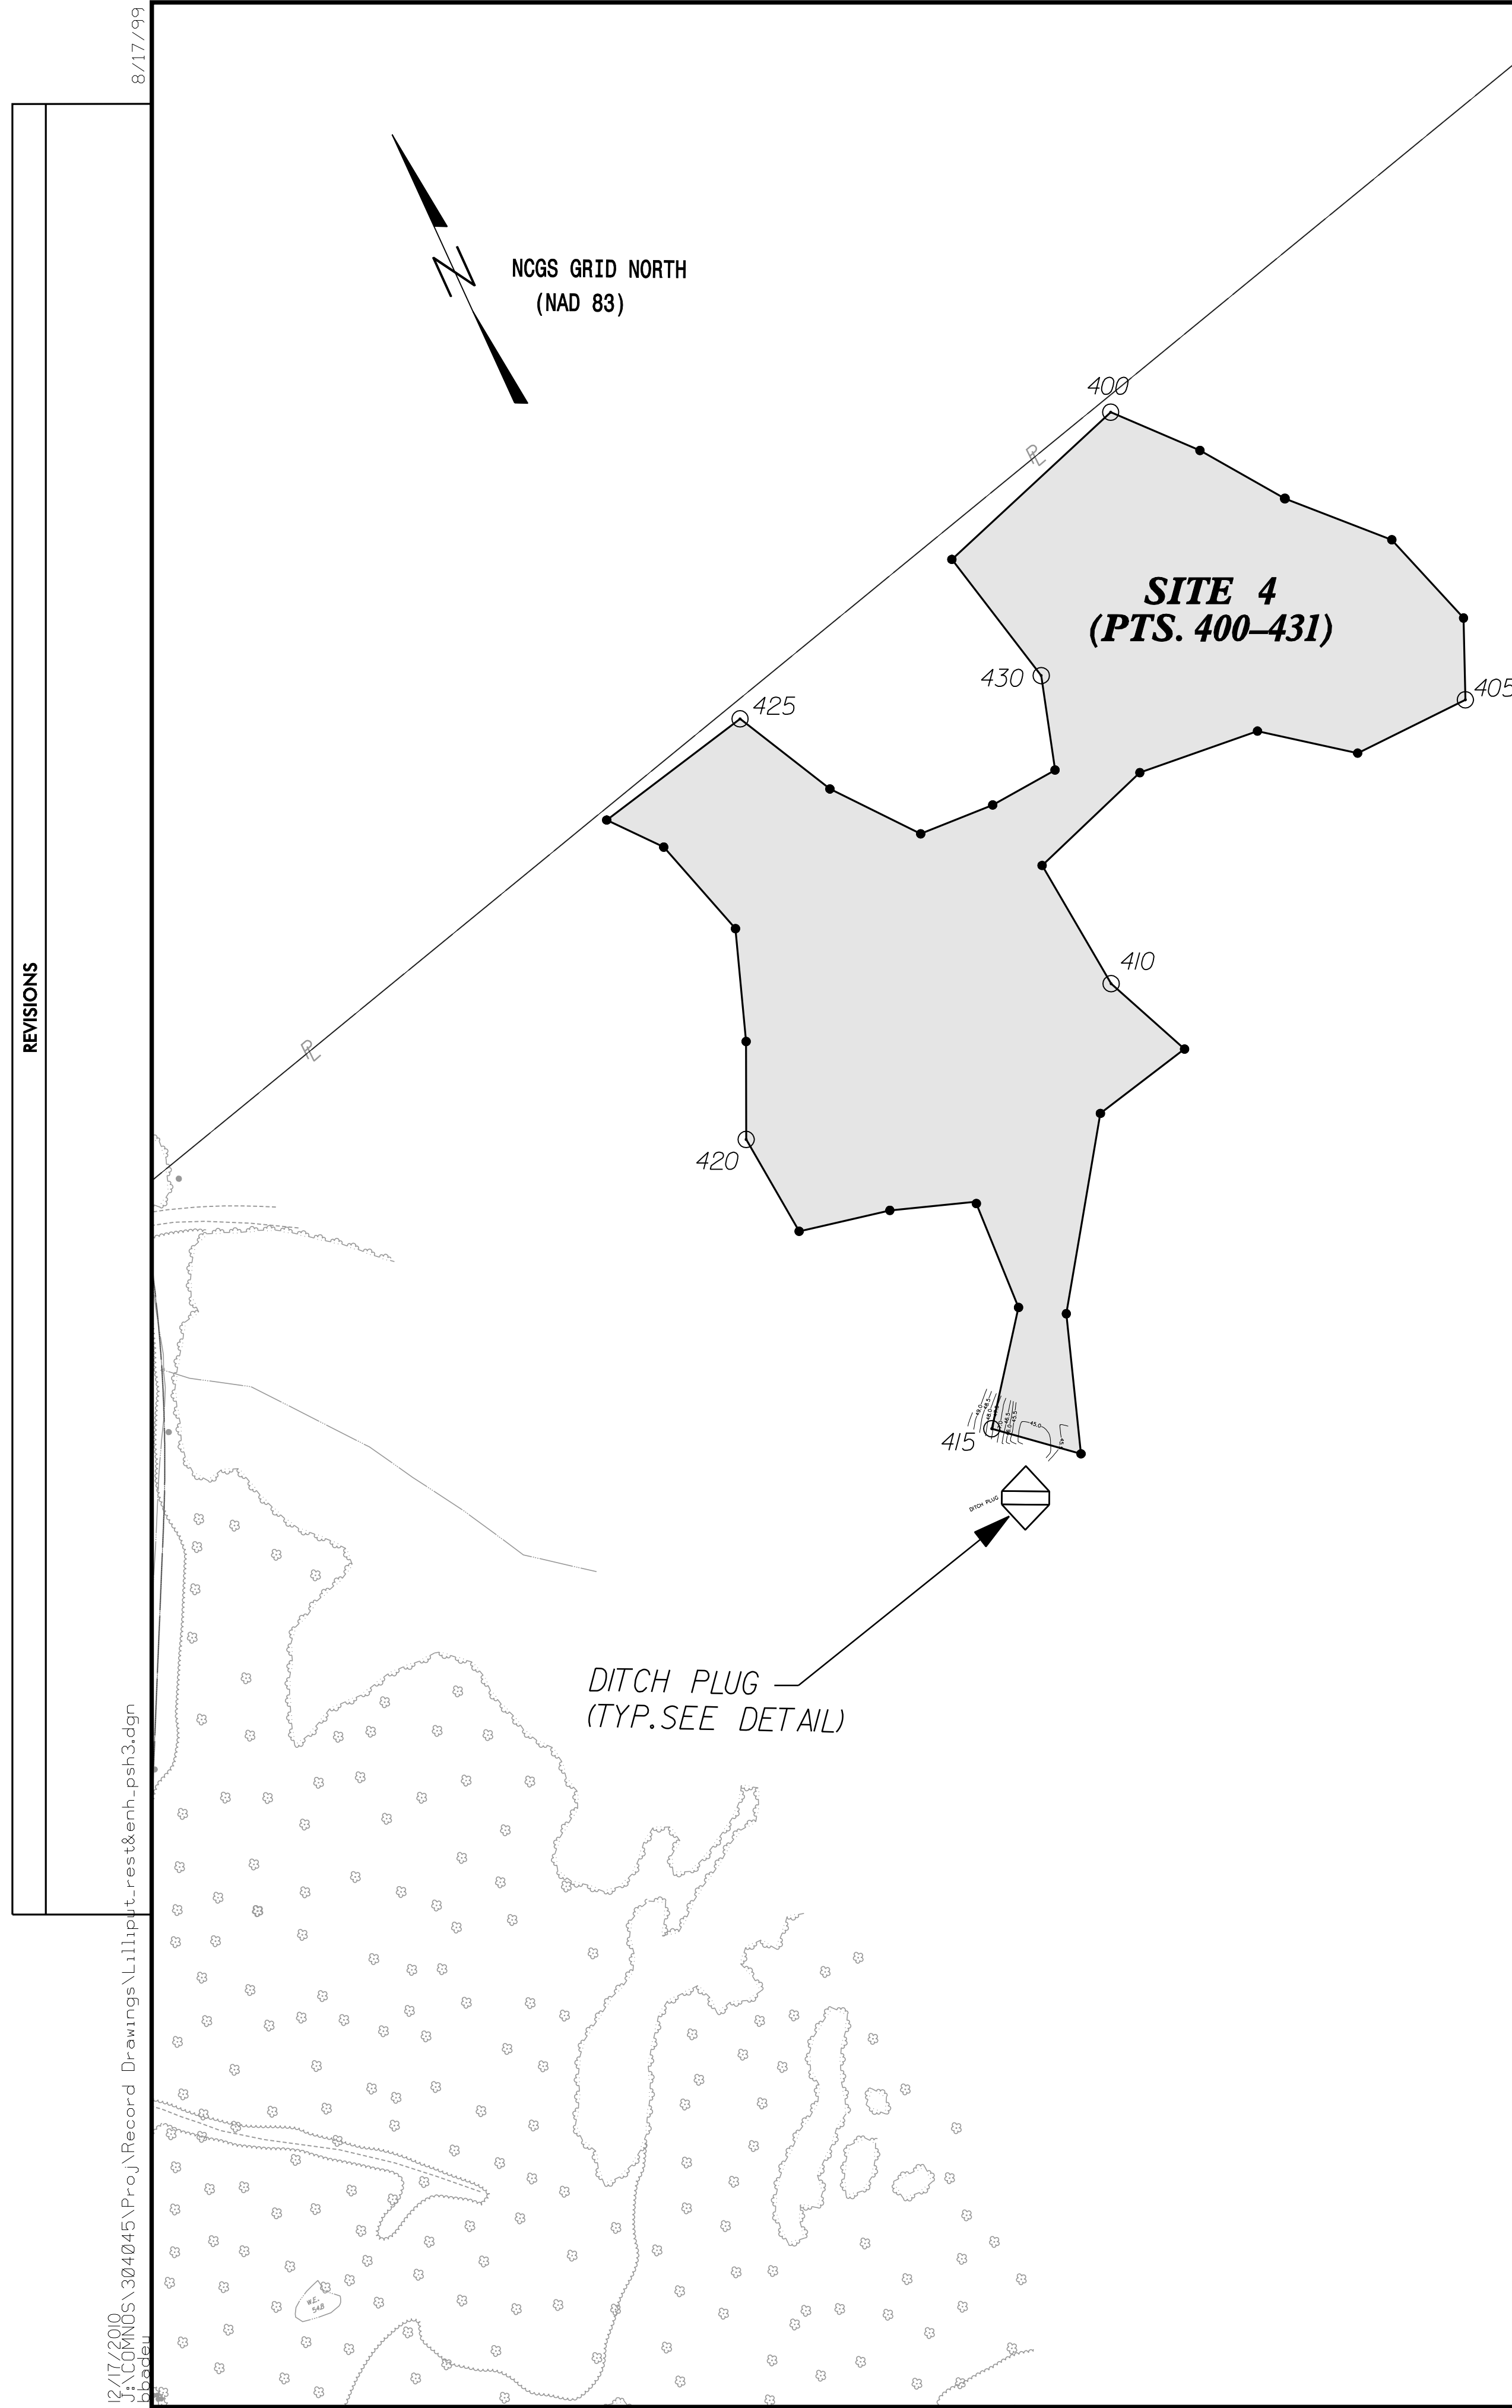


PLANS PREPARED BY :
RUMMEL KLEPPER & KAHL, LLP
consulting engineers
 900 RIDGEFIELD DRIVE SUITE 350
 RALEIGH, NORTH CAROLINA 27609-3960
 NC LICENSE NO. F-0112 (919) 878-9560
 FOR
DENR-ECOSYSTEM ENHANCEMENT PROGRAM

8/17/99
 P:\17\2008\Drawings\11\11\p1\1-rest&enh-psht3.dgn
 12/17/2008

PROJECT REFERENCE NO. D05053S	SHEET NO. 12
RW SHEET NO.	
HYDRAULICS ENGINEER NORTH CAROLINA PROFESSIONAL SEAL 25881 CONWARD, T. WOODALL III	





RECORD DRAWINGS

WETLAND RESTORATION & ENHANCEMENT

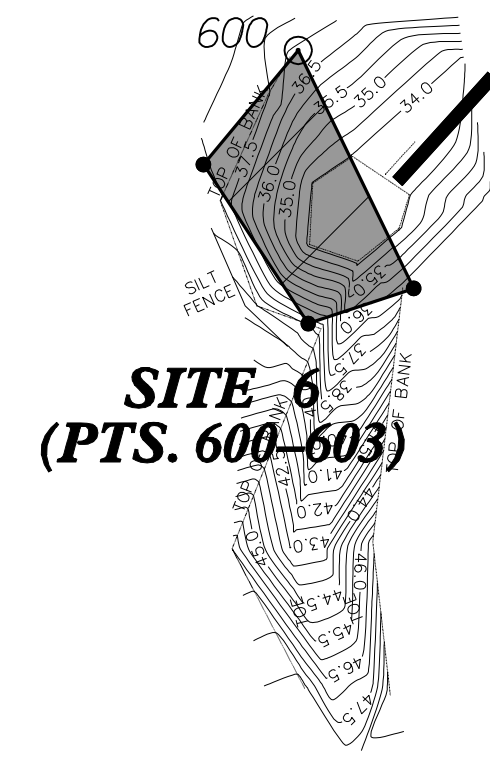


SITE 6		
POINT	NORTH (ft)	EAST (ft)
600	118,972.54	2,298,304.96
601	118,903.62	2,298,306.58
602	118,906.73	2,298,277.79
603	118,955.72	2,298,270.18

SITE 7		
POINT	NORTH (ft)	EAST (ft)
700	118,539.28	2,297,725.89
701	118,459.96	2,297,693.63
702	118,439.02	2,297,573.33
703	118,467.40	2,297,485.81
704	118,469.05	2,297,428.76
705	118,443.70	2,297,337.14
706	118,502.02	2,297,348.01
707	118,497.18	2,297,427.84
708	118,517.63	2,297,519.57
709	118,517.02	2,297,630.25
710	118,537.90	2,297,714.79

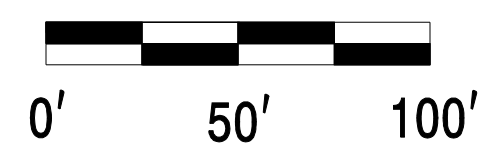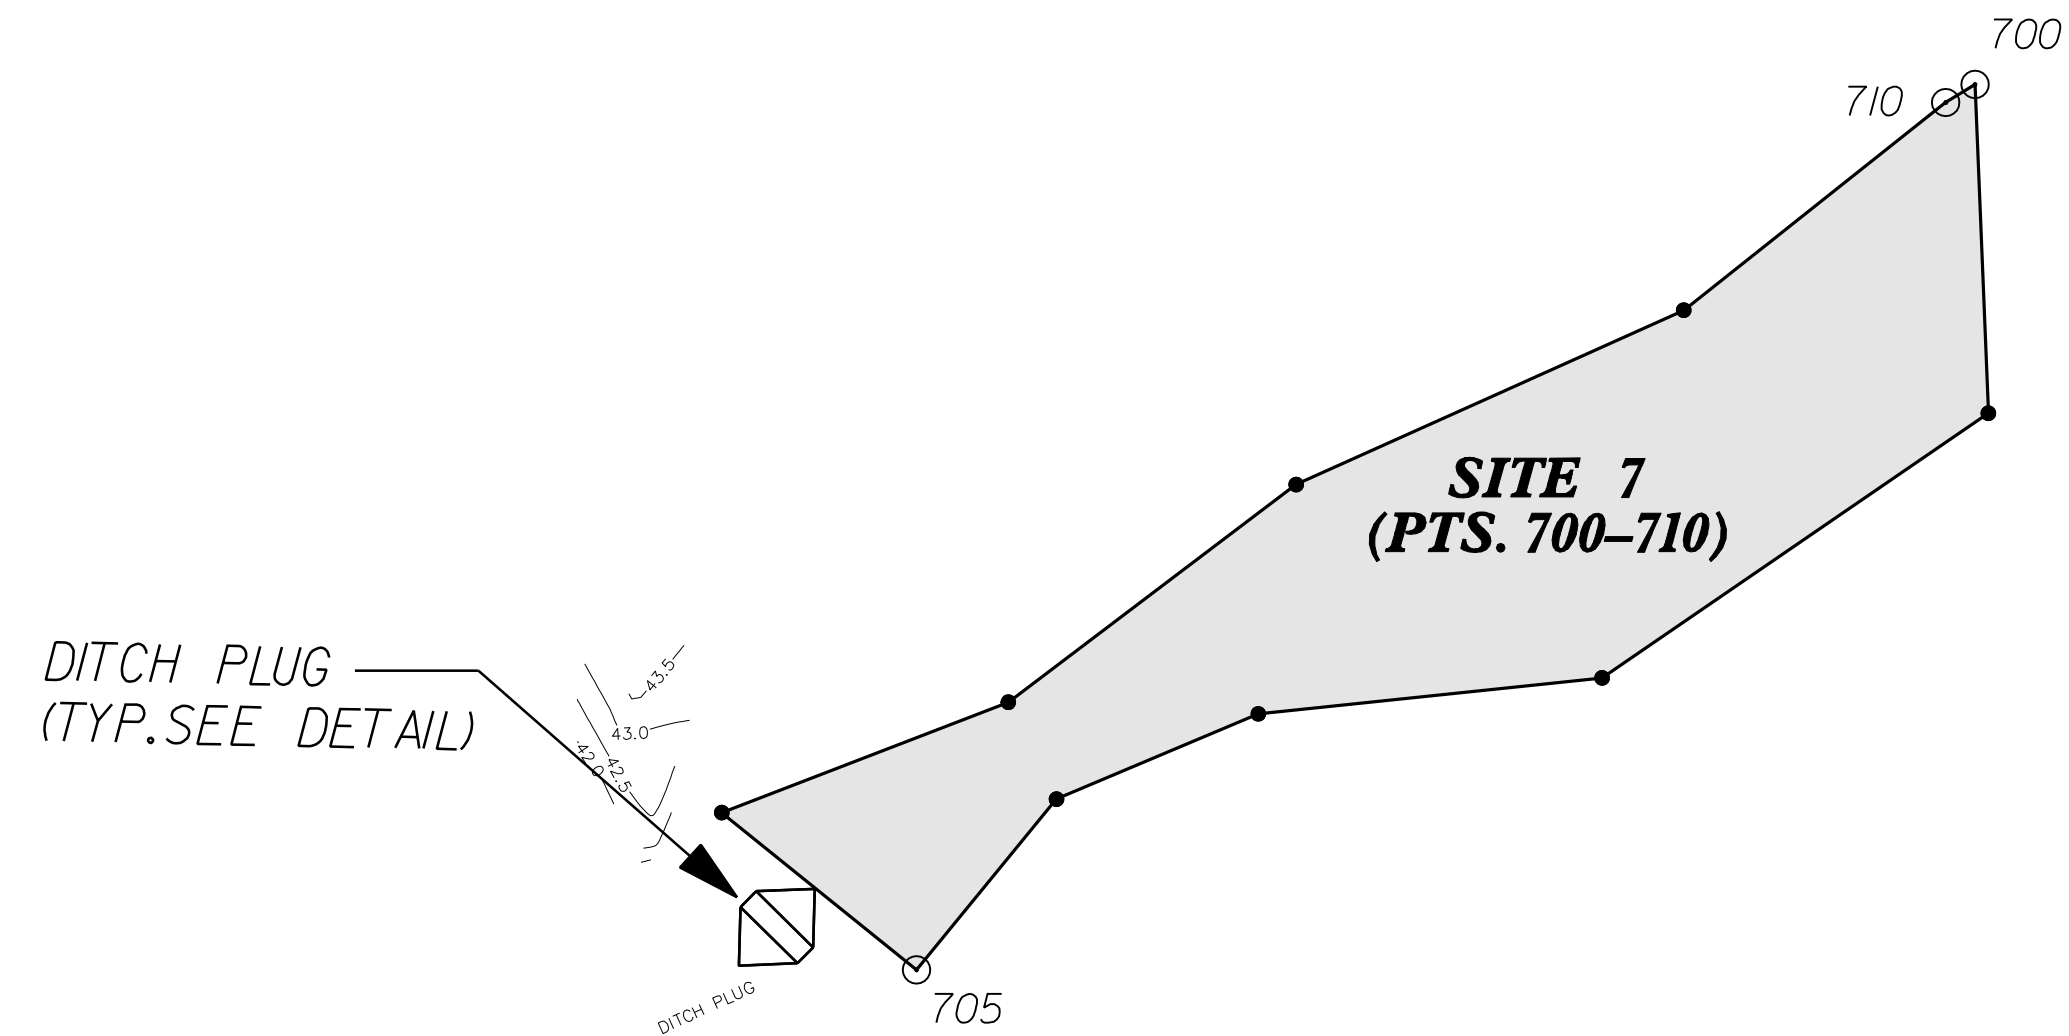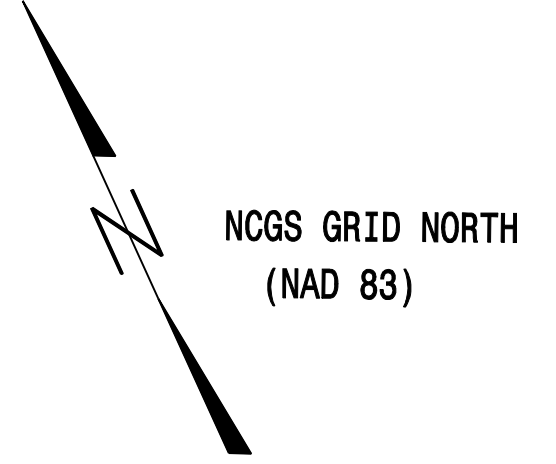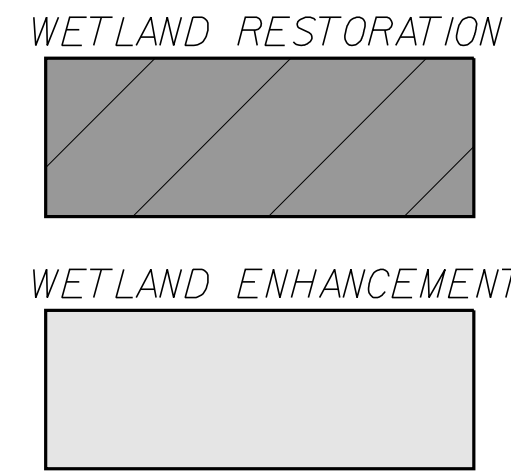

PLANS PREPARED BY :
RUMMEL KLEPPER & KAHL, LLP
consulting engineers
 900 RIDGEFIELD DRIVE SUITE 350
 RALEIGH, NORTH CAROLINA 27609-3960
 NC LICENSE NO. F-0112 (919) 878-9560
 FOR
DENR-ECOSYSTEM ENHANCEMENT PROGRAM

8/17/99
 REVISIONS
 P:\17\2008\12\05\304045\Proj\Record Drawings\11\11\pl_t_rest&enh_psh4.dgn
 11/11/08
 11/11/08

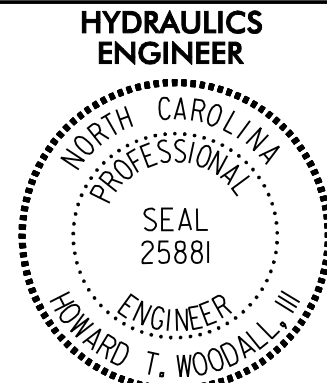PROJECT REFERENCE NO. D050535	SHEET NO. 13
R / W SHEET NO.	
	


RECORD DRAWINGS

REVISIONS

COORDINATE GEOMETRY - NORTH MAIN									
10+00.00		POT	121,624.52	2,293,929.32					
	T1				S 59° 38' 45.25" E	158.56'	N/A	N/A	N/A
11+58.56		PC	121,544.39	2,294,066.14					
	C1	CC	122,053.51	2,294,364.29	S 68° 42' 39.11" E	185.91'	186.69'	18° 07' 47.73" left	590.00'
13+45.25		PT	121,476.89	2,294,239.37					
	T2				S 77° 46' 32.98" E	67.52'	N/A	N/A	N/A
14+12.77		PC	121,462.59	2,294,305.36					
	C2	CC	121,511.46	2,294,315.94	N 8° 24' 32.56" E	28.93'	29.35'	33° 37' 48.92" left	50.00'
14+42.11		PT	121,464.91	2,294,334.19					
	T3				N 68° 35' 38.10" E	106.16'	N/A	N/A	N/A
15+48.27		PC	121,503.65	2,294,433.03					
	C3	CC	120,945.04	2,294,652.01	N 71° 18' 2.43" E	56.67'	56.69'	05° 24' 48.65" right	600.00'
16+04.96		PT	121,521.82	2,294,486.70					
	T4				N 74° 00' 26.75" E	440.20'	N/A	N/A	N/A
20+45.16		PC	121,643.10	2,294,909.86					
	C4	CC	121,369.13	2,294,988.38	S 84° 44' 27.23" E	206.61'	211.42'	42° 30' 12.03" right	285.00'
22+56.58		PT	121,624.17	2,295,115.60					
	T5				S 63° 29' 21.21" E	224.44'	N/A	N/A	N/A
24+81.01		PC	121,523.98	2,295,316.44					
	C5	CC	121,166.04	2,295,137.89	S 56° 06' 45.34" E	102.71'	103.00'	14° 45' 11.74" right	400.00'
25+84.01		PT	121,466.72	2,295,401.70					
	T6				S 48° 44' 9.47" E	52.83'	N/A	N/A	N/A
26+36.84		PC	121,431.87	2,295,441.41					
	C6	CC	121,341.67	2,295,362.27	S 33° 42' 19.31" E	62.24'	62.96'	30° 03' 40.32" right	120.00'
26+99.80		CRC	121,380.10	2,295,475.95					
	C7	CC	121,431.33	2,295,627.53	S 43° 58' 25.23" E	136.75'	141.30'	50° 35' 52.16" left	160.00'
28+41.10		PT	121,281.68	2,295,570.90					
	T7				S 69° 16' 21.31" E	158.72'	N/A	N/A	N/A
29+99.81		PT	121,225.51	2,295,719.34					
COORDINATE GEOMETRY - NORTH TRIB									
10+00.00			121,124.61	2,294,076.36					
	T10				N 30° 12' 26.25" E	254.24'	N/A	N/A	N/A
12+54.24		PC	121,344.33	2,294,204.28					
	C10	CC	121,193.39	2,294,463.54	N 49° 24' 2.17" E	197.25'	200.99'	38° 23' 11.86" right	300.00'
14+55.23		PT	121,472.69	2,294,354.05					

COORDINATE GEOMETRY - SOUTH MAIN									
10+00.00			120,776.63	2,293,491.26					
	T20				S 81° 17' 28.47" E	351.87'	N/A	N/A	N/A
13+51.87		PC	120,723.36	2,293,839.08					
	C20	CC	120,525.66	2,293,808.80	S 56° 32' 32.06" E	167.46'	172.78'	49° 29' 52.82" right	200.00'
15+24.65		CRC	120,631.03	2,293,978.79					
	C21	CC	120,757.48	2,294,182.78	S 47° 46' 59.20" E	132.22'	133.96'	31° 58' 47.11" left	240.00'
16+58.61		PT	120,542.19	2,294,076.71					
	T21				S 63° 46' 22.75" E	267.77'	N/A	N/A	N/A
19+26.38		PC	120,423.85	2,294,316.91					
	C22	CC	119,975.33	2,294,095.95	S 56° 10' 39.68" E	132.18'	132.56'	15° 11' 26.15" right	500.00'
20+58.94		PT	120,350.28	2,294,426.72					
	T22				S 48° 34' 56.61" E	157.75'	N/A	N/A	N/A
22+16.69		PC	120,245.93	2,294,545.02					
	C23	CC	120,077.20	2,294,396.17	S 24° 07' 18.71" E	186.33'	192.11'	48° 55' 15.79" right	225.00'
24+08.80		PT	120,075.87	2,294,621.17					
	T23				S 00° 20' 19.19" W	193.04'	N/A	N/A	N/A
26+01.84		PC	119,882.83	2,294,620.02					
	C24	CC	119,880.91	2,294,945.02	S 14° 18' 17.45" E	164.32'	166.13'	29° 17' 13.28" left	325.00'
27+67.96		CRC	119,723.61	2,294,660.63					
	C25	CC	119,563.88	2,294,371.86	S 06° 29' 44.47" E	252.07'	258.64'	44° 54' 19.23" right	330.00'
30+26.60		PT	119,473.16	2,294,689.14					
	T24				S 15° 57' 25.15" W	13.97'	N/A	N/A	N/A
30+40.57		PC	119,459.72	2,294,685.30					
	C26	CC	119,452.85	2,294,709.34	S 10° 29' 51.30" E	22.27'	23.09'	52° 54' 32.90" left	25.00'
30+63.65		PT	119,437.82	2,294,689.36					
	T25				S 36° 57' 7.75" E	37.84'	N/A	N/A	N/A
31+01.50		PT	119,407.58	2,294,712.11					
COORDINATE GEOMETRY - SOUTH MAIN									
10+00.00			120,345.43	2,293,550.02					
	T30				N 40° 52' 45.07" E	476.13'	N/A	N/A	N/A
14+76.13		PC	120,705.43	2,293,861.63					
	C30	CC	120,692.34	2,293,876.75	N 76° 31' 46.24" E	23.31'	24.89'	71° 18' 2.35" right	20.00'
15+01.02		PT	120,710.86	2,293,884.30					


P:\17\2005\170505\304045\Proc\Record Drawings\11\input_atm.dwg

	PLANS PREPARED BY :
	RUMMEL KLEPPER & KAHL, LLP
	<i>consulting engineers</i>
	900 RIDGEFIELD DRIVE SUITE 350 RALEIGH, NORTH CAROLINA 27609-3960 NC LICENSE NO. F-0112 (919) 878-9560
	FOR
	DENR-ECOSYSTEM ENHANCEMENT PROGRAM

PROJECT REFERENCE NO. D05053S	SHEET NO. 14
RW SHEET NO.	
HYDRAULICS ENGINEER NORTH CAROLINA PROFESSIONAL SEAL 25681 ENGINEER HOWARD T. WOODALL III	

RECORD DRAWINGS


STREAM & WETLAND RESTORATION

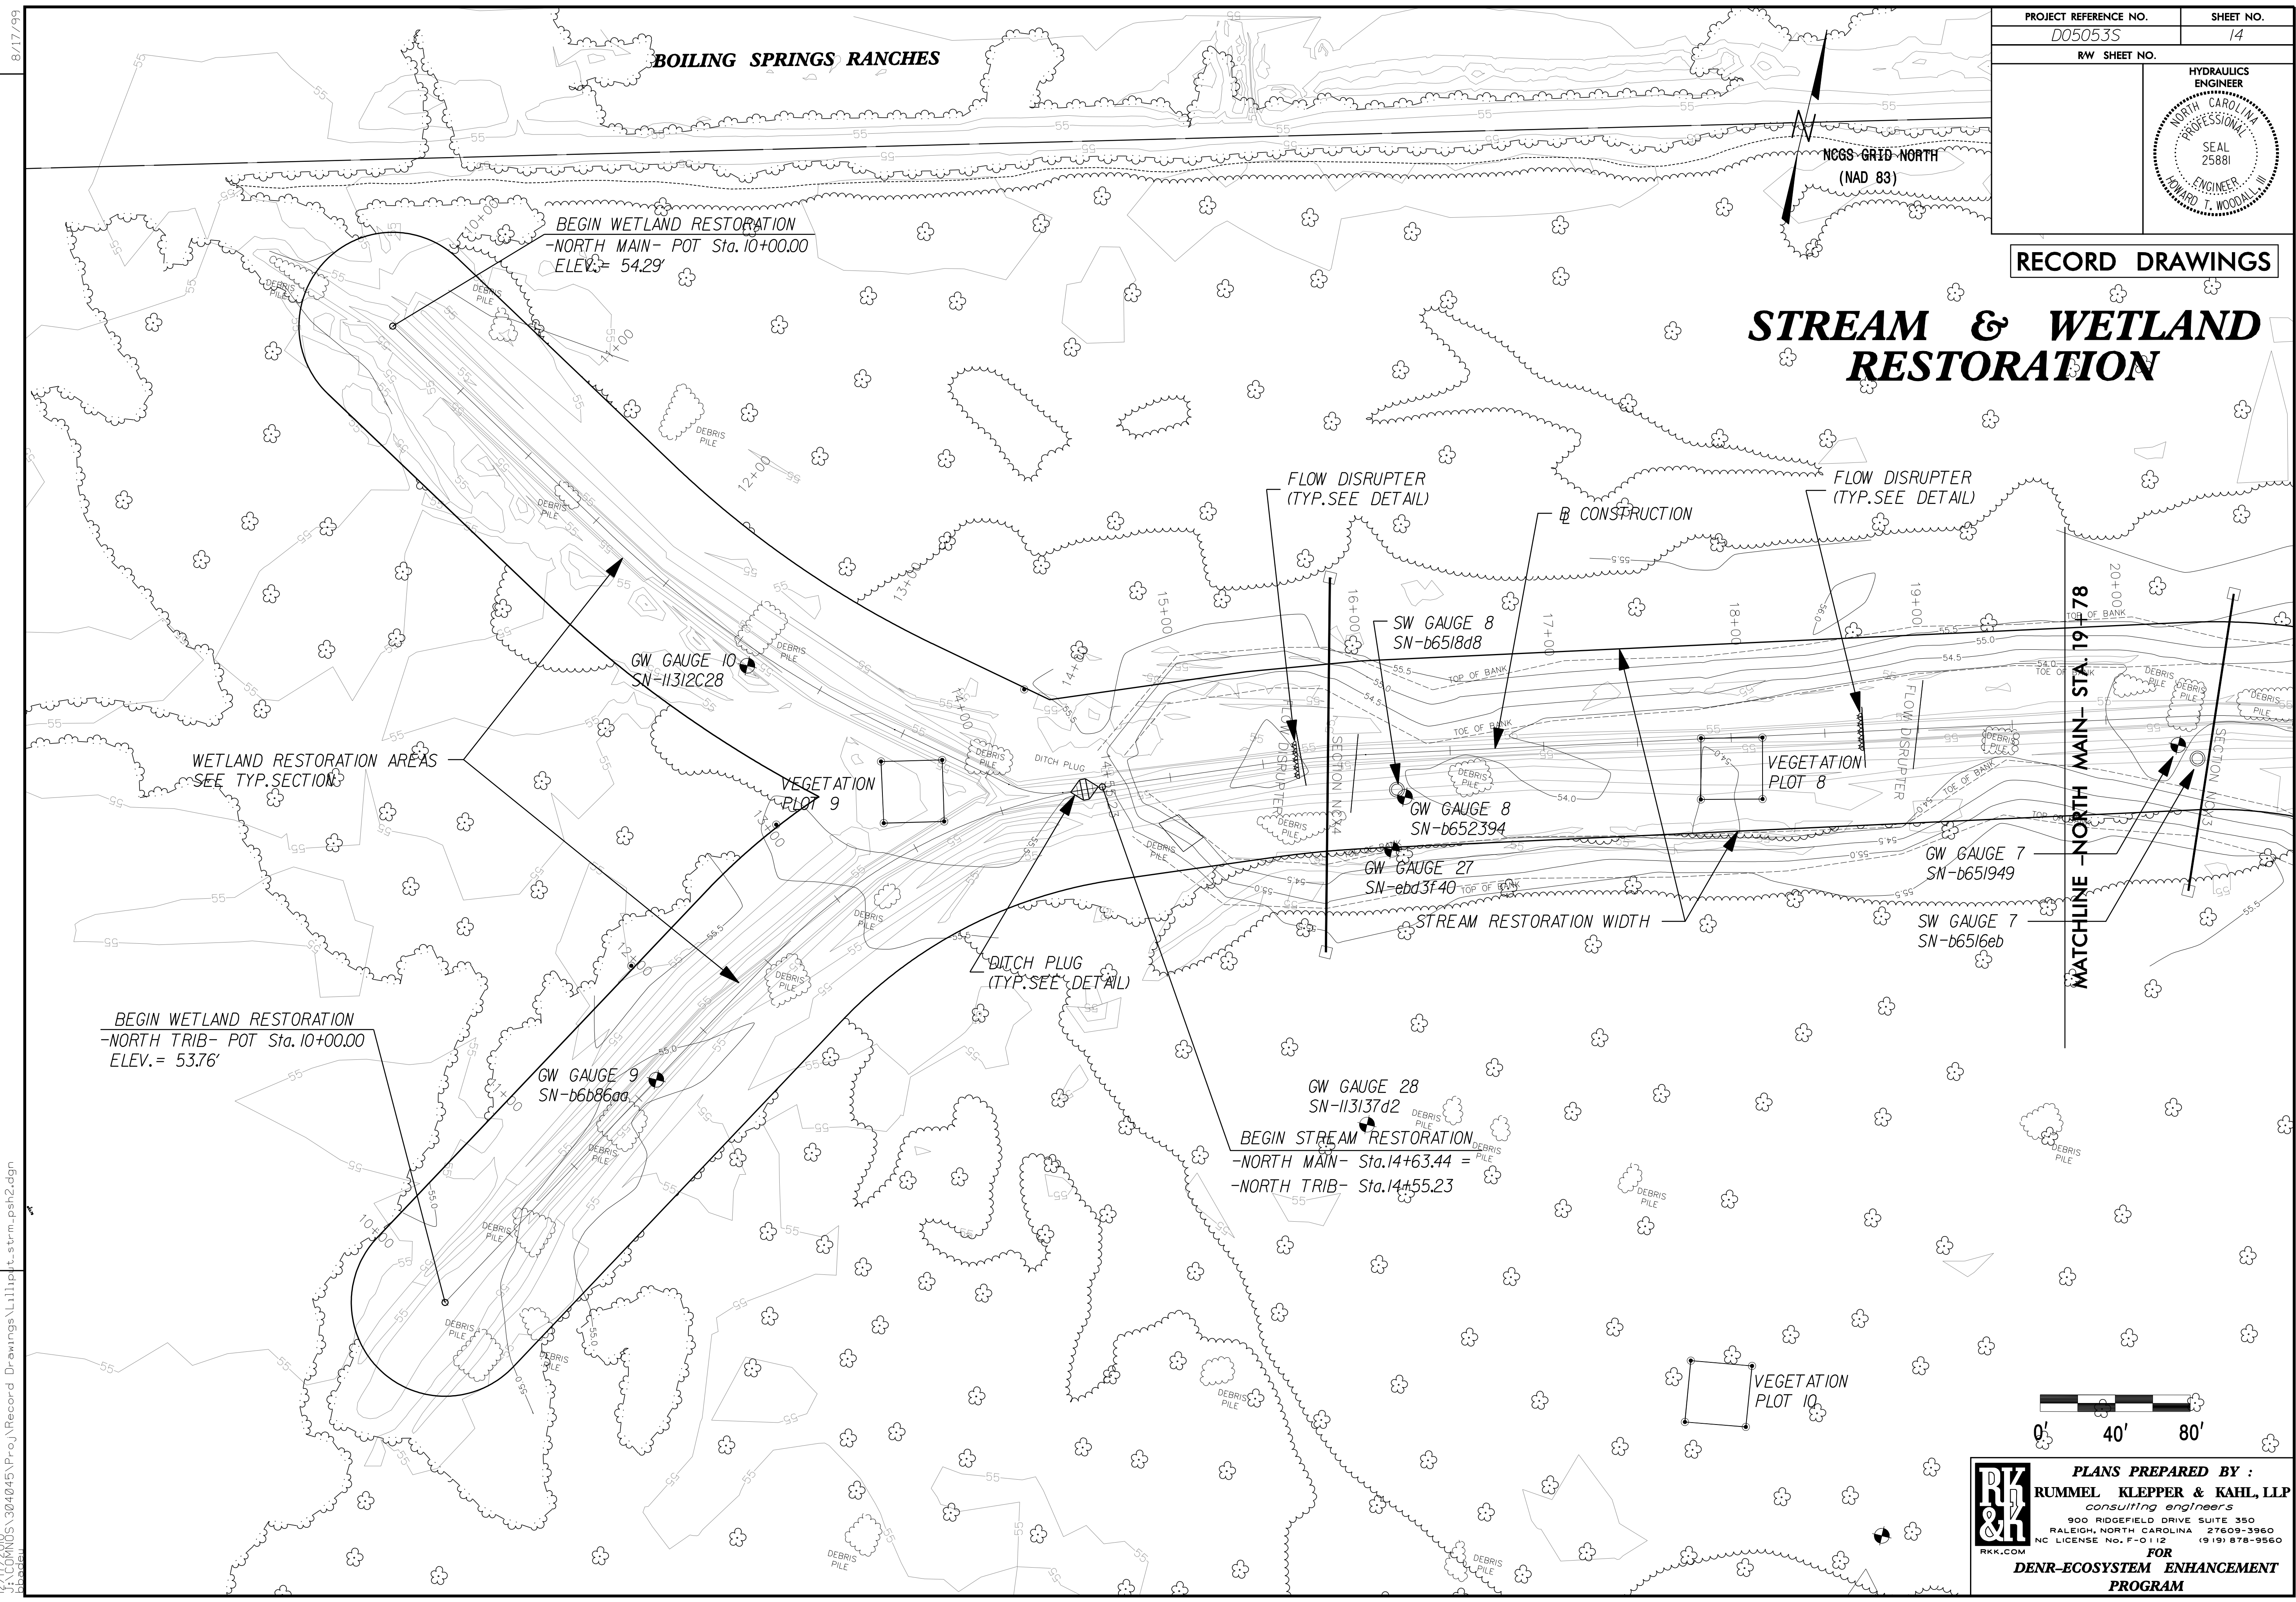

REVISIONS


8/17/99

\\c:\p000\304045\Proj\Record Drawings\11\11pl1.t-1.st-m_psh2.dgn

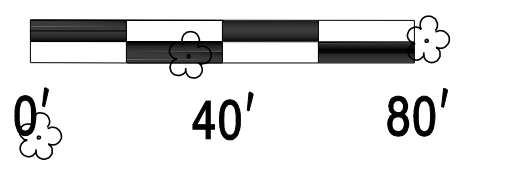

PLANS PREPARED BY :
RUMMEL, KLEPPER & KAHL, LLP
consulting engineers
 900 RIDGEFIELD DRIVE SUITE 350
 RALEIGH, NORTH CAROLINA 27609-3960
 NC LICENSE NO. F-0112 (919) 878-9560
 FOR
DENR-ECOSYSTEM ENHANCEMENT PROGRAM

RECORD DRAWINGS

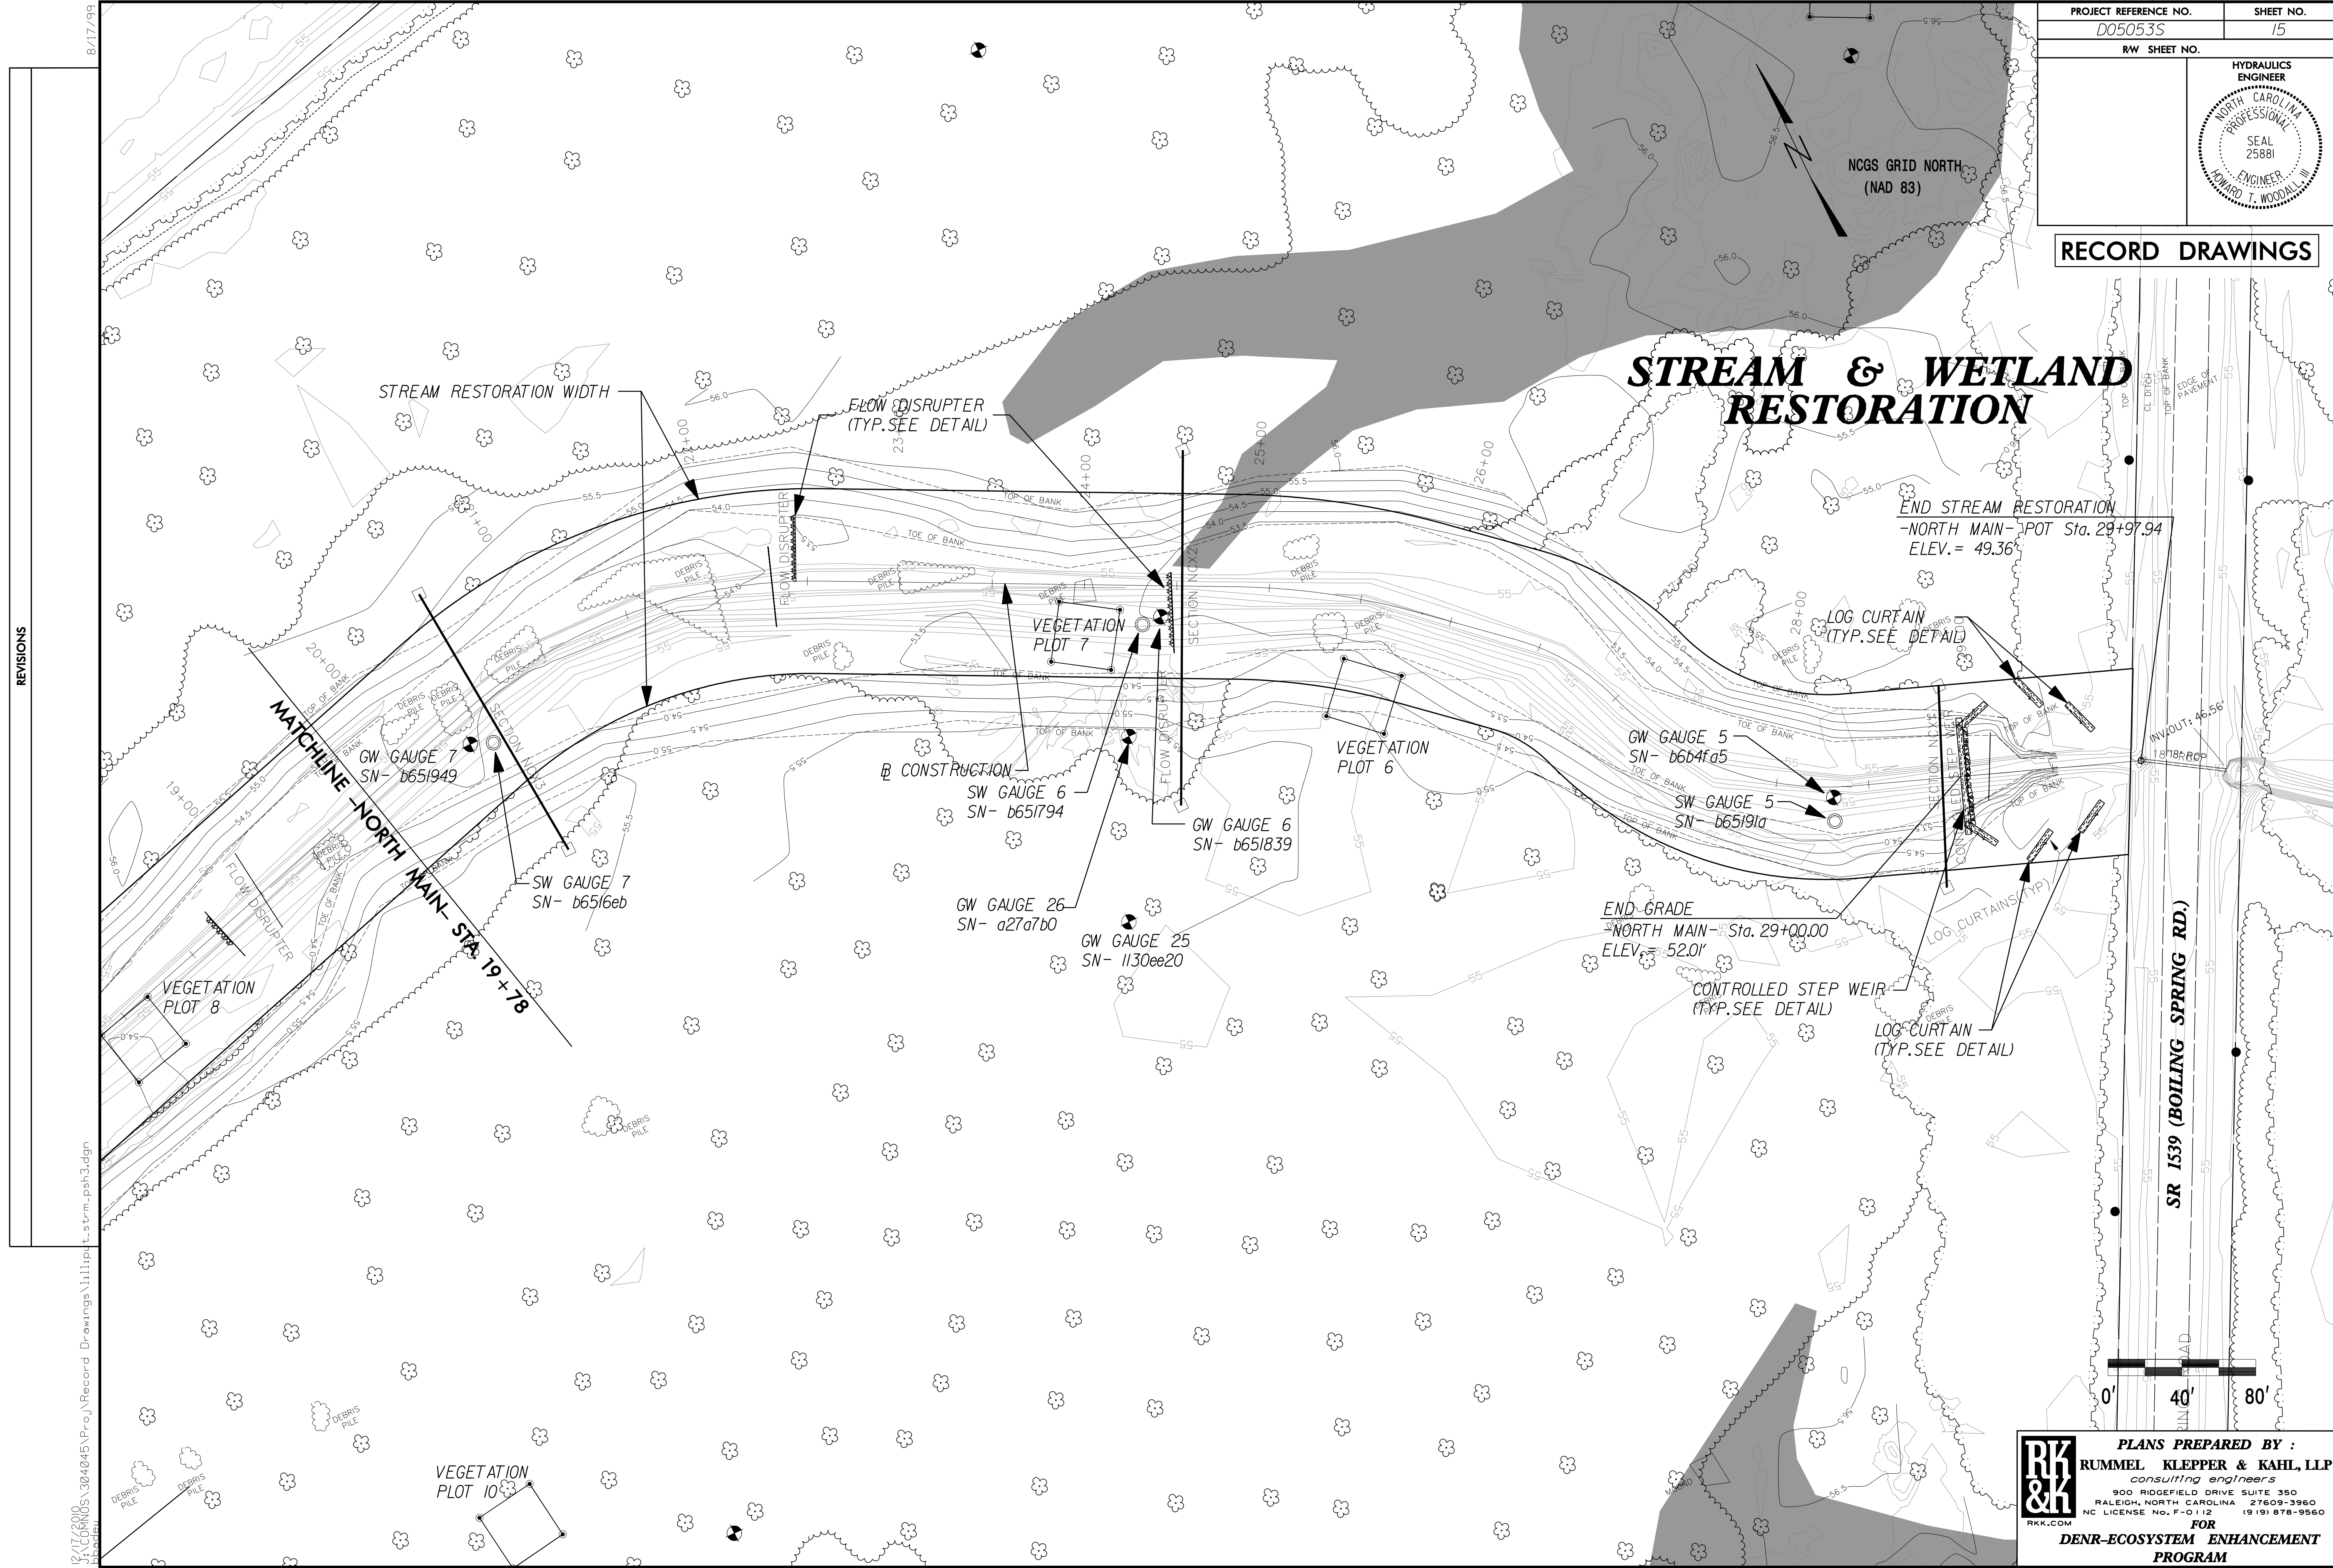

REVISIONS

8/17/99


\\c:\work\304045\Proj\Record Drawings\1111\1111.t...strm_psh3.dgn

PLANS PREPARED BY :
RK & K
RUMMEL KLEPPER & KAHL, LLP
consulting engineers
 900 RIDGEFIELD DRIVE SUITE 350
 RALEIGH, NORTH CAROLINA 27609-3960
 NC LICENSE NO. F-0112 (919) 878-9560
 FOR
DENR-ECOSYSTEM ENHANCEMENT PROGRAM

PROJECT REFERENCE NO. D05053S	SHEET NO. 16
RW SHEET NO.	
HYDRAULICS ENGINEER NORTH CAROLINA PROFESSIONAL SEAL 25881 ENGINEER HOWARD T. WOODALL III	

RECORD DRAWINGS

STREAM & WETLAND RESTORATION

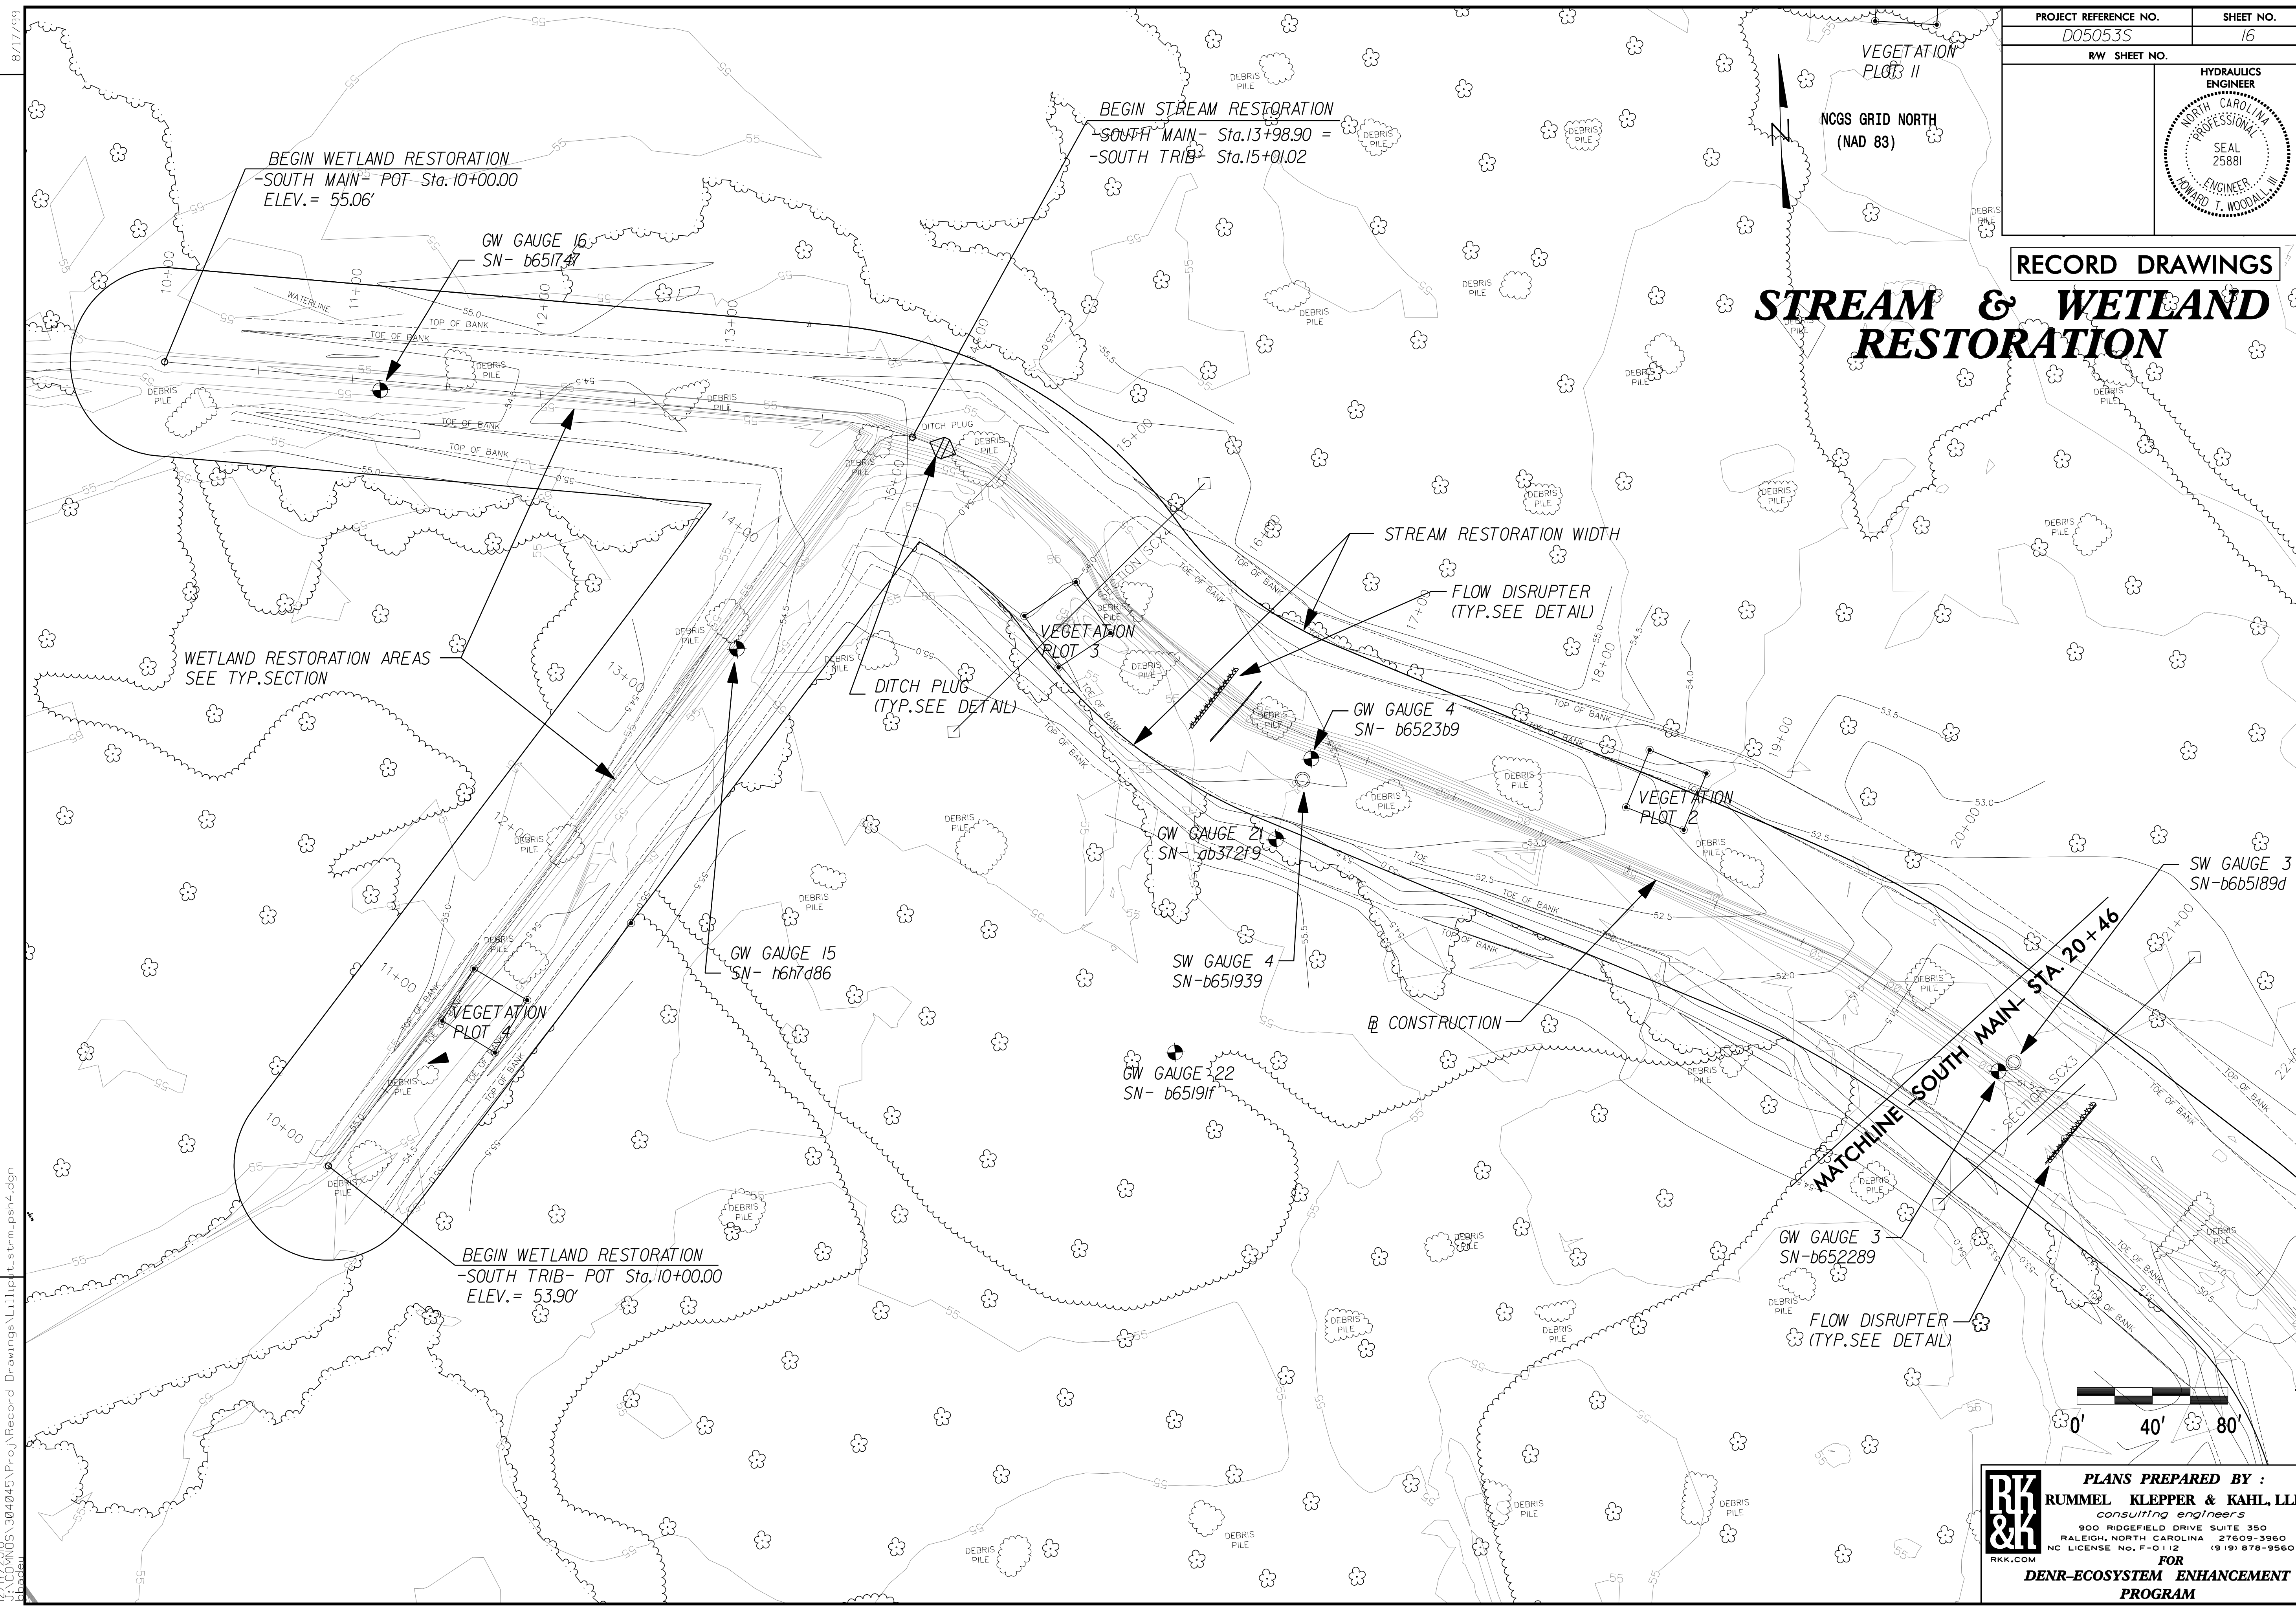



REVISIONS

8/17/99
C:\COMDS\304045\Proj\Record Drawings\11\11pl1.t.st.m_pah4.dgn

PLANS PREPARED BY :
RRK & K
RUMMEL KLEPPER & KAHL, LLP
consulting engineers
 900 RIDGEFIELD DRIVE SUITE 350
 RALEIGH, NORTH CAROLINA 27609-3960
 NC LICENSE NO. F-0112 (919) 878-9560
 FOR
DENR-ECOSYSTEM ENHANCEMENT PROGRAM

RECORD DRAWINGS

STREAM RESTORATION

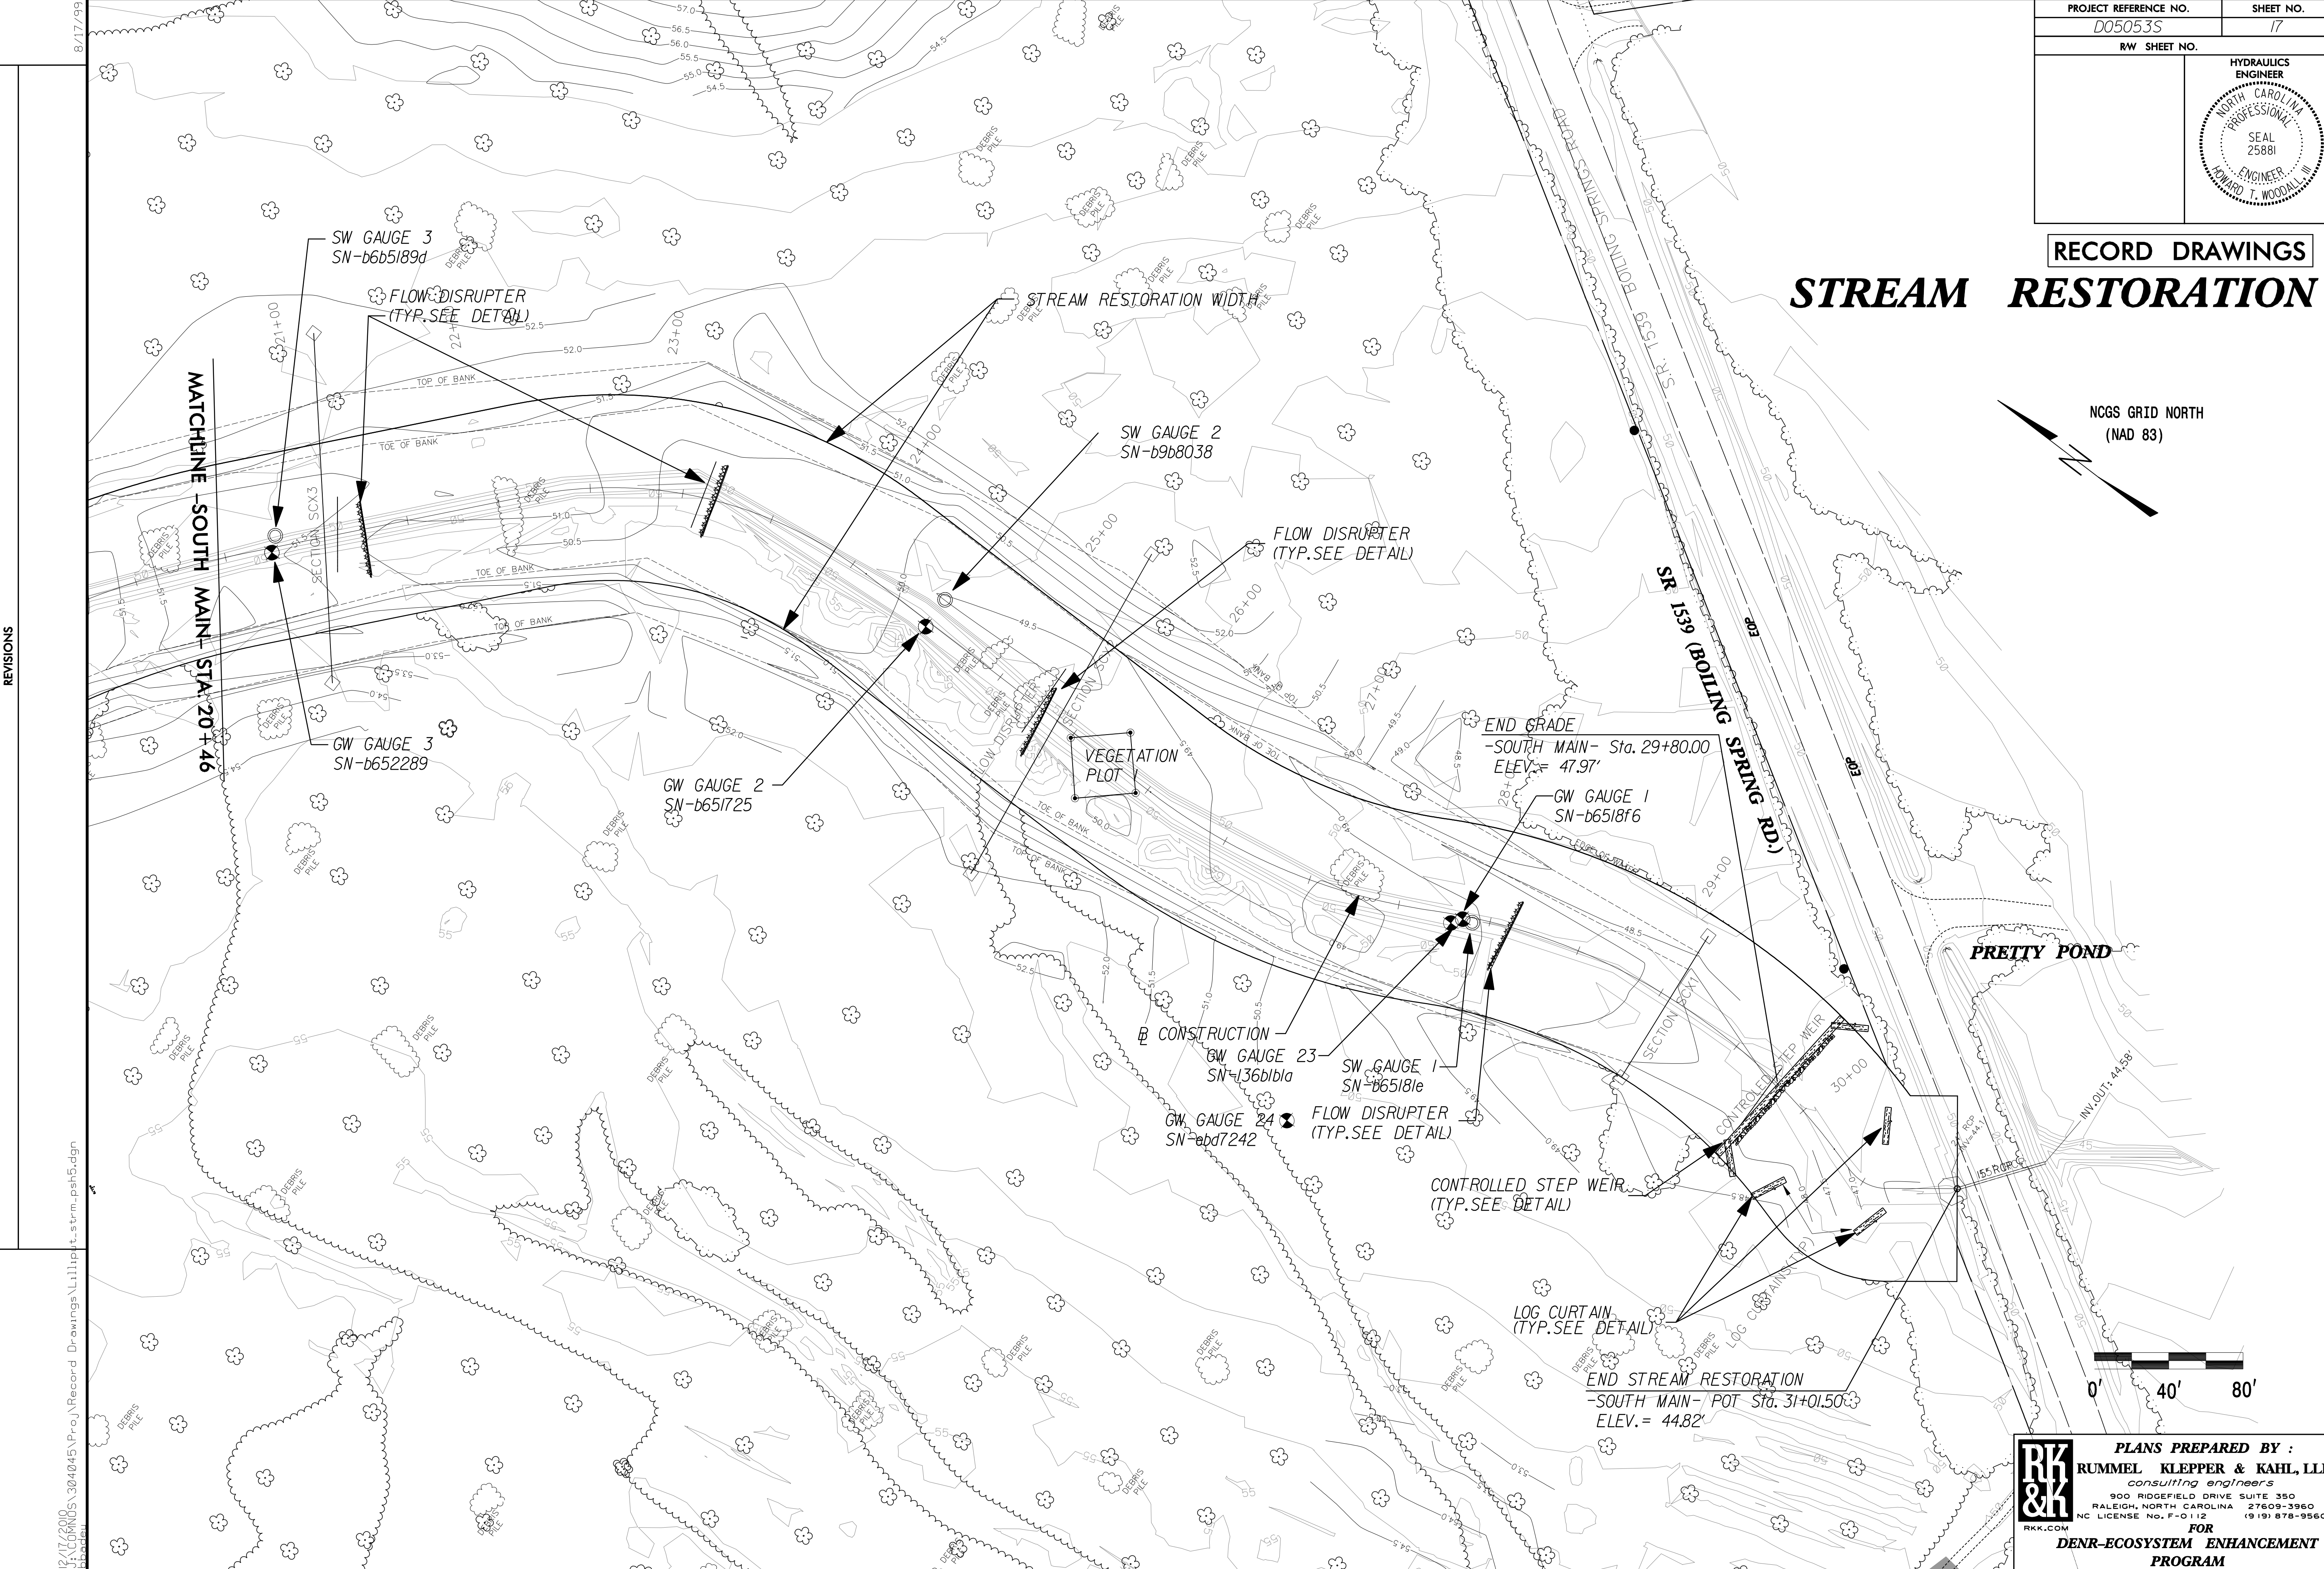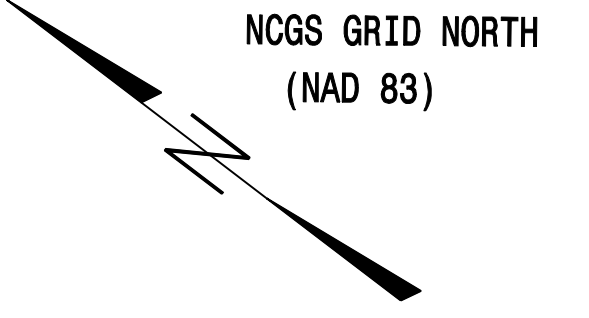

REVISIONS

8/17/99

I:\COMDS\304045\Proj\Record Drawings\Lilipit\l-st-m_pah5.dgn




PLANS PREPARED BY :
RUMMEL, KLEPPER & KAHL, LLP
consulting engineers
 900 RIDGEFIELD DRIVE SUITE 350
 RALEIGH, NORTH CAROLINA 27609-3960
 NC LICENSE NO. F-0112 (919) 878-9560
FOR
DENR-ECOSYSTEM ENHANCEMENT PROGRAM


PROJECT REFERENCE NO. D050535	SHEET NO. 18
ROADWAY DESIGN ENGINEER	HYDRAULICS ENGINEER NORTH CAROLINA PROFESSIONAL SEAL 25881 EDWARD T. WOODALL III

RECORD DRAWINGS

-NORTH MAIN- PROFILE

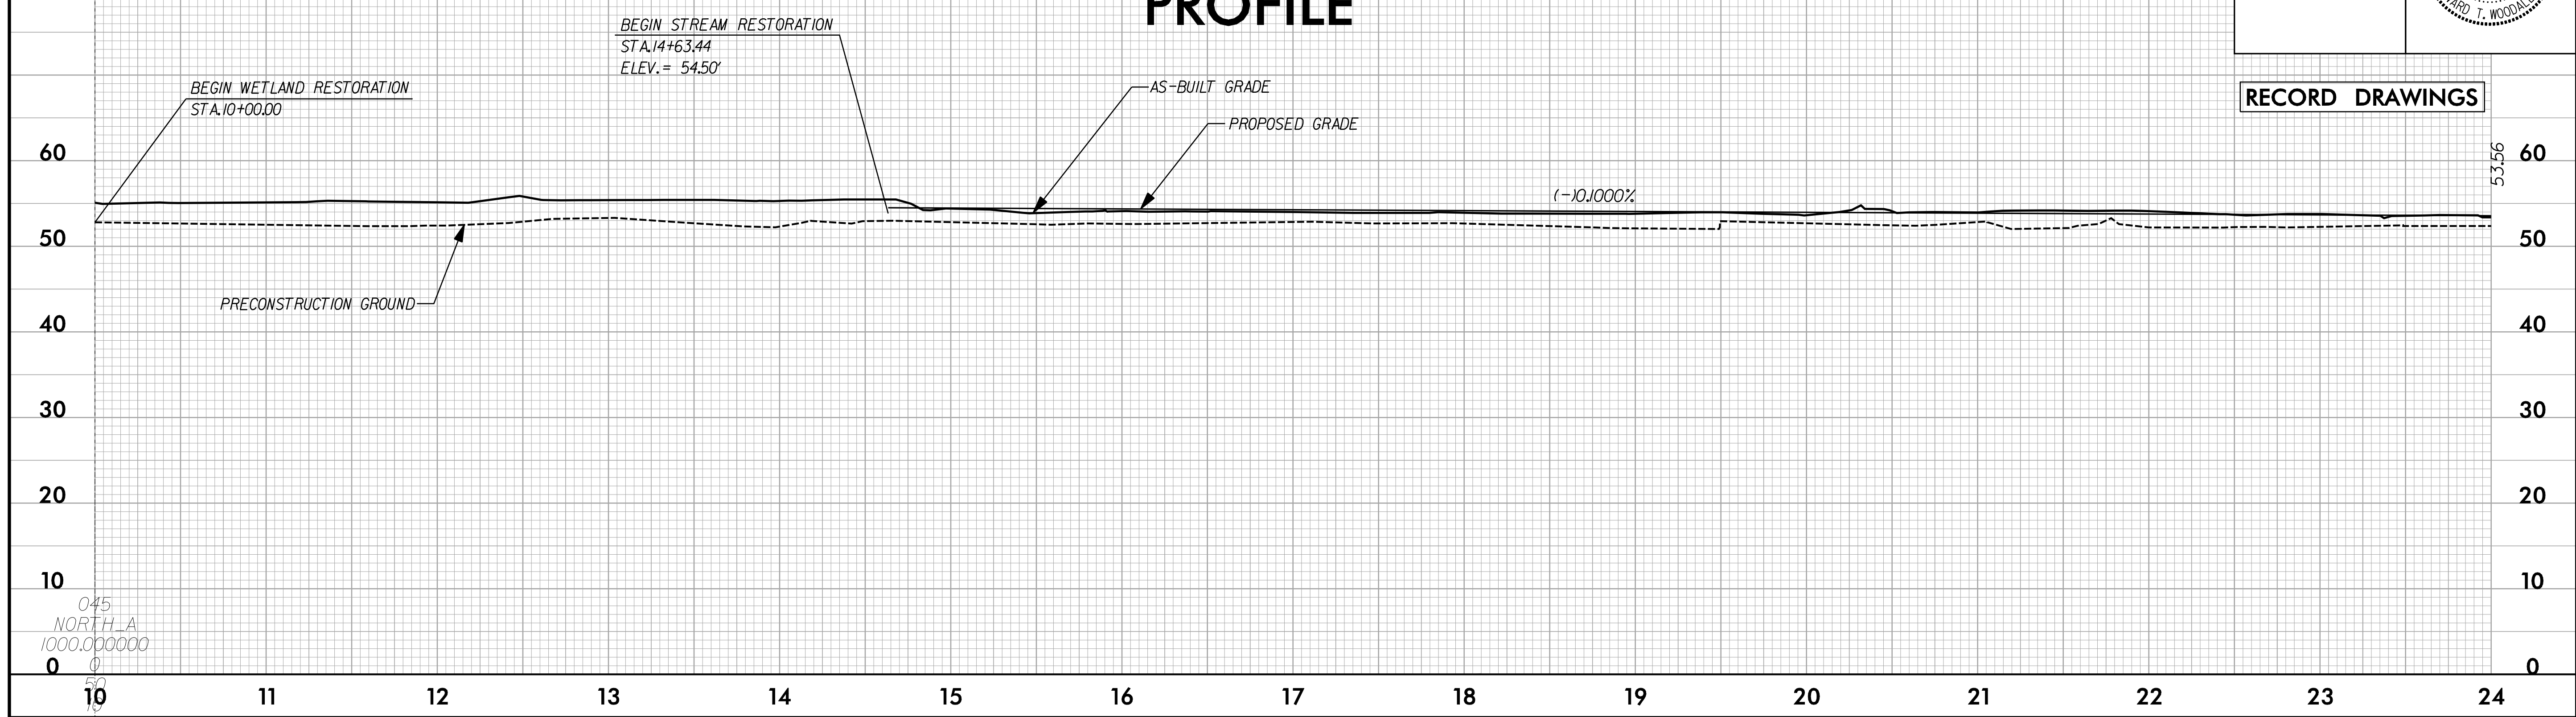

-NORTH MAIN- PROFILE

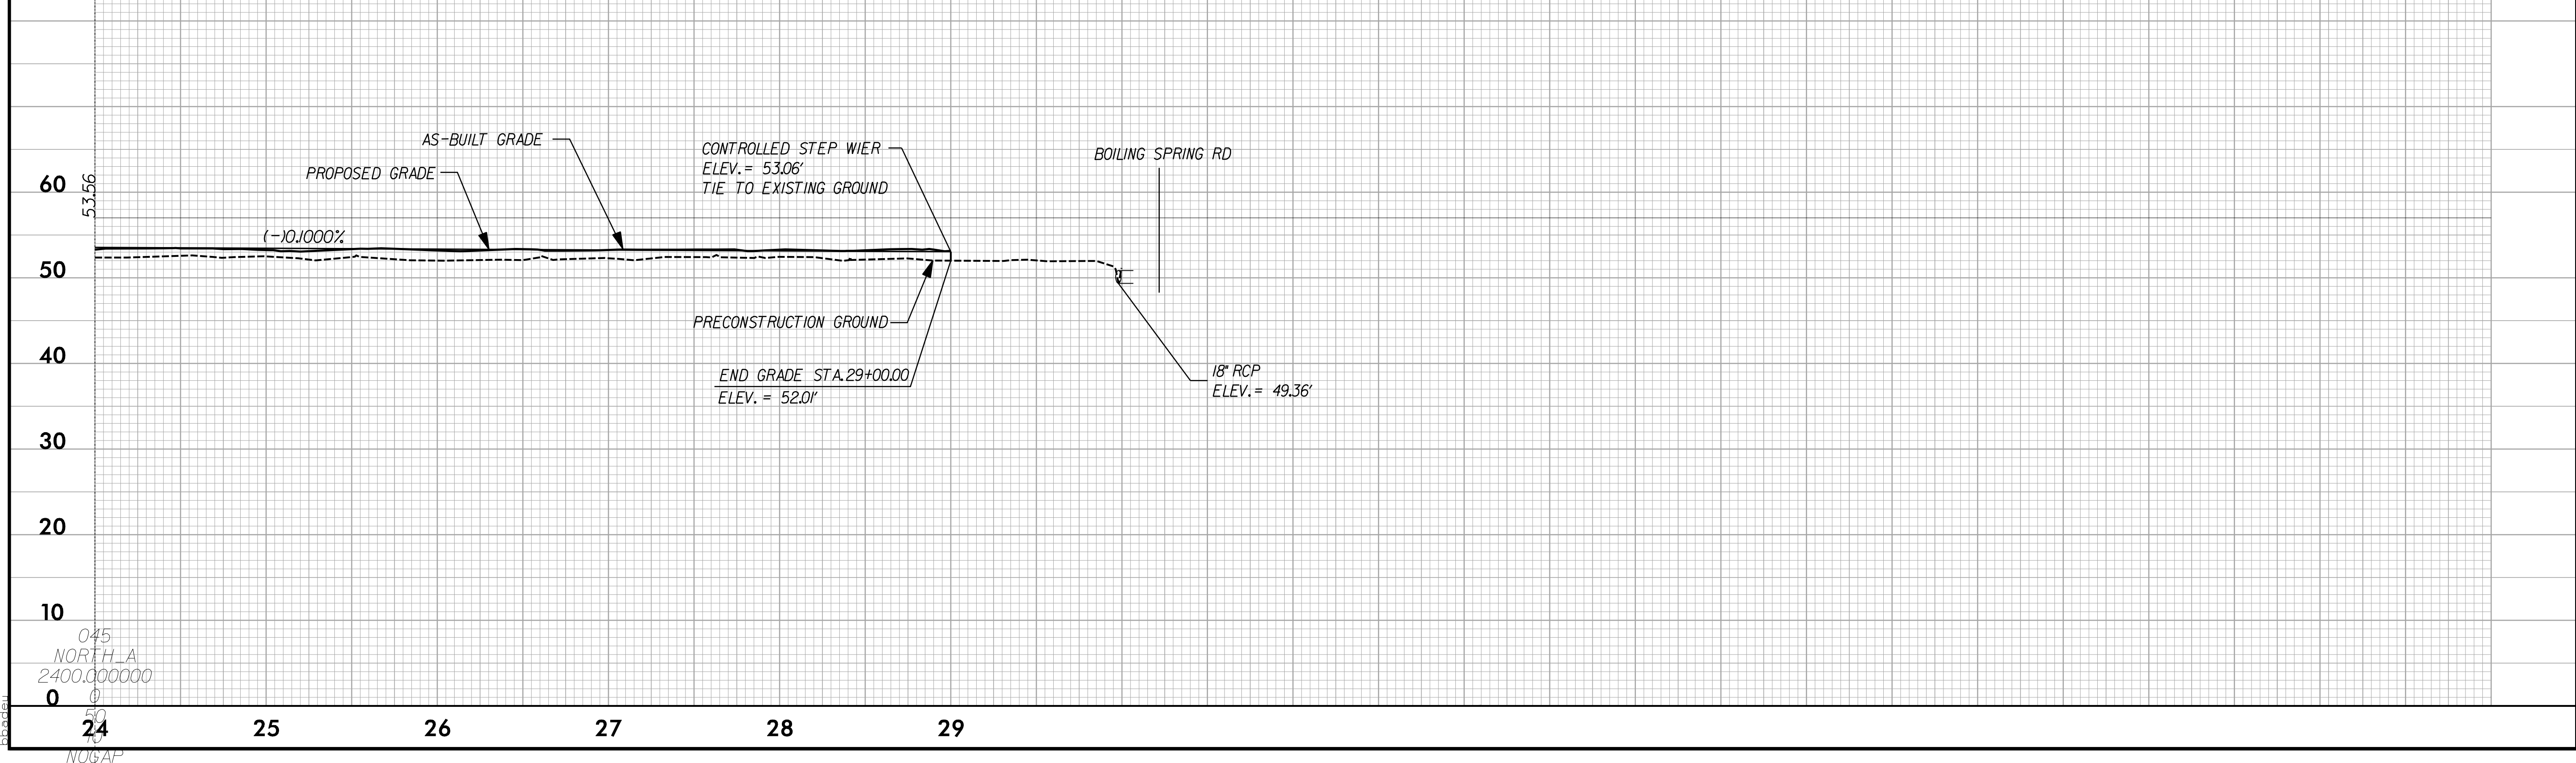

I:\Projects\2010\304045\Proj\Record Drawings\11\input_strm_pf1.dgn


045
NORTH_A
1000.000000
0

045
NORTH_A
2400.000000
0


RECORD DRAWINGS

PI = 23+00.00
EL = 50.35'

-SOUTH MAIN- PROFILE

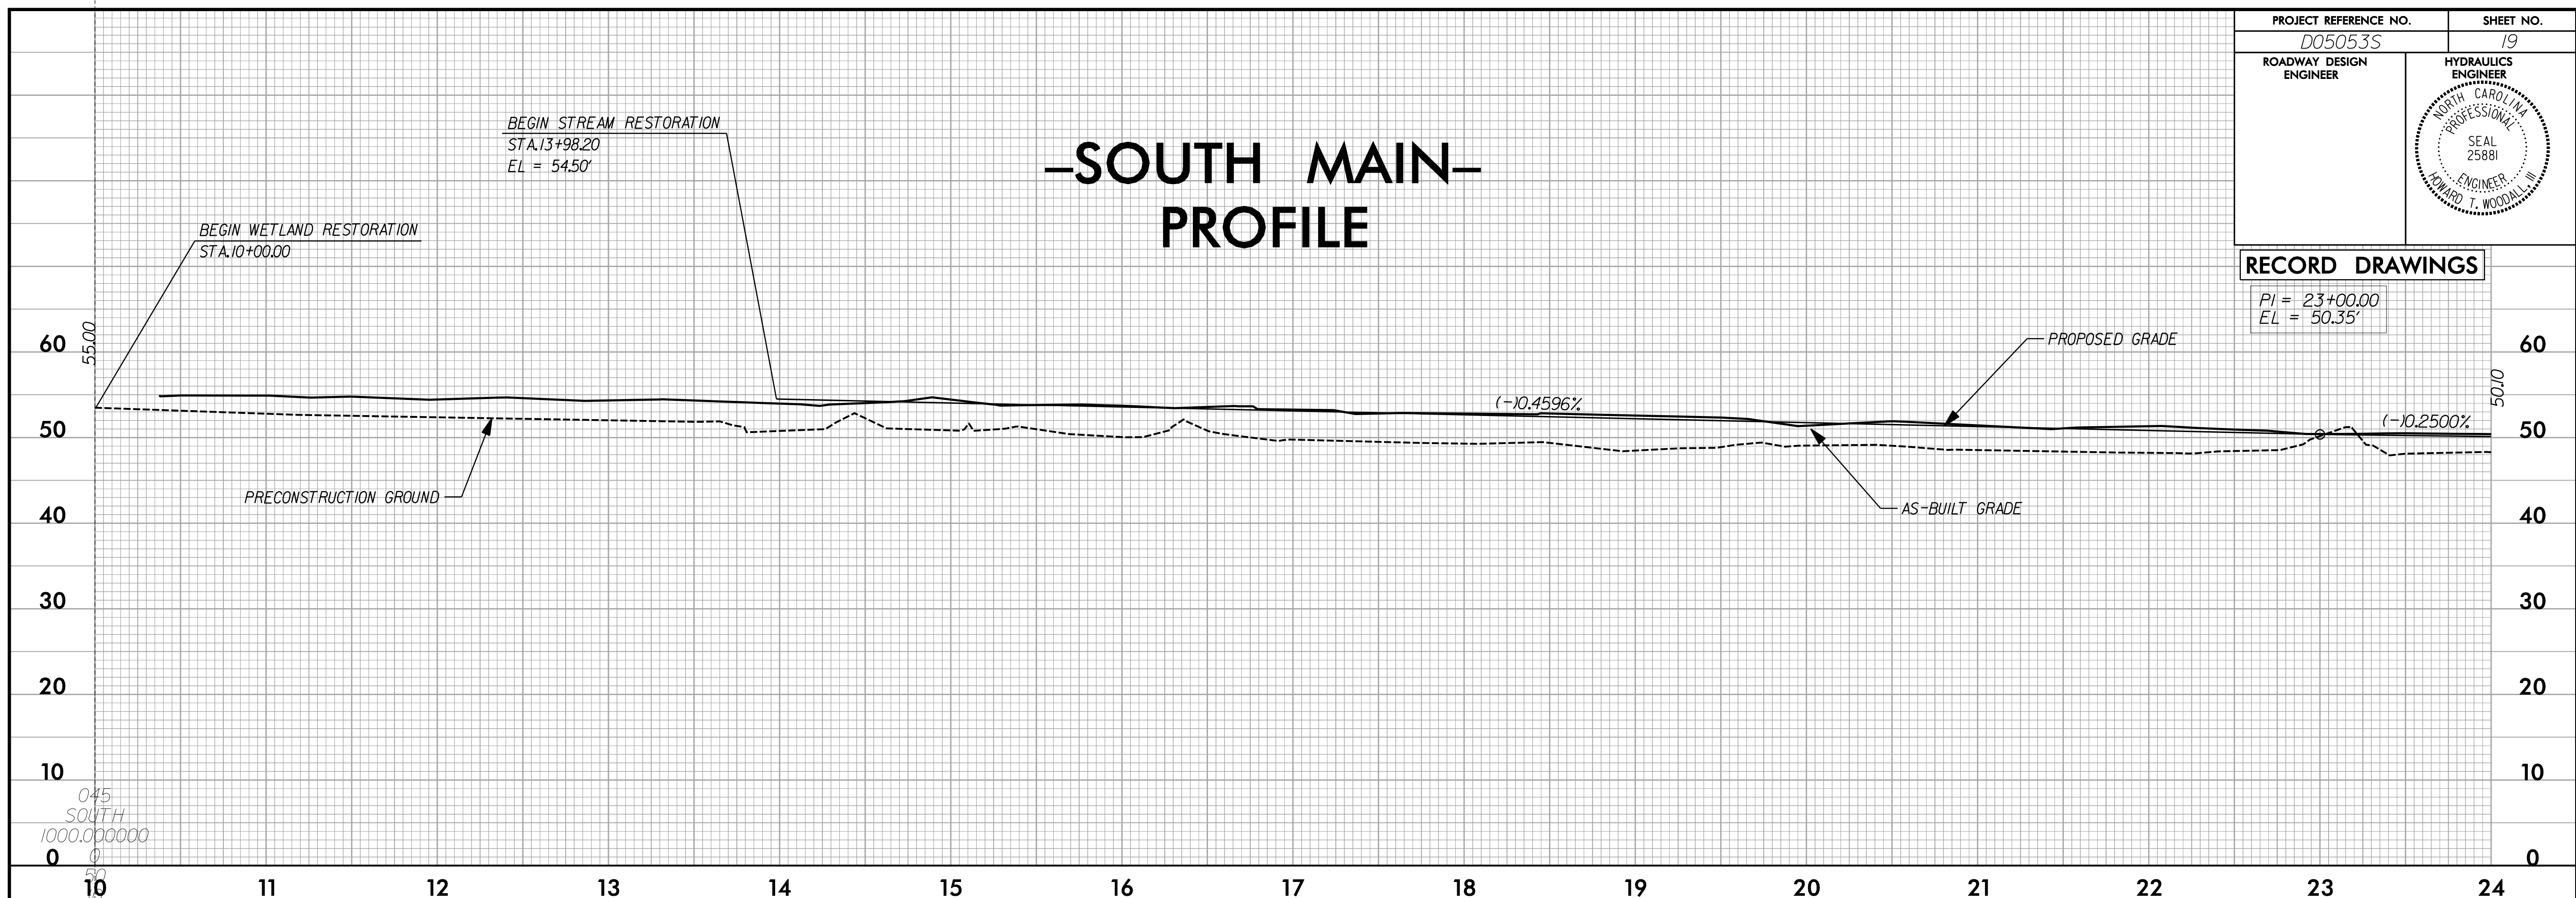

-SOUTH MAIN- PROFILE

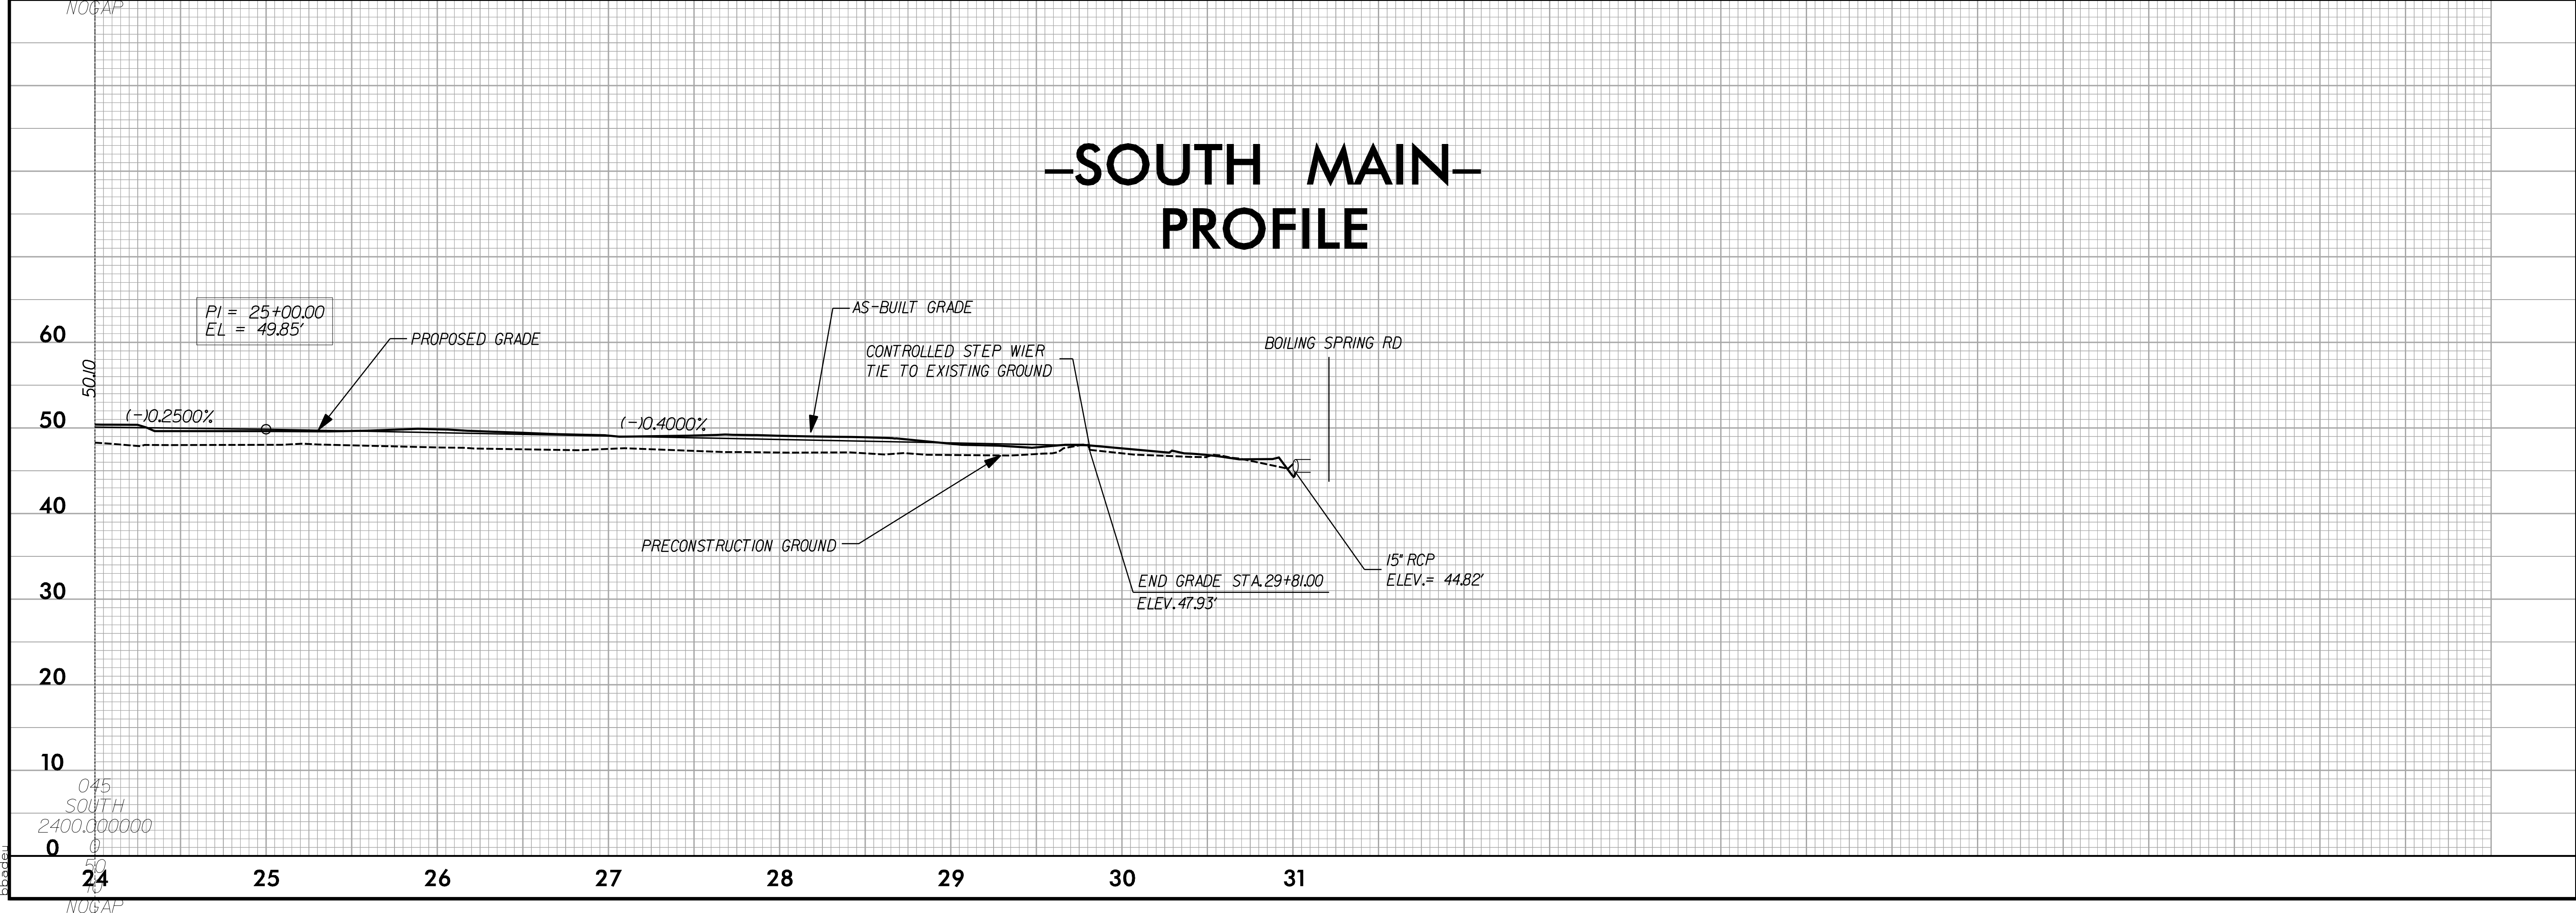


I:\Projects\2010\304045\Proj\Record Drawings\11\input_strm_pf1.dgn
 045 SOUTH 2400.000000
 0

ECOSYSTEM ENHANCEMENT PROGRAM


STATE	DENR CONTRACT NO.	SHEET NO.	TOTAL SHEETS
N.C.	D05053S	PL-1	5

PLANTING PLAN

LOCATION: SR 1539 (BOILING SPRING RD.)
 TYPE OF WORK: STREAM & WETLAND RESTORATION

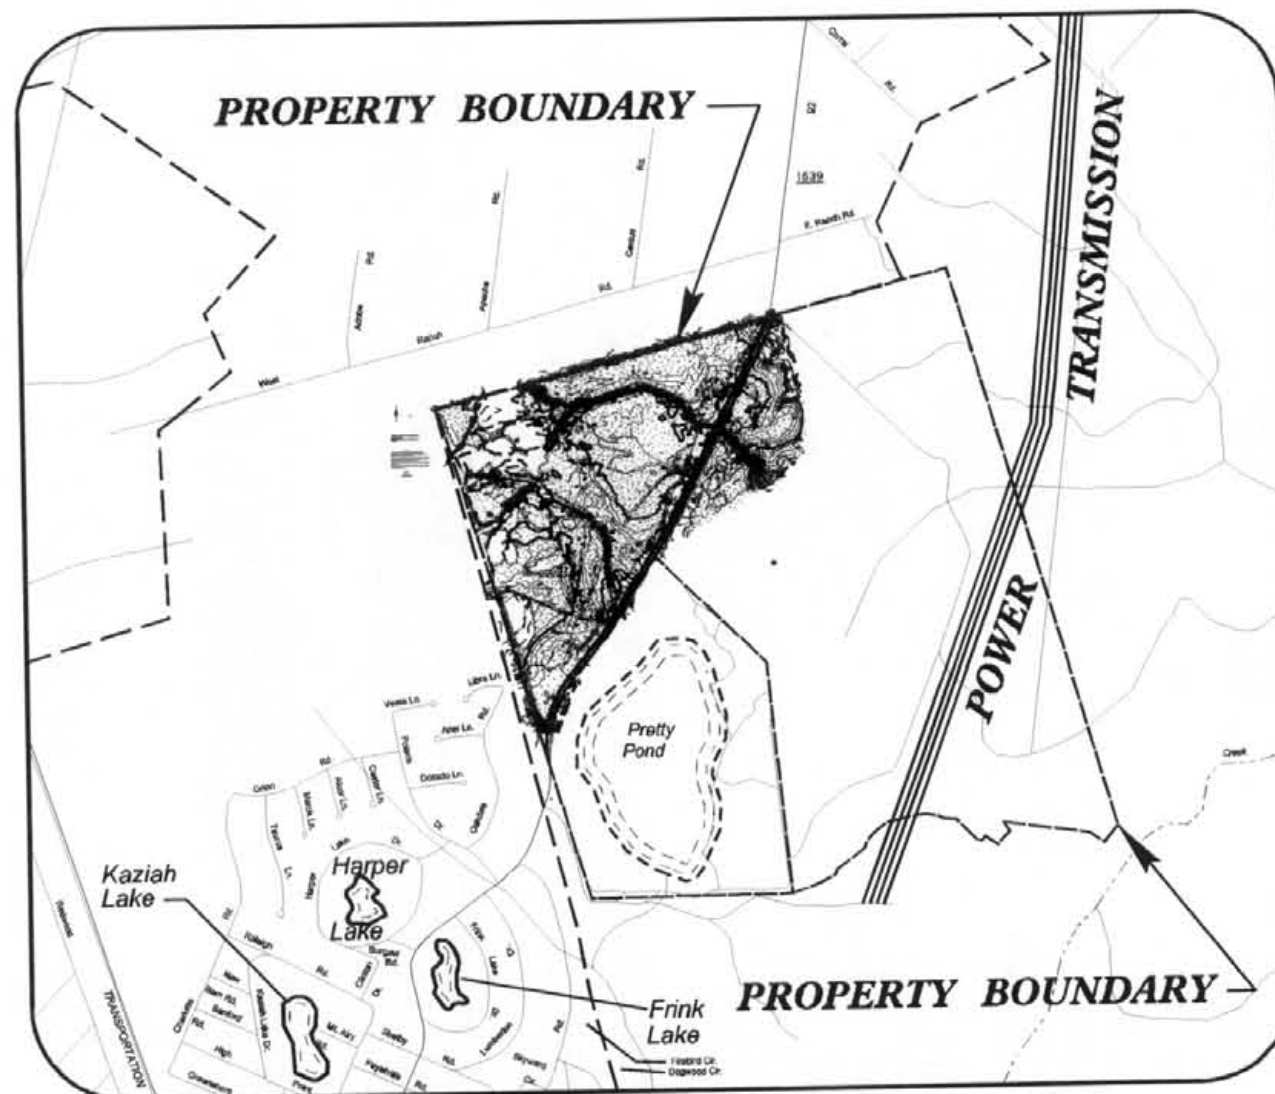

VICINITY MAP

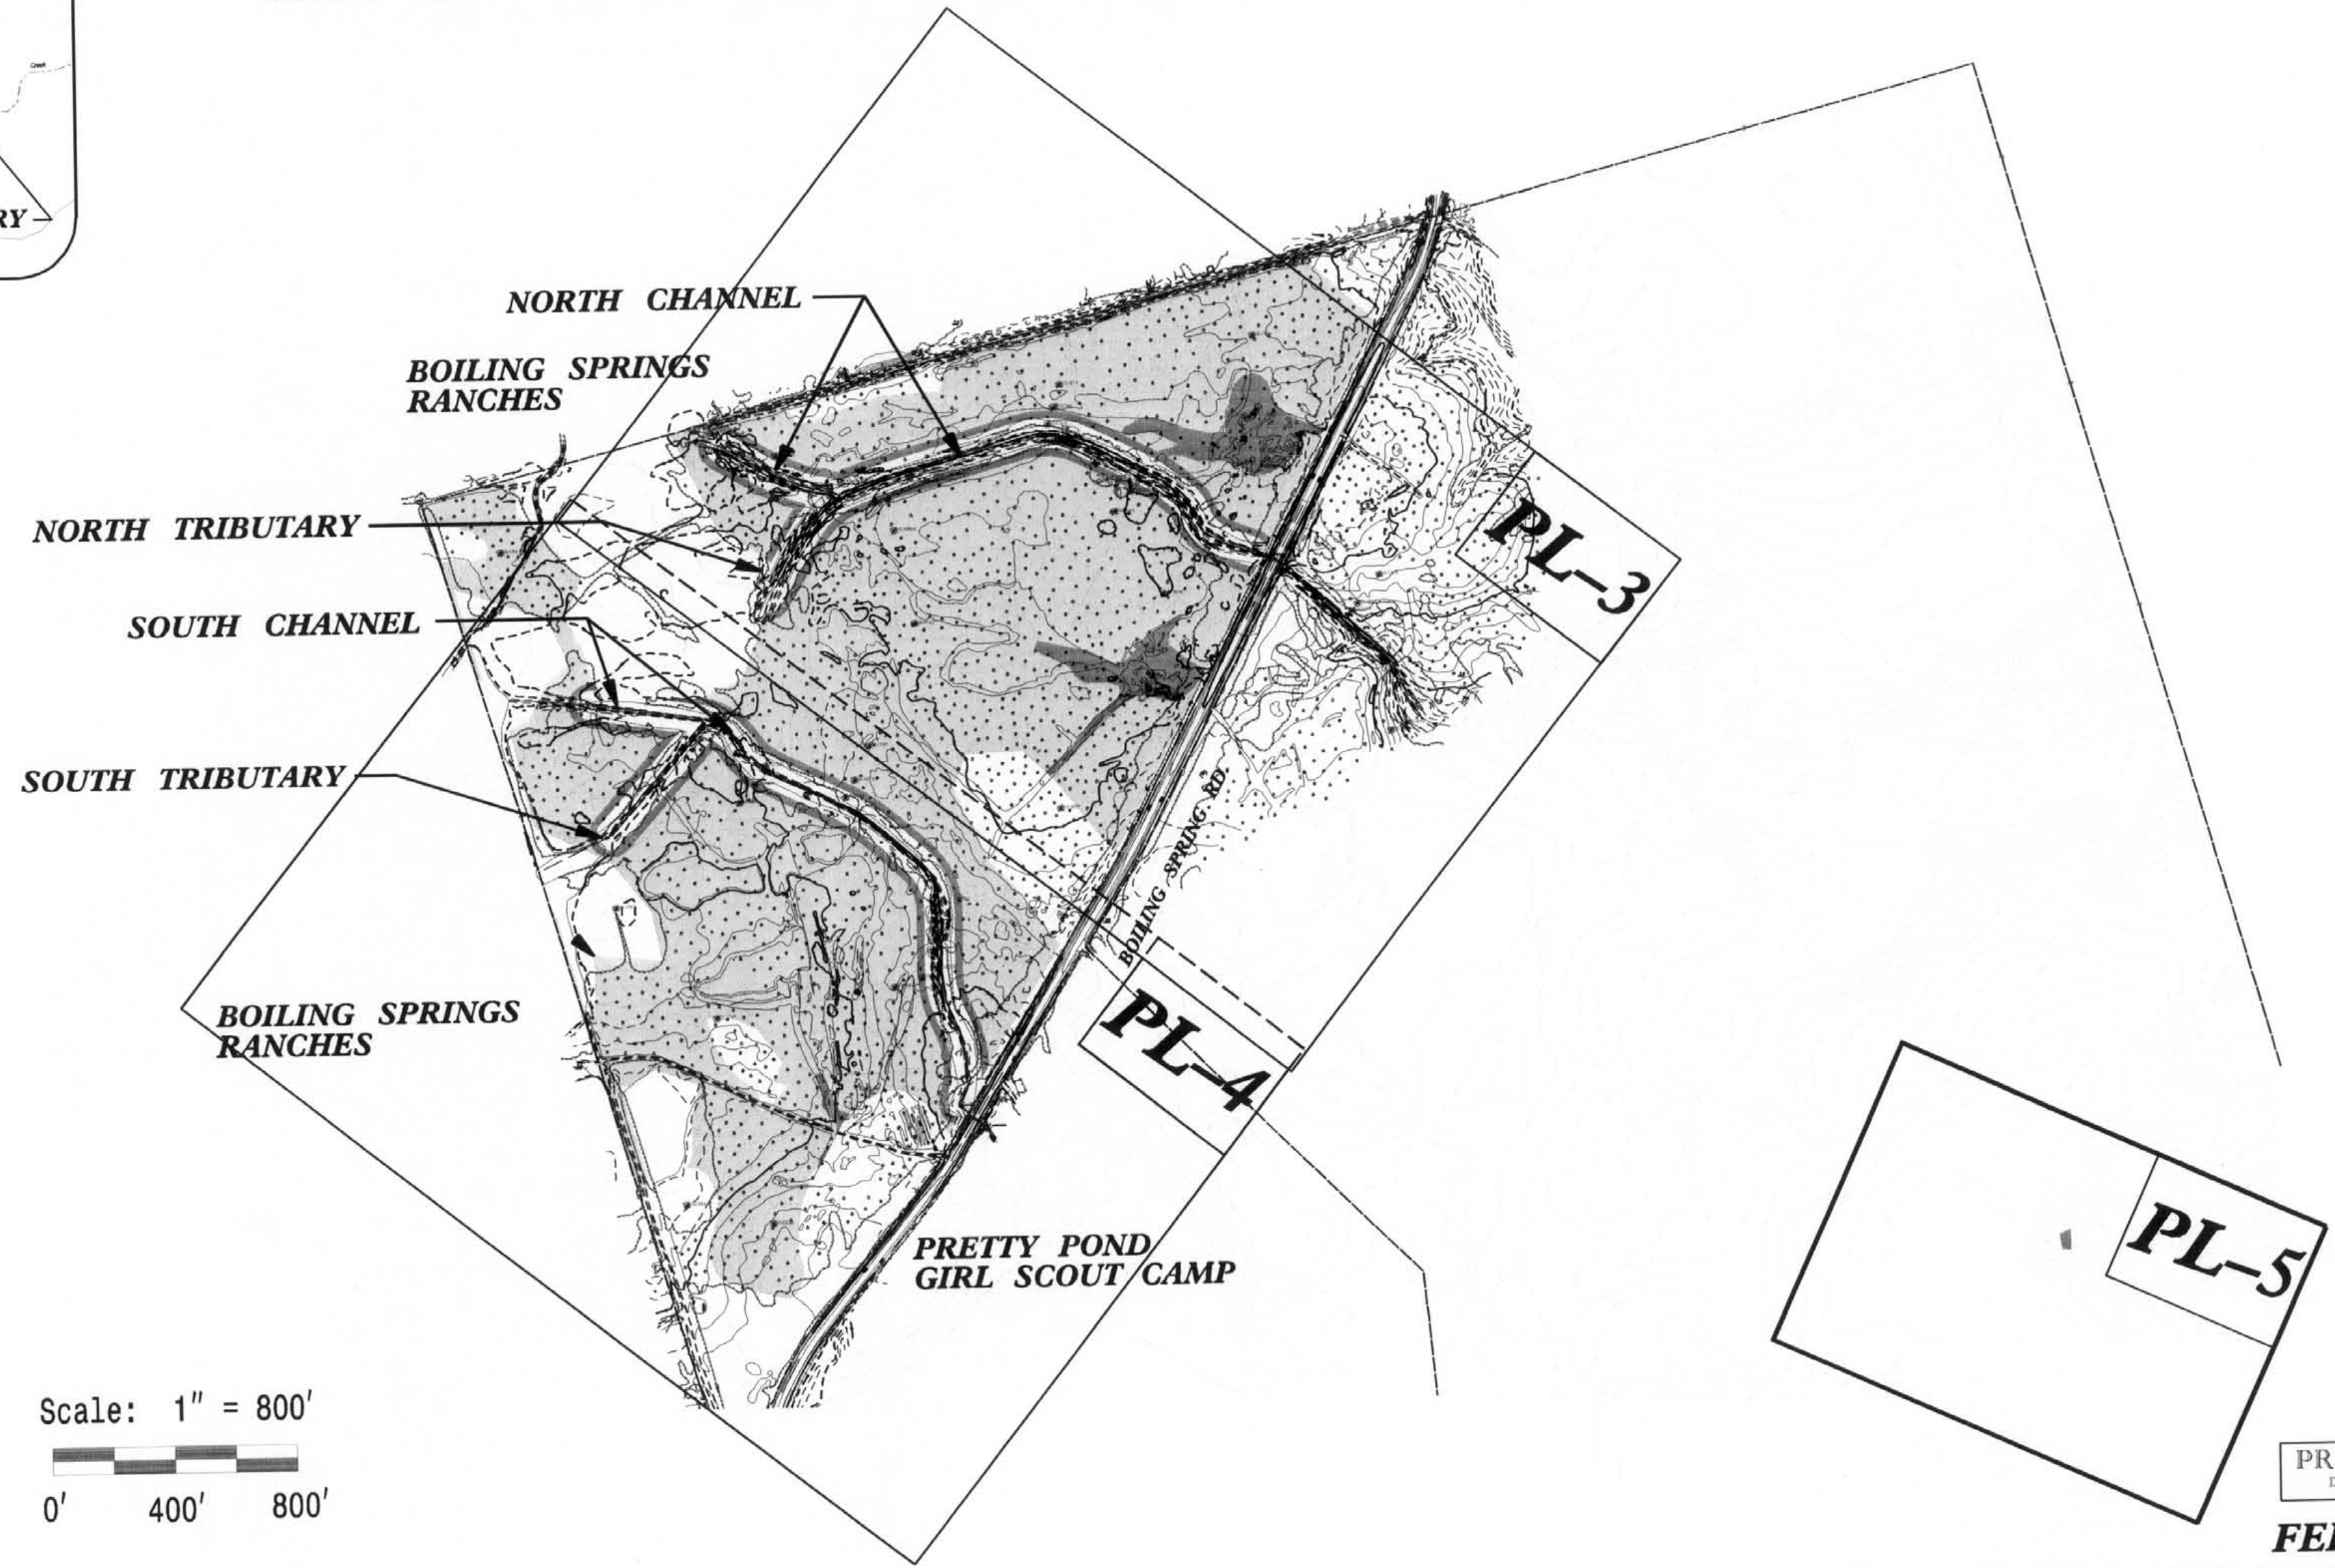

Scale: 1" = 800'
 0' 400' 800'

PRELIMINARY PLANS
 DO NOT USE FOR CONSTRUCTION
 FEBRUARY 1, 2007

DENR CONTRACT: D05053S

INDEX OF SHEETS

SHEET NO.	DESCRIPTION
PL-1	TITLE
PL-1A	SPECIFICATIONS
PL-2	DETAILS
PL-3 THRU PL-5	PLANTING PLANS



PLANS PREPARED BY :
 RUMMEL • KLEPPER & KAHL, LLP
 consulting engineers
 900 RIDGEFIELD DRIVE SUITE 350
 RALEIGH, NORTH CAROLINA 27609-3960

FOR
 ECOSYSTEM ENHANCEMENT PROGRAM

KRISTIN MIGUEZ
 EEP PROJECT MANAGER

WYATT BROWN
 EEP REVIEW COORDINATOR

DESIGN ENGINEER


Signature: Howard T. Woodall III

WILLIAM E. STAFFORD
 PROJECT SCIENTIST

HOWARD T. WOODALL III, P.E.
 PROJECT DESIGN ENGINEER

04\01\08_09\43\26
 p:\compos\304045\proj\N\l\l\l\put_pint_tsh.dgn
 jeh


-PLANTING PLAN-

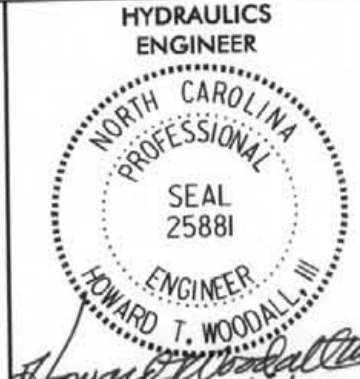PROJECT REFERENCE NO. D05053S	SHEET NO. PL-3
RW SHEET NO.	
HYDRAULICS ENGINEER	
	
PRELIMINARY PLANS DO NOT USE FOR CONSTRUCTION	


AREA	TYPE	PLANTING DESCRIPTION		PLANTING REQUIREMENTS
		AREA (AC)	TOTAL SEEDLINGS/AREA	
1	PINE SAVANNA	15.56	10,581	LONG LEAF PINE
2	PINE SAVANNA	1.42	966	STEMS SHALL BE PLACED 8 FT. X 8 FT. OR 1 STEM EVERY 64 SQ. FT. OR 680 STEMS PER ACRE.
3	PINE SAVANNA	30.71	20,883	
4	PINE SAVANNA	2.61	1,775	
5	WET PINE FLATWOODS	2.01	1,367	LONG LEAF PINE
6	WET PINE FLATWOODS	1.55	1,054	POND PINE
7	WET PINE FLATWOODS	1.12	762	STEMS SHALL BE PLACED 8 FT. X 8 FT. OR 1 STEM EVERY 64 SQ. FT. OR 680 STEMS PER ACRE.
8	WET PINE FLATWOODS	1.70	1,156	
9	COASTAL PLAIN SMALL STREAM SWAMP	5.36	3,645	BLACKGUM, POND PINE, LAUREL OAK, OVERCUP OAK, SWEETBAY STEM SHALL BE PLACED 8 FT. X 8 FT. OR 1 STEM EVERY 64 SQ. FT. OR 680 STEMS PER ACRE. USE CONTAINERIZED SEEDLINGS ONLY.

- NOTES:
1. EVENLY DISTRIBUTE NUMBER OF SEEDLING TYPES +/- 5% PER SPECIES
 2. PLANTING REQUIRED ONLY IN THE AREAS SHADED OR HATCHED.

WET PINE FLATWOODS

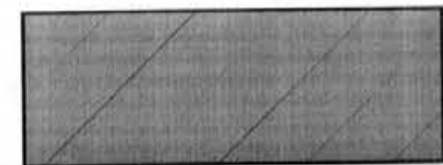

PINE SAVANNA

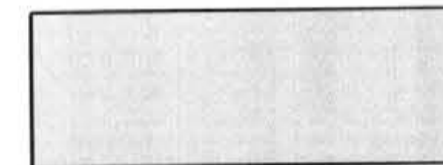


COASTAL PLAIN SMALL STREAM SWAMP



SEE SHEET PL-2 FOR POINT DESCRIPTIONS

04-01-08 09:44:48 h:\comica_30404\pre\1\1\input_plans\psnl.dgn

REVISIONS

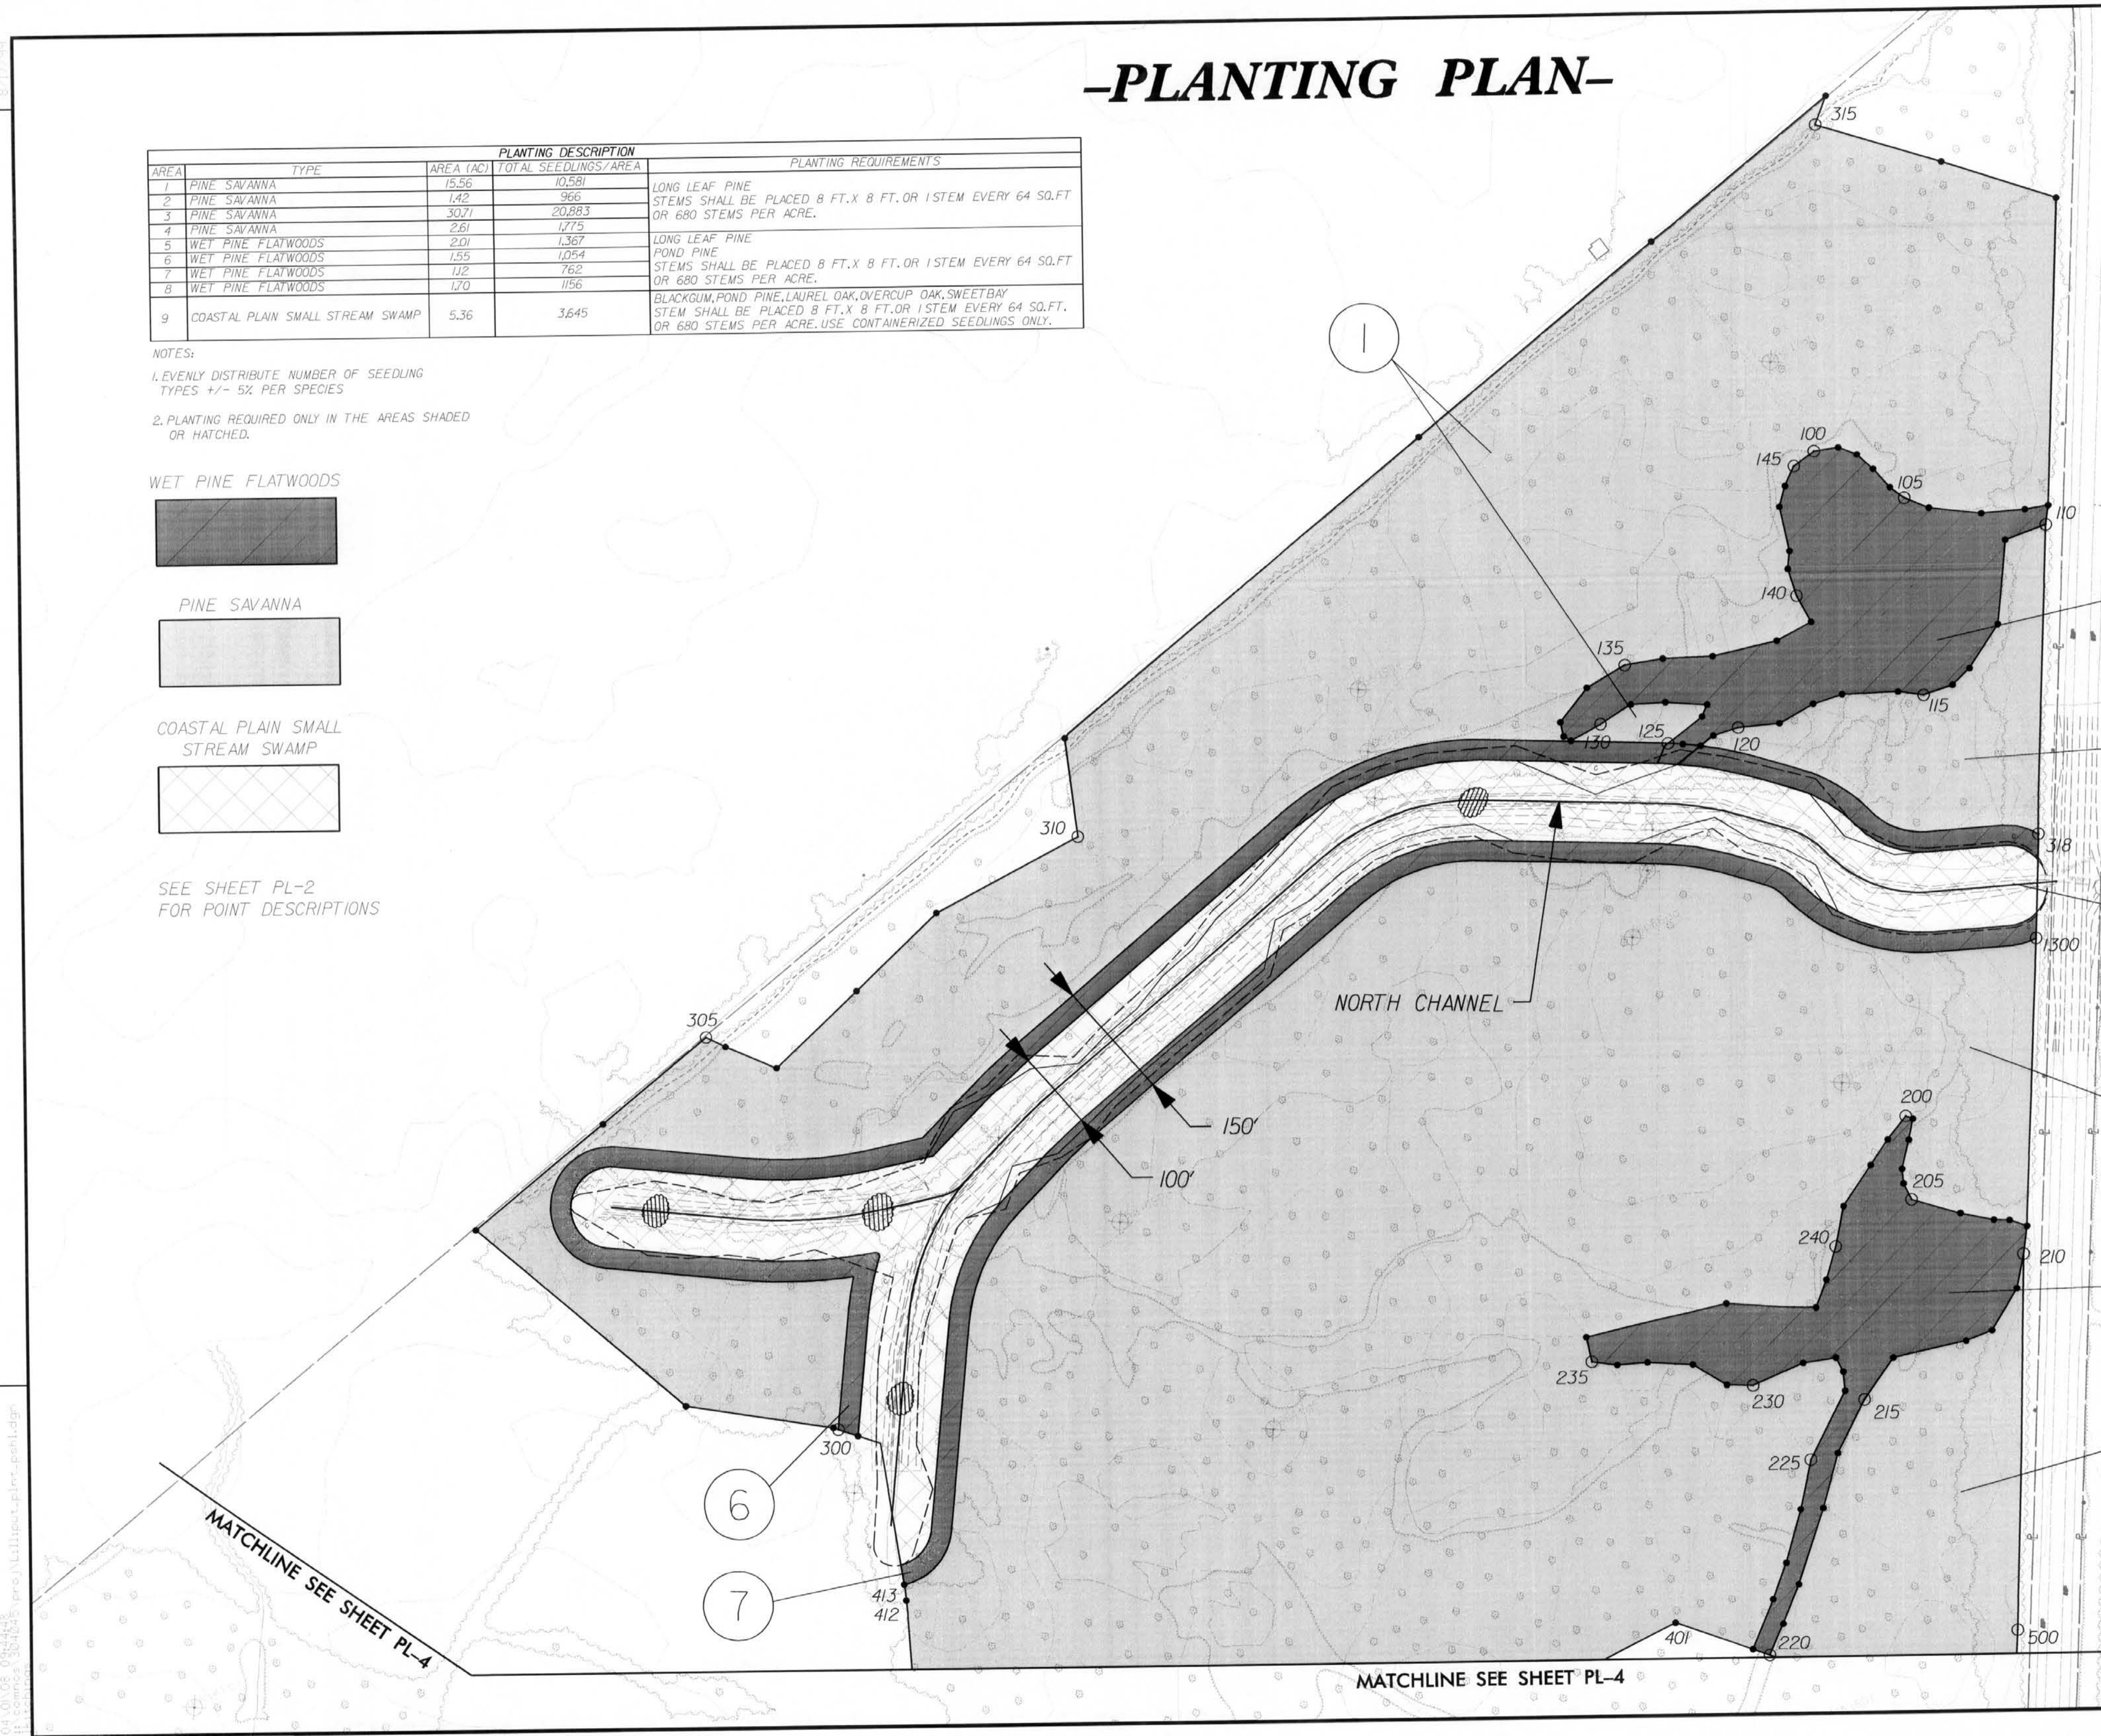

BOILING SPRING ROAD

- 5
- 2
- 9
- 3
- 8
- 4


NCGS GRID NORTH (NAD 83)

Scale: 1" = 200'


0' 100' 200'

PLANS PREPARED BY :
RUMMEL KLEPPER & KAHL, L.L.P.
consulting engineers
 900 RIDGEFIELD DRIVE SUITE 350
 RALEIGH, NORTH CAROLINA 27609-3960
 (919) 878-9560
 FOR
DENR-ECOSYSTEM ENHANCEMENT PROGRAM

-PLANTING PLAN-

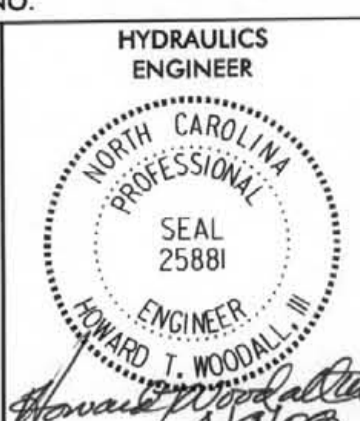PROJECT REFERENCE NO. D05053S	SHEET NO. PL-4
RW SHEET NO.	
	

PRELIMINARY PLANS
DO NOT USE FOR CONSTRUCTION

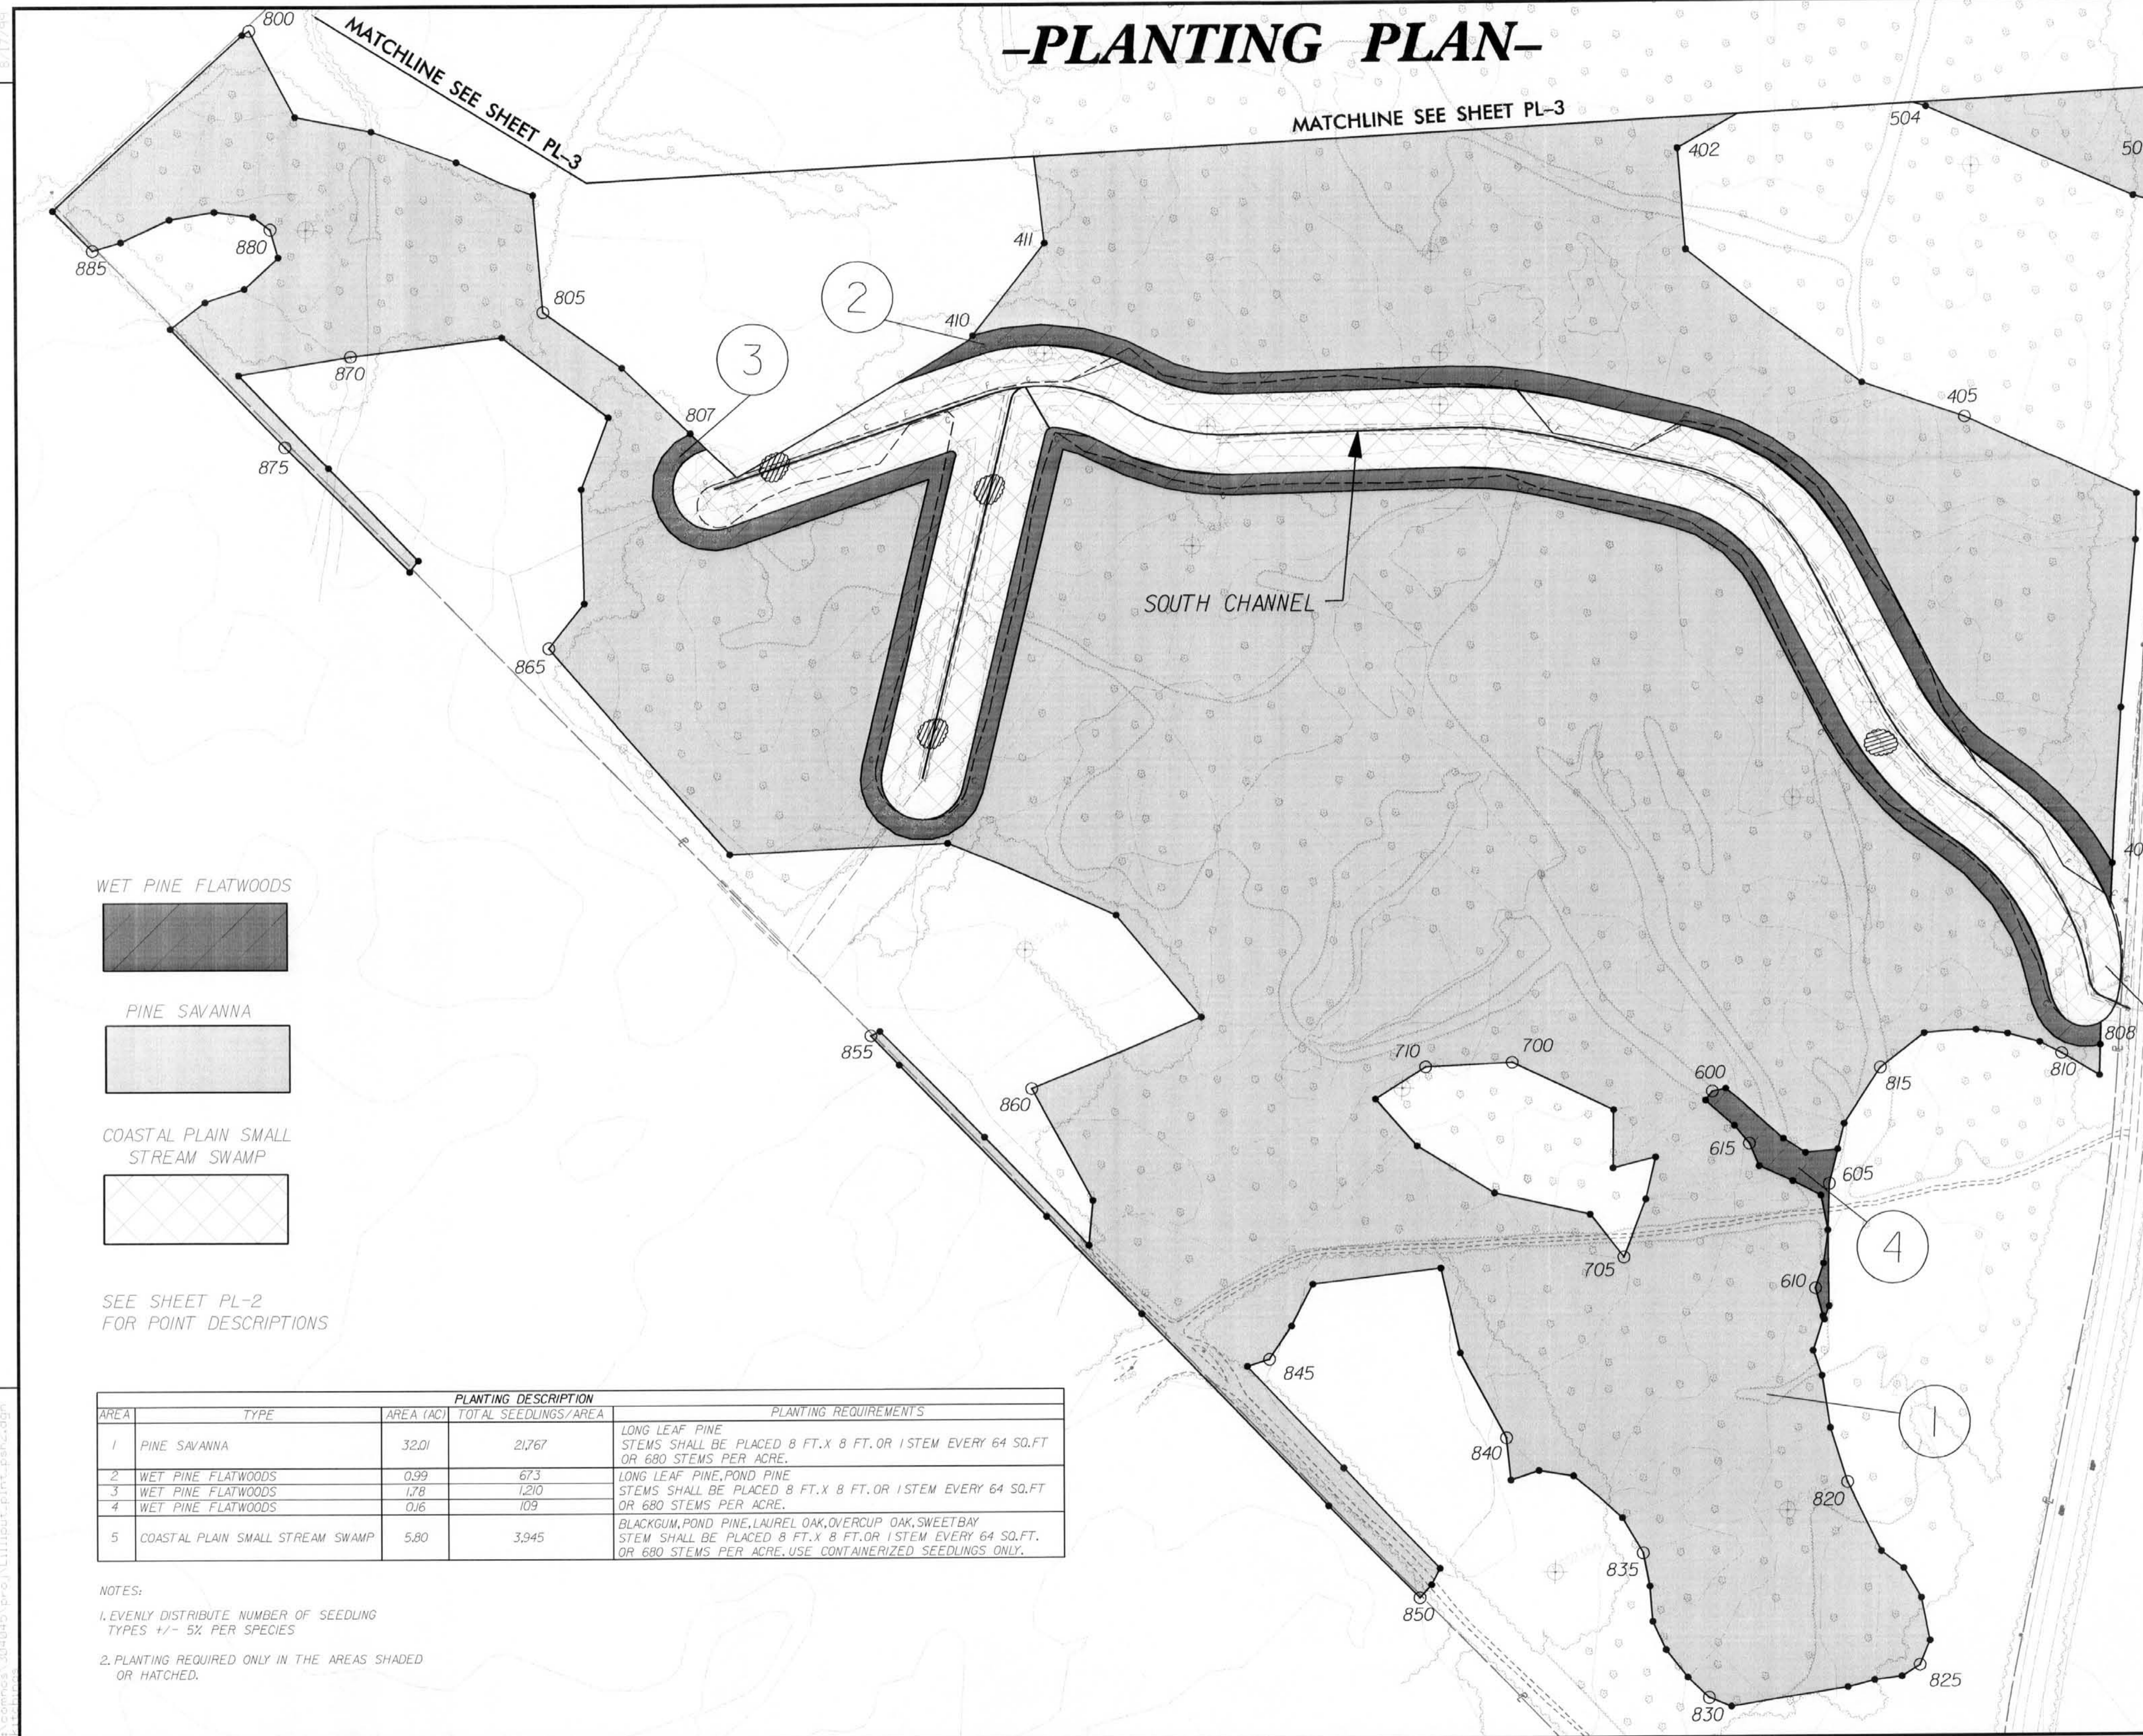


- WET PINE FLATWOODS
- PINE SAVANNA
- COASTAL PLAIN SMALL STREAM SWAMP

SEE SHEET PL-2 FOR POINT DESCRIPTIONS

PLANTING DESCRIPTION		PLANTING REQUIREMENTS	
AREA	TYPE	AREA (AC)	TOTAL SEEDLINGS/AREA
1	PINE SAVANNA	32.01	2,1767
2	WET PINE FLATWOODS	0.99	673
3	WET PINE FLATWOODS	1.78	1,210
4	WET PINE FLATWOODS	0.16	109
5	COASTAL PLAIN SMALL STREAM SWAMP	5.80	3,945

- NOTES:
1. EVENLY DISTRIBUTE NUMBER OF SEEDLING TYPES +/- 5% PER SPECIES
 2. PLANTING REQUIRED ONLY IN THE AREAS SHADED OR HATCHED.




 NCGS GRID NORTH
(NAD 83)

BOILING SPRING ROAD

PRETTY POND GIRL SCOUT CAMP

Scale: 1" = 200'



PLANS PREPARED BY :
RUMMEL KLEPPER & KAHL, LLP
consulting engineers
 900 RIDGEFIELD DRIVE SUITE 350
 RALEIGH, NORTH CAROLINA 27609-3960
 (919) 878-9560
 FOR
DENR-ECOSYSTEM ENHANCEMENT PROGRAM

8/17/99
 04/01/08 09:45:51
 if:\csm\3301045\proj\11\input.plt\psh2.dgn


REVISIONS

-PLANTING PLAN-


<small>PROJECT REFERENCE NO.</small> D05053S	<small>SHEET NO.</small> PL-5
<small>RW SHEET NO.</small>	

PRELIMINARY PLANS
DO NOT USE FOR CONSTRUCTION

POINT	NORTH (ft)	EAST (ft)
600	118,972.54	2,298,304.96
601	118,903.62	2,298,306.58
602	118,906.73	2,298,277.79
603	118,955.72	2,298,270.18

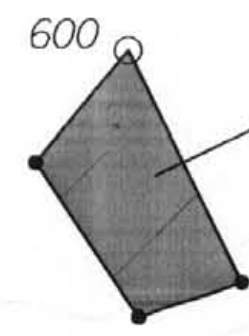


1

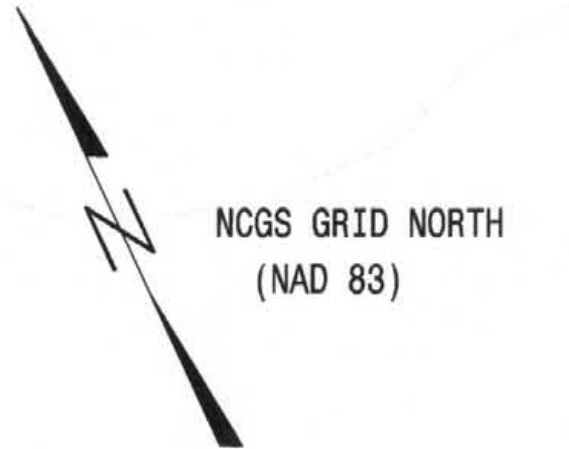

POWER EASEMENT

AREA	TYPE	AREA (AC)	PLANTING DESCRIPTION		PLANTING REQUIREMENTS
			TOTAL SEEDLINGS/AREA		
1	CYPRESS GUM SWAMP	.044	30		BLACKGUM, BALD CYPRESS STEMS SHALL BE PLACED 8 FT. X 8 FT. OR 1 STEM EVERY 64 SQ. FT. OR 680 STEMS PER ACRE. USE CONTAINERIZED SEEDLINGS ONLY.

- NOTES:
1. EVENLY DISTRIBUTE NUMBER OF SEEDLING TYPES +/- 5% PER SPECIES
 2. PLANTING REQUIRED ONLY IN THE AREAS SHADED OR HATCHED.

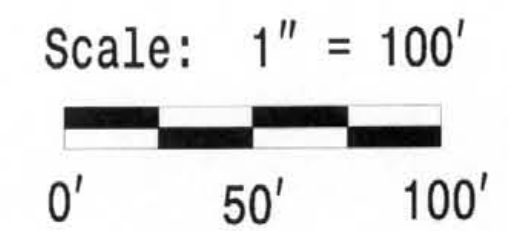

PLANS PREPARED BY :
RUMMEL, KLEPPER & KAHL, LLP
consulting engineers
 900 RIDGEFIELD DRIVE SUITE 350
 RALEIGH, NORTH CAROLINA 27609-3960
 (919) 878-9560

FOR
DENR-ECOSYSTEM ENHANCEMENT PROGRAM

04/01/08 09:46:52
 h:\comras_30-1075\proj\11\liliput.plt.psh.dgn

REVISIONS