

**FINAL**  
**AS-BUILT BASELINE MONITORING REPORT**  
**UT TO MARTIN'S CREEK (CONTRERAS) MITIGATION PROJECT**  
Cherokee County, North Carolina  
EEP Project No. 92766 (Contract No. 005717)  
USACE Action ID No. 2010-00961/DWR Project No. 2010-00448  
SCO No. 08-07249-01

**Data Collection – March-April 2014**

Hiwassee River Basin  
Cataloging Unit 06020002170010



**SUBMITTED TO/PREPARED FOR:**



North Carolina Department of Environment and Natural Resources  
Ecosystem Enhancement Program  
217 West Jones Street, Suite 3000A  
Raleigh, North Carolina 27603

**SUBMITTED BY:**



Axiom Environmental, Inc.  
218 Snow Avenue  
Raleigh, North Carolina 27603

**MAY 2014**

## TABLE OF CONTENTS

1.0	PROJECT SUMMARY .....	1
2.0	METHODOLOGY .....	3
2.1	Streams.....	3
2.2	Vegetation.....	4
3.0	REFERENCES .....	5

## APPENDICES

### Appendix A. Background Tables

Table 1. Project Components and Mitigation Units

Table 2. Project Activity and Reporting History

Table 3. Project Contacts Table

Table 4. Project Attributes Table

### Appendix B. Visual Assessment Data

Figure 1. Vicinity Map

Figure 2. Current Conditions Plan View

Figure 3. Project Components Map

Stream Fixed Station Photo Points

Vegetation Plot Photographs

### Appendix C. Vegetation Plot Data

Table 5. Planted Stems

Table 6. Planted and Total Stem Counts

### Appendix D. Stream Geomorphology Data

Tables 7a-7f. Baseline Stream Data Summary

Tables 8a-8f. Monitoring Data-Dimensional Data Summary

Cross-section Plots

Longitudinal Profile Plots

### Appendix E. As-built Plan Sheets

## 1.0 PROJECT SUMMARY

The North Carolina Ecosystem Enhancement Program (EEP) has established the UT to Martin's Creek (Contreras) Mitigation Project (Site) located in Cherokee County, just south of the town of Murphy. The Site is encompassed within 14-digit Cataloging Unit 06020002170010 of the Hiwassee River Basin (Figure 1, Appendix B and Table 4, Appendix A). Land use at the Site, prior to mitigation activities, was composed of agricultural uses, logging, grass land, single-family residences, and forested areas. Martin's Creek and its tributaries had been impaired by historical and current land management practices, which include timber harvesting, pasture conversion, channelization, and livestock grazing. Completed project activities, reporting history, completion dates, project contacts, and project attributes are summarized in Tables 1-4 (Appendix A).

The Site is located on tributaries to Martin's Creek, which has been assigned Stream Index Number 1-49 and a Best Usage Classification of C. Site streams are listed on the NCDWQ draft 2014 and final 2012 Section 303(d) list of impaired streams due to a fair bioclassification for ecological/biological integrity and fish communities, and elevated levels of fecal coliform bacteria. The Site is located within a Targeted Local Watershed that has been identified for stream and buffer restoration opportunities (NCEEP 2008).

The Site lies within the focus area of the *Peachtree-Martins Creek Local Watershed Plan* (LWP). Goals of the LWP include working with local landowners, resource agencies and nongovernmental groups to implement wetland and stream restoration projects that reduce sources of sediment and nutrients by restoring riparian buffers, stabilizing stream banks, and restoring natural channel geomorphology, particularly in headwater streams. The NCEEP is also placing an emphasis on projects that contribute to the restoration and protection of habitat for priority fish, mussel, snail and crayfish species in the basin (NCEEP 2008).

The project goals will directly address stressors identified in the Peachtree-Martins Creek LWP, namely lack of riparian vegetation, channel modification, excess sediment inputs, excess nutrient inputs, and bacterial contamination as follows.

- Restore geomorphically stable stream channels within the Site;
- Restoration or enhancement of wetlands onsite;
- Exclude livestock from accessing project streams, wetlands, and riparian zones;
- Improve and restore hydrologic connections and achieve uplift of ecosystem functions;
- Improve water quality within the Site through reduction of bank erosion, improved nutrient and sediment removal, and stabilization of streambanks;
- Restore and preserve headwater tributaries in the Peachtree-Martins Creek Watershed and the Hiwassee River; and
- Improve aquatic and terrestrial habitat through improved substrate and in-stream cover, addition of woody debris, reduction of water temperature, and restoration of riparian habitat.

In order to accomplish the goals of the project and contribute to the overall success of goals set forth for the greater Peachtree-Martin Creek local watershed planning area, a number of general project objectives and design objectives were identified for this project as follows.

### General Project Objectives

- Utilize natural channel design concepts to restore or enhance channel profile, pattern, and dimension to reduce bank and channel profile degradation and to allow greater floodplain connectivity to aid in the dissipation of bankfull flows.
- Reduce streambank degradation and sediment and nutrient inputs by limiting livestock access of project tributaries to crossings agreed upon between the NCEEP and the landowner.
- Further reduce sediment and nutrient inputs and streambank instability by restoring or enhancing native riparian vegetation along a 30-foot buffer along the project reach.
- Improve bedform function and diversity by installing toe wood structures and grade control structures that also function to improve riffle and scour pool habitat.

### Design Objectives

- Make important design decisions based on a geomorphic analyses of the Site, reference conditions, and hydraulic modeling.
- Consider field constraints and construction tolerances in order to produce a realistic design.
- Minimize disturbance to ecologically functional and physically stable areas, mimic the character of these areas to create a more natural design.
- Structures and over-all design will attempt to use native materials and minimize materials brought onsite to produce more favorable habitat for native flora and fauna, reduce compaction and onsite disturbance from material transport, and produce an aesthetically pleasing result.

The Site mitigation plan was completed in March 2010 with the final design and construction plans completed in November 2010 (Table 2, Appendix A). Project construction was completed between October 2012-July 2013. The implemented mitigation is as follows (Figure 2, Appendix B and Table 1, Appendix A).

- 4952 Stream Mitigation Units
  - Restoring approximately 3330 linear feet of stream channel through construction of stable channel at the historic floodplain elevation.
  - Enhancing (level I) approximately 1319 linear feet of stream channel through cessation of current land use practices, installing grade control structures, repairing bank erosion, restoring proper channel dimension and profile, and planting with native forest vegetation.
  - Enhancing (level II) approximately 1953 linear feet of stream channel through cessation of current land use practices, removing invasive species, and planting with native forest vegetation.
- 0.15 Riparian Wetland Mitigation Units
  - Enhancing approximately 0.3 acres of riparian wetland by filling ditches/abandoned channels and supplemental planting.
- Planting a native woody riparian buffer (at least 30 feet in width) adjacent to restored/enhanced streams and wetlands within the Site.
- Protecting the Site in perpetuity with a conservation easement.

### Stream Success Criteria

Stream restoration success criteria for the Site are based on the *Stream Mitigation Guidelines* issued in April 2003 by the USACE and NCDWQ. Success criteria for stream restoration will include 1) documentation of two bankfull events, 2) little change in the channel cross-section from as-built conditions, 3) stable longitudinal profile, 4) substrate consistency, and 5) photographic evidence of stability.

### Bankfull Events

Two bankfull flow events in separate years must be documented within the 5-year monitoring period. Otherwise, the stream monitoring will continue until two bankfull events have been documented in separate years.

### Cross-sections

Riffle cross-sections on the restoration and enhancement reaches should be stable and should show little change in bankfull area, maximum depth ratio, and width-to-depth ratio. Riffle cross-sections should generally fall within the parameters defined for channels of the appropriate Rosgen stream type. If any changes do occur, these changes will be evaluated to assess whether the stream channel is showing signs of instability. Indicators of instability include a vertically incising thalweg or eroding channel banks. Changes in the channel that indicate a movement toward stability or enhanced habitat include a decrease in the width-to-depth ratio in meandering channels or an increase in pool depth.

### Longitudinal Profile

Longitudinal profile data for the stream reach should show that bedform features are remaining stable. The riffles should be steeper and shallower than the pools, while the pools should be deep with flat water surface slopes. The relative percentage of riffles and pools should not change significantly from the design parameters.

### Bed Material Analysis

Substrate materials in the restoration reaches should indicate a progression towards or the maintenance of coarser materials in the riffle features and smaller particles in the pool features.

### Photo Reference Sites

Photographs will be used to evaluate channel aggradation or degradation, bank erosion, success of riparian vegetation, and effectiveness of erosion control measures subjectively. Lateral photos should not indicate excessive erosion or continuing degradation of the banks. A series of photos over time should indicate successive maturation of riparian vegetation.

### Vegetation Success Criteria

Success criteria have been established to verify that the vegetation component supports community elements necessary for forest development. Success criteria for this project includes an average density of 320 planted stems per acre must be surviving in the first three monitoring years. Subsequently, 290 planted stems per acre must be surviving in year 4, and 260 planted stems per acre in year 5.

## **2.0 METHODOLOGY**

Monitoring of the Site's restoration efforts will be performed until agreed upon success criteria are fulfilled. Monitoring is proposed for the stream channel, riparian vegetation, and hydrology for a period of five years (Figure 2, Appendix B). Monitoring reports of collected data will be submitted no later than December of each monitoring year.

### **2.1 Streams**

Post-restoration monitoring will be conducted for five years following the completion of construction to evaluate the effectiveness of the restoration practices. Monitored stream parameters include stream

dimension (cross-sections), pattern (longitudinal survey), profile (profile survey), and photographic documentation. Baseline stream data can be found in Appendix D.

### Bankfull Events

The occurrence of bankfull events within the monitoring period will be documented by the use of a crest gauge and photographs. One crest gauge was installed to record the highest watermark between site visits, and the gauge will be checked each time there is a Site visit to determine if a bankfull event has occurred (Figure 2, Appendix B). Photographs will be used to document the occurrence of debris lines and sediment deposition on the floodplain during monitoring site visits.

### Cross-sections

A total of 14 permanent cross-sections, 10 riffle and 4 pool, were established and will be used to evaluate stream dimension; locations are depicted on Figure 2 (Appendix B). Because riffle cross-sections are critical in determining bankfull design parameters, the number of riffle cross-sections established will generally outnumber pool cross-sections. Each cross-section will be marked on both banks with permanent pins to establish the exact transect used. A common benchmark will be used for cross-sections and consistently used to facilitate easy comparison of year-to-year data. The annual cross-section survey will include points measured at all breaks in slope, including top of bank, bankfull, inner berm, edge of water, and thalweg, if the features are present. Riffle cross sections will be classified using the Rosgen Stream Classification System.

### Longitudinal Profile

After Site construction, approximately 4640 linear feet of longitudinal profile was completed to document baseline conditions. Longitudinal profile will be resurveyed annually for the duration of the five-year monitoring period. Measurements include thalweg, water surface, bankfull, and top of low bank. Each of these measurements will be taken at the head of each channel unit (e.g., riffle, pool) and at the maximum pool depth. The survey will be tied to a permanent benchmark.

### Bed Material Analysis

Pebble counts will be conducted annually on one permanent riffle cross-section (100-counts) at the time cross-section and longitudinal surveys are performed during the five year monitoring period. These samples will reveal changes in sediment gradation over time as the stream adjusts to upstream sediment loads.

### Photo Reference Sites

A total of 24 photographs will be used to visually document restoration success for at least five years following construction. Photographs will be taken from a height of approximately five to six feet. Photo locations will be recorded using sub-meter GPS to ensure that the same locations (and view directions) on the Site are monitored in each monitoring period.

## **2.2 Vegetation**

After planting was completed, an initial evaluation was performed to verify planting methods were successful and to determine initial species composition and density. Eleven sample vegetation plots (10-meter by 10-meter) were installed and measured within the Site as per guidelines established in *CVS-EEP Protocol for Recording Vegetation, Version 4.2* (Lee et al. 2008). Vegetation plots are permanently monumented with 6-foot metal t-posts at each corner. In each sample plot, vegetation parameters to be monitored include species composition and species density. Visual observations of the percent cover of

shrub and herbaceous species will also be documented by photograph. Baseline vegetation plot information can be found in Appendix C. Initial stem count measurements indicate an average of 416 planted stems per acre (excluding livestakes) across the Site.

### 3.0 REFERENCES

Lee, M.T., R.K. Peet, S.D. Roberts, and T.R. Wentworth. 2008. CVS-EEP Protocol for Recording Vegetation. Version 4.2. North Carolina Department of Environment and Natural Resources, Ecosystem Enhancement Program. Raleigh, North Carolina.

North Carolina Division of Water Quality (NCDWQ). 2012. Final North Carolina Water Quality Assessment and Impaired Waters List (NC 2012 Integrated Report Category 5, 303(d) List) (online). Available: [http://portal.ncdenr.org/c/document\\_library/get\\_file?uuid=9d45b3b4-d066-4619-82e6-ea8ea0e01930&groupId=38364](http://portal.ncdenr.org/c/document_library/get_file?uuid=9d45b3b4-d066-4619-82e6-ea8ea0e01930&groupId=38364) [February 17, 2014]. North Carolina Department of Environment and Natural Resources, Raleigh, North Carolina.

North Carolina Division of Water Quality (NCDWQ). 2014. Draft 2014 NC 303(d) List-Category 5 Assessments Requiring TMDLs (online). Available: [http://portal.ncdenr.org/c/document\\_library/get\\_file?uuid=096fb2ff-296b-4bd8-8b88-e83bb5984be6&groupId=38364](http://portal.ncdenr.org/c/document_library/get_file?uuid=096fb2ff-296b-4bd8-8b88-e83bb5984be6&groupId=38364) [February 17, 2014]. North Carolina Department of Environment and Natural Resources, Raleigh, North Carolina.

North Carolina Ecosystem Enhancement Program and Equinox Environmental Consultation and Design (NCEEP). 2007. Peachtree-Martins Creek Local Watershed Plan (Phase3), Hiwassee River Basin, Cherokee and Clay Counties, North Carolina. October 2007 Watershed Management Plan. [Online WWW]. Available URL: [http://www.nceep.net/services/lwps/pull\\_down/by\\_basin/Hiwassee\\_RB.html](http://www.nceep.net/services/lwps/pull_down/by_basin/Hiwassee_RB.html).

North Carolina Ecosystem Enhancement Program (NCEEP). 2008. Hiwassee River Basin Restoration Priorities 2008 (online). Available: [http://www.nceep.net/services/lwps/pull\\_down/by\\_basin/Hiwassee\\_RB.html](http://www.nceep.net/services/lwps/pull_down/by_basin/Hiwassee_RB.html). North Carolina Department of Environment and Natural Resources, Raleigh, North Carolina.

Rosgen, D.L. 1996. Applied River Morphology. Wildland Hydrology Books, Pagosa Springs, CO.

Schafale, M.P. and A.S. Weakley. 1990. Classification of the Natural Communities of North Carolina: Third Approximation. North Carolina Natural Heritage Program, Division of Parks and Recreation, North Carolina Department of Environment, Health, and Natural Resources. Raleigh, North Carolina.

United States Army Corps of Engineers, United States Environmental Protection Agency, North Carolina Wildlife Resources Commission, North Carolina Division of Water Quality (USACE et al.). 2003. Stream Mitigation Guidelines.

United States Geological Survey (USGS). 1974. Hydrologic Unit Map - 1974. State of North Carolina.

**Appendix A.**  
**Background Tables**

Table 1. Project Components and Mitigation Units

Table 2. Project Activity and Reporting History

Table 3. Project Contacts Table

Table 4. Project Attributes Table



**Table 1. Project Components and Mitigation Credits  
UT to Martin's Creek (Contreras) Mitigation Site**

Mitigation Credit Summations							
Stream		Riparian Wetland			Nonriparian Wetland		
4952		0.15			--		
Project Components							
Station Range	Existing Linear Footage/Acreage	Priority Approach	Restoration/Restoration Equivalent	Restoration Linear Footage/Acreage	Mitigation Ratio	Mitigation Credits	Comment
UT1-1 Station 00+00 to 06+02	602	---	Enhance I	602-54=548	1.5:1	365.3	Forced Crossing (54 linear feet) removed from credit
UT1-1	346	---	Enhance II	346	2.5:1	138.4	
UT1-1-1	106	---	Enhance II	106	2.5:1	42.4	
UT1-2 Station 00+00 to 02+07	141	PI	Restoration	207	1:1	207	
UT1-3 Station 00+00 to 08+33	767	---	Enhance I	767-62=705	1.5:1	470	Stream under power line easement (66 linear feet) will generate half credit and piped stream crossing (62 linear feet) removed from credit.
	66			66	3:1*	22.0	
UT1-4	1099	---	Enhance II	1014-53=961	2.5:1	384.4	Stream under two power line easements (40 and 45 linear feet) will generate half credit and forced crossing (53 linear feet) removed from credit.
	40			40	5:1**	8	
	45			45	5:1**	9	
UT 1 to Martin's Creek	455	---	Enhance II	455	2.5:1	182	
UT1 to Martin's Creek Station 00+00 to 32+74	2674	PI	Restoration	3274-53-47-51 =3123	1:1	3123	Three crossings (53, 47, and 51 linear feet) removed from credit.
Wetland Enhancement	0.3	---	Enhancement	0.3	2:1	0.15	Enhancement of existing riparian wetlands characterized by removal of invasive species and supplemental planting.
Component Summation							
Restoration Level	Stream (linear footage)	Riparian Wetland (acreage)			Nonriparian Wetland (acreage)		
Restoration	3330	--			--		
Enhancement (Level I)	1319	--			--		
Enhancement (Level II)	1953	--			--		
Enhancement	--	0.3			--		
<b>Totals</b>	<b>6602</b>	<b>0.3</b>			<b>--</b>		
<b>Mitigation Units</b>	<b>4952 SMUs</b>	<b>0.15 Riparian WMUs</b>			<b>0.00 Nonriparian WMUs</b>		

\*66 linear feet of stream under the power line easement is receiving a mitigation ratio of 3:1 (half credit for enhancement [level I]).

\*\*85 linear feet of stream under two power line easements is receiving a mitigation ratio of 5:1 (half credit for enhancement [level II]).

**Table 2. Project Activity and Reporting History  
UT to Martin's Creek (Contreras) Mitigation Site**

<b>Activity or Deliverable</b>	<b>Data Collection Complete</b>	<b>Completion or Delivery</b>
Mitigation Plan	September 2009-March 2010	March 2010
Final Design – Construction Plans	March 2010-November 2010	November 2010
Construction	--	October 2012-July 2013
Temporary S&E Mix applied to Entire Project Site	--	October 2012-July 2013
Permanent Seed Mix applied to the Entire Project Site	--	October 2012-July 2013
Bare Root; Containerized; and B&B Plantings for the Entire Project Site	--	March 2014
Mitigation Plan/ As-Built (Year 0 Monitoring Baseline)	March-April 2014	April 2014
Year 1 Monitoring		
Year 2 Monitoring		
Year 3 Monitoring		
Year 4 Monitoring		
Year 5 Monitoring		

**Table 3. Project Contacts Table  
Martin's Creek II Mitigation Site**


<b>Designer</b>	Michael Baker Engineering, Inc. 797 Haywood Road, Suite 201 Asheville, NC 28806 Micky Clemmons 828-350-1408
<b>Construction Plans and Sediment and Erosion Control Plans</b>	Michael Baker Engineering, Inc. 797 Haywood Road, Suite 201 Asheville, NC 28806 Micky Clemmons 828-350-1408
<b>Construction Contractor</b>	River Works, Inc. 6105 Chapel Hill Rd. Raleigh, NC 27607 919-582-3574
<b>Planting Contractor</b>	Carolina Silvics, Inc. 908 Indian Trail Road Edenton, NC 27932 (252) 482-8491
<b>As-built Surveyor</b>	Turner Land Surveying, PLLC 3201 Glenridge Drive Raleigh, NC 27604 919-875-1378
<b>Baseline Data Collection</b>	Axiom Environmental, Inc. 218 Snow Avenue Raleigh, NC 27603 Grant Lewis 919-215-1693

**Table 4. Project Attribute Table  
UT to Martin's Creek (Contreras) Mitigation Site**

Project County	Cherokee County, North Carolina									
Physiographic Region	Blue Ridge									
Ecoregion	Broad Basins									
Project River Basin	Hiwassee									
USGS HUC for Project (14 digit)	06020002170010									
NCDWQ Sub-basin for Project	04-05-02									
Planning Area	Yes – Peachtree-Martins Creek LWP									
WRC Class (Warm, Cool, Cold)	Cold									
% of easement fenced/demarcated	100% fenced to exclude livestock									
Beaver activity observed during design phase?	Yes, on UT1 below lower limits of project area									
	<b>Restoration Component Attribute Table</b>									
	UT 1-1		UT 1-1-1	UT 1-2	UT 1-3		UT 1-4		UT1 to Martin Cr	
Drainage Area	.018	.028	.004	.005	.074	.082	.023		.79	.82
Stream Order (USGS topo)	1 <sup>st</sup>	2 <sup>nd</sup>	1 <sup>st</sup>	1 <sup>st</sup>	1 <sup>st</sup>	1 <sup>st</sup>	2 <sup>nd</sup>		3 <sup>rd</sup>	3 <sup>rd</sup>
Restored Length (feet)	346	548	106	207	----	738	----	1099	3123	----
Perennial or Intermittent	I	P	I	I	I	P	I	P	P	P
Watershed Type	Rural									
Watershed impervious cover	<10%									
NCDWQ AU/Index number	1-49									
NCDWQ Classification	C		C	C	C		C		C	
303d listed?	No									
Upstream of a 303d listed	No									
Reasons for 303d listed segment	NA									
Total acreage of easement	15.63									
Total existing vegetated acreage of easement	---									
Total planted restoration acreage	~15.63									
Rosgen Classification of preexisting	B/E/Eb		E	F	G/C/B		B		G/Eb/Cb	
Rosgen Classification of As-built	B		---	C	B		B		C	
Valley type	II		II	II	II		II		II	
Valley slope	.034		---	.010	.029		---		.009	
Cowardin classification of proposed	N/A		N/A	N/A	N/A		N/A		N/A	
Trout waters designation	No									
Species of concern, endangered etc.	No									
Dominant Soil Series	Junaluska Brasstown Complex/Thurmont-Dillard Complex/Arc aqua loam		Junaluska Brasstown Complex	Arc qua loam	Thurmont-Dillard Complex		Junaluska Tsali Complex		Arc qua loam	

**Appendix B**  
**Visual Assessment Data**


- Figure 1. Vicinity Map
- Figure 2. Current Conditions Plan View
- Figure 3. Project Components Map
- Stream Fixed Station Photo Points
- Vegetation Plot Photographs

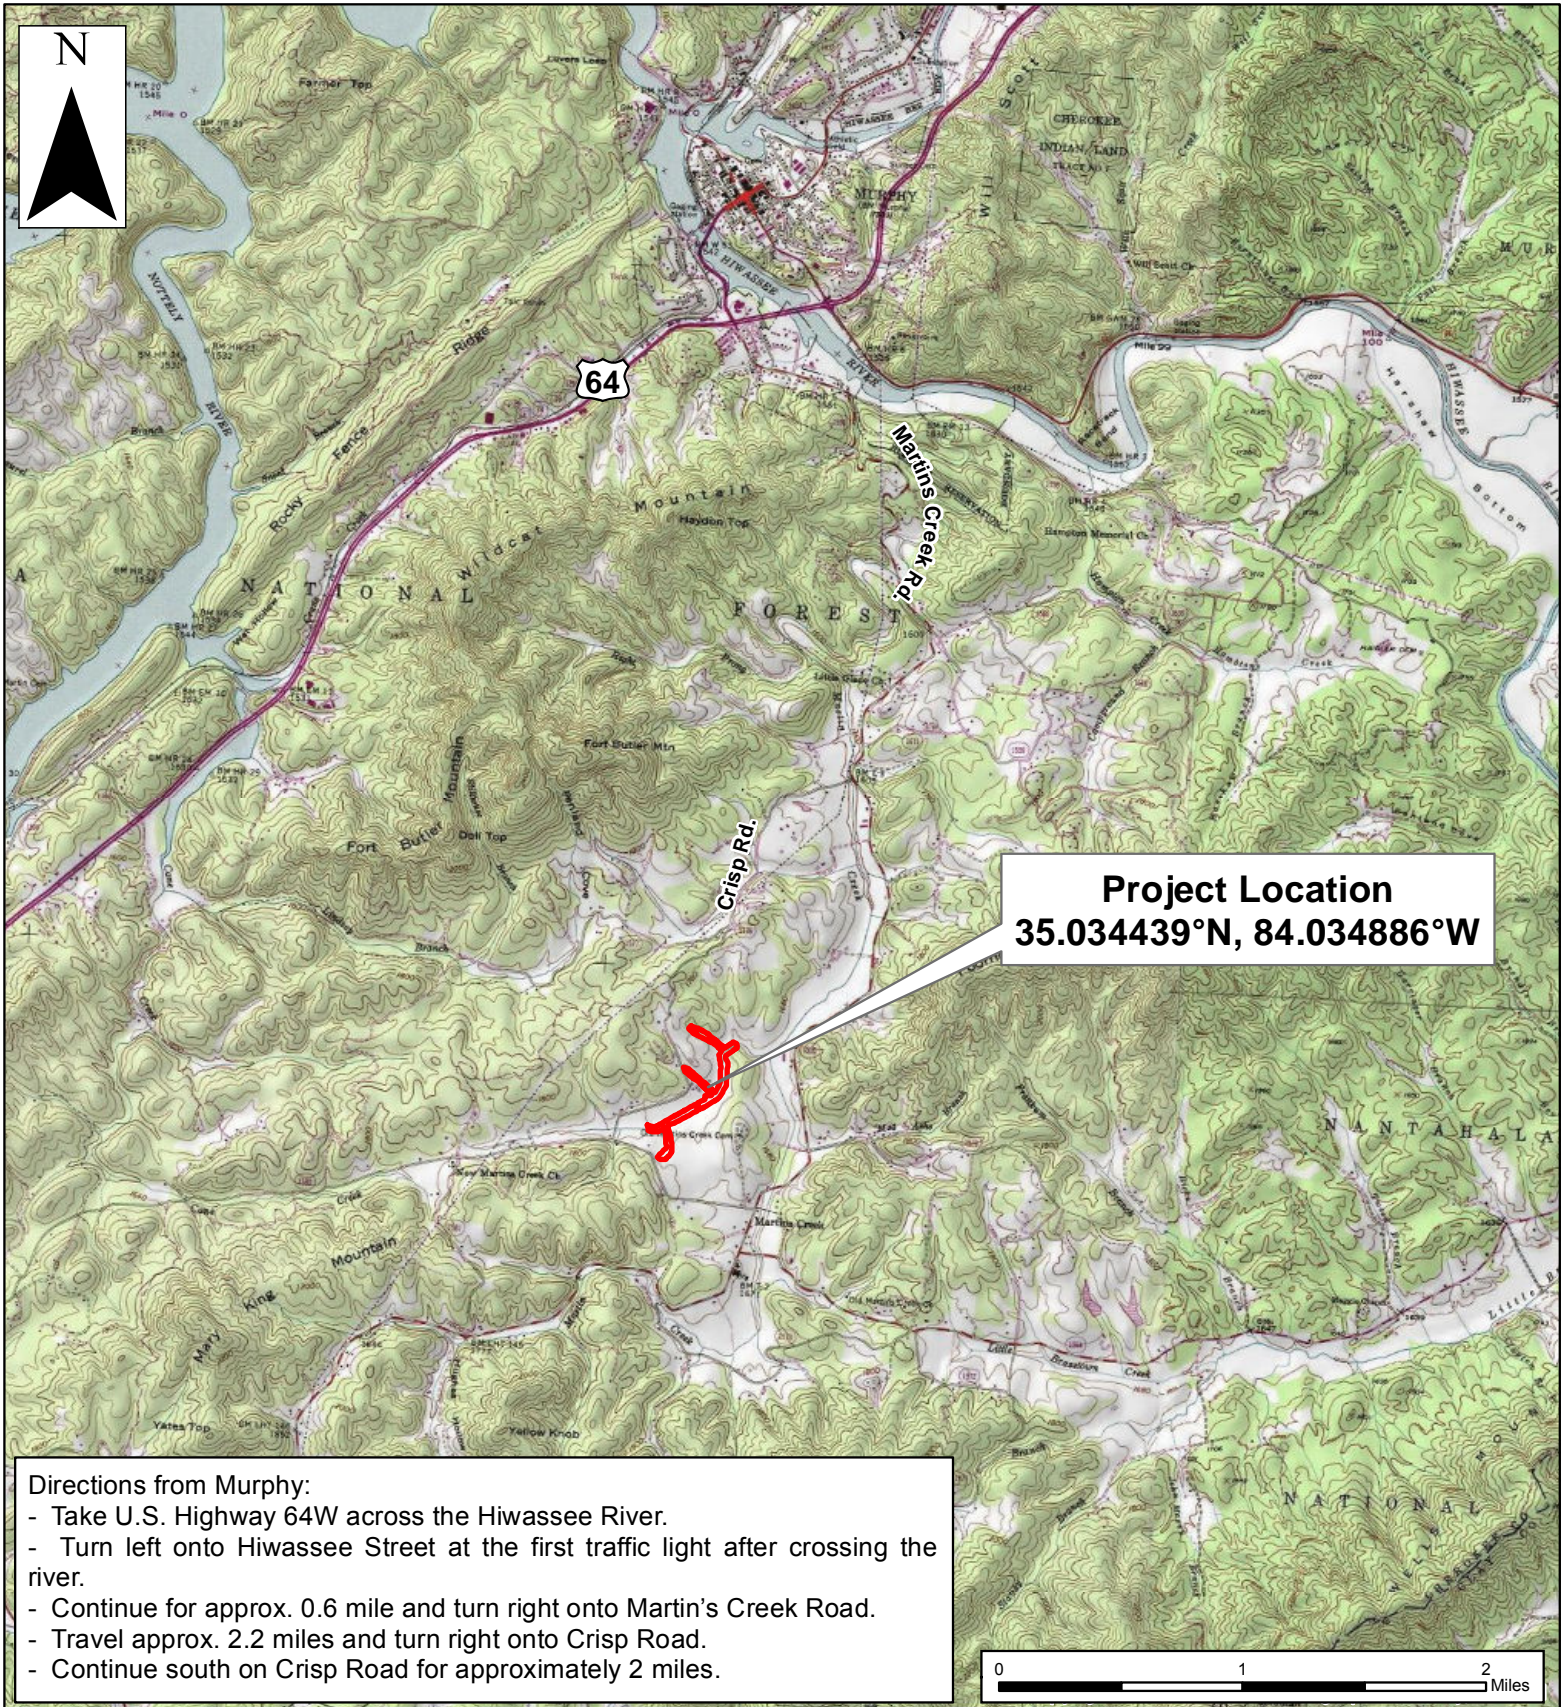



**Project Location**  
**35.034439°N, 84.034886°W**

**Directions from Murphy:**

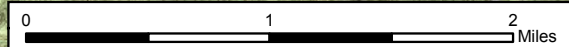
- Take U.S. Highway 64W across the Hiwassee River.
- Turn left onto Hiwassee Street at the first traffic light after crossing the river.
- Continue for approx. 0.6 mile and turn right onto Martin's Creek Road.
- Travel approx. 2.2 miles and turn right onto Crisp Road.
- Continue south on Crisp Road for approximately 2 miles.



<p>Prepared by:</p>  <p>Axiom Environmental, Inc.</p>	<p>Prepared for:</p>  <p>Ecosystem Enhancement PROGRAM</p>
---	---


VICINITY MAP  
 UT TO MARTINS CREEK (CONTRERAS)  
 EEP PROJECT NUMBER 92766  
 Cherokee County, North Carolina

Dwn. by: KRJ	<p>FIGURE</p> <h1 style="font-size: 48px; margin: 0;">1</h1>
Date: April 2014	
Project: 12.004.16	

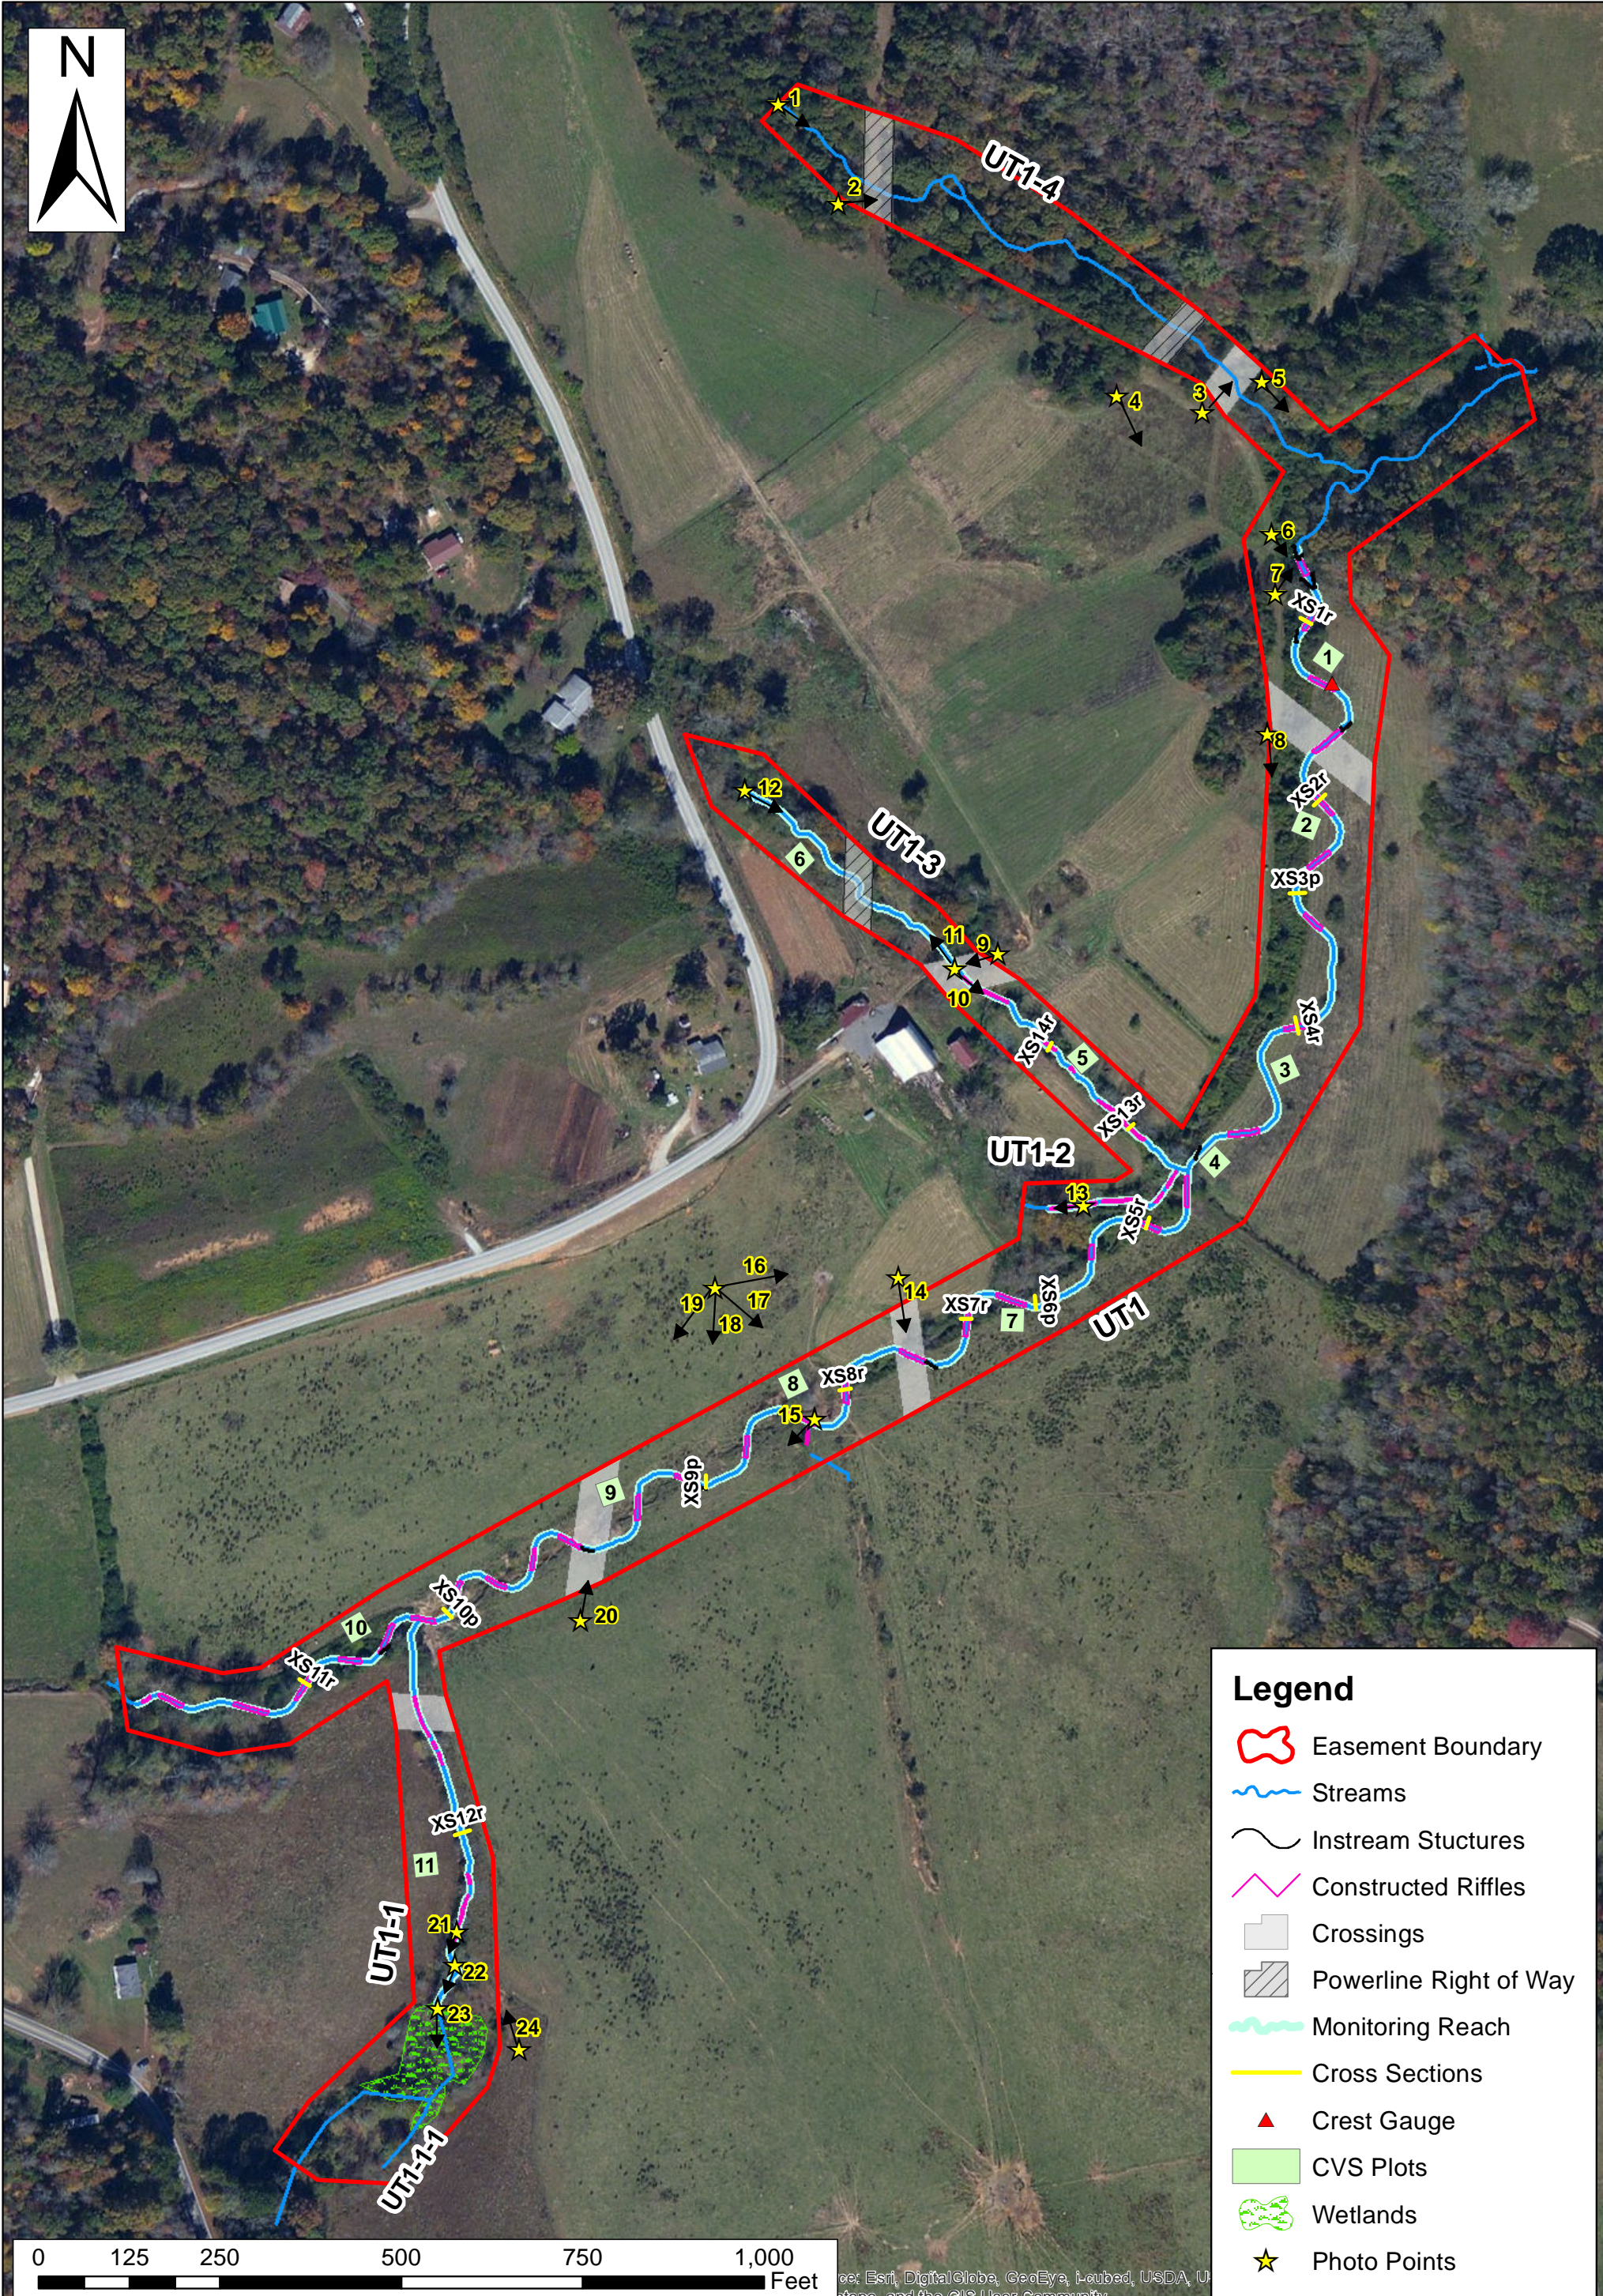

**Legend**

- Easement Boundary
- Streams
- Instream Structures
- Constructed Riffles
- Crossings
- Powerline Right of Way
- Monitoring Reach
- Cross Sections
- Crest Gauge
- CVS Plots
- Wetlands
- Photo Points

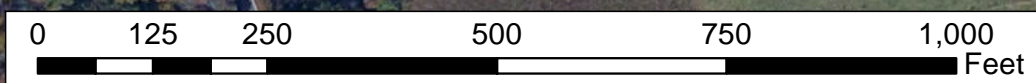



Axiom Environmental  
218 Snow Avenue  
Raleigh, NC 27603  
(919) 215-1693

Axiom Environmental, Inc.

**CURRENT CONDITIONS PLAN VIEW  
UT TO MARTINS CREEK (CONTRERAS)  
EEP PROJECT # 92766  
Cherokee County, North Carolina**

Dwn. by:	KRJ
Date:	May 2014
Project:	12-004.16

FIGURE  
**2**

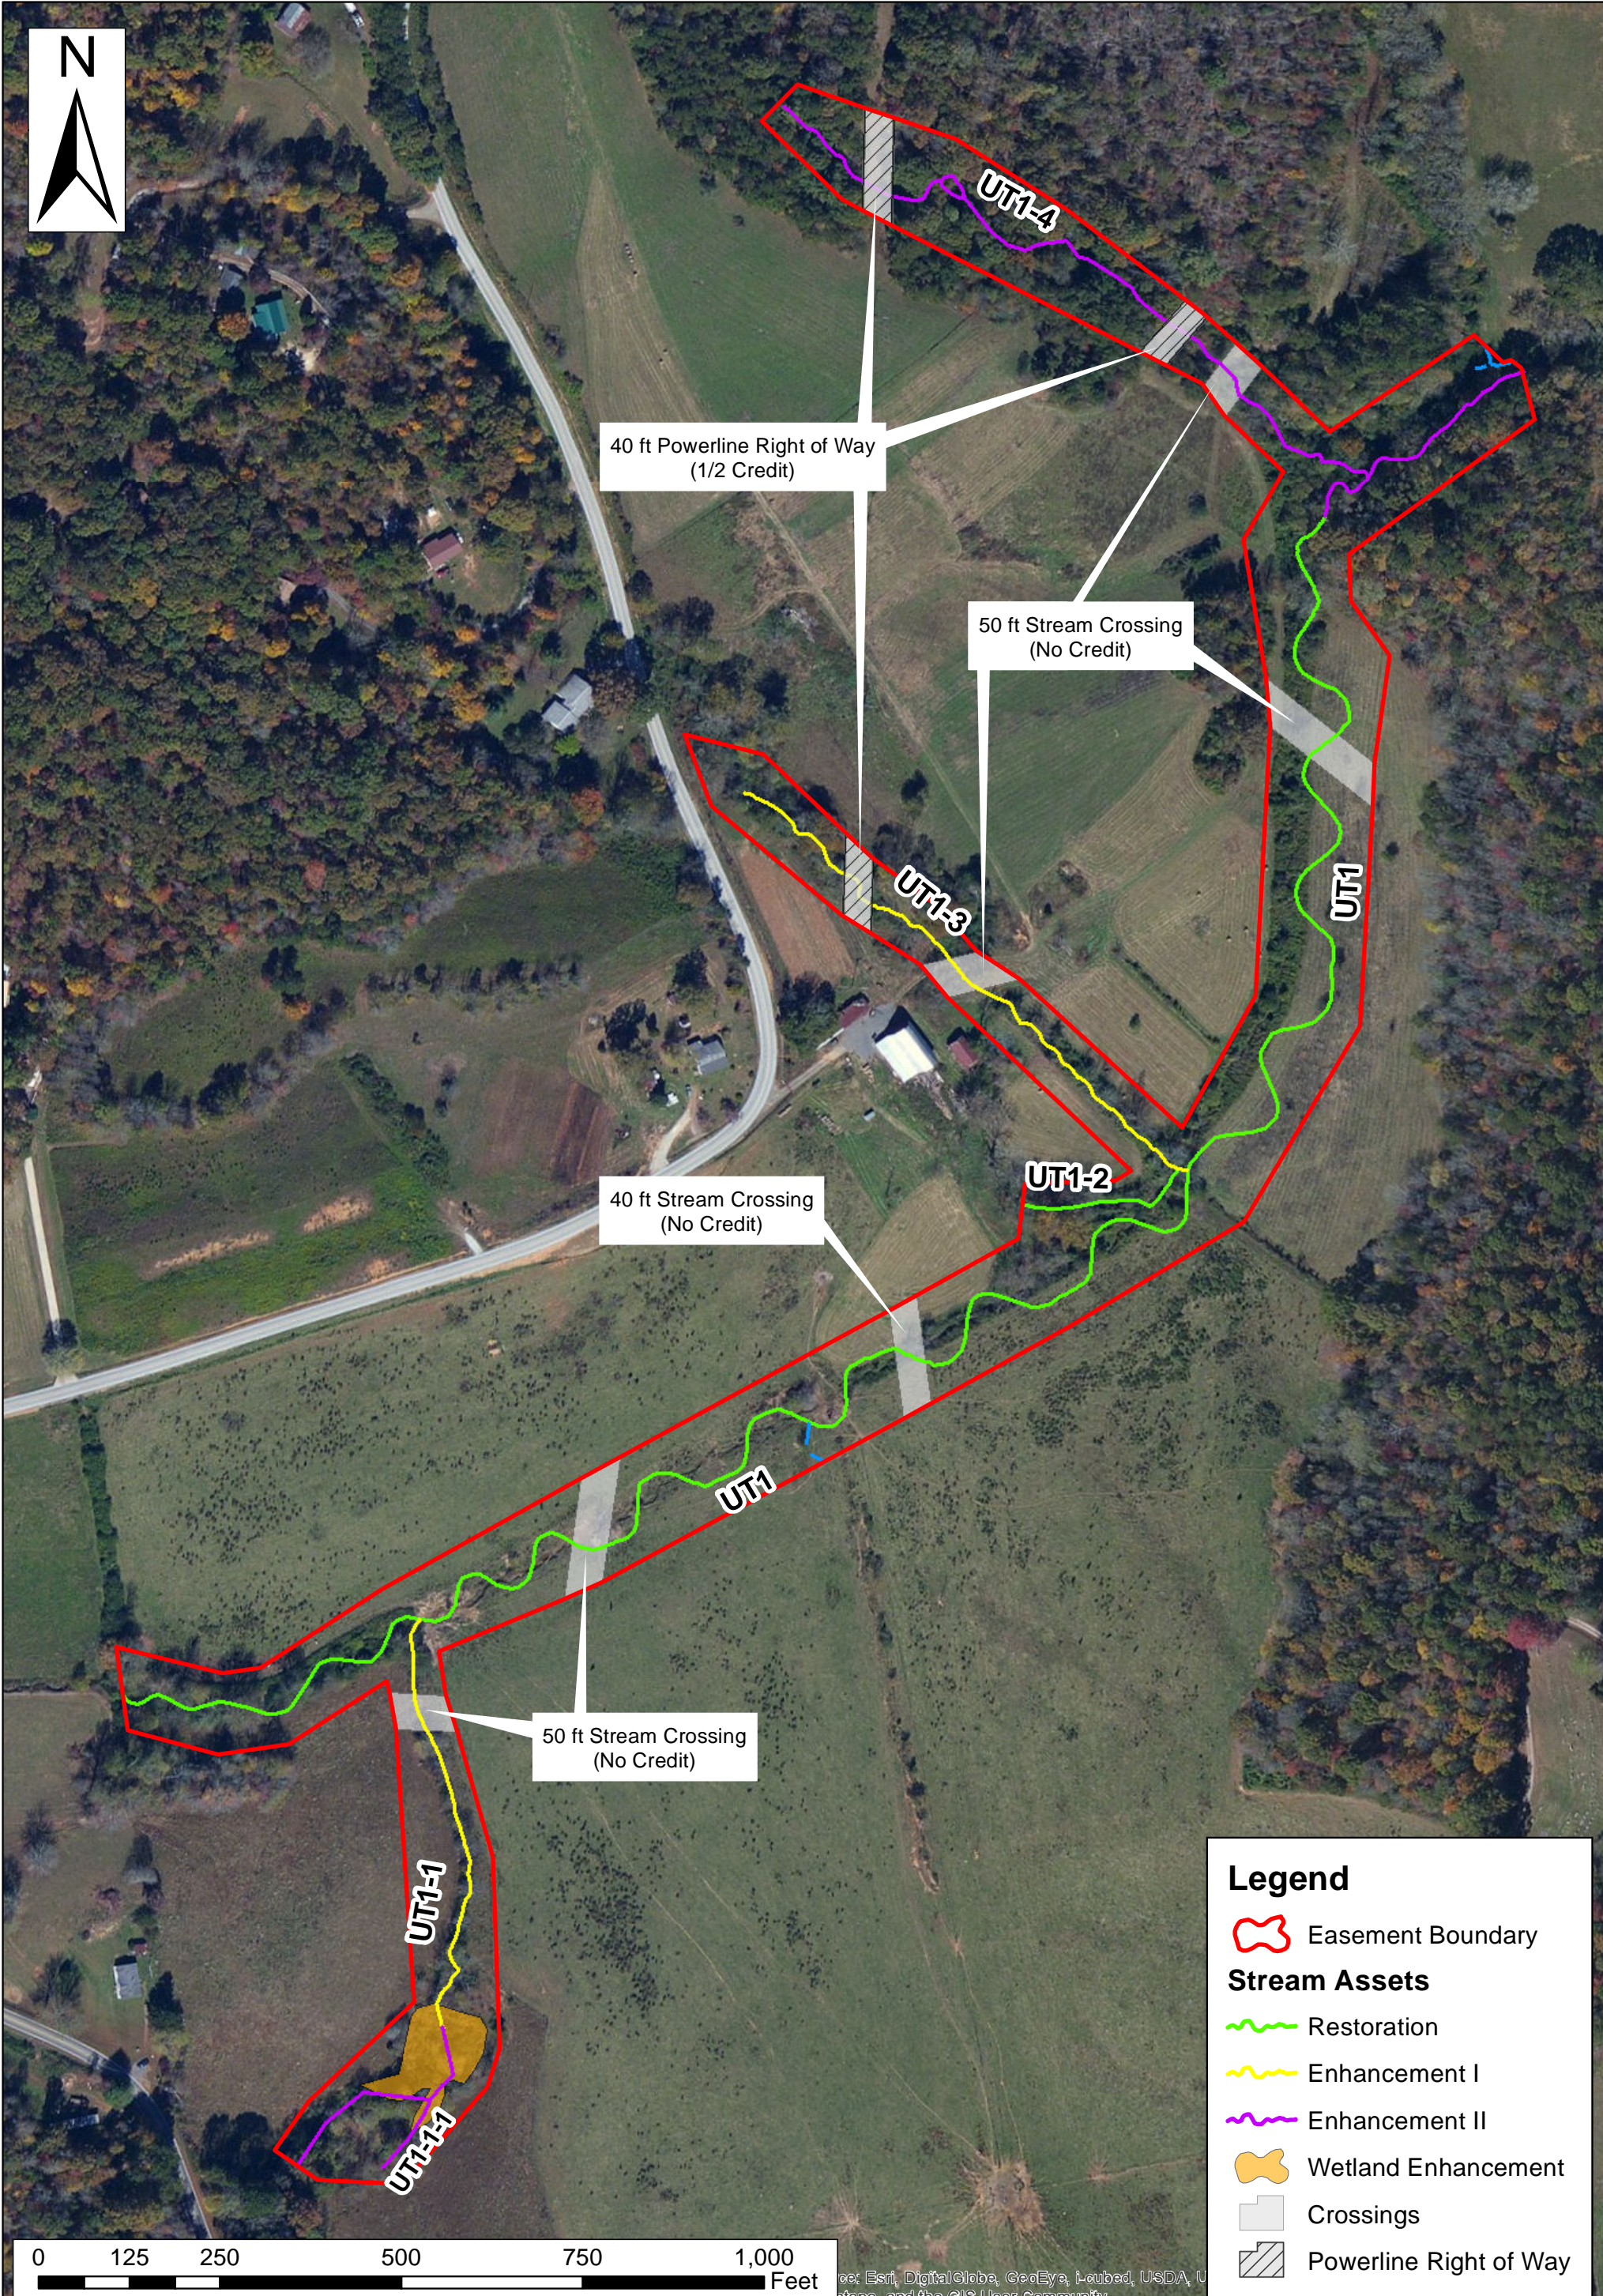

**Legend**

- Easement Boundary
- Stream Assets**
- Restoration
- Enhancement I
- Enhancement II
- Wetland Enhancement
- Crossings
- Powerline Right of Way



Axiom Environmental  
218 Snow Avenue  
Raleigh, NC 27603  
(919) 215-1693


Axiom Environmental, Inc.

**PROJECT COMPONENTS MAP**  
**UT TO MARTINS CREEK (CONTRERAS)**  
**EEP PROJECT # 92766**  
**Cherokee County, North Carolina**

Dwn. by:	KRJ
Date:	May 2014
Project:	12-004.16

FIGURE  
**3**

**UT to Martin's Creek (Contreras)  
Baseline Fixed Station Photographs  
Taken April 2014**

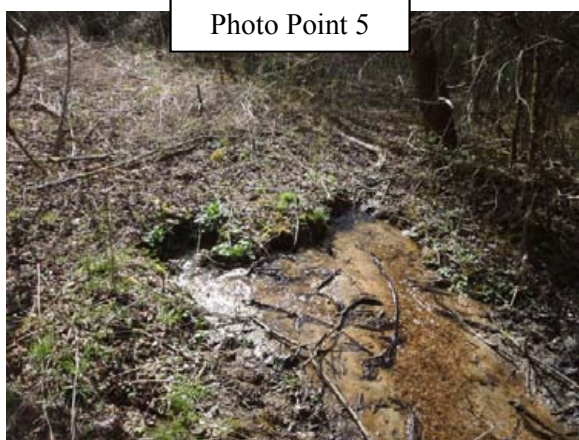



**UT to Martin's Creek (Contreras)  
Baseline Fixed Station Photographs (continued)  
Taken April 2014**

Photo Point 7



Photo Point 8



Photo Point 9

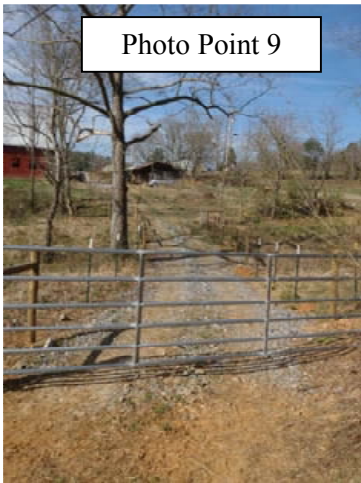


Photo Point 10



Photo Point 11



Photo Point 12



**UT to Martin's Creek (Contreras)  
Baseline Fixed Station Photographs (continued)  
Taken April 2014**

Photo Point 13



Photo Point 14



Photo Point 15



Photo Point 16



Photo Point 17



Photo Point 18



**UT to Martin's Creek (Contreras)  
Baseline Fixed Station Photographs (continued)  
Taken April 2014**

Photo Point 19



Photo Point 20



Photo Point 21



Photo Point 22





Photo Point 23






Photo Point 24



**UT to Martin's Creek (Contreras)  
Baseline Vegetation Monitoring Photographs  
Taken March 25-26, 2014**

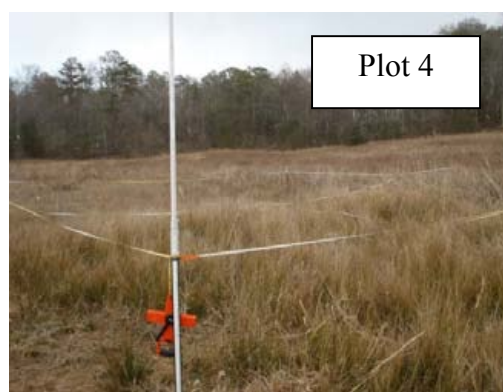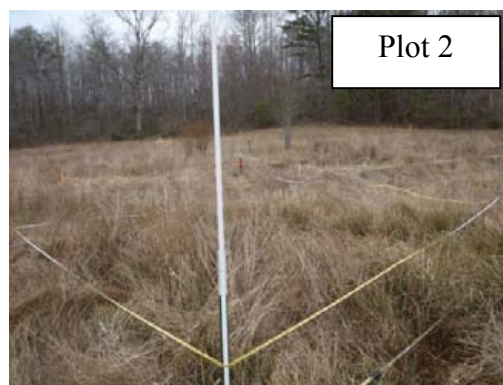

**UT to Martin's Creek (Contreras)  
Baseline Vegetation Monitoring Photographs  
Taken March 25-26, 2014  
(continued)**

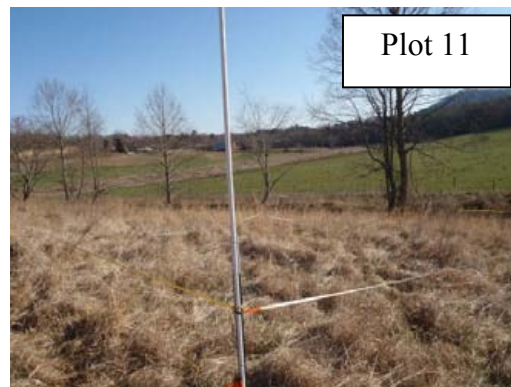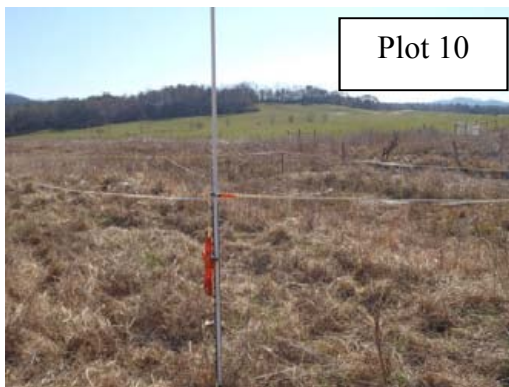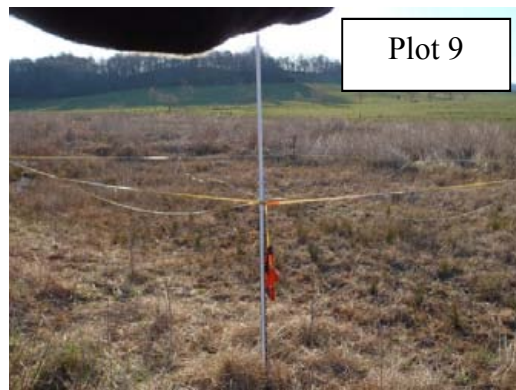

**Appendix C.**  
**Vegetation Plot Data**

Table 5. Planted Stems

Table 6. Planted and Total Stem Counts

**Table 5. Planted Woody Vegetation**

Species	Quantity
<b>Bare Root</b>	
River birch ( <i>Betula nigra</i> )	410
Pignut hickory ( <i>Carya glabra</i> )	400
Mockernut hickory ( <i>Carya tomentosa/alba</i> )	400
Persimmon ( <i>Diospyros virginiana</i> )	200
Tulip poplar ( <i>Liriodendron tulipifera</i> )	410
Sycamore ( <i>Platanus occidentalis</i> )	412
Scarlet oak ( <i>Quercus coccinea</i> )	700
Cherrybark oak ( <i>Quercus pagoda</i> )	512
Water oak ( <i>Quercus nigra</i> )	12
Northern red oak ( <i>Quercus rubra</i> )	412
<b>1-gallon Containers</b>	
Common serviceberry ( <i>Amelanchier arborea</i> )	25
Tag alder ( <i>Alnus serrulata</i> )	3
Ironwood ( <i>Carpinus caroliniana</i> )	50
Winterberry ( <i>Ilex verticillata</i> )	3
<b>TOTAL</b>	<b>3949</b>

**Table 6. Total and Planted Stem Counts**

EEP Project Code 92766. Project Name: UT to Martin's Creek (Contreras)

			Current Plot Data (MYO 2014)																							
Scientific Name	Common Name	Species Type	92766-01-0001			92766-01-0002			92766-01-0003			92766-01-0004			92766-01-0005			92766-01-0006			92766-01-0007			92766-01-0008		
			PnoLS	P-all	T	PnoLS	P-all	T	PnoLS	P-all	T	PnoLS	P-all	T	PnoLS	P-all	T	PnoLS	P-all	T	PnoLS	P-all	T	PnoLS	P-all	T
Alnus serrulata	hazel alder	Shrub																								
Amelanchier arborea	common serviceberry	Tree																								
Betula nigra	river birch	Tree	4	4	4							2	2	2	2	2	2	5	5	5	3	3	3			
Carpinus caroliniana	American hornbeam	Tree													4	4	4									
Carya	hickory	Tree				2	2	2																		
Carya alba	mockernut hickory	Tree	1	1	1	1	1	1	3	3	3															
Carya glabra	pignut hickory	Tree										1	1	1						1	1	1				
Cornus amomum	silky dogwood	Shrub													1	1										
Diospyros virginiana	common persimmon	Tree																								
Liriodendron tulipifera	tuliptree	Tree												3	3	3	1	1	1				1	1	1	
Platanus occidentalis	American sycamore	Tree																								
Quercus	oak	Tree	5	5	5	4	4	4	3	3	3	6	6	6	1	1	1	8	8	8	4	4	4	7	7	7
Quercus pagoda	cherrybark oak	Tree										2	2	2						1	1	1				
Quercus nigra	water oak	Tree																					1	1	1	
Quercus rubra	northern red oak	Tree																					1	1	1	
Salix nigra	black willow	Tree			1																					
Unknown		Shrub or Tree																								
<b>Stem count</b>			10	10	11	7	7	7	6	6	6	11	11	11	10	11	11	14	14	14	9	9	9	10	10	10
<b>size (ares)</b>			1			1			1			1			1			1			1			1		
<b>size (ACRES)</b>			0.02			0.02			0.02			0.02			0.02			0.02			0.02			0.02		
<b>Species count</b>			3	3	4	3	3	3	2	2	2	4	4	4	4	5	5	3	3	3	4	4	4	4	4	4
<b>Stems per ACRE</b>			404.7	404.7	445.2	283.3	283.3	283.3	242.8	242.8	242.8	445.2	445.2	445.2	404.7	445.2	445.2	566.6	566.6	566.6	364.2	364.2	364.2	404.7	404.7	404.7

**Color for Density**

Exceeds requirements by 10%

Exceeds requirements, but by less than 10%

Fails to meet requirements, by less than 10%

Fails to meet requirements by more than 10%

PnoLS = Planted stems excluding live stakes

P-all = Planted stems including live stakes

T = Planted stems and natural recruits

Total includes stems of natural recruits



**Table 6. Total and Planted Stem Counts**

EEP Project Code 92766. Project Name: UT to Martin's Creek (Contreras)

Scientific Name	Common Name	Species Type	Current Plot Data (MY) 2014)									Annual Means		
			92766-01-0009			92766-01-0010			92766-01-0011			MY0 (2014)		
			PnoLS	P-all	T	PnoLS	P-all	T	PnoLS	P-all	T	PnoLS	P-all	T
Alnus serrulata	hazel alder	Shrub						1						1
Amelanchier arborea	common serviceberry	Tree	3	3	3							3	3	3
Betula nigra	river birch	Tree				3	3	3				19	19	19
Carpinus caroliniana	American hornbeam	Tree	1	1	1							5	5	5
Carya	hickory	Tree										2	2	2
Carya alba	mockernut hickory	Tree										5	5	5
Carya glabra	pignut hickory	Tree							3	3	3	5	5	5
Cornus amomum	silky dogwood	Shrub								1		1	2	
Diospyros virginiana	common persimmon	Tree	1	1	1							1	1	1
Liriodendron tulipifera	tuliptree	Tree	1	1	1				1	1	1	7	7	7
Platanus occidentalis	American sycamore	Tree	6	6	6	3	3	3	1	1	1	10	10	10
Quercus	oak	Tree	6	6	6	1	1	1	4	4	4	49	49	49
Quercus pagoda	cherrybark oak	Tree				2	2	2				5	5	5
Quercus nigra	water oak	Tree										1	1	1
Quercus rubra	northern red oak	Tree										1	1	1
Salix nigra	black willow	Tree												1
Unknown		Shrub or Tree									6			6
<b>Stem count</b>			18	18	18	9	9	10	9	9	16	113	114	123
<b>size (ares)</b>			1			1			1			11		
<b>size (ACRES)</b>			0.02			0.02			0.02			0.27		
<b>Species count</b>			6	6	6	4	4	5	4	4	6	13	14	17
<b>Stems per ACRE</b>			728.4	728.4	728.4	364.2	364.2	404.7	364.2	364.2	647.5	415.7	419.4	452.5

**Color for Density**

Exceeds requirements by 10%

Exceeds requirements, but by less than 10%

Fails to meet requirements, by less than 10%

Fails to meet requirements by more than 10%

PnoLS = Planted stems excluding live stakes

P-all = Planted stems including live stakes

T = Planted stems and natural recruits

Total includes stems of natural recruits

**Appendix D.**  
**Stream Geomorphology Data**

Tables 7a-7f. Baseline Stream Data Summary  
Tables 8a-8f. Monitoring Data-Dimensional Data Summary  
Cross-section Plots  
Longitudinal Profile Plots



**Table 7c. Baseline Stream Data Summary (UT 1-1 and UT 1-2 to Martin's Creek)  
UT to Martin's Creek Mitigation Project - EEP Project Number 92766**

Parameter	Gauge	Regional Curve			Pre-Existing Condition					Reference Reach(es) Data					Design			Monitoring Baseline				
		LL	UL	Eq.	Min	Mean	Med	Max	SD	Min	Mean	Med	Max	SD	Min	Max	Med	Min	Mean	Med	Max	SD
<b>Dimension and Substrate - Riffle Only</b>																						
BF Width (ft)					4.5			6.7		11.7			21.7				4.5		2.9			
Floodprone Width (ft)					5.4			8.5		20			410				13.5		14			
BF Mean Depth (ft)					0.3			0.4		0.6			1.0				0.4		0.5			
BF Max Depth (ft)					0.5			1.0		0.9			2.5				0.5		0.7			
BF Cross Sectional Area (ft <sup>2</sup> )					1.5			2.4		10.2			13.1				1.7		1.4			
Width/Depth Ratio					13.2			18.9		10.7			17.0				12.0		6.0			
Entrenchment Ratio					1.2			1.6		1.7			32.0				3.0		4.8			
Bank Height Ratio					1.0			4.4		1.0			1.0				1.0		1.0			
<b>Profile</b>																						
Riffle length (ft)																		5	24	15	67	21
Riffle slope (ft/ft)										0.2000			1.9000				0.0140	0.0000	0.0357	0.0332	0.1101	0.0245
Pool length (ft)																		4.0	8.0	8.0	14.0	2.3
Pool Max depth (ft)										2.2			2.5				0.8	----	----	----	----	----
Pool spacing (ft)										48.0			231.0				32.0	6.0	32.0	23.0	78.0	22.0
<b>Pattern</b>																						
Channel Beltwidth (ft)										16			55									
Radius of Curvature (ft)										28			47				34			34		
Rc:Bankfull width (ft/ft)										2			3				7.6			7.6		
Meander Wavelength (ft)										70			260									
Meander Width ratio										4.4			17.6									
<b>Transport parameters</b>																						
Reach Shear Stress (competency) lbs/ft <sup>2</sup>																						
Max part size (mm) mobilized at bankfull																						
Stream Power (transport capacity) W/m <sup>2</sup>																						
<b>Additional Reach Parameters</b>																						
Rosgen Classification					C					Aa/Bc					C			E				
Bankfull Velocity (fps)					3.5 - 4.1										3.5 - 4.1							
Bankfull Discharge (cfs)					6.0 - 7.0																	
Valley Length (ft)																						
Channel Thalweg Length (ft)																		580				
Sinuosity					1.02 - 1.08					1.19					1.03			1.03				
Water Surface Slope (ft/ft)					0.0096 - 0.0333					0.0333					0.0096 - 0.0333			0.0383				
BF slope (ft/ft)					----					----					----			----				
Bankfull Floodplain Area (acres)					----					----					----			----				
% of Reach with Eroding Banks					----					----					----			----				
Channel Stability or Habitat Metric					----					----					----			----				
Biological or Other					----					----					----			----				

**Table 7d. Baseline Stream Data Summary (Substrate, Bed, Bank, and Hydrologic Containment Parameter Distributions)  
UT to Martin's Creek Mitigation Project - EEP Project Number 92766**

Parameter	Pre-Existing Condition					Reference Reach(es) Data					Design					Monitoring Baseline									
Ri%/RU%P%G%/S%																									
SC%/SA%/G%/C%/B%BE%																									
d16/d35/d50/d84/d95																									
Entrainment Class <1.5/1.5-1.99/2.0-4.9/5.0-																									
Incision Class <1.2/1.2-1.49/1.5-1.99/>2.0																									

**Table 7e. Baseline Stream Data Summary (UT 1-3 to Martin's Creek)  
UT to Martin's Creek Mitigation Project - EEP Project Number 92766**

Parameter	Gauge	Regional Curve			Pre-Existing Condition					Reference Reach(es) Data					Design			Monitoring Baseline				
		LL	UL	Eq.	Min	Mean	Med	Max	SD	Min	Mean	Med	Max	SD	Min	Max	Med	Min	Mean	Med	Max	SD
<b>Dimension and Substrate - Riffle Only</b>																						
BF Width (ft)					6.3			14.3		11.7			21.7				6.5	5.9	6.6	6.6	7.3	1
Floodprone Width (ft)					10.2			32.6		20			410				14.0		25	25		
BF Mean Depth (ft)					0.2			0.5		0.6			1.0				0.5	0.4	0.5	0.5	0.5	0.1
BF Max Depth (ft)					0.8			1.0		0.9			2.5				0.7	0.9	1.0	1.0	1.0	0.1
BF Cross Sectional Area (ft <sup>2</sup> )					3.2			3.5		10.2			13.1				3.5	2.7	3.2	3.2	3.6	0.6
Width/Depth Ratio					12.5			58.6		10.7			17.0				12.0	14.6	14.7	14.7	14.8	0.1
Entrenchment Ratio					>1.6			2.3		1.7			32.0				2.2	3.4	3.8	3.8	4.2	0.6
Bank Height Ratio					1.2			1.3		1.0			1.0				1.0		1.0	1.0		
<b>Profile</b>																						
Riffle length (ft)																		4	41	22	173	44
Riffle slope (ft/ft)										0.2000			1.9000				0.0140	0.0047	0.0318	0.0326	0.0913	0.0218
Pool length (ft)																		5.0	12.0	7.0	50.0	11.0
Pool Max depth (ft)										2.2			2.5				1.1					
Pool spacing (ft)										48.0			231.0				45.0	11.0	51.0	31.0	178.0	43.0
<b>Pattern</b>																						
Channel Beltwidth (ft)										16			55									
Radius of Curvature (ft)										28			47									
Rc:Bankfull width (ft/ft)										2			3									
Meander Wavelength (ft)										70			260									
Meander Width ratio										4.4			17.6									
<b>Transport parameters</b>																						
Reach Shear Stress (competency) lbs/ft <sup>2</sup>																						
Max part size (mm) mobilized at bankfull																						
Stream Power (transport capacity) W/m <sup>2</sup>																						
<b>Additional Reach Parameters</b>																						
Rosgen Classification					B					Aa/Bc					B			C/E				
Bankfull Velocity (fps)					2.5 - 2.9										2.3							
Bankfull Discharge (cfs)					8.0 - 10.0																	
Valley Length (ft)																						
Channel Thalweg Length (ft)																		813				
Sinuosity					1.08					1.19					1.08			1.08				
Water Surface Slope (ft/ft)					0.0275					0.0333					0.0275			0.0321				
BF slope (ft/ft)					----					----					----			----				
Bankfull Floodplain Area (acres)					----					----					----			----				
% of Reach with Eroding Banks					----					----					----			----				
Channel Stability or Habitat Metric					----					----					----			----				
Biological or Other					----					----					----			----				

**Table 7f. Baseline Stream Data Summary (Substrate, Bed, Bank, and Hydrologic Containment Parameter Distributions)  
UT to Martin's Creek Mitigation Project - EEP Project Number 92766**

Parameter	Pre-Existing Condition					Reference Reach(es) Data					Design					Monitoring Baseline									
Ri%/RU%P%G%/S%																									
SC%/SA%/G%/C%/B%BE%																									
d16/d35/d50/d84/d95																									
Entrainment Class <1.5/1.5-1.99/2.0-4.9/5.0-																									
Incision Class <1.2/1.2-1.49/1.5-1.99/>2.0																									










<b>Site</b>	UT to Martins
<b>Watershed:</b>	Hiwassee
<b>XS ID</b>	XS - 1, Riffle
<b>Feature</b>	Riffle
<b>Date:</b>	4/4/2014
<b>Field Crew:</b>	Perkinson, Jernigan



<b>Stream Type</b>	E
--------------------	---

Station	Elevation
0.00	90.67
1.84	90.67
3.11	90.60
4.50	89.81
5.32	89.22
5.54	89.02
6.14	88.90
6.96	88.87
8.35	88.91
9.82	88.91
11.13	88.93
11.79	89.58
12.33	89.89
12.93	90.02
15.11	90.65
16.1	90.59
16.7	90.59

SUMMARY DATA	
<b>Bankfull Elevation:</b>	90.6
<b>Bankfull Cross-Sectional Area:</b>	13.3
<b>Bankfull Width:</b>	11.7
<b>Flood Prone Area Elevation:</b>	92.3
<b>Flood Prone Width:</b>	100.0
<b>Max Depth at Bankfull:</b>	1.7
<b>Mean Depth at Bankfull:</b>	1.1
<b>W / D Ratio:</b>	10.3
<b>Entrenchment Ratio:</b>	8.5
<b>Bank Height Ratio:</b>	1.0

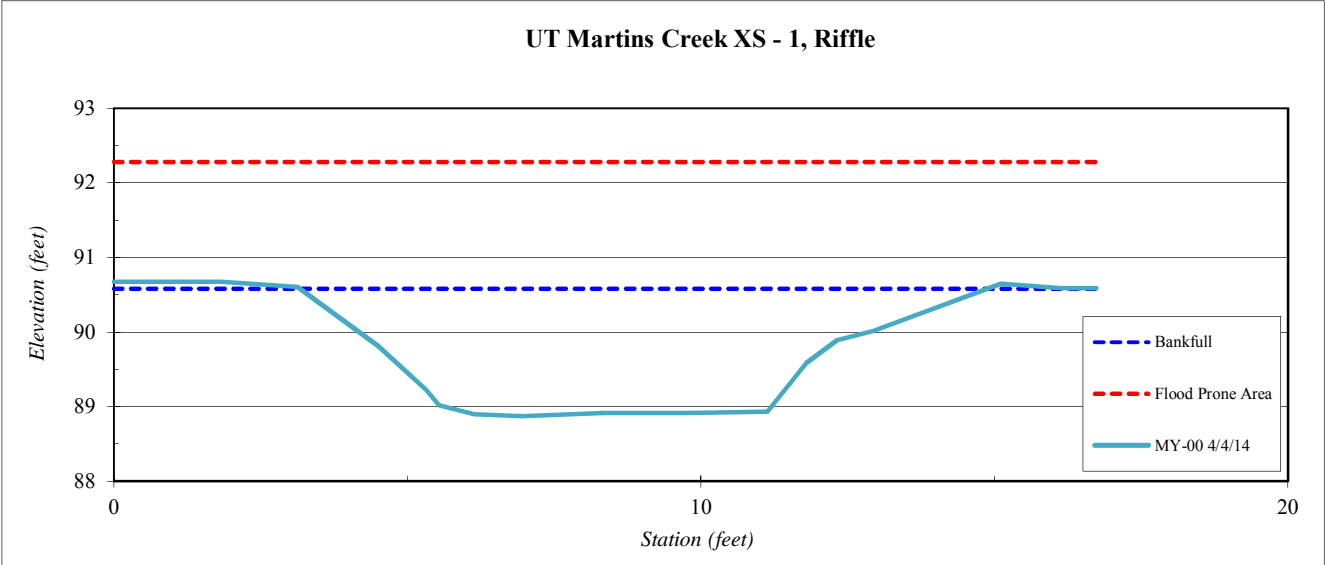


<b>Site</b>	UT to Martins
<b>Watershed:</b>	Hiwassee
<b>XS ID</b>	XS - 2, Riffle
<b>Feature</b>	Riffle
<b>Date:</b>	4/4/2014
<b>Field Crew:</b>	Perkinson, Jernigan



<b>Stream Type</b>	E
--------------------	---

Station	Elevation
0.00	93.21
1.43	93.19
3.20	92.61
4.17	92.31
4.89	91.50
6.15	91.48
7.33	91.46
8.10	91.27
8.86	91.34
10.21	91.36
11.01	92.10
11.82	92.34
14.26	93.08
16.64	93.19

<b>SUMMARY DATA</b>	
<b>Bankfull Elevation:</b>	93.1
<b>Bankfull Cross-Sectional Area:</b>	13.4
<b>Bankfull Width:</b>	12.5
<b>Flood Prone Area Elevation:</b>	94.9
<b>Flood Prone Width:</b>	100.0
<b>Max Depth at Bankfull:</b>	1.8
<b>Mean Depth at Bankfull:</b>	1.1
<b>W / D Ratio:</b>	11.7
<b>Entrenchment Ratio:</b>	8.0
<b>Bank Height Ratio:</b>	1.0

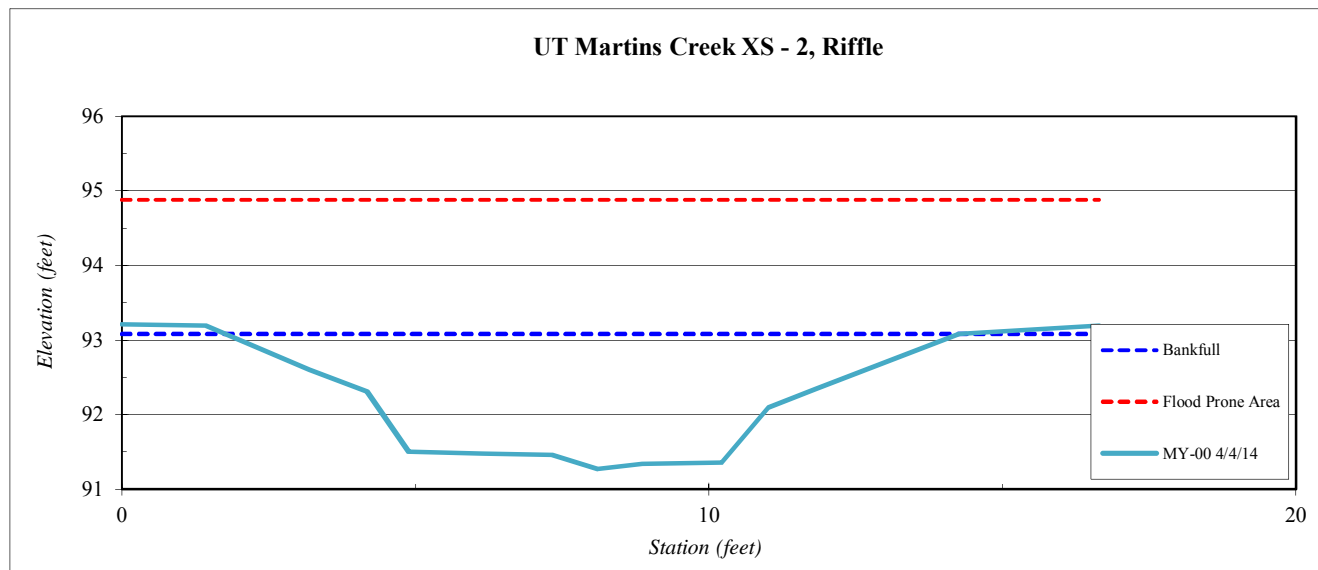


<b>Site</b>	UT to Martins
<b>Watershed:</b>	Hiwassee
<b>XS ID</b>	XS - 3, Pool
<b>Feature</b>	Pool
<b>Date:</b>	4/4/2014
<b>Field Crew:</b>	Perkinson, Jernigan

Station	Elevation
0.0	94.1
2.8	93.9
3.9	93.3
4.6	93.1
5.1	92.6
6.5	92.0
7.4	91.7
8.4	91.4
9.2	91.4
10.1	91.7
10.7	91.7
11.3	92.3
12.4	92.5
13.5	93.2
14.6	93.3
16.7	93.5
19.7	94.0
21.9	94.2

SUMMARY DATA	
<b>Bankfull Elevation:</b>	93.9
<b>Bankfull Cross-Sectional Area:</b>	19.9
<b>Bankfull Width:</b>	16.4
<b>Flood Prone Area Elevation:</b>	NA
<b>Flood Prone Width:</b>	NA
<b>Max Depth at Bankfull:</b>	2.5
<b>Mean Depth at Bankfull:</b>	1.2
<b>W / D Ratio:</b>	NA
<b>Entrenchment Ratio:</b>	NA
<b>Bank Height Ratio:</b>	1.0



<b>Stream Type</b>	E
--------------------	---

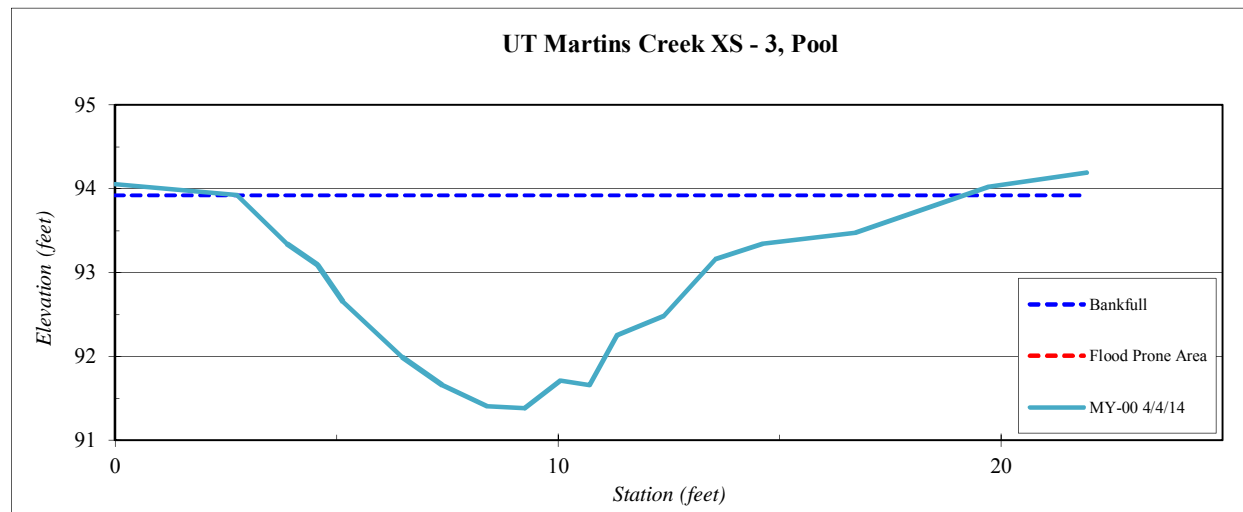

<b>Site</b>	UT to Martins
<b>Watershed:</b>	Hiwassee
<b>XS ID</b>	XS - 4, Riffle
<b>Feature</b>	Riffle
<b>Date:</b>	4/4/2014
<b>Field Crew:</b>	Perkinson, Jernigan




Stream Type

Station	Elevation
0.00	95.86
2.78	95.68
5.57	94.64
6.56	94.17
6.83	93.94
7.69	93.82
8.56	93.74
9.97	93.78
10.86	93.78
11.65	94.00
12.70	94.02
13.46	94.49
14.31	94.88
15.52	95.02
17.15	95.49
18.8	95.61

SUMMARY DATA	
<b>Bankfull Elevation:</b>	95.5
<b>Bankfull Cross-Sectional Area:</b>	14.7
<b>Bankfull Width:</b>	13.8
<b>Flood Prone Area Elevation:</b>	97.3
<b>Flood Prone Width:</b>	100.0
<b>Max Depth at Bankfull:</b>	1.8
<b>Mean Depth at Bankfull:</b>	1.1
<b>W / D Ratio:</b>	13.0
<b>Entrenchment Ratio:</b>	7.2
<b>Bank Height Ratio:</b>	1.0

UT Martins Creek XS - 4, Riffle

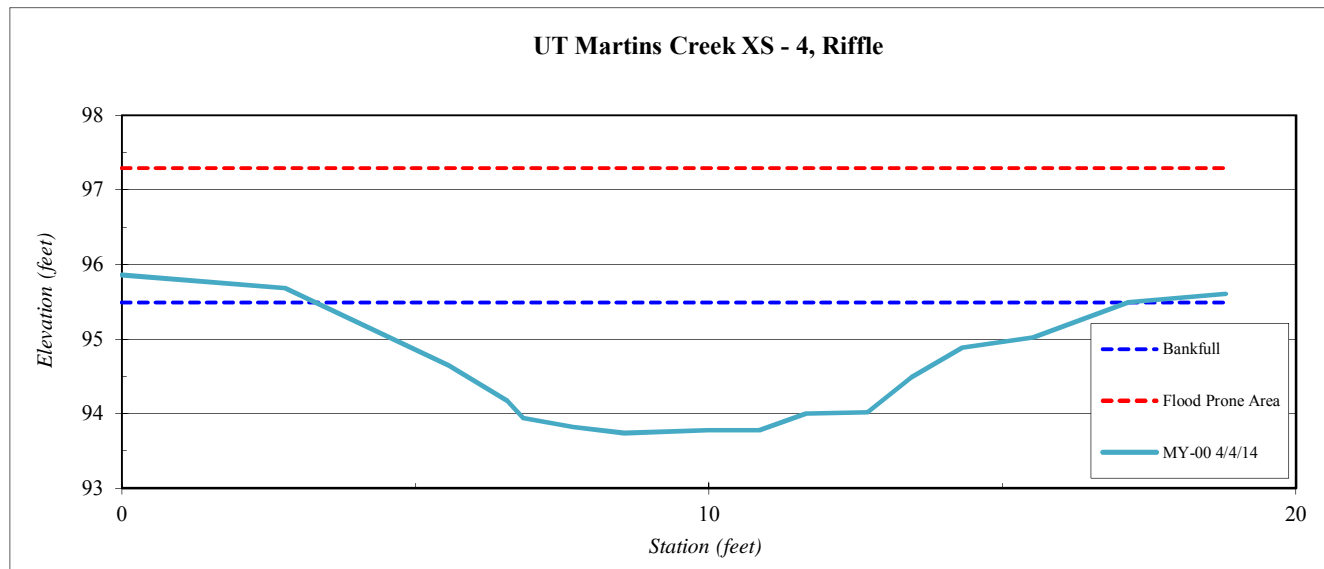


<b>Site</b>	UT to Martins
<b>Watershed:</b>	Hiwassee
<b>XS ID</b>	XS - 5, Riffle
<b>Feature</b>	Riffle
<b>Date:</b>	4/4/2014
<b>Field Crew:</b>	Perkinson, Jernigan



<b>Stream Type</b>	E
--------------------	---

Station	Elevation
0.00	95.91
1.69	95.81
3.12	95.51
4.30	95.06
4.97	94.69
5.37	94.40
5.75	94.06
6.34	93.99
7.54	93.96
8.01	93.97
8.86	94.10
10.03	94.11
10.73	94.71
11.46	95.02
12.93	95.51
14.3	96.01
15.8	96.07

SUMMARY DATA	
<b>Bankfull Elevation:</b>	95.8
<b>Bankfull Cross-Sectional Area:</b>	12.8
<b>Bankfull Width:</b>	12.1
<b>Flood Prone Area Elevation:</b>	97.6
<b>Flood Prone Width:</b>	50.0
<b>Max Depth at Bankfull:</b>	1.8
<b>Mean Depth at Bankfull:</b>	1.1
<b>W / D Ratio:</b>	11.4
<b>Entrenchment Ratio:</b>	4.1
<b>Bank Height Ratio:</b>	1.0

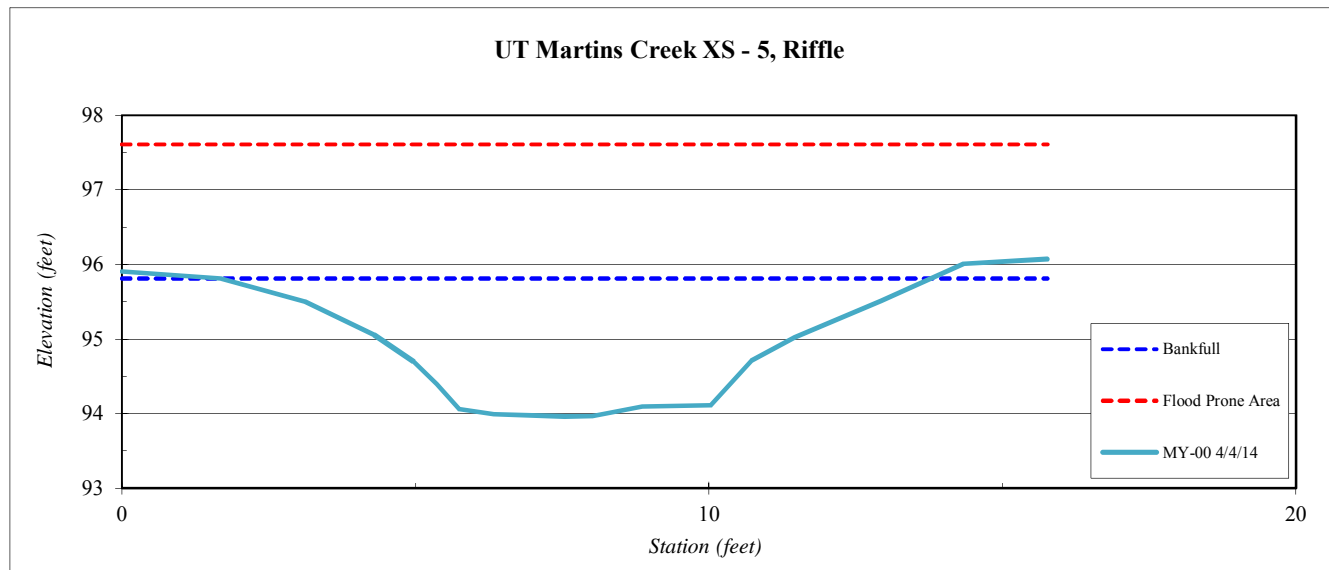


<b>Site</b>	UT to Martins
<b>Watershed:</b>	Hiwassee
<b>XS ID</b>	XS - 6, Pool
<b>Feature</b>	Pool
<b>Date:</b>	4/4/2014
<b>Field Crew:</b>	Perkinson, Jernigan



Station	Elevation
0.00	97.15
2.48	97.11
6.67	96.14
7.56	95.81
8.00	94.85
9.12	94.49
10.25	94.35
11.46	94.62
12.34	95.03
13.24	95.50
13.78	95.60
14.28	96.36
15.02	96.73
15.52	97.12
17.48	97.14
18.73	97.13

SUMMARY DATA	
<b>Bankfull Elevation:</b>	97.1
<b>Bankfull Cross-Sectional Area:</b>	18.3
<b>Bankfull Width:</b>	13.0
<b>Flood Prone Area Elevation:</b>	NA
<b>Flood Prone Width:</b>	NA
<b>Max Depth at Bankfull:</b>	2.8
<b>Mean Depth at Bankfull:</b>	1.4
<b>W / D Ratio:</b>	NA
<b>Entrenchment Ratio:</b>	NA
<b>Bank Height Ratio:</b>	1.0

<b>Stream Type</b>	E
--------------------	---

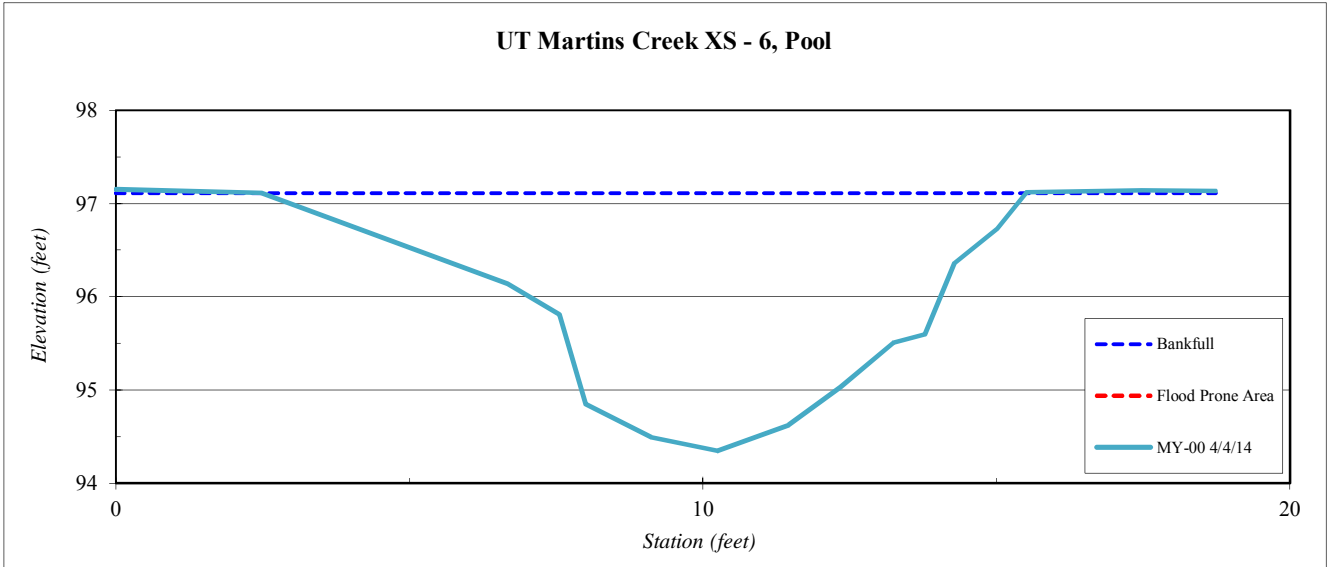


<b>Site</b>	UT to Martins
<b>Watershed:</b>	Hiwassee
<b>XS ID</b>	XS - 7, Riffle
<b>Feature</b>	Riffle
<b>Date:</b>	4/4/2014
<b>Field Crew:</b>	Perkinson, Jernigan



Station	Elevation
0.00	98.16
1.15	98.11
3.11	97.42
4.05	97.25
4.23	97.07
4.72	96.69
5.39	96.81
6.39	96.68
7.26	96.68
8.51	96.65
9.25	96.62
10.20	96.56
10.91	97.10
12.18	97.84
13.36	98.28
15.0	98.18

SUMMARY DATA	
<b>Bankfull Elevation:</b>	98.1
<b>Bankfull Cross-Sectional Area:</b>	11.7
<b>Bankfull Width:</b>	11.7
<b>Flood Prone Area Elevation:</b>	99.6
<b>Flood Prone Width:</b>	50.0
<b>Max Depth at Bankfull:</b>	1.5
<b>Mean Depth at Bankfull:</b>	1.0
<b>W / D Ratio:</b>	11.7
<b>Entrenchment Ratio:</b>	4.3
<b>Bank Height Ratio:</b>	1.0

<b>Stream Type</b>	E
--------------------	---

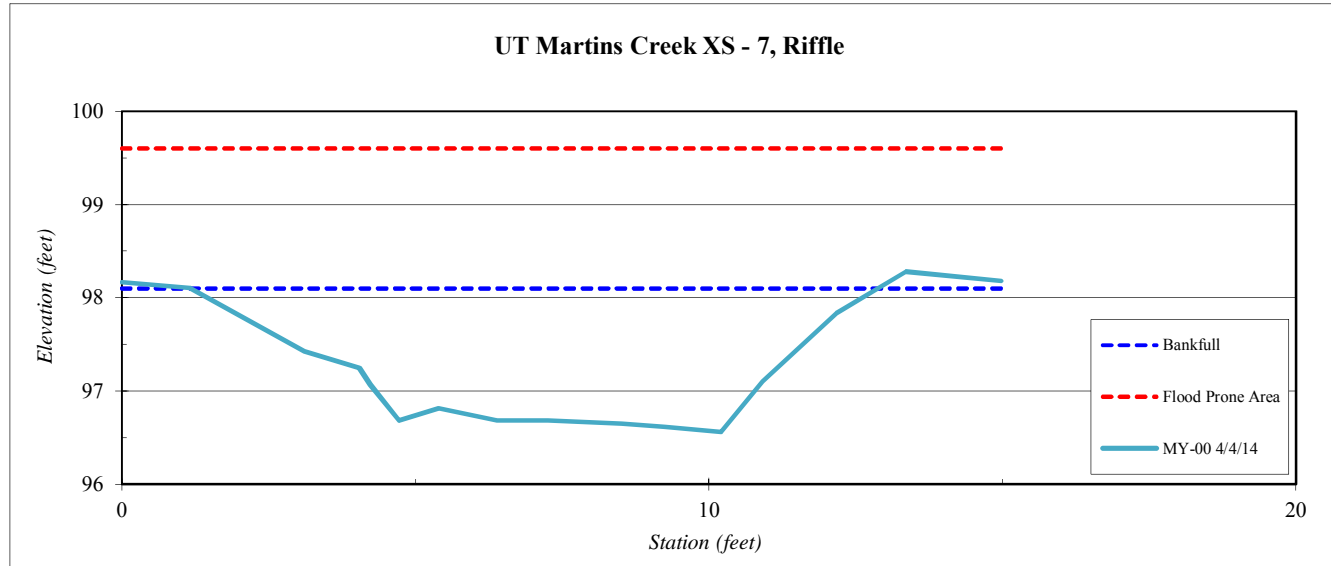


<b>Site</b>	UT to Martins
<b>Watershed:</b>	Hiwassee
<b>XS ID</b>	XS - 8, Riffle
<b>Feature</b>	Riffle
<b>Date:</b>	4/4/2014
<b>Field Crew:</b>	Perkinson, Jernigan



<b>Stream Type</b>	E
--------------------	---

Station	Elevation
0.00	99.76
0.03	99.77
1.71	99.61
2.90	99.26
3.93	99.10
4.58	98.79
5.11	98.70
5.70	98.19
6.43	98.06
7.62	98.14
9.02	98.09
9.97	98.11
10.51	98.07
11.25	98.54
12.12	98.88
13.0	99.34
14.6	99.82
16.3	99.80

SUMMARY DATA	
<b>Bankfull Elevation:</b>	99.6
<b>Bankfull Cross-Sectional Area:</b>	11.8
<b>Bankfull Width:</b>	12.2
<b>Flood Prone Area Elevation:</b>	101.1
<b>Flood Prone Width:</b>	50.0
<b>Max Depth at Bankfull:</b>	1.5
<b>Mean Depth at Bankfull:</b>	1.0
<b>W / D Ratio:</b>	12.6
<b>Entrenchment Ratio:</b>	4.1
<b>Bank Height Ratio:</b>	1.0

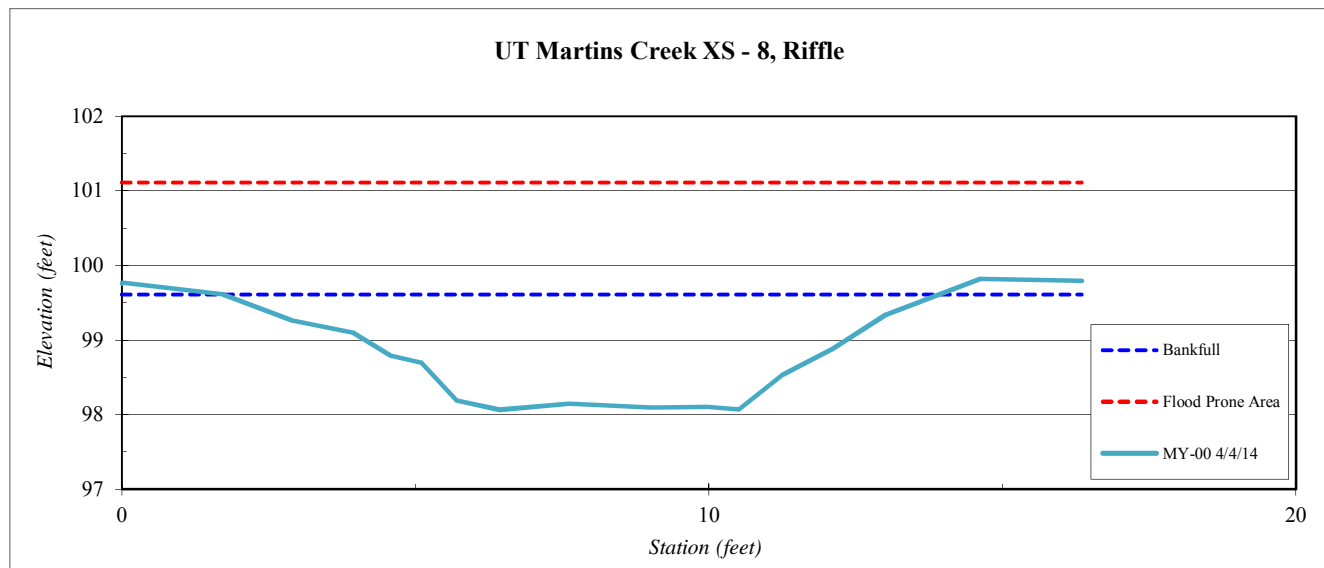




<b>Site</b>	UT to Martins
<b>Watershed:</b>	Hiwassee
<b>XS ID</b>	XS - 9, Pool
<b>Feature</b>	Pool
<b>Date:</b>	4/4/2014
<b>Field Crew:</b>	Perkinson, Jernigan



SUMMARY DATA	
<b>Bankfull Elevation:</b>	100.9
<b>Bankfull Cross-Sectional Area:</b>	15.5
<b>Bankfull Width:</b>	9.4
<b>Flood Prone Area Elevation:</b>	NA
<b>Flood Prone Width:</b>	NA
<b>Max Depth at Bankfull:</b>	2.3
<b>Mean Depth at Bankfull:</b>	1.6
<b>W / D Ratio:</b>	NA
<b>Entrenchment Ratio:</b>	NA
<b>Bank Height Ratio:</b>	1.0

Station	Elevation
0.00	101.35
2.25	101.28
3.81	101.07
4.89	100.72
5.62	100.06
6.50	99.12
7.41	98.76
8.79	98.53
9.06	98.60
10.32	98.73
11.49	98.88
12.50	98.98
12.91	99.34
13.79	100.87
15.60	101.42
17.35	101.64

Stream Type	E
-------------	---

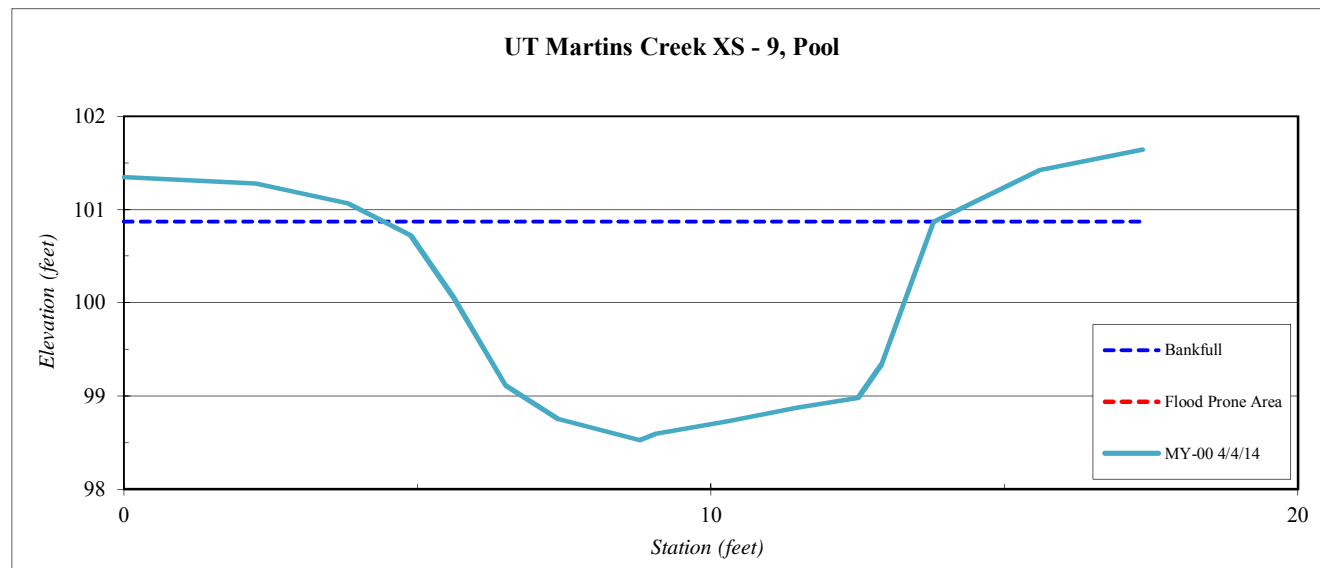


<b>Site</b>	UT to Martins
<b>Watershed:</b>	Hiwassee
<b>XS ID</b>	XS - 10, Pool
<b>Feature</b>	Pool
<b>Date:</b>	4/4/2014
<b>Field Crew:</b>	Perkinson, Jernigan



<b>Stream Type</b>	E
--------------------	---

Station	Elevation
0.00	98.76
1.96	98.93
3.01	98.93
3.93	98.68
4.42	98.35
5.14	97.36
5.77	96.69
6.56	96.17
8.13	95.99
9.16	96.29
9.86	96.63
10.72	96.56
11.11	97.01
11.72	97.29
12.36	97.69
12.82	98.47
13.99	99.28
15.23	99.32
16.54	99.32

SUMMARY DATA	
<b>Bankfull Elevation:</b>	98.8
<b>Bankfull Cross-Sectional Area:</b>	17.0
<b>Bankfull Width:</b>	9.6
<b>Flood Prone Area Elevation:</b>	NA
<b>Flood Prone Width:</b>	NA
<b>Max Depth at Bankfull:</b>	2.8
<b>Mean Depth at Bankfull:</b>	1.8
<b>W / D Ratio:</b>	NA
<b>Entrenchment Ratio:</b>	NA
<b>Bank Height Ratio:</b>	1.0

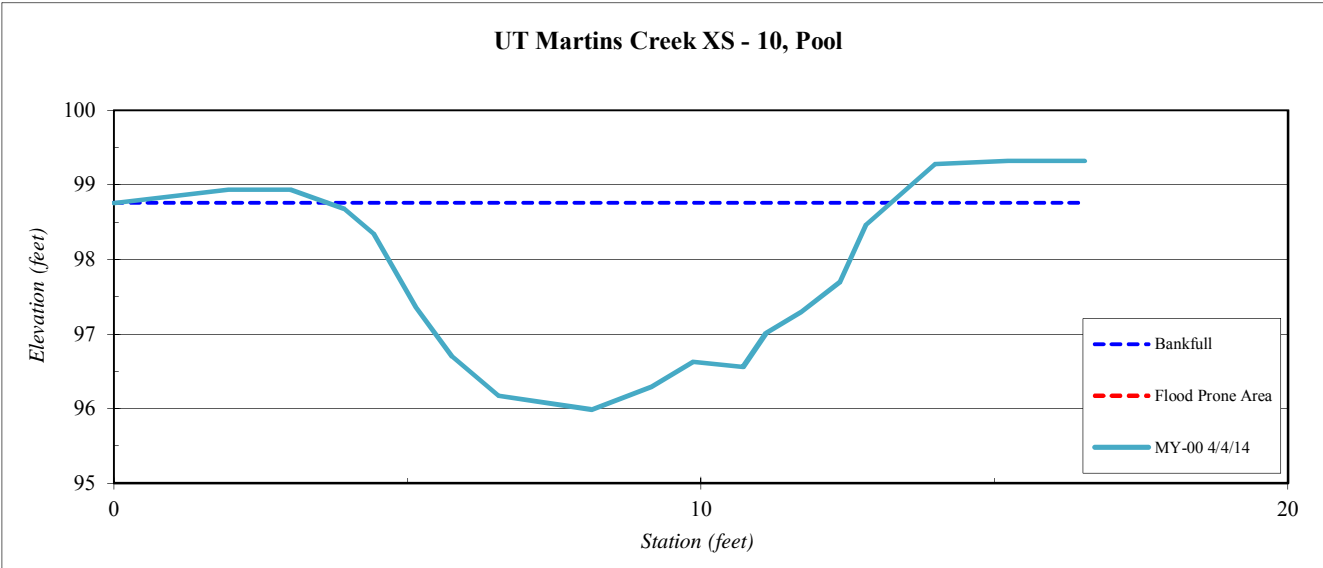


Site	UT to Martins
Watershed:	Hiwassee
XS ID	XS - 11, Riffle
Feature	Riffle
Date:	4/4/2014
Field Crew:	Perkinson, Jernigan



Stream Type E

Station	Elevation
0.00	100.63
1.68	100.60
2.44	100.17
3.39	99.95
3.84	99.93
4.54	99.58
5.14	99.18
6.11	98.94
7.09	98.86
8.19	98.97
9.08	98.92
9.95	98.92
10.58	98.99
11.09	99.43
12.50	99.87
14.7	100.46
16.5	100.38

SUMMARY DATA	
Bankfull Elevation:	100.4
Bankfull Cross-Sectional Area:	11.5
Bankfull Width:	12.3
Flood Prone Area Elevation:	101.9
Flood Prone Width:	50.0
Max Depth at Bankfull:	1.5
Mean Depth at Bankfull:	0.9
W / D Ratio:	13.2
Entrenchment Ratio:	4.1
Bank Height Ratio:	1.0

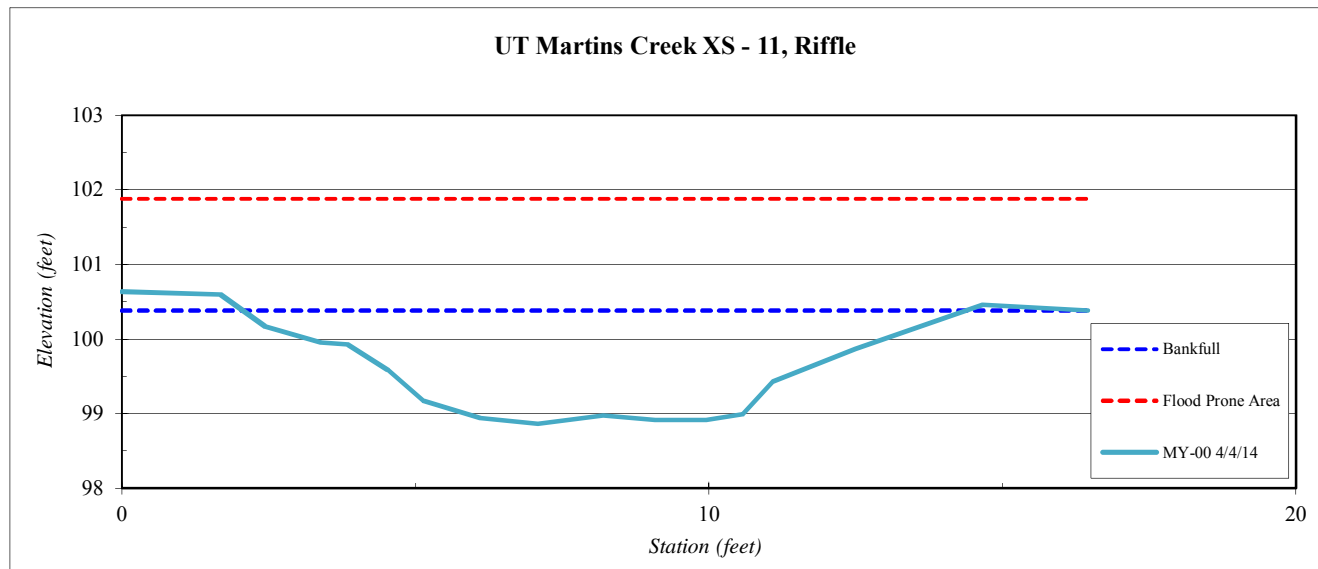


<b>Site</b>	UT to Martins
<b>Watershed:</b>	Hiwassee
<b>XS ID</b>	XS - 12, Riffle
<b>Feature</b>	Riffle
<b>Date:</b>	4/4/2014
<b>Field Crew:</b>	Perkinson, Jernigan



<b>Stream Type</b>	E
--------------------	---

Station	Elevation
0.00	111.68
1.58	111.47
2.50	110.98
3.76	110.54
5.24	109.64
6.32	109.14
7.68	108.73
8.83	108.45
9.21	107.91
9.54	107.76
10.02	107.87
10.43	107.75
10.68	107.83
10.92	107.80
11.34	108.32
12.0	108.56
13.9	108.85
18.0	108.98
20.3	109.24
21.7	109.40

SUMMARY DATA	
<b>Bankfull Elevation:</b>	108.5
<b>Bankfull Cross-Sectional Area:</b>	1.4
<b>Bankfull Width:</b>	2.9
<b>Flood Prone Area Elevation:</b>	109.2
<b>Flood Prone Width:</b>	14.0
<b>Max Depth at Bankfull:</b>	0.7
<b>Mean Depth at Bankfull:</b>	0.5
<b>W / D Ratio:</b>	6.0
<b>Entrenchment Ratio:</b>	4.8
<b>Bank Height Ratio:</b>	1.0

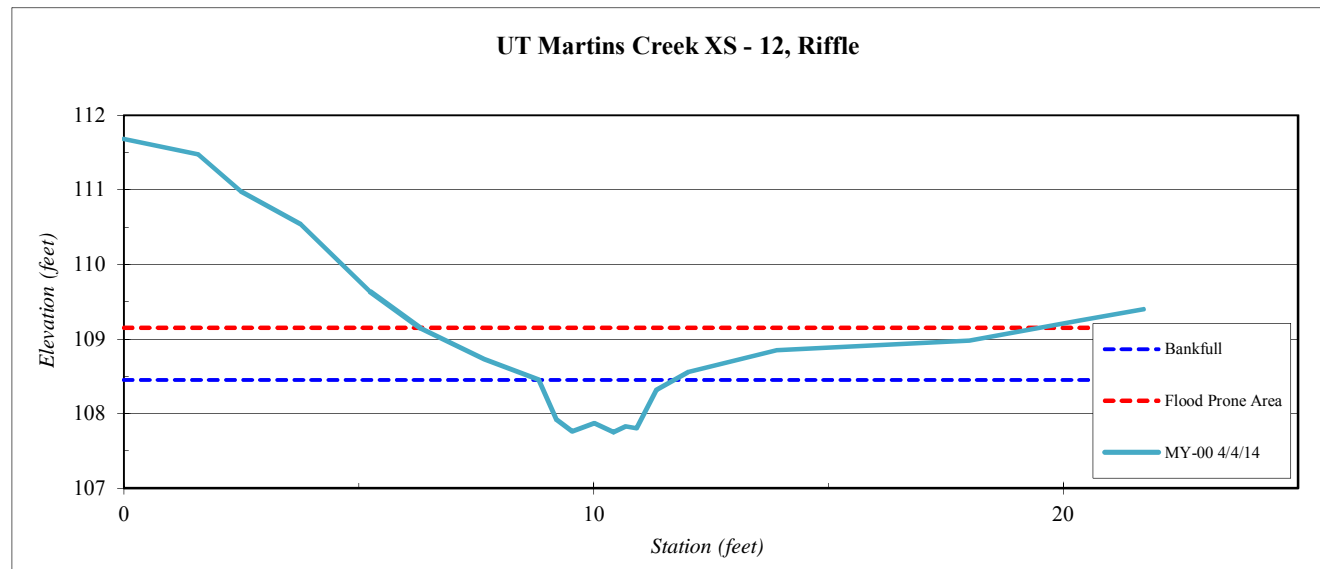


<b>Site</b>	UT to Martins
<b>Watershed:</b>	Hiwassee
<b>XS ID</b>	XS - 13, Riffle
<b>Feature</b>	Riffle
<b>Date:</b>	4/4/2014
<b>Field Crew:</b>	Perkinson, Jernigan

Station	Elevation
0.00	96.73
1.69	96.72
3.45	96.37
4.10	96.03
4.82	95.78
5.27	95.83
6.18	95.94
6.65	96.15
7.09	96.42
8.05	96.67
10.58	96.65

SUMMARY DATA	
<b>Bankfull Elevation:</b>	96.7
<b>Bankfull Cross-Sectional Area:</b>	2.7
<b>Bankfull Width:</b>	5.9
<b>Flood Prone Area Elevation:</b>	97.6
<b>Flood Prone Width:</b>	25.0
<b>Max Depth at Bankfull:</b>	0.9
<b>Mean Depth at Bankfull:</b>	0.5
<b>W / D Ratio:</b>	12.9
<b>Entrenchment Ratio:</b>	4.2
<b>Bank Height Ratio:</b>	1.0



Stream Type      C/E

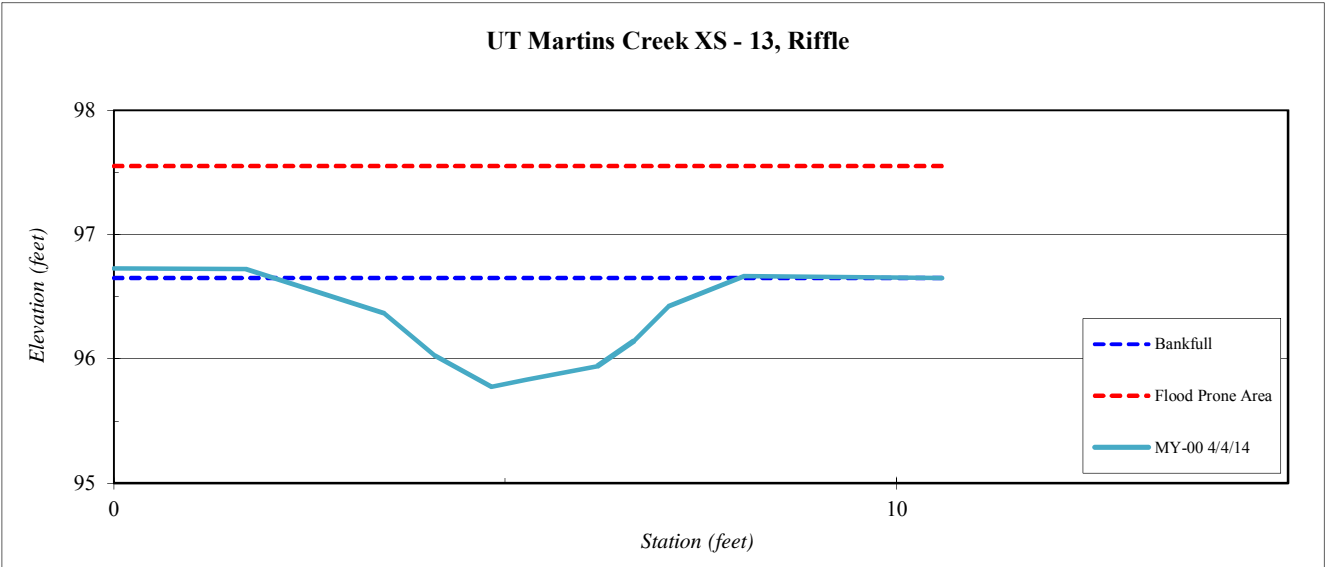


<b>Site</b>	UT to Martins
<b>Watershed:</b>	Hiwassee
<b>XS ID</b>	XS - 14, Riffle
<b>Feature</b>	Riffle
<b>Date:</b>	4/4/2014
<b>Field Crew:</b>	Perkinson, Jernigan

Station	Elevation
0.00	102.39
2.74	102.33
3.95	101.97
4.85	101.69
5.48	101.63
6.05	101.33
6.62	101.28
7.15	101.21
7.86	101.55
8.44	101.92
10.31	102.24
12.48	102.38

SUMMARY DATA	
<b>Bankfull Elevation:</b>	102.2
<b>Bankfull Cross-Sectional Area:</b>	3.6
<b>Bankfull Width:</b>	7.3
<b>Flood Prone Area Elevation:</b>	103.2
<b>Flood Prone Width:</b>	25.0
<b>Max Depth at Bankfull:</b>	1.0
<b>Mean Depth at Bankfull:</b>	0.5
<b>W / D Ratio:</b>	14.8
<b>Entrenchment Ratio:</b>	3.4
<b>Bank Height Ratio:</b>	1.0



<b>Stream Type</b>	C/E
--------------------	-----

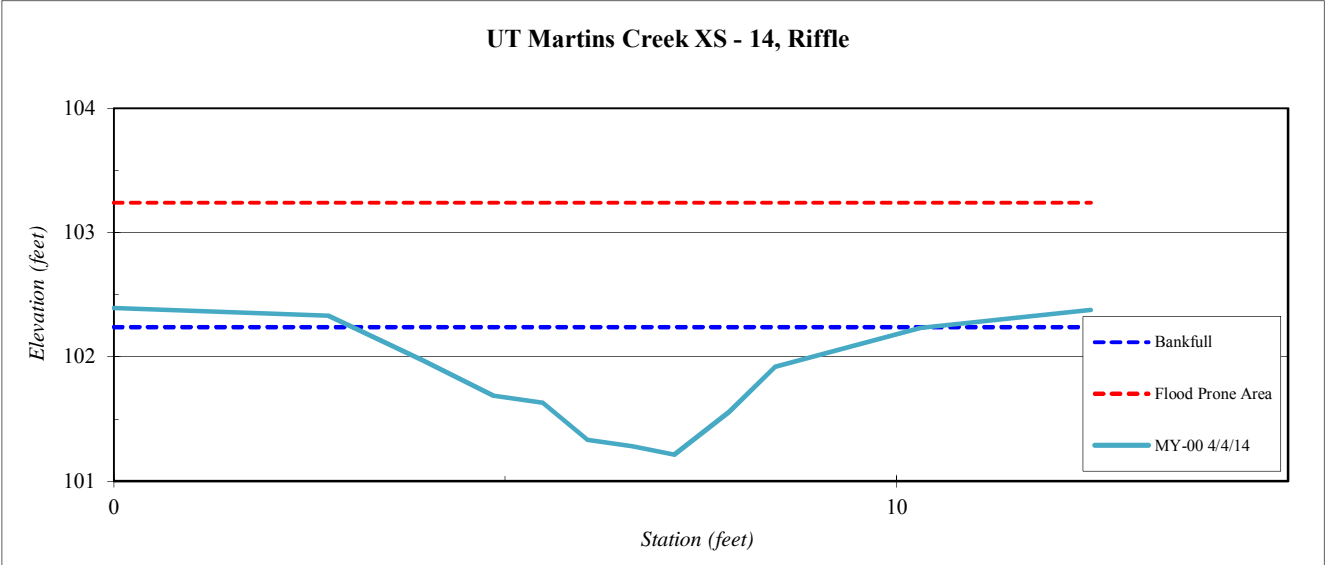


**Project Name** UT to Martins Creek - Profile  
**Reach** UT 1 Station 00+00 - 10+00  
**Feature** Profile  
**Date** 4/4/14  
**Crew** Perkinson, Jernigan

2014 Year 0 Monitoring \Survey			2014 Year 1 Monitoring \Survey			2015 Year 2 Monitoring \Survey			2016 Year 3 Monitoring \Survey			2017 Year 4 Monitoring \Survey		
Station	Bed Elevation	Water Elevation	Station	Bed Elevation	Water Elevation	Station	Bed Elevation	Water Elevation	Station	Bed Elevation	Water Elevation	Station	Bed Elevation	Water Elevation
0.0	89.1	89.4												
25.0	89.5	89.8												
31.7	88.8	89.8												
45.4	88.8	89.8												
48.5	90.2	90.3												
56.8	88.7	90.4												
68.6	88.3	90.3												
82.0	89.2	90.4												
84.6	90.7	90.8												
103.2	90.5	91.0												
109.4	89.8	91.0												
116.3	89.7	91.1												
126.5	89.8	91.0												
129.8	91.3	91.6												
135.2	90.5	91.6												
162.4	89.9	91.6												
180.3	90.3	91.7												
186.8	91.4	91.7												
207.9	91.7	92.2												
241.5	91.6	92.1												
255.9	90.6	92.1												
268.0	89.2	92.1												
285.6	90.8	92.2												
289.7	92.1	92.6												
324.3	92.6	93.0												
336.1	92.6	93.1												
344.1	92.0	93.1												
367.3	91.7	93.2												

	2014	2014	2015	2016	2017
Avg. Water Surface Slope	0.0069				
Riffle Length	33				
Avg. Riffle Slope	0.0107				
Pool Length	40				
Pool to Pool Spacing	66				

UT to Martins Creek Year 0 (2014) Profile - UT 1 Station 00+00 to 10+00

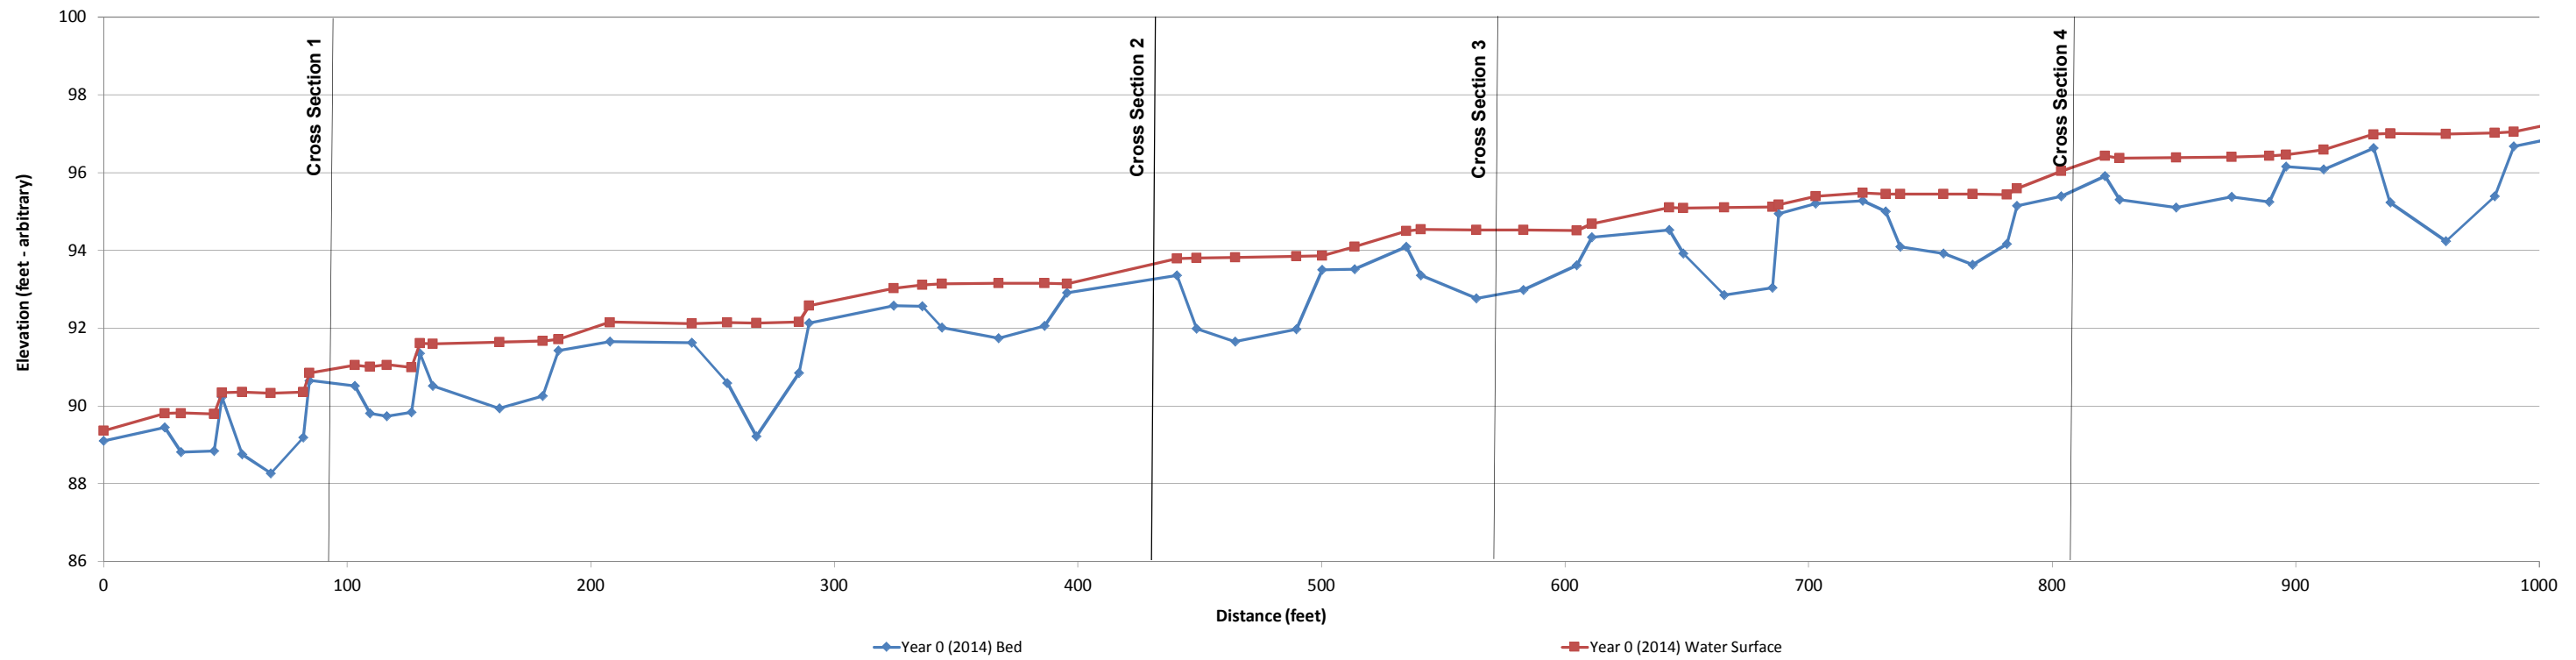


**Project Name** UT to Martins Creek - Profile  
**Reach** UT 1 Station 10+00 - 20+00  
**Feature** Profile  
**Date** 4/4/14  
**Crew** Perkinson, Jernigan

2014 Year 0 Monitoring \Survey			2014 Year 1 Monitoring \Survey			2015 Year 2 Monitoring \Survey			2016 Year 3 Monitoring \Survey			2017 Year 4 Monitoring \Survey		
Station	Bed Elevation	Water Elevation	Station	Bed Elevation	Water Elevation	Station	Bed Elevation	Water Elevation	Station	Bed Elevation	Water Elevation	Station	Bed Elevation	Water Elevation
989.7	96.7	97.0												
1031.5	97.2	97.6												
1038.8	95.9	97.6												
1051.3	95.9	97.6												
1063.4	97.1	97.6												
1073.6	97.0	97.6												
1075.3	96.2	97.6												
1084.7	95.9	97.6												
1090.1	97.5	98.1												
1094.6	96.6	98.0												
1109.2	96.6	98.0												
1115.5	96.8	98.0												
1119.4	97.8	98.0												
1163.7	98.1	98.7												
1170.6	97.1	98.7												
1195.7	96.7	98.7												
1212.9	96.7	98.7												
1218.0	98.5	98.8												
1232.6	98.2	98.9												
1253.5	98.0	99.0												
1262.6	97.5	99.0												
1286.1	97.7	99.0												
1304.9	97.6	99.0												
1323.5	97.6	99.0												
1330.4	98.6	99.0												
1356.5	98.6	99.4												
1360.5	98.1	99.4												
1379.9	98.1	99.4												

	2014	2014	2015	2016	2017
Avg. Water Surface Slope	0.0069				
Riffle Length	33				
Avg. Riffle Slope	0.0107				
Pool Length	40				
Pool to Pool Spacing	66				

UT to Martins Creek Year 0 (2014) Profile - UT 1 Station 10+00 to 20+00

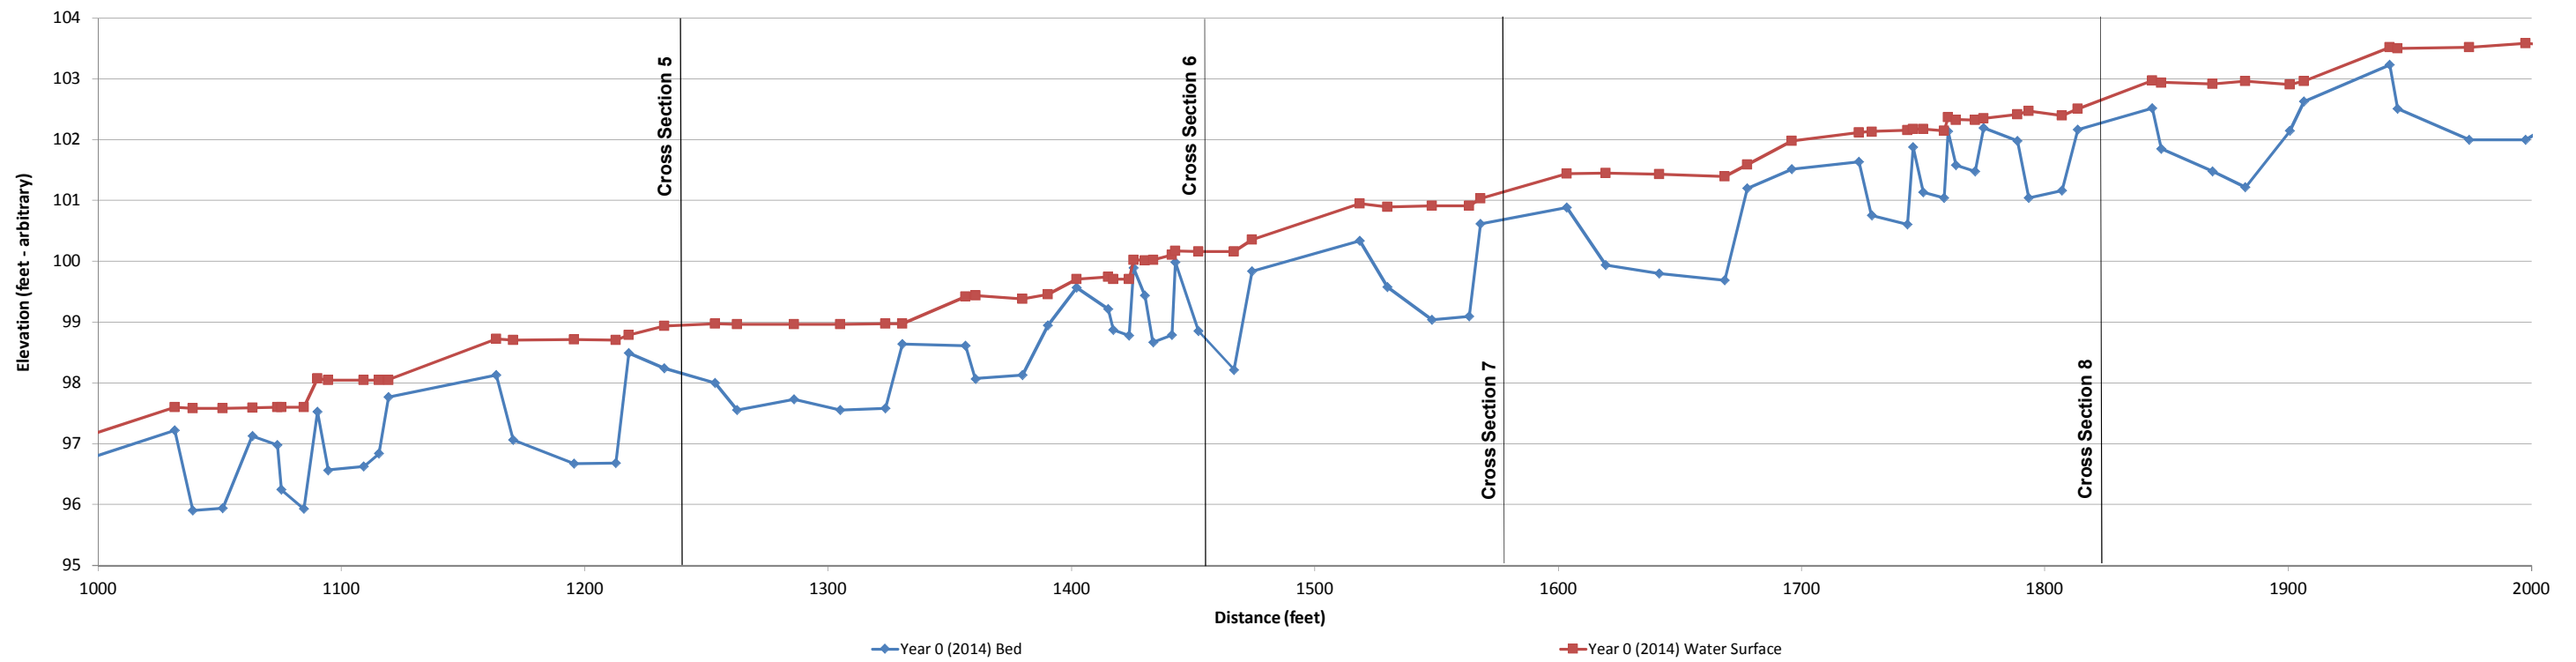




**Project Name** UT to Martins Creek - Profile  
**Reach** UT 1 Station 20+00 - 32+00  
**Feature** Profile  
**Date** 4/4/14  
**Crew** Perkinson, Jernigan

2014 Year 0 Monitoring \Survey			2014 Year 1 Monitoring \Survey			2015 Year 2 Monitoring \Survey			2016 Year 3 Monitoring \Survey			2017 Year 4 Monitoring \Survey		
Station	Bed Elevation	Water Elevation	Station	Bed Elevation	Water Elevation	Station	Bed Elevation	Water Elevation	Station	Bed Elevation	Water Elevation	Station	Bed Elevation	Water Elevation
1997.6	102.0	103.6												
2013.7	102.4	103.5												
2024.1	103.5	103.9												
2053.3	103.8	104.2												
2060.1	101.8	104.2												
2070.6	102.1	104.2												
2079.0	103.7	104.2												
2112.4	104.1	104.6												
2116.8	103.0	104.6												
2129.8	102.5	104.5												
2138.4	104.3	104.6												
2169.0	104.5	105.0												
2179.0	103.6	105.0												
2202.4	103.1	105.0												
2228.9	103.5	105.0												
2233.1	104.7	105.2												
2270.1	105.3	105.7												
2275.9	104.2	105.7												
2294.9	104.3	105.7												
2306.1	105.5	105.7												
2309.8	104.7	105.7												
2315.6	104.7	105.8												
2318.9	105.7	105.9												
2322.4	104.9	105.9												
2327.5	104.3	105.9												
2329.1	106.0	106.2												
2335.0	105.3	106.2												
2346.6	103.7	106.2												

	2014	2014	2015	2016	2017
Avg. Water Surface Slope	0.0069				
Riffle Length	33				
Avg. Riffle Slope	0.0107				
Pool Length	40				
Pool to Pool Spacing	66				

UT to Martins Creek Year 0 (2014) Profile - UT 1 Station 20+00 to 32+00

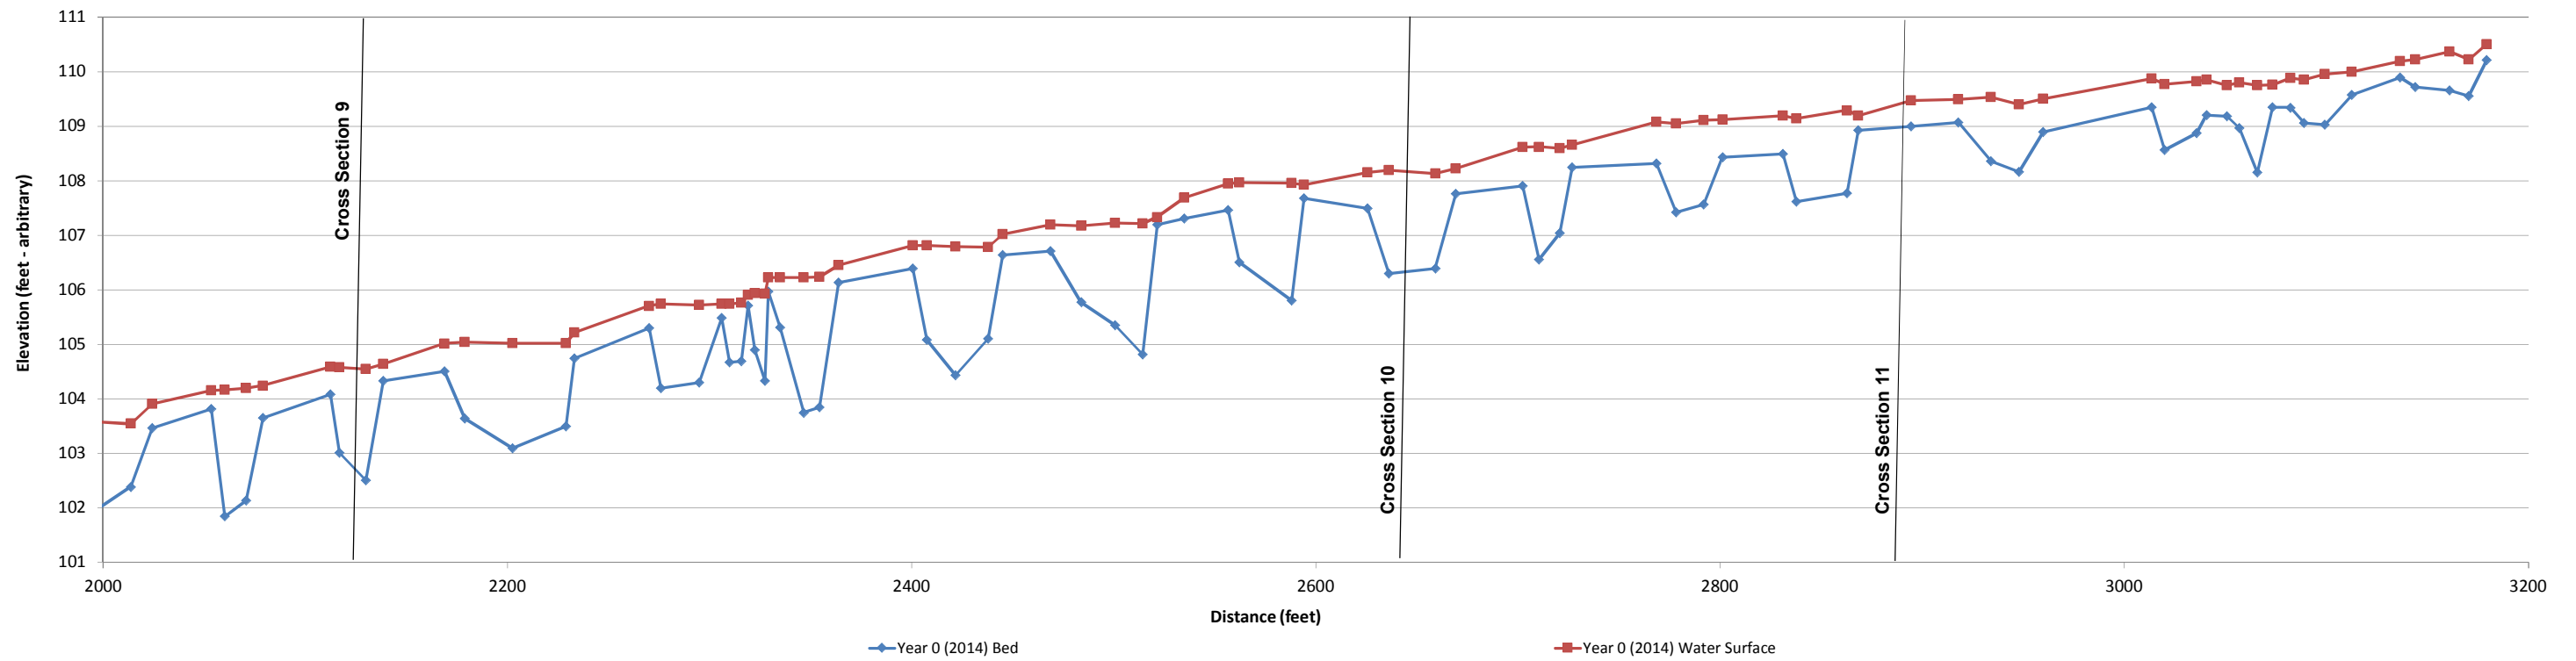


**Project Name** UT to Martins Creek - Profile  
**Reach** UT 1-1 Station 00+00 - 06+00  
**Feature** Profile  
**Date** 4/4/14  
**Crew** Perkinson, Jernigan

2014 Year 0 Monitoring \Survey			2014 Year 1 Monitoring \Survey			2015 Year 2 Monitoring \Survey			2016 Year 3 Monitoring \Survey			2017 Year 4 Monitoring \Survey		
Station	Bed Elevation	Water Elevation	Station	Bed Elevation	Water Elevation	Station	Bed Elevation	Water Elevation	Station	Bed Elevation	Water Elevation	Station	Bed Elevation	Water Elevation
0.0	107.7	108.5												
6.1	108.0	108.6												
15.6	107.9	108.5												
17.9	107.6	108.6												
21.6	107.8	108.7												
23.0	108.7	108.9												
37.6	108.6	109.3												
39.8	108.3	109.3												
43.1	108.3	109.3												
46.9	108.9	109.3												
52.5	108.7	109.5												
54.9	108.4	109.5												
58.7	108.4	109.5												
59.4	109.5	109.5												
79.1	109.4	110.0												
89.9	109.6	109.9												
92.9	109.0	110.0												
96.0	109.3	109.9												
97.4	110.0	110.1												
115.3	110.6	110.9												
130.4	110.7	111.1												
145.7	111.1	111.4												
164.9	111.8	111.9												
168.5	110.7	111.9												
171.9	110.3	111.9												
173.5	112.1	112.2												
183.9	112.5	112.8												
185.4	111.9	112.8												

	2014	2014	2015	2016	2017
Avg. Water Surface Slope	0.0383				
Riffle Length	24				
Avg. Riffle Slope	0.0357				
Pool Length	8				
Pool to Pool Spacing	32				

UT to Martins Creek Year 0 (2014) Profile - UT 1-1 Station 00+00 to 06+00

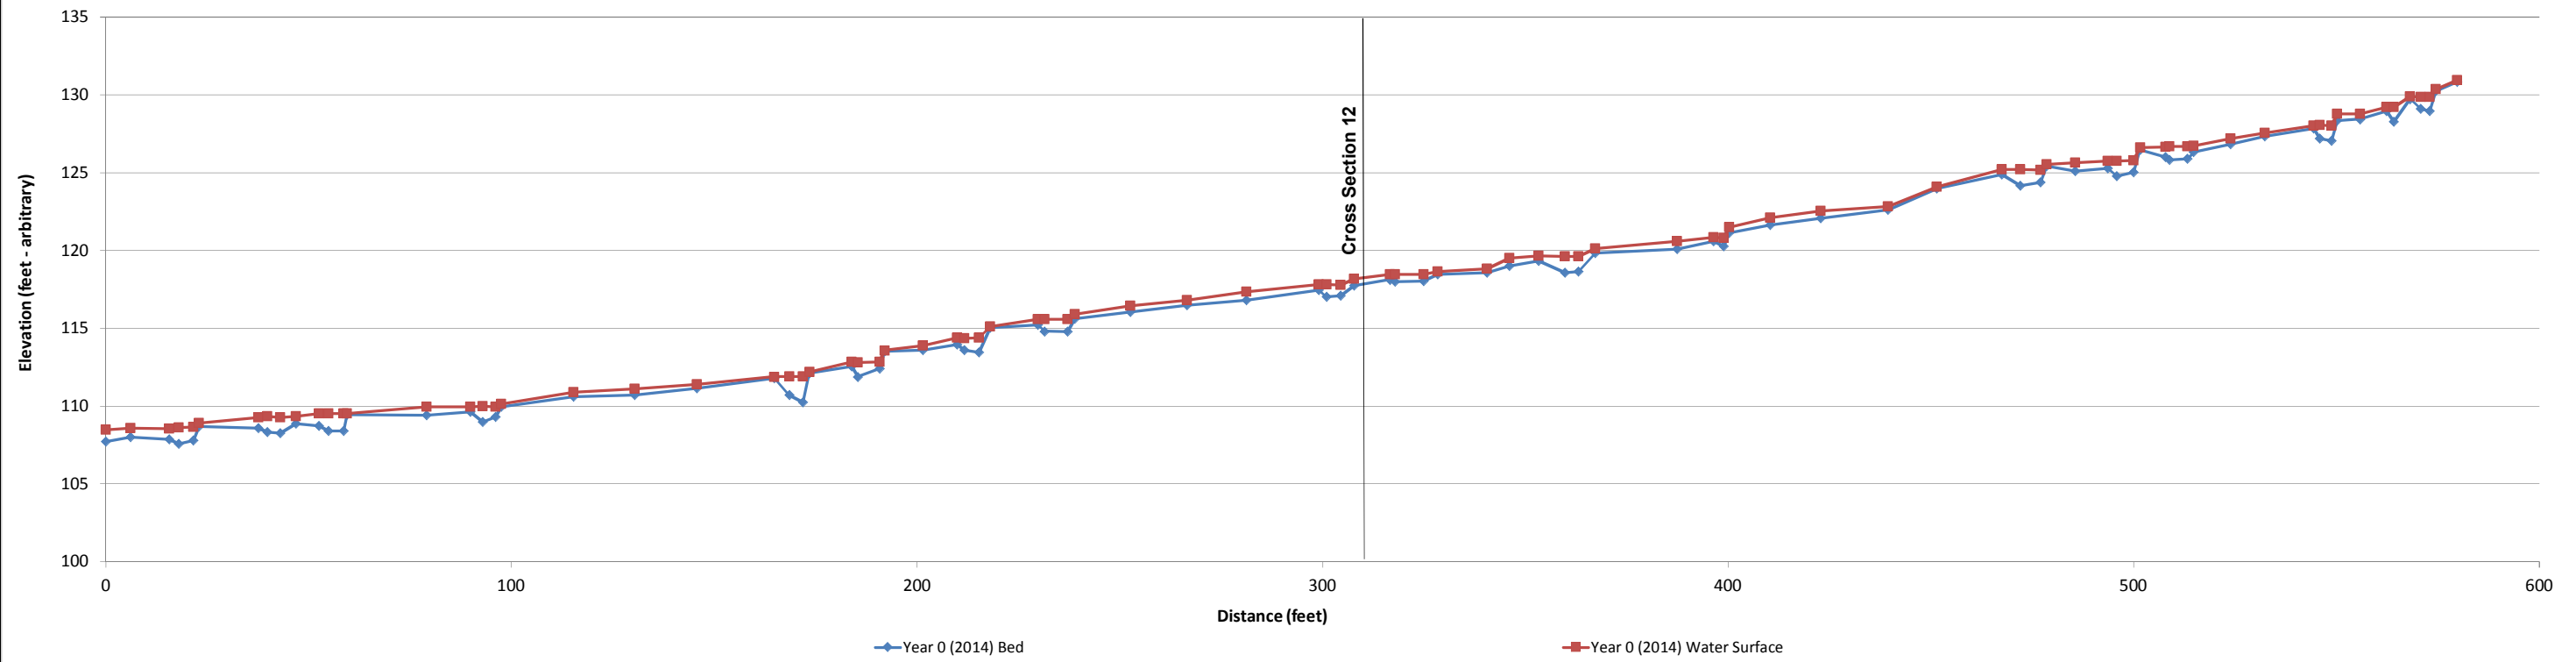


**Project Name** UT to Martins Creek - Profile  
**Reach** UT 1-2 Station 00+00 - 02+00  
**Feature** Profile  
**Date** 4/4/14  
**Crew** Perkinson, Jernigan

2014 Year 0 Monitoring \Survey			2014 Year 1 Monitoring \Survey			2015 Year 2 Monitoring \Survey			2016 Year 3 Monitoring \Survey			2017 Year 4 Monitoring \Survey		
Station	Bed Elevation	Water Elevation	Station	Bed Elevation	Water Elevation	Station	Bed Elevation	Water Elevation	Station	Bed Elevation	Water Elevation	Station	Bed Elevation	Water Elevation
0.0	92.4	93.0												
10.9	92.7	93.2												
23.2	92.7	93.2												
28.0	92.1	93.2												
34.1	91.8	93.2												
36.6	92.9	93.2												
46.0	92.9	93.3												
54.3	92.8	93.3												
57.1	91.8	93.3												
63.2	91.9	93.3												
65.7	92.9	93.3												
74.1	92.8	93.4												
76.9	91.9	93.4												
82.0	92.0	93.3												
83.3	93.1	93.4												
99.4	93.3	93.6												
117.3	93.4	93.9												
130.4	93.3	93.9												
133.1	92.6	93.9												
135.1	92.6	93.9												
136.1	93.9	94.0												
152.9	93.9	94.3												
168.8	94.2	94.6												
183.3	94.3	94.7												
186.6	93.5	94.8												
189.4	93.1	94.7												
191.8	94.7	95.0												

	2014	2014	2015	2016	2017
Avg. Water Surface Slope	0.0105				
Riffle Length	29				
Avg. Riffle Slope	0.0108				
Pool Length	10				
Pool to Pool Spacing	38				

UT to Martins Creek Year 0 (2014) Profile - UT 1-2 Station 00+00 to 02+00

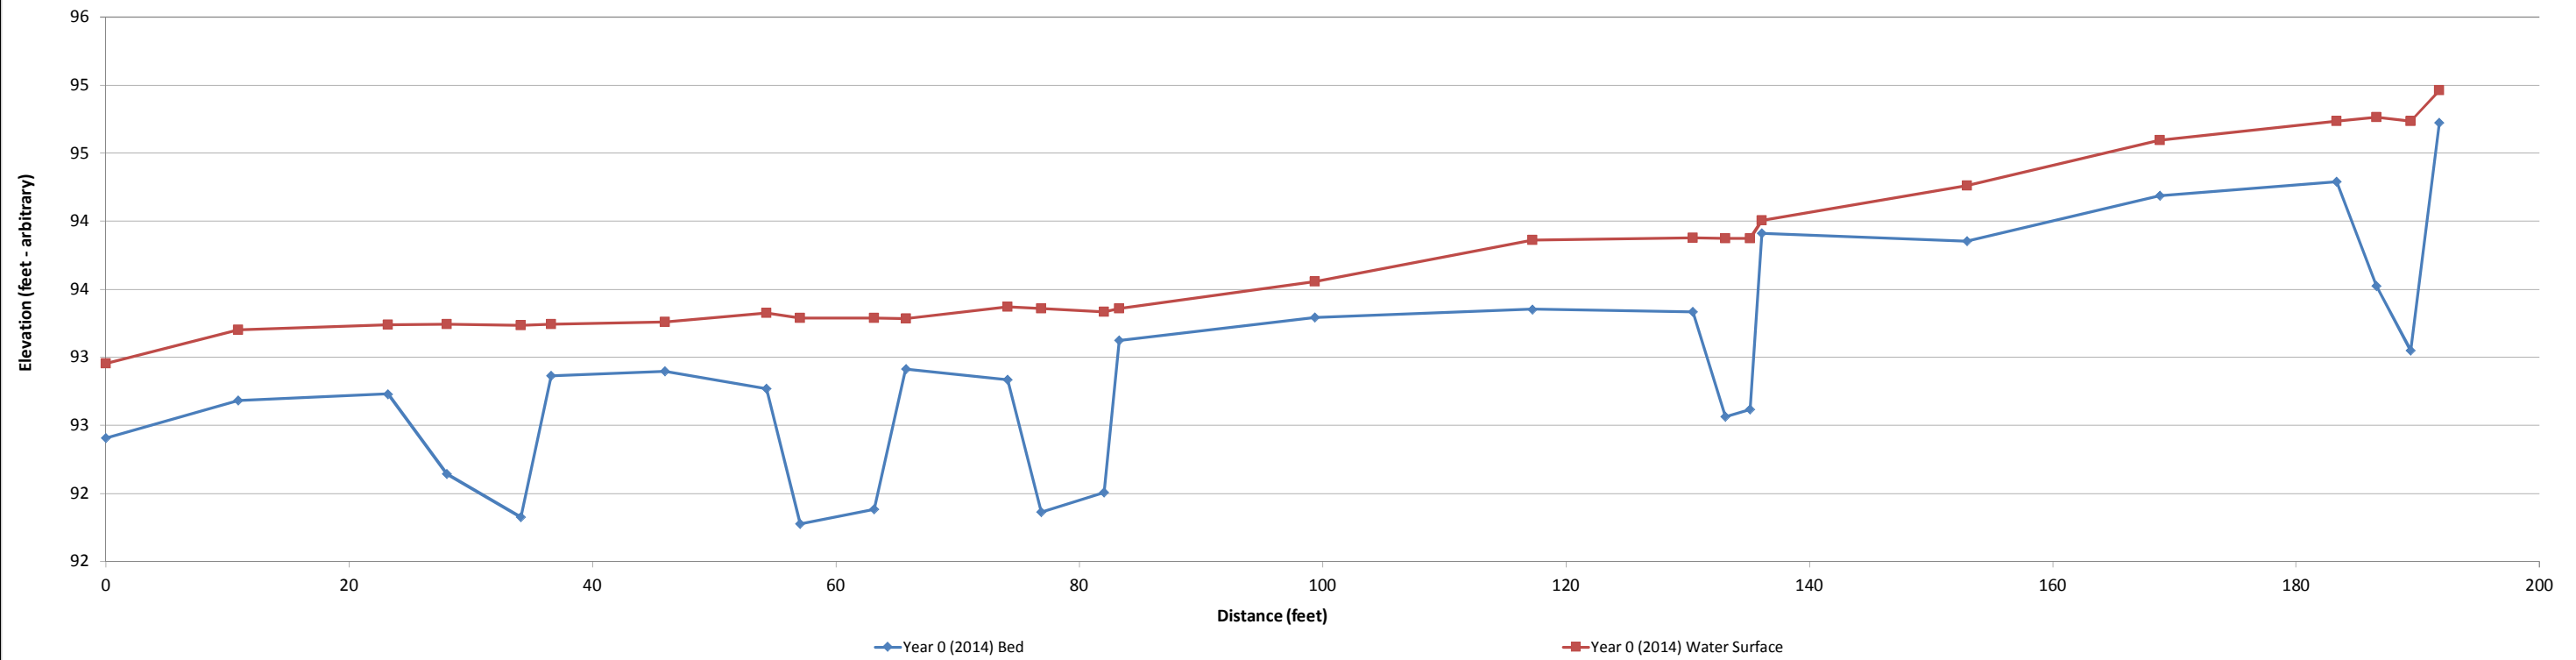


**Project Name** UT to Martins Creek - Profile  
**Reach** UT 1-3 Station 00+00 - 09+00  
**Feature** Profile  
**Date** 4/4/14  
**Crew** Perkinson, Jernigan

2014 Year 0 Monitoring \Survey			2014 Year 1 Monitoring \Survey			2015 Year 2 Monitoring \Survey			2016 Year 3 Monitoring \Survey			2017 Year 4 Monitoring \Survey		
Station	Bed Elevation	Water Elevation	Station	Bed Elevation	Water Elevation	Station	Bed Elevation	Water Elevation	Station	Bed Elevation	Water Elevation	Station	Bed Elevation	Water Elevation
0.0	92.4	92.9												
15.0	92.4	93.0												
32.8	92.6	93.3												
46.8	92.8	93.5												
64.9	93.4	93.8												
68.3	93.2	93.8												
70.4	93.8	93.9												
94.5	94.8	95.0												
115.4	95.1	95.4												
140.7	95.9	96.2												
156.6	96.4	97.0												
160.0	96.3	97.0												
162.4	96.2	97.0												
171.0	96.4	97.1												
175.6	96.7	97.2												
192.1	97.0	97.4												
198.4	97.2	97.5												
200.6	96.7	97.5												
204.2	96.8	97.5												
205.4	97.7	97.8												
215.2	98.2	98.7												
217.4	97.4	98.7												
221.5	98.1	98.6												
222.3	98.9	99.1												
231.3	99.3	99.5												
240.3	99.5	99.9												
249.2	99.8	100.1												
265.8	100.6	101.1												

	2014	2014	2015	2016	2017
Avg. Water Surface Slope	0.0321				
Riffle Length	41				
Avg. Riffle Slope	0.0318				
Pool Length	12				
Pool to Pool Spacing	51				

UT to Martins Creek Year 0 (2014) Profile - UT 1-3 Station 00+00 to 09+00

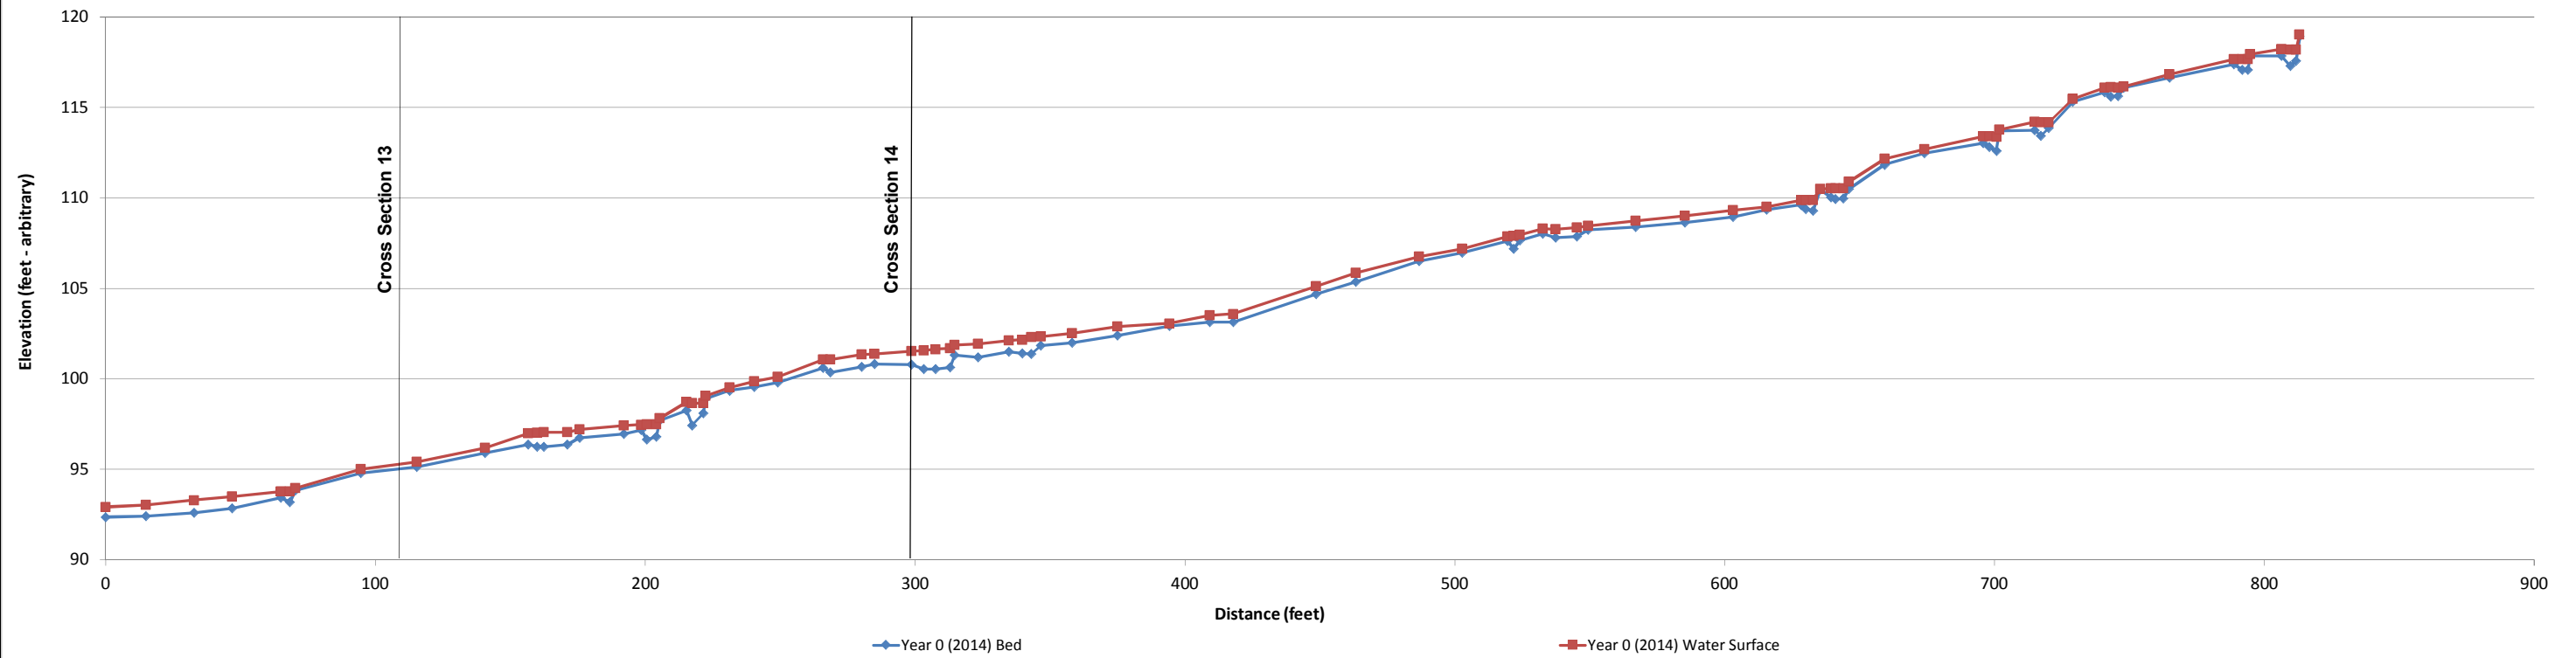


**Appendix E.**  
**As-built Plan Sheets**

# AS-BUILT SURVEY OF UT TO MARTINS CREEK (CONTRERAS) MITIGATION PROJECT

CHEROKEE COUNTY, NC

SCO PROJECT NO. #08-07249-01

EEP PROJECT ID #92766

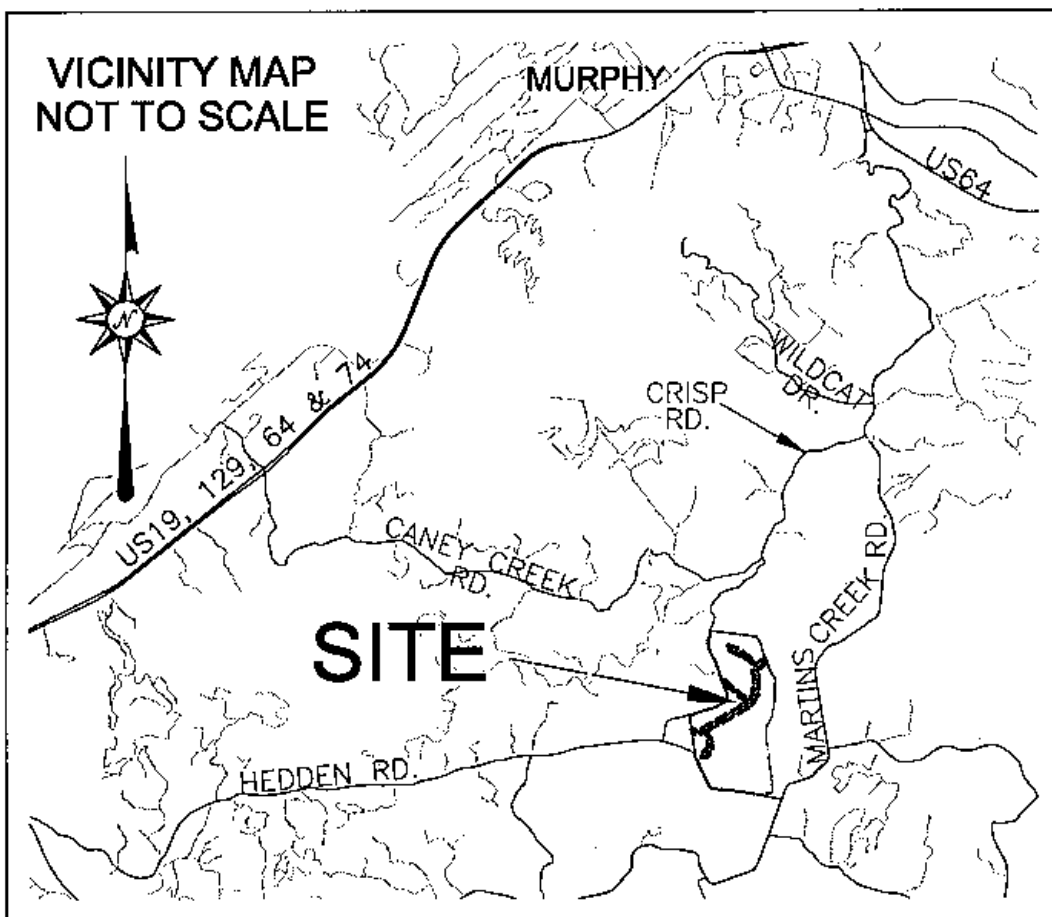


I, ELISABETH G. TURNER, AS A DULY REGISTERED PROFESSIONAL LAND SURVEYOR IN THE STATE OF NORTH CAROLINA, HEREBY CERTIFY THAT THE DATA SHOWN ON THIS DRAWING, WAS OBTAINED UNDER MY SUPERVISION, IS AN ACCURATE AND COMPLETE REPRESENTATION OF WHAT WAS CONSTRUCTED IN THE FIELD, AND THAT THE PHYSICAL DIMENSIONS OR ELEVATIONS SHOWN THERE ARE AS-BUILT CONDITIONS EXCEPT WHERE OTHERWISE NOTED HEREON. WITNESS MY ORIGINAL SIGNATURE, REGISTRATION NUMBER, AND SEAL THIS 2nd DAY OF AUGUST, 2013.

*Elisabeth G. Turner*  
ELISABETH G. TURNER, P.L.S. #L-4440



### GENERAL NOTES

1. ALL DISTANCES ARE HORIZONTAL UNLESS OTHERWISE NOTED.
2. THE VERTICAL DATUM IS NAVD88.
3. THE BASIS OF BEARINGS IS NCGS STATE PLANE GRID COORDINATES NAD83 (NSRS 2007) DATUM.
4. CONTROL IS BASED ON EXISTING CONTROL DATA AS SHOWN ON SHEET 48 OF THE DESIGN PLANS AND RECOVERED DURING THE CONSTRUCTION & AS-BUILT SURVEYS. ADDITIONAL CONTROL POINTS WERE ESTABLISHED FROM EXISTING CONTROL PRIOR TO CONSTRUCTION. THE CONTROL POINTS USED DURING THE AS-BUILT SURVEY ARE LISTED BELOW.
5. THIS MAP IS NOT FOR RECORDATION, SALES, OR CONVEYANCES AND DOES NOT COMPLY WITH G.S. 47-30 MAPPING REQUIREMENTS.
6. THE SOLE PURPOSE OF THIS SURVEY IS TO SHOW THE CONSTRUCTED STREAM AND THE FEATURES RELATED TO THE RESTORATION PROJECT.
7. THE 0+00 STATIONS ARE MATCHED WITH THE DESIGN 0+00 STATIONS, HOWEVER THE AS-BUILT SURVEY LENGTH MAY VARY SLIGHTLY FROM THE DESIGN LENGTH.
8. FEATURES OUTSIDE THE AS-BUILT LIMITS OF DISTURBANCE INCLUDING BUT NOT LIMITED TO EXISTING UTILITIES, EASEMENTS, DRAINAGE, & PROPERTY LINES WERE NOT LOCATED BY TURNER LAND SURVEYING, PLLC. ALL FEATURES SHOWN OUTSIDE THE AS-BUILT LIMITS WERE TAKEN FROM EXISTING CONDITIONS AND DESIGN DATA PROVIDED BY THE DESIGNER.
9. CONSERVATION EASEMENT PROVIDED BY DESIGNER.

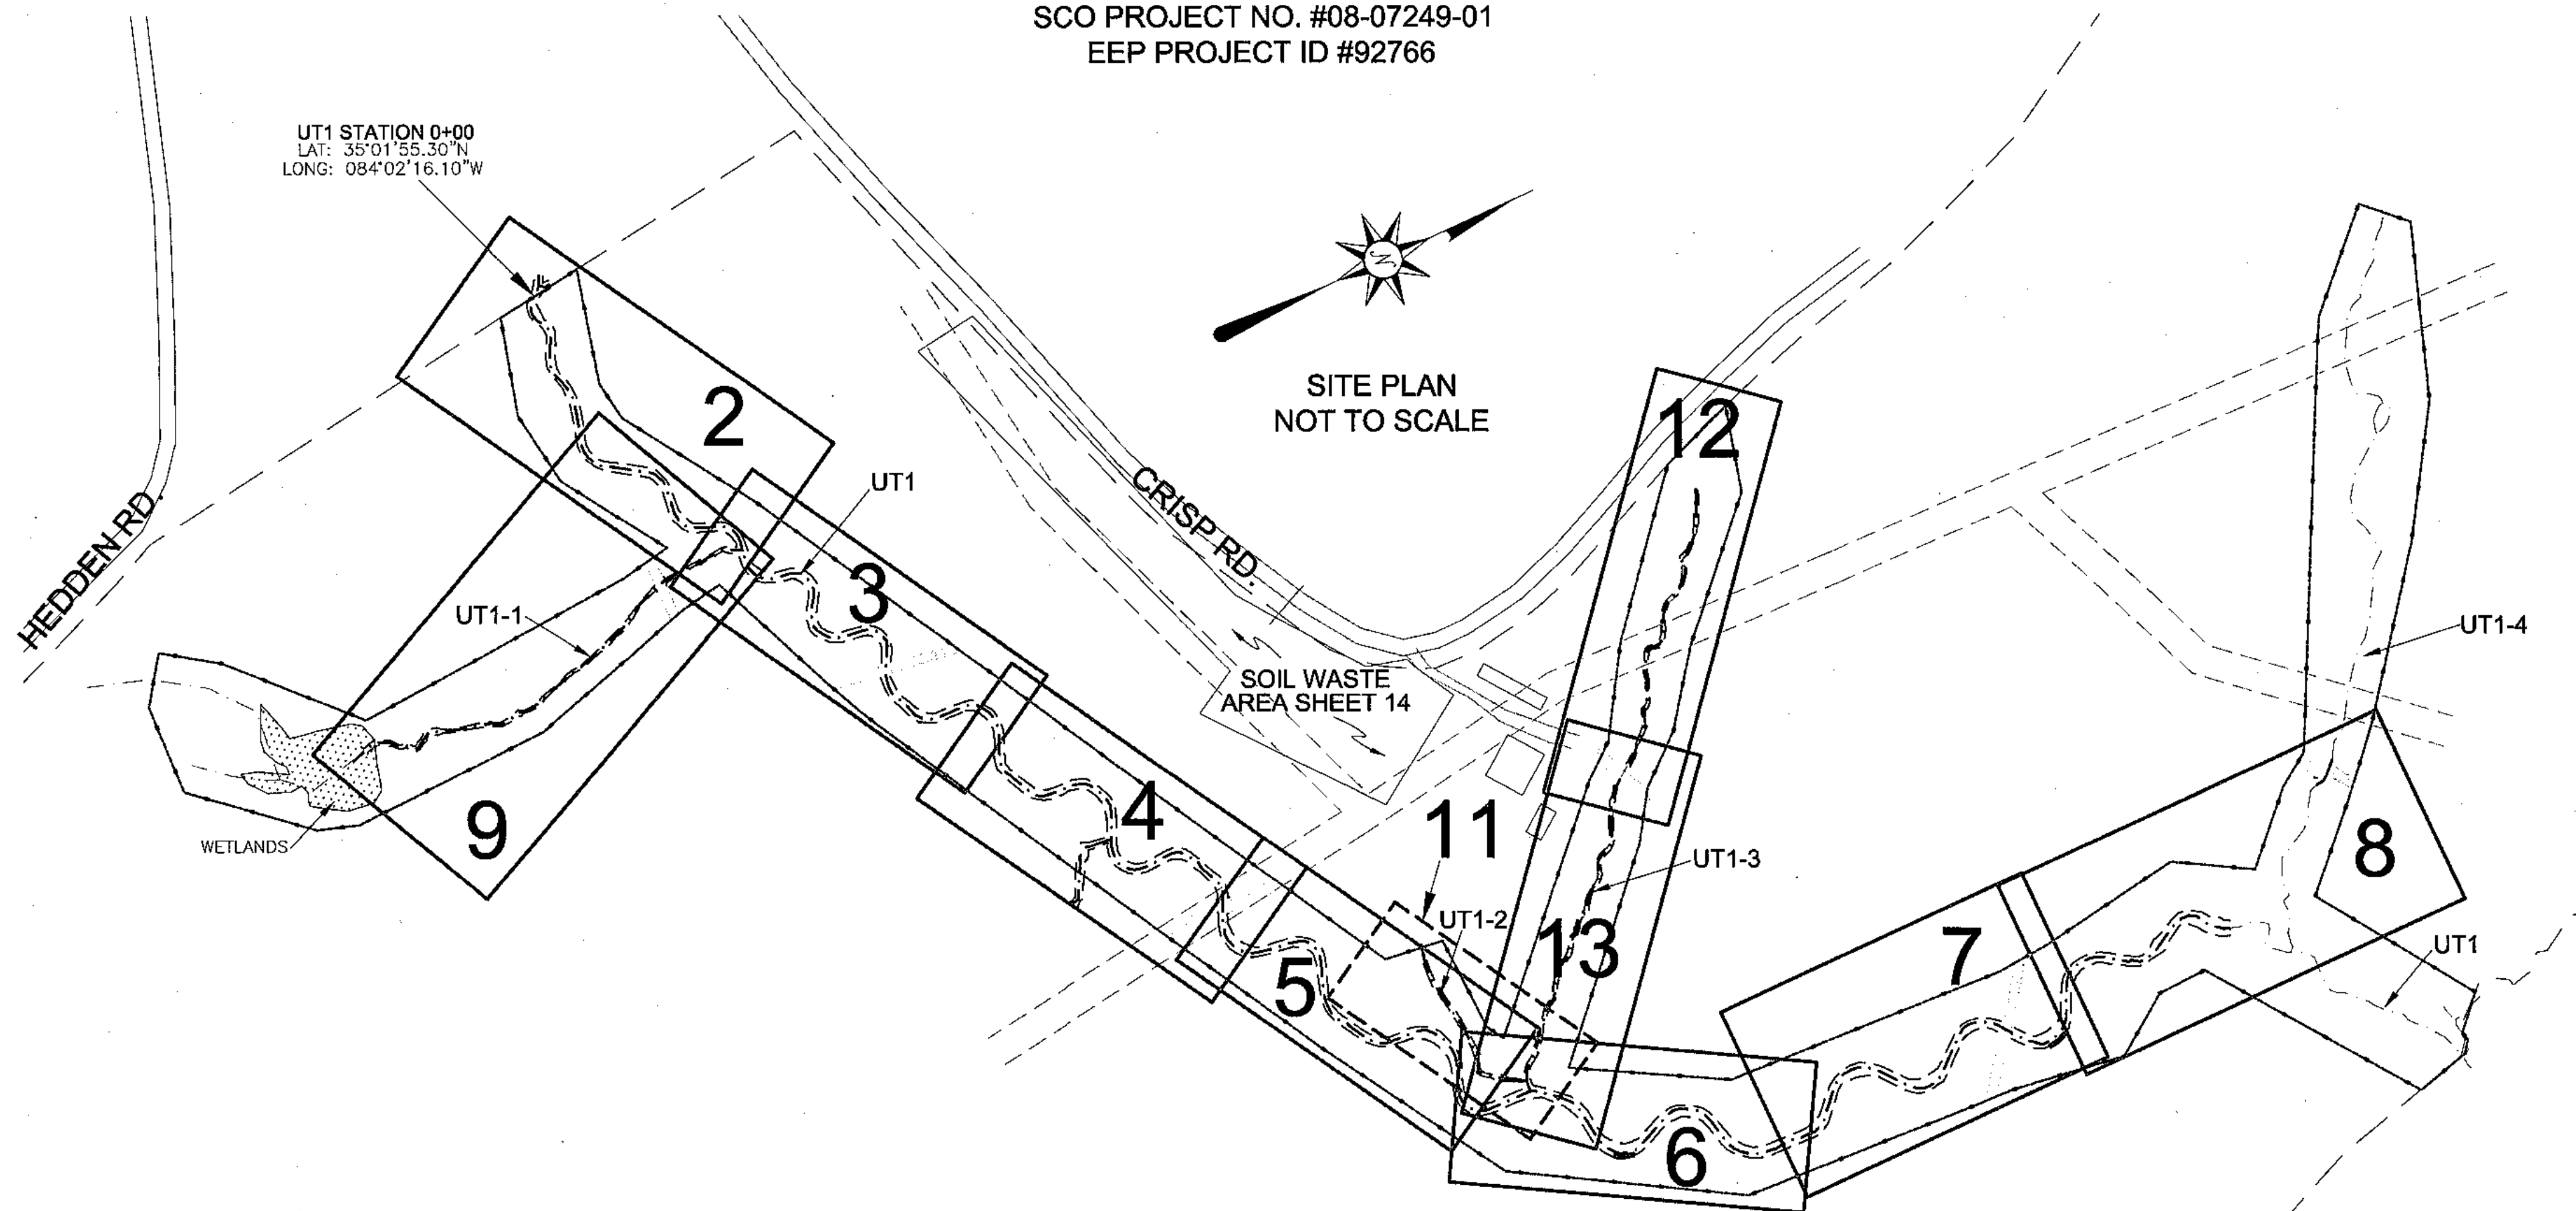

### SHEET INDEX

- SHEET 1 - TITLE, VICINITY MAP, SHEET INDEX, AND GENERAL NOTES
- SHEET 2 - UT1 STA 0+00 TO 5+00 PLAN & PROFILE
- SHEET 3 - UT1 STA 5+00 TO 10+00 PLAN & PROFILE
- SHEET 4 - UT1 STA 10+00 TO 15+00 PLAN & PROFILE
- SHEET 5 - UT1 STA 15+00 TO 20+00 PLAN & PROFILE
- SHEET 6 - UT1 STA 20+00 TO 25+00 PLAN & PROFILE
- SHEET 7 - UT1 STA 25+00 TO 30+00 PLAN & PROFILE
- SHEET 8 - UT1 STA 30+00 TO 32+80 PLAN & PROFILE AND UT1-4 CROSSING & STRUCTURE
- SHEET 9 - UT1-1 STA 0+00 TO 6+02 PLAN VIEW
- SHEET 10 - UT1-1 STA 0+00 TO 6+02 PROFILE
- SHEET 11 - UT1-2 STA 0+00 TO 2+07 PLAN & PROFILE
- SHEET 12 - UT1-3 STA 0+00 TO 4+00 PLAN & PROFILE
- SHEET 13 - UT1-3 STA 4+00 TO 8+32 PLAN & PROFILE
- SHEET 14 - GRADED SOIL WASTE AREA

### AS-BUILT CONTROL:

PT#	Northing(Y)	Eastng(X)	Elev(Z)	Description
1	505438.99	493163.10	1679.61	EX GPS1
2	505167.51	493211.22	1654.92	EX GPS2
3	504800.49	494574.90	1771.87	EX GPS3
4	505035.71	493009.43	1655.83	TLS#4 NAIL
11	505171.16	493571.56	1651.22	TLS#11 NAIL
14	505550.89	493956.54	1647.06	TLS#14 MON7
20	505746.92	493776.10	1661.60	TLS#20 REBAR W/CAP
21	505850.53	493605.40	1670.87	TLS#21 NAIL
22	506028.78	493420.69	1678.32	TBM#211 HUB & TACK
25	506434.38	494133.09	1640.21	TLS#25 MON25
200	504901.54	493023.29	1657.17	TBM#200 MON60
202	504435.95	492992.33	1681.81	TBM#202 HUB & TACK
205	505436.43	493668.73	1650.59	TBM#205 HUB & TACK
206	505494.23	494133.55	1646.56	TBM#206 MON54
208	506175.73	494306.05	1640.68	TBM#208 HUB & TACK
210	505923.12	493676.89	1661.66	TBM#210 HUB & TACK
212	506088.00	493464.63	1673.53	TBM#212 BENCHTIE IN TREE
240	506678.36	494106.33	1645.78	TBM#240 HUB & TACK

### REFERENCES:

OWNER:  
NORTH CAROLINA ECOSYSTEM  
ENHANCEMENT PROGRAM  
1652 MAIL SERVICE CENTER  
RALEIGH, NC 27099-1652  
(919)715-1157  
PROJ. MGR.: PAUL WIESNER

CONTRACTOR:  
RIVER WORKS, INC.  
RALEIGH, NC  
(919)582-3574

DESIGNER:  
MICHAEL BAKER ENGINEERING, INC.  
ASHEVILLE, NC  
(828)350-1408

PROPERTY OWNER:  
NANCY KETNER CONTRERAS  
CONSERVATION EASEMENT  
RECORDED IN DB 1004, PG 1017 IN  
THE CHEROKEE COUNTY NC  
REGISTER OF DEEDS.


TITLE, VICINITY MAP, SHEET INDEX, & GENERAL NOTES

AS-BUILT SURVEY OF  
UT TO MARTINS CREEK (CONTRERAS)  
MITIGATION PROJECT

DATE: 04/24/13  
SURVEYED BY: DST/JGT  
DRAWN BY: DST/JGT  
REVIEWED BY: DST/JGT  
PROJECT: TLS-12-021  
FILE: UTMC-CONTRERAS\_92766\_TLS\_AB\_F  
SCALE: AS SHOWN

SHEET  
1 of 14

REVISIONS, DATE, AND INITIAL:  
TURNER LAND SURVEYING, PLLC  
3201 Glenridge Drive, Raleigh, NC 27604 - (919)875-1378  
P-0702 - Lturner21@gat.net - Dturner119@gat.net  
WWW.TURNERLANDSURVEYING.COM

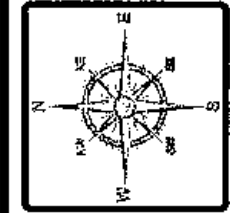


NORTH CAROLINA

MURPHY

CHEROKEE COUNTY

I, ELISABETH G. TURNER, AS A DULY REGISTERED PROFESSIONAL LAND SURVEYOR IN THE STATE OF NORTH CAROLINA, HEREBY CERTIFY THAT THE DATA SHOWN ON THIS DRAWING, WAS OBTAINED UNDER MY SUPERVISION, IS AN ACCURATE AND COMPLETE REPRESENTATION OF WHAT WAS CONSTRUCTED IN THE FIELD, AND THAT THE PHYSICAL DIMENSIONS OR ELEVATIONS SHOWN THUS ARE AS-BUILT CONDITIONS EXCEPT WHERE OTHERWISE NOTED HEREON. WITNESS MY ORIGINAL SIGNATURE, REGISTRATION NUMBER, AND SEAL THIS 2nd DAY OF AUGUST, 2013.


*Elisabeth G. Turner*  
 ELISABETH G. TURNER, P.L.S. #L-4440

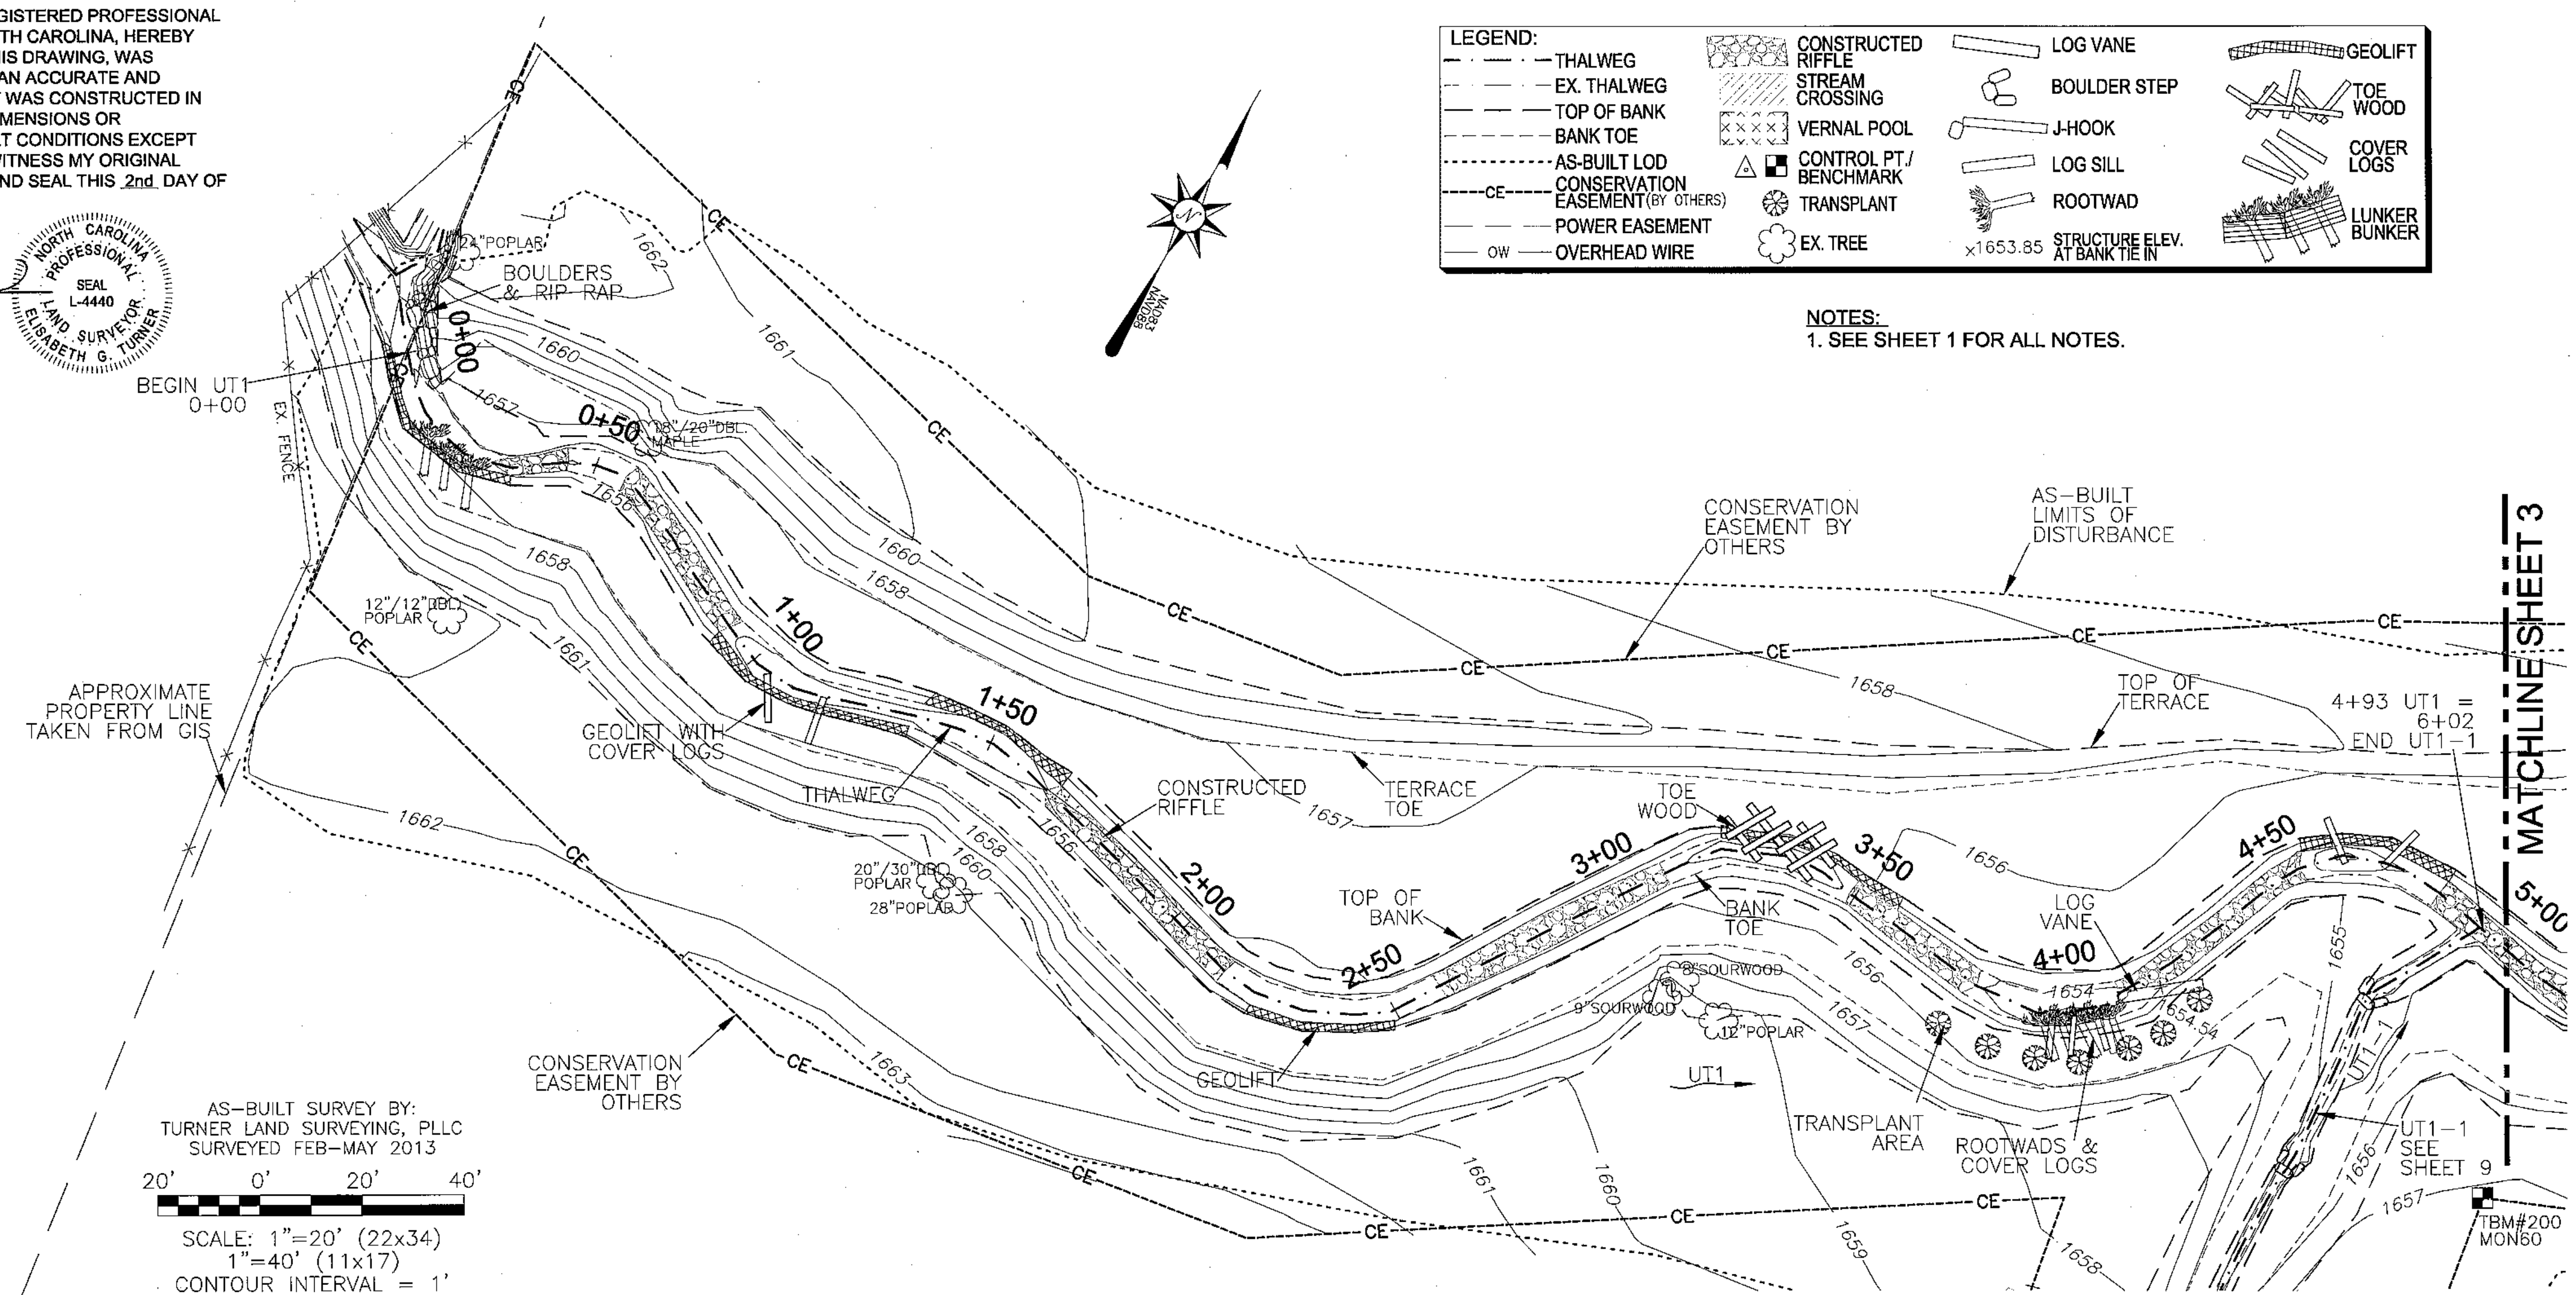

LEGEND:			
--- THALWEG	CONSTRUCTED RIFFLE	LOG VANE	GEOLIFT
--- EX. THALWEG	STREAM CROSSING	BOULDER STEP	TOE WOOD
--- TOP OF BANK	VERNAL POOL	J-HOOK	COVER LOGS
--- BANK TOE	CONTROL PT./ BENCHMARK	LOG SILL	LUNKER BUNKER
--- AS-BUILT LOD	TRANSPLANT	ROOTWAD	
--- CE CONSERVATION EASEMENT (BY OTHERS)	EX. TREE	STRUCTURE ELEV. AT BANK TIE IN	
--- POWER EASEMENT			
--- OW OVERHEAD WIRE			

NOTES:  
 1. SEE SHEET 1 FOR ALL NOTES.

AS-BUILT SURVEY BY:  
 TURNER LAND SURVEYING, PLLC  
 SURVEYED FEB-MAY 2013  
 SCALE: 1"=20' (22x34)  
 1"=40' (11x17)  
 CONTOUR INTERVAL = 1'

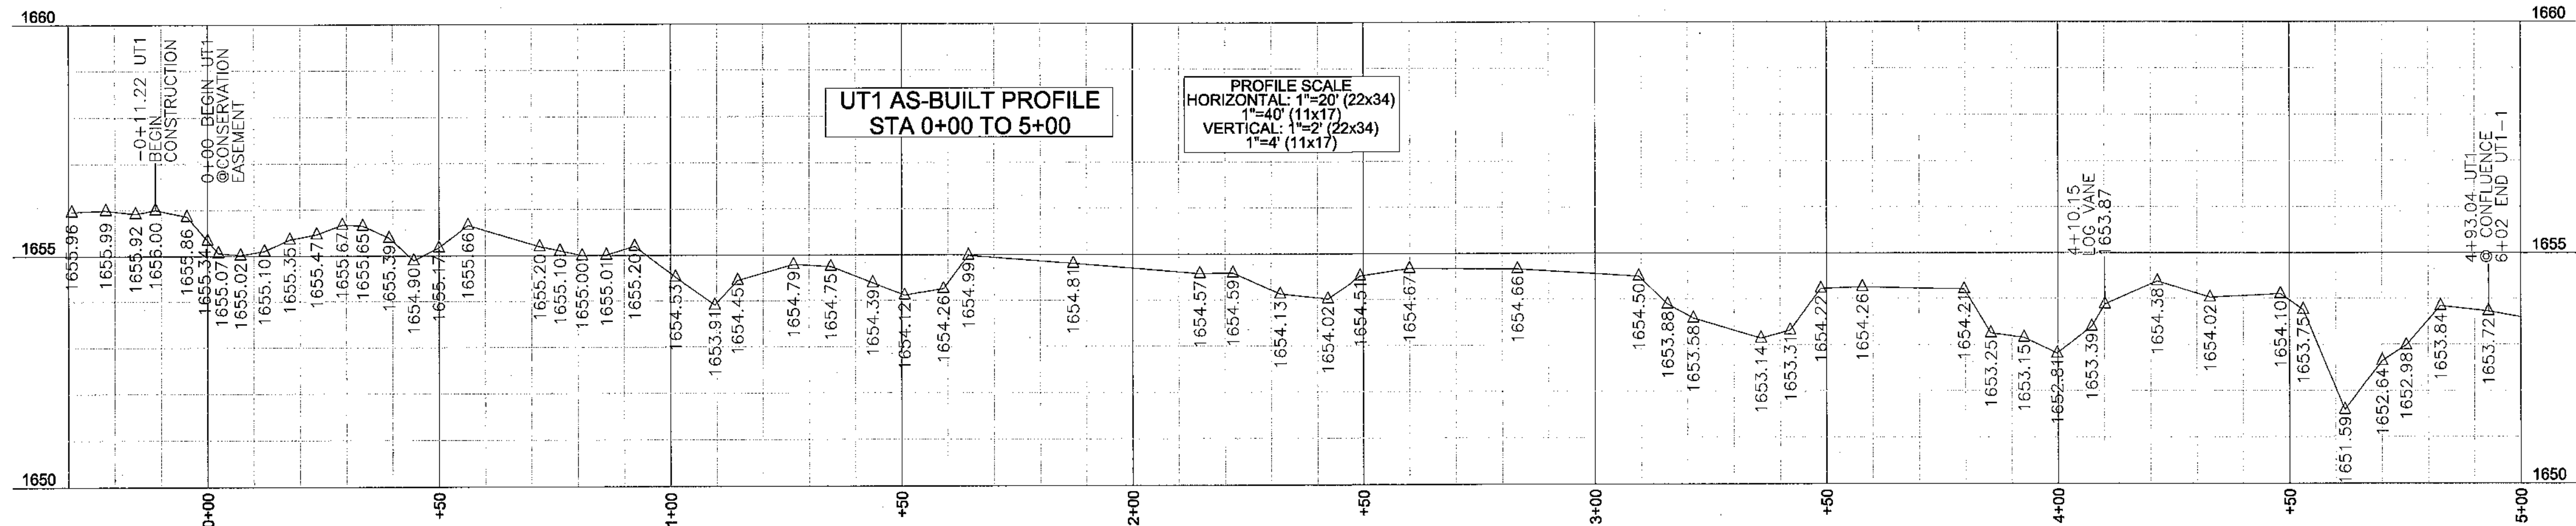


UT1 AS-BUILT PROFILE  
 STA 0+00 TO 5+00

PROFILE SCALE  
 HORIZONTAL: 1"=20' (22x34)  
 1"=40' (11x17)  
 VERTICAL: 1"=2' (22x34)  
 1"=4' (11x17)

REVISIONS, DATE, AND INITIAL:

TURNER LAND SURVEYING, PLLC  
 3201 Glenridge Drive, Raleigh, NC 27604 -- (919) 975-1378  
 P-0702 -- Lturner921@att.net -- Dturner119@att.net  
 WWW.TURNERLANDSURVEYING.COM

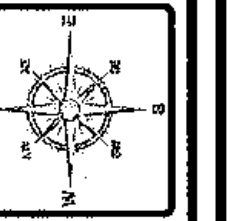

UT1 STA 0+00 TO 5+00 PLAN & PROFILE

AS-BUILT SURVEY OF  
 UT TO MARTINS CREEK (CONTRERAS)  
 MITIGATION PROJECT

NORTH CAROLINA

MURPHY

CHEROKEE COUNTY

DATE: 04/24/13  
 SURVEYED BY: DST/JGT  
 DRAWN BY: DST/JGT  
 REVIEWED BY: DST/JGT  
 PROJECT: TLS-12-021  
 FILE: UTM-CONTRERAS\_92766\_TLS\_AB\_F  
 SCALE: AS SHOWN

SHEET  
 2 of 14



I, ELISABETH G. TURNER, AS A DULY REGISTERED PROFESSIONAL LAND SURVEYOR IN THE STATE OF NORTH CAROLINA, HEREBY CERTIFY THAT THE DATA SHOWN ON THIS DRAWING, WAS OBTAINED UNDER MY SUPERVISION, IS AN ACCURATE AND COMPLETE REPRESENTATION OF WHAT WAS CONSTRUCTED IN THE FIELD, AND THAT THE PHYSICAL DIMENSIONS OR ELEVATIONS SHOWN THUS ARE AS-BUILT CONDITIONS EXCEPT WHERE OTHERWISE NOTED HEREON. WITNESS MY ORIGINAL SIGNATURE, REGISTRATION NUMBER, AND SEAL THIS 2nd DAY OF AUGUST, 2013.

*Elisabeth G. Turner*  
 ELISABETH G. TURNER, P.L.S. #L-4440  
 NORTH CAROLINA PROFESSIONAL LAND SURVEYOR SEAL L-4440 ELISABETH G. TURNER

NOTES:  
 1. SEE SHEET 1 FOR ALL NOTES.

LEGEND:			
--- THALWEG	--- EX. THALWEG	--- TOP OF BANK	--- BANK TOE
--- AS-BUILT LOD	--- CE CONSERVATION EASEMENT (BY OTHERS)	--- POWER EASEMENT	--- OW OVERHEAD WIRE
[Symbol] CONSTRUCTED RIFFLE	[Symbol] STREAM CROSSING	[Symbol] VERNAL POOL	[Symbol] CONTROL PT./ BENCHMARK
[Symbol] LOG VANE	[Symbol] BOULDER STEP	[Symbol] J-HOOK	[Symbol] LOG SILL
[Symbol] GEOLIFT	[Symbol] TOE WOOD	[Symbol] COVER LOGS	[Symbol] LUNKER BUNKER
[Symbol] EX. TREE	[Symbol] TRANSPLANT	[Symbol] ROOTWAD	[Symbol] STRUCTURE ELEV. AT BANK TIE IN

AS-BUILT SURVEY BY:  
 TURNER LAND SURVEYING, PLLC  
 SURVEYED FEB-MAY 2013  
 SCALE: 1"=20' (22x34)  
 1"=40' (11x17)  
 CONTOUR INTERVAL = 1'

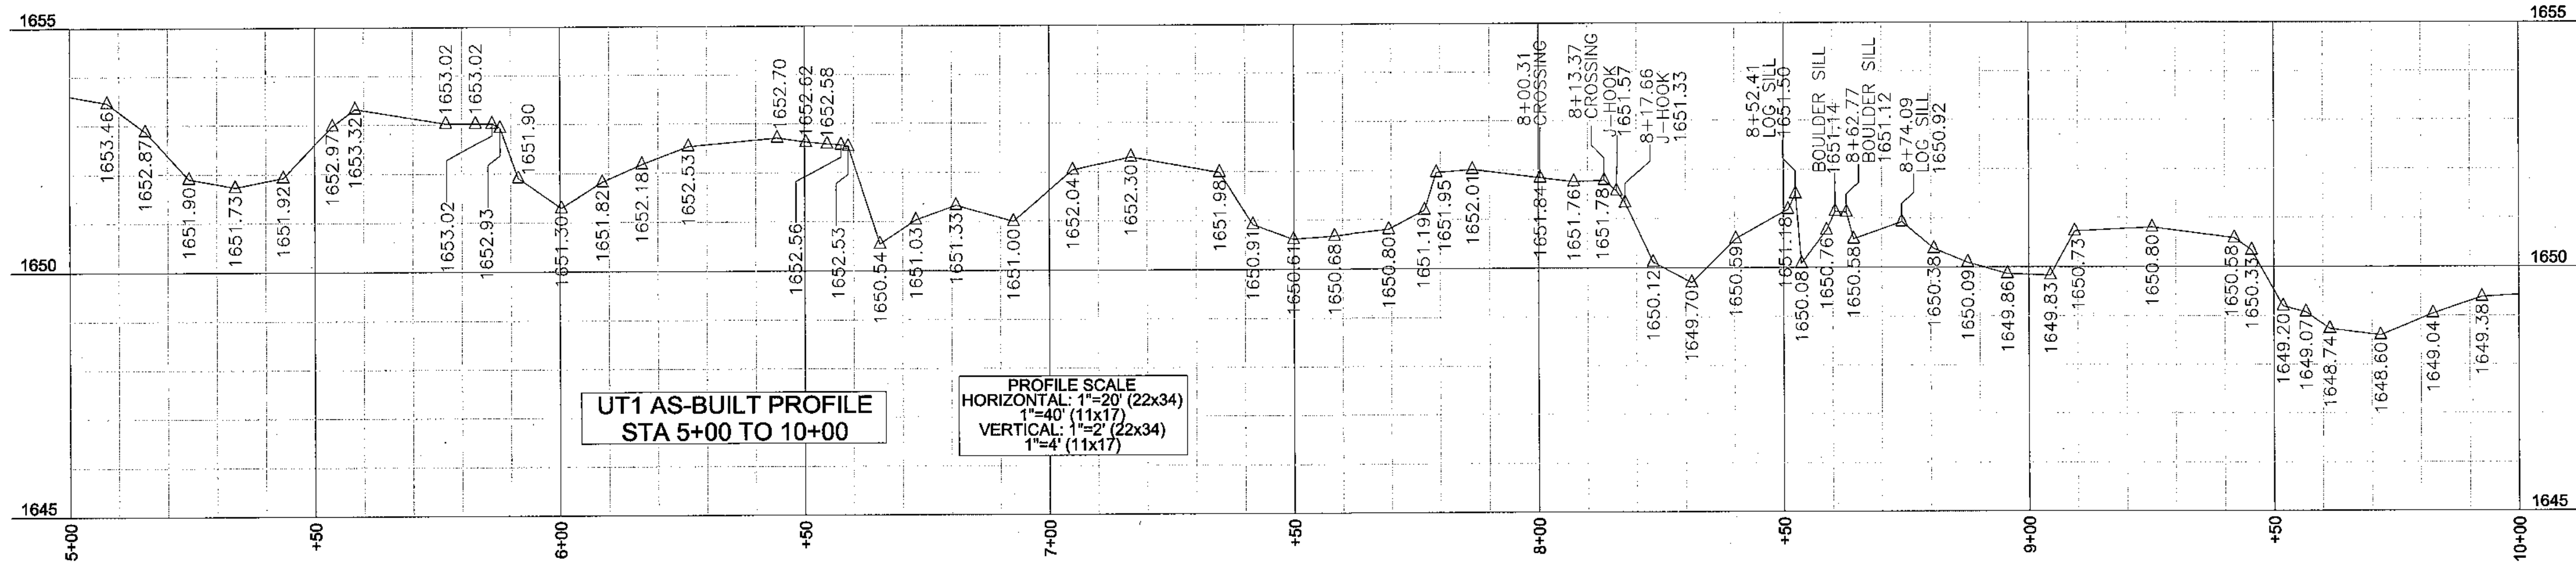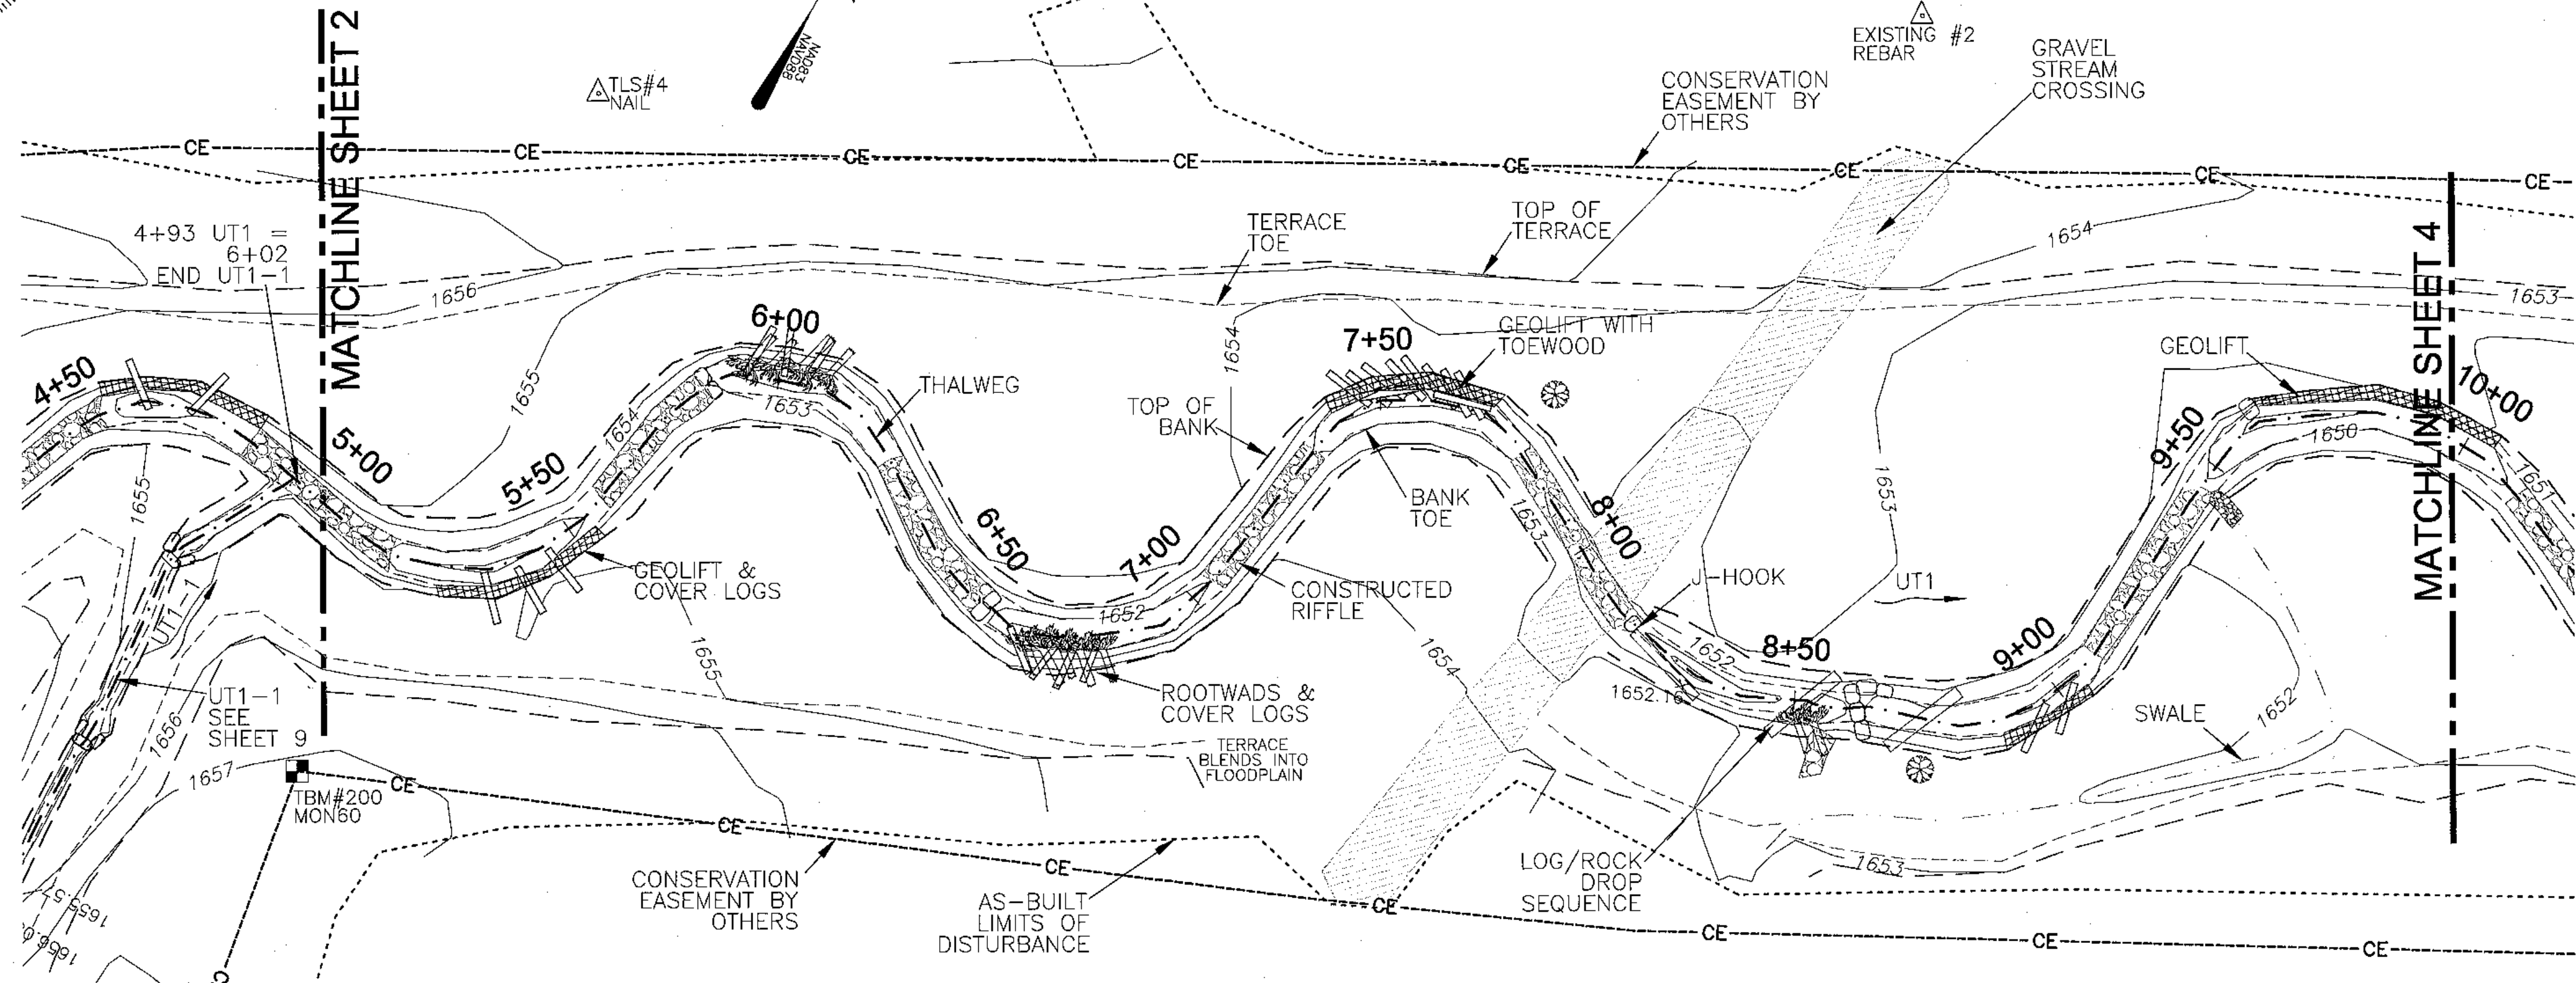

UT1 STA 5+00 TO 10+00 PLAN & PROFILE  
 AS-BUILT SURVEY OF  
 UT TO MARTINS CREEK (CONTRERAS)  
 MITIGATION PROJECT  
 MURPHY  
 CHEROKEE COUNTY  
 NORTH CAROLINA

DATE: 04/24/13  
 SURVEYED BY: DST/EGT  
 DRAWN BY: DST/EGT  
 REVIEWED BY: DST/EGT  
 PROJECT: TLS-12-021  
 FILE: UTMC-CONTRERAS\_92766\_TLS\_AB\_F  
 SCALE: AS SHOWN


SHEET  
**3 of 14**

TURNER LAND SURVEYING, PLLC  
 3201 Glenridge Drive, Raleigh, NC 27604 - (919)875-1378  
 P-0702 - Ltumer921@att.net - Dturner119@att.net  
 WWW.TURNERLANDSURVEYING.COM




I, ELISABETH G. TURNER, AS A DULY REGISTERED PROFESSIONAL LAND SURVEYOR IN THE STATE OF NORTH CAROLINA, HEREBY CERTIFY THAT THE DATA SHOWN ON THIS DRAWING, WAS OBTAINED UNDER MY SUPERVISION, IS AN ACCURATE AND COMPLETE REPRESENTATION OF WHAT WAS CONSTRUCTED IN THE FIELD, AND THAT THE PHYSICAL DIMENSIONS OR ELEVATIONS SHOWN THUS ARE AS-BUILT CONDITIONS EXCEPT WHERE OTHERWISE NOTED HEREON. WITNESS MY ORIGINAL SIGNATURE, REGISTRATION NUMBER, AND SEAL THIS 2nd DAY OF AUGUST, 2013.

*Elisabeth G. Turner*  
 ELISABETH G. TURNER, P.L.S. #L-4440  
 NORTH CAROLINA PROFESSIONAL LAND SURVEYOR SEAL L-4440 ELISABETH G. TURNER

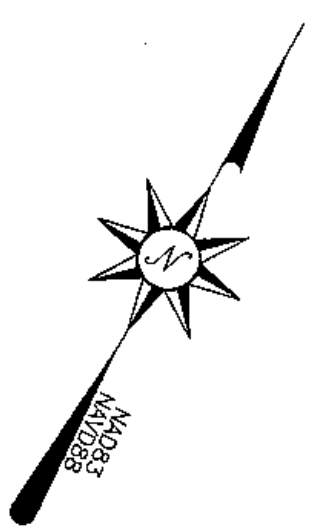


LEGEND:			
---	THALWEG		CONSTRUCTED RIFFLE
---	EX. THALWEG		STREAM CROSSING
---	TOP OF BANK		VERNAL POOL
---	BANK TOE		CONTROL PT./BENCHMARK
---	AS-BUILT LOD		TRANSPLANT
---	CE CONSERVATION EASEMENT (BY OTHERS)		EX. TREE
---	POWER EASEMENT		LOG VANE
---	OW OVERHEAD WIRE		BOULDER STEP
			J-HOOK
			LOG SILL
			ROOTWAD
			STRUCTURE ELEV. AT BANK TIE IN
			GEO-LIFT
			TOE WOOD
			COVER LOGS
			LUNKER BUNKER

NOTES:  
 1. SEE SHEET 1 FOR ALL NOTES.

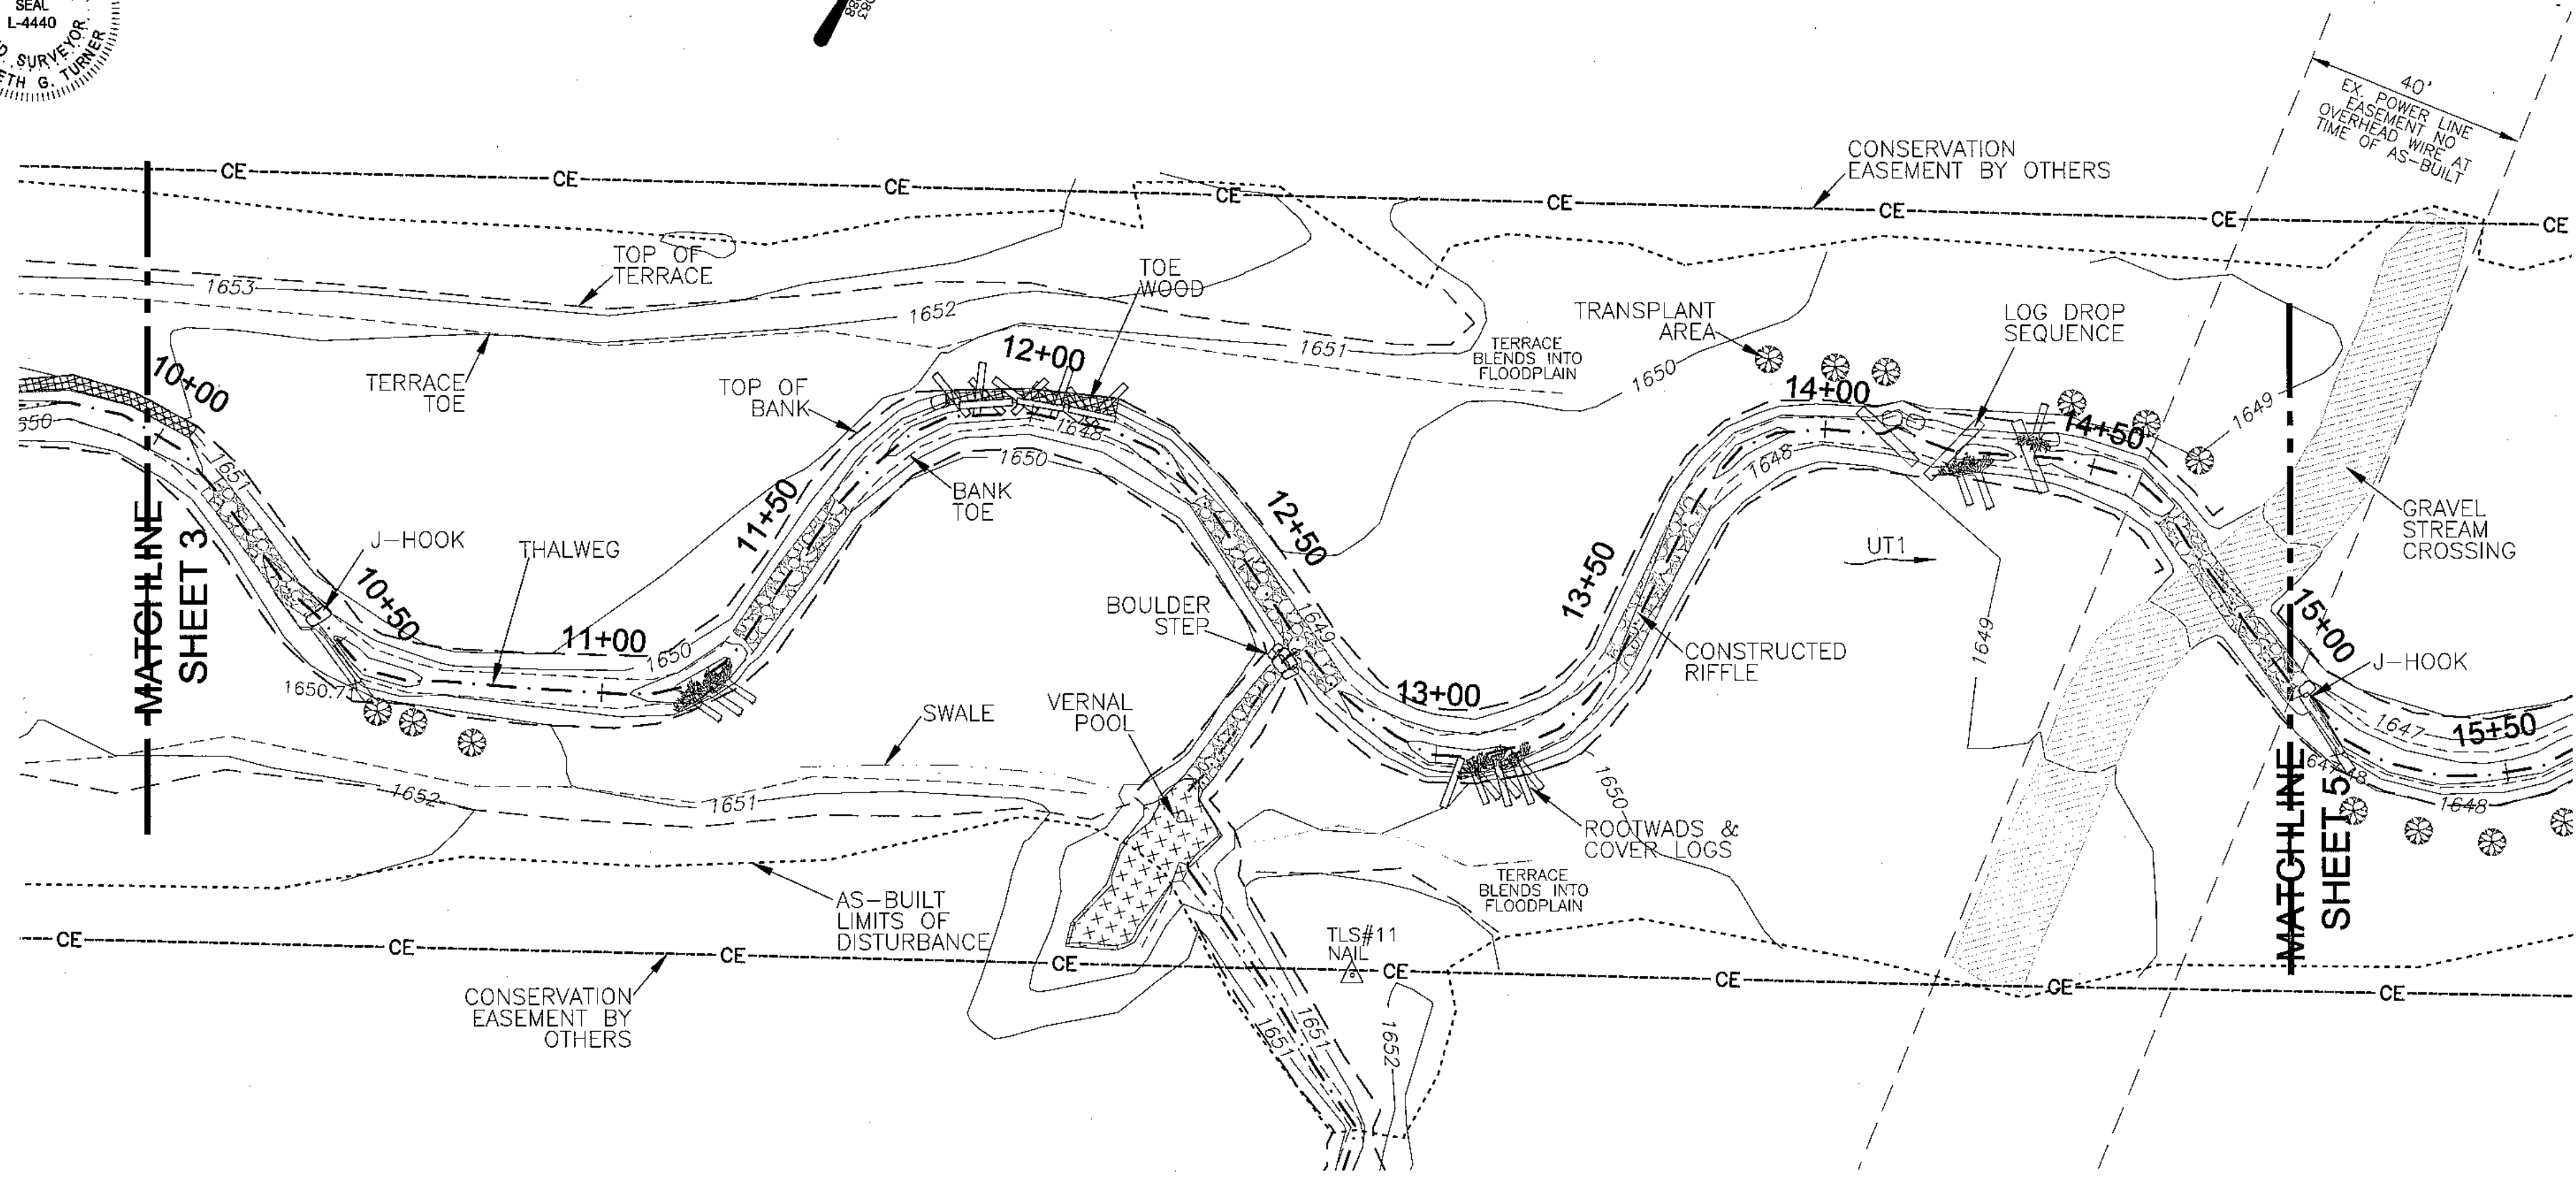

AS-BUILT SURVEY BY:  
 TURNER LAND SURVEYING, PLLC  
 SURVEYED FEB-MAY 2013  
 SCALE: 1"=20' (22x34)  
 1"=40' (11x17)  
 CONTOUR INTERVAL = 1'

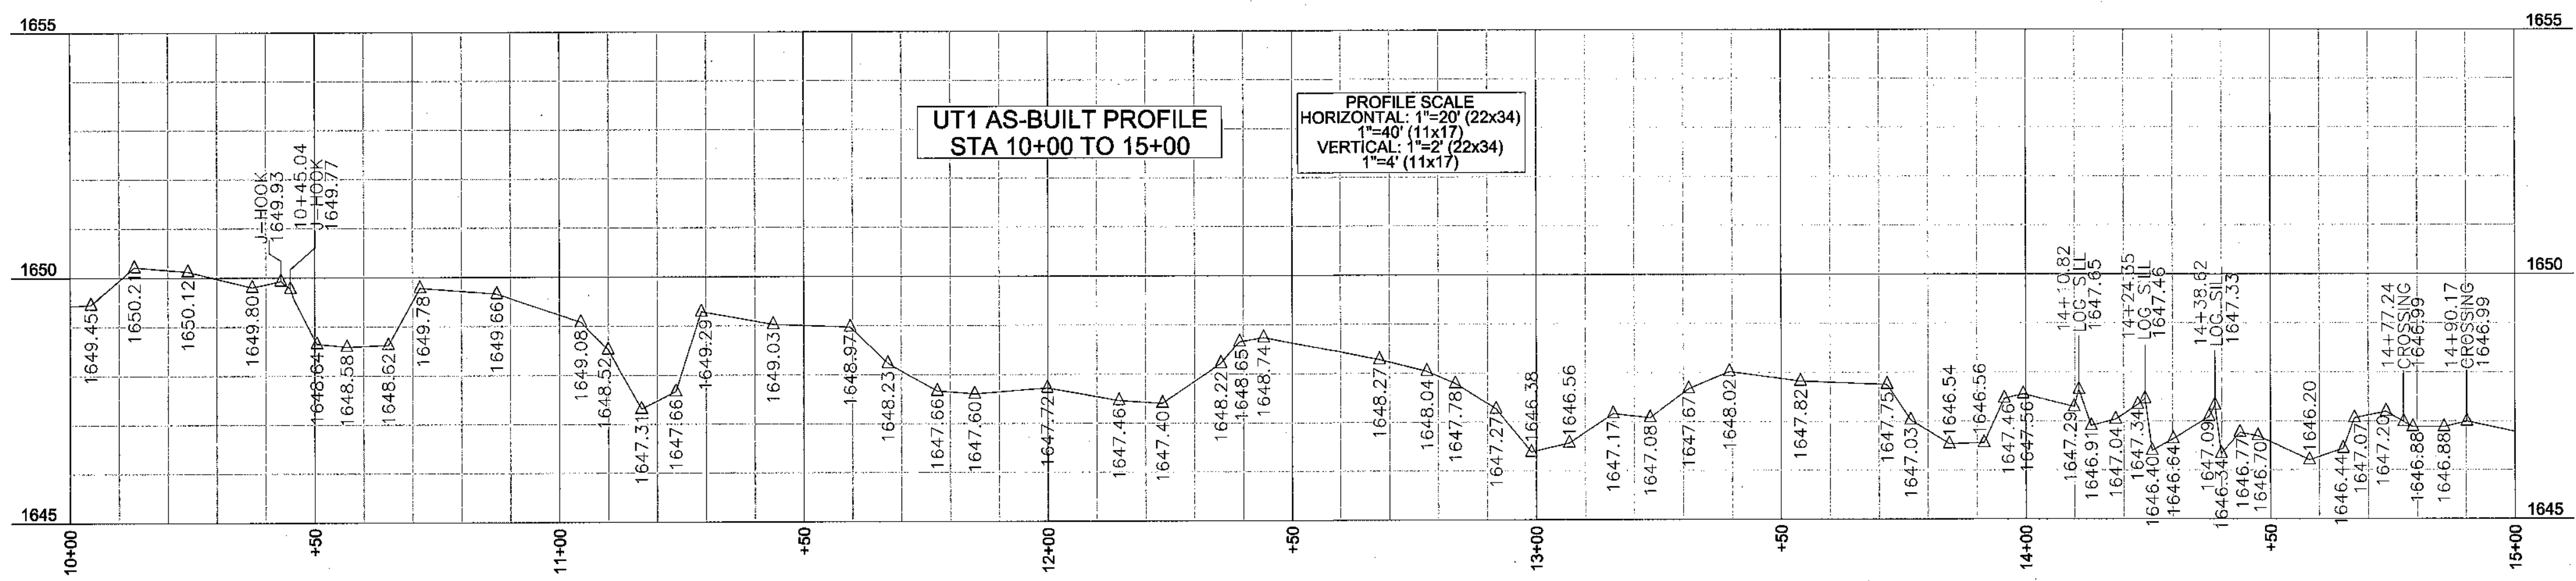

REVISIONS, DATE, AND INITIAL:

TURNER LAND SURVEYING, PLLC  
 3201 Glenridge Drive, Raleigh, NC 27604 -- (919)875-1378  
 P-0702 -- Turner192@att.net -- Turner119@att.net  
 WWW.TURNERLANDSURVEYING.COM

UT1 STA 10+00 TO 15+00 PLAN & PROFILE

AS-BUILT SURVEY OF  
 UT TO MARTINS CREEK (CONTRERAS)  
 MITIGATION PROJECT


MURPHY  
 CHEROKEE COUNTY  
 NORTH CAROLINA

DATE: 04/24/13  
 SURVEYED BY: DST/EGT  
 DRAWN BY: DST/EGT  
 REVIEWED BY: DST/EGT  
 PROJECT: TLS-12-021  
 FILE: UTM-C-CONTRERAS\_92766\_TLS\_AB\_F  
 SCALE: AS SHOWN

SHEET  
**4 of 14**

I, ELISABETH G. TURNER, AS A DULY REGISTERED PROFESSIONAL LAND SURVEYOR IN THE STATE OF NORTH CAROLINA, HEREBY CERTIFY THAT THE DATA SHOWN ON THIS DRAWING, WAS OBTAINED UNDER MY SUPERVISION, IS AN ACCURATE AND COMPLETE REPRESENTATION OF WHAT WAS CONSTRUCTED IN THE FIELD, AND THAT THE PHYSICAL DIMENSIONS OR ELEVATIONS SHOWN THUS ARE AS-BUILT CONDITIONS EXCEPT WHERE OTHERWISE NOTED HEREON. WITNESS MY ORIGINAL SIGNATURE, REGISTRATION NUMBER, AND SEAL THIS 2nd DAY OF AUGUST, 2013.

*Elisabeth G. Turner*  
 ELISABETH G. TURNER, P.L.S. #L-4440

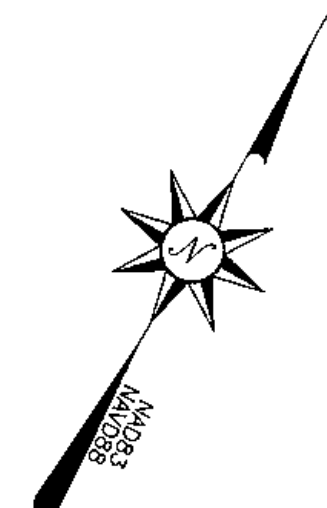



LEGEND:	
--- THALWEG	CONSTRUCTED RIFFLE
--- EX. THALWEG	STREAM CROSSING
--- TOP OF BANK	VERNAL POOL
--- BANK TOE	CONTROL PT./ BENCHMARK
--- AS-BUILT LOD CONSERVATION EASEMENT (BY OTHERS)	TRANSPLANT
--- CE --- POWER EASEMENT	EX. TREE
--- OW --- OVERHEAD WIRE	LOG VANE
	BOULDER STEP
	J-HOOK
	LOG SILL
	ROOTWAD
	STRUCTURE ELEV. AT BANK TIE IN
	GEOLIFT
	TOE WOOD
	COVER LOGS
	LUNKER BUNKER

**NOTES:**  
 1. SEE SHEET 1 FOR ALL NOTES.

AS-BUILT SURVEY BY:  
 TURNER LAND SURVEYING, PLLC  
 SURVEYED FEB-MAY 2013

20' 0' 20' 40'

SCALE: 1"=20' (22x34)  
 1"=40' (11x17)  
 CONTOUR INTERVAL = 1'

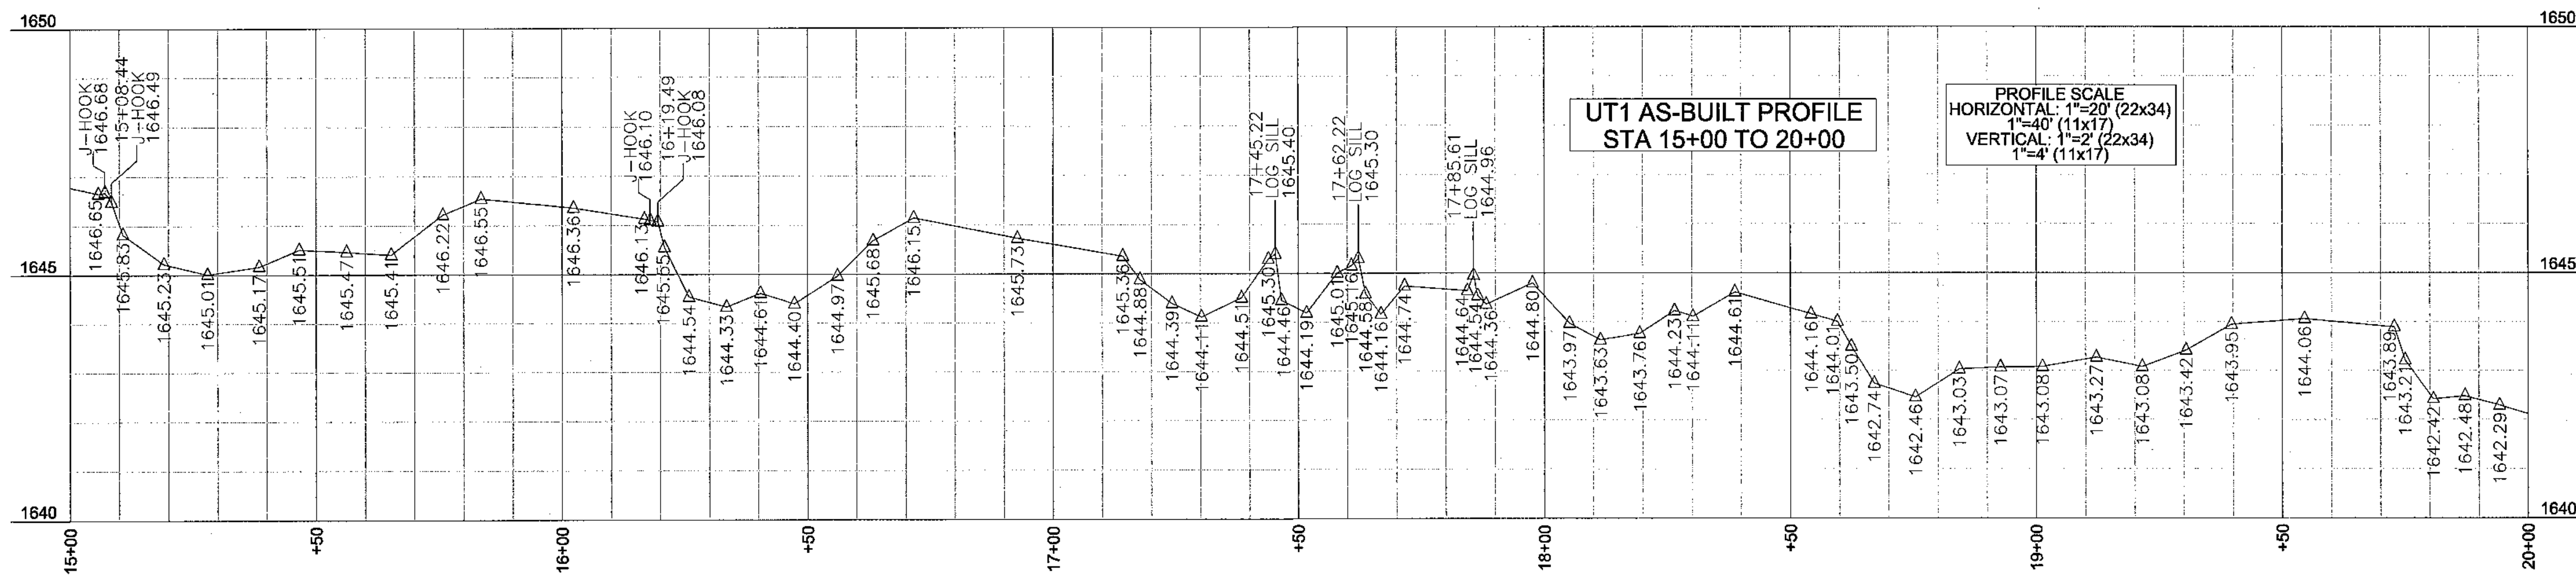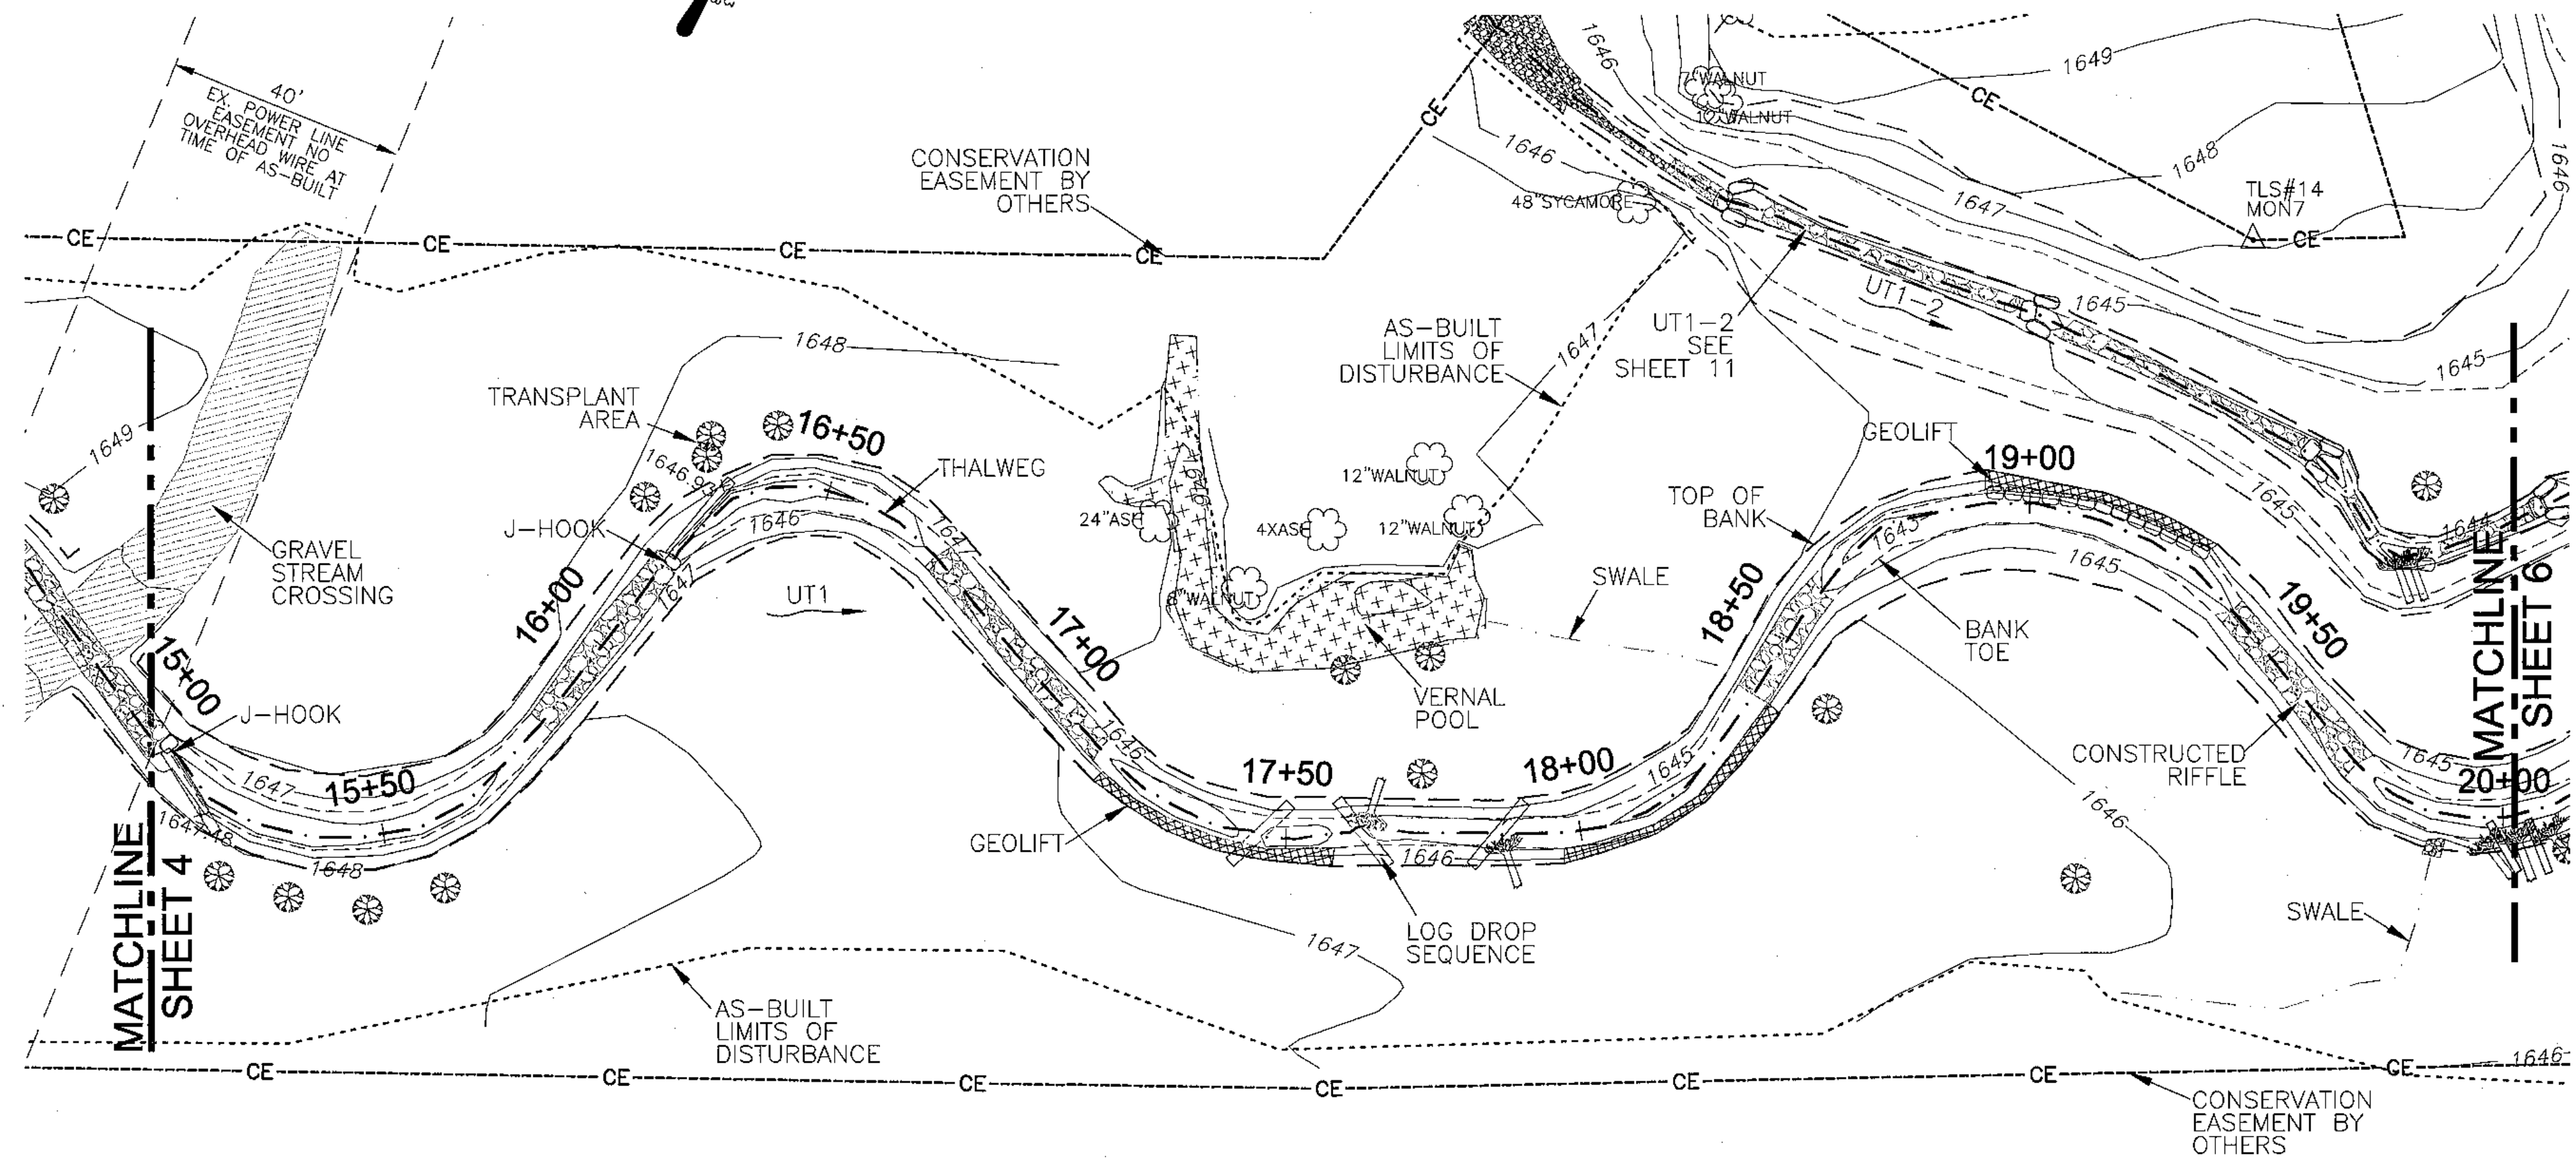

REVISIONS, DATE, AND INITIAL


UT1 STA 15+00 TO 20+00 PLAN & PROFILE  
 AS-BUILT SURVEY OF  
 UT TO MARTINS CREEK (CONTRERAS)  
 MITIGATION PROJECT

NORTH CAROLINA

MURPHY

CHEROKEE COUNTY

TURNER LAND SURVEYING, PLLC  
 3201 Glenridge Drive, Raleigh, NC 27604 - (919)875-1378  
 P-0702 - Lturner921@att.net - Dturner119@att.net  
 www.TURNERLANDSURVEYING.com

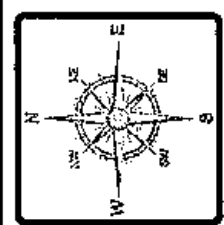


DATE: 04/24/13  
 SURVEYED BY: DST/EGT  
 DRAWN BY: DST/EGT  
 REVIEWED BY: DST/EGT  
 PROJECT: TLS-12-021  
 FILE: UTMC-CONTRERAS\_92766\_TLS\_AB\_F  
 SCALE: AS SHOWN

SHEET  
**5 of 14**


I, ELISABETH G. TURNER, AS A DULY REGISTERED PROFESSIONAL LAND SURVEYOR IN THE STATE OF NORTH CAROLINA, HEREBY CERTIFY THAT THE DATA SHOWN ON THIS DRAWING, WAS OBTAINED UNDER MY SUPERVISION, IS AN ACCURATE AND COMPLETE REPRESENTATION OF WHAT WAS CONSTRUCTED IN THE FIELD, AND THAT THE PHYSICAL DIMENSIONS OR ELEVATIONS SHOWN THUS ARE AS-BUILT CONDITIONS EXCEPT WHERE OTHERWISE NOTED HEREON. WITNESS MY ORIGINAL SIGNATURE, REGISTRATION NUMBER, AND SEAL THIS 2nd DAY OF AUGUST, 2013.

*Elisabeth G. Turner*  
 ELISABETH G. TURNER, P.L.S. #L-4440  
 NORTH CAROLINA PROFESSIONAL LAND SURVEYOR  
 SEAL L-4440  
 ELISABETH G. TURNER

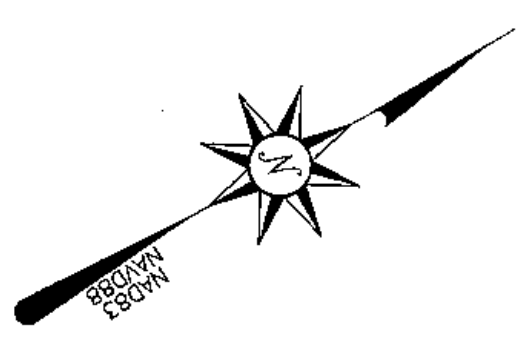

NOTES:  
 1. SEE SHEET 1 FOR ALL NOTES.


LEGEND:	
--- THALWEG	CONSTRUCTED RIFFLE
- - - EX. THALWEG	STREAM CROSSING
--- TOP OF BANK	VERNAL POOL
--- BANK TOE	CONTROL PT./ BENCHMARK
--- AS-BUILT LOD	TRANSPLANT
--- CE CONSERVATION EASEMENT (BY OTHERS)	EX. TREE
--- POWER EASEMENT	LOG VANE
--- OW OVERHEAD WIRE	BOULDER STEP
	J-HOOK
	LOG SILL
	ROOTWAD
	STRUCTURE ELEV. AT BANK TIE IN
	GEOLIFT
	TOE WOOD
	COVER LOGS
	LUNKER BUNKER

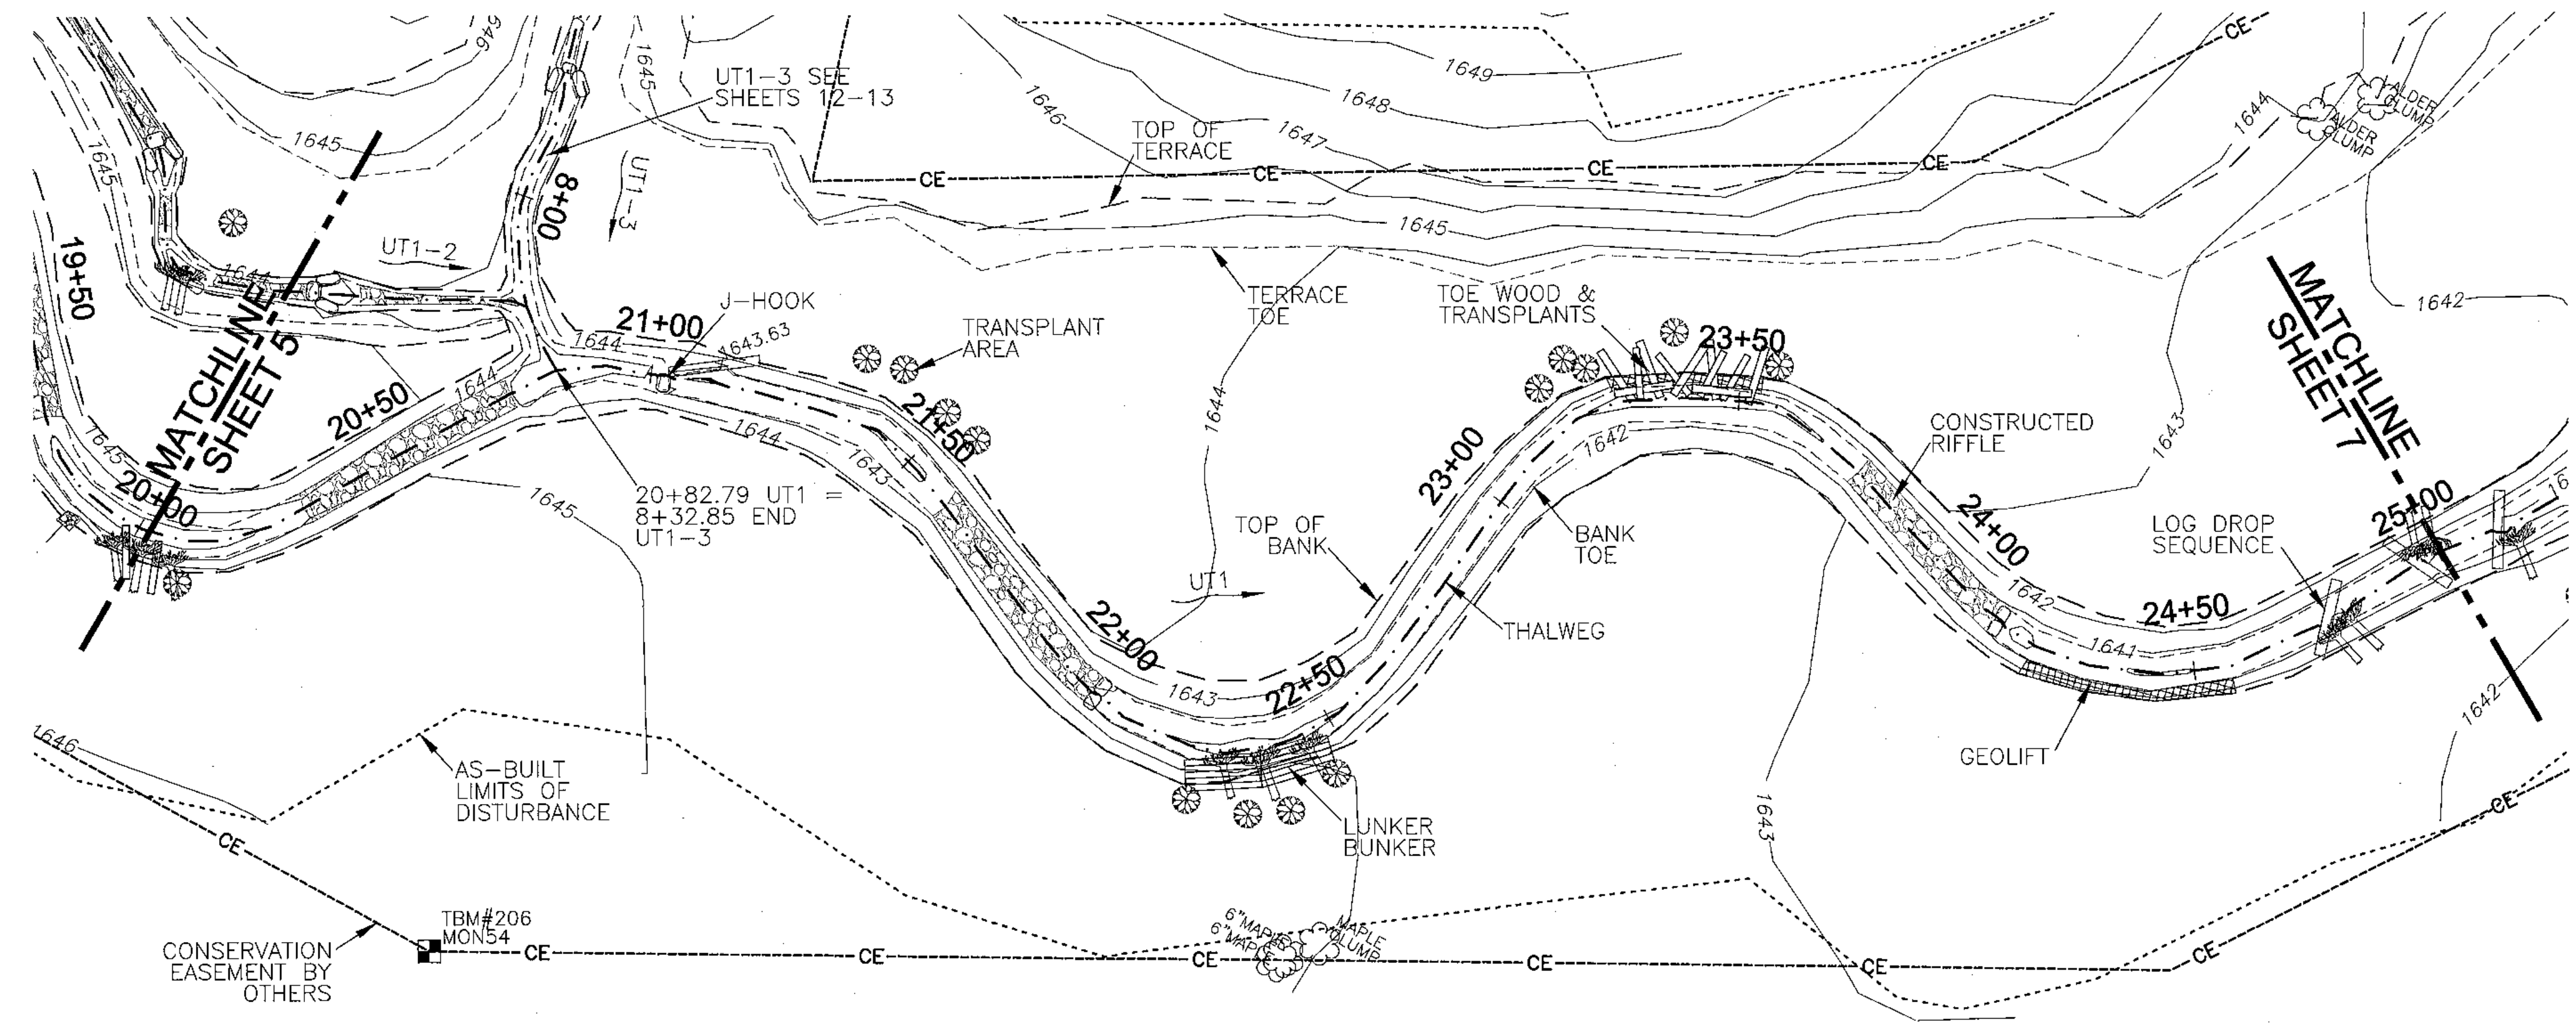

AS-BUILT SURVEY BY:  
 TURNER LAND SURVEYING, PLLC  
 SURVEYED FEB-MAY 2013

20' 0' 20' 40'

SCALE: 1"=20' (22x34)  
 1"=40' (11x17)  
 CONTOUR INTERVAL = 1'

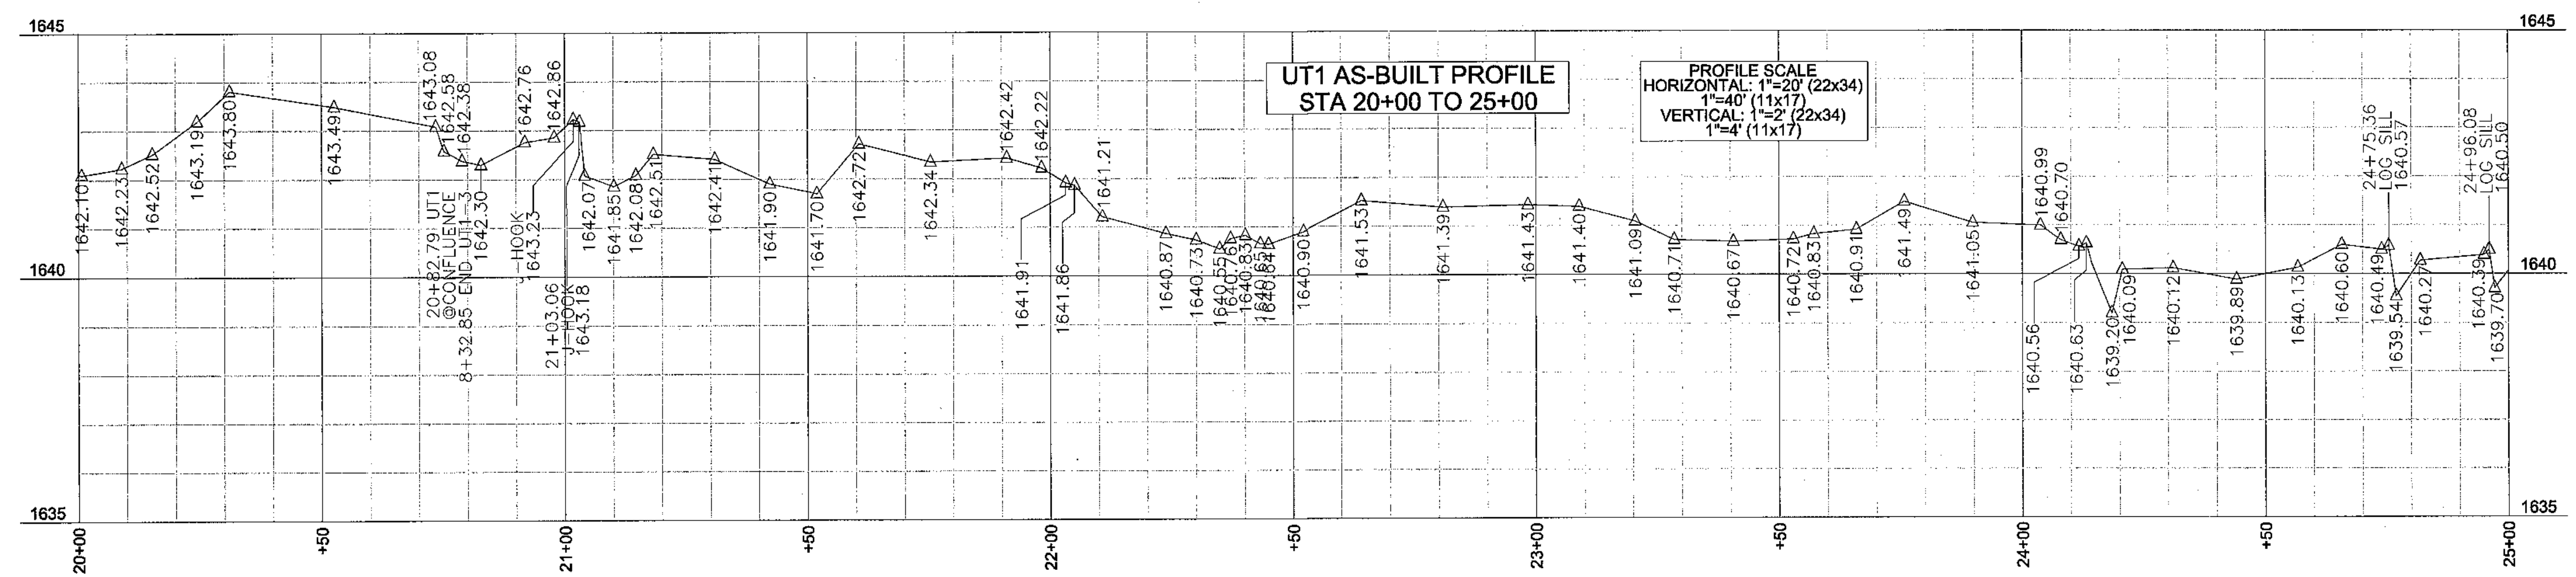

REVISIONS, DATE, AND INITIAL:

TURNER LAND SURVEYING, PLLC  
 3201 Glenridge Drive, Raleigh, NC 27604 - (919)875-1378  
 P-0702 - Ltumer21@att.net - Dturner19@att.net  
 WWW.TURNERLANDSURVEYING.COM

UT1 STA 20+00 TO 25+00 PLAN & PROFILE  
 AS-BUILT SURVEY OF  
 UT TO MARTINS CREEK (CONTRERAS)  
 MITIGATION PROJECT  
 MURPHY  
 CHEROKEE COUNTY  
 NORTH CAROLINA

DATE: 04/24/13  
 SURVEYED BY: DST/JGT  
 DRAWN BY: DST/JGT  
 REVIEWED BY: DST/JGT  
 PROJECT: TLS-12-021  
 FILE: UTMC-CONTRERAS\_92766\_TLS\_AB\_F  
 SCALE: AS SHOWN

SHEET  
**6 of 14**


I, ELISABETH G. TURNER, AS A DULY REGISTERED PROFESSIONAL LAND SURVEYOR IN THE STATE OF NORTH CAROLINA, HEREBY CERTIFY THAT THE DATA SHOWN ON THIS DRAWING, WAS OBTAINED UNDER MY SUPERVISION, IS AN ACCURATE AND COMPLETE REPRESENTATION OF WHAT WAS CONSTRUCTED IN THE FIELD, AND THAT THE PHYSICAL DIMENSIONS OR ELEVATIONS SHOWN THUS ARE AS-BUILT CONDITIONS EXCEPT WHERE OTHERWISE NOTED HEREON. WITNESS MY ORIGINAL SIGNATURE, REGISTRATION NUMBER, AND SEAL THIS 2nd DAY OF AUGUST, 2013.

*Elisabeth G. Turner*  
 ELISABETH G. TURNER, P.L.S. #L-4440



NOTES:  
 1. SEE SHEET 1 FOR ALL NOTES.


LEGEND:	
--- THALWEG	CONSTRUCTED RIFFLE
- - - EX. THALWEG	STREAM CROSSING
--- TOP OF BANK	VERNAL POOL
--- BANK TOE	CONTROL PT./ BENCHMARK
- - - AS-BUILT LOD	TRANSPLANT
--- CE CONSERVATION EASEMENT (BY OTHERS)	EX. TREE
--- POWER EASEMENT	LOG VANE
--- OW OVERHEAD WIRE	BOULDER STEP
	J-HOOK
	LOG SILL
	ROOTWAD
	STRUCTURE ELEV. AT BANK TIE IN
	GEOLIFT
	TOE WOOD
	COVER LOGS
	LUNKER BUNKER

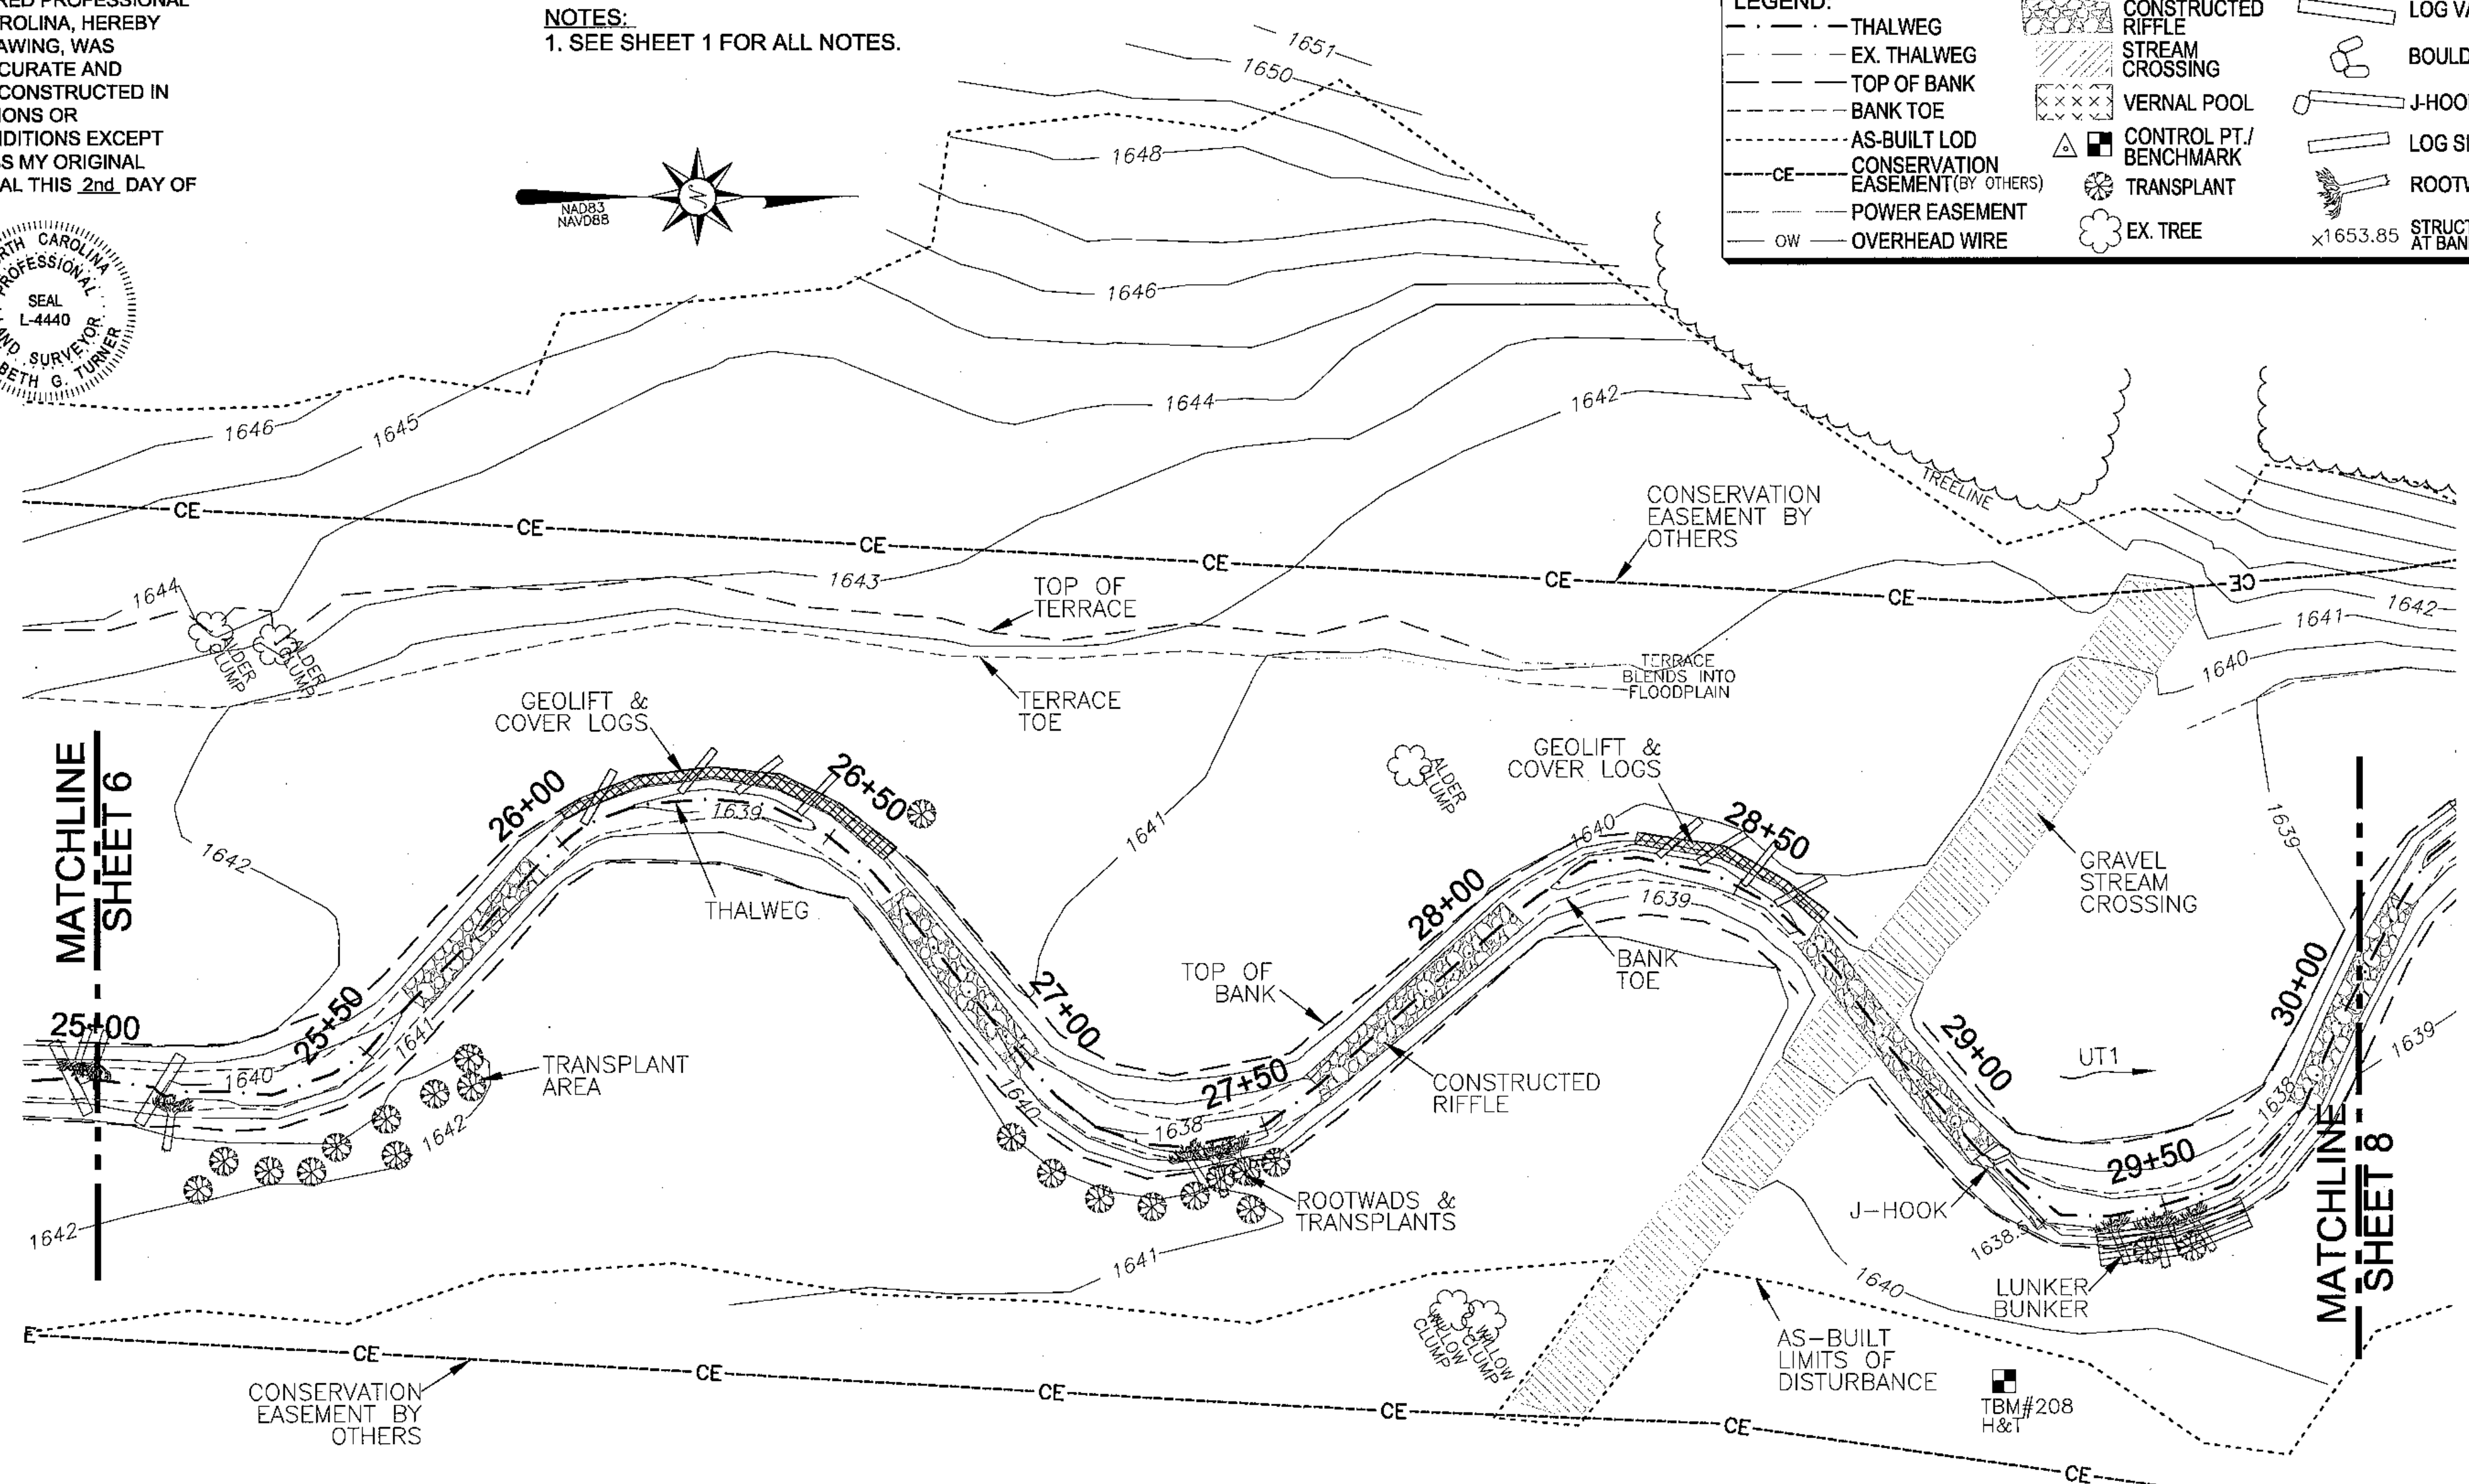

AS-BUILT SURVEY BY:  
 TURNER LAND SURVEYING, PLLC  
 SURVEYED FEB-MAY 2013

20' 0' 20' 40'

SCALE: 1"=20' (22x34)  
 1"=40' (11x17)  
 CONTOUR INTERVAL = 1'

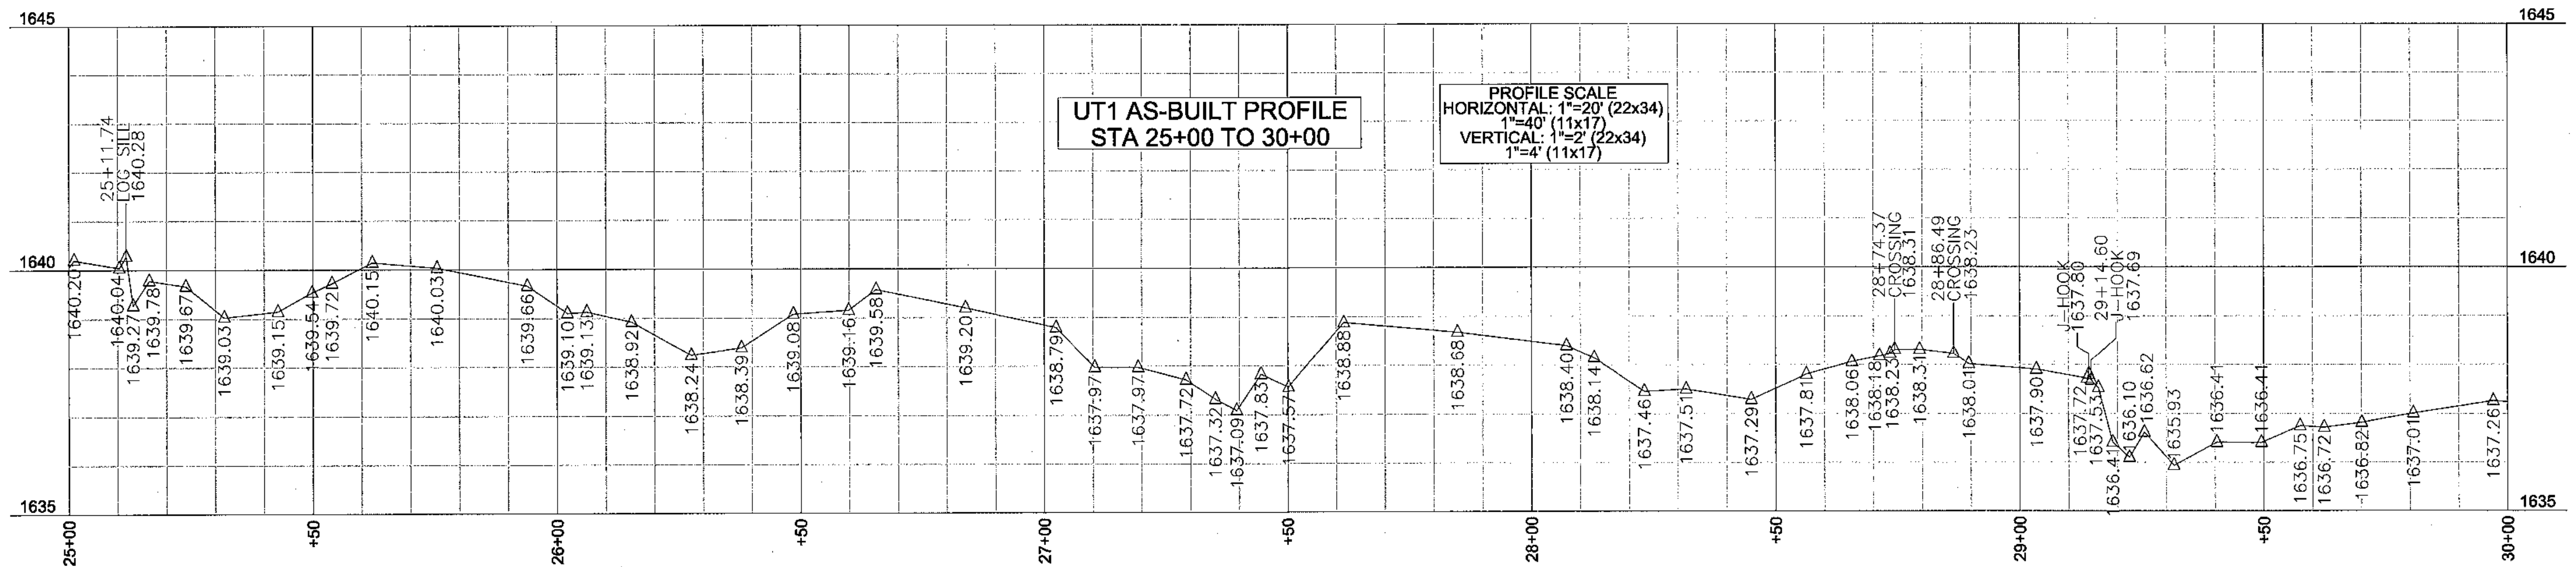

REVISIONS, DATE, AND INITIAL:

TURNER LAND SURVEYING, PLLC  
 3201 Glenridge Drive, Raleigh, NC 27604 - (919) 875-1378  
 P-0702 - lturner21@att.net - Dturner119@att.net  
 www.TURNERLANDSURVEYING.com

UT1 STA 25+00 TO 30+00 PLAN & PROFILE  
 AS-BUILT SURVEY OF  
 UT TO MARTINS CREEK (CONTRERAS)  
 MITIGATION PROJECT

MURPHY  
 NORTH CAROLINA  
 CHEROKEE COUNTY



DATE: 04/24/13  
 SURVEYED BY: DST/EGT  
 DRAWN BY: DST/EGT  
 REVIEWED BY: DST/EGT  
 PROJECT: TLS-12-021  
 FILE: UTM-CONTRERAS\_92766\_TLS\_AB\_F  
 SCALE: AS SHOWN

SHEET  
**7 of 14**


I, ELISABETH G. TURNER, AS A DULY REGISTERED PROFESSIONAL LAND SURVEYOR IN THE STATE OF NORTH CAROLINA, HEREBY CERTIFY THAT THE DATA SHOWN ON THIS DRAWING, WAS OBTAINED UNDER MY SUPERVISION, IS AN ACCURATE AND COMPLETE REPRESENTATION OF WHAT WAS CONSTRUCTED IN THE FIELD, AND THAT THE PHYSICAL DIMENSIONS OR ELEVATIONS SHOWN THUS ARE AS-BUILT CONDITIONS EXCEPT WHERE OTHERWISE NOTED HEREON. WITNESS MY ORIGINAL SIGNATURE, REGISTRATION NUMBER, AND SEAL THIS 2nd DAY OF AUGUST, 2013.

*Elisabeth G. Turner*  
 ELISABETH G. TURNER, P.L.S. #L-4440  
 NORTH CAROLINA PROFESSIONAL LAND SURVEYOR SEAL L-4440 ELISABETH G. TURNER

NOTES:  
 1. SEE SHEET 1 FOR ALL NOTES.

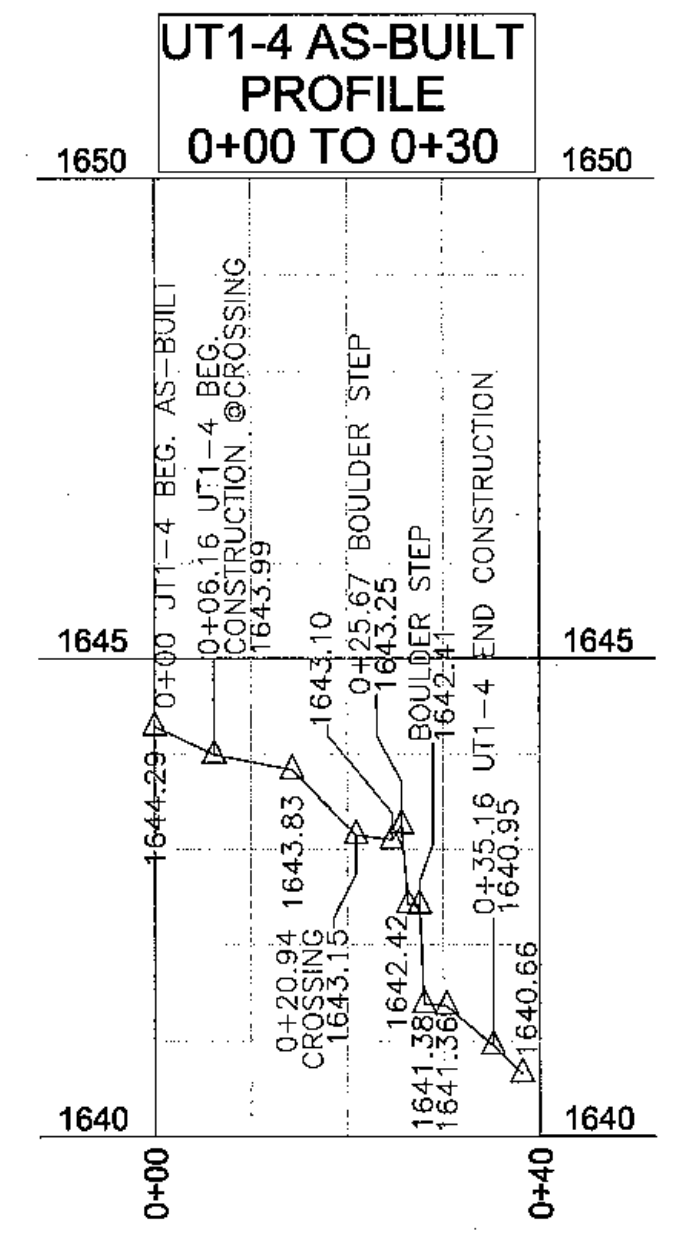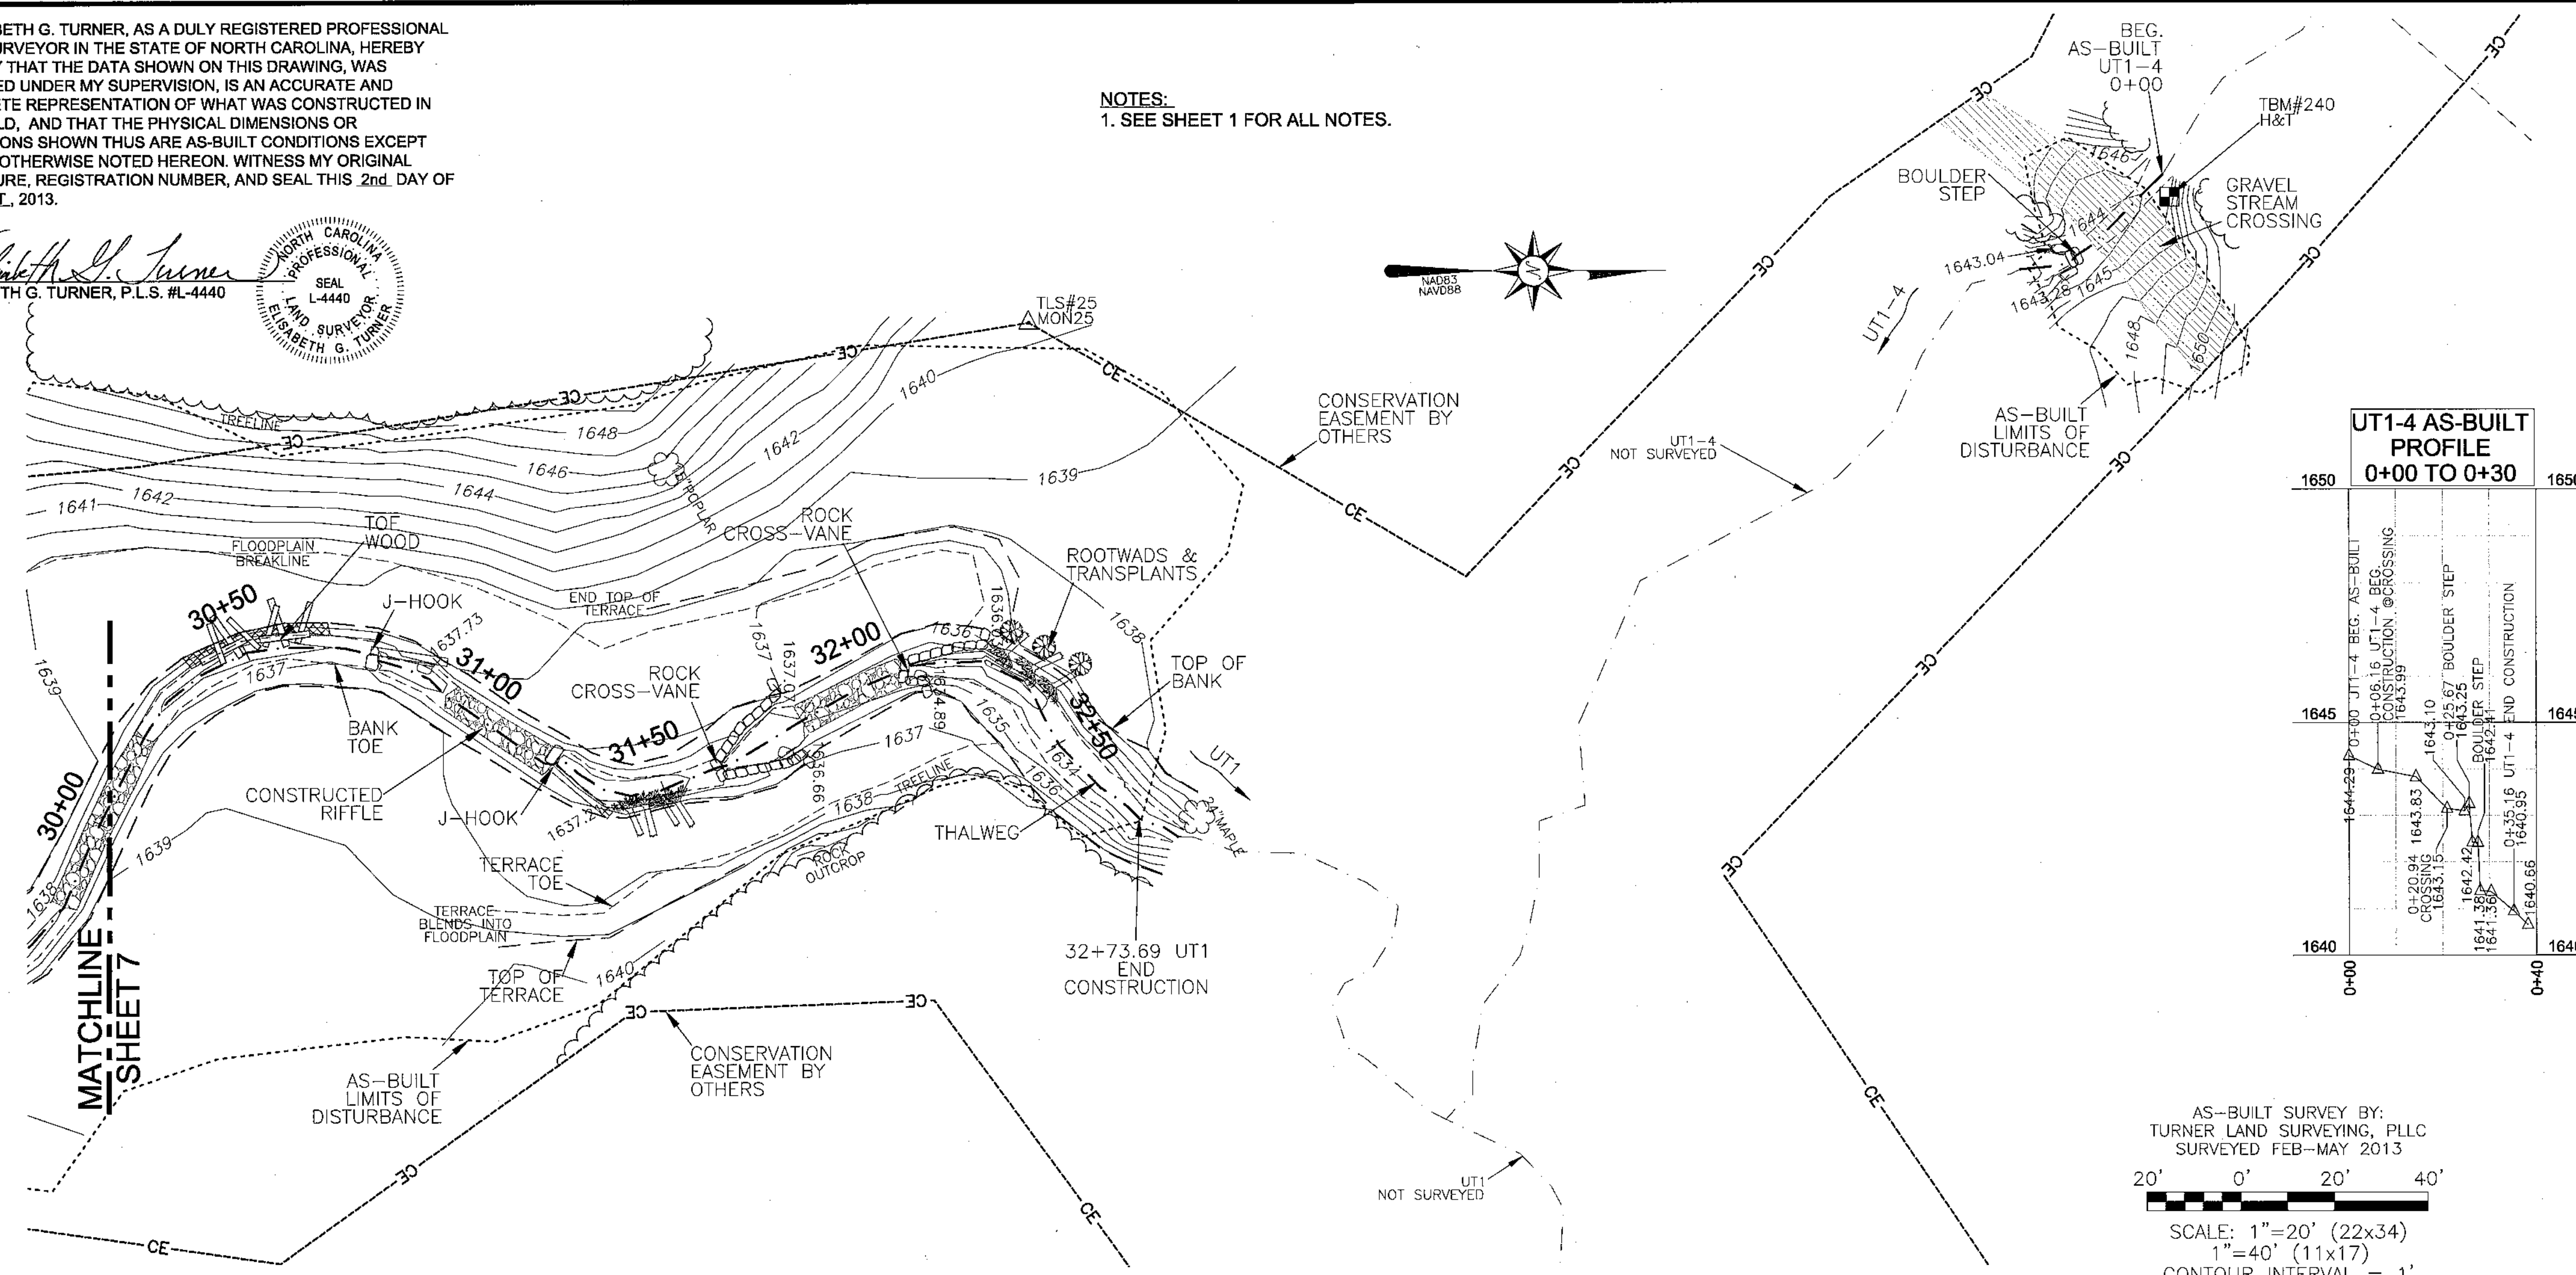

AS-BUILT SURVEY BY:  
 TURNER LAND SURVEYING, PLLC  
 SURVEYED FEB-MAY 2013  
 20' 0' 20' 40'  
 SCALE: 1"=20' (22x34)  
 1"=40' (11x17)  
 CONTOUR INTERVAL = 1'

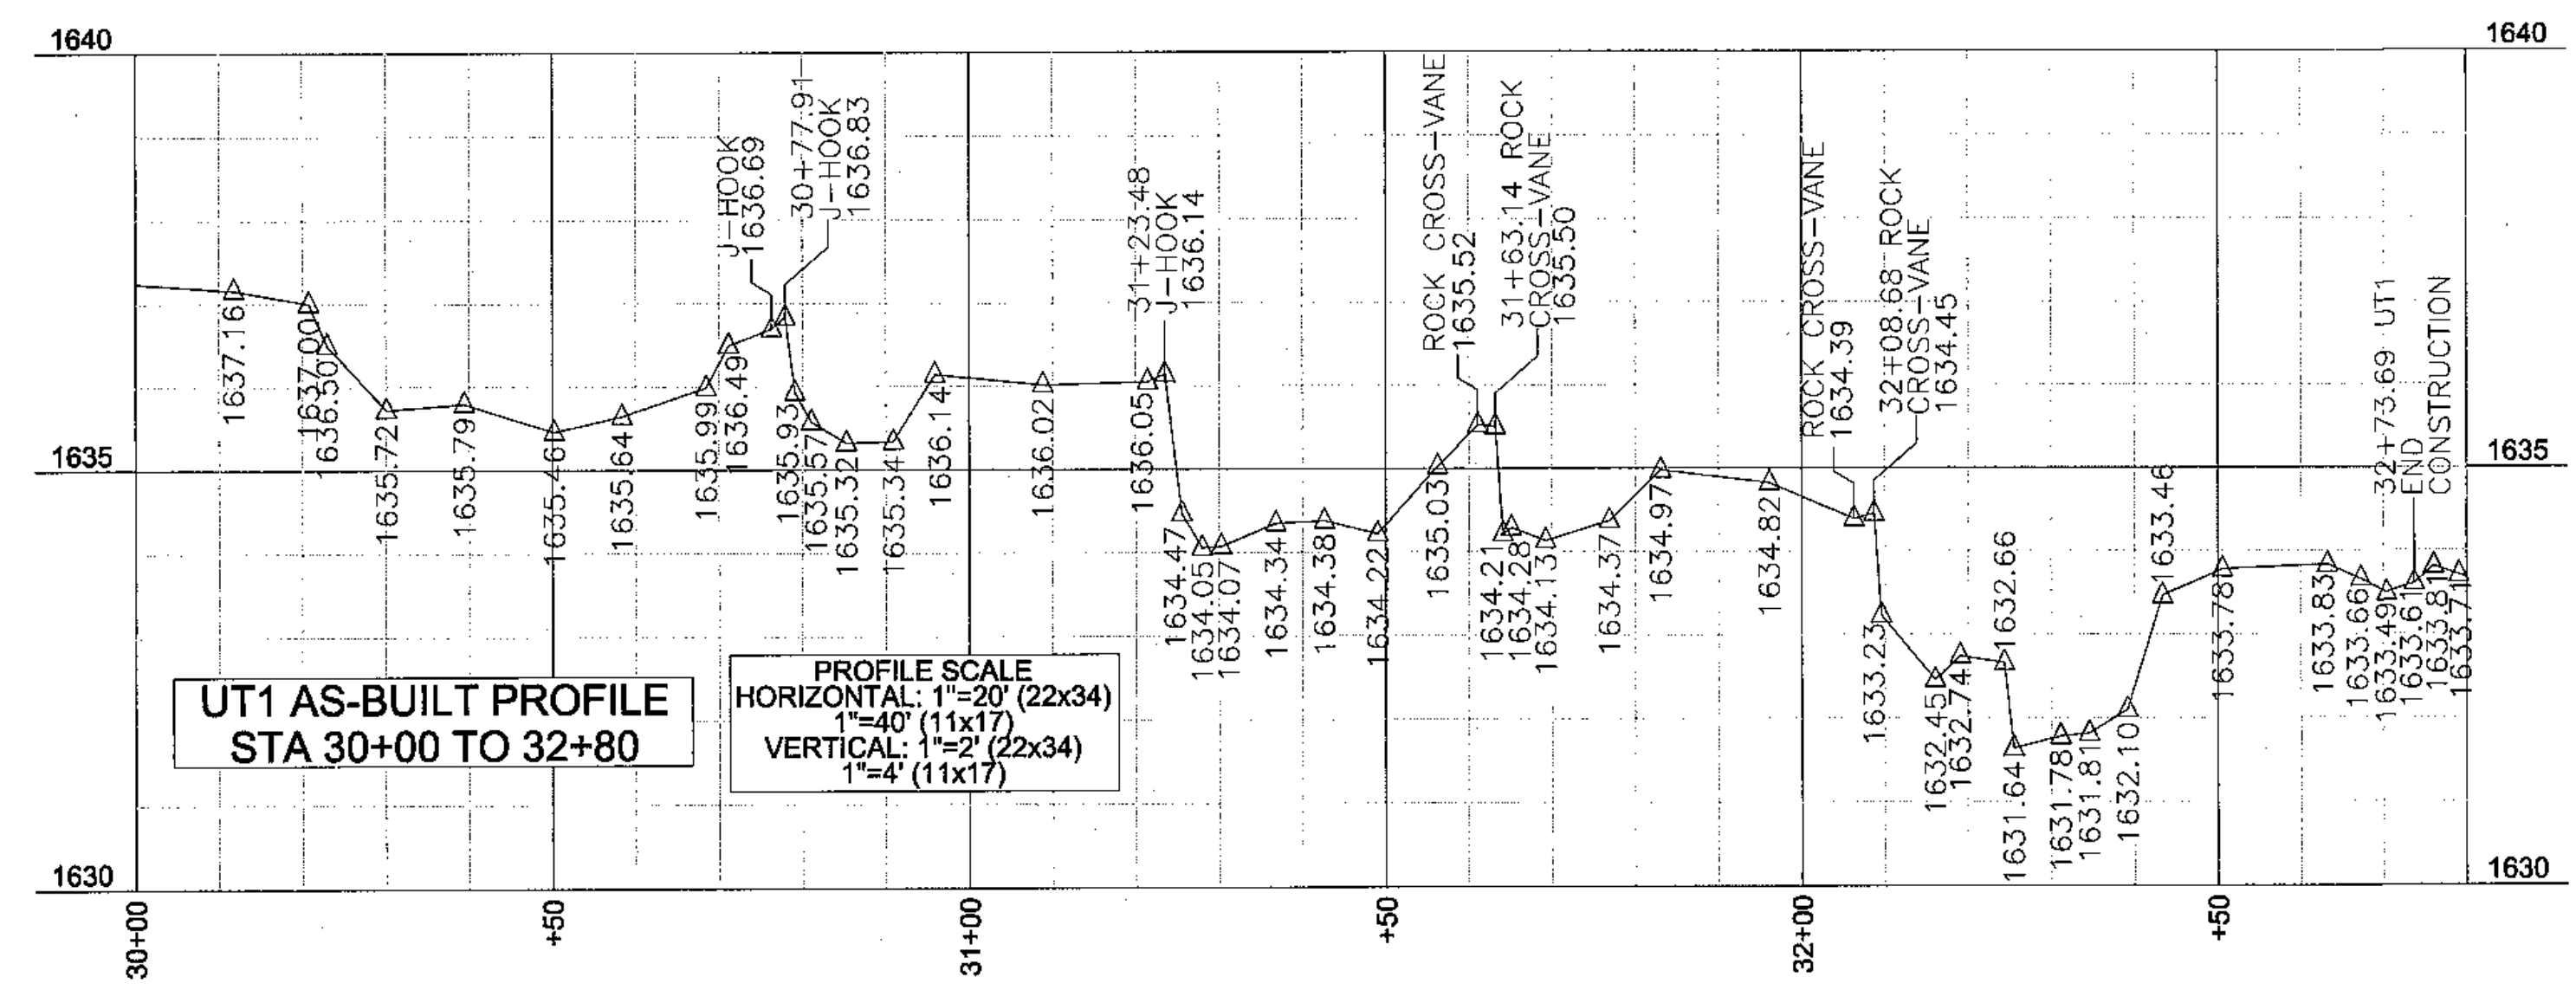

LEGEND:

--- THALWEG	CONSTRUCTED RIFFLE	LOG VANE	GEOLIFT
- - - EX. THALWEG	STREAM CROSSING	BOULDER STEP	TOE WOOD
--- TOP OF BANK	VERNAL POOL	J-HOOK	COVER LOGS
--- BANK TOE	AS-BUILT LOD	LOG SILL	LUNKER BUNKER
--- CE	CONSERVATION EASEMENT (BY OTHERS)	ROOTWAD	
--- POWER EASEMENT	CONTROL PT / BENCHMARK	STRUCTURE ELEV. AT BANK TIE IN	
--- OW	TRANSPLANT		
	EX. TREE		

REVISIONS, DATE, AND INITIAL:

TURNER LAND SURVEYING, PLLC  
 3201 Glenridge Drive, Raleigh, NC 27604 - (919) 875-1378  
 P-0702 - Lturner@atl.net - Dturner119@atl.net  
 WWW.TURNERLANDSURVEYING.COM


UT1 STA 30+00 TO 32+80 PLAN & PROFILE AND UT-4 CROSSING & STRUCTURE

AS-BUILT SURVEY OF UT TO MARTINS CREEK (CONTRERAS) MITIGATION PROJECT

MURPHY NORTH CAROLINA CHEROKEE COUNTY

DATE: 04/24/13  
 SURVEYED BY: DST/EGT  
 DRAWN BY: DST/EGT  
 REVIEWED BY: DST/EGT  
 PROJECT: TLS-12-021  
 FILE: UTM-CONTRERAS\_92766\_TLS\_AB\_F  
 SCALE: AS SHOWN

SHEET 8 of 14

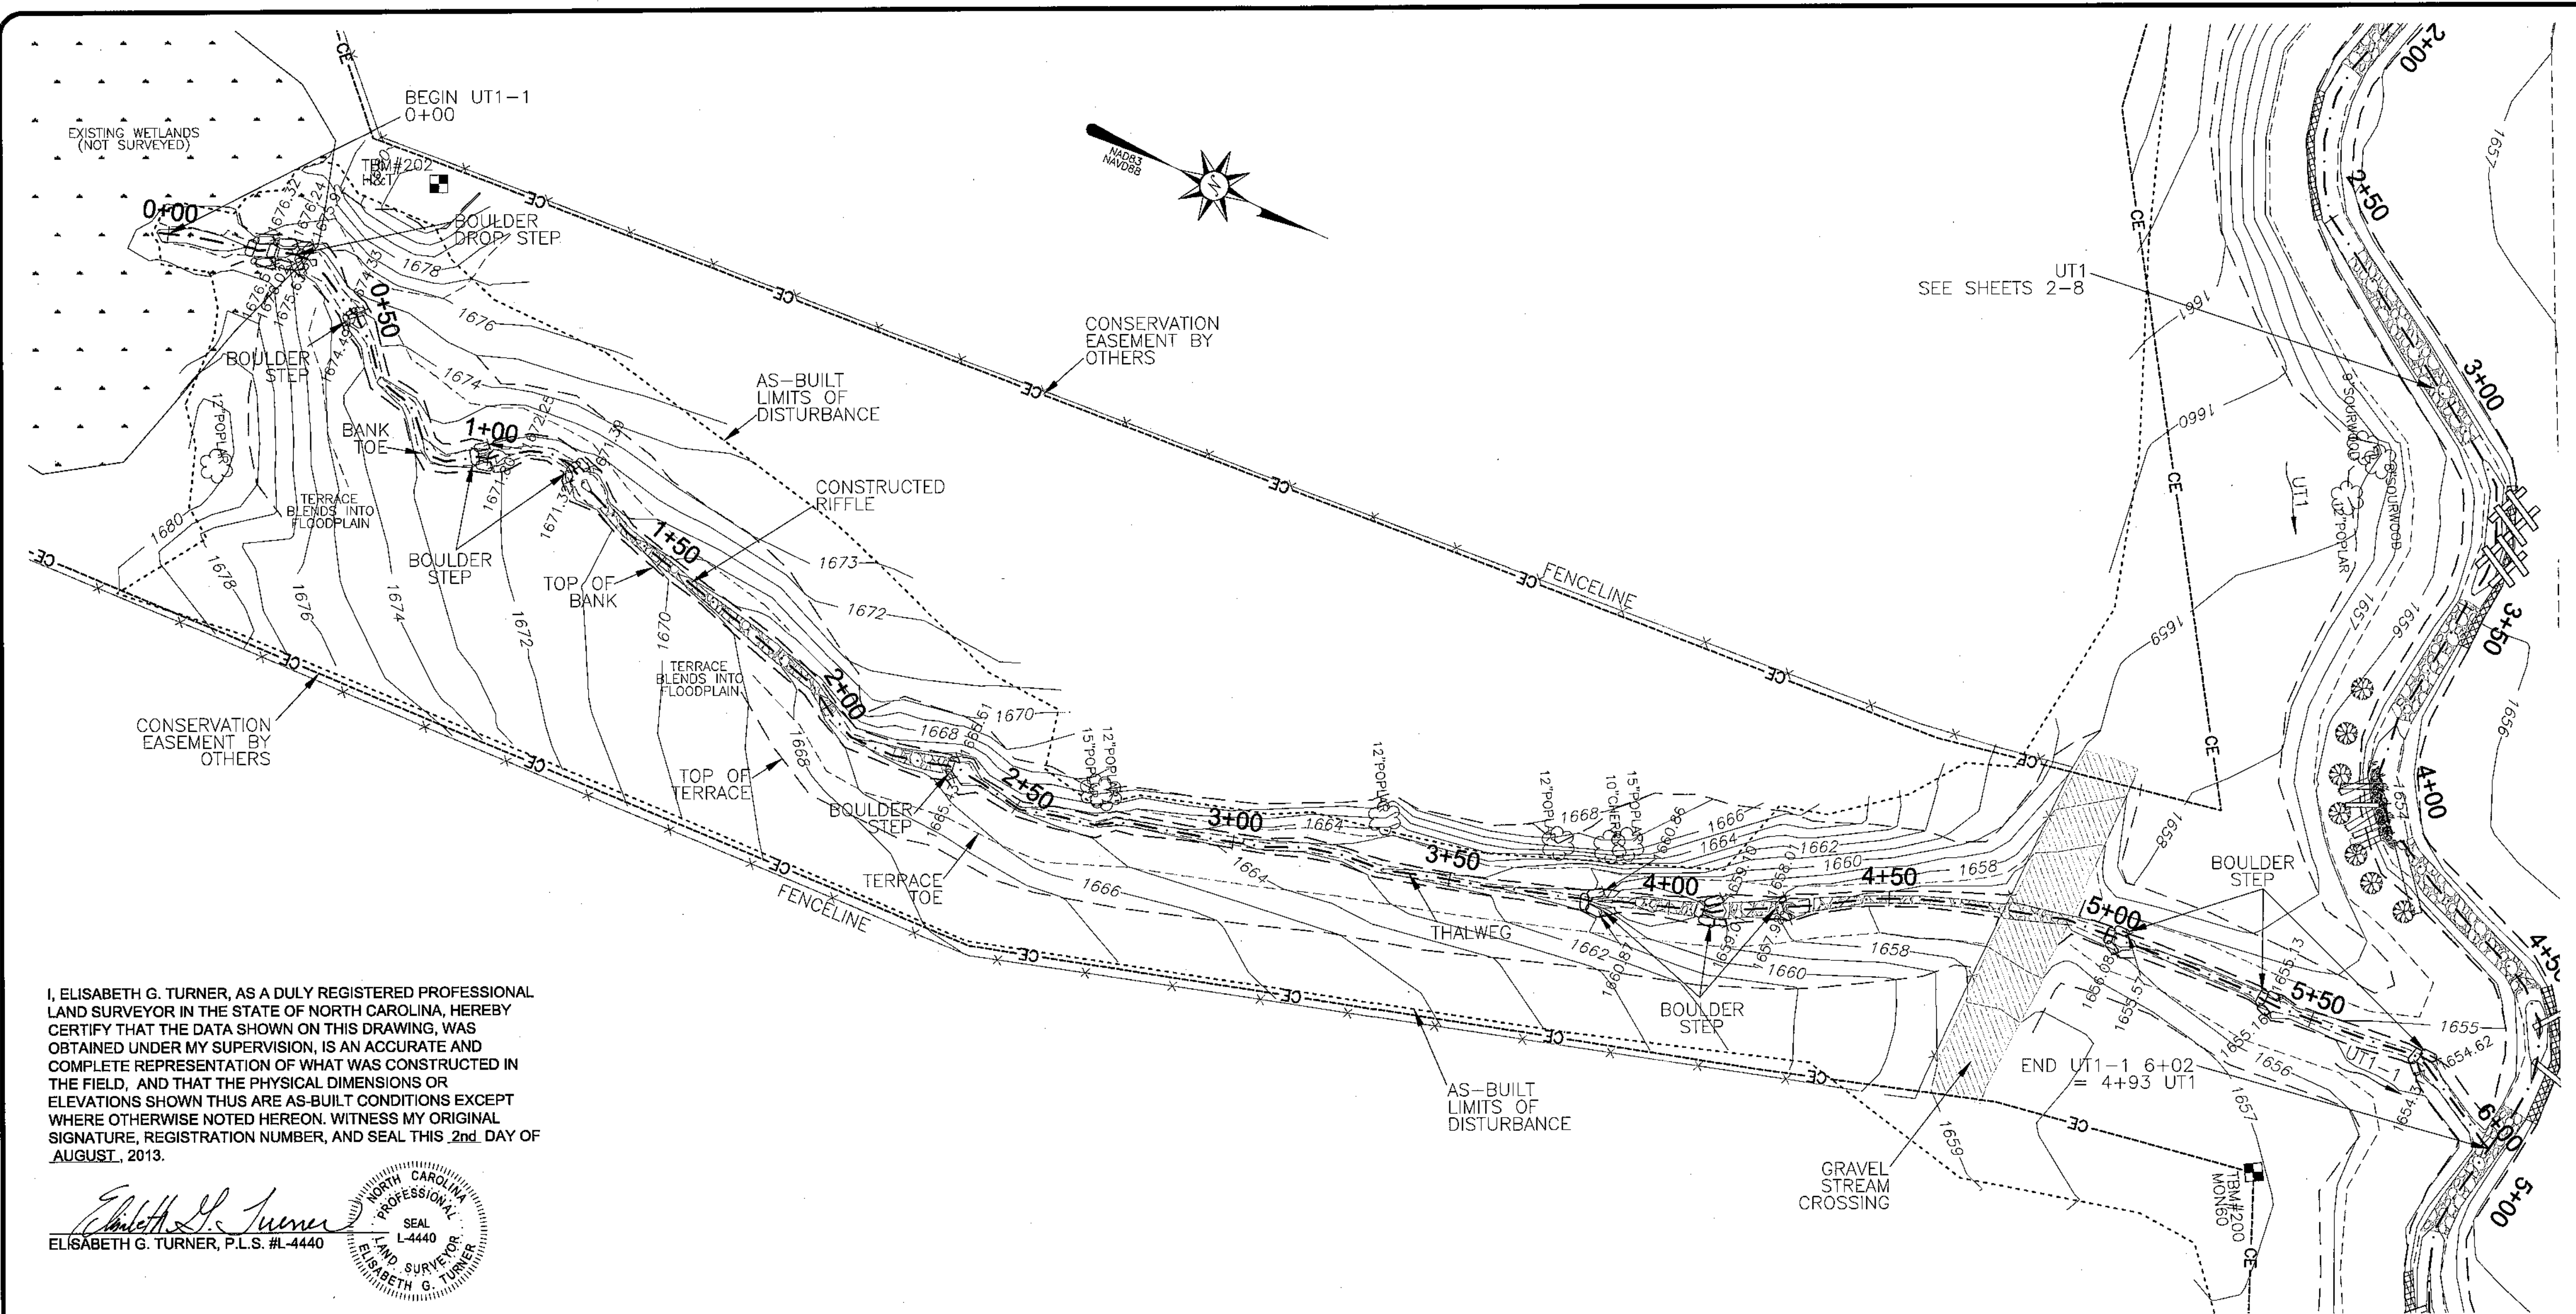

I, ELISABETH G. TURNER, AS A DULY REGISTERED PROFESSIONAL LAND SURVEYOR IN THE STATE OF NORTH CAROLINA, HEREBY CERTIFY THAT THE DATA SHOWN ON THIS DRAWING, WAS OBTAINED UNDER MY SUPERVISION, IS AN ACCURATE AND COMPLETE REPRESENTATION OF WHAT WAS CONSTRUCTED IN THE FIELD, AND THAT THE PHYSICAL DIMENSIONS OR ELEVATIONS SHOWN THUS ARE AS-BUILT CONDITIONS EXCEPT WHERE OTHERWISE NOTED HEREON. WITNESS MY ORIGINAL SIGNATURE, REGISTRATION NUMBER, AND SEAL THIS 2nd DAY OF AUGUST, 2013.

*Elisabeth G. Turner*  
 ELISABETH G. TURNER, P.L.S. #L-4440  
 NORTH CAROLINA PROFESSIONAL LAND SURVEYOR  
 SEAL L-4440  
 ELISABETH G. TURNER

LEGEND:	
--- THALWEG	CONSTRUCTED RIFFLE
--- EX. THALWEG	STREAM CROSSING
--- TOP OF BANK	VERNAL POOL
--- BANK TOE	CONTROL PT./ BENCHMARK
--- AS-BUILT LOD	TRANSPLANT
--- CE --- CONSERVATION EASEMENT (BY OTHERS)	EX. TREE
--- POWER EASEMENT	LOG VANE
--- OW --- OVERHEAD WIRE	BOULDER STEP
	J-HOOK
	LOG SILL
	ROOTWAD
	STRUCTURE ELEV. AT BANK TIE IN
	GEOLIFT
	TOE WOOD
	COVER LOGS
	LUNKER BUNKER

**NOTES:**  
 1. SEE SHEET 1 FOR ALL NOTES.  
 2. SEE SHEET 10 FOR UT1-1 PROFILE.

AS-BUILT SURVEY BY:  
 TURNER LAND SURVEYING, PLLC  
 SURVEYED FEB-MAY 2013  
 20' 0' 20' 40'  
 SCALE: 1"=20' (22x34)  
 1"=40' (11x17)  
 CONTOUR INTERVAL = 1'


REVISIONS, DATE, AND INITIAL:

TURNER LAND SURVEYING, PLLC  
 3201 Glenridge Drive, Raleigh, NC 27604 - (919)75-1378  
 P-0702 - Lturner921@att.net - Dturner119@att.net  
 www.TURNERLANDSURVEYING.com



UT1-1 STA 0+00 TO 6+02 PLAN VIEW  
 AS-BUILT SURVEY OF  
 UT TO MARTINS CREEK (CONTRERAS)  
 MITIGATION PROJECT  
 MURPHY  
 CHEROKEE COUNTY  
 NORTH CAROLINA

DATE: 04/24/13  
 SURVEYED BY: DST/EGT  
 DRAWN BY: DST/EGT  
 REVIEWED BY: DST/EGT  
 PROJECT: TLS-12-021  
 FILE: UTM-C-CONTRERAS\_92766\_TLS\_AB\_F  
 SCALE: AS SHOWN

SHEET  
**9 of 14**

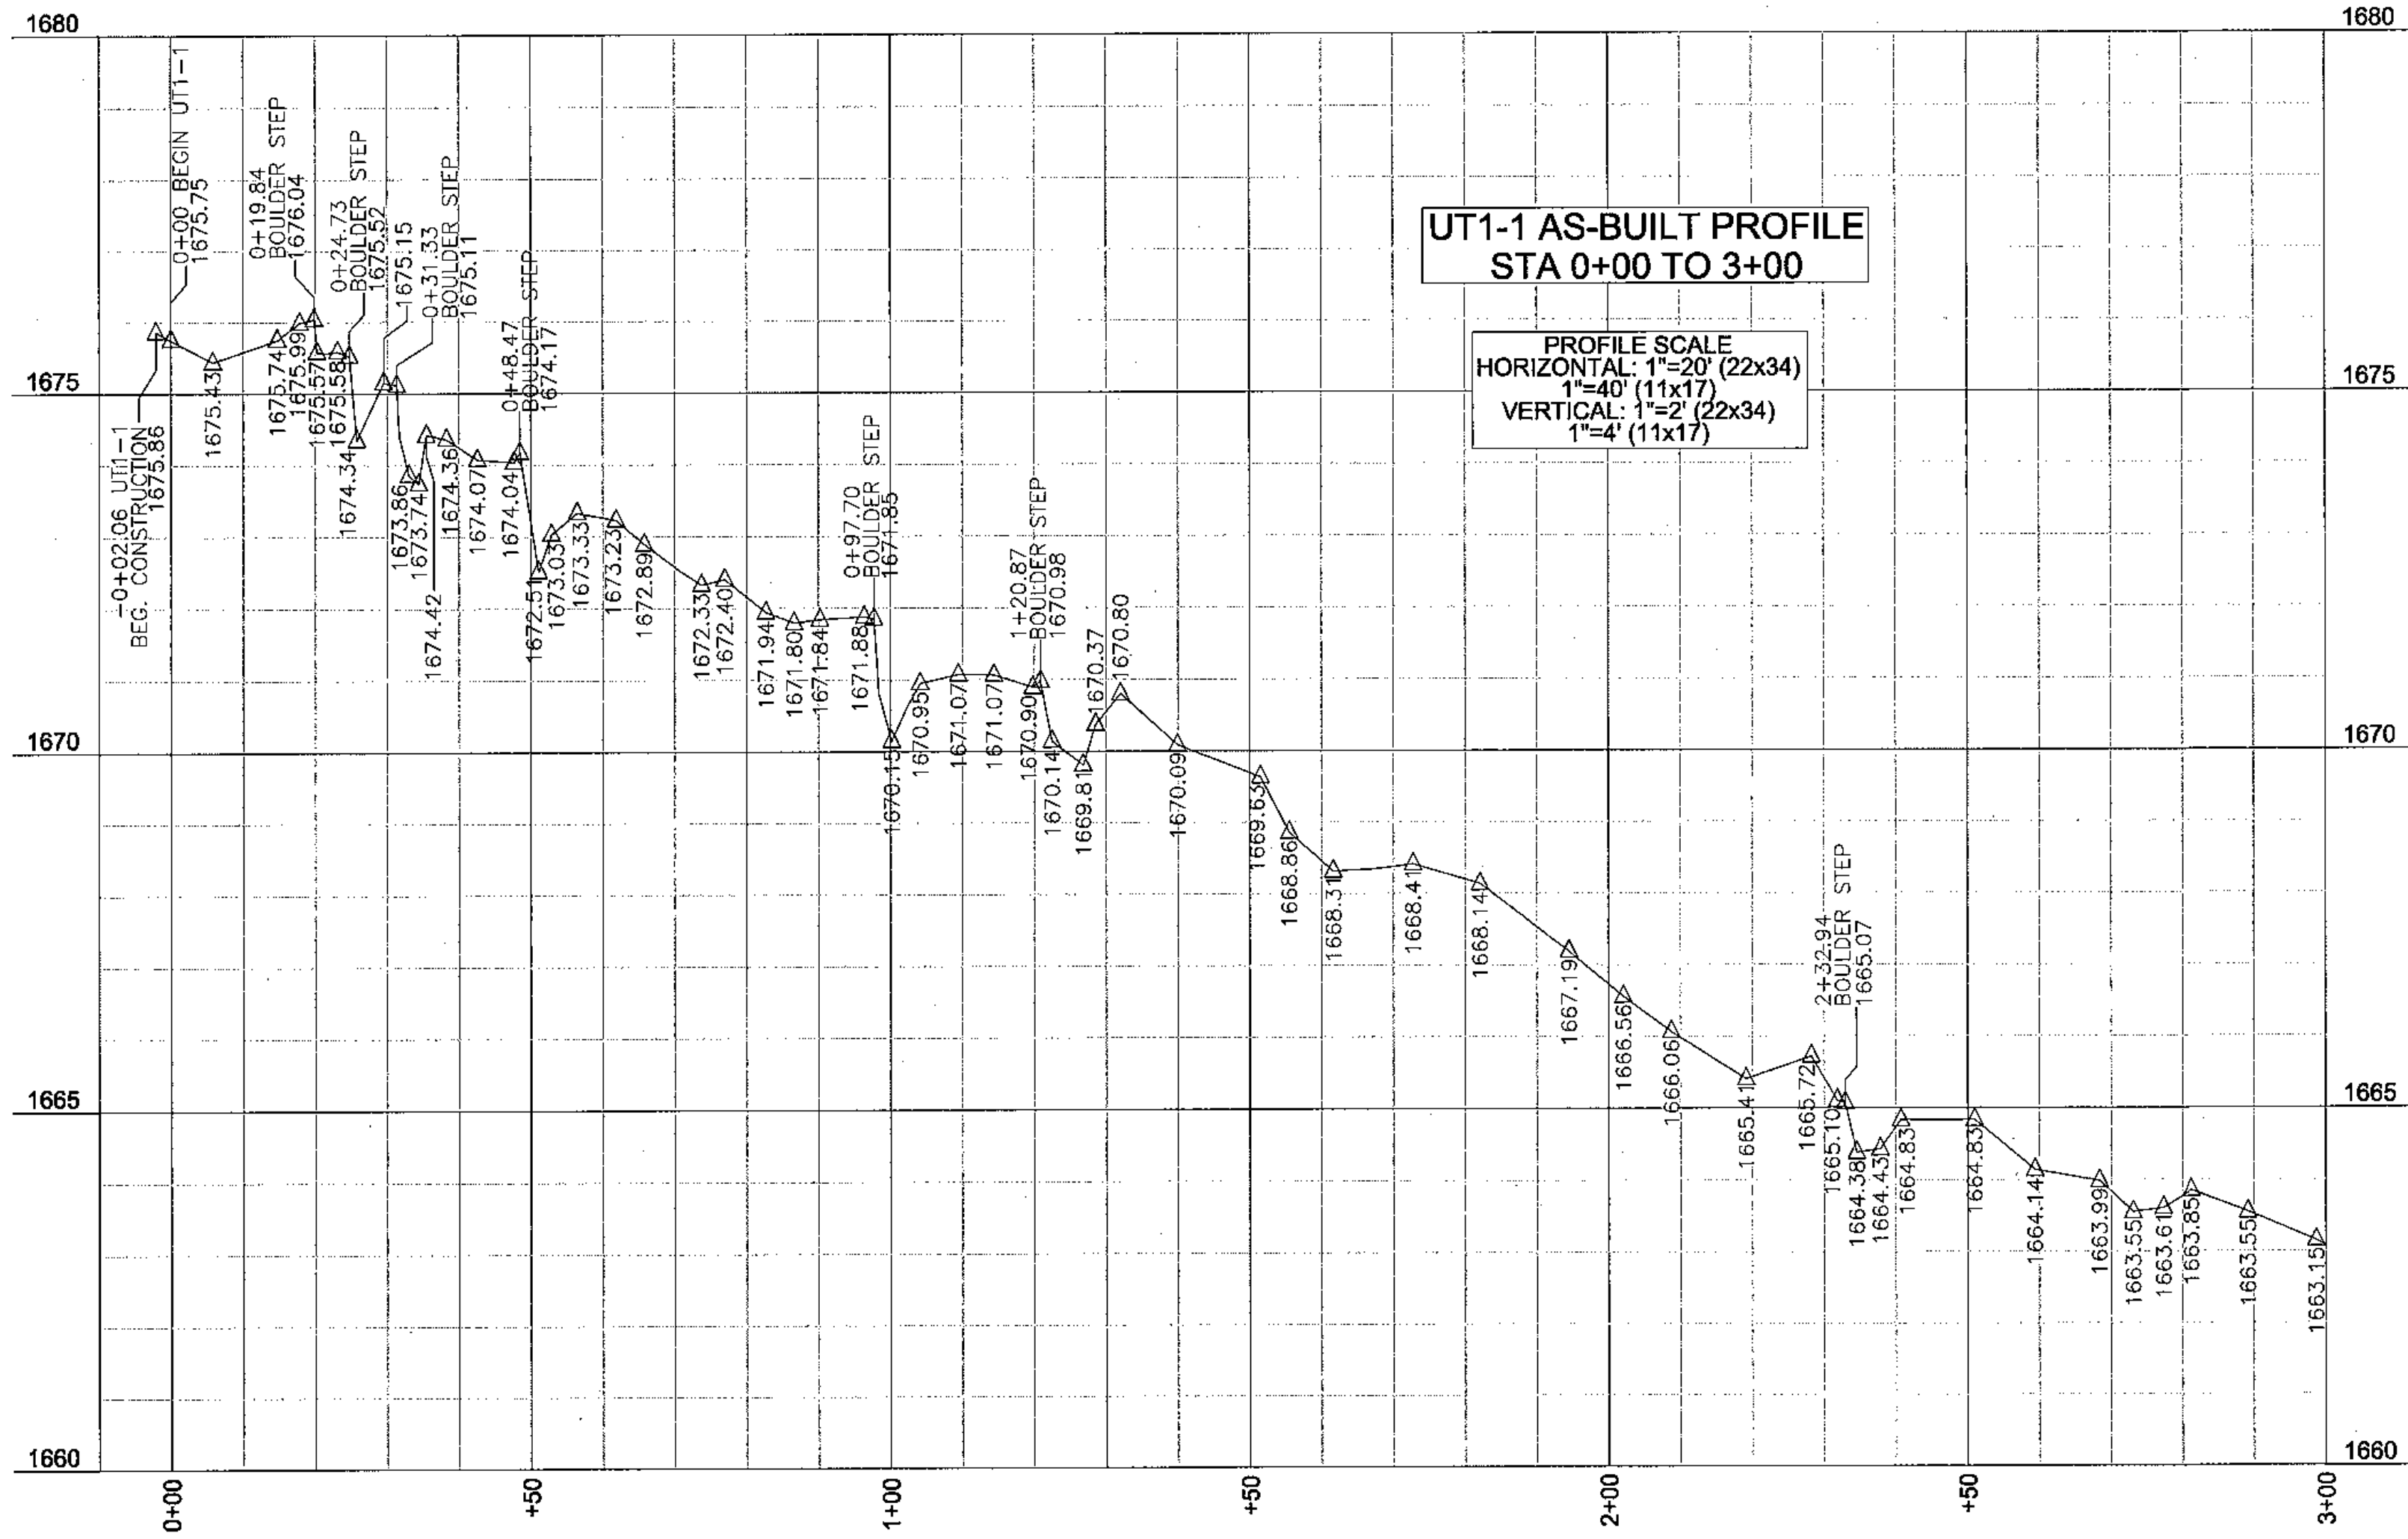

**NOTES:**  
1. SEE SHEET 1 FOR ALL NOTES.

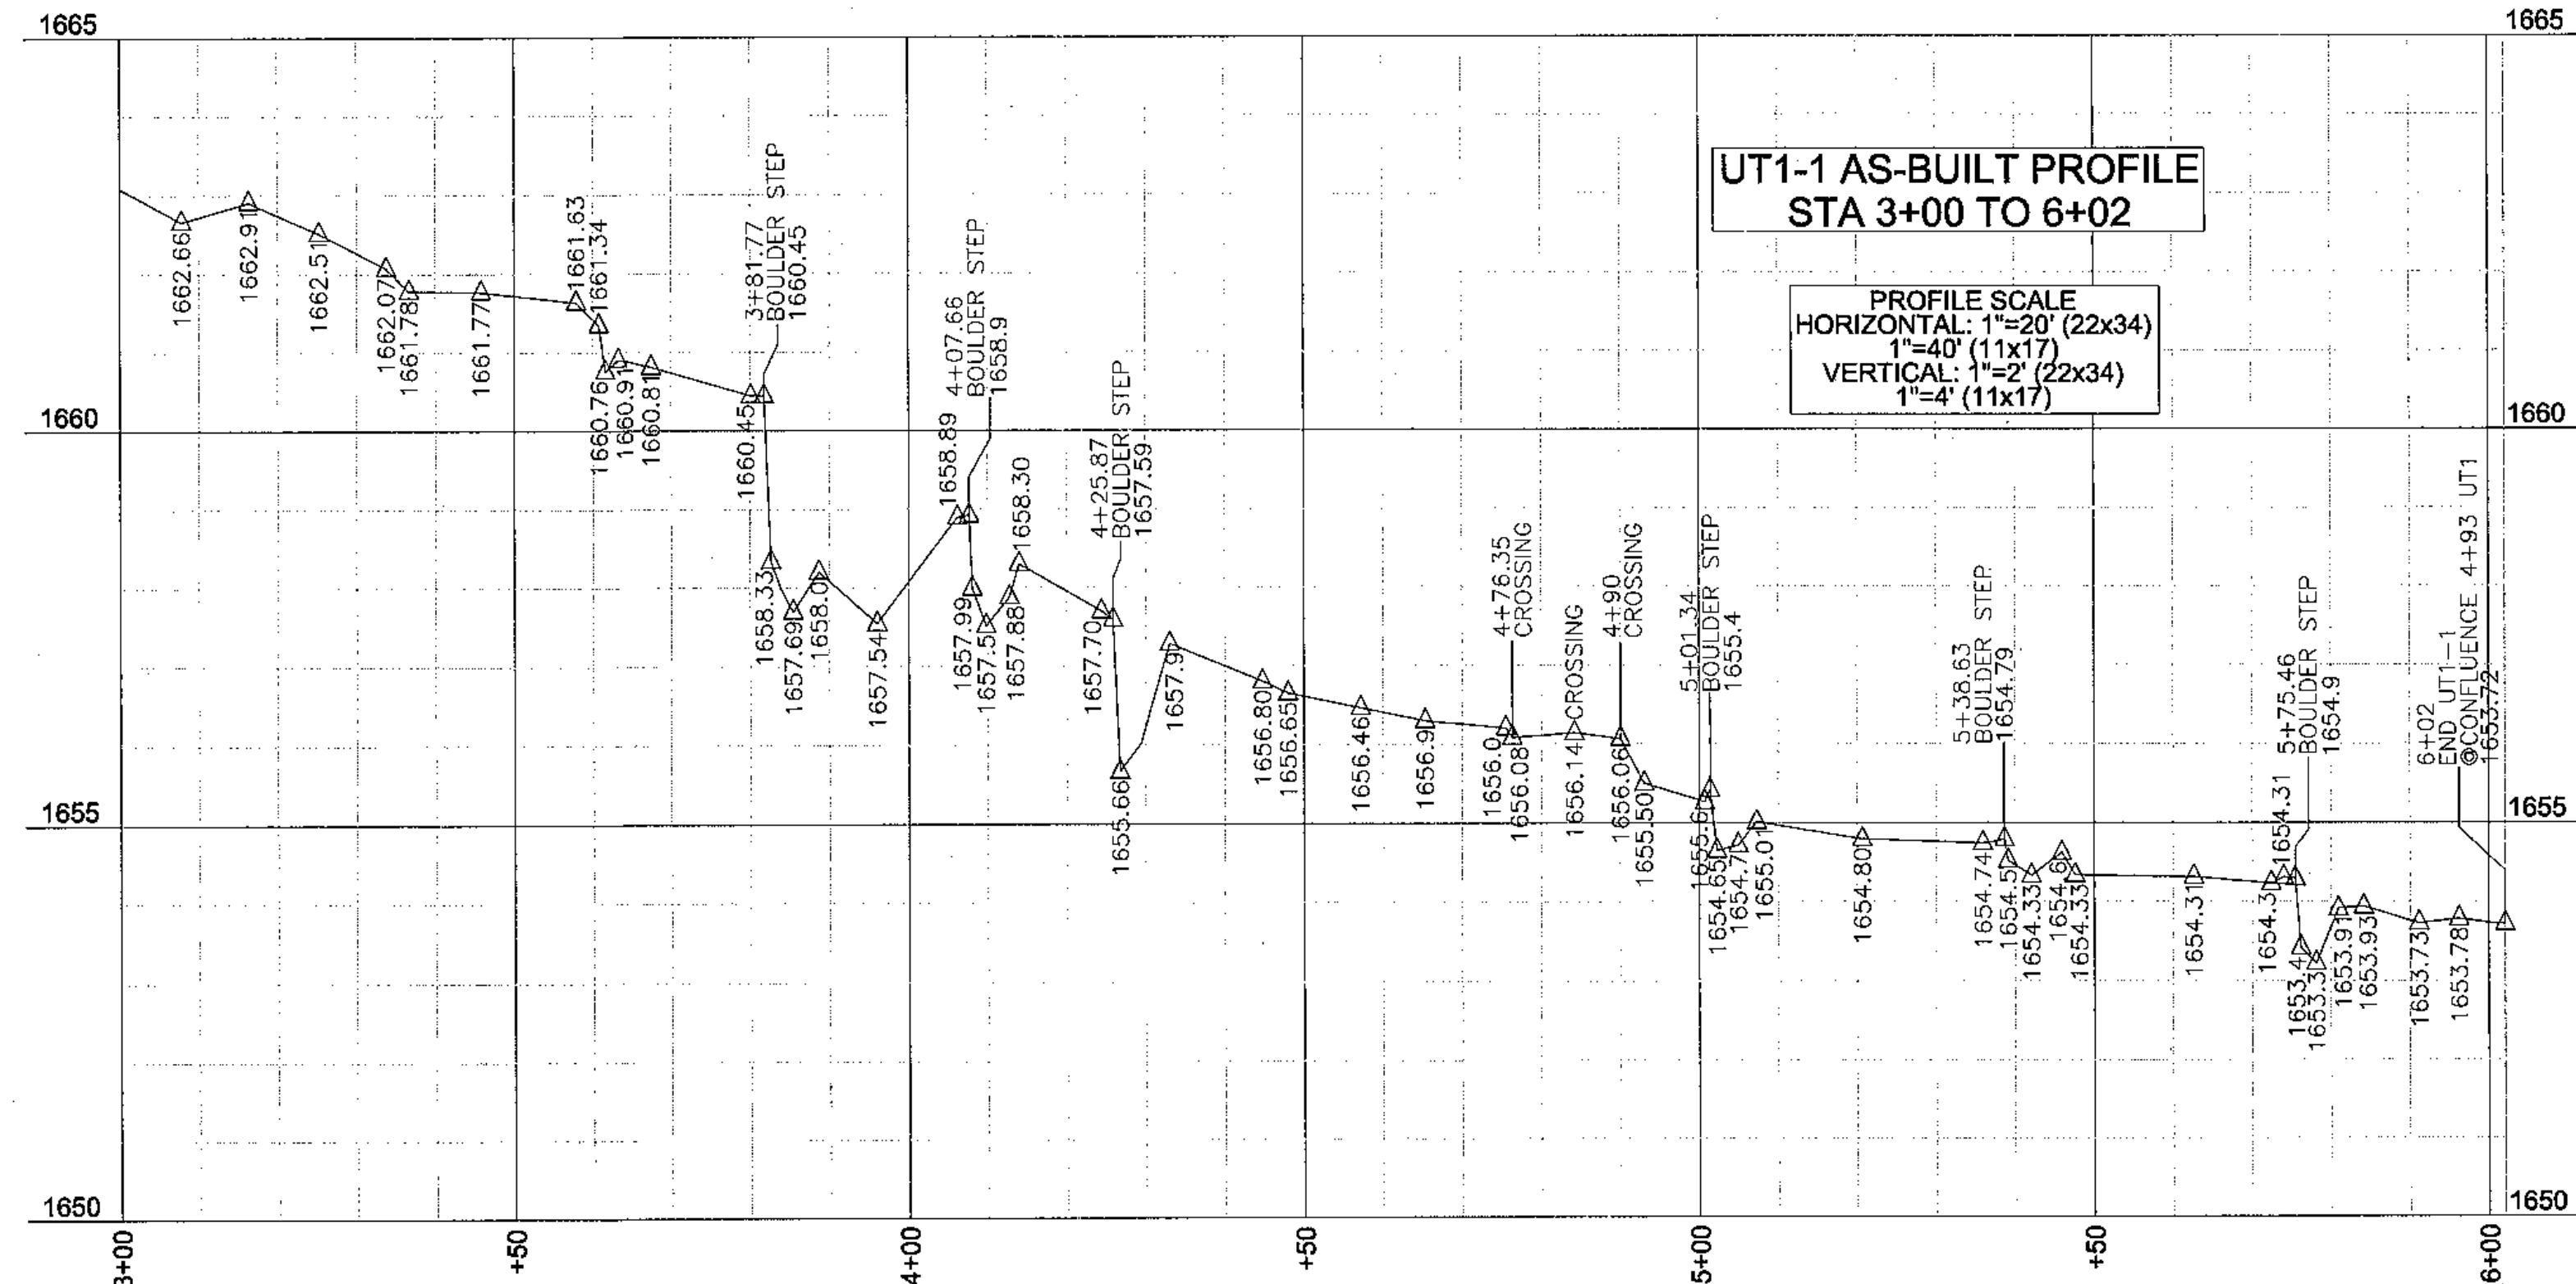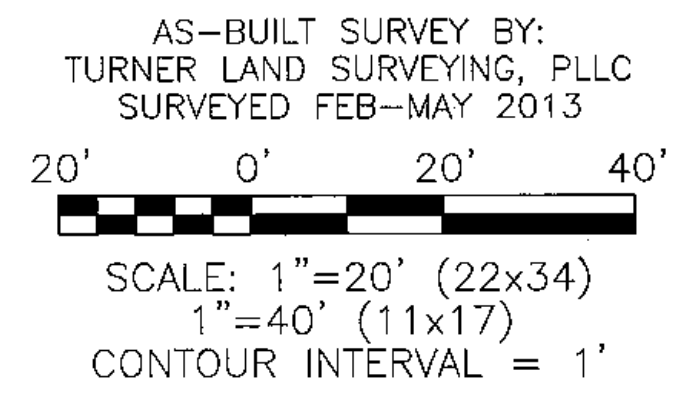

I, ELISABETH G. TURNER, AS A DULY REGISTERED PROFESSIONAL LAND SURVEYOR IN THE STATE OF NORTH CAROLINA, HEREBY CERTIFY THAT THE DATA SHOWN ON THIS DRAWING, WAS OBTAINED UNDER MY SUPERVISION, IS AN ACCURATE AND COMPLETE REPRESENTATION OF WHAT WAS CONSTRUCTED IN THE FIELD, AND THAT THE PHYSICAL DIMENSIONS OR ELEVATIONS SHOWN THUS ARE AS-BUILT CONDITIONS EXCEPT WHERE OTHERWISE NOTED HEREON. WITNESS MY ORIGINAL SIGNATURE, REGISTRATION NUMBER, AND SEAL THIS 2nd DAY OF AUGUST, 2013.

*Elisabeth G. Turner*  
ELISABETH G. TURNER, P.L.S. #L-4440

SEAL  
L-4440  
NORTH CAROLINA  
PROFESSIONAL  
LAND SURVEYOR  
ELISABETH G. TURNER

REVISIONS, DATE, AND INITIAL:

**TURNER LAND SURVEYING, PLLC**  
3201 Glenridge Drive, Raleigh, NC 27604 -- (919)875-1378  
P-0702 -- Lturner@tlls.net -- Dturner19@tlls.net  
www.TURNERLANDSURVEYING.com

**UT1-1 STA 0+00 TO 6+02 PROFILE**

AS-BUILT SURVEY OF  
**UT TO MARTINS CREEK (CONTRERAS)**  
MITIGATION PROJECT

MURPHY  
CHEROKEE COUNTY  
NORTH CAROLINA

DATE: 04/24/13  
SURVEYED BY: DST/EGT  
DRAWN BY: DST/EGT  
REVIEWED BY: DST/EGT  
PROJECT: TLS-12-021  
FILE: UTM-CONTRERAS\_92766\_TLS\_AB\_F  
SCALE: AS SHOWN



SHEET  
**10 of 14**

I, ELISABETH G. TURNER, AS A DULY REGISTERED PROFESSIONAL LAND SURVEYOR IN THE STATE OF NORTH CAROLINA, HEREBY CERTIFY THAT THE DATA SHOWN ON THIS DRAWING, WAS OBTAINED UNDER MY SUPERVISION, IS AN ACCURATE AND COMPLETE REPRESENTATION OF WHAT WAS CONSTRUCTED IN THE FIELD, AND THAT THE PHYSICAL DIMENSIONS OR ELEVATIONS SHOWN THUS ARE AS-BUILT CONDITIONS EXCEPT WHERE OTHERWISE NOTED HEREON. WITNESS MY ORIGINAL SIGNATURE, REGISTRATION NUMBER, AND SEAL THIS 2nd DAY OF AUGUST, 2013.

*Elisabeth G. Turner*  
 ELISABETH G. TURNER, P.L.S. #L-4440  
 NORTH CAROLINA PROFESSIONAL LAND SURVEYOR  
 SEAL L-4440  
 ELISABETH G. TURNER

NOTES:  
 1. SEE SHEET 1 FOR ALL NOTES.

LEGEND:	
--- THALWEG	CONSTRUCTED RIFFLE
- - - EX. THALWEG	STREAM CROSSING
--- TOP OF BANK	VERNAL POOL
--- BANK TOE	CONTROL PT./ BENCHMARK
- - - AS-BUILT LOD	TRANSPLANT
--- CE CONSERVATION EASEMENT (BY OTHERS)	EX. TREE
--- POWER EASEMENT	LOG VANE
--- OW OVERHEAD WIRE	BOULDER STEP
	J-HOOK
	LOG SILL
	ROOTWAD
	STRUCTURE ELEV. AT BANK TIE IN
	GEOLIFT
	TOE WOOD
	COVER LOGS
	LUNKER BUNKER

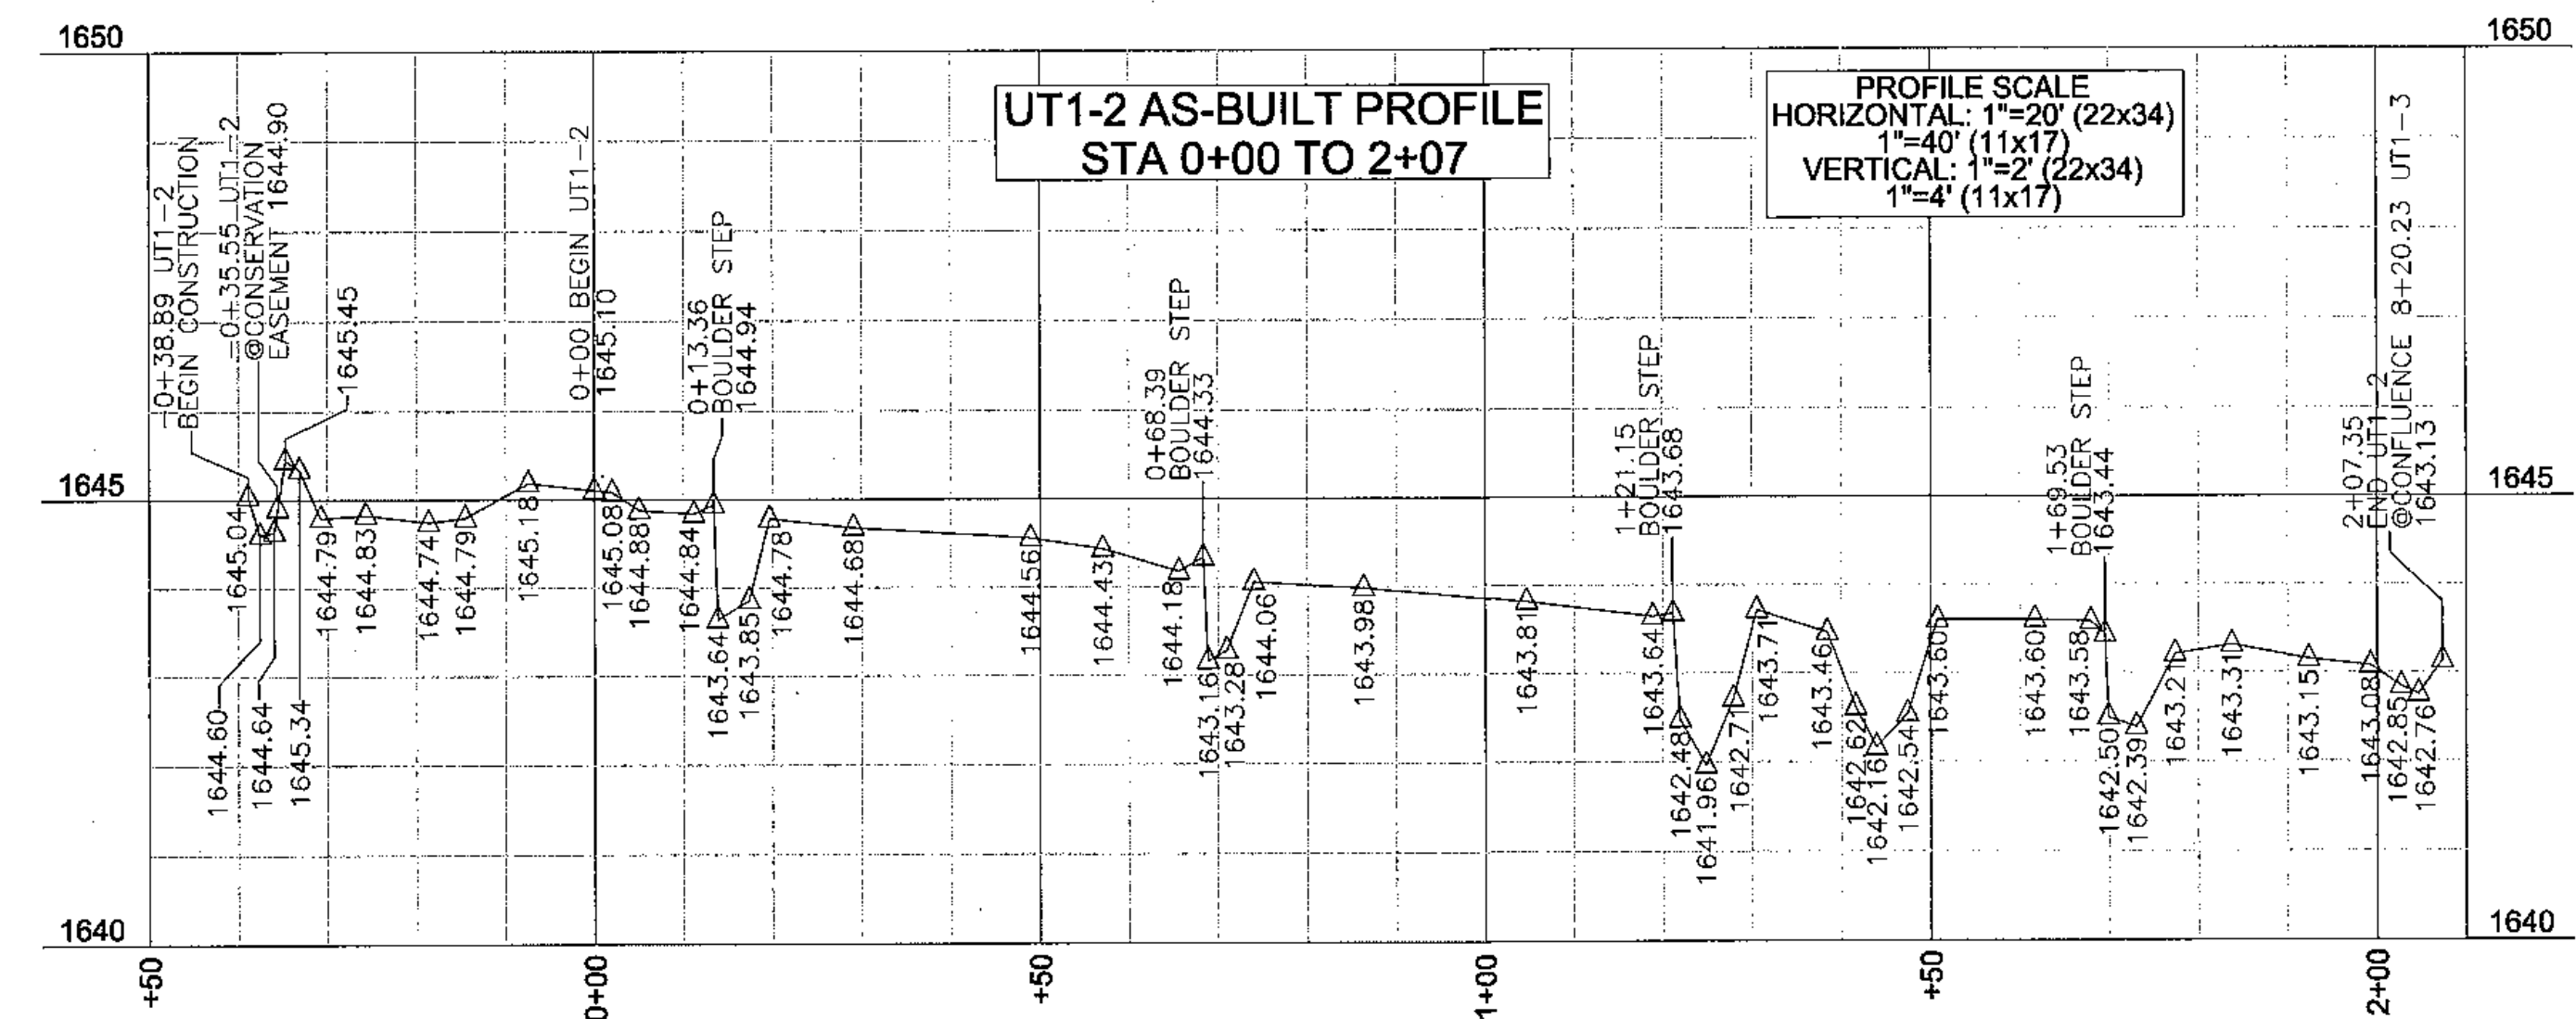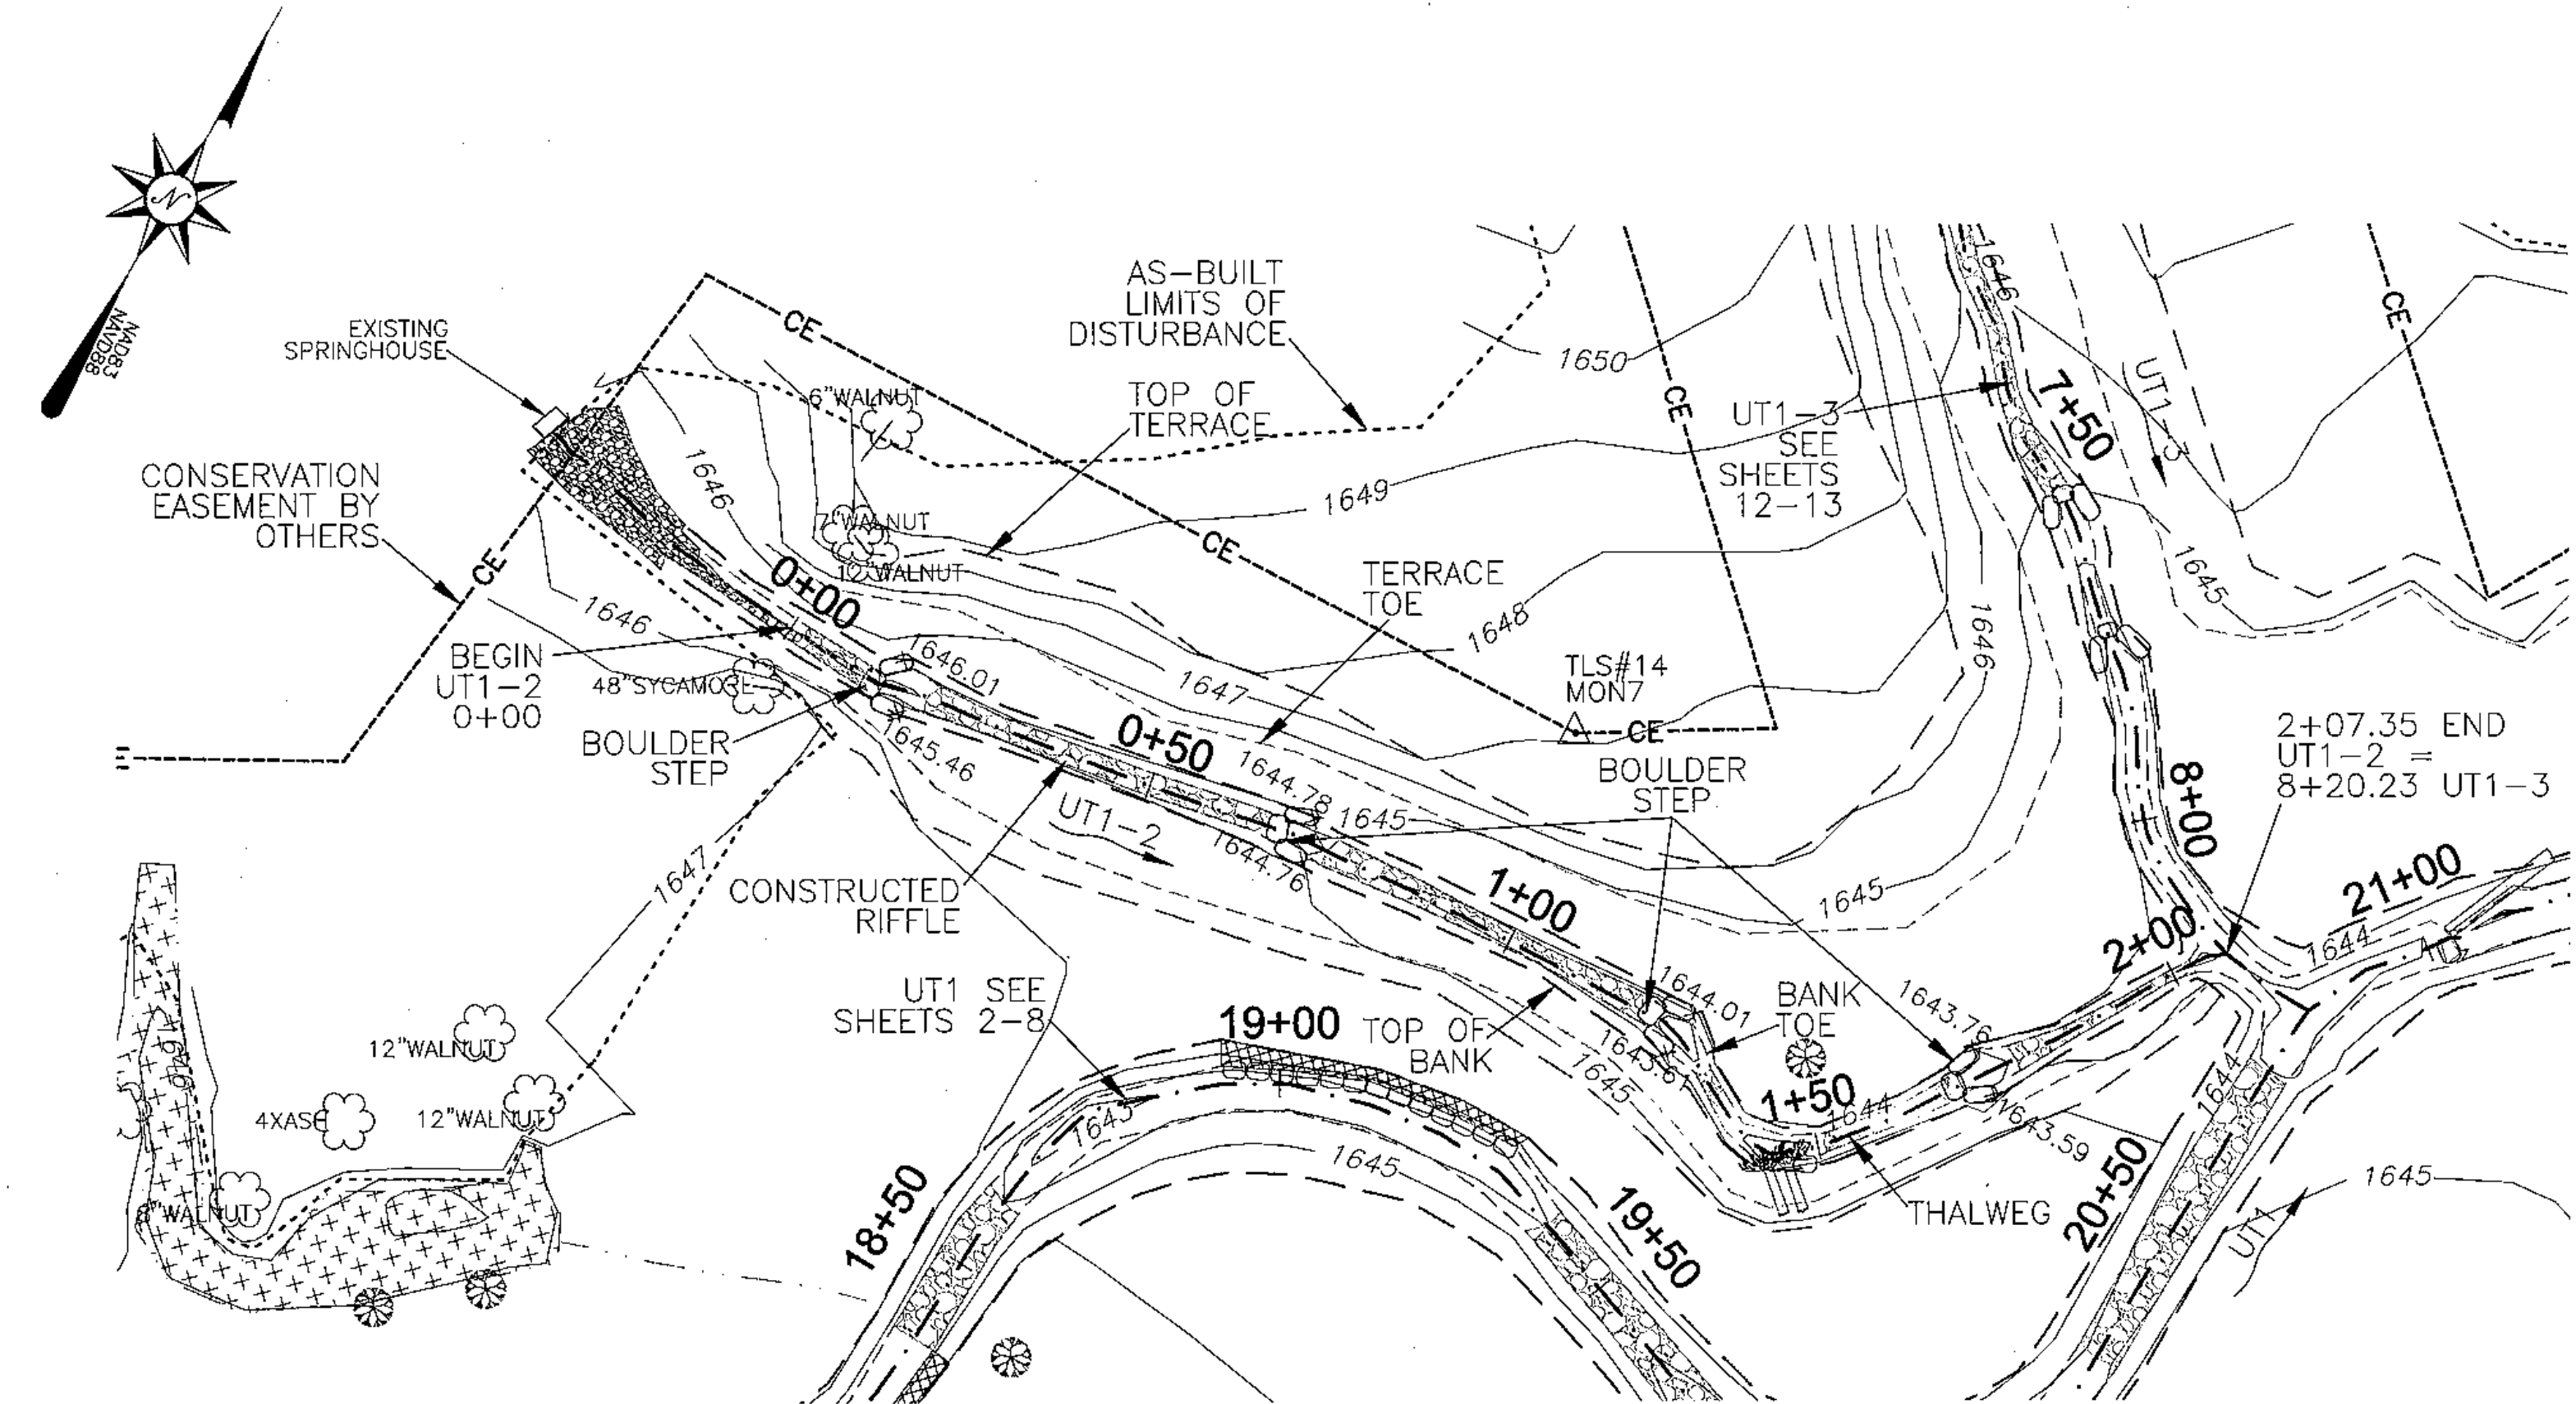

AS-BUILT SURVEY BY:  
 TURNER LAND SURVEYING, PLLC  
 SURVEYED FEB-MAY 2013  
 20' 0' 20' 40'  
 SCALE: 1"=20' (22x34)  
 1"=40' (11x17)  
 CONTOUR INTERVAL = 1'

REVISIONS, DATE, AND INITIAL:

TURNER LAND SURVEYING, PLLC  
 3201 Glenridge Drive, Raleigh, NC 27604 - (919)875-1378  
 P-0702 - Lturner921@att.net - Dturner119@att.net  
 www.TURNERLANDSURVEYING.com


AS-BUILT SURVEY OF  
 UT TO MARTINS CREEK (CONTRERAS)  
 MITIGATION PROJECT

MURPHY  
 NORTH CAROLINA  
 CHEROKEE COUNTY

DATE: 04/24/13  
 SURVEYED BY: DST/EGT  
 DRAWN BY: DST/EGT  
 REVIEWED BY: DST/EGT  
 PROJECT: TLS-12-021  
 FILE: UTM-CONTRERAS\_92766\_TLS\_AB\_F  
 SCALE: AS SHOWN

SHEET  
 11 of 14



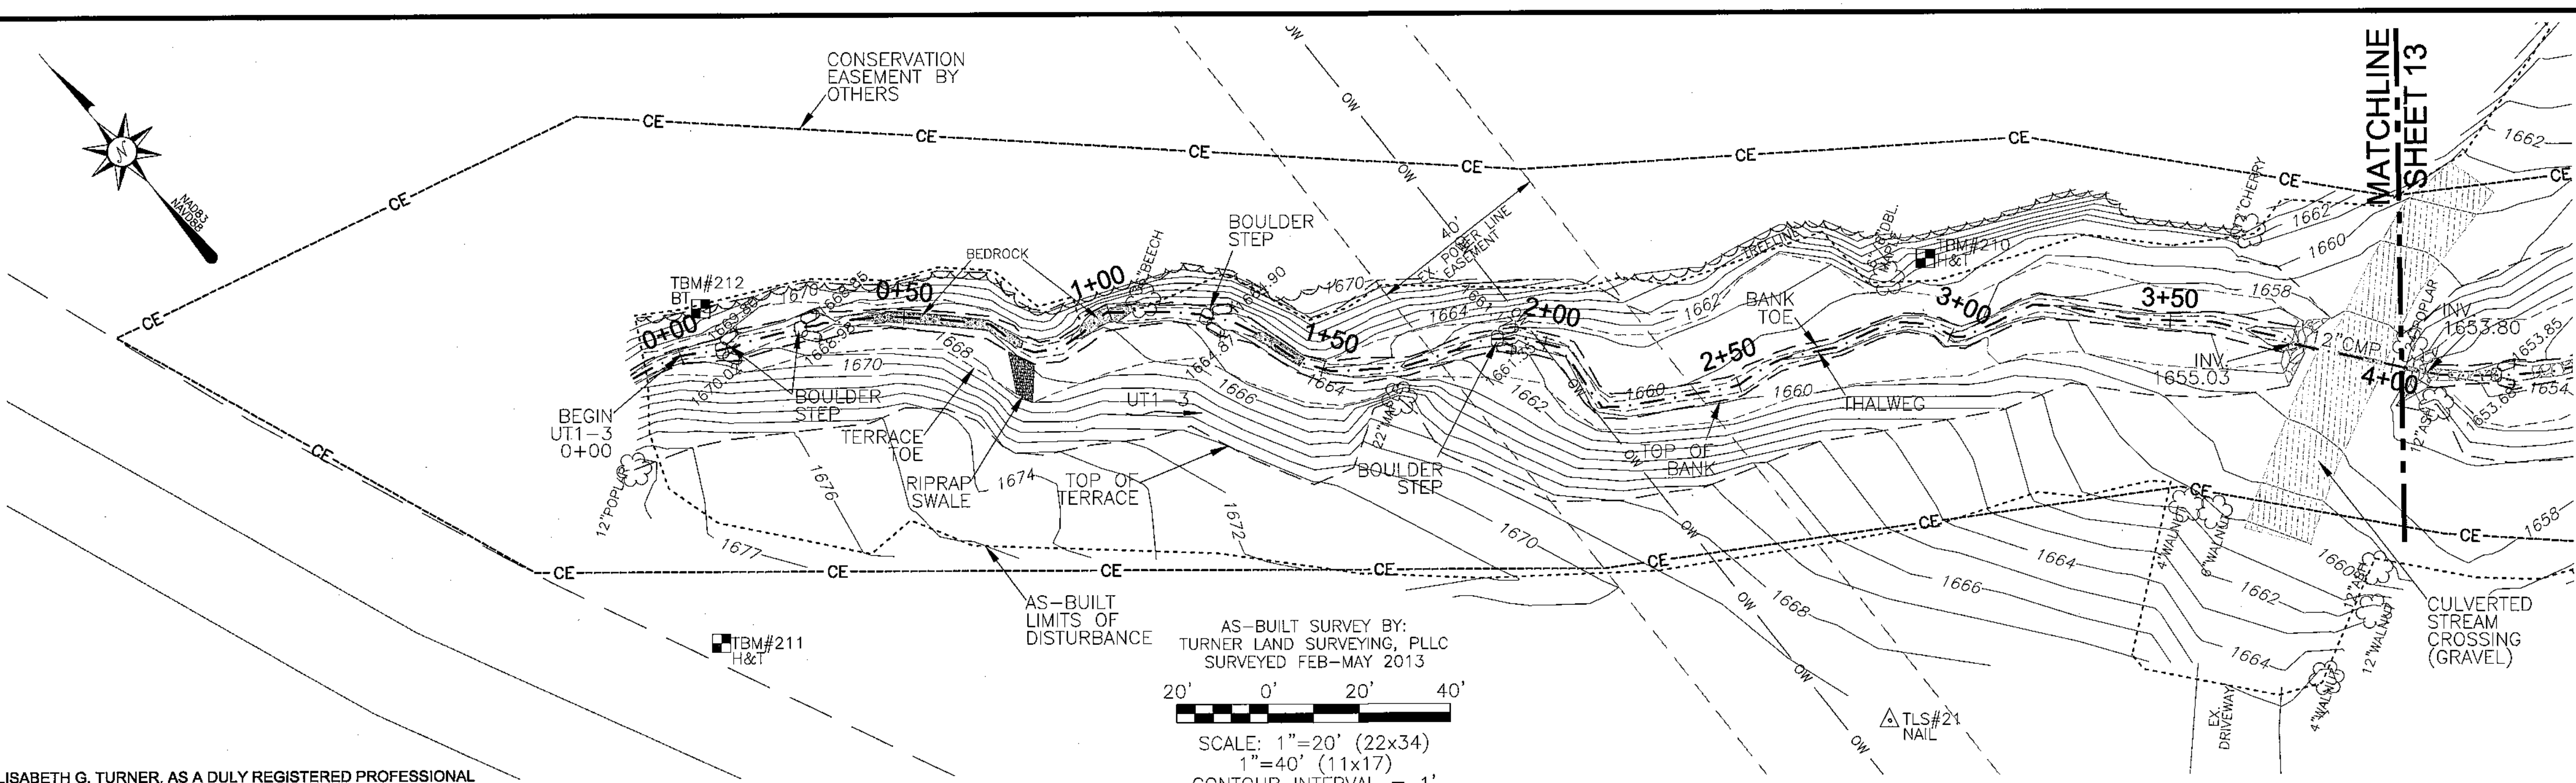


I, ELISABETH G. TURNER, AS A DULY REGISTERED PROFESSIONAL LAND SURVEYOR IN THE STATE OF NORTH CAROLINA, HEREBY CERTIFY THAT THE DATA SHOWN ON THIS DRAWING, WAS OBTAINED UNDER MY SUPERVISION, IS AN ACCURATE AND COMPLETE REPRESENTATION OF WHAT WAS CONSTRUCTED IN THE FIELD, AND THAT THE PHYSICAL DIMENSIONS OR ELEVATIONS SHOWN THUS ARE AS-BUILT CONDITIONS EXCEPT WHERE OTHERWISE NOTED HEREON. WITNESS MY ORIGINAL SIGNATURE, REGISTRATION NUMBER, AND SEAL THIS 2nd DAY OF AUGUST, 2013.

*Elisabeth G. Turner*  
 ELISABETH G. TURNER, P.L.S. #L-4440  
 NORTH CAROLINA PROFESSIONAL LAND SURVEYOR SEAL L-4440  
 ELISABETH G. TURNER

NOTES:  
 1. SEE SHEET 1 FOR ALL NOTES.

LEGEND:	
--- THALWEG	CONSTRUCTED RIFFLE
- - - EX. THALWEG	STREAM CROSSING
--- TOP OF BANK	VERNAL POOL
--- BANK TOE	CONTROL PT./ BENCHMARK
--- AS-BUILT LOD	TRANSPLANT
- - - CE CONSERVATION EASEMENT (BY OTHERS)	EX. TREE
--- POWER EASEMENT	GEOLIFT
--- OW OVERHEAD WIRE	TOE WOOD
--- LOG VANE	COVER LOGS
--- BOULDER STEP	LUNKER BUNKER
--- J-HOOK	
--- LOG SILL	
--- ROOTWAD	
--- STRUCTURE ELEV. AT BANK TIE IN	

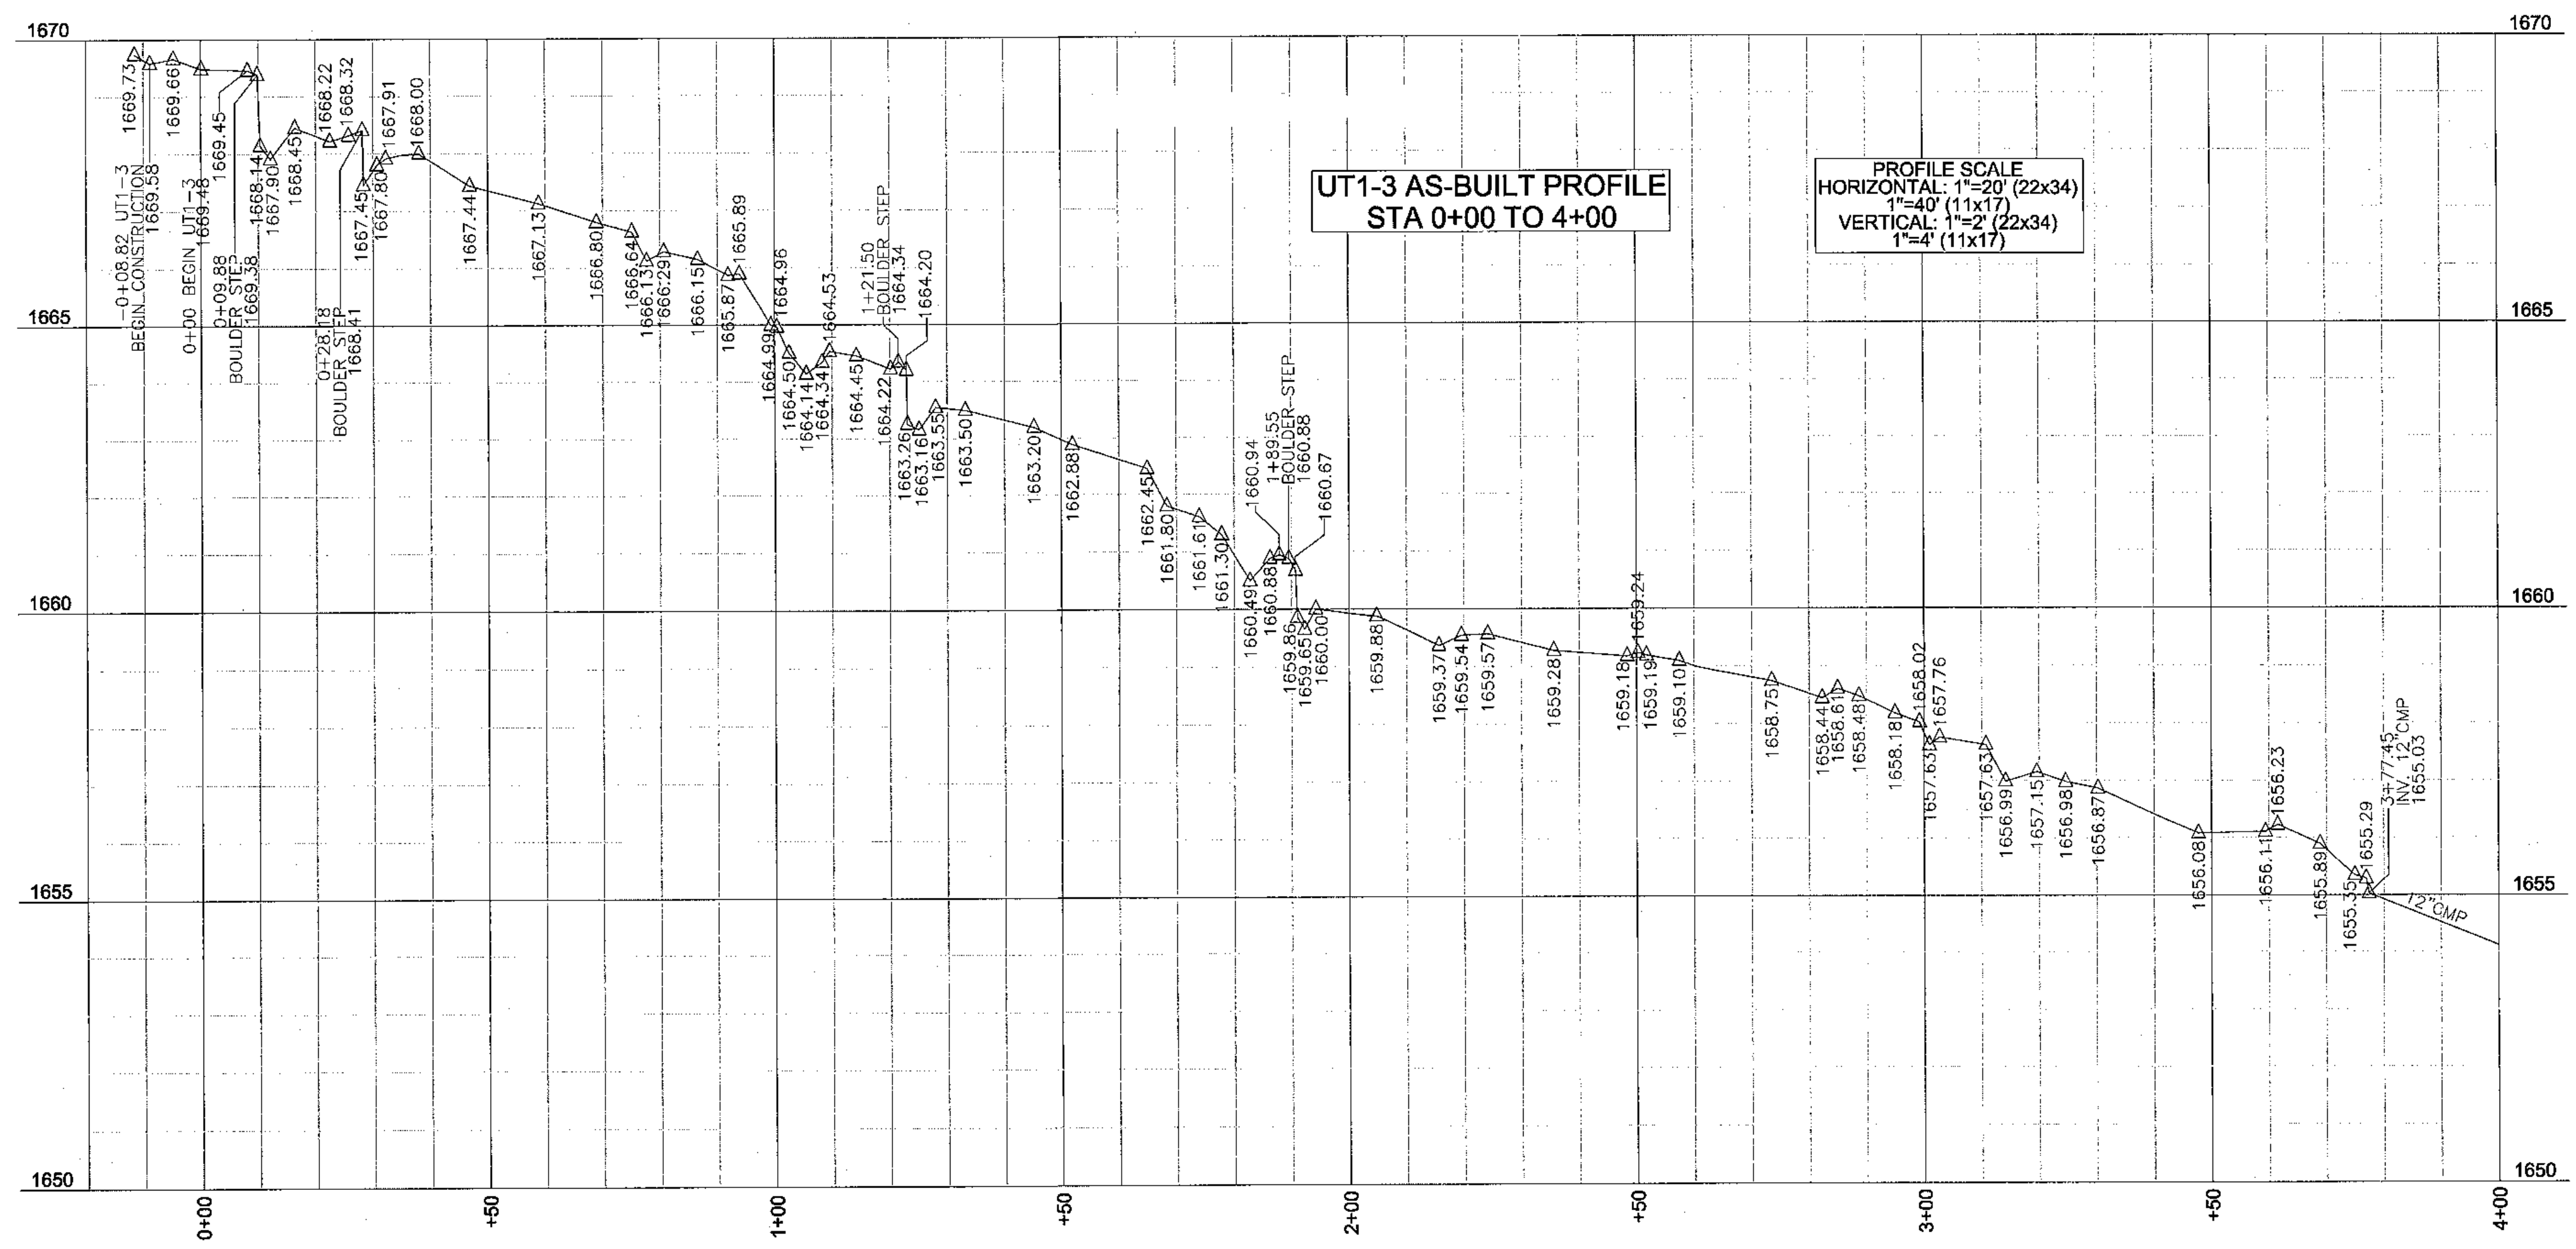

REVISIONS, DATE, AND INITIAL:

TURNER LAND SURVEYING, PLLC  
 3201 Glenridge Drive, Raleigh, NC 27604 - (919) 975-1378  
 P-0702 - Lturner921@att.net - Dturner119@att.net  
 WWW.TURNERLANDSURVEYING.COM

UT1-3 STA 0+00 TO 4+00 PLAN & PROFILE

AS-BUILT SURVEY OF  
 UT TO MARTINS CREEK (CONTRERAS)  
 MITIGATION PROJECT

NORTH CAROLINA  
 MURPHY  
 CHEROKEE COUNTY

DATE: 04/24/13  
 SURVEYED BY: DST/JGT  
 DRAWN BY: DST/JGT  
 REVIEWED BY: DST/JGT  
 PROJECT: TLS-12-021  
 FILE: UTM-CONTRERAS\_92766\_TLS\_AB\_F  
 SCALE: AS SHOWN


SHEET 12 of 14

I, ELISABETH G. TURNER, AS A DULY REGISTERED PROFESSIONAL LAND SURVEYOR IN THE STATE OF NORTH CAROLINA, HEREBY CERTIFY THAT THE DATA SHOWN ON THIS DRAWING, WAS OBTAINED UNDER MY SUPERVISION, IS AN ACCURATE AND COMPLETE REPRESENTATION OF WHAT WAS CONSTRUCTED IN THE FIELD, AND THAT THE PHYSICAL DIMENSIONS OR ELEVATIONS SHOWN THUS ARE AS-BUILT CONDITIONS EXCEPT WHERE OTHERWISE NOTED HEREON. WITNESS MY ORIGINAL SIGNATURE, REGISTRATION NUMBER, AND SEAL THIS 2nd DAY OF AUGUST, 2013.


*Elisabeth G. Turner*  
 ELISABETH G. TURNER, P.L.S. #L-4440  
 NORTH CAROLINA PROFESSIONAL LAND SURVEYOR  
 SEAL L-4440  
 ELISABETH G. TURNER

LEGEND:			
--- THALWEG	CONSTRUCTED RIFFLE	LOG VANE	GEOLIFT
- - - EX. THALWEG	STREAM CROSSING	BOULDER STEP	TOE WOOD
--- TOP OF BANK	VERNAL POOL	J-HOOK	COVER LOGS
--- BANK TOE	AS-BUILT LOD	LOG SILL	LUNKER BUNKER
--- CE CONSERVATION EASEMENT (BY OTHERS)	CONSERVATION EASEMENT (BY OTHERS)	CONTROL PT./ BENCHMARK	
--- OW OVERHEAD WIRE	TRANSPLANT	ROOTWAD	
	EX. TREE	STRUCTURE ELEV. AT BANK TIE IN	

NOTES:  
 1. SEE SHEET 1 FOR ALL NOTES.

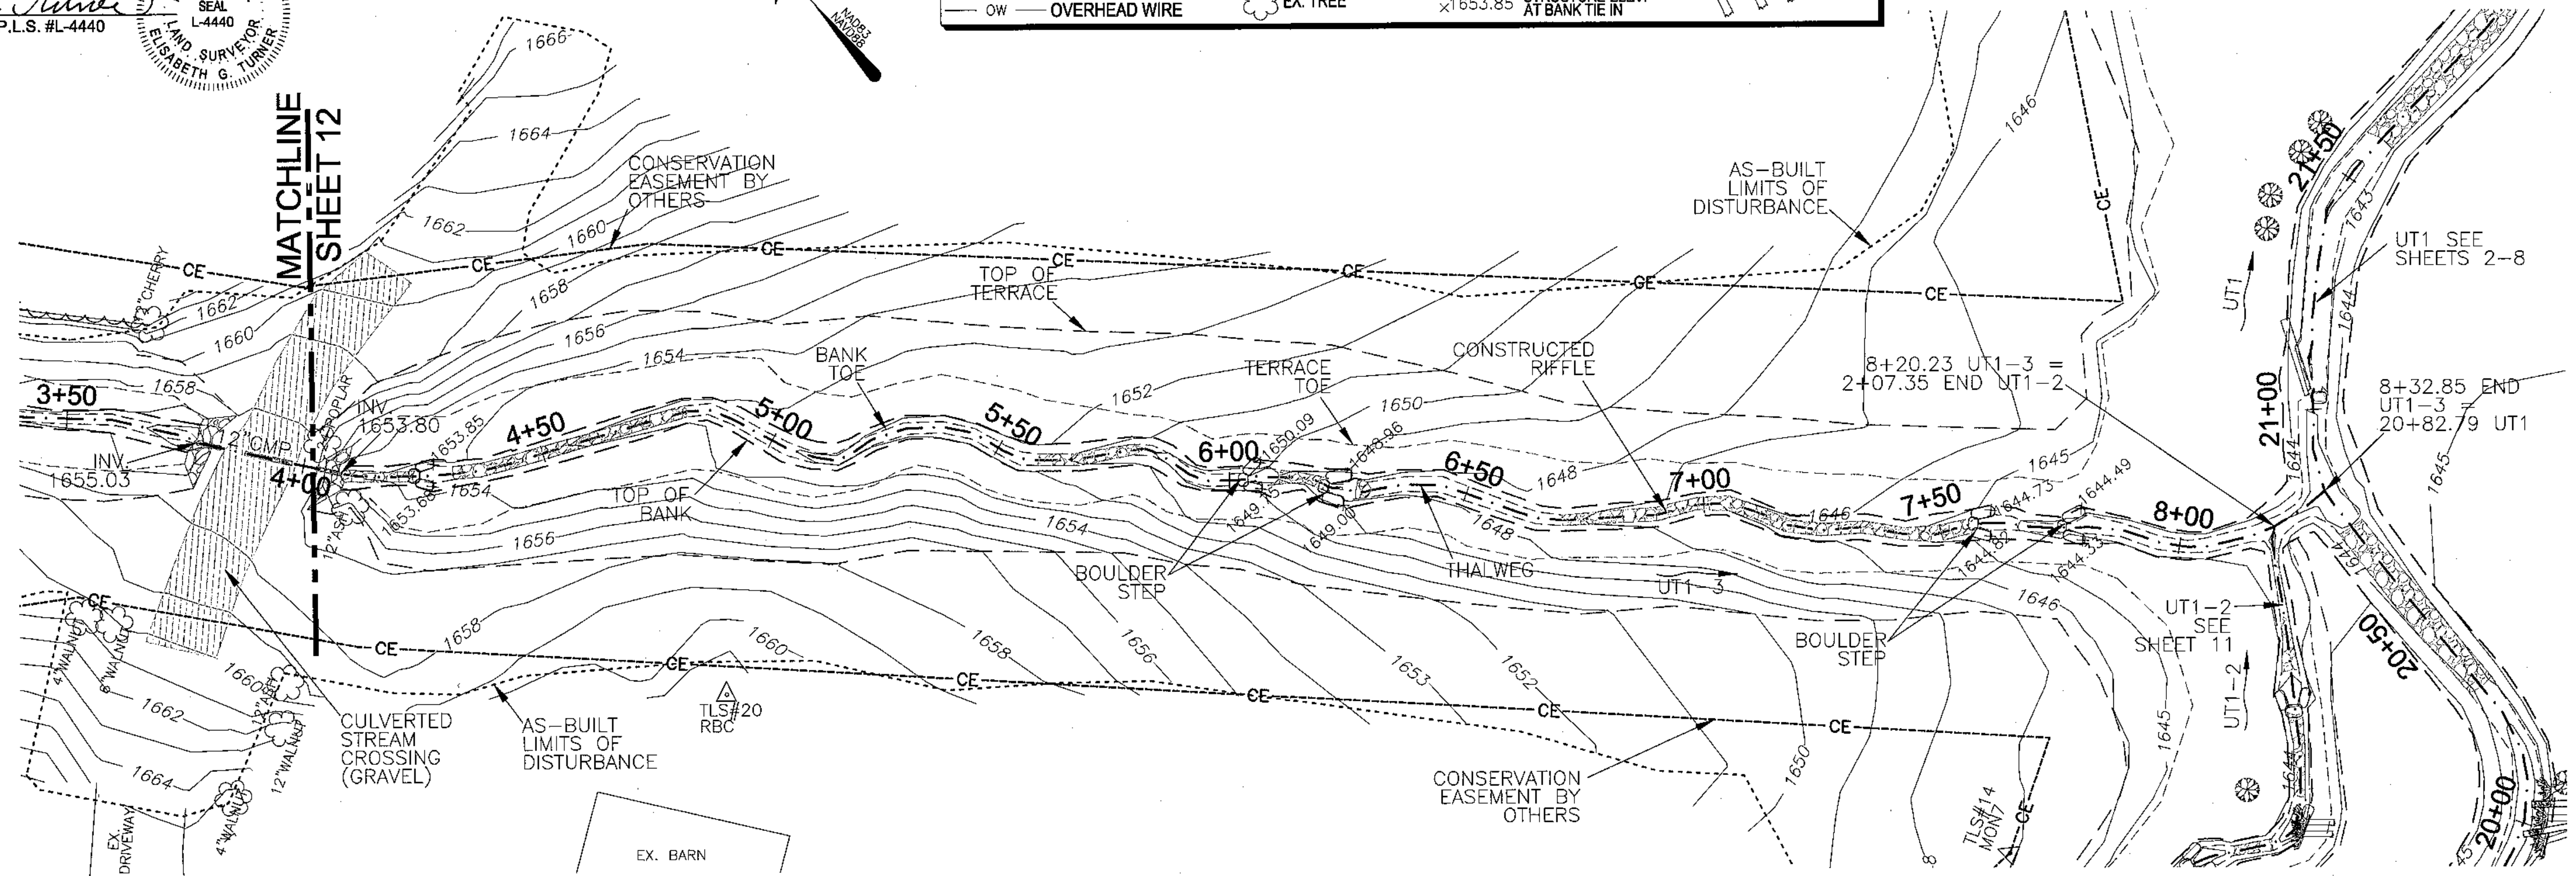

AS-BUILT SURVEY BY:  
 TURNER LAND SURVEYING, PLLC  
 SURVEYED FEB-MAY 2013  
 SCALE: 1"=20' (22x34)  
 1"=40' (11x17)  
 CONTOUR INTERVAL = 1'

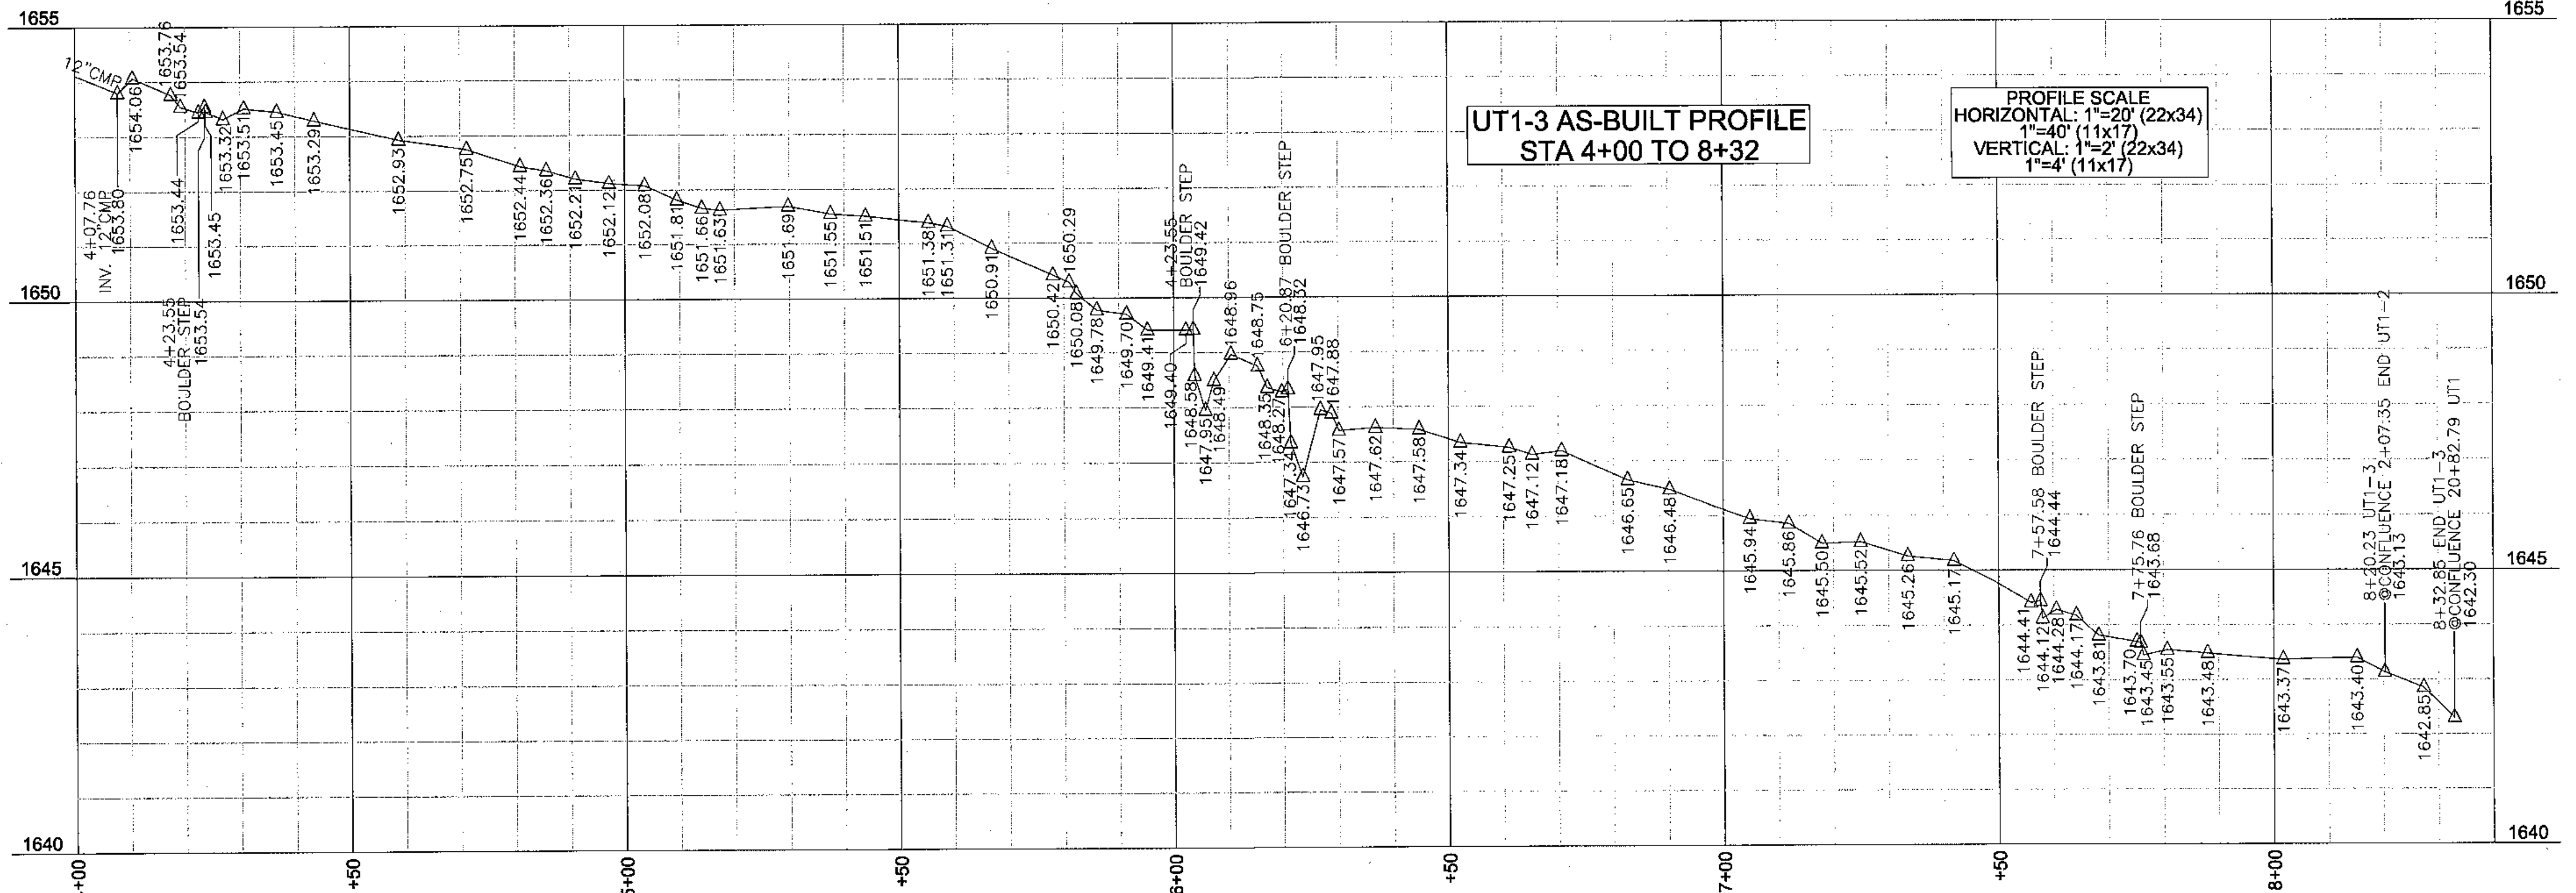

PROFILE SCALE  
 HORIZONTAL: 1"=20' (22x34)  
 1"=40' (11x17)  
 VERTICAL: 1"=2' (22x34)  
 1"=4' (11x17)

REVISIONS, DATE, AND INITIAL

TURNER LAND SURVEYING, PLLC  
 3201 Glenridge Drive, Raleigh, NC 27604 - (919) 875-1378  
 P-0702 - Lturner@tlr.net - Dturner@tlr.net  
 www.TURNERLANDSURVEYING.com

UT1-3 STA 4+00 TO 8+32 PLAN & PROFILE  
 AS-BUILT SURVEY OF  
 UT TO MARTINS CREEK (CONTRERAS)  
 MITIGATION PROJECT

CHEROKEE COUNTY  
 NORTH CAROLINA  
 MURPHY

DATE: 04/24/13  
 SURVEYED BY: DST/EGT  
 DRAWN BY: DST/EGT  
 REVIEWED BY: DST/EGT  
 PROJECT: TLS-12-021  
 FILE: UTM-CONTRERAS\_92766\_TLS\_AB\_F  
 SCALE: AS SHOWN

SHEET  
 13 of 14

I, ELISABETH G. TURNER, AS A DULY REGISTERED PROFESSIONAL LAND SURVEYOR IN THE STATE OF NORTH CAROLINA, HEREBY CERTIFY THAT THE DATA SHOWN ON THIS DRAWING, WAS OBTAINED UNDER MY SUPERVISION, IS AN ACCURATE AND COMPLETE REPRESENTATION OF WHAT WAS CONSTRUCTED IN THE FIELD, AND THAT THE PHYSICAL DIMENSIONS OR ELEVATIONS SHOWN THUS ARE AS-BUILT CONDITIONS EXCEPT WHERE OTHERWISE NOTED HEREON. WITNESS MY ORIGINAL SIGNATURE, REGISTRATION NUMBER, AND SEAL THIS 2nd DAY OF AUGUST, 2013.


*Elisabeth G. Turner*  
 ELISABETH G. TURNER, P.L.S. #L-4440  
 NORTH CAROLINA PROFESSIONAL LAND SURVEYOR  
 SEAL L-4440  
 ELISABETH G. TURNER

NOTES:  
 1. SEE SHEET 1 FOR ALL NOTES.

LEGEND:  
 - - - THALWEG  
 - - - TOP OF BANK  
 - - - AS-BUILT LOD  
 - - - CE CONSERVATION EASEMENT (BY OTHERS)  
 - - - POWER EASEMENT  
 - - - OW OVERHEAD WIRE  
 △ CONTROL PT./ BENCHMARK  
 ▣ STREAM CROSSING



AS-BUILT SURVEY BY:  
 TURNER LAND SURVEYING, PLLC  
 SURVEYED FEB-MAY 2013  
 40' 0' 40' 80'  
 SCALE: 1"=40' (22x34)  
 1"=80' (11x17)  
 CONTOUR INTERVAL = 1'

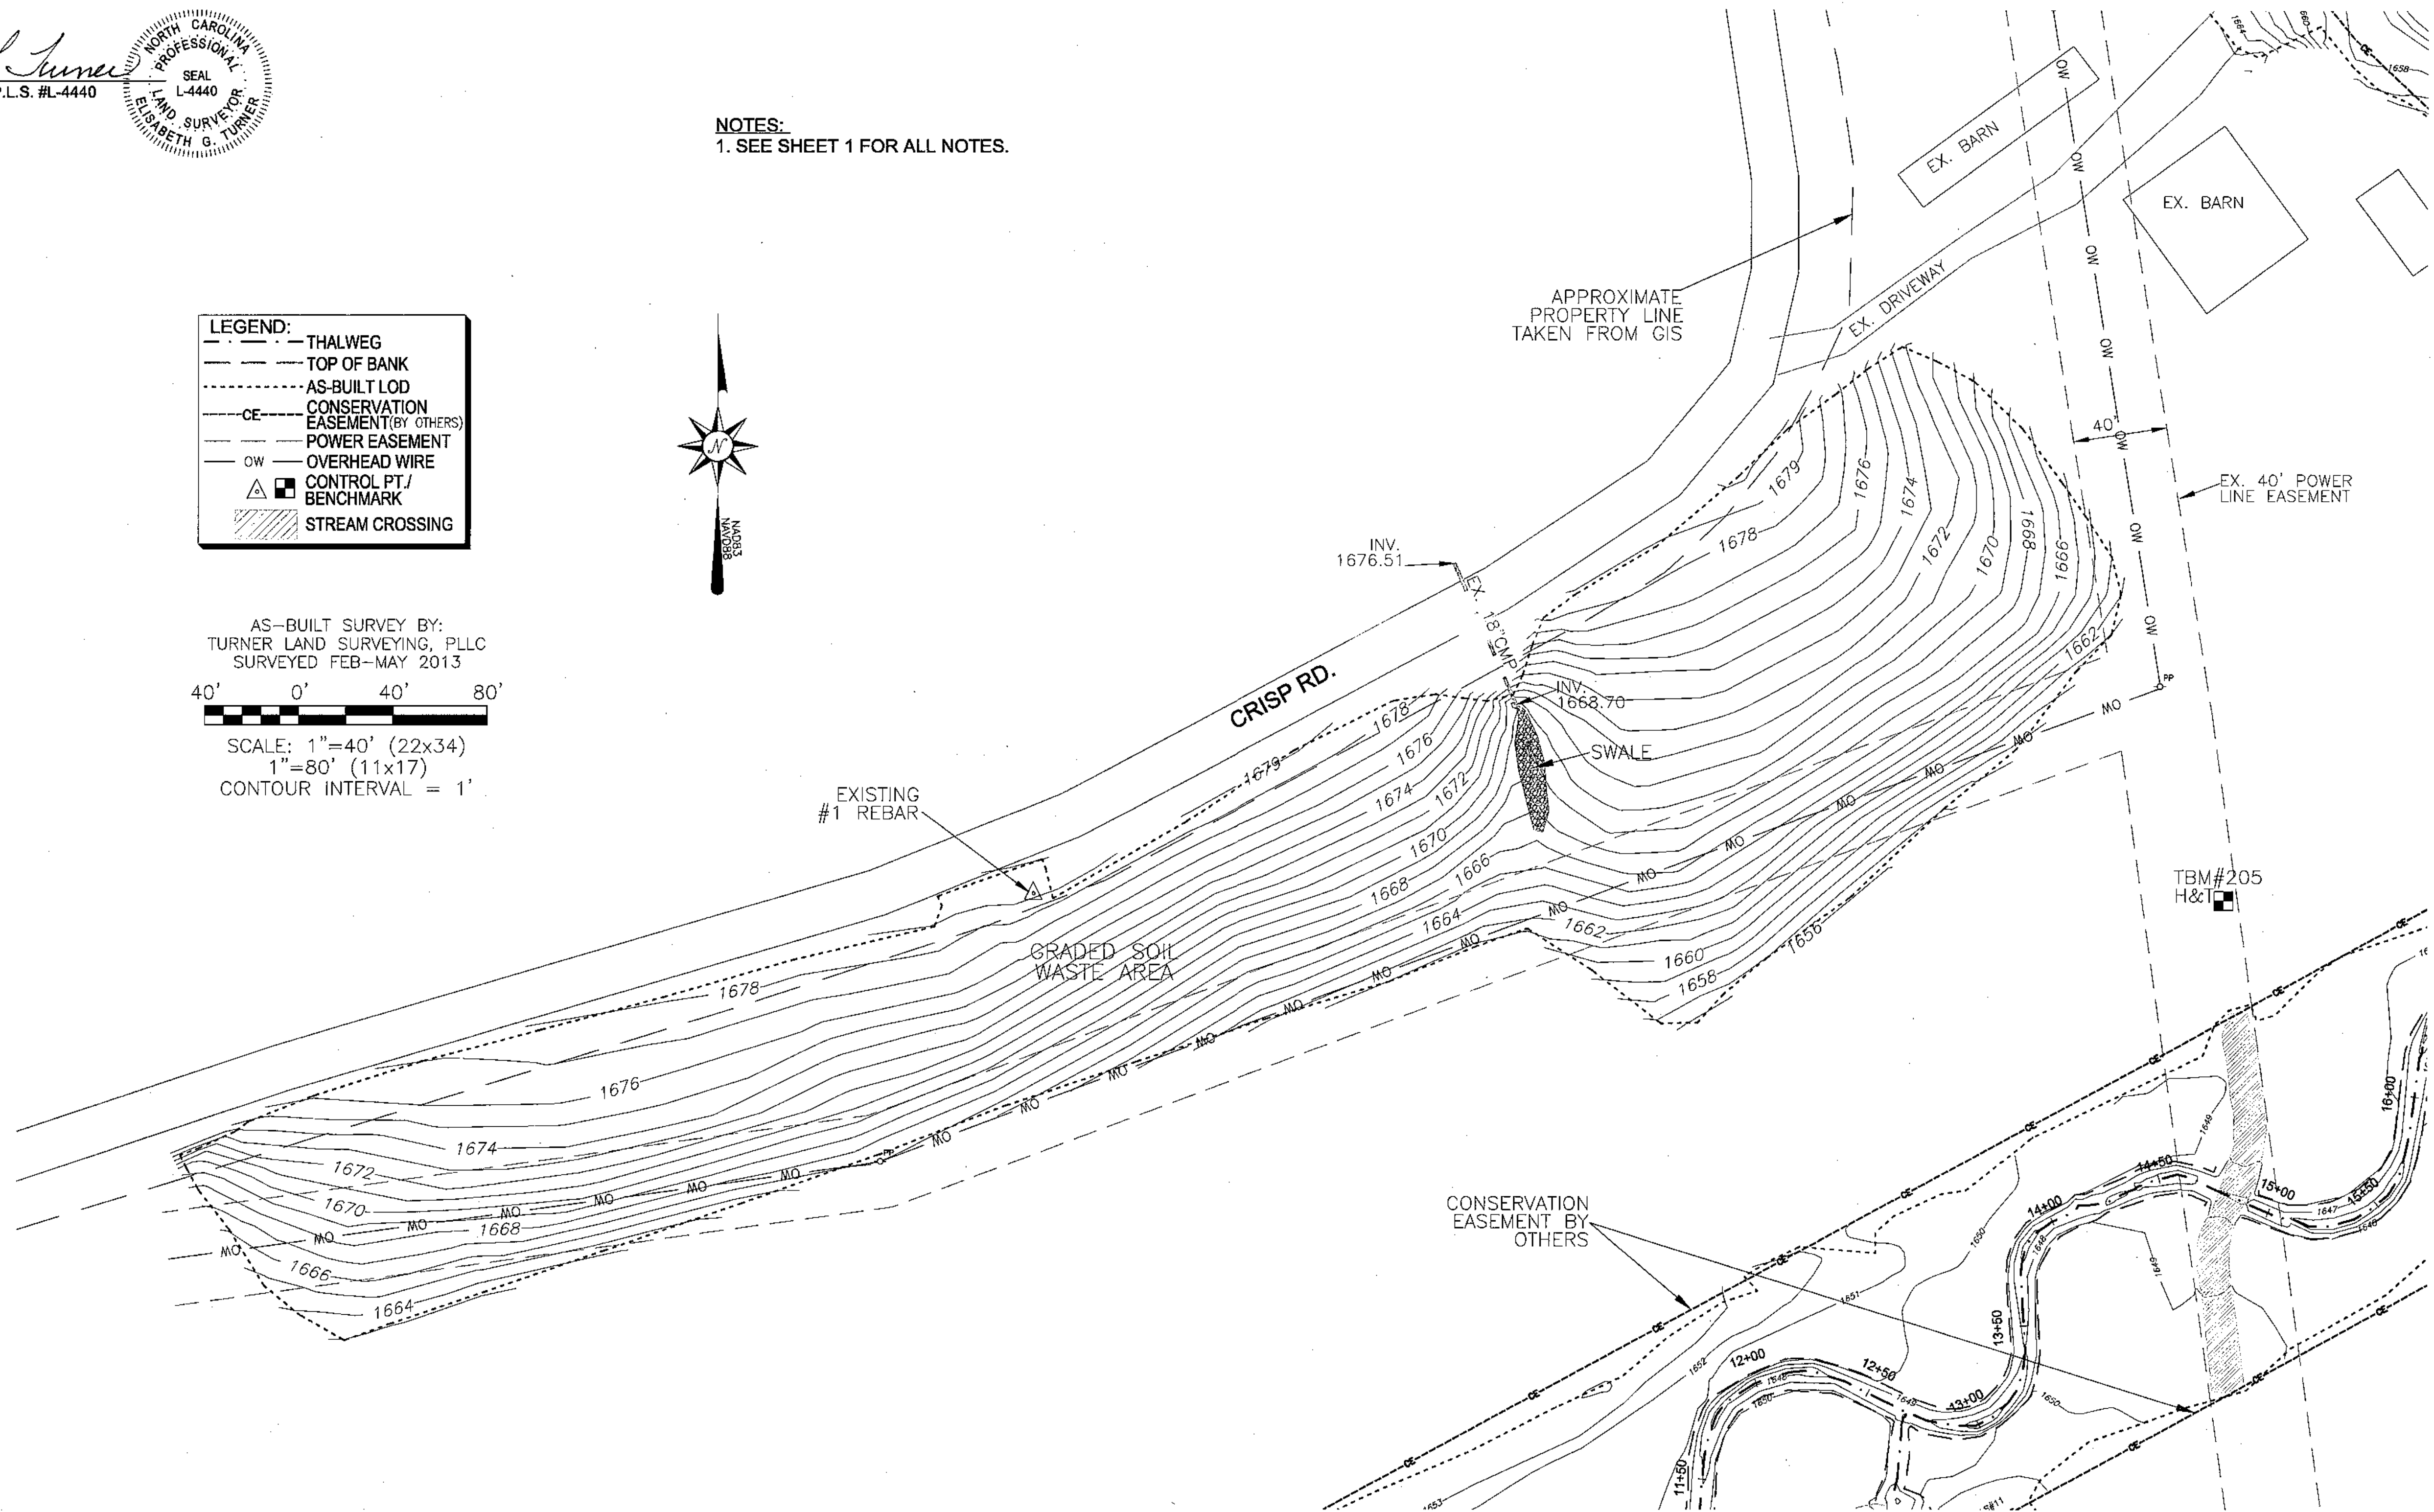

REVISIONS, DATE, AND INITIAL:  
 TURNER LAND SURVEYING, PLLC  
 3201 Glenridge Drive Raleigh, NC 27604 - (919)875-1378  
 P-0702 - Lturner@atl.net - Dturner1@atl.net  
 www.TURNERLANDSURVEYING.com

GRADED SOIL WASTE AREA  
 AS-BUILT SURVEY OF  
 UT TO MARTINS CREEK (CONTRERAS)  
 MITIGATION PROJECT  
 NORTH CAROLINA  
 MURPHY  
 CHEROKEE COUNTY

DATE: 04/24/13  
 SURVEYED BY: DST/EGT  
 DRAWN BY: DST/EGT  
 REVIEWED BY: DST/EGT  
 PROJECT: TLS-12-021  
 FILE: UTM-CONTRERAS\_92766\_TLS\_AB\_F  
 SCALE: AS SHOWN

SHEET  
 14 of 14