

# **APPENDIX D**

*As-Built Plan Sheets/Record Drawings*

**UT TO CANE CREEK**

**PROJECT: 132700**


**NORTH CAROLINA  
ECOSYSTEM ENHANCEMENT PROGRAM**

**ALAMANCE COUNTY**

**LOCATION: APPROXIMATELY 3 MILES SOUTH  
OF THE TOWN OF SAXAPAHAW**

**TYPE OF WORK: AS - BUILT PLANS FOR STREAM  
RESTORATION AND ENHANCEMENT**


STATE	BASIS PROJECT REFERENCE NO.	SHEET NO.	TOTAL SHEETS
NC	132700	1	15
EEP ID No. 95729			

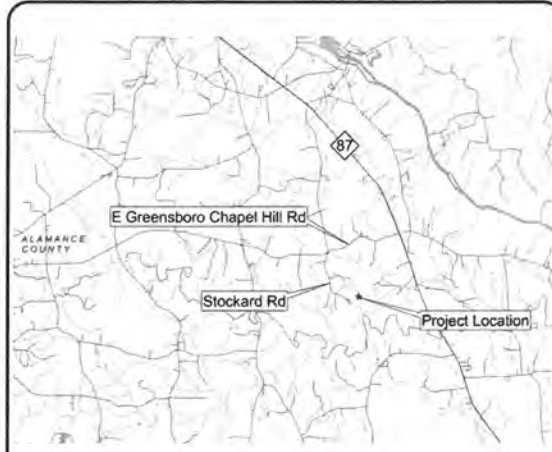


**VICINITY MAP**

INDEX OF SHEETS	
1...	TITLE SHEET
1-A...	STREAM CONVENTIONAL SYMBOLS GENERAL NOTES STANDARD SPECIFICATIONS VEGETATION SELECTION
1-B...	NCDOT CONVENTIONAL SYMBOLS
2-2-D...	DETAILS
3-7...	AS-BUILT PLANS
8-10...	AS-BUILT PROFILES

DWR PROJECT #13-1177  
USACE ACTION ID #2012-01907  
APPROVAL DATE 02/19/14

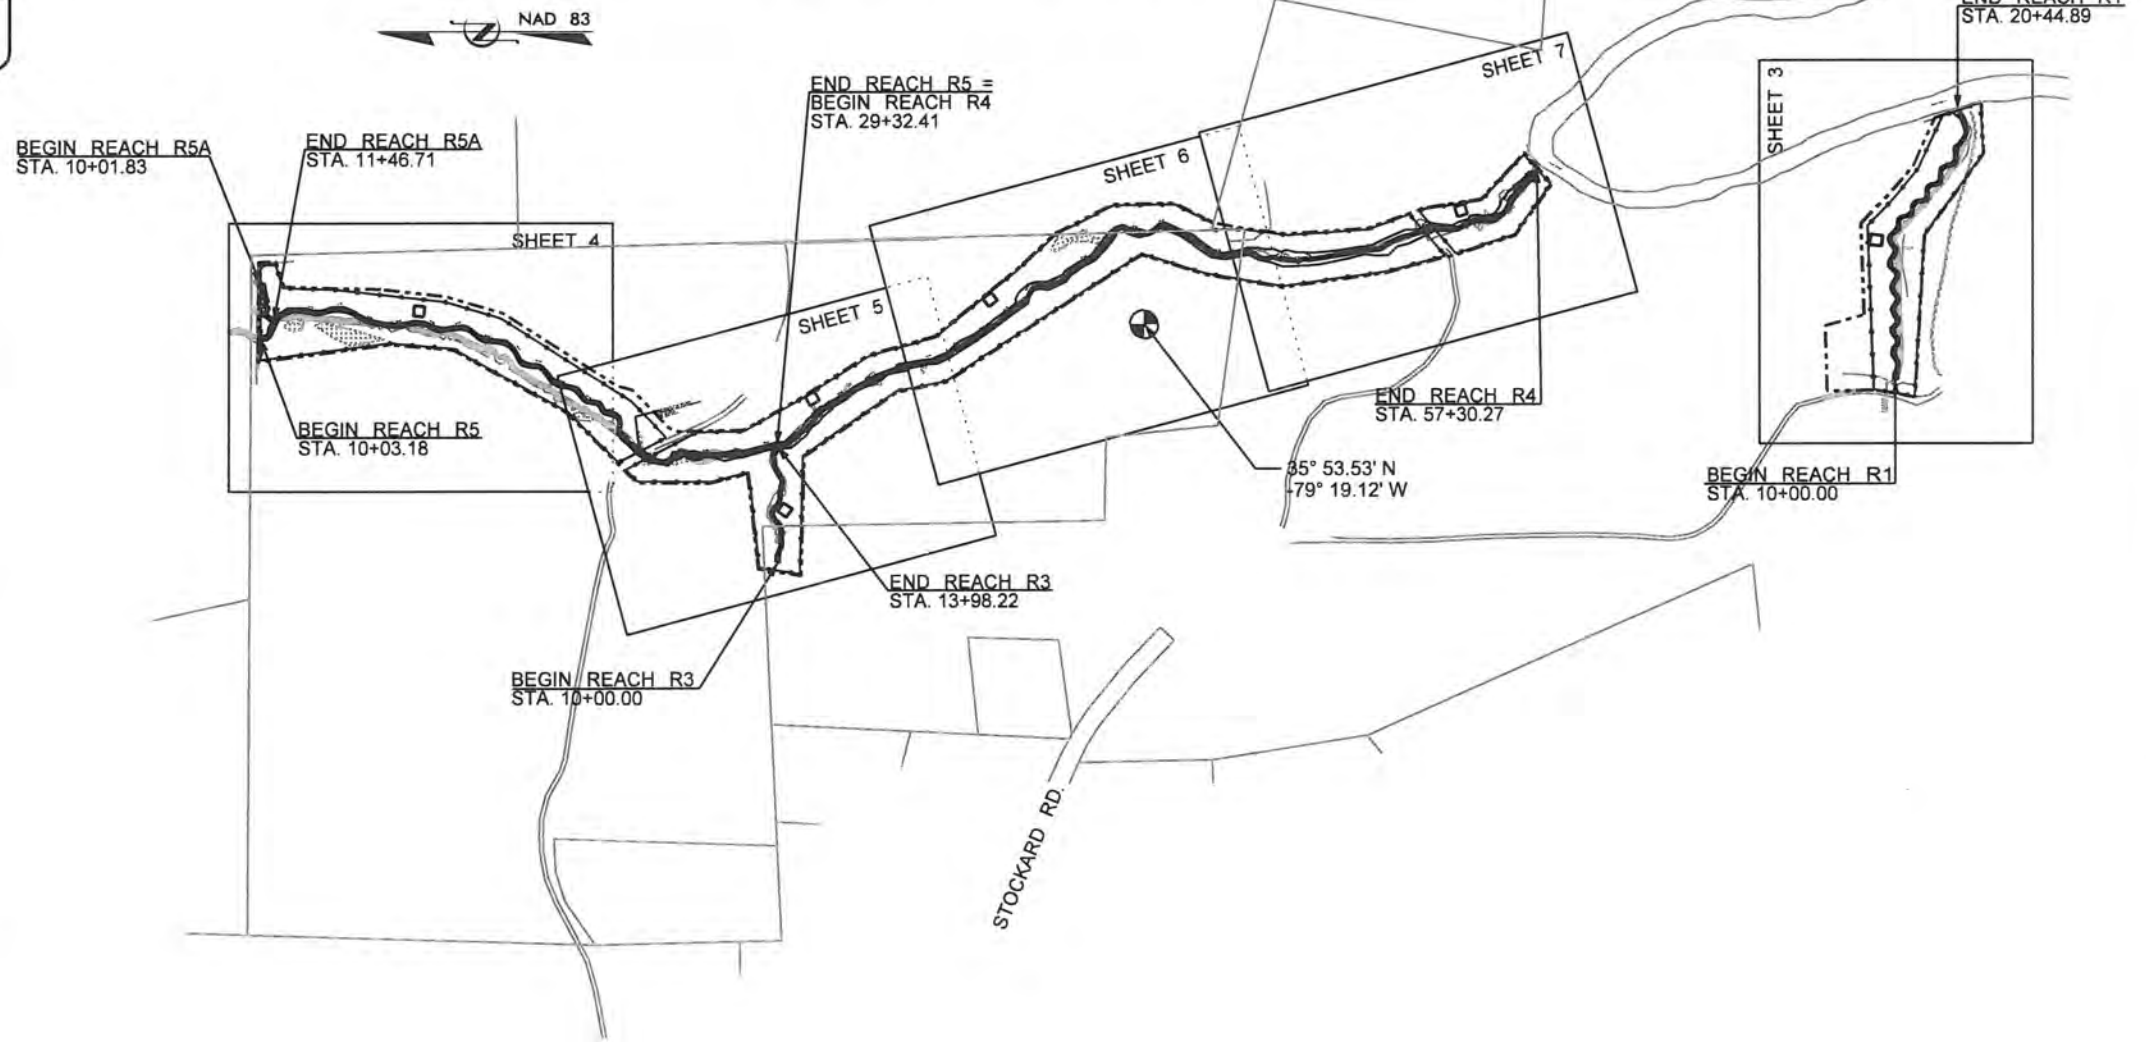

**GRAPHIC SCALES**

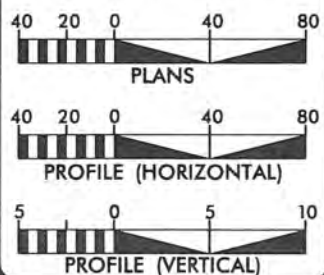

**PROJECT SUMMARY**

AS-BUILT RESTORATION LENGTH REACH R1	=	1,045 FEET
AS-BUILT RESTORATION LENGTH REACH R3	=	398 FEET
AS-BUILT RESTORATION LENGTH REACH R4	=	410 FEET
AS-BUILT ENHANCEMENT LENGTH REACH R4	=	2,353 FEET
AS-BUILT RESTORATION LENGTH REACH R5	=	1,461 FEET
AS-BUILT ENHANCEMENT LENGTH REACH R5	=	433 FEET
AS-BUILT ENHANCEMENT LENGTH REACH R5A	=	145 FEET

**PREPARED FOR THE OFFICE OF:**



NCDENR  
ECOSYSTEM ENHANCEMENT PROGRAM  
1652 MAIL SERVICE CENTER  
RALEIGH, NC 27699-1652

**NCEP CONTACT:** JEFF SCHAFFER  
PROJECT MANAGER

**PREPARED IN THE OFFICE OF:**

**Baker**

Michael Baker Engineering Inc.  
8000 Regency Parkway, Suite 600  
Cary, NORTH CAROLINA 27518  
Phone: 919.483.5488  
Fax: 919.483.5490  
License # F-1084

WILLIAM SCOTT HUNT, III, PE  
PROJECT ENGINEER

KAYNE VAN STELL  
PROJECT MANAGER

JUNE 2014  
COMPLETION DATE:

**PROJECT ENGINEER**



**STREAM CONVENTIONAL SYMBOLS  
SUPERCEDES SHEET 1-B**

	ROCK J-HOOK		FIELD FENCE
	ROOT WAD		CONSERVATION EASEMENT
	LOG J-HOOK		EXISTING MAJOR CONTOUR
	LOG VANE		EXISTING MINOR CONTOUR
	LOG WEIR		LIMITS OF DISTURBANCE
	CONSTRUCTED RIFFLE		PROPERTY LINE
	BOULDER CLUSTER		DITCH PLUG
	LOG STEP POOL		CHANNEL FILL
	PERMANENT STREAM CROSSING		BRUSH MATTRESS
	VEGETATION PLOT		GEOLIFT WITH BRUSH TOE
	CONTROL POINT		
	CREST GAUGE		

**GENERAL NOTES**

1. CONSTRUCTION BEGAN IN MARCH 2014 AND WAS COMPLETED IN JUNE 2014.
2. VEGETATION PLANTING BEGAN IN APRIL 2014 AND WAS COMPLETED IN JUNE 2014.

PROJECT REFERENCE NO. <b>132700</b>	SHEET NO. <b>1-A</b>
PROJECT ENGINEER	
<b>Baker</b>	
<small>Michael Baker Engineering Inc. 8000 Regency Parkway, Suite 600 Cary, NORTH CAROLINA 27518 Phone: 919.483.5488 Fax: 919.483.5480 License # F-1084</small>	
EEP ID No. 95729	

**STANDARD SPECIFICATIONS**

*NORTH CAROLINA  
EROSION AND SEDIMENT CONTROL PLANNING AND DESIGN MANUAL  
MARCH 2009 (REV 2013)*

- 6.05 TREE PROTECTION
- 6.06 TEMPORARY GRAVEL CONSTRUCTION ENTRANCE
- 6.24 RIPARIAN AREA SEEDING
- 6.60 TEMPORARY SEDIMENT TRAP
- 6.62 TEMPORARY SILT FENCE
- 6.63 TEMPORARY ROCK DAM
- 6.70 TEMPORARY STREAM CROSSING



**VEGETATION SELECTION**

The following table lists the bare root vegetation selection for the project site. Total planting area is approximately 14 acres. Species were planted at density of 680 stems per acre and a minimum of 50 feet from the stream banks to the revegetation limits. Exact placement of species were determined prior to site planting and based on apparent wetness of planting locations and per the vegetation specialist. Refer to the Revegetation Plan Sheets & Construction Specifications for vegetation planting locations and riparian buffer requirements.

Riparian Buffer - Overstory Trees (8'x8' spacing - 680 stems/acre)				
Scientific Name	Common Name	% Planted By Species	Wetland Tolerance	Approx. Number of Stems
<i>Fraxinus pennsylvanica</i>	Green Ash	9%	FACW	860
<i>Betula nigra</i>	River Birch	9%	FACW	860
<i>Liriodendron tulipifera</i>	Tulip Poplar	6%	FAC	570
<i>Quercus michauxii</i>	Swamp Chestnut Oak	6%	FACW-	570
<i>Carpinus caroliniana</i>	Ironwood	6%	FAC	570
<i>Platanus occidentalis</i>	American Sycamore	9%	FACW-	860
<i>Quercus alba</i>	White Oak	9%	FACU	860
<i>Quercus nigra</i>	White Oak	6%	FACU	570
<b>Sub-total</b>		<b>60%</b>		<b>5,720</b>
Riparian Buffer - Understory (8'x8' spacing - 680 stems/acre)				
Scientific Name	Common Name			
<i>Diospyros virginiana</i>	Persimmon	6%	FAC	570
<i>Lindera benzoin</i>	Spicebush	8%	FACW	760
<i>Hamamelis virginiana</i>	Witch hazel	6%	FAC-	570
<i>Viburnum dentatum</i>	Arrowwood Viburnum	6%	FAC	570
<i>Itea virginica</i>	Virginia sweetspire	8%	FACW+	760
<i>Asimina triloba</i>	Paw paw	6%	FAC	570
<b>Sub-total</b>		<b>40%</b>		<b>3,800</b>
<b>Total Bare-roots</b>				<b>9,520</b>

Permanent herbaceous seed mixtures for the project site were planted throughout the floodplain and riparian buffer areas. Permanent seed mixtures were applied with temporary seed, as defined in the construction specifications.

Scientific Name	Common Name	% Planted By Species	Total lbs per Acre	Wetland Tolerance
<i>Andropogon gerardii</i>	Big blue stem	10%	1.50	FAC
<i>Dichanthelium clandestinum</i>	Deer Tongue	15%	1.50	FACW
<i>Carex crinata</i>	Fringed sedge	10%	2.25	FACW+
<i>Chasmanthium latifolium</i>	River oats	5%	1.50	FACU
<i>Elymus virginicus</i>	Virginia wild rye	15%	1.50	FAC
<i>Juncus effusus</i>	Soft rush	5%	2.25	FACW+
<i>Panicum virgatum</i>	Switchgrass	10%	1.50	FAC+
<i>Polygonum pensylvanicum</i>	Pennsylvania Smartweed	5%	0.75	FACW
<i>Schizachyrium scoparium</i>	Little blue stem	10%	0.75	FACU
<i>Tripsacum dactyloides</i>	Eastern gamagrass	5%	0.75	FAC+
<i>Sorghastrum nutans</i>	Indiangrass	10%	0.75	FACU
<b>Total</b>		<b>100%</b>	<b>15.0</b>	

The following table lists temporary seed mix for the project site. All disturbed areas were stabilized using mulch and temporary seed as defined in the construction specifications.

Planting Dates	Species Name	Rate (lbs./acre)
September to March	Rye Grain (Cool Season)	130
April to August	Browntop Millet (Warm Season)	40


Live staking was applied to all restored streambanks following the details in this plan set and according to the construction specifications.

Scientific Name	Common Name	% Planted By Species	Wetland Tolerance
<i>Cornus amomum</i>	Silky Dogwood	10%	FACW+
<i>Salix nigra</i>	Black Willow	10%	OBL
<i>Salix sericea</i>	Silky Willow	40%	OBL
<i>Sambucus canadensis</i>	Elderberry	40%	FACW-

2/26/03  
 R:\132700\Design\Plans\As-Built\132700\_AB\_PSH\_1A.dgn  
 mcor-ey  
 UTCANECR 95729 AB\_BAKER\_FINAL

# STATE OF NORTH CAROLINA DIVISION OF HIGHWAYS CONVENTIONAL SYMBOLS

\*S.U.E = SUBSURFACE UTILITY ENGINEER

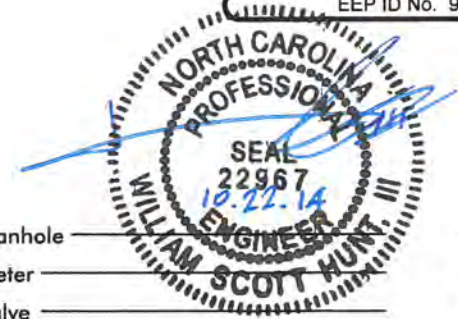

### BOUNDARIES AND PROPERTY:

State Line	-----
County Line	-----
Township Line	-----
City Line	-----
Reservation Line	-----
Property Line	-----
Existing Iron Pin	○
Property Corner	-----
Property Monument	□
Parcel/Sequence Number	②
Existing Fence Line	-x-x-x-
Proposed Woven Wire Fence	○
Proposed Chain Link Fence	○
Proposed Barbed Wire Fence	◇
Existing Wetland Boundary	-----
Proposed Wetland Boundary	-----
Existing Endangered Animal Boundary	-----
Existing Endangered Plant Boundary	-----

### BUILDINGS AND OTHER CULTURE:

Gas Pump Vent or UG Tank Cap	○
Sign	○
Well	○
Small Mine	✕
Foundation	□
Area Outline	□
Cemetery	↑
Building	□
School	□
Church	□
Dam	-----

### HYDROLOGY:

Stream or Body of Water	-----
Hydro, Pool or Reservoir	-----
Jurisdictional Stream	----- JS
Buffer Zone 1	----- BZ 1
Buffer Zone 2	----- BZ 2
Flow Arrow	←
Disappearing Stream	-----
Spring	○
Wetland	-----
Proposed Lateral, Tail, Head Ditch	-----
False Sump	-----

### RAILROADS:

Standard Gauge	-----
RR Signal Milepost	○
Switch	SWITCH
RR Abandoned	-----
RR Dismantled	-----

### RIGHT OF WAY:

Baseline Control Point	◆
Existing Right of Way Marker	△
Existing Right of Way Line	-----
Proposed Right of Way Line	-----
Proposed Right of Way Line with Iron Pin and Cap Marker	-----
Proposed Right of Way Line with Concrete or Granite Marker	-----
Existing Control of Access	-----
Proposed Control of Access	-----
Existing Easement Line	----- E
Proposed Temporary Construction Easement	----- E
Proposed Temporary Drainage Easement	----- TDE
Proposed Permanent Drainage Easement	----- PDE
Proposed Permanent Utility Easement	----- PUE
Proposed Temporary Utility Easement	----- TUE
Proposed Permanent Easement with Iron Pin and Cap Marker	-----

### ROADS AND RELATED FEATURES:

Existing Edge of Pavement	-----
Existing Curb	-----
Proposed Slope Stakes Cut	-----
Proposed Slope Stakes Fill	-----
Proposed Wheel Chair Ramp	WCR
Existing Metal Guardrail	-----
Proposed Guardrail	-----
Existing Cable Guiderail	-----
Proposed Cable Guiderail	-----
Equality Symbol	⊕
Pavement Removal	XXXX

### VEGETATION:

Single Tree	○
Single Shrub	○
Hedge	-----
Woods Line	-----
Orchard	-----
Vineyard	Vineyard

### EXISTING STRUCTURES:

MAJOR:	
Bridge, Tunnel or Box Culvert	CONC
Bridge Wing Wall, Head Wall and End Wall	CONC WW
MINOR:	
Head and End Wall	CONC HW
Pipe Culvert	-----
Footbridge	-----
Drainage Box: Catch Basin, DI or JB	CB
Paved Ditch Gutter	-----
Storm Sewer Manhole	Ⓢ
Storm Sewer	-----

### UTILITIES:

POWER:	
Existing Power Pole	○
Proposed Power Pole	○
Existing Joint Use Pole	○
Proposed Joint Use Pole	○
Power Manhole	Ⓢ
Power Line Tower	⊠
Power Transformer	⊠
UG Power Cable Hand Hole	PH
H-Frame Pole	-----
Recorded UG Power Line	-----
Designated UG Power Line (S.U.E.*)	-----

### TELEPHONE:

Existing Telephone Pole	○
Proposed Telephone Pole	○
Telephone Manhole	Ⓢ
Telephone Booth	⊠
Telephone Pedestal	⊠
Telephone Cell Tower	⊠
UG Telephone Cable Hand Hole	PH
Recorded UG Telephone Cable	-----
Designated UG Telephone Cable (S.U.E.*)	-----
Recorded UG Telephone Conduit	-----
Designated UG Telephone Conduit (S.U.E.*)	-----
Recorded UG Fiber Optics Cable	-----
Designated UG Fiber Optics Cable (S.U.E.*)	-----

### WATER:

Water Manhole	Ⓢ
Water Meter	○
Water Valve	Ⓢ
Water Hydrant	Ⓢ
Recorded UG Water Line	-----
Designated UG Water Line (S.U.E.*)	-----
Above Ground Water Line	----- A/G Water

### TV:

TV Satellite Dish	⊠
TV Pedestal	⊠
TV Tower	⊠
UG TV Cable Hand Hole	PH
Recorded UG TV Cable	-----
Designated UG TV Cable (S.U.E.*)	-----
Recorded UG Fiber Optic Cable	-----
Designated UG Fiber Optic Cable (S.U.E.*)	-----

### GAS:

Gas Valve	◇
Gas Meter	Ⓢ
Recorded UG Gas Line	-----
Designated UG Gas Line (S.U.E.*)	-----
Above Ground Gas Line	----- A/G Gas


### SANITARY SEWER:

Sanitary Sewer Manhole	Ⓢ
Sanitary Sewer Cleanout	Ⓢ
UG Sanitary Sewer Line	-----
Above Ground Sanitary Sewer	----- A/G Sanitary Sewer
Recorded SS Forced Main Line	-----
Designated SS Forced Main Line (S.U.E.*)	-----

### MISCELLANEOUS:


Utility Pole	○
Utility Pole with Base	□
Utility Located Object	○
Utility Traffic Signal Box	⊠
Utility Unknown UG Line	-----
UG Tank; Water, Gas, Oil	□
A/G Tank; Water, Gas, Oil	□
UG Test Hole (S.U.E.*)	Ⓢ
Abandoned According to Utility Records	AATUR
End of Information	E.O.I.

**ROOT WADS**

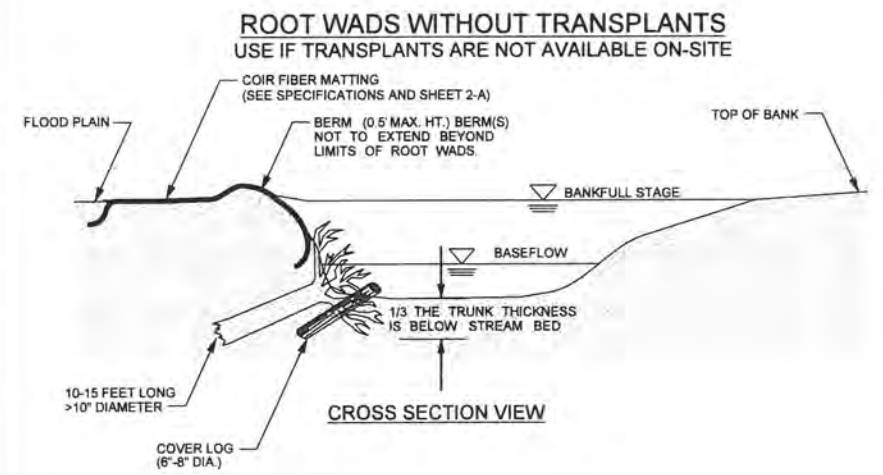


**ROOT WADS WITHOUT TRANSPLANTS**  
 USE IF TRANSPLANTS ARE NOT AVAILABLE ON-SITE

- NOTES:**
1. INSTALLATION USING THE TRENCHING METHOD REQUIRES THAT A TRENCH BE EXCAVATED FOR THE LOG PORTION OF THE ROOT WAD. ONE-THIRD OF THE ROOT WAD SHOULD REMAIN BELOW NORMAL BASE FLOW CONDITIONS OR CHANNEL BOTTOM.
  2. THE NUMBER OF ROOTWADS ESTIMATED MAY VARY DEPENDING ON THE ROOTMASS SIZE. IN GENERAL, ROOTWADS SHOULD PROTECT THE OUTER MEANDER BEND AS SHOWN. SEE STRUCTURE TABLE FOR APPROXIMATE STATION AND LOCATION.
  3. INSTALL COVER LOGS BETWEEN ROOTWADS TO PROVIDE HABITAT ONLY WHEN AVAILABLE FROM ON-SITE HARVESTING.




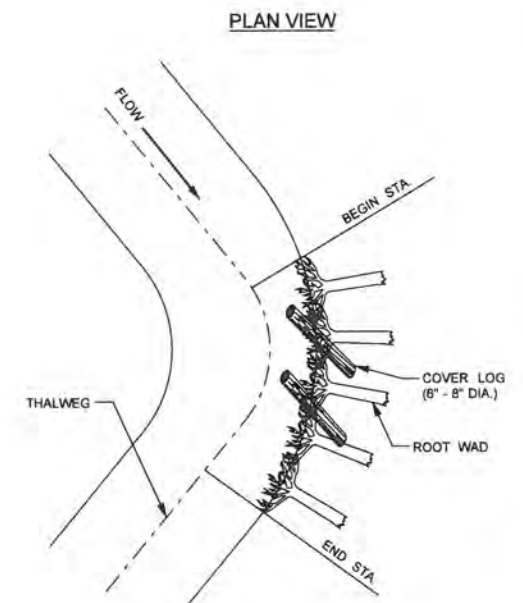


**TYPICAL STRUCTURE PLACEMENT**

- STRUCTURE NOTES:**
1. GENERALLY CONSTRUCTED RIFFLES, ROOT WADS, LOG VANES AND COIR FIBER MATTING WILL BE INSTALLED IN THE LOCATION AND SEQUENCE AS SHOWN.
  2. ANY CHANGES TO NUMBER OR LOCATION OF STRUCTURES DURING CONSTRUCTION MUST BE APPROVED BY THE DESIGN ENGINEER.
  3. COIR FIBER MATTING TO BE INSTALLED ON ALL RESTORED STREAMBANKS, FLOODPLAIN BENCHING, AND TERRACE SLOPES AS DESCRIBED IN THE TECHNICAL SPECIFICATIONS.

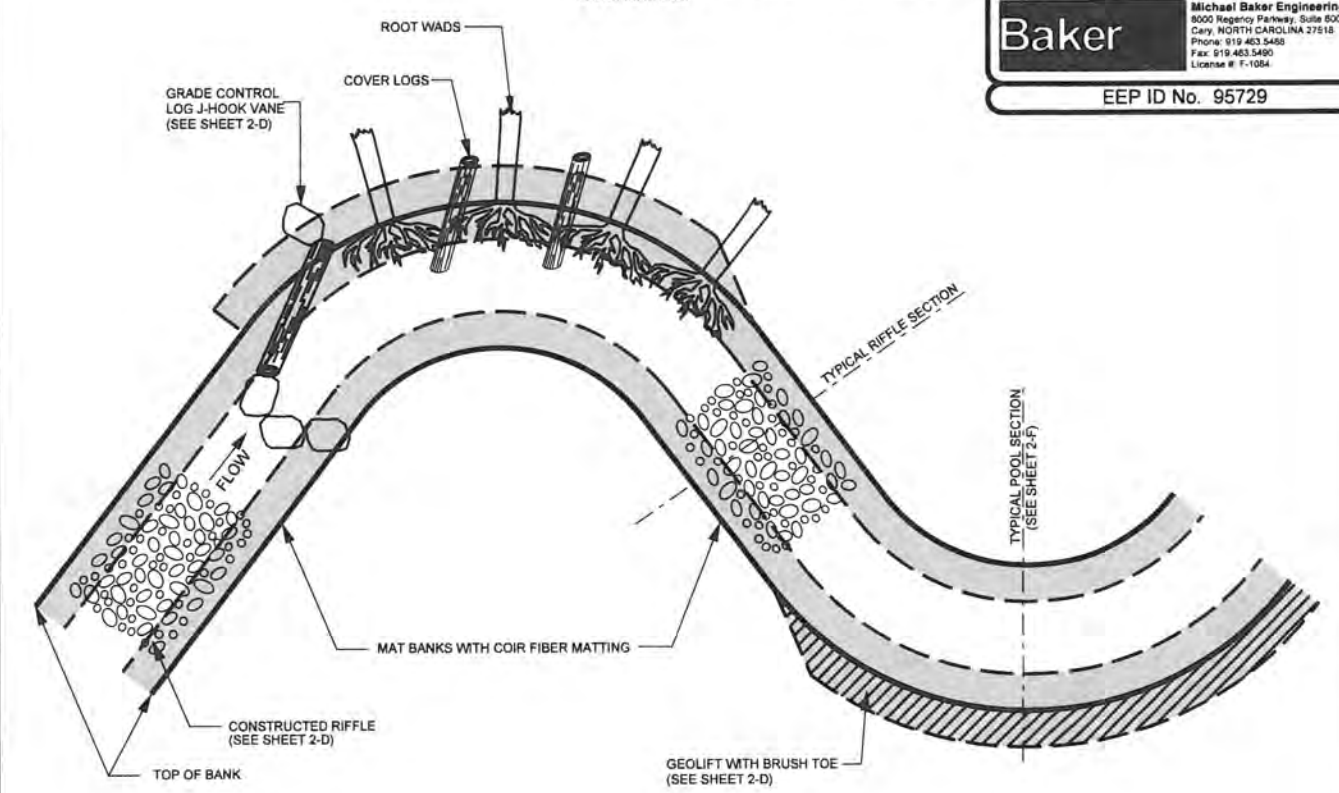

**TYPICAL RIFFLE, POOL, AND BANKFULL BENCH CROSS-SECTIONS**

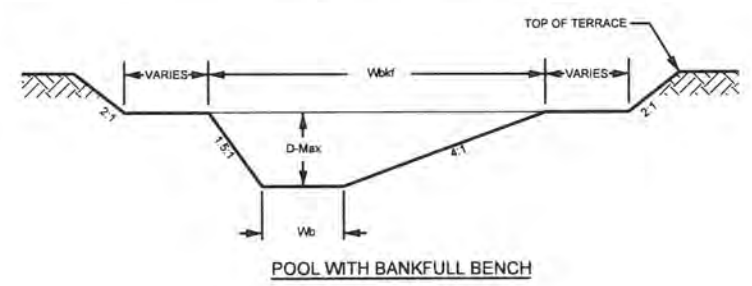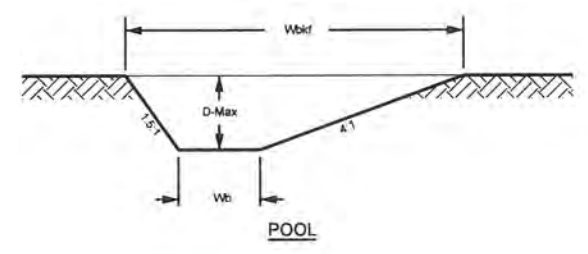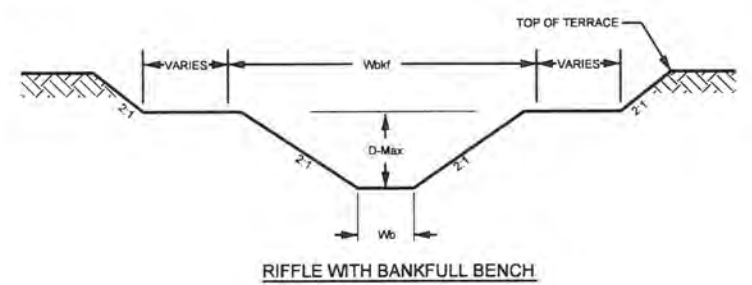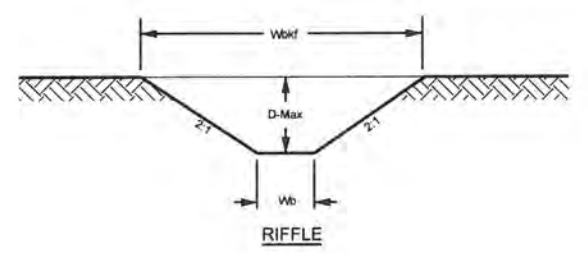

R1		R3		R4		R5		R5A	
RIFFLE	POOL	RIFFLE	POOL	RIFFLE	POOL	RIFFLE	POOL	RIFFLE	POOL
6.9	9.0	7.2	9.2	14.0	17.0	10.8	13.0	3.2	5.0
0.7	1.5	0.7	1.3	1.2	2.2	1.1	2.0	0.4	1.0
13.0	11.1	13.0	12.3	14.0	12.6	13.0	12.1	12.0	10.0
3.7	7.3	4.0	6.9	14.0	22.9	9.0	14.0	0.9	2.5
4.3	0.8	4.5	1.4	9.2	3.8	5.2	1.0	1.3	0.1

WIDTH OF BANKFULL (Wbkf)  
 MAXIMUM DEPTH (D-Max)  
 WIDTH TO DEPTH RATIO (Wbkf / D)  
 BANKFULL AREA (Abkf)  
 BOTTOM WIDTH (Wb)




- NOTES:**
1. DURING CONSTRUCTION CORNERS OF DESIGN CHANNEL WILL BE ROUNDED AND A THALWEG WILL BE SHAPED PER DIRECTION OF ENGINEER.
  2. POOLS SHOWN ABOVE ARE LEFT POOLS FOR MEANDER CHANNELS.



I:\Projects\132700\132700\_AB\_PSH\_2.dgn  
 mcberry  
 UTCANECR 95729 AB BAKER FINAL




**LIVE STAKING**

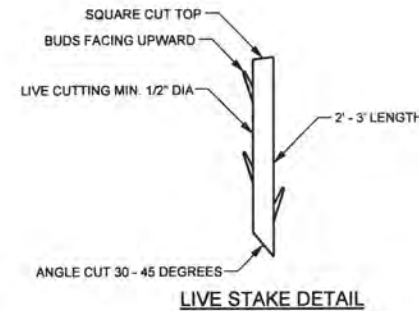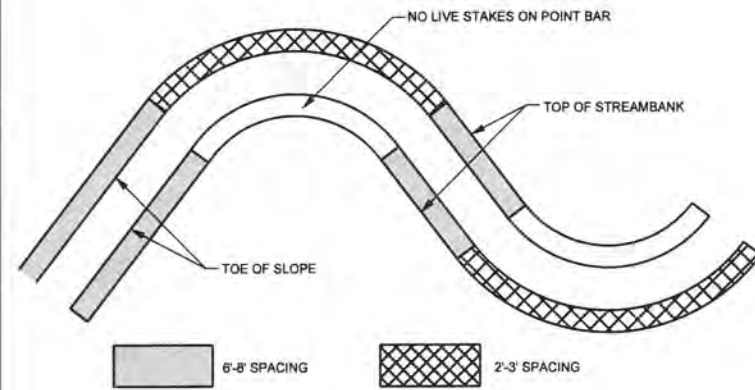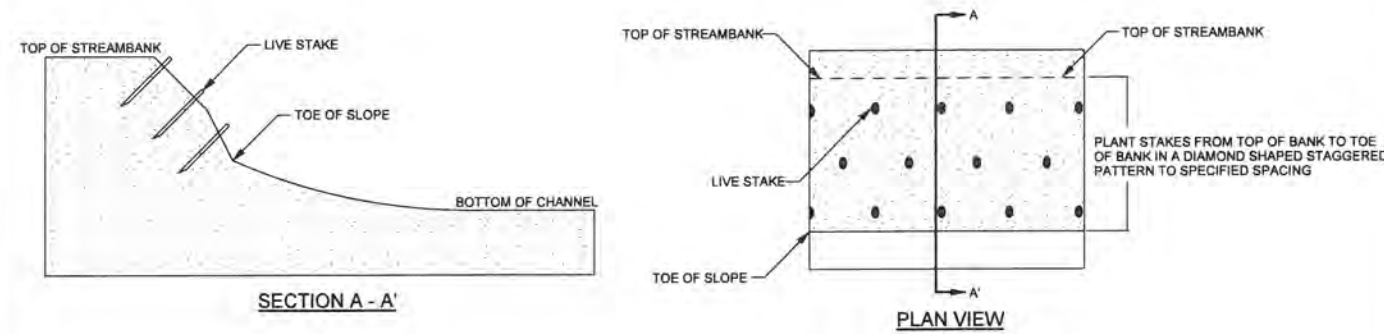



- NOTES:**
1. STAKES SHOULD BE CUT AND INSTALLED ON THE SAME DAY.
  2. DO NOT INSTALL STAKES THAT HAVE BEEN SPLIT.
  3. STAKES MUST BE INSTALLED WITH BUDS POINTING UPWARDS.
  4. STAKES SHOULD BE INSTALLED PERPENDICULAR TO BANK.
  5. STAKES SHOULD BE 1/2 TO 2 INCHES IN DIAMETER AND 2 TO 3 FT LONG.
  6. STAKES SHOULD BE INSTALLED LEAVING 1/5 OF STAKE ABOVE GROUND.

**PLANTING SPECIFICATIONS**

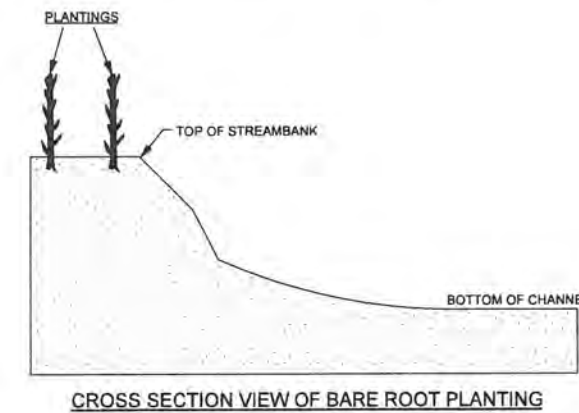


- NOTES:**
1. PLANT BARE ROOT SHRUBS AND TREES TO THE WIDTH OF THE BUFFER PLANTING ZONE AS SHOWN ON THE PLANS.
  2. ALLOW FOR 6-10 FEET BETWEEN PLANTINGS, DEPENDING ON SIZE.
  3. LOOSEN COMPACTED SOIL.
  4. PLANT IN HOLES MADE BY A MATTOCK, DIBBLE, PLANTING BAR, OR OTHER APPROVED MEANS.
  5. PLANT IN HOLES DEEP AND WIDE ENOUGH TO ALLOW THE ROOTS TO SPREAD OUT AND DOWN WITHOUT J-ROOTING.
  6. KEEP ROOTS MOIST WHILE DISTRIBUTING OR WAITING TO PLANT BY MEANS OF WET CANVAS, BURLAP OR STRAW.
  7. WHEEL-IN PLANTS IN MOIST SOIL OR SAWDUST IF NOT PROMPTLY PLANTED UPON ARRIVAL TO PROJECT SITE.

**TRANSPLANTED VEGETATION**

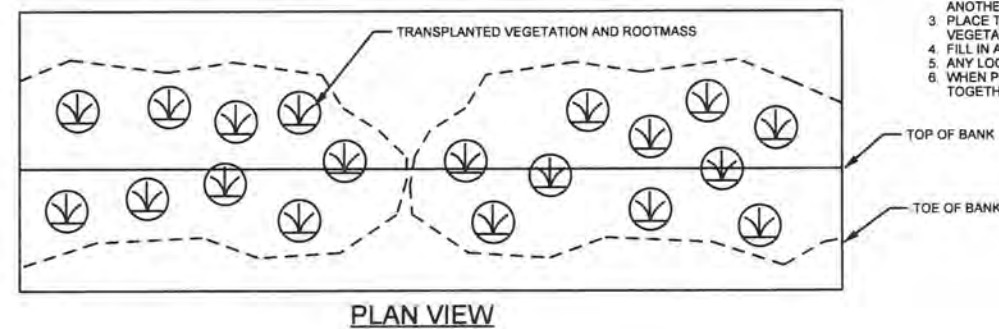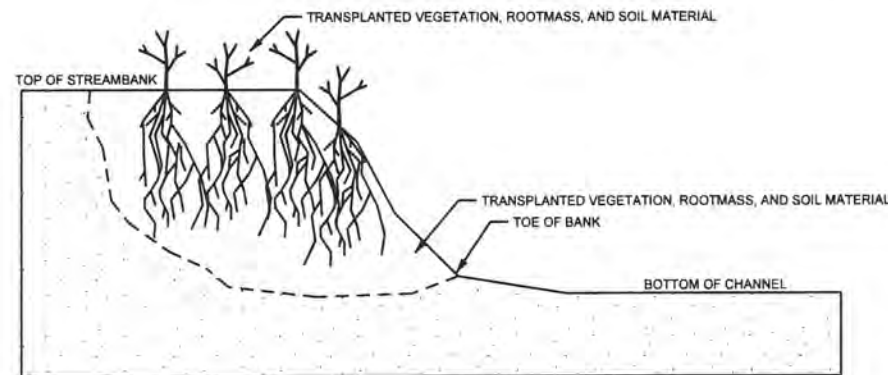


- NOTES:**
1. EXCAVATE A HOLE IN THE BANK TO BE STABILIZED THAT WILL ACCOMMODATE THE SIZE OF TRANSPLANT TO BE PLACED. BEGIN EXCAVATION AT THE TOE OF THE BANK.
  2. EXCAVATE THE ENTIRE ROOT MASS AND AS MUCH ADDITIONAL SOIL MATERIAL AS POSSIBLE. IF ENTIRE ROOT MASS CAN NOT BE EXCAVATED AT ONCE, THE TRANSPLANT IS TOO LARGE AND ANOTHER SHOULD BE SELECTED.
  3. PLACE TRANSPLANT IN THE BANK TO BE STABILIZED SO THAT VEGETATION IS ORIENTATED VERTICALLY.
  4. FILL IN ANY HOLES AROUND THE TRANSPLANT AND COMPACT.
  5. ANY LOOSE SOIL LEFT IN THE STREAM SHOULD BE COMPACT.
  6. WHEN POSSIBLE, PLACE MULTIPLE TRANSPLANTS CLOSE TOGETHER SUCH THAT THEY TOUCH.

**PERMANENT ROAD CULVERT CROSSING**

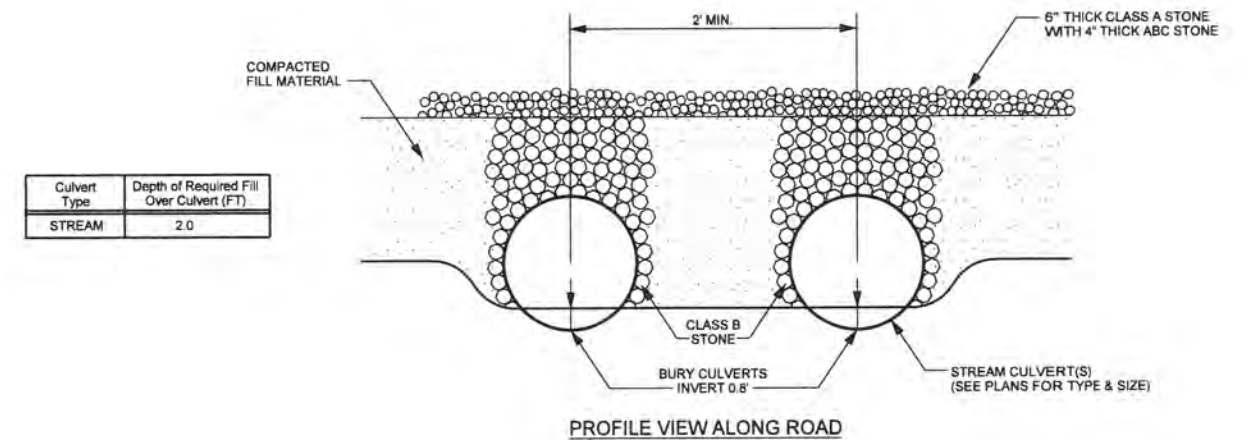


Culvert Type	Depth of Required Fill Over Culvert (FT)
STREAM	2.0

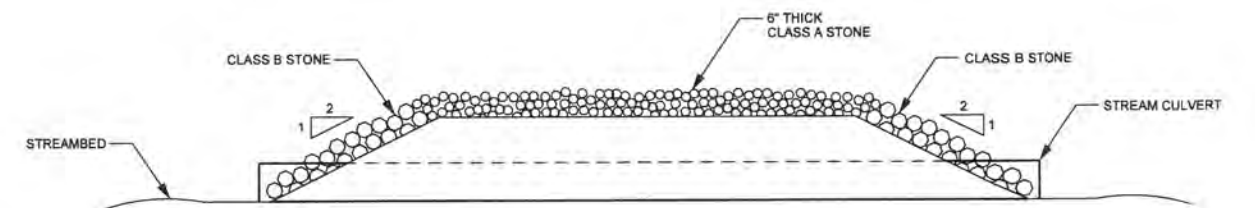

- NOTES:**
1. APPLY SUFFICIENT FILL OVER CULVERTS TO PREVENT CULVERT COLLAPSE.
  2. STABILIZE FILL AROUND CULVERTS WITH CLASS B STONE. STABILIZE REMAINING ROADSIDE SLOPES WITH EROSION MATTING ACCORDING TO SPECIFICATIONS.
  3. CULVERT SPACING A MINIMUM OF 2' APART.


I:\132700\132700\Design\Plans\As-Built\132700\_AB\_PSH\_2A.dgn  
 mcbrey  
 UTCANECR 95729 AB BAKER FINAL

**LOG WEIR**

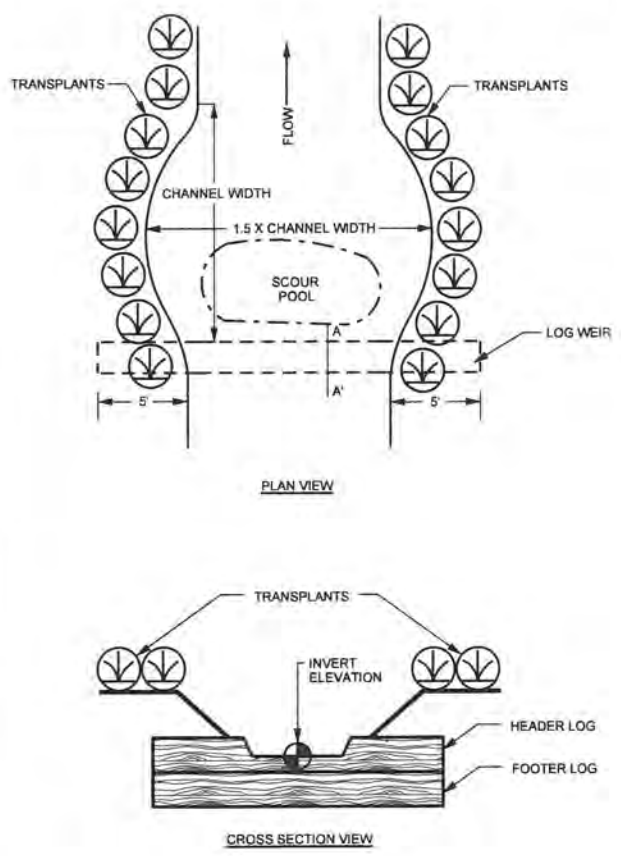


- NOTES:**
- LOGS SHOULD BE AT LEAST 12 INCHES IN DIAMETER, RELATIVELY STRAIGHT, HARDWOOD, AND RECENTLY HARVESTED.
  - LOGS >24 INCHES IN DIAMETER MAY BE USED ALONE WITHOUT AN ADDITIONAL LOG. GEOTEXTILE FABRIC SHOULD STILL BE USED TO SEAL AROUND LOG.
  - PLACE FOOTER LOGS FIRST AND THEN HEADER (TOP) LOG. SET HEADER LOG APPROXIMATELY 3 INCHES ABOVE THE INVERT ELEVATION.
  - CUT A NOTCH IN THE HEADER LOG APPROXIMATELY 50 PERCENT OF THE CHANNEL BOTTOM WIDTH AND EXTENDING DOWN TO THE INVERT ELEVATION.
  - USE GEOTEXTILE FABRIC TO SEAL GAPS BETWEEN LOGS.
  - PLACE TRANSPLANTS FROM TOE OF STREAMBANK TO TOP OF STREAMBANK

**LOG VANE**

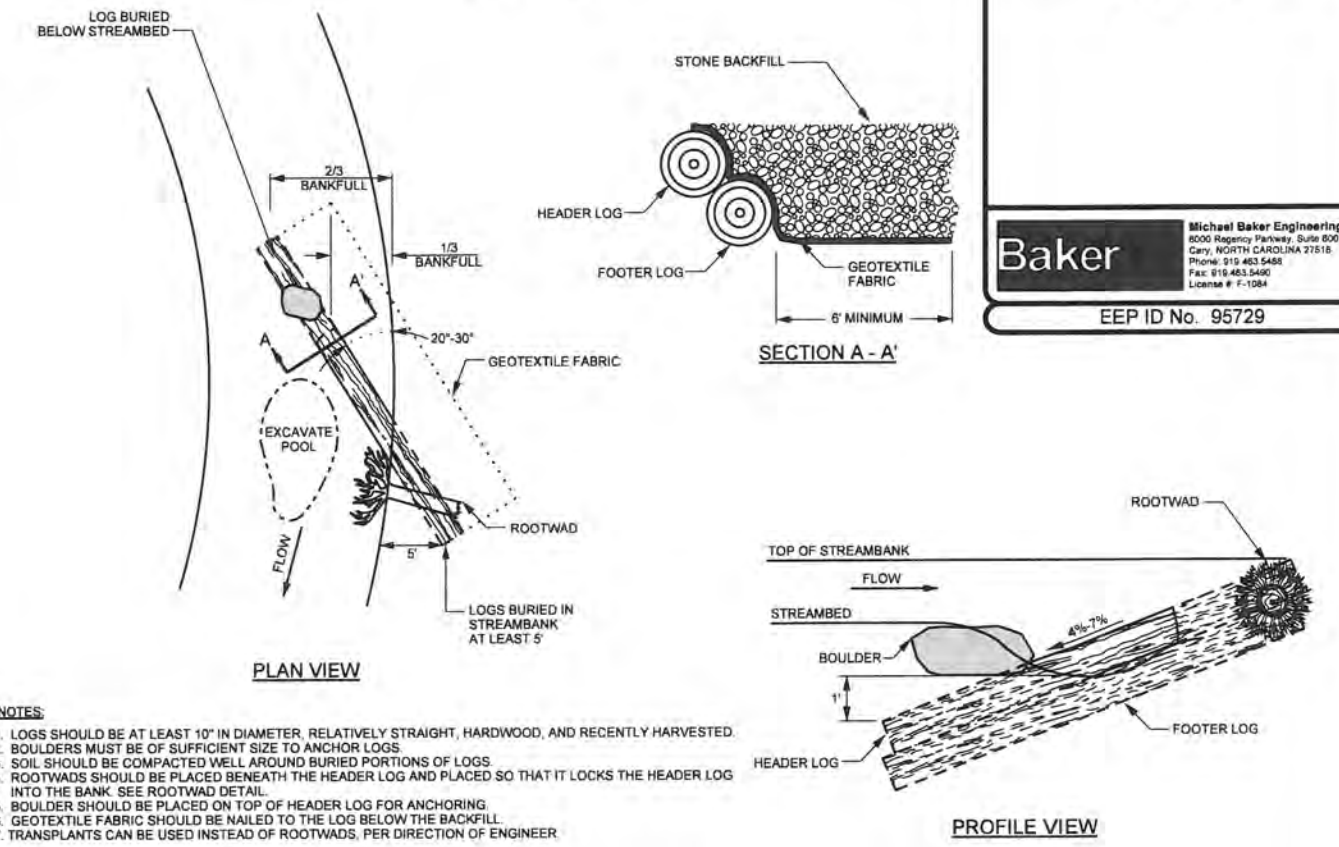


- NOTES:**
- LOGS SHOULD BE AT LEAST 10" IN DIAMETER, RELATIVELY STRAIGHT, HARDWOOD, AND RECENTLY HARVESTED.
  - BOULDERS MUST BE OF SUFFICIENT SIZE TO ANCHOR LOGS.
  - SOIL SHOULD BE COMPACTED WELL AROUND BURIED PORTIONS OF LOGS.
  - ROOTWADS SHOULD BE PLACED BENEATH THE HEADER LOG AND PLACED SO THAT IT LOCKS THE HEADER LOG INTO THE BANK. SEE ROOTWAD DETAIL.
  - BOULDER SHOULD BE PLACED ON TOP OF HEADER LOG FOR ANCHORING.
  - GEOTEXTILE FABRIC SHOULD BE NAILED TO THE LOG BELOW THE BACKFILL.
  - TRANSPLANTS CAN BE USED INSTEAD OF ROOTWADS, PER DIRECTION OF ENGINEER.

**HIGH TENSILE FIELD FENCE**

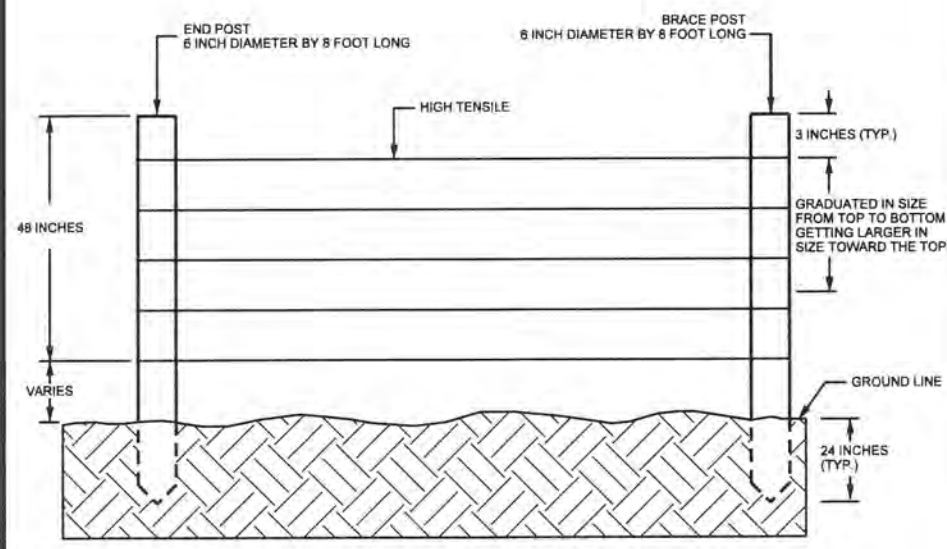


- NOTE:**
- END POSTS SHALL BE INSTALLED AT A SPACING OF 10-15 FEET.

**WOVEN FIELD FENCE**

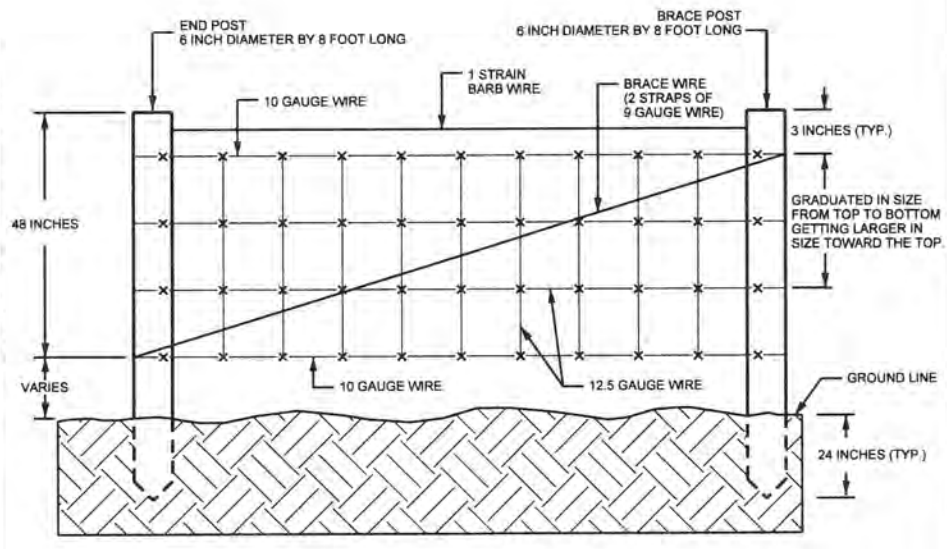

- NOTE:**
- END POSTS SHALL BE INSTALLED AT A SPACING OF 10-15 FEET.

**STEEL GATES**

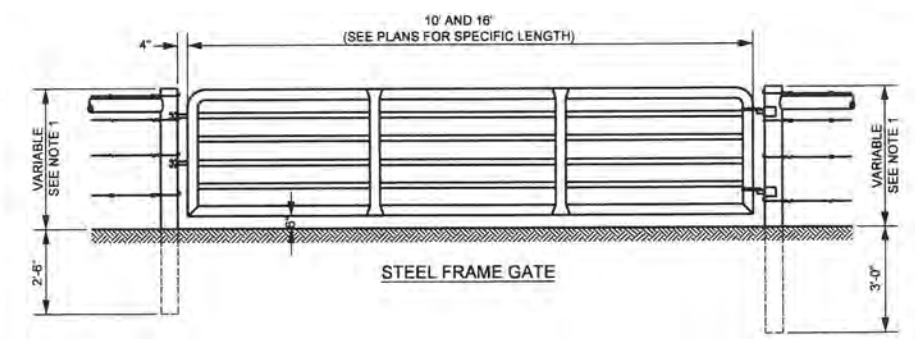


- NOTES:**
- POST HEIGHT DIMENSION SHALL BE THE SAME AS REQUIRED FOR THE ADJACENT FENCE.
  - CONSTRUCT AN END OR STRESS PANEL AS REQUIRED IN THE SPECIFICATION, ON EACH SIDE OF GATE.
  - HINGES AND LOCKS SHALL BE INSTALLED AS SPECIFIED BY GATE MANUFACTURER.




I:\Projects\132700\Design\Plans\As-Built\132700\_AB\_PSH\_2B.dgn  
 mcorne  
 UTCANECKR 95729 AB BAKER FINAL

2/26/03

**DITCH PLUG**

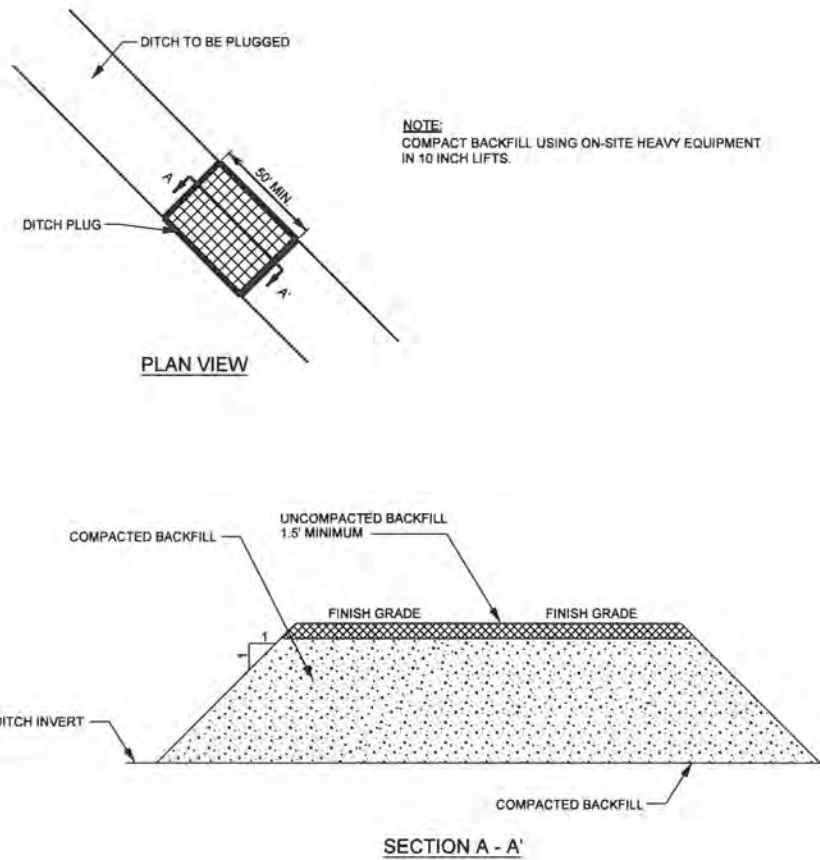


**CHANNEL BLOCK**

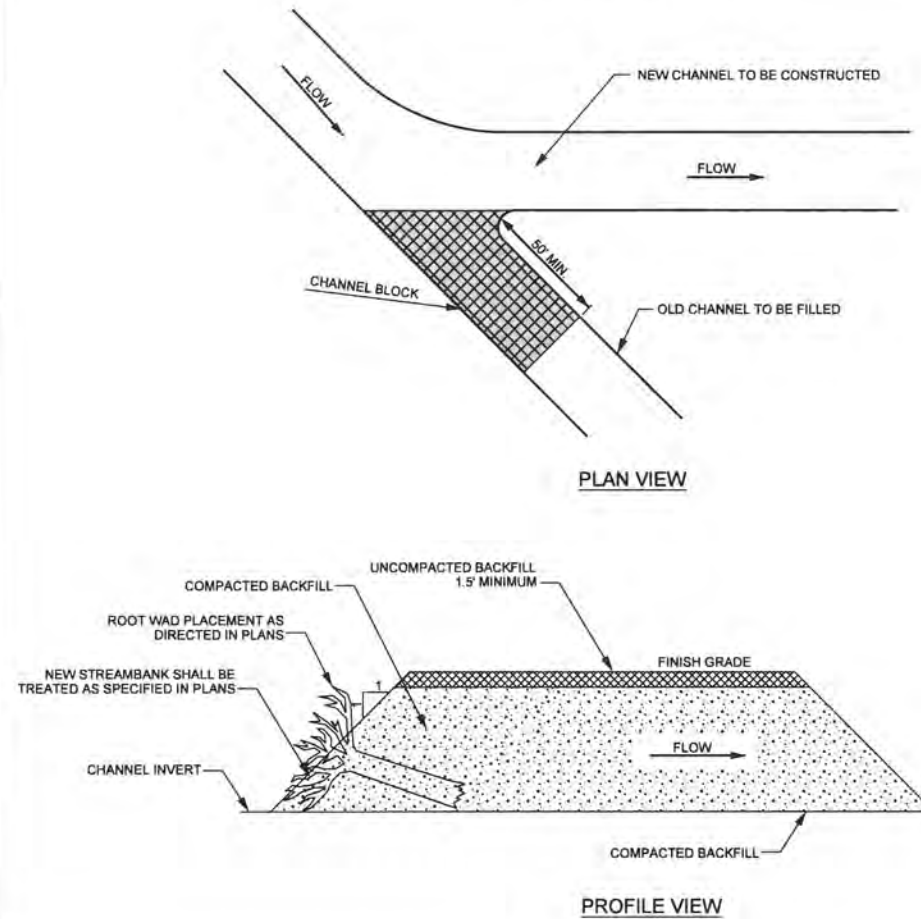

BAKER PROJECT REFERENCE NO.	SHEET NO.
132700	2-C
PROJECT ENGINEER	
<b>Baker</b>	
<small>Michael Baker Engineering Inc.          9000 Regency Parkway, Suite 600          Cary, NORTH CAROLINA 27516          Phone: 919.463.5488          Fax: 919.463.5480          License # F-1084</small>	
EEP ID No. 95729	



**LOG AND ROCK STEP-POOL**

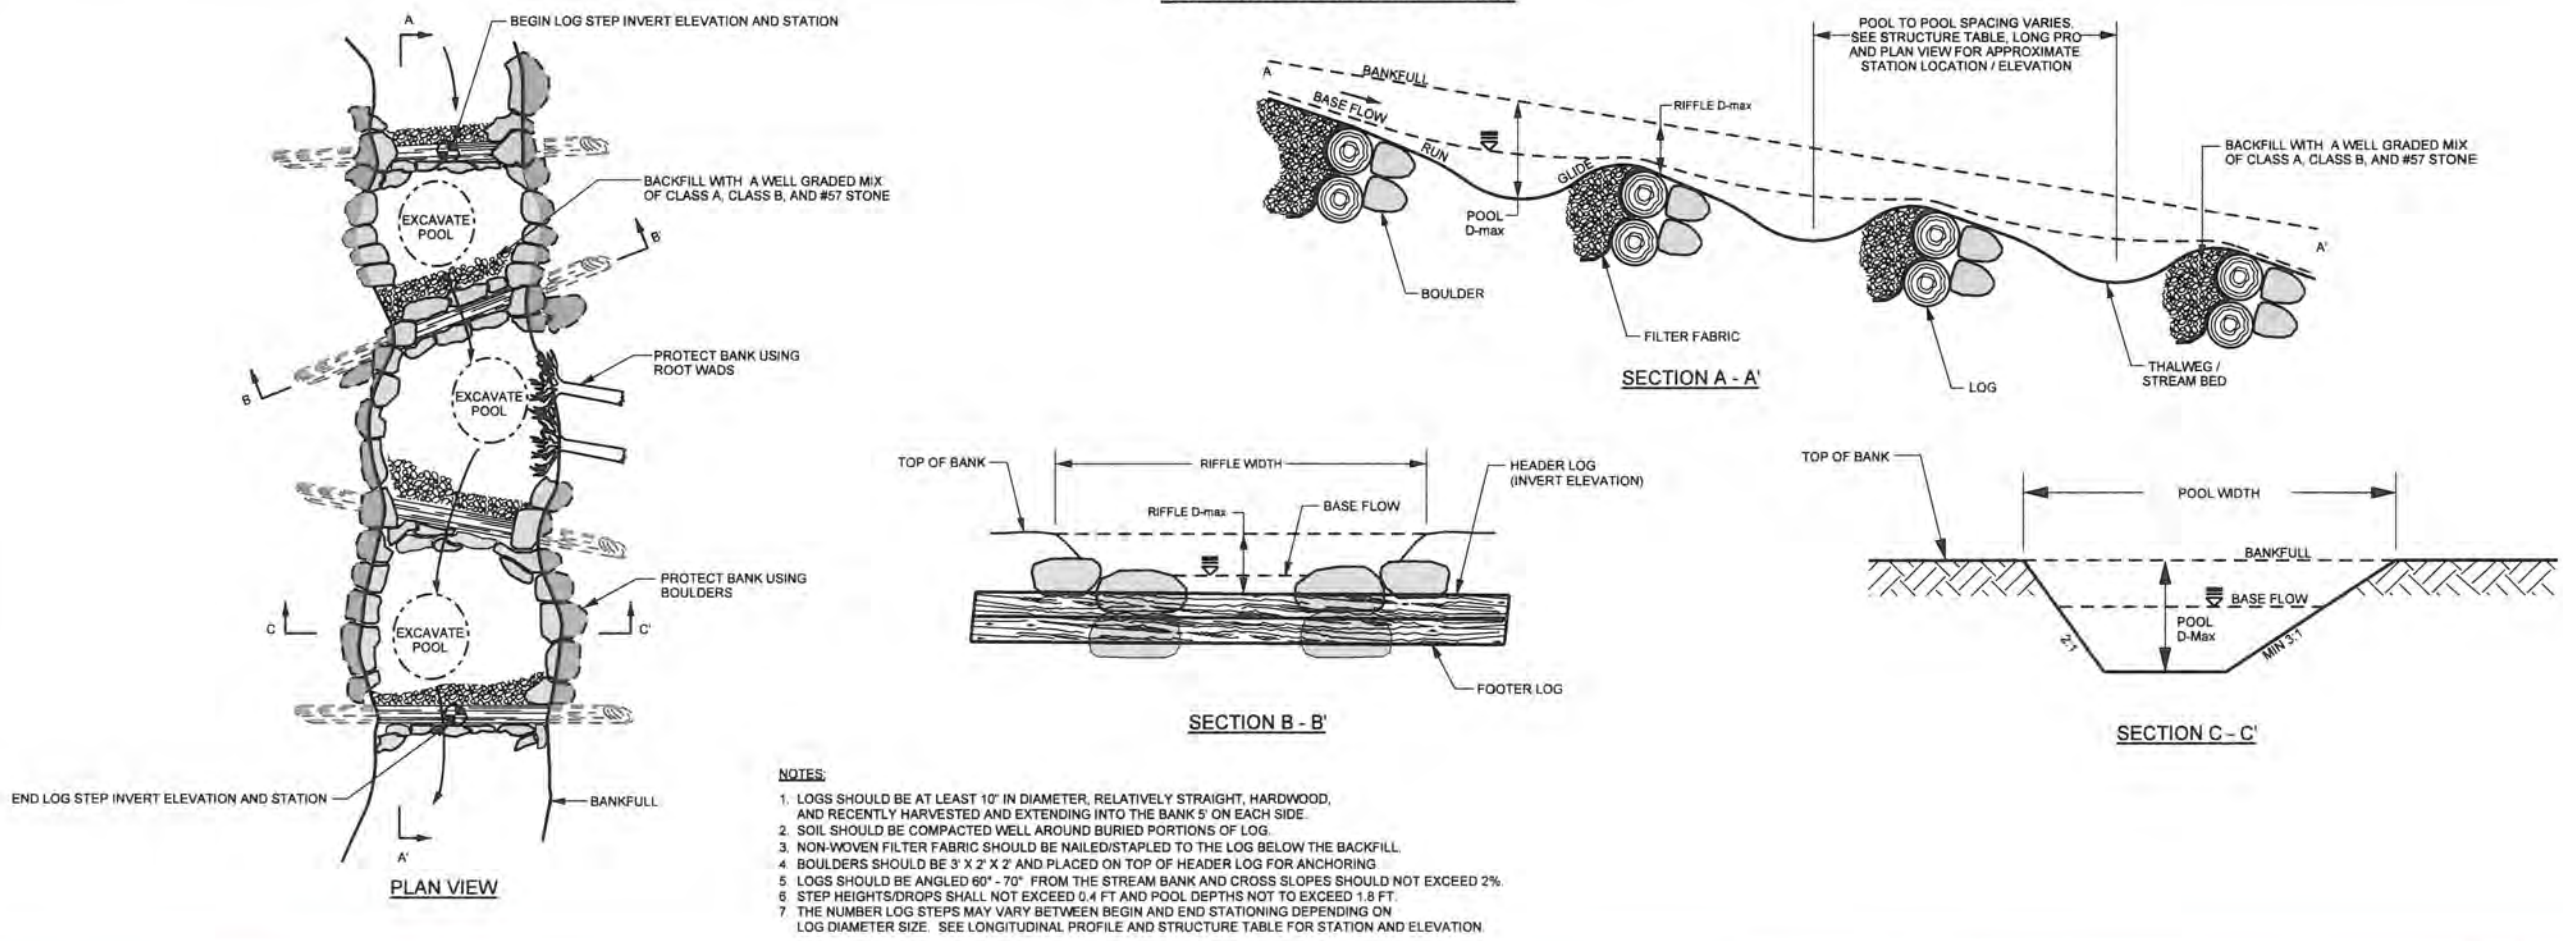


- NOTES:**
- LOGS SHOULD BE AT LEAST 10" IN DIAMETER, RELATIVELY STRAIGHT, HARDWOOD, AND RECENTLY HARVESTED AND EXTENDING INTO THE BANK 5' ON EACH SIDE.
  - SOIL SHOULD BE COMPACTED WELL AROUND BURIED PORTIONS OF LOG.
  - NON-WOVEN FILTER FABRIC SHOULD BE NAILED/STAPLED TO THE LOG BELOW THE BACKFILL.
  - BOULDERS SHOULD BE 3' X 2' X 2' AND PLACED ON TOP OF HEADER LOG FOR ANCHORING.
  - LOGS SHOULD BE ANGLED 60° - 70° FROM THE STREAM BANK AND CROSS SLOPES SHOULD NOT EXCEED 2%.
  - STEP HEIGHTS/DROPS SHALL NOT EXCEED 0.4 FT AND POOL DEPTHS NOT TO EXCEED 1.8 FT.
  - THE NUMBER LOG STEPS MAY VARY BETWEEN BEGIN AND END STATIONING DEPENDING ON LOG DIAMETER SIZE. SEE LONGITUDINAL PROFILE AND STRUCTURE TABLE FOR STATION AND ELEVATION.

10/17/2004  
 R:\132700\Design\Plans\As-Built\132700\_AB\_PSH\_2C.dgn  
 mcr-ey  
 UTCANECR 95729 AB BAKER FINAL




### CONSTRUCTED RIFFLE

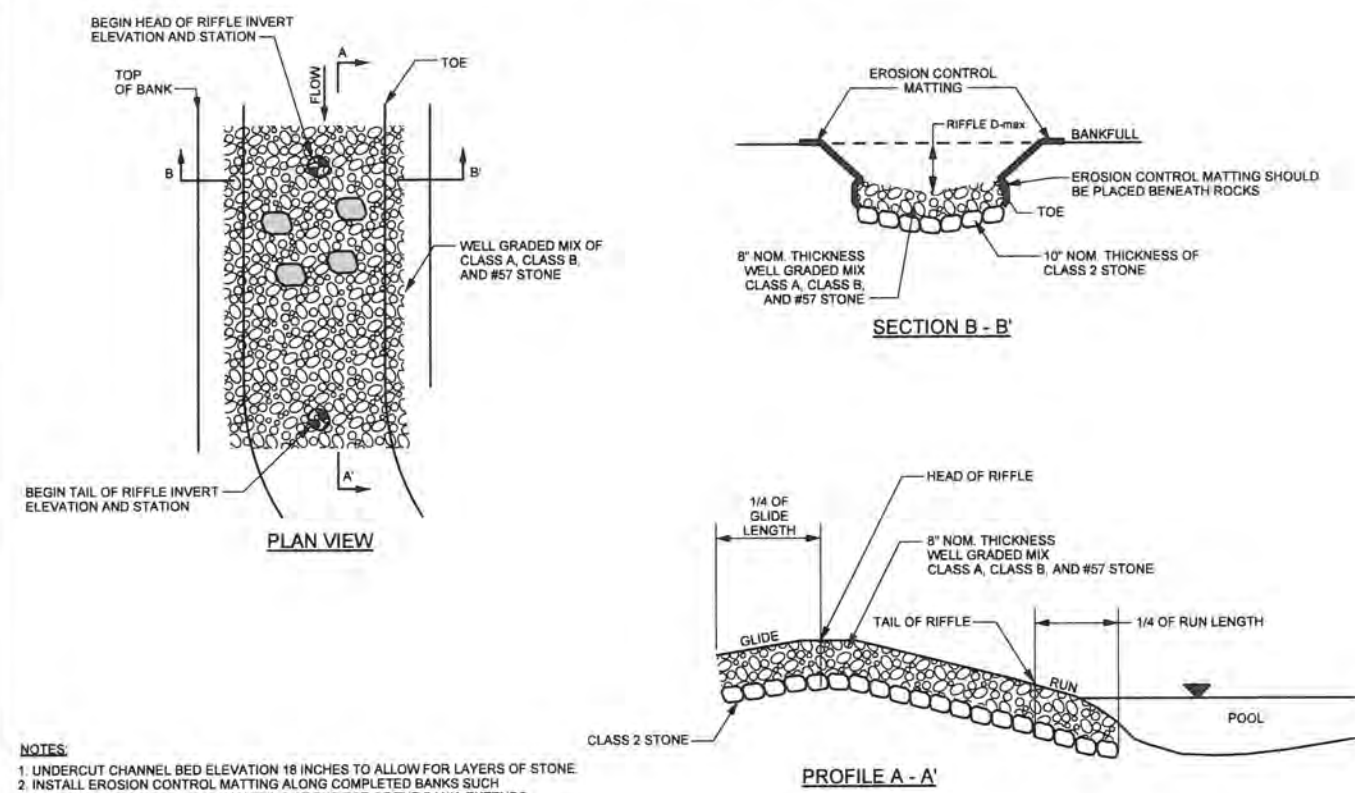


- NOTES:**
1. UNDERCUT CHANNEL BED ELEVATION 18 INCHES TO ALLOW FOR LAYERS OF STONE
  2. INSTALL EROSION CONTROL MATTING ALONG COMPLETED BANKS SUCH THAT THE EROSION CONTROL MATTING AT THE TOE OF THE BANK EXTENDS DOWN TO THE UNDERCUT ELEVATION
  3. INSTALL SUB LAYER OF CLASS 2 STONE.
  4. INSTALL A WELL GRADED MIX OF SPECIFIED STONE, COMPACTED TO GRADE
  5. FINAL CHANNEL BED SHAPE SHOULD BE ROUNDED, SMOOTH, AND CONCAVE, WITH THE ELEVATION OF THE BED 0.2 FT DEEPER IN THE CENTER THAN AT THE EDGES
  6. RIFFLE LENGTHS WILL VARY. SEE LONGITUDINAL PROFILE AND STRUCTURE TABLE FOR BEGINNING AND ENDING STATIONS AND ELEVATIONS.

### GEOLIFT WITH BRUSH TOE

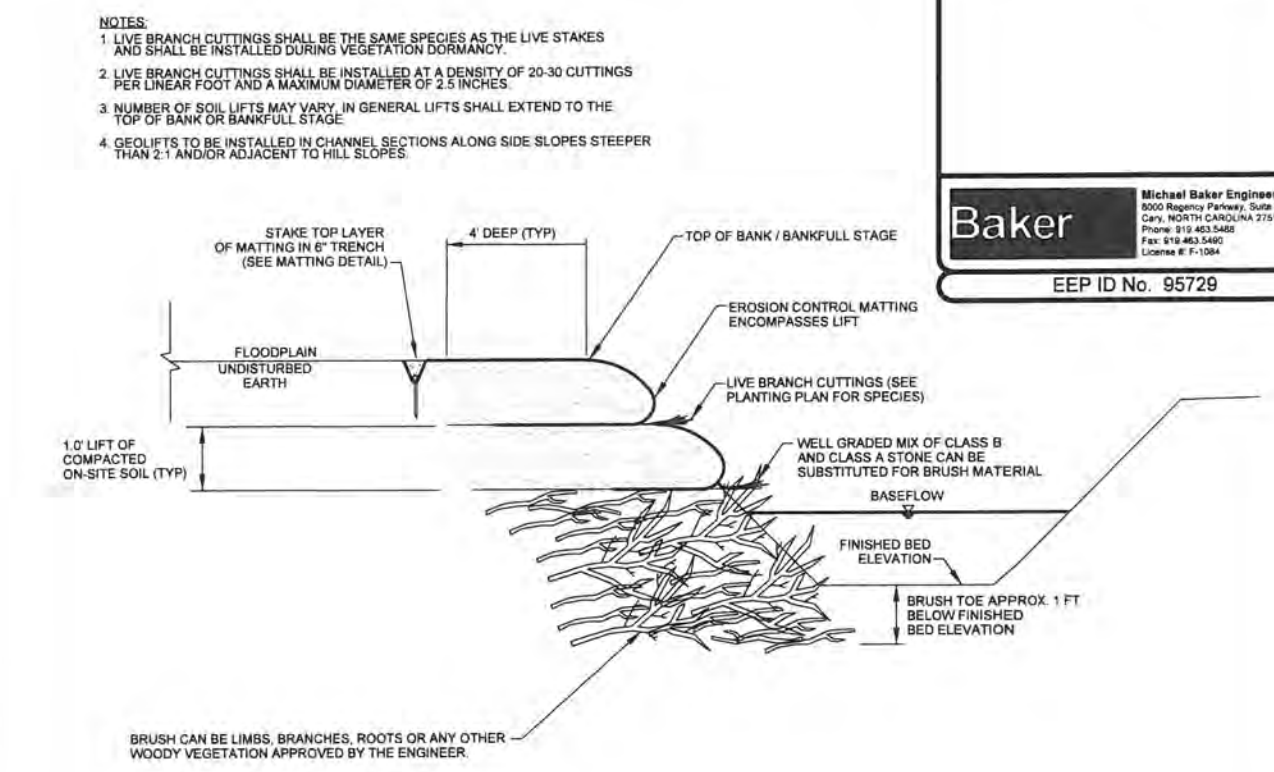


- NOTES:**
1. WHEN GEOLIFTS ARE BUILT ABOVE ROOTWAD CLUSTER, USE LARGE STONE BACKFILL BEHIND ROOT MASS TO BUILT FOUNDATION

### GRADE CONTROL LOG J-HOOK VANE

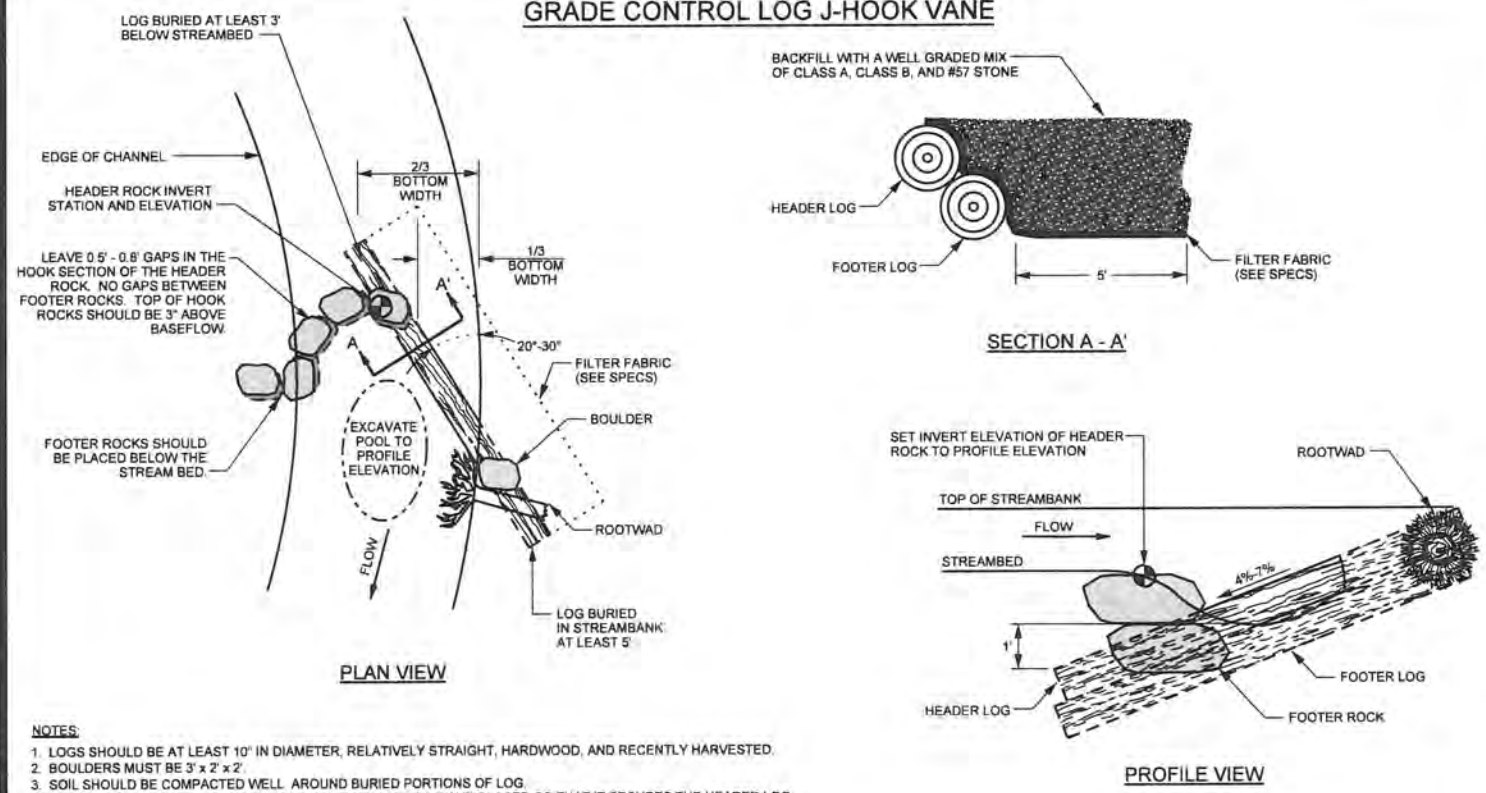

- NOTES:**
1. LOGS SHOULD BE AT LEAST 10" IN DIAMETER, RELATIVELY STRAIGHT, HARDWOOD, AND RECENTLY HARVESTED.
  2. BOULDERS MUST BE 3" x 2" x 2"
  3. SOIL SHOULD BE COMPACTED WELL AROUND BURIED PORTIONS OF LOG
  4. ROOTWADS SHOULD BE PLACED BENEATH THE HEADER LOG AND PLACED SO THAT IT SECURES THE HEADER LOG INTO THE BANK. SEE ROOTWAD DETAIL.
  5. BOULDERS SHOULD BE PLACED ON TOP OF HEADER LOG FOR ANCHORING.
  6. HEADER BOULDERS TO BE PLACED 0.5 TO 0.8 FEET APART.
  7. NON-WOVEN FILTER FABRIC SHOULD BE NAILED TO THE LOG BELOW THE BACKFILL.
  8. FOOTERS SHALL BE INSTALLED SUCH THAT 1/4 TO 1/3 OF THE LENGTH IS DOWNSTREAM OF THE HEADER.


### PERMANENT FORD STREAM CROSSING

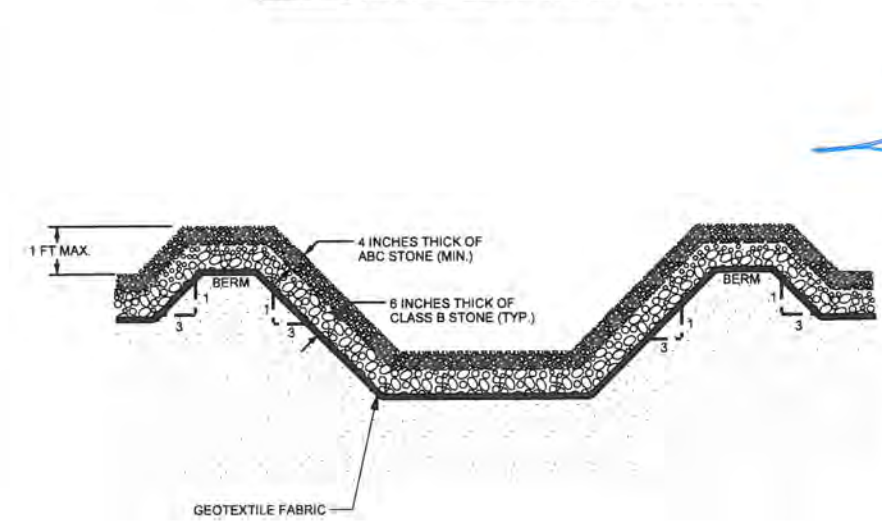

- NOTES:**
1. CONSTRUCT STREAM CROSSING WHEN FLOW IS LOW
  2. HAVE ALL NECESSARY MATERIALS AND EQUIPMENT ON-SITE BEFORE WORK BEGINS
  3. MINIMIZE CLEARING AND EXCAVATION OF STREAMBANKS. DO NOT EXCAVATE CHANNEL BOTTOM. COMPLETE ONE SIDE BEFORE STARTING ON THE OTHER SIDE.
  4. INSTALL STREAM CROSSING AT RIGHT ANGLE TO THE FLOW.
  5. GRADE SLOPES TO A 3:1 SLOPE. TRANSPLANT SOD FROM ORIGINAL STREAMBANK ONTO SIDE SLOPES.
  6. MAINTAIN CROSSING SO THAT RUNOFF IN THE CONSTRUCTION ROAD DOES NOT ENTER EXISTING CHANNEL.
  7. A STABILIZED PAD OF STONE BACKFILL, 6 INCHES THICK, LINED WITH GEOTEXTILE FABRIC SHALL BE USED OVER THE BERM AND ACCESS SLOPES.
  8. WIDTH OF THE CROSSING SHALL BE SUFFICIENT TO ACCOMMODATE THE LARGEST VEHICLE CROSSING THE CHANNEL.
  9. CONTRACTOR SHALL DETERMINE AN APPROPRIATE RAMP ANGLE ACCORDING TO EQUIPMENT UTILIZED.




I:\Projects\132700\Design\Plans\As-Built\132700\_AB\_PSH\_2D.dgn  
 mcorley  
 UTCAMECR 95729 AB BAKER FINAL

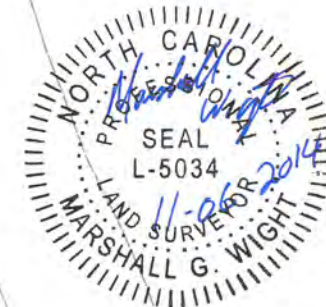

2/25/03




N/F  
ELWOOD PAUL & SHELBY McBANE  
DB 3/6 PG 221  
PN: 3707574849

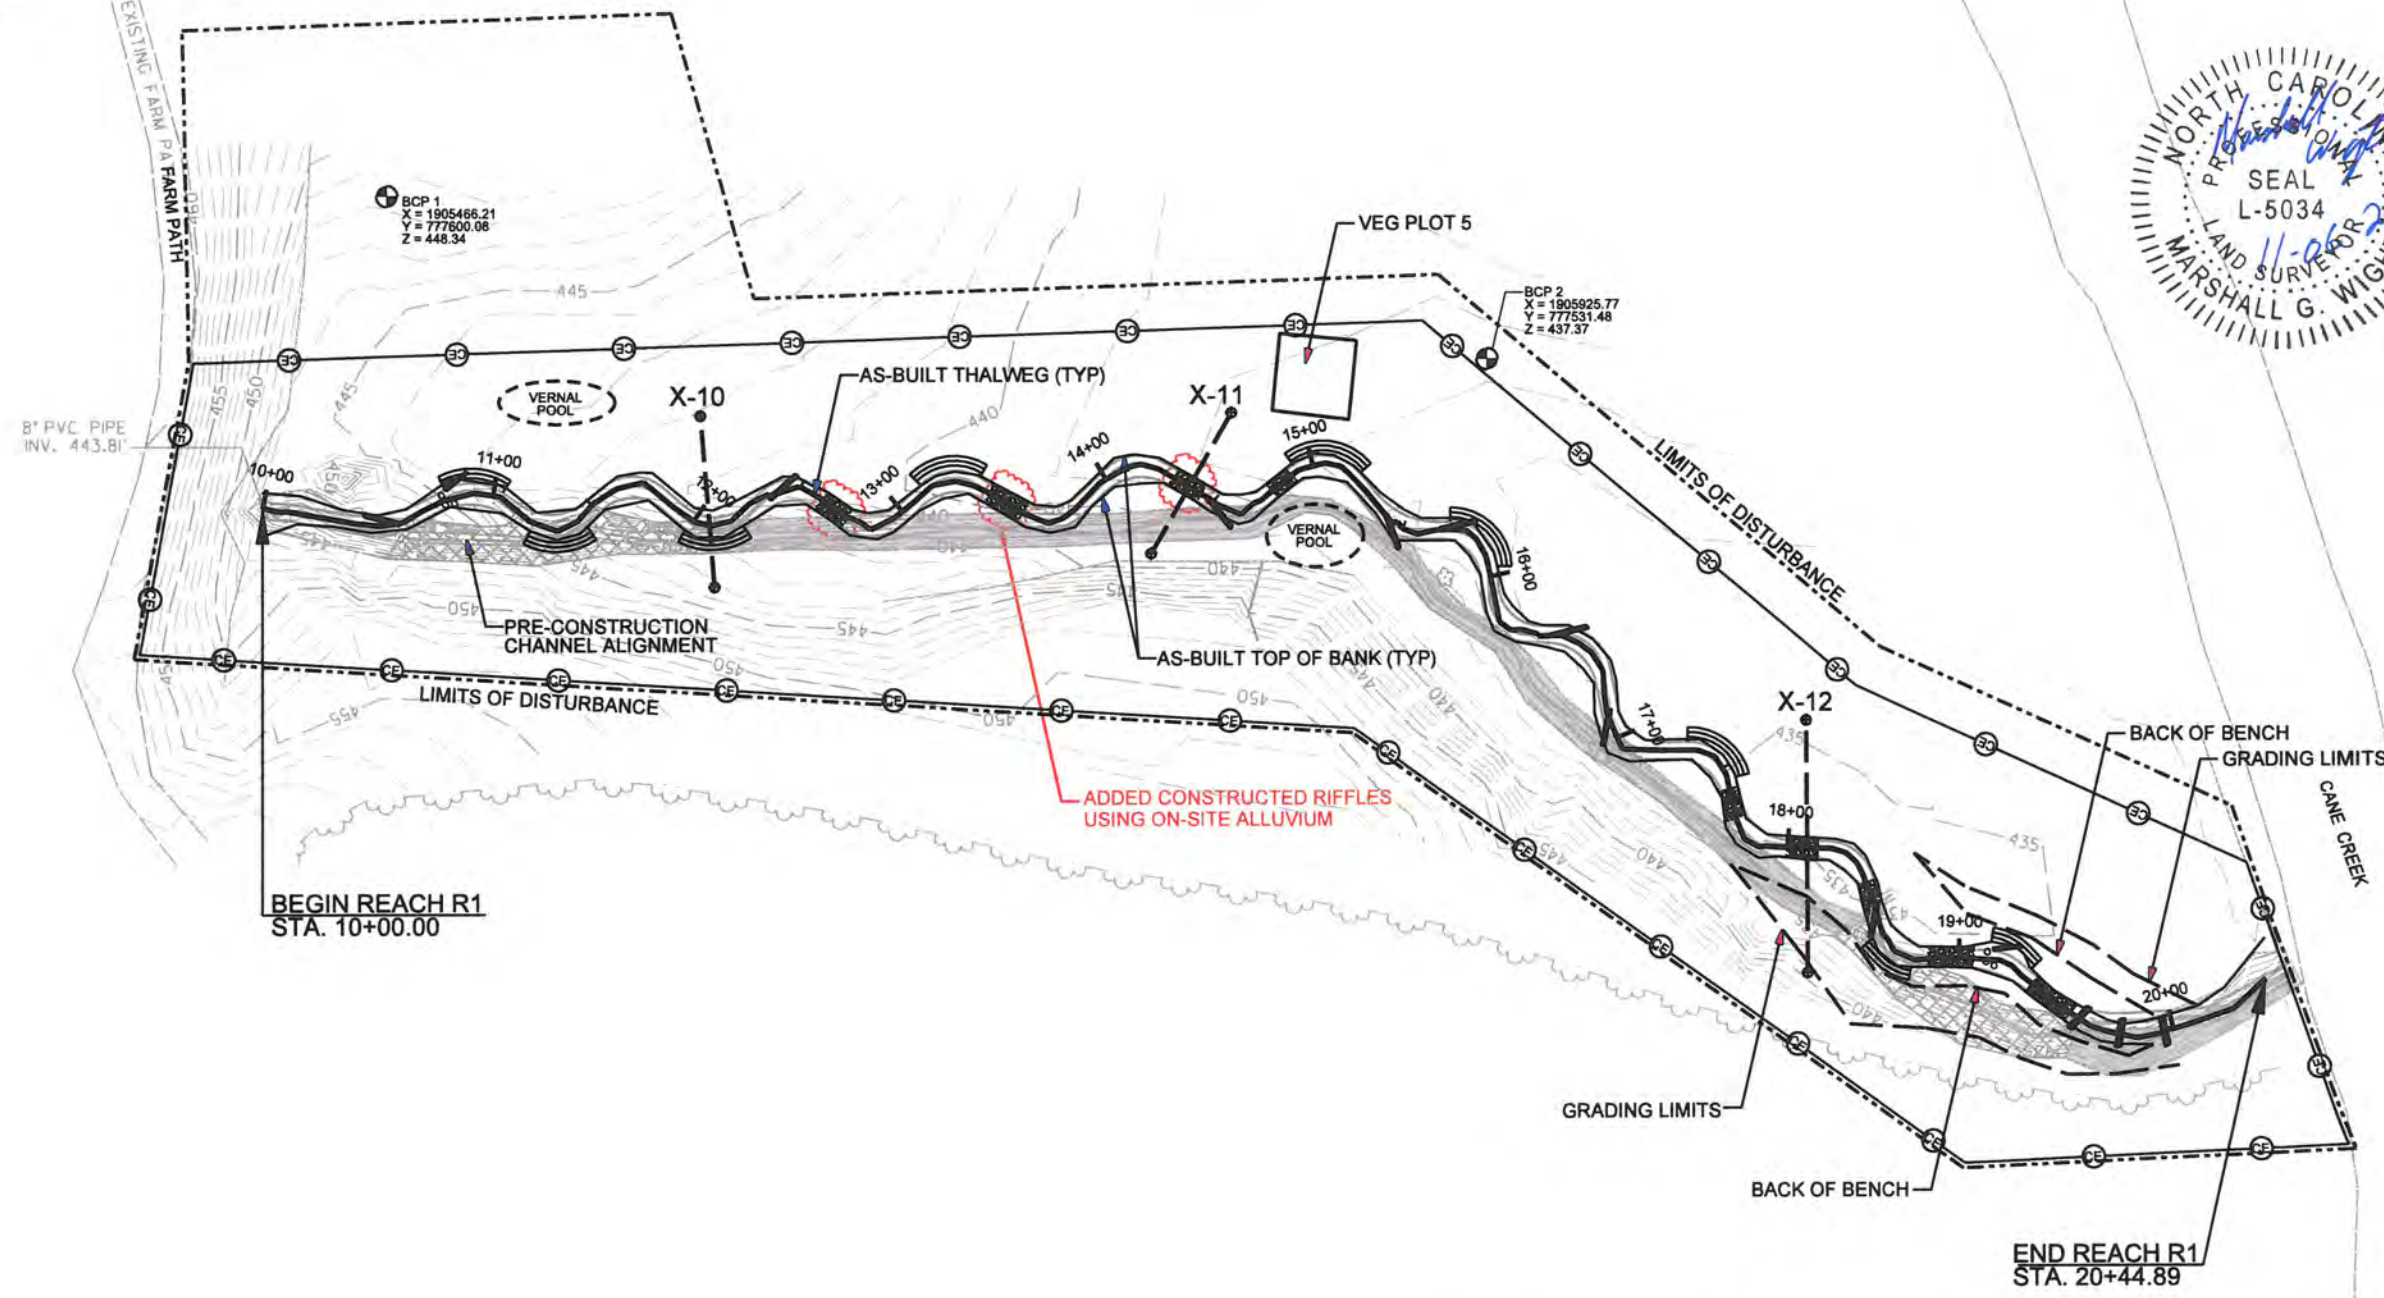


BEGIN REACH R1  
STA. 10+00.00


END REACH R1  
STA. 20+44.89

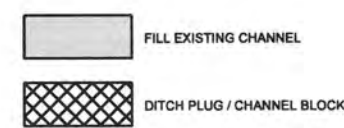

- NOTES:
1. CONTOURS SHOWN ARE PRE-RESTORATION.
  2. FENCE LOCATIONS SHOWN ARE APPROXIMATE AND INSTALLED OUTSIDE OF THE CONSERVATION EASEMENT BOUNDARY.

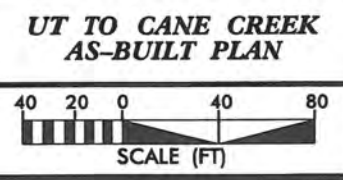

R:\132700\Design\Plans\As-Built\132700\_AB\_PSH\_03.dgn  
 mcorley  
 UTCANECKR 95729 AB BAKER FINAL

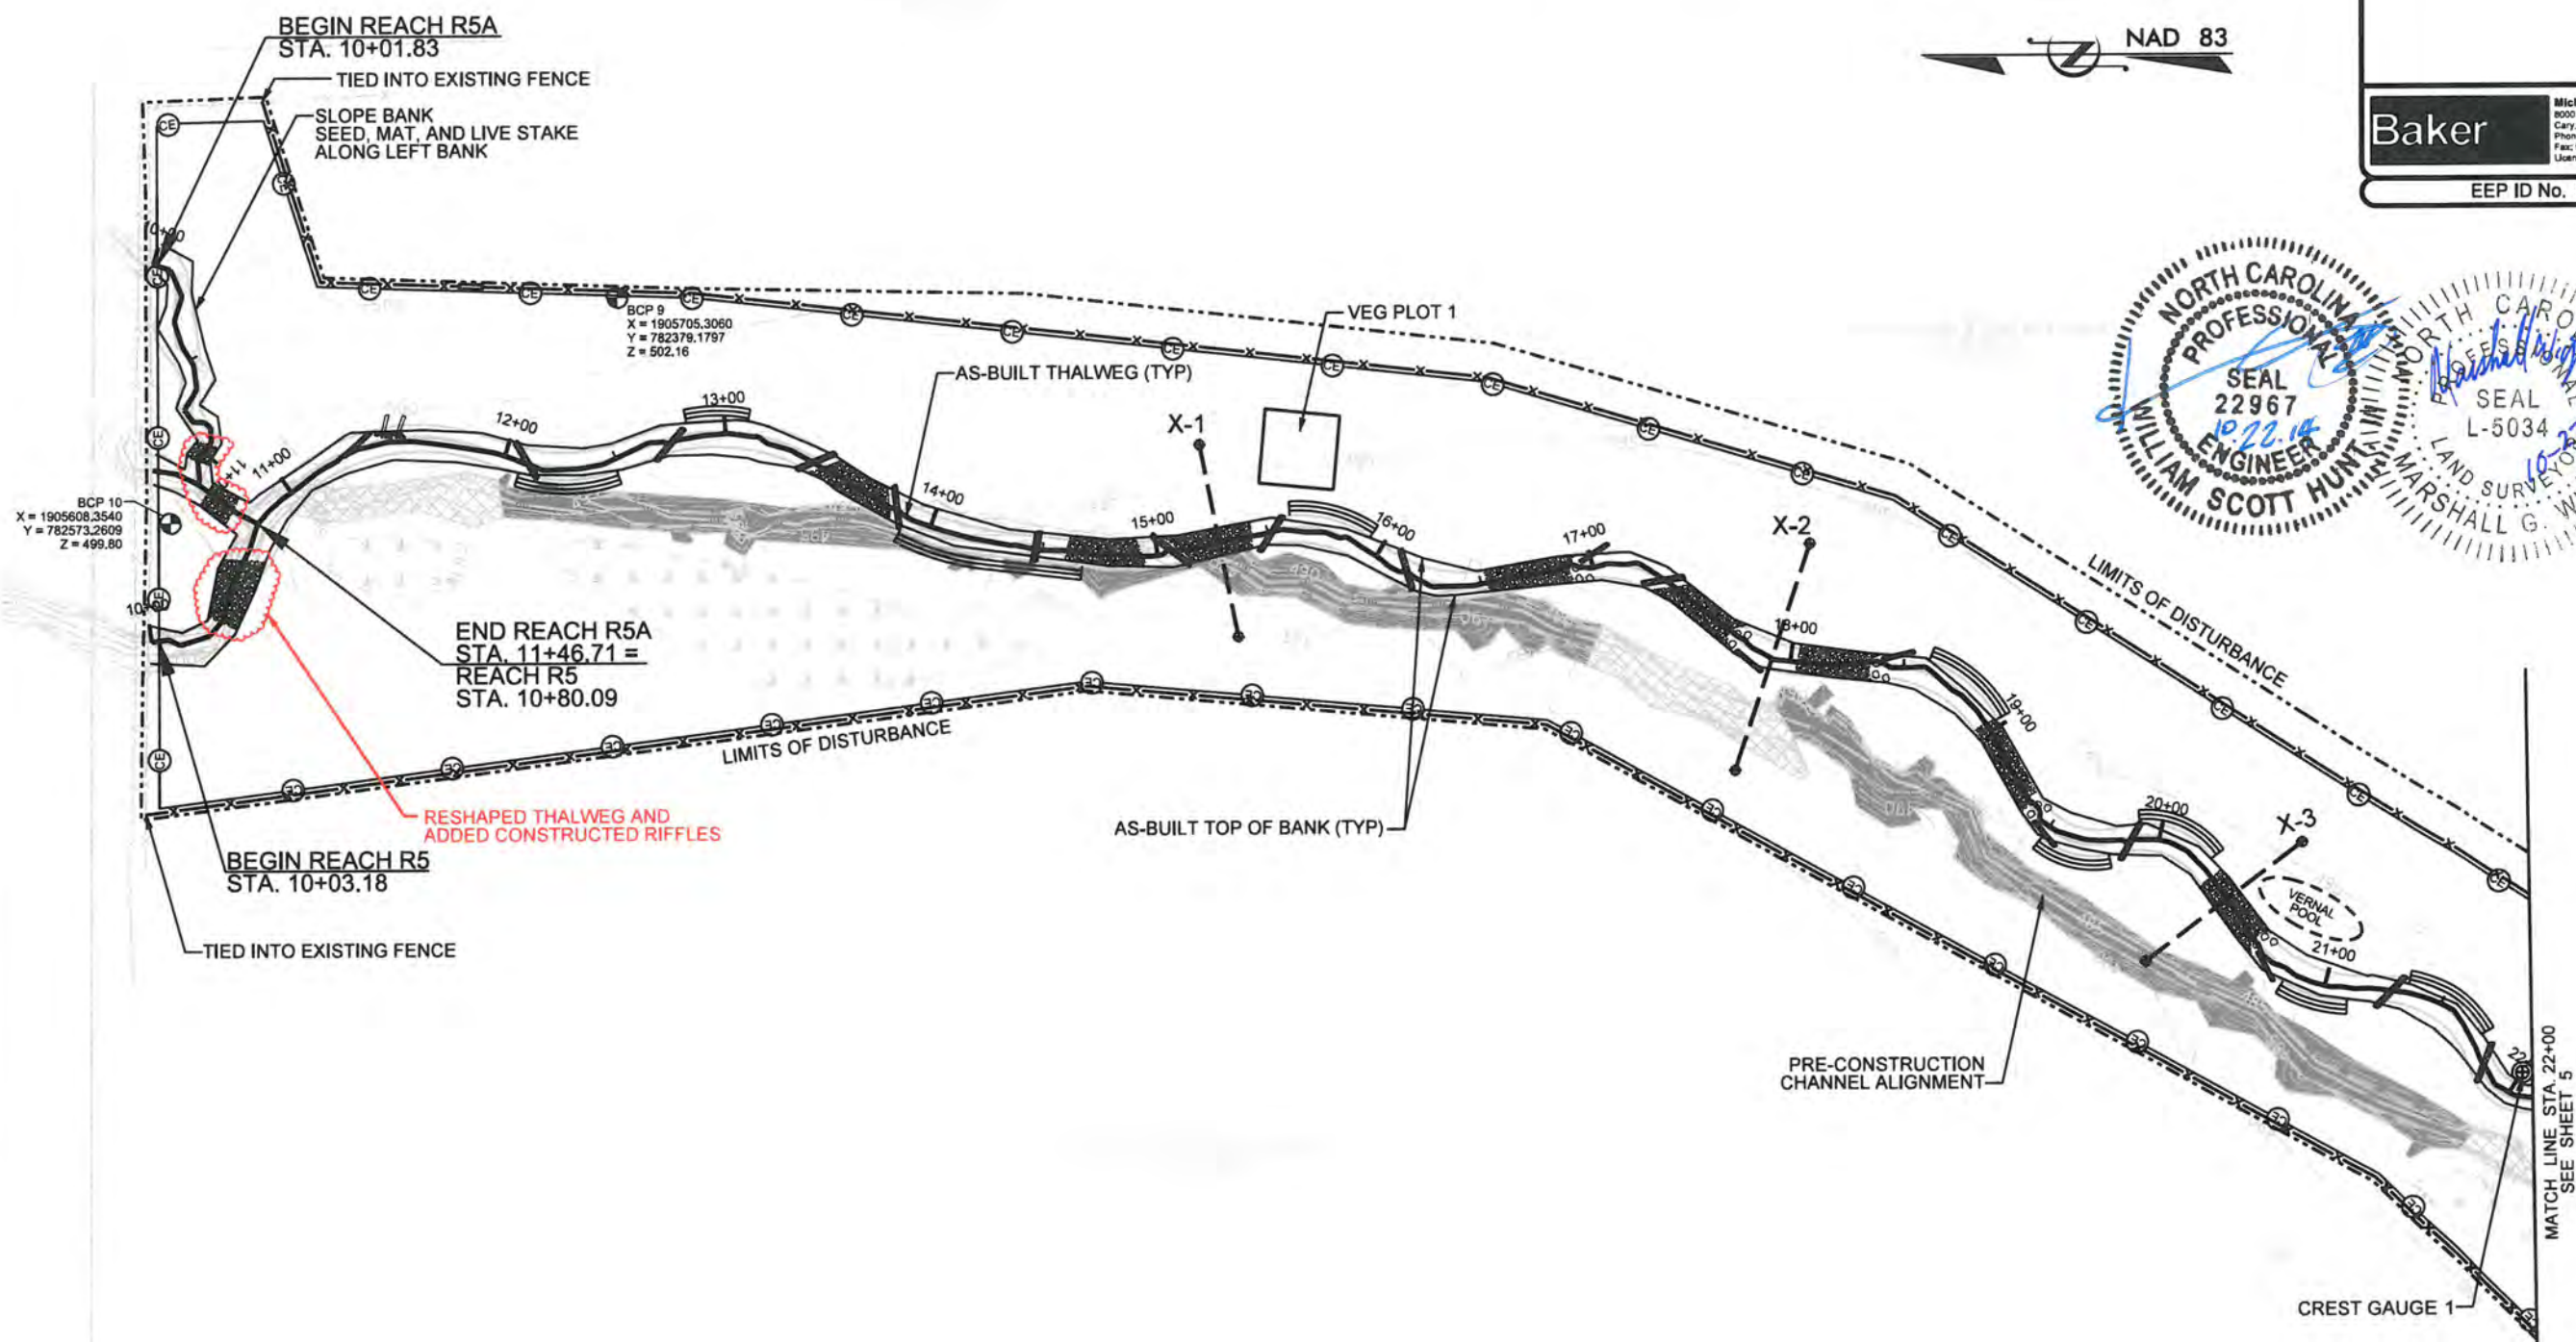

BCP 10  
X = 1905608.3540  
Y = 782573.2609  
Z = 499.80



BCP 9  
X = 1905705.3060  
Y = 782379.1797  
Z = 502.16

END REACH R5A  
STA. 11+46.71 =  
REACH R5  
STA. 10+80.09

BEGIN REACH R5  
STA. 10+03.18



MATCH LINE STA. 22+00  
SEE SHEET 5

- NOTES:**
1. CONTOURS SHOWN ARE PRE-RESTORATION.
  2. FENCE LOCATIONS SHOWN ARE APPROXIMATE AND INSTALLED OUTSIDE OF THE CONSERVATION EASEMENT BOUNDARY.

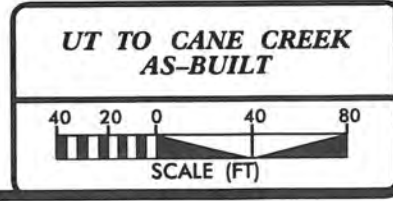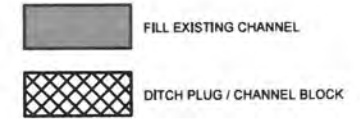


I:\132700\Design\Plans\As-Built\132700\_AB\_PSH\_04.dgn  
 mcbrey  
 UTCANECR 95729 AB BAKER FINAL

2/26/03

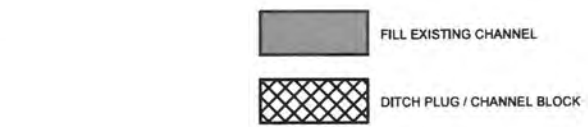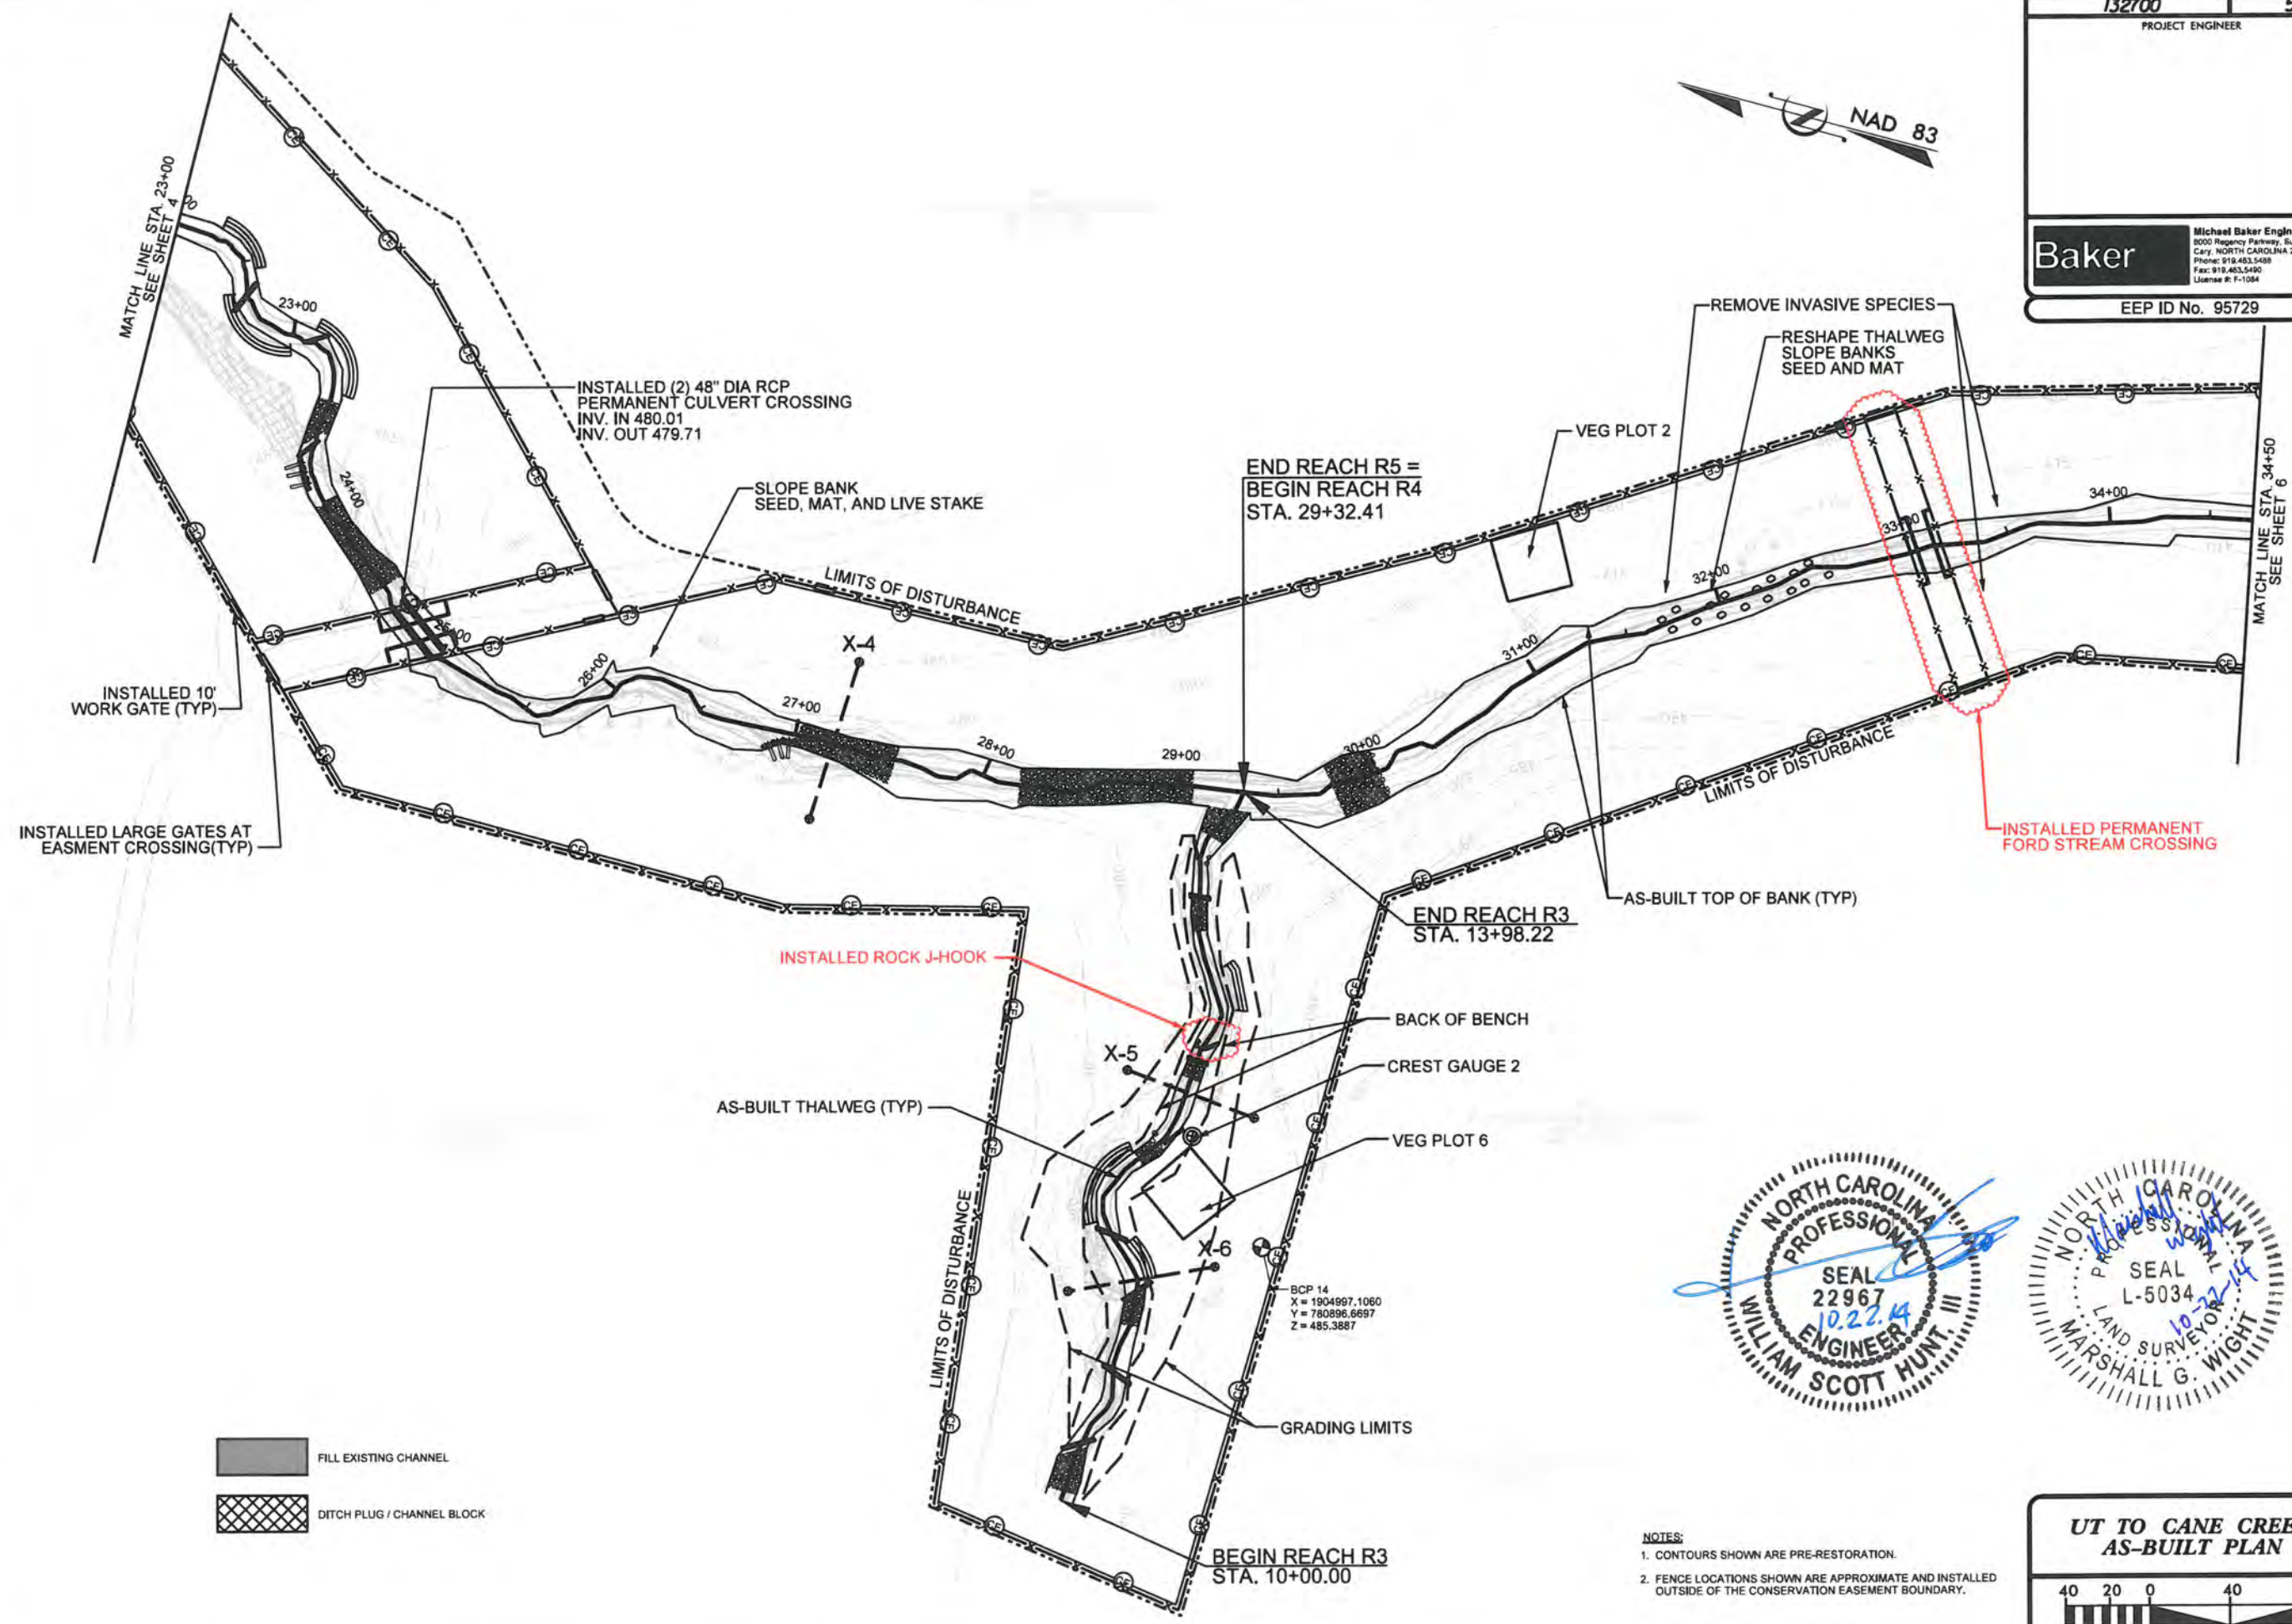


- NOTES:**
1. CONTOURS SHOWN ARE PRE-RESTORATION.
  2. FENCE LOCATIONS SHOWN ARE APPROXIMATE AND INSTALLED OUTSIDE OF THE CONSERVATION EASEMENT BOUNDARY.

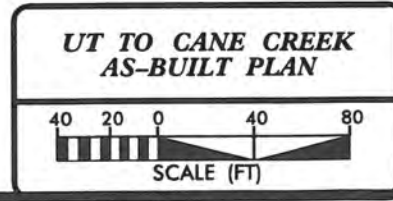

R:\132700\Design\PI\ems\As-Built\132700\_AB\_PSH\_05.dgn  
 UTCANEGR 95729 AB\_BAKER\_FINAL

2/25/03

BAKER PROJECT REFERENCE NO.	SHEET NO.
132700	6
PROJECT ENGINEER	
<b>Baker</b>	
<small>Michael Baker Engineering Inc.        8000 Regency Parkway, Suite 600        Cary, NORTH CAROLINA 27518        Phone: 919.483.5488        Fax: 919.483.5490        License #: F-1054</small>	
EEP ID No. 95729	

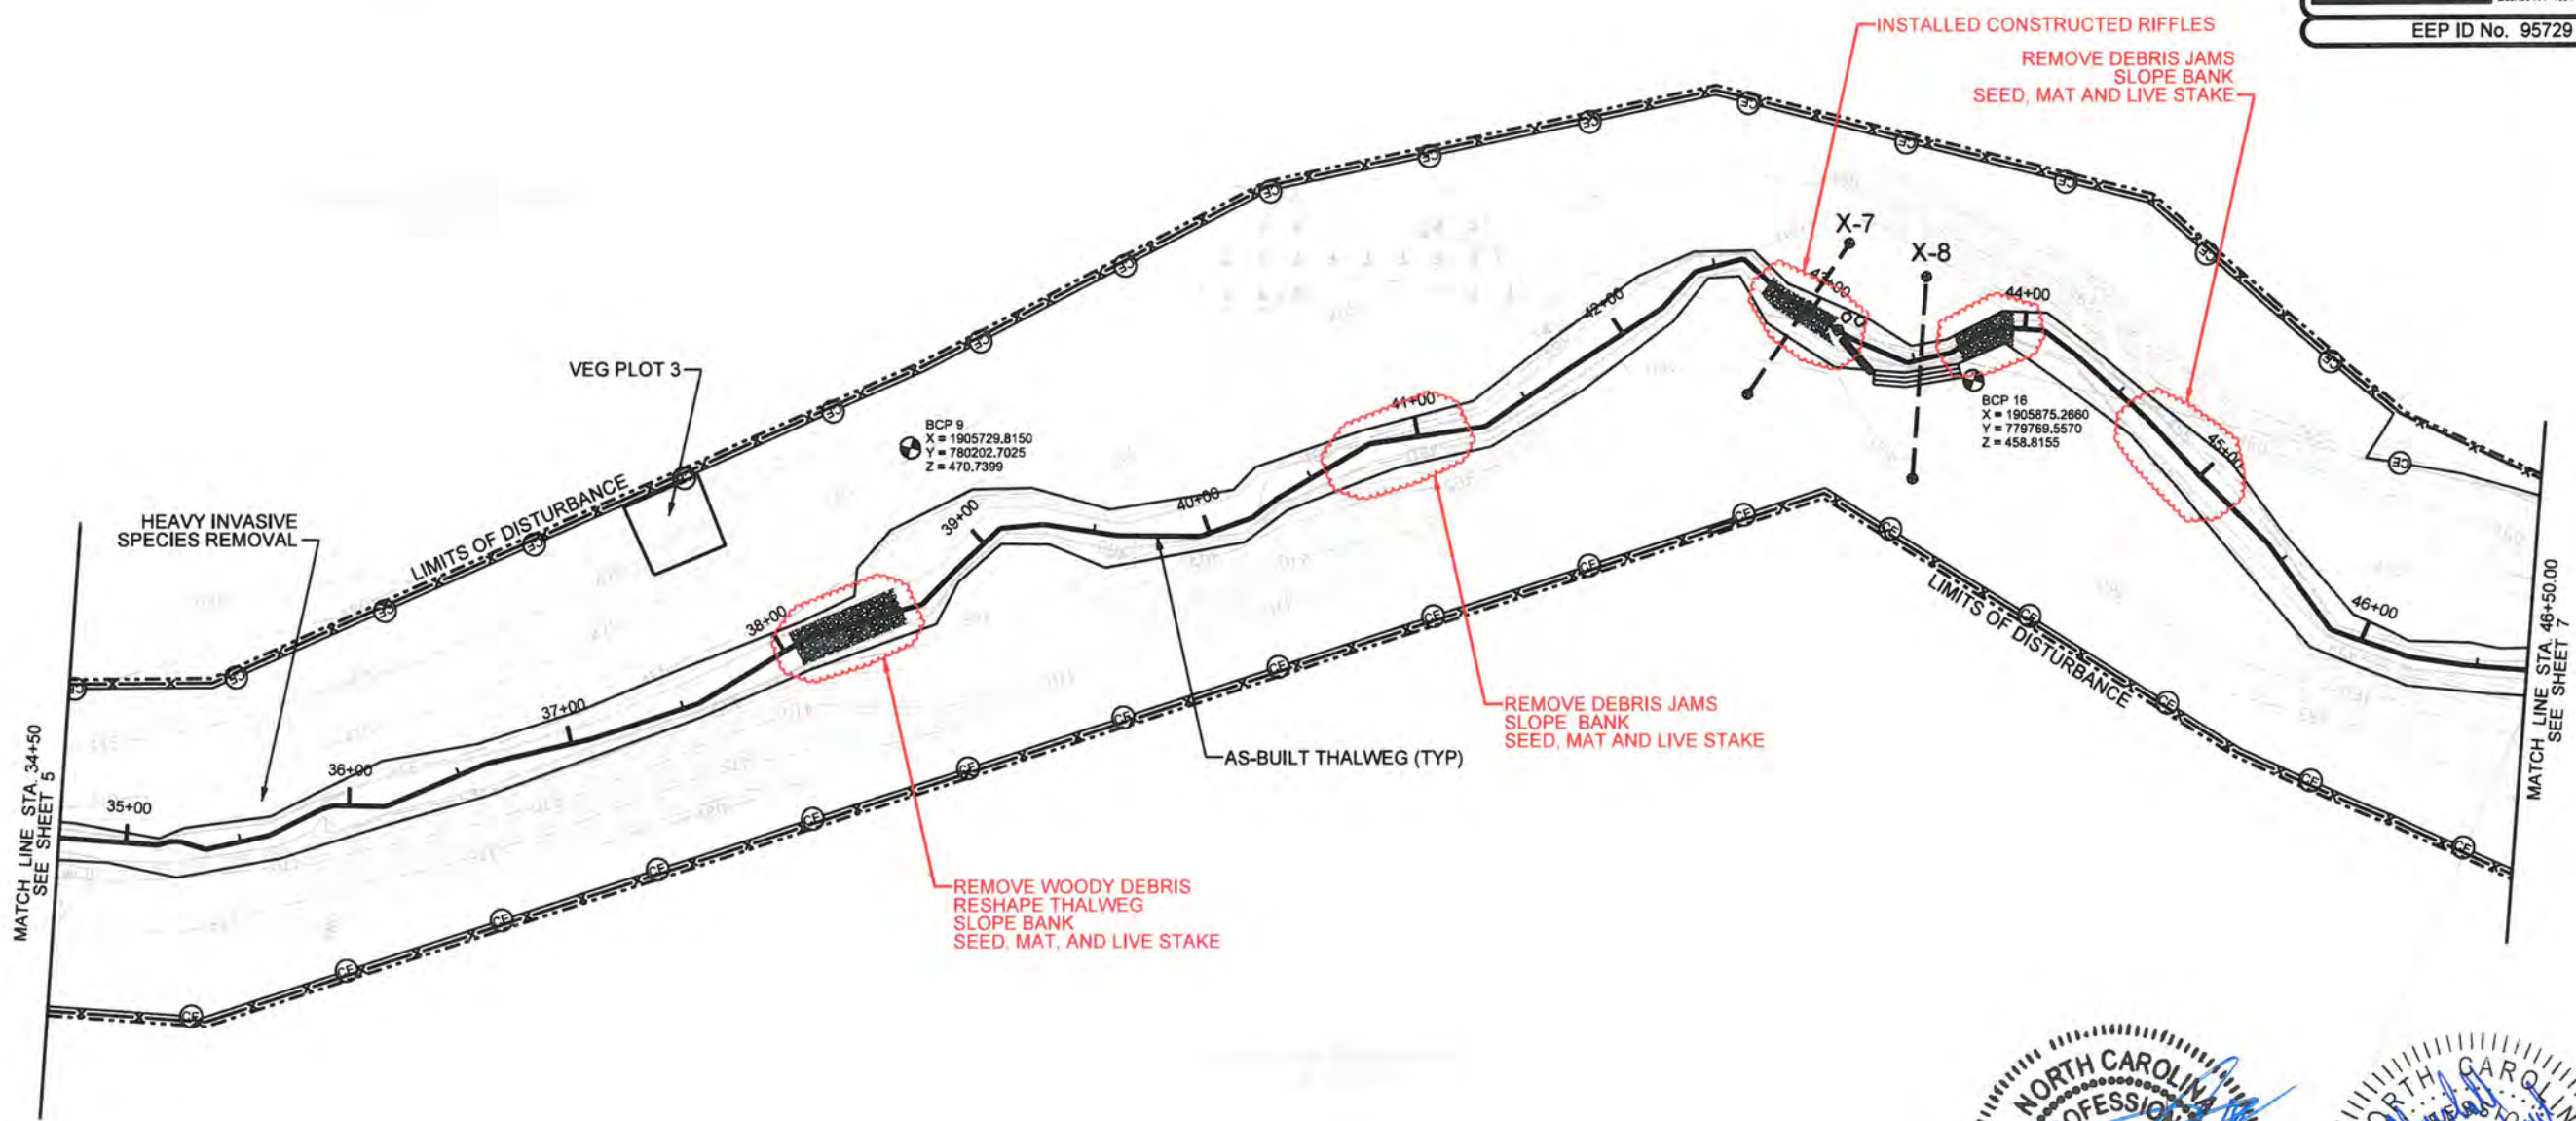


I:\Projects\132700\Design\Plans\As-Built\132700\_AB\_PSH\_06.dgn  
 mcarre  
 UTCANECR 95729 AB\_BAKER\_FINAL



- NOTES:**
1. CONTOURS SHOWN ARE PRE-RESTORATION.
  2. FENCE LOCATIONS SHOWN ARE APPROXIMATE AND INSTALLED OUTSIDE OF THE CONSERVATION EASEMENT BOUNDARY.

**UT TO CANE CREEK  
AS-BUILT PLAN**

SCALE (FT)

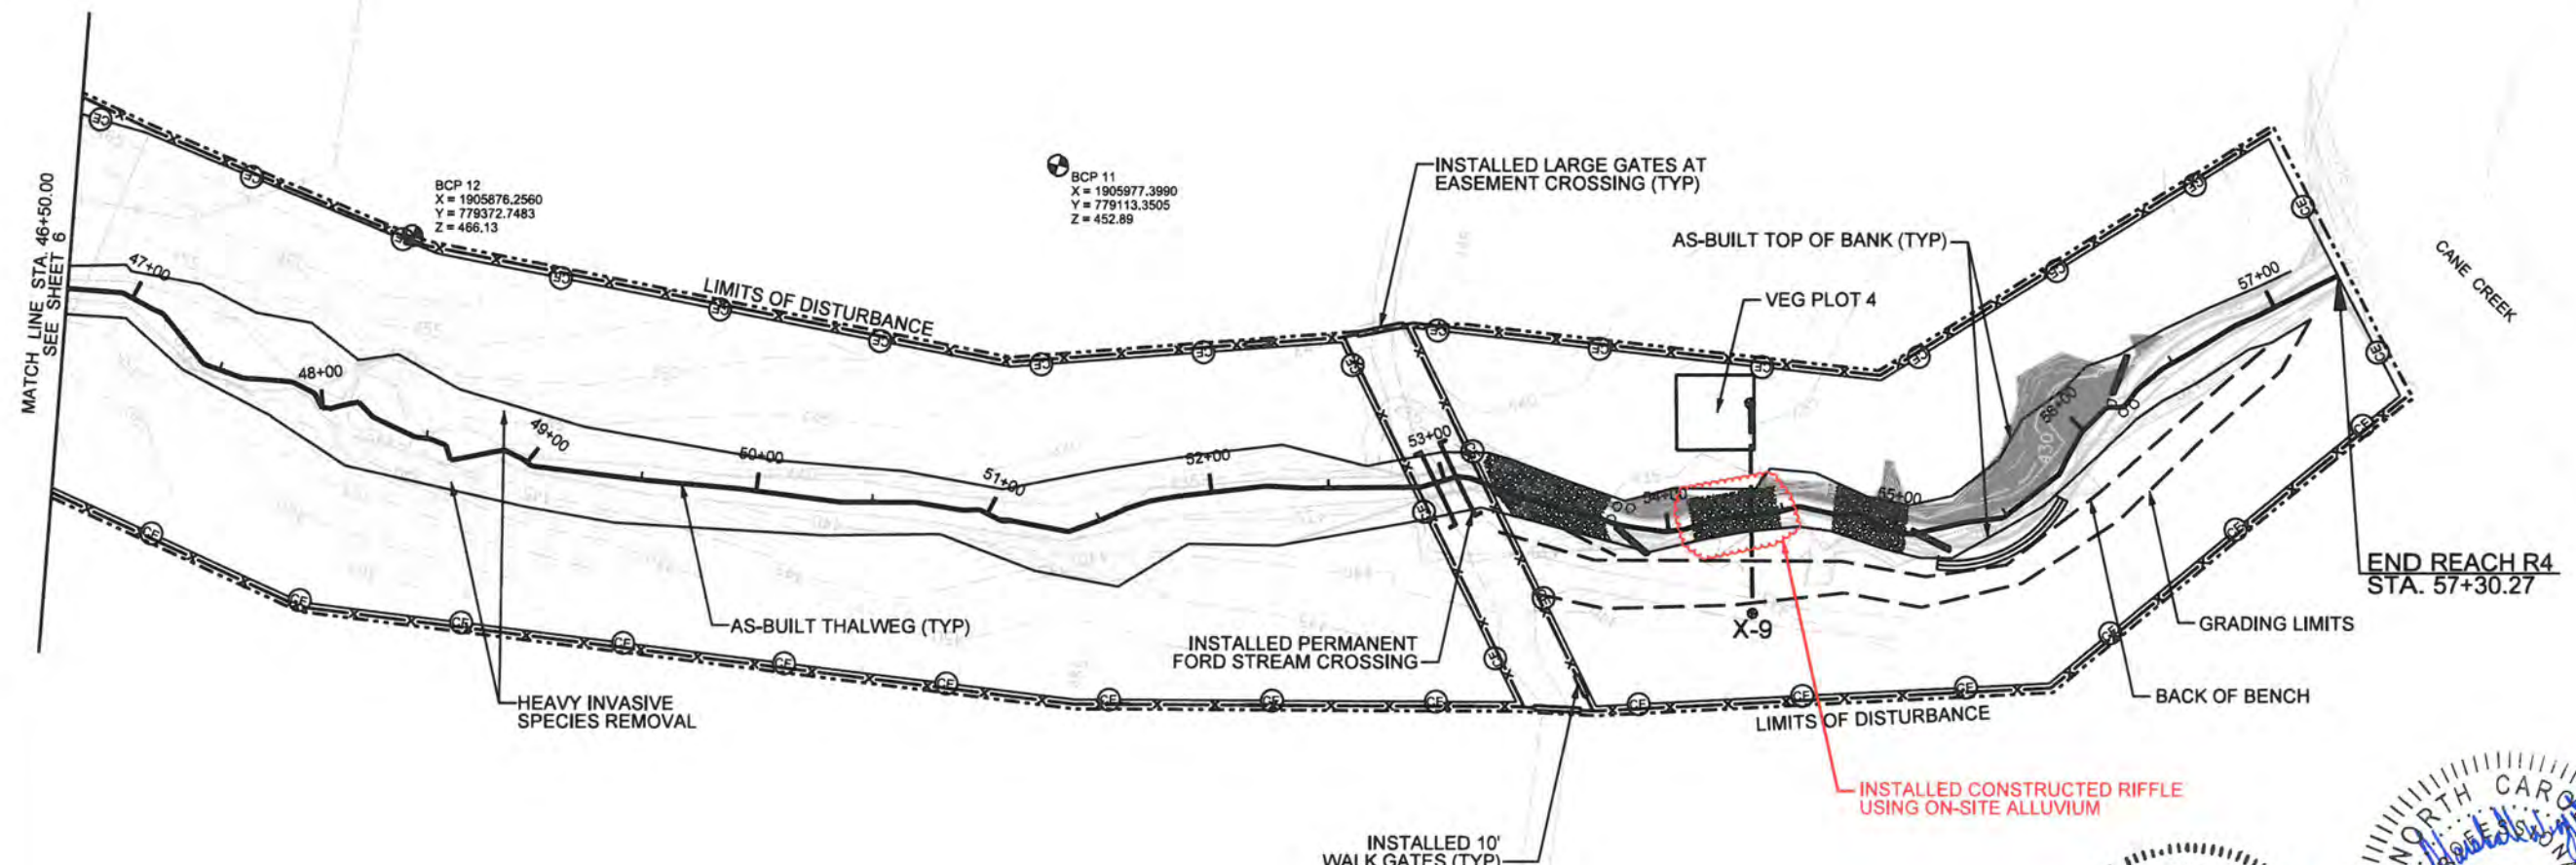


END REACH R4  
STA. 57+30.27



FILL EXISTING CHANNEL

- NOTES:**
1. CONTOURS SHOWN ARE PRE-RESTORATION.
  2. FENCE LOCATIONS SHOWN ARE APPROXIMATE AND INSTALLED OUTSIDE OF THE CONSERVATION EASEMENT BOUNDARY.

**UT TO CANE CREEK  
AS-BUILT PLAN**




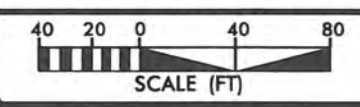


I:\Projects\132700\Design\Plans\As-Built\132700\_AB\_PSH\_07.dgn  
 mcbreu  
 UTCANECR 95729 AB\_BAKER\_FINAL

2/26/03

**Baker**  
Michael Baker Engineering Inc.  
8500 Regency Parkway, Suite 800  
Cary, NORTH CAROLINA 27518  
Phone: 919.463.5488  
Fax: 919.463.5490  
License #: P-1084

EEP ID No. 95729

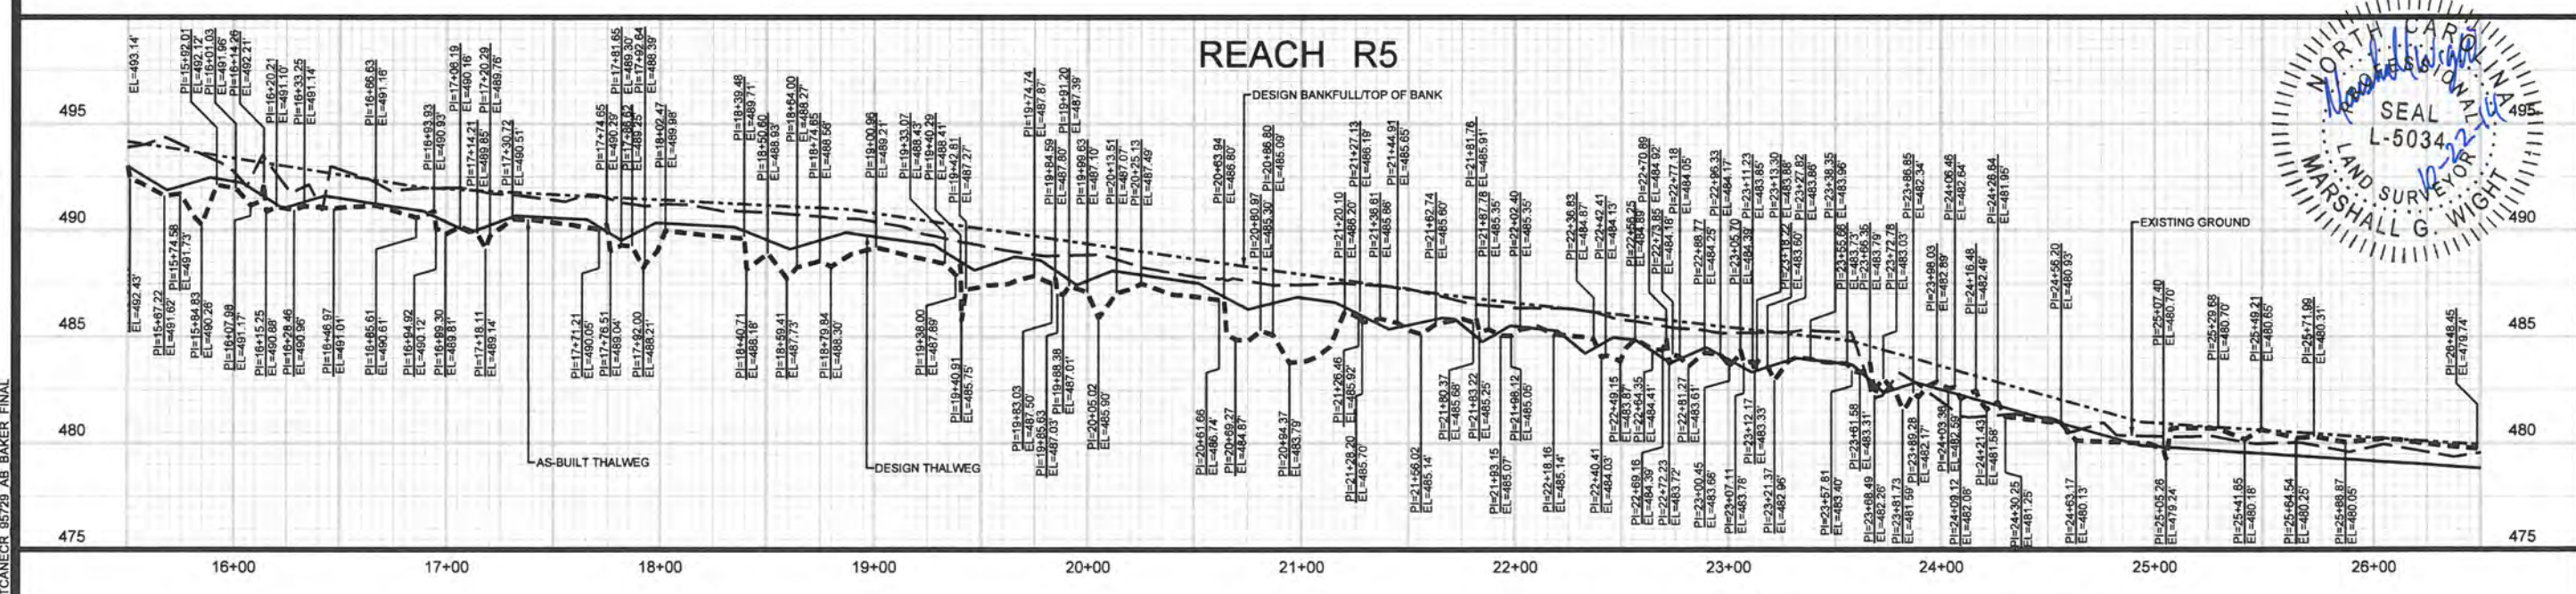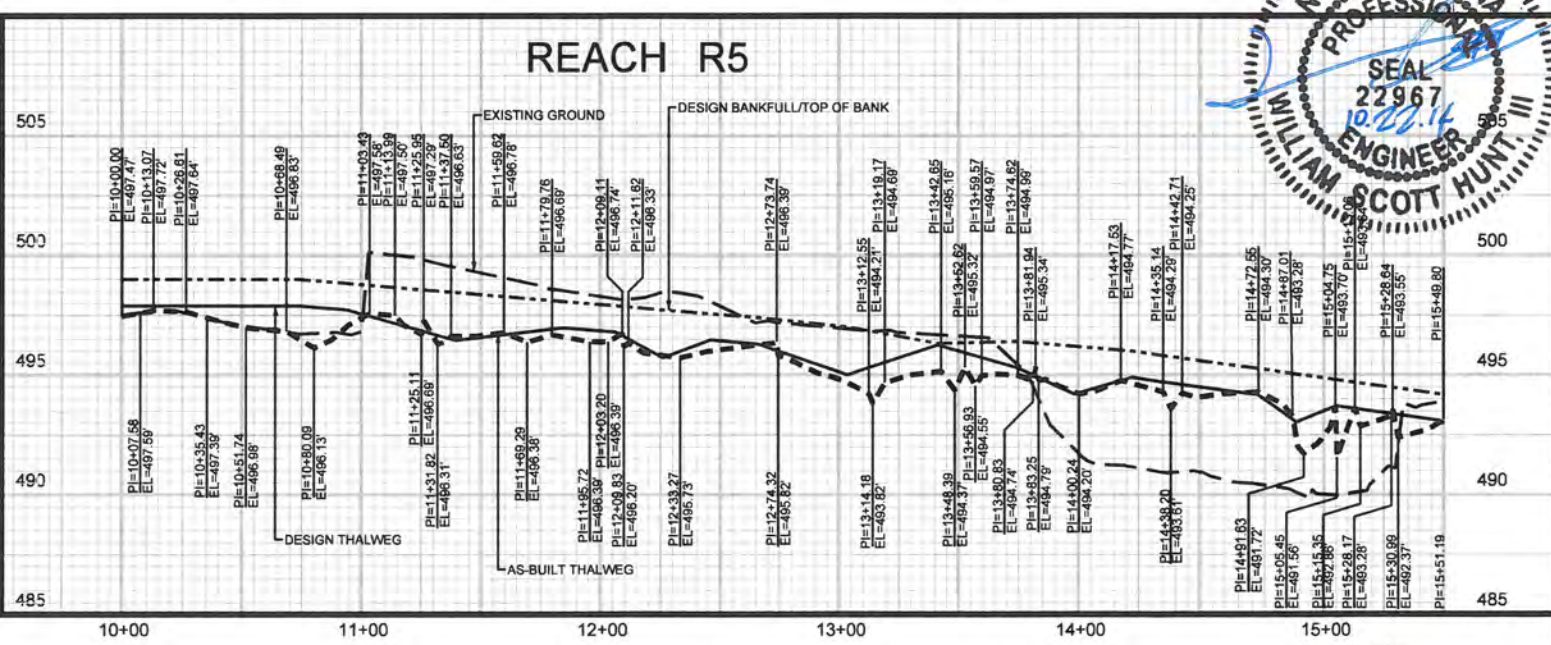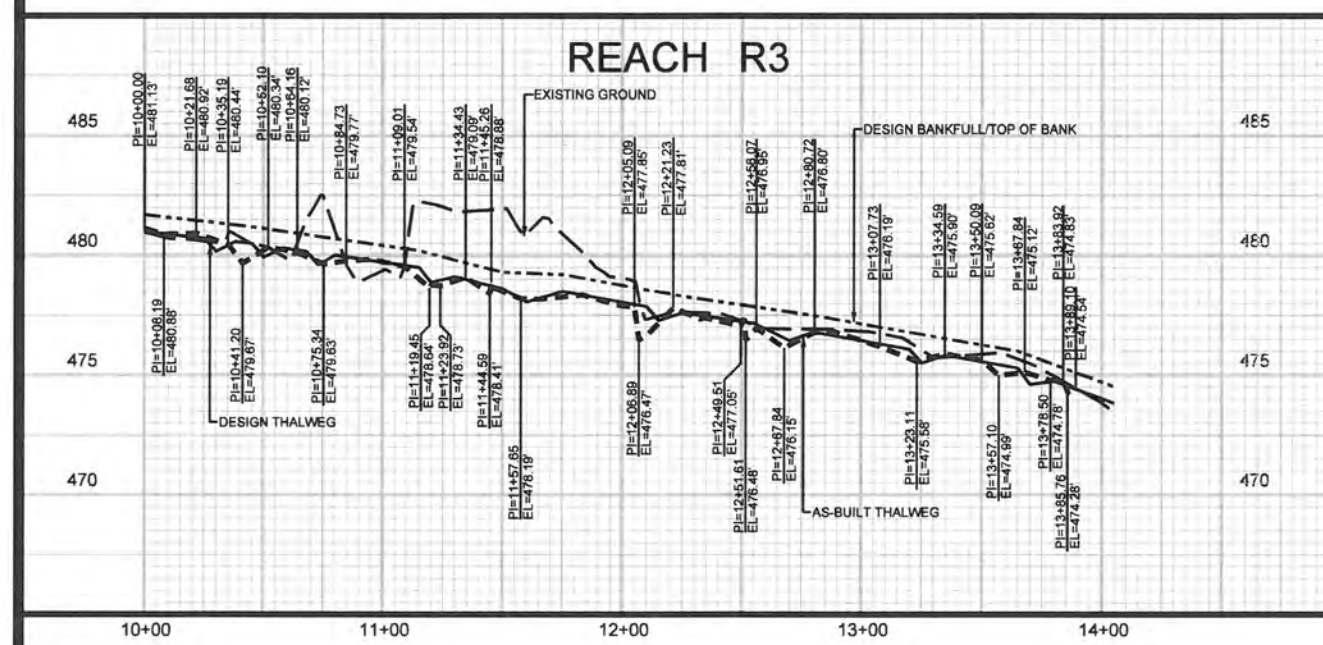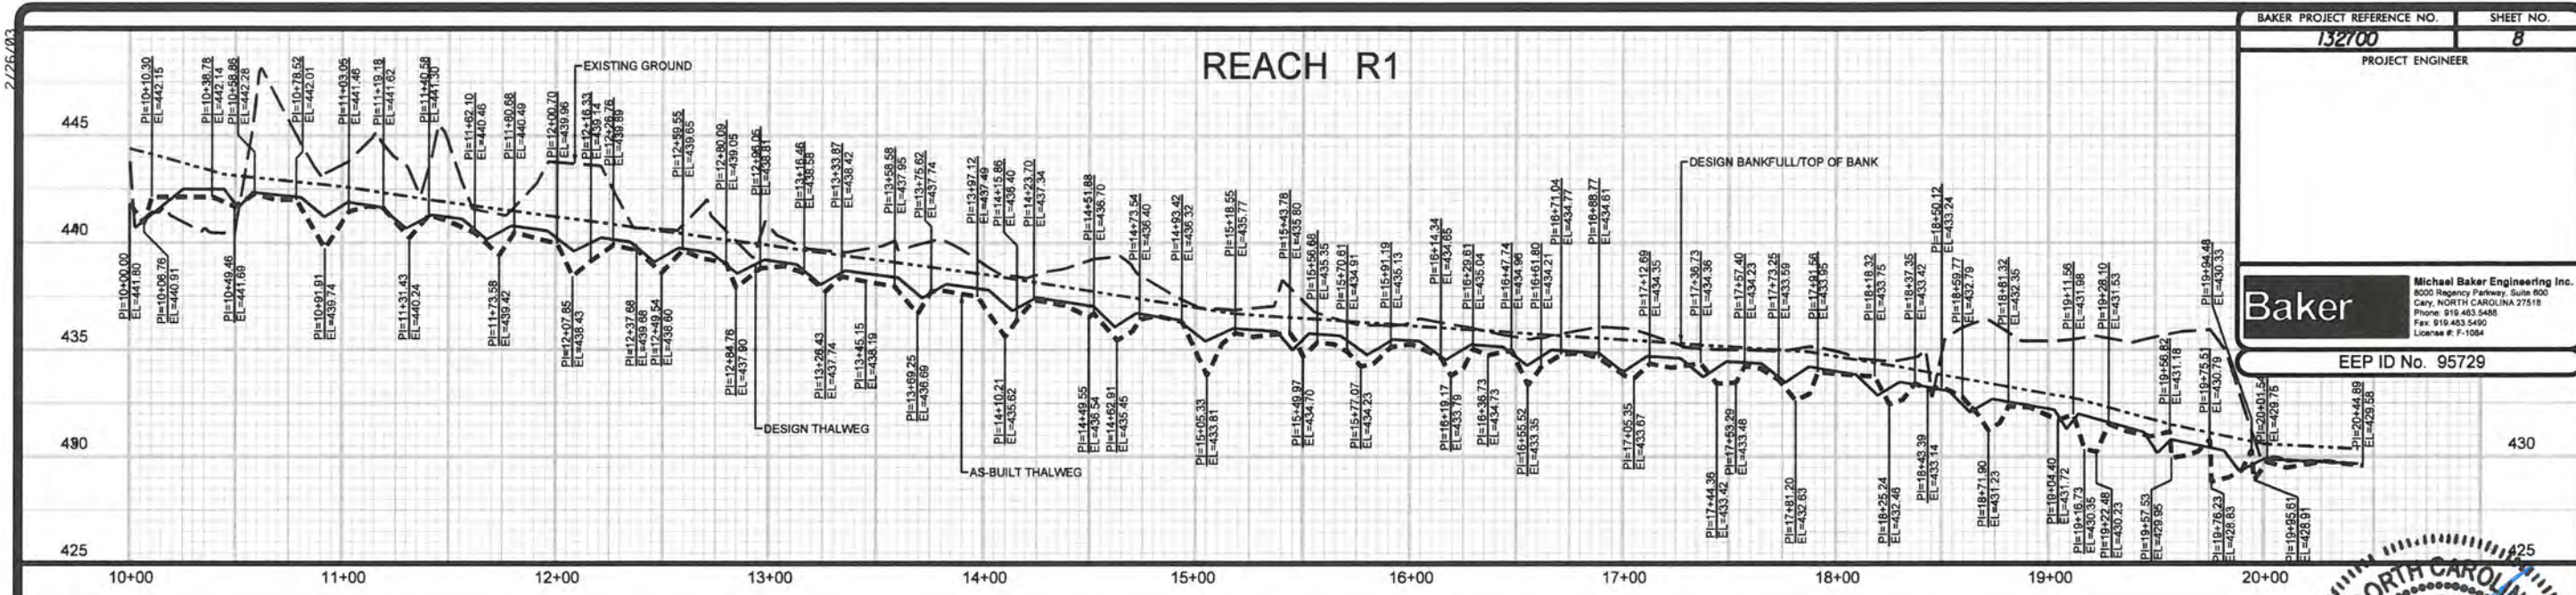


R:\132700\Design\Plans\As-Built\132700\_AB\_PFL\_08.dgn  
 8/19/14 4:00 AM  
 UTCANEER 95729 AB BAKER FINAL




EEP ID No. 95729


### REACH R4-5

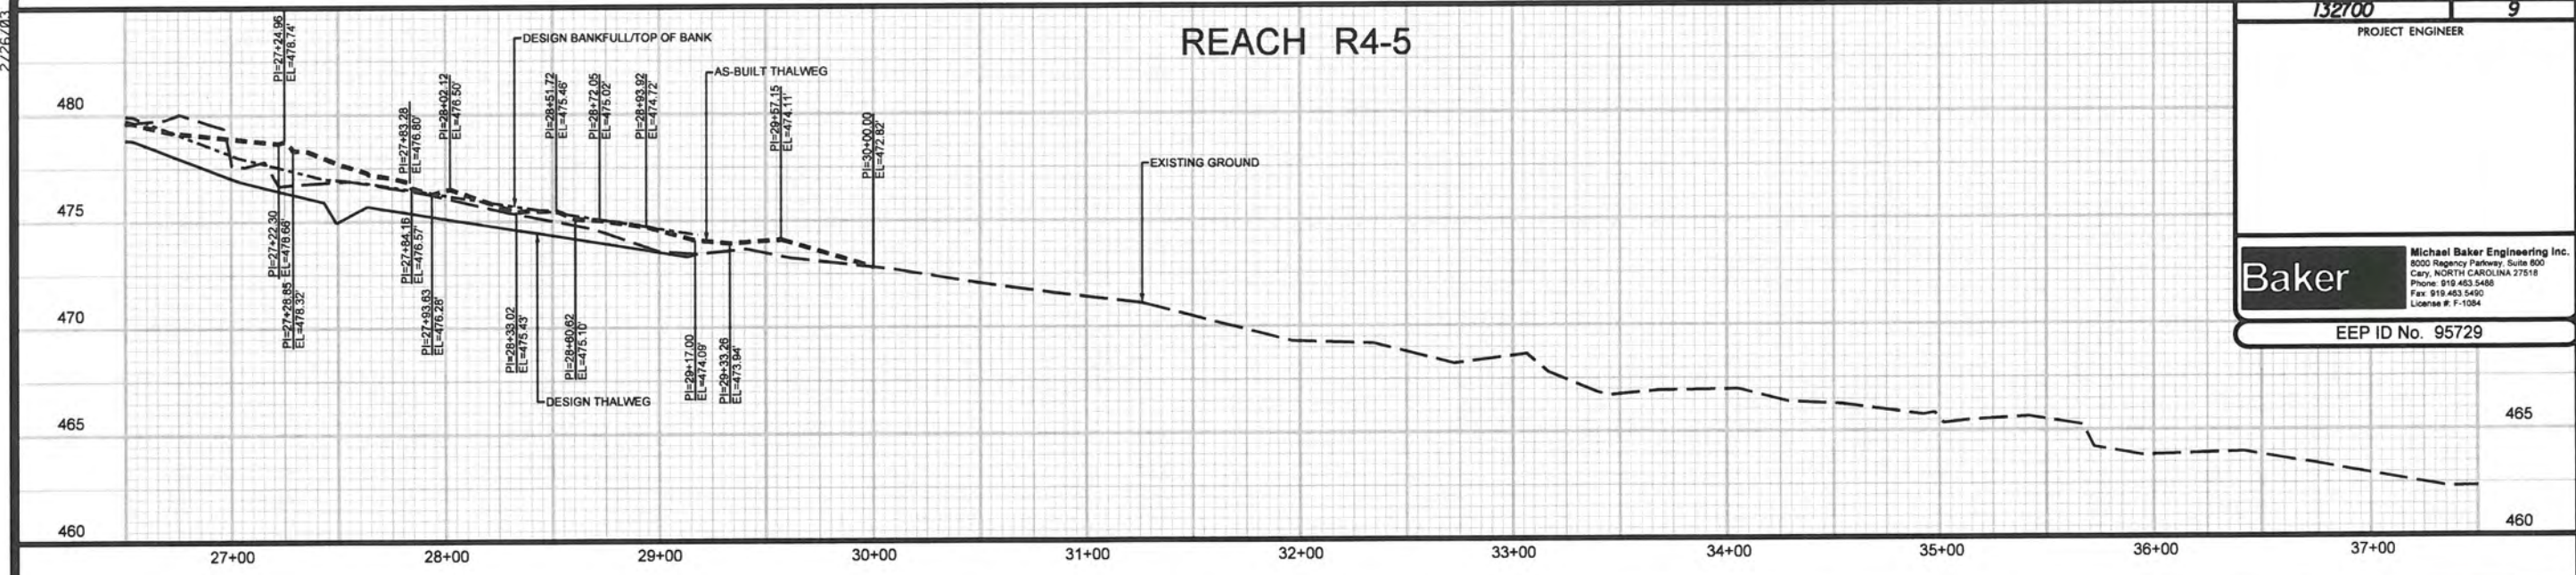

### REACH R4 ( ENHANCEMENT ONLY )

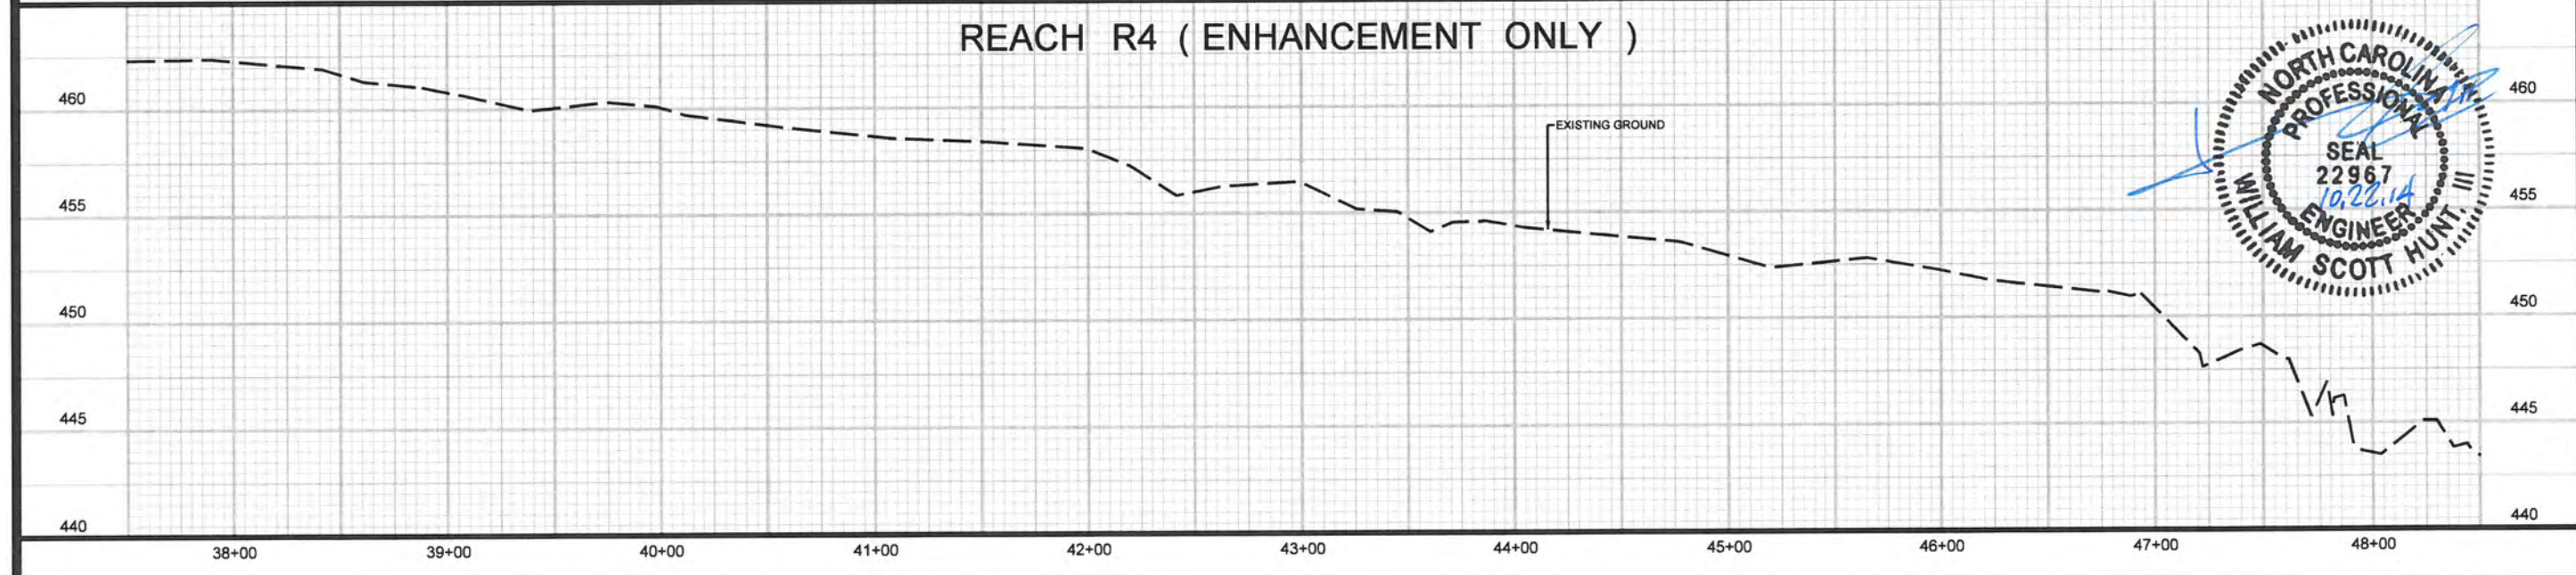

### REACH R4

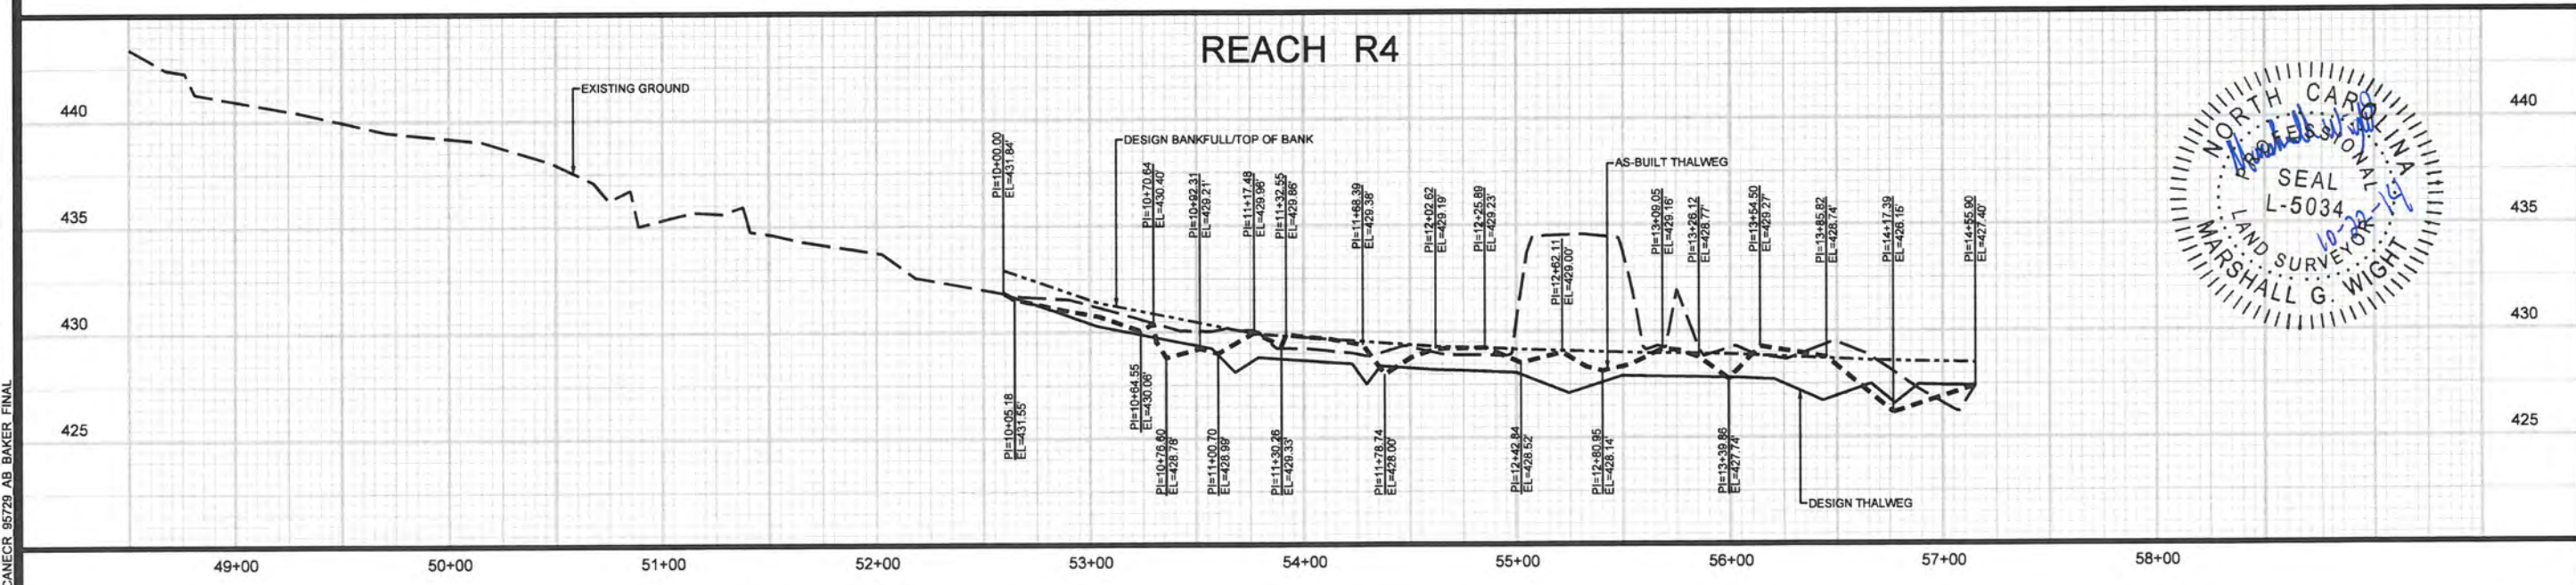

I:\Projects\Design\Plans\As-Built\132700\_AB\_PFL\_09.dgn  
 8/10/2011 10:01 AM  
 UTCANECR 95729 AB BAKER FINAL