

Valley Fields Stream and Wetland Restoration Monitoring Baseline Report

Davidson County, North Carolina

USGS HUC: 03040103

Project ID: 020593902

EEP Project ID #407



EEP Project Manager: Melonie Allen

Prepared for:



NCDENR-Ecosystem Enhancement Program

1652 Mail Service Center

Raleigh, North Carolina 27699-1652

Data Collected: May 2008 and June 2009

Revised: February 2010

Executive Summary

The goals of the Valley Fields Stream and Wetland Restoration Project (Project) relate to providing ecological improvements to the Site's streams, wetlands, and riparian buffers through beneficial modifications of hydrology, water quality, and habitat.

The project site is located in the USGS Hydrologic Unit Code **03040103030030**. It began as North Carolina Department of Transportation (NCDOT) feasibility report performed by Kimley-Horn and Associates, Inc. (KHA) in May of 2003. The Ecosystem Enhancement Program (EEP) oversaw the project after completion of the feasibility study. KHA finalized the construction plans in January of 2007. North State Environmental, Inc. (North State) completed construction of the project in June of 2008 with repairs to Reach B completed in November 2008.

The Site consists of a tract of land owned by a single landowner. NCDOT purchased a conservation easement covering a large portion of the floodplain. Prior to restoration, the floodplain consisted of a mix of cleared land, crop land, and forested areas. The Project streams were generally incised, entrenched, and had unstable banks. Sand deposits reduced bed feature diversity. Beavers had dammed portions of the streams. The landscape of project wetlands generally fell into two categories: forested with some populations of invasive species or completely cleared. Stream bed degradation led to lower base elevations that in turn lowered groundwater elevations in the adjacent wetlands. One cleared wetland had been crowned to promote surface water run-off and limit water retention.

The reaches were restored using a combination of priority I and II approaches. The work used in-stream structures to control grade, stabilize stream banks, and add bed form diversity (e.g. pools and riffles). The work restored wetland hydrology through the elevation of the stream bed. The stream banks, wetlands, and riparian area were replanted with live stakes, bare roots, and containerized stock.

The work closely followed the design plan. The work followed the plan and profile design specifications in all sections except lower reach C and a meander of upper reach A where minor adjustments were made to avoid utilities. The work also differed from design where a few A-vanes were converted to cross vanes and a few rock structures were converted to log structures due to the onsite availability of logs. These changes improved or maintained design goals and reduced costs.

Monitoring will occur annually for five (5) years. Morphology monitoring includes twenty-two (22) cross sections and seven (7) longitudinal profile segments. Channel stability assessment will cover the entire restored length and includes thirty-eight (38) permanent photos. Hydrology monitoring includes four (4) groundwater gauges and four (4) crest gauges. Vegetation monitoring includes twenty-nine (29) plots.

Table of Contents

Executive Summary	i
Table of Contents	ii
List of Tables	iii
List of Figures	iii
List of Attachments	iii
Location and Setting.....	1
Project Goals and Objectives	3
Project Structure.....	4
Restoration Type and Approach	4
Project History	6
Success Criteria.....	6
Channel Morphology and Stability	6
Dimension	7
Pattern and Profile	8
Substrate	8
Sediment Transport	8
Vegetation	8
Hydrology	9
Streams	9
Wetlands	9
Monitoring Plan	9
Hydrology	10
Wetland	10
Stream	10
Channel Morphology and Stability	10
Dimension	10
Profile	10
Pattern	10
Substrate	10
Visual Channel and Bank Stability Assessment	10
Vegetation	11
Watershed	11
Maintenance and Contingency Plans	11
References.....	13

List of Tables

Table 1: Restoration Component Attribute Table5
Table 2: Stream Mitigation Summary Table5
Table 3 Wetland Mitigation Summary Table6

List of Figures

Figure 1: Project Map.....2

List of Appendices

Appendix 1: Baseline Monitoring
Appendix 2: EEP Baseline Morphology Tables

List of Attachments

Attachment 1: As-Built/Record Drawings

Location and Setting

The Project Site (Site) lies approximately 3.2 miles northwest of High Point, North Carolina in Davidson County adjacent to Wallburg-High Point Road about 1 mile east of the intersection of Wallburg-High Point Road and Horneytown Road (Figure 1).


The Valley Fields Farm Stream and Wetland Restoration Project (Project) falls within the Yadkin River Sub basin (03040103030030 Hydrologic Unit Code). The Site includes Rich Fork and its tributaries. The North Carolina Environmental and Natural Resources, Division of Water Quality (NCDENR-DWQ) lists Rich Fork from its source downstream to Abbot's Creek as an impaired water due to fecal coliform on the 2002 Integrated 305(b) and 303 (d) report (North Carolina Department of Environment and Natural Resources - Division of Water Quality: Planning Branch 2003a).

The project watershed lies within the Piedmont – Southern Outer Piedmont Ecoregion, part of the Piedmont physiographic province. Valley slopes between 0.003 and 0.011 typify the topography of the project watershed.

The Site lies within an area that has been used for agriculture. Some of these areas have reforested while other areas continue to be used for agriculture or are maintained as cleared land. The Site also includes two utility easements (gas line/ fiber optic and sanitary sewer that cross the stream and/or run parallel to the streams.

Upstream development of the watershed has increased the frequency of flooding events. The portion of impervious surface composing reach drainage areas ranges from 1.0% to 16.5%. Reach B, the primary tributary to Rich Fork, has the most developed drainage area with impervious surfaces composing up to 16.5% of the total drainage area. Much of the watershed has not been developed; however, current trends indicate strong growth in both commercial and residential developments within the project watershed.

Figure 1: Project Map

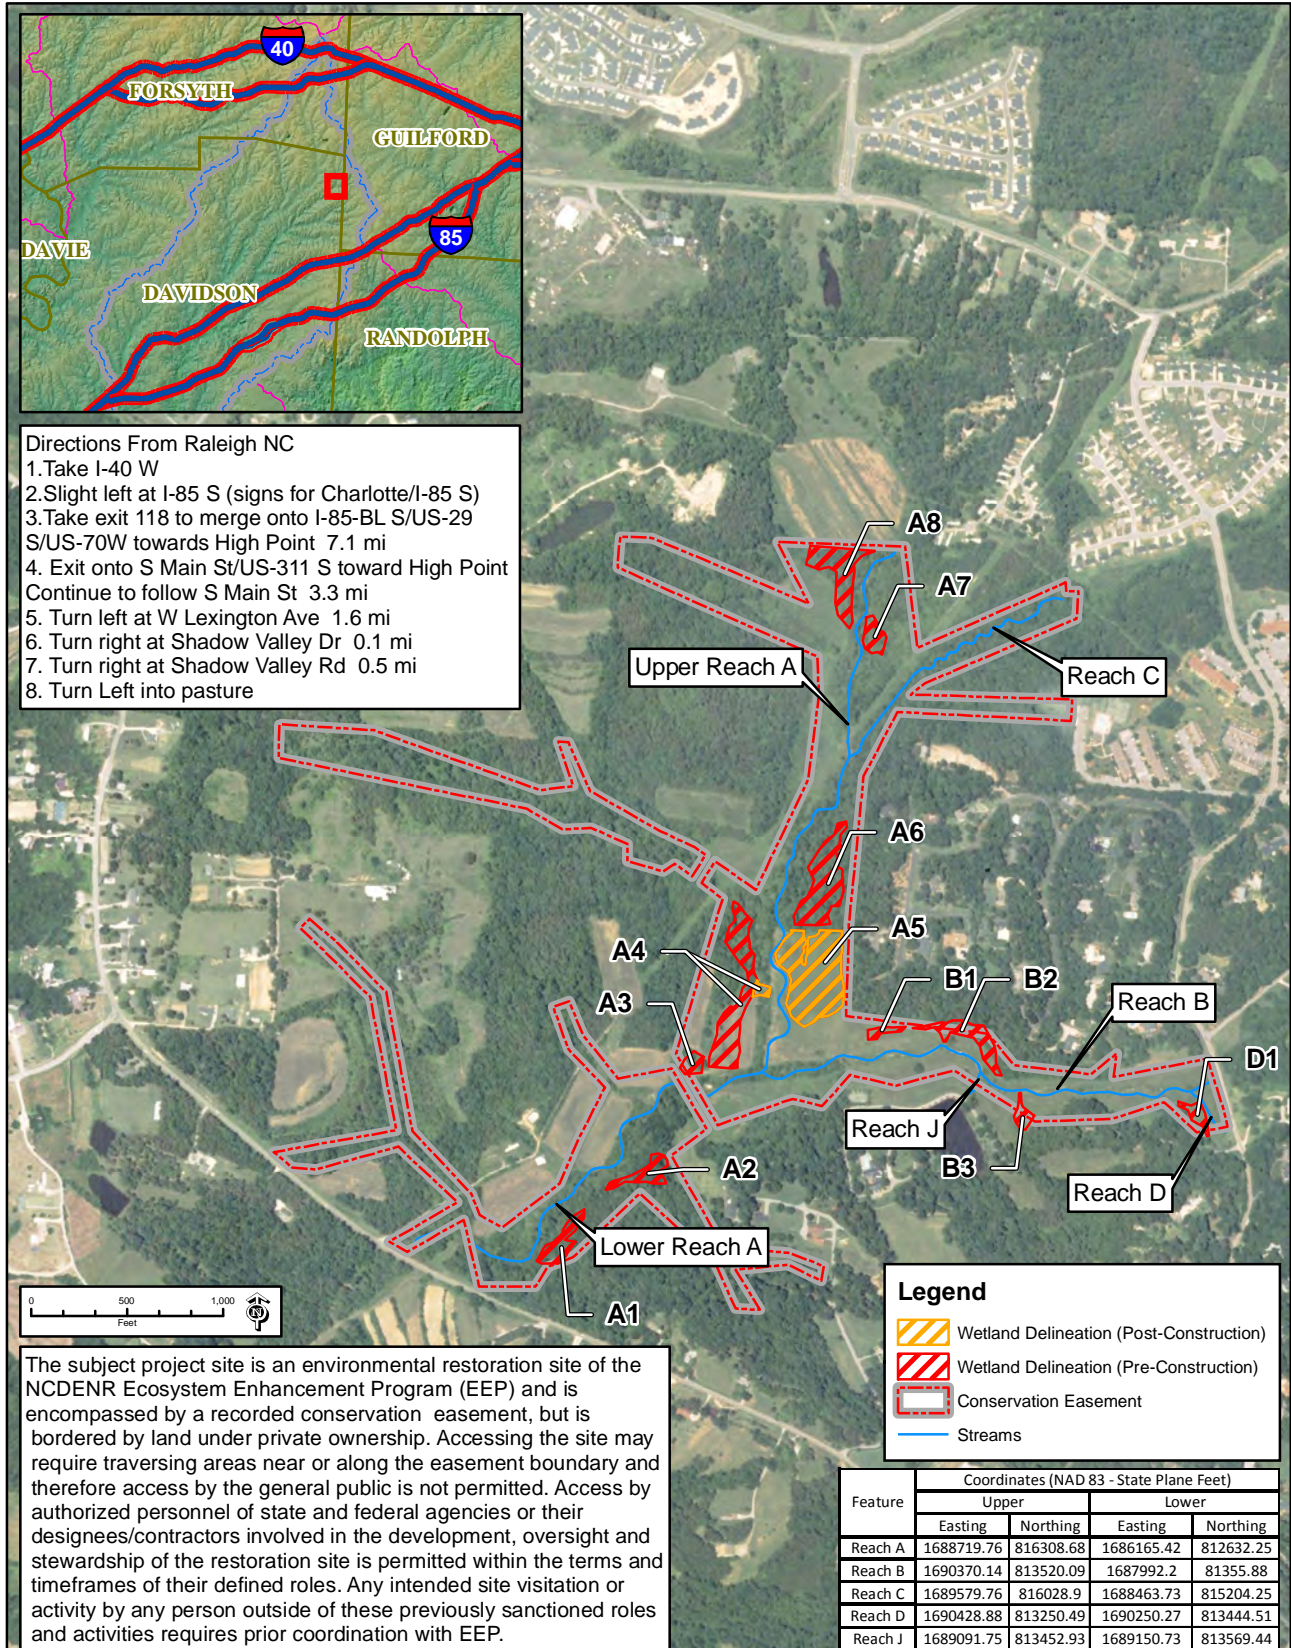

Project Goals and Objectives

The goals of the project relate to providing ecological improvements to the Site's streams, wetlands, and riparian buffers through beneficial modifications of hydrology, water quality, and habitat.

Goals related to hydrology include:

- Better manage hydrologic energies and improve system hydraulics through the re-establishment of a floodplain connection at the bankfull discharge and by increasing flood storage events above bankfull
- Improve wetland hydrology by raising the water table and/or enhancing surface water floodplain interactions

Goals related to water quality include:

- Reduce bank sediment losses to the receiving watershed from erosion
- Provide substantive thermoregulation via vegetative shading for reaches C, D, and J within the standard 5 year monitoring timeframe and over the longer term for reaches A and B through the provision of a sufficiently dense and vigorous riparian community
- Proved turbulence derived oxygenation in the base flow range

Goals related to habitat include:

- Improve instream habitat through diversification of bedform
- Improving bank habitat by increasing stability and woody biomass
- Improving wetland and floodplain habitat by establishing microtopography and hydrology, removing invasive vegetation, and increasing habitat diversity
- Improving food web dynamics by adding biomass (such as detritus, woody debris, and leaf matter) and re-establishing floodplain connection

The restoration achieves these goals through the following objectives:

- Stabilizing channel bed and banks through modifying dimension, pattern, and profile using natural channel design priority I and II techniques. Priority I is the re-establishment of a connection to the historic floodplain by raising the stream bed and priority II is the establishment of a new floodplain at the current stream elevation.
- Installing in-stream structures such as rock vanes, log vanes, and constructed riffles
- Raising stream bed elevations or lowering floodplains
- Removing invasive vegetation
- Planting native vegetation in riparian buffer
- Removing crowns from wetland areas

Project Structure

The Site includes Rich Fork and several of its tributaries. The mitigation work restored six (6) reaches and preserved several others. The mitigation work restored a large riparian buffer that surrounds the project reaches. The Site also includes several wetlands. The mitigation work restored one (1) wetland tract (A-5) and enhanced several others. Figure 1 shows the locations of the restored features and Table 1 provide a summary of mitigation values.

Restoration Type and Approach

Prior to restoration activities, the stream features consisted of steep, vertical banks, little riparian buffer, excessive turbidity during rain events, severely eroded banks, and sediment filled culverts. Some wetland features were forested while others were entirely cleared. Some of the forested wetlands contained significant populations of invasive species. The hydrology of all the wetlands were impaired due to lowered base elevations of the adjacent incised, entrenched stream channels. One wetland had been graded to promote drainage of surface / flood waters. Sections of the riparian buffer had been entirely cleared. Other sections consisted of isolated populations of invasive species.

The design of the channel reaches employed a Rosgen priority I and priority II restoration approach. Morphological data from the reference reach, piedmont rural regional curves, regime equations, and the existing channel morphology of the Site's stable reaches were used in the design. The designer, KHA, sampled bed materials and performed sediment transport calculations to validate the designed profile and dimensions. The restored channels have banks constructed at a 3:1 slope to ensure stability until deep rooted vegetation can become established. To promote proper bed width using these slopes, the channels for this project are designed Rosgen type C channels. However, the designer anticipates that with maturing vegetation the channel will narrow and evolve into a Rosgen type E channel. Increasing sinuosity on all channels for restoration decreased average stream slopes and provides the proper pool and riffle sequencing found in natural reference stream systems.

The Site's wetlands were restored and enhanced through improvements to hydrology and vegetation. Raising the stream bed elevations raised groundwater elevations leading to reestablished flooding dynamics between the channel and adjacent wetlands. Tract A-5 was further restored by modifying the ground surface to better retain surface water inputs.

Vegetation was planted in five (5) zones that reflect different conditions within the site. Zone 1, stream channel, was planted with live stake, successional species that provide immediate bank stability. Zone 2, stream bank, includes live stakes and bare roots that were planted around structure installations and the outside of meander bends to provide an area of high density root mass. Zones 3 and 4, riparian and transitional, cover the floodplain and consist of planted live stakes, bare roots, and container stock. Zone 5, maintained easement, was planted with native grasses. Zone 5 includes areas where utility easement cross the conservation easement. The easements typically cannot have deep rooting plants because of the potential damage they could cause to underground utilities. In addition, these easements are typically maintained by the owner/operator of the easement which is why only native grasses were placed in these areas.

Table 1: Stream Restoration Component Attribute Table

	Reach A	Reach B	Reach C	Reach D	Reach J
Drainage Area	6.5	2.3	0.2	0.2	0.1
Stream Order	3	2	1	1	1
Restored length (feet)	5,013	2,492	1,489	295	61
Perennial or Intermittent	Perennial	Perennial	Perennial	Perennial	Perennial
Watershed type	Developing	Developing	Developing	Developing	Developing
Rosgen classification of pre-existing	G5c→F5	G5	F5→B5	B5	G
Rosgen classification of As-built	B5c→C5	B5c→C5	C5c→E5	B5c→C5	Ba

Table 2: Stream Mitigation Summary Table

Project Component or Reach ID	Pre-Construction Length (Feet)	Constructed Length (Feet)	Mitigation Type	Mitigation Ratio	SMUs
Upper A	3,100	3,078	Restoration	1:1	3,078
Lower A	2,284	1,935	Restoration	1:1	1,935
B	2,550	2,492	Restoration	1:1	2,492
C	1,560	1,489	Restoration	1:1	1,489
D	240	295	Restoration	1:1	295
J (Pond Tributary)	61	61	Restoration	1:1	61
Reach A	276	-	Preservation	5:1	55
Reach E	2,930	-	Preservation	5:1	586
Reach F	1,840	-	Preservation	5:1	368
Reach G	1,200	-	Preservation	5:1	240
Reach H	1,400	-	Preservation	5:1	280
Reach K	240	-	Preservation	5:1	48
Reach L	700	-	Preservation	5:1	140
Reach M	420	-	Preservation	5:1	84
Total Credits					11,151

*Utility Easements subtracted out of constructed length and are not included in SMU's.

Table 3: Wetland Mitigation Summary Table

Project Component or Reach ID	Pre-Construction Area (Acres)	Constructed Area (Acres)	Mitigation Type	Mitigation Ratio	WMUs
Wetland A-5	-	3.0	Restoration	1:1	3.0
Wetland A-4	-	0.1	Restoration	1:1	0.1
Wetland B-1	0.1	0.1	Enhancement	2.5:1	0.04
Wetland B-2	0.7	0.4	Enhancement	2.5:1	0.28
Wetland B-3	0.2	0.08	Enhancement	2.5:1	0.08
Wetland D-1	0.2	0.2	Enhancement	2.5:1	0.08
Wetland A-6	1.7	1.7	Enhancement	2.5:1	0.68
Wetland A-4	1.8	1.8	Enhancement	2.5:1	0.72
Wetland A-3	0.2	0.2	Enhancement	2.5:1	0.08
Wetland A-1	0.6	0.6	Preservation	5:1	0.12
Wetland A-2	0.5	0.5	Preservation	5:1	0.10
Wetland A-7	0.4	0.4	Preservation	5:1	0.08
Wetland A-8	1.2	1.2	Preservation	5:1	0.24
Total Credits					5.60

Project History

KHA prepared the Valley Fields Farm project feasibility report for NCDOT in May 2003 (TIP No. R-2568WM). The project was transferred to EEP and awarded to KHA for Design and Construction Management in January 2005. KHA completed design in January 2007 and North State Environmental, Inc. completed construction in June 2008. On August 27th and 28th 2008 the project was damaged by rainfall caused by Hurricane Fay resulting in multiple failures to Reach B and Reach D. KHA completed the repair design in October 2008 and North State Environmental, Inc completed the repair construction in November 2008.

Success Criteria

Channel Morphology and Stability

The stream geometry will be considered successful if the cross-section geometry, profile, and sinuosity are stable or reach a dynamic equilibrium. It is expected that there will be changes towards a stable stream type in the designed cross sections, profile, and/or substrate composition. Changes that may occur during the monitoring period will be

evaluated to determine if they represent a movement toward a more unstable condition (e.g. down cutting, erosion, mid-channel bars, etc.) or are changes that represent an increase in stability (e.g. settling, vegetative changes, coarsening of bed material, etc.).

An initial, though not exclusive, indicator of success will be adherence to design or reference ratios of stream geometry found in the Baseline Stream Data Summary tables (table 5 set) or in comparable and stable reference systems.

Deviation from the design ratios will not necessarily denote failure as it is possible to maintain stability and not stay within the design geometry. Additionally, determination of true bankfull will be difficult until the stream has had adequate and diverse flow events to create strong bankfull indicators. The following key indicators of stability provide a more complete picture of stream stability:

- Stream Type: Maintenance of the design stream type or progression or conversion to stable stream type such as B, C, or E will indicate stability
- Bank Height Ratio: Bank height ratio between 1.0 and 1.1 will indicate flood flows have access to the active floodplain and that higher flows do not apply excessive stresses to stream banks

The nature of the watershed presents challenges to stream restoration. The contributing watersheds lie within a rapidly developing region. The urbanizing watershed's runoff character will continue to change as the nature of the land cover shifts to less permeable surfaces. The hydrograph will shift such that bankfull flooding events will become more frequent, peak discharges will be higher, and overall sediment budget will fluctuate. The cross sections have been designed with bankfull benches to account for some shifting in bankfull discharges.

Dimension

General maintenance of a stable cross-section and hydrologic access to the floodplain features over the course of the monitoring period will generally represent success in dimensional stability. However, some change is natural and expected and can even indicate that the design was successful and appropriate for the hydrologic and sediment regime. Examples include depositional processes resulting in the development of constructive features on the banks and floodplain, such as an inner berm, a slightly narrower channel, modest natural levees, and general floodplain deposition. Significant widening of the channel cross-section or trends of increase in the cross-sectional area generally represent concern, although some adjustment in this direction is acceptable if the process is arrested after a period of modest adjustment. In the case of riffle cross sections, maintenance of depths that represent small changes to target competency (e.g. consistently low BHRs <1.2) would also reflect stability. Although a pool cross-section may experience periodic infilling due to watershed activity and the timing of events relative to monitoring, the majority of pools within a project stream reach should demonstrate maintenance of greater depths and flat water surface slopes over time. The critical habitat value of pool depth should be maintained over time and rates of lateral migration should not be significant.

Pattern and Profile

For the channels' profile, the reach under assessment should not demonstrate any trends in significant thalweg aggradation or degradation over significant continuous portion of its length. Over the monitoring period, the profile should also demonstrate the maintenance or development of bedform (facets) more in keeping with reference level diversity and distributions for the stream type in question. It should also provide a meaningful contrast in terms of bedform diversity against the pre-existing condition. Bedform distributions, riffle/pool lengths, and slopes will vary, but should do so with maintenance around general design distributions. This requires that the majority of pools are maintained at greater depths with lower water surface slopes and riffles are shallow with greater water surface slopes. Pattern features should show minimal adjustment over the standard five (5) year monitoring period.

Substrate

Substrate measurement should indicate a progression towards, or the maintenance of the known distributions from the design phase.

Sediment Transport

Upstream construction activities driven by land development likely will lead to episodic sediment pulses sent downstream through the stream network. Additionally, erosion of upstream unstable stream banks will persistently contribute sediment to the project reaches. The designer anticipates that the excess sediment will either be routed through the project area or deposited in target areas such as point bars and the floodplain. While stream restoration projects are designed to transport bedload in equilibrium and carry overall sediment loads at bankfull, fines can be transported even at low discharges and upstream instability beyond design projections can contribute to widespread deposition as storm event recede in areas of energy dissipation such as restored reaches. This can have the effect of obscuring bedform especially in the first few years after the implementation of a stream restoration project. In many cases subsequent narrowing and reduction of width/depth ratios as a project develops and stabilizes it can then increase transport efficiency and return bedform to intended distribution, but some tendency for modest filling of pools and glides may persist. The pools are designed to be over dug to account for some sedimentation of pools and glides. Changes that may occur during the monitoring period will be evaluated to determine if they represent a movement toward a more unstable condition or are minor changes that represent an increase in stability or insignificant changes.

Vegetation

The project site was planted in phases as the construction progressed. The initial plantings were completed in May 2008. Reach B was replanted after the repairs in November 2008. KHA collected vegetation plot data originally in June 2008 and in June 2009 for Reach B. The time interval between the final baseline vegetation data collection and submittal of this report is approximately 8 weeks. The success of riparian vegetation planting will be gauged by stem counts of planted and recruited species and an assessment community composition. Stem counts of over 260 trees per acres after 5

years will be considered successful. Interim stem count criteria will be 320 trees per acre for year 3 and 288 trees per acre for year 4. The composition of the vegetation community should trend toward a predominance of target species. A majority (80%) of the target species should be present in the reforestation area in numbers and condition conducive to continuing the species through the maturation of the community. The population of invasive species will be kept below 10% of the total population.

Hydrology

Streams

A minimum of two bankfull events must be documented within the standard five (5) year monitoring period. In order for the monitoring to be considered complete, the two (2) verification events must occur in separate monitoring years.

Wetlands

The minimum requirement to judge establishment of wetland hydrology will be adherence to USACE guidelines (United States Army Corps of Engineers 1987) including saturation of the upper 12" of the soils for a minimum period of 18 consecutive days (~7.5%) during the microbial growing season. Further success of the restoration and enhancement of wetland hydrology will be measured by improvements to the frequency and duration of flood flows, groundwater levels, flood storage, and surface water infiltration. The following changes from baseline conditions will indicate enhancement or restoration of wetland hydrology:

- Indicators of overbank inputs to wetlands
- Rise in groundwater elevations
- Maintenance of floodplain based on morphology indicators and gauging
- Increase in volume of surface water infiltration

Monitoring Plan

The monitoring will assess the Site's stream, wetland, and riparian areas to determine restoration success. The monitoring plan has been set up based on guidance provided by The Stream Mitigation Guidelines disseminated by the United States Corps of Engineers – Wilmington District (McLendon, Scott, Fox, Becky et al. 2003), version 1.2 (11/16/2006) of the North Carolina Ecosystem Enhancement Program (EEP) document entitled "Content, Format, and Data Requirements for EEP Monitoring Reports", version 2.0 (3/27/2008) of the EEP document entitled "Mitigation Plan Document Format, Data Requirements, and Content Guidance".

The monitoring will occur annually for five (5) years. The monitoring period should include two (2) separate years with bankfull events. Bankfull events will be verified using an installed crest gauge that will be inspected during each monitoring visit. If there are not two (2) bankfull events, the monitoring period may be extended at the discretion of the Corps of Engineers, Raleigh Regulatory Field Office Project Manager and the 401-Wetlands Unit. Monitoring reports will be submitted during years 1-5.

Monitoring work will include reference photographs, materials sampling, site survey, visual assessment, mapping of significant features, vegetation sampling, and groundwater monitoring.

Hydrology

Each site visit by the monitoring performer must include documentation of the wetland and stream hydrology gauges described below.

Wetland

The Site includes four (4) groundwater gauges that were installed during the design phase. Three (3) gauges are located within the restoration wetland (A-5) and one (1) gauge is located within a reference wetland immediately north of wetland A-5. These gauges continue to function and will be used to continue to monitor wetland hydrology. The gauges should be downloaded during each monitoring visit.

Stream

Installed crest gauges will be used to verify the occurrence of bankfull events. The gauge should be reset after each observation. Observations of wrack and deposition may serve to augment gauge observations when necessary.

Channel Morphology and Stability

Dimension

The survey of channel dimension consists of twenty-two (22) permanent cross sections placed throughout the project extent. The cross sections represent fourteen (14) riffles and eight (8) pools. Annual photographs showing both banks and upstream and downstream views will be taken for each cross section.

Profile

The survey of the longitudinal profile covers seven (7) sections located throughout the project reaches. The longitudinal profile sections include portions of Upper A, Lower A, B, and C. Reaches D and J were not surveyed due to their short length and will be assessed visually. The thalweg of the channel should be used as a baseline and profile measures should be stationed relative to the thalweg.

Pattern

Pattern data will be collected in year 5 and then only if there were any indications through profile and dimensional data that significant geomorphological adjustments occurred.

Substrate

Channel material measurements will be collected by using pebble counts for each longitudinal profile section.

Visual Channel and Bank Stability Assessment

Thirty-eight (38) permanent photo stations have been set up to visually monitor stream conditions. These photo stations are mapped on the As-Built drawings.

The entire restored length of stream will be investigated for channel stability and in-stream structure functionality. Any evidence of channel instability will be identified, mapped, and photographed. All structures will be inventoried for functionality and impaired structures will be photographed.

Vegetation

Twenty-nine (29) permanent quadrants have been setup to sample the riparian buffer and restored wetland. Each quadrant covers 100 square meters. The annual assessments will track the growth and health of planted stems and provide an overall count of woody stems including recruits. The vegetation survey will occur during the growing season. Permanent photo points have been set up for each quadrant. Planted specimens have been flagged, but not mapped. Not all species were identified due to the bare roots lacking distinguishable features. The plot setup may be modified to match Carolina Vegetation Survey (CVS) Level 1 and 2 protocols.

Watershed

Excessive sediments enter the reaches from their watershed for all reaches but especially reach B. These Sediments should wash through the system; however, due to the drought conditions in the Piedmont, NC there has been a lack of channel forming flows. The sediment is causing mid channel bars to form: however these seem to be temporary in nature and migrating as the excess sediment is flushed and deposited on the benches and point bars.

A review of land use change during the monitoring period will provide a clearer picture of stream channel stability and performance.

Maintenance and Contingency Plans

If problem areas arise during the monitoring period, corrective action may be required. If the problem is isolated in nature it may not require remedial action; however, if the issue is determined to systemic, corrective action may be needed. The following provides an outline for maintenance thresholds and contingency plans for the Site's streams, wetlands, and planted areas (Riparian Buffer and Wetland).

Stream Issue Threshold:

- Beaver repopulation
- BHR >1.2 and visual indication of systemic instability or the problem threatens to create instability.
- Excess sediment from site features. Design assumes sediment pulses from upstream.

Stream Remedial Actions:

- Beaver removal
- Hand repairs and/or mobilization of equipment.
- Investigation of upstream sediment inputs to determine any violations to the state or federal land and water quality rules and regulations.

Wetland Criteria:

- Hydrology does not meet USACE guidelines and reference values

Wetland Remedial Actions:

- Verify climate conditions are normal
- Mobilization of equipment to either raise or lower the grade.

Planted Area Issue Thresholds:

- >15% invasives
- Not meeting stem count or diversity

Planted Area Remedial Actions:

- Nuisance vegetation removal/treatment
- Supplemental plantings

References


- McLendon, Scott, Becky Fox, et al. (2003). Stream Mitigation Guidelines. United States Army Corps of Engineers - Wilmington District, United States Environmental Protection Agency, North Carolina Wildlife Resources Commission and North Carolina Department of Natural Resources - Division of Water Quality.
- Rosgen, David L. (1997). A Geomorphic Approach to Restoration of Incised Rivers. Management of Landscapes Disturbed by Channel Incision.

Appendix 1


Baseline Monitoring

Longitudinal Profile


Longitudinal Profile - Reach Upper A (1) - 50+43 to 58+36 - May 2008

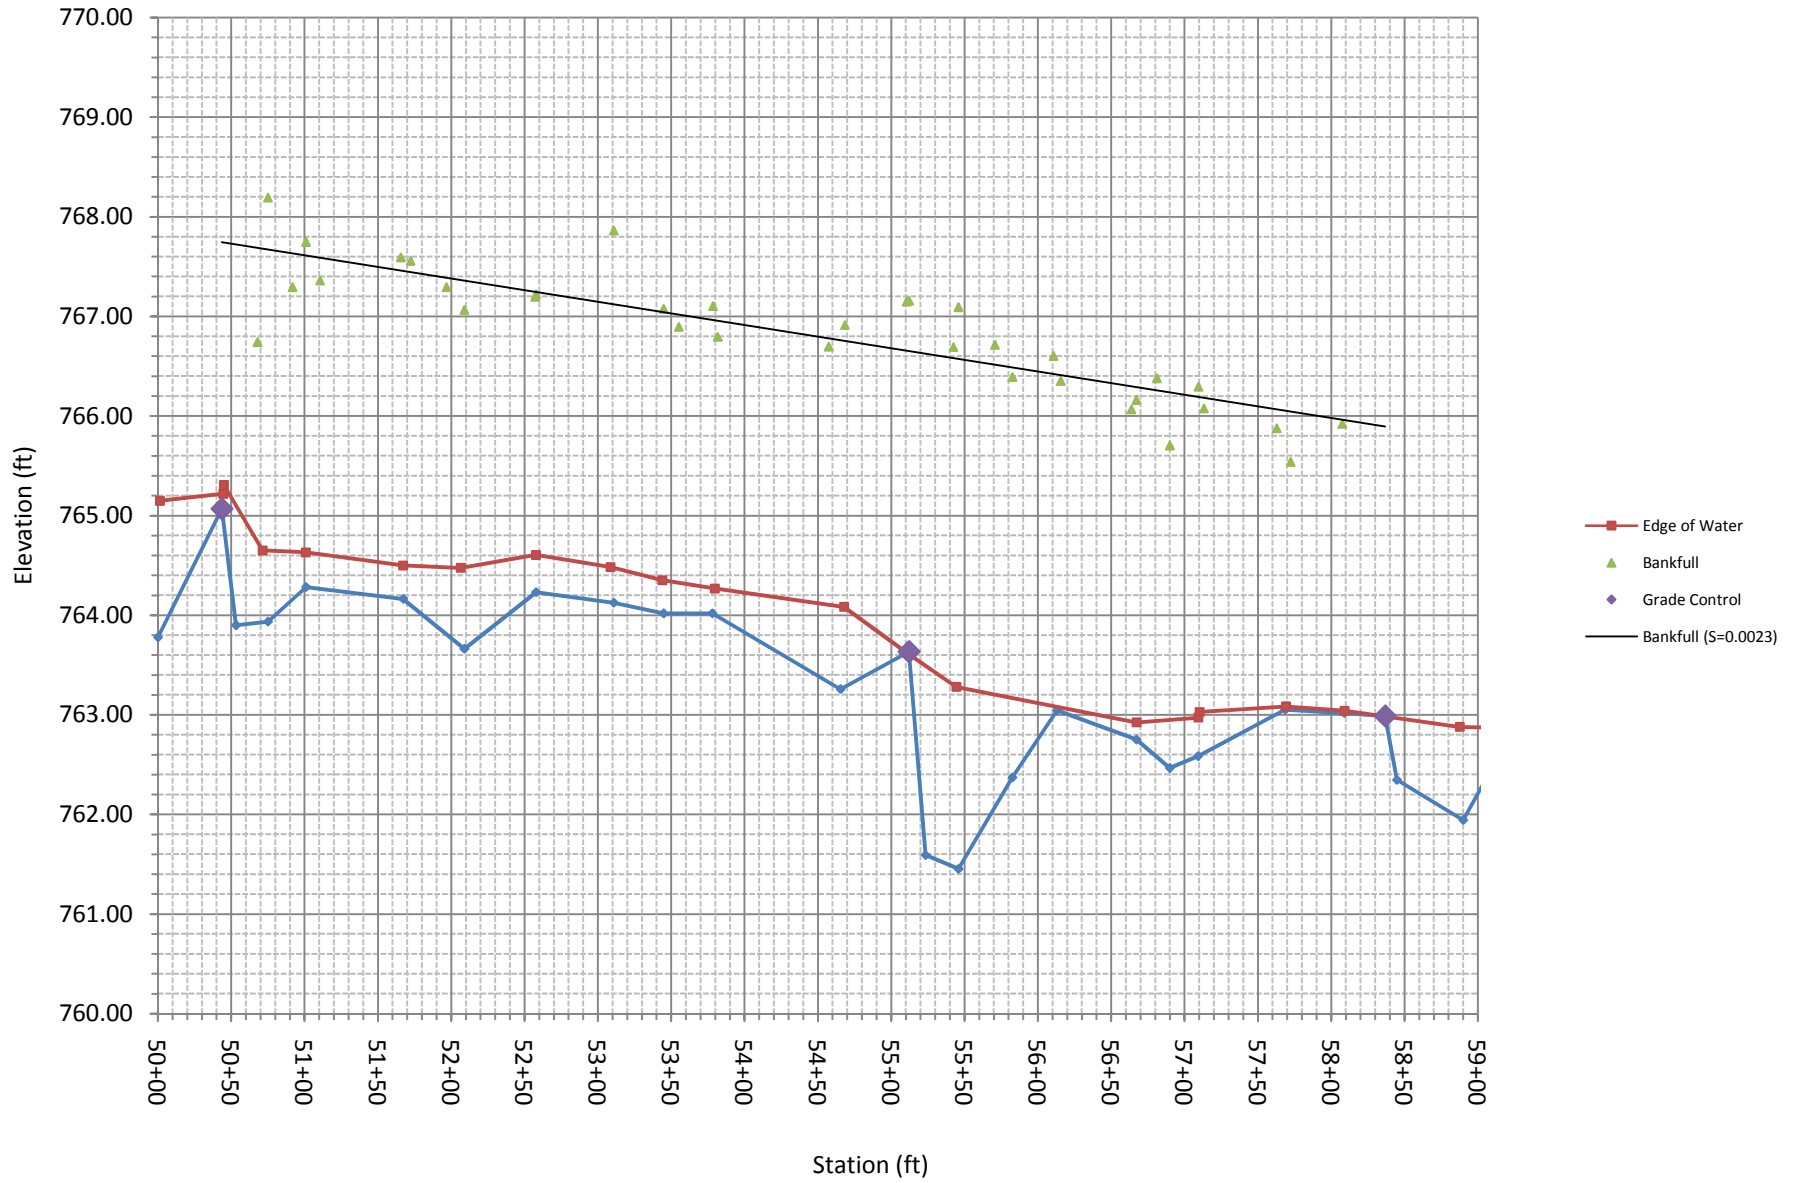


Longitudinal Profile - Reach Upper A (2) - 63+13 to 70+20 - May 2008

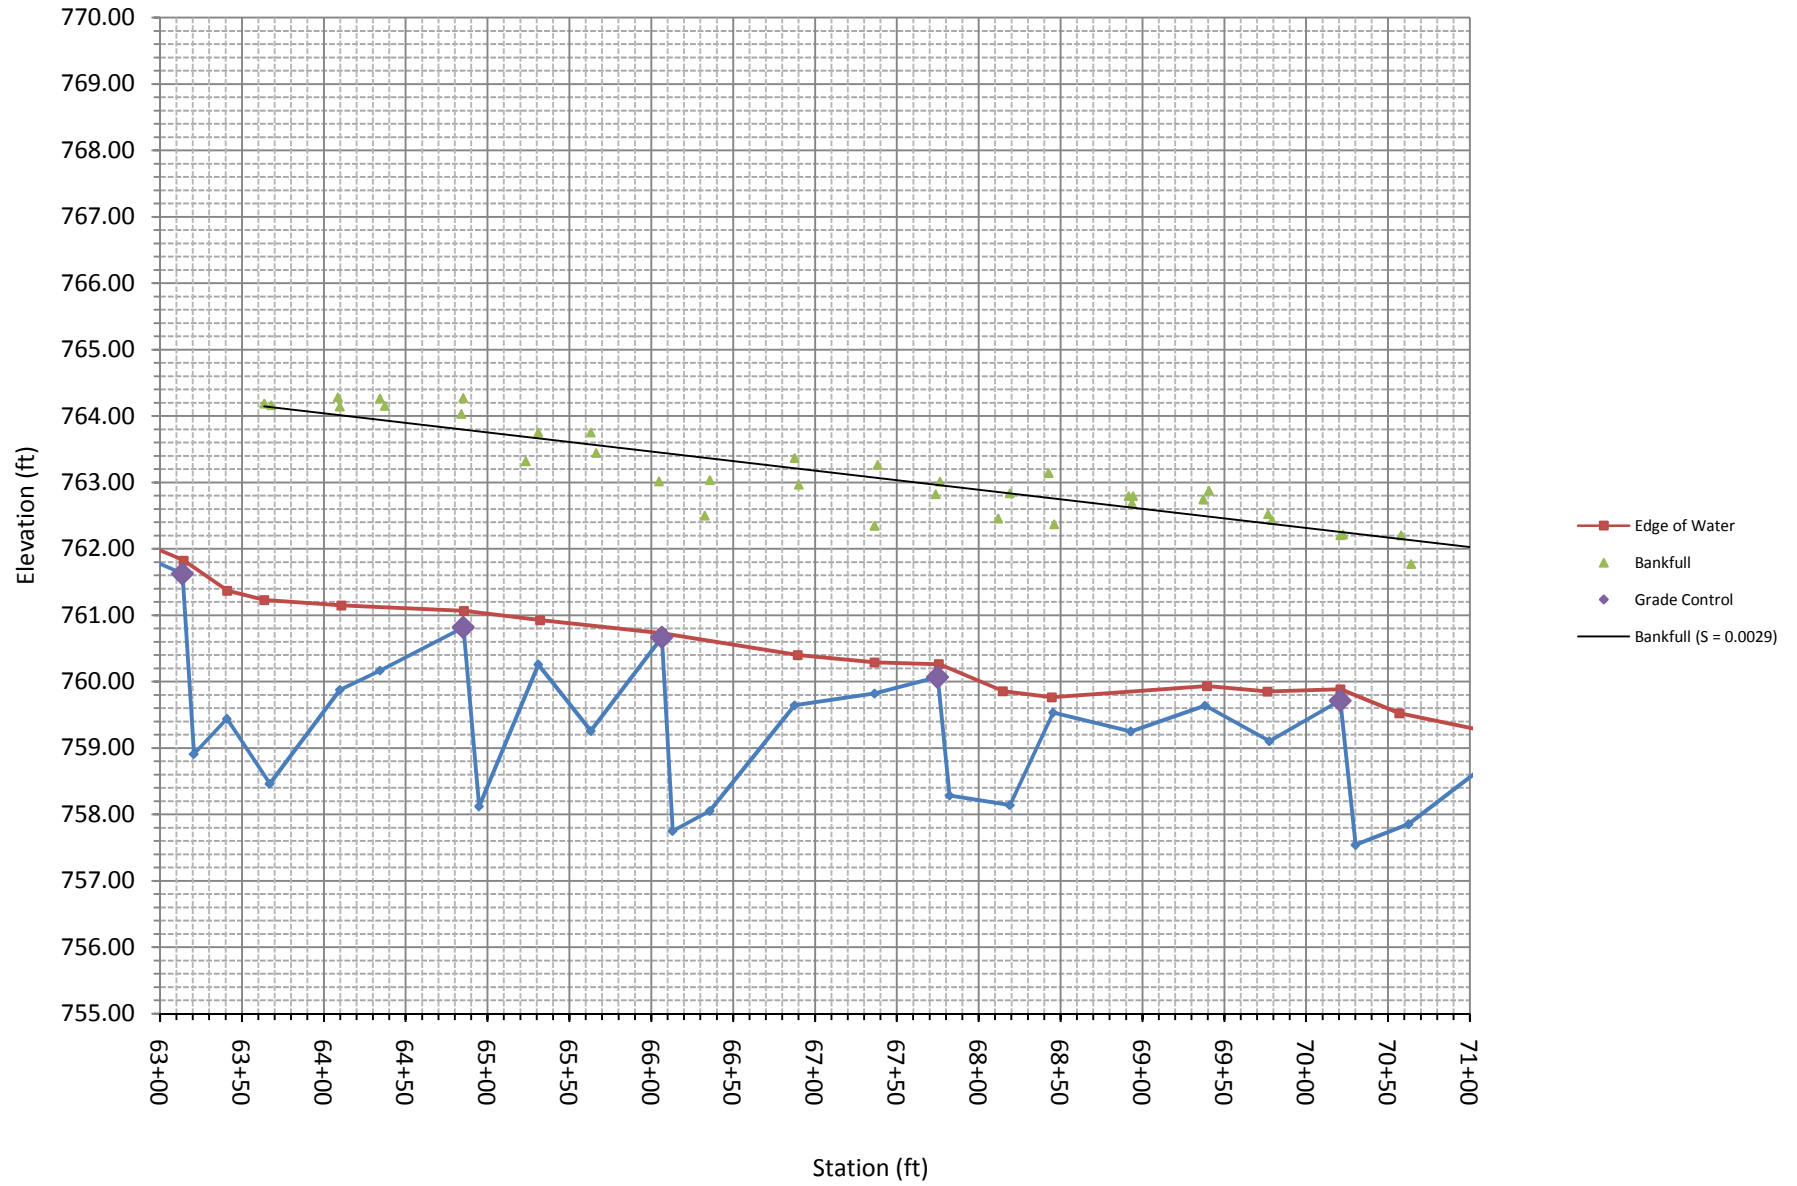


Longitudinal Profile - Reach Lower A (1) - 72+07 to 79+98 - May 2008

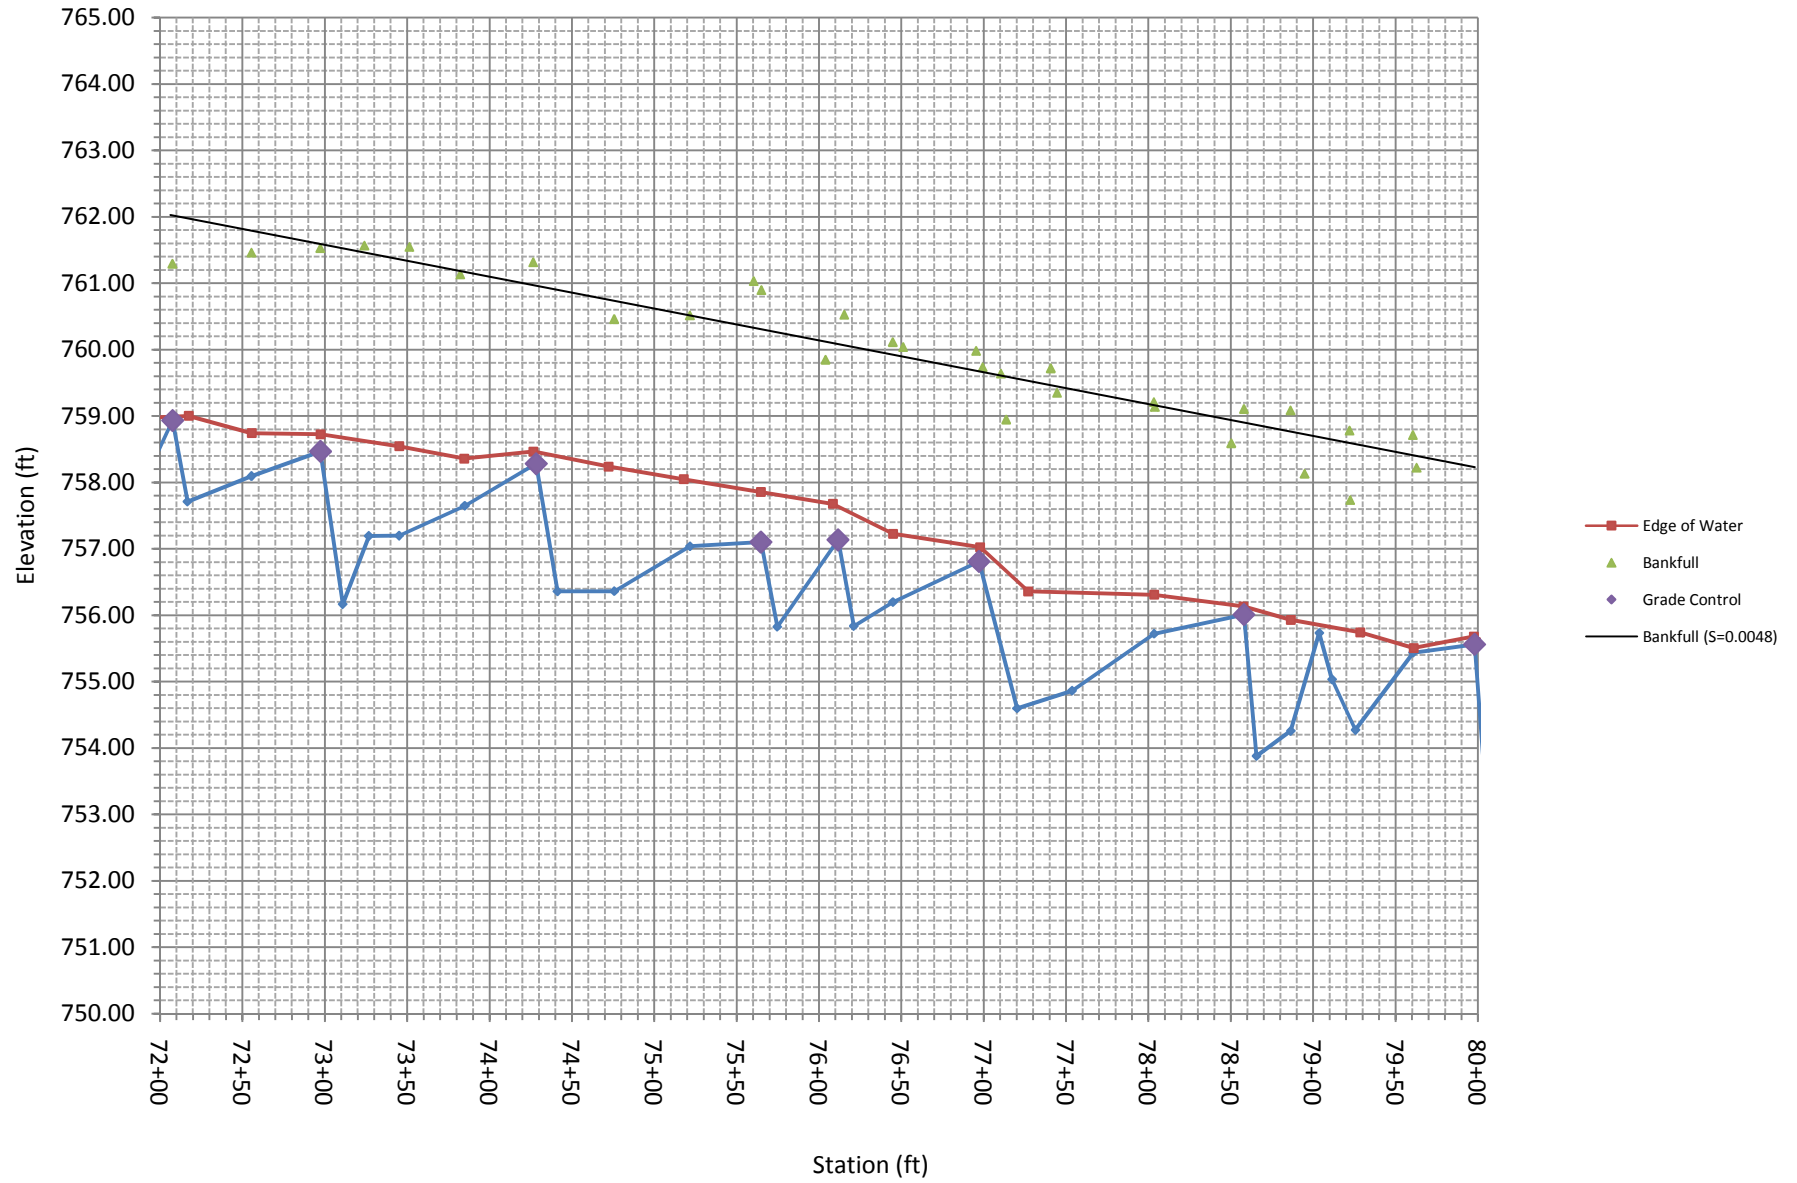


Longitudinal Profile - Reach Lower A (2) - 81+62 to 95+72 - May 2008

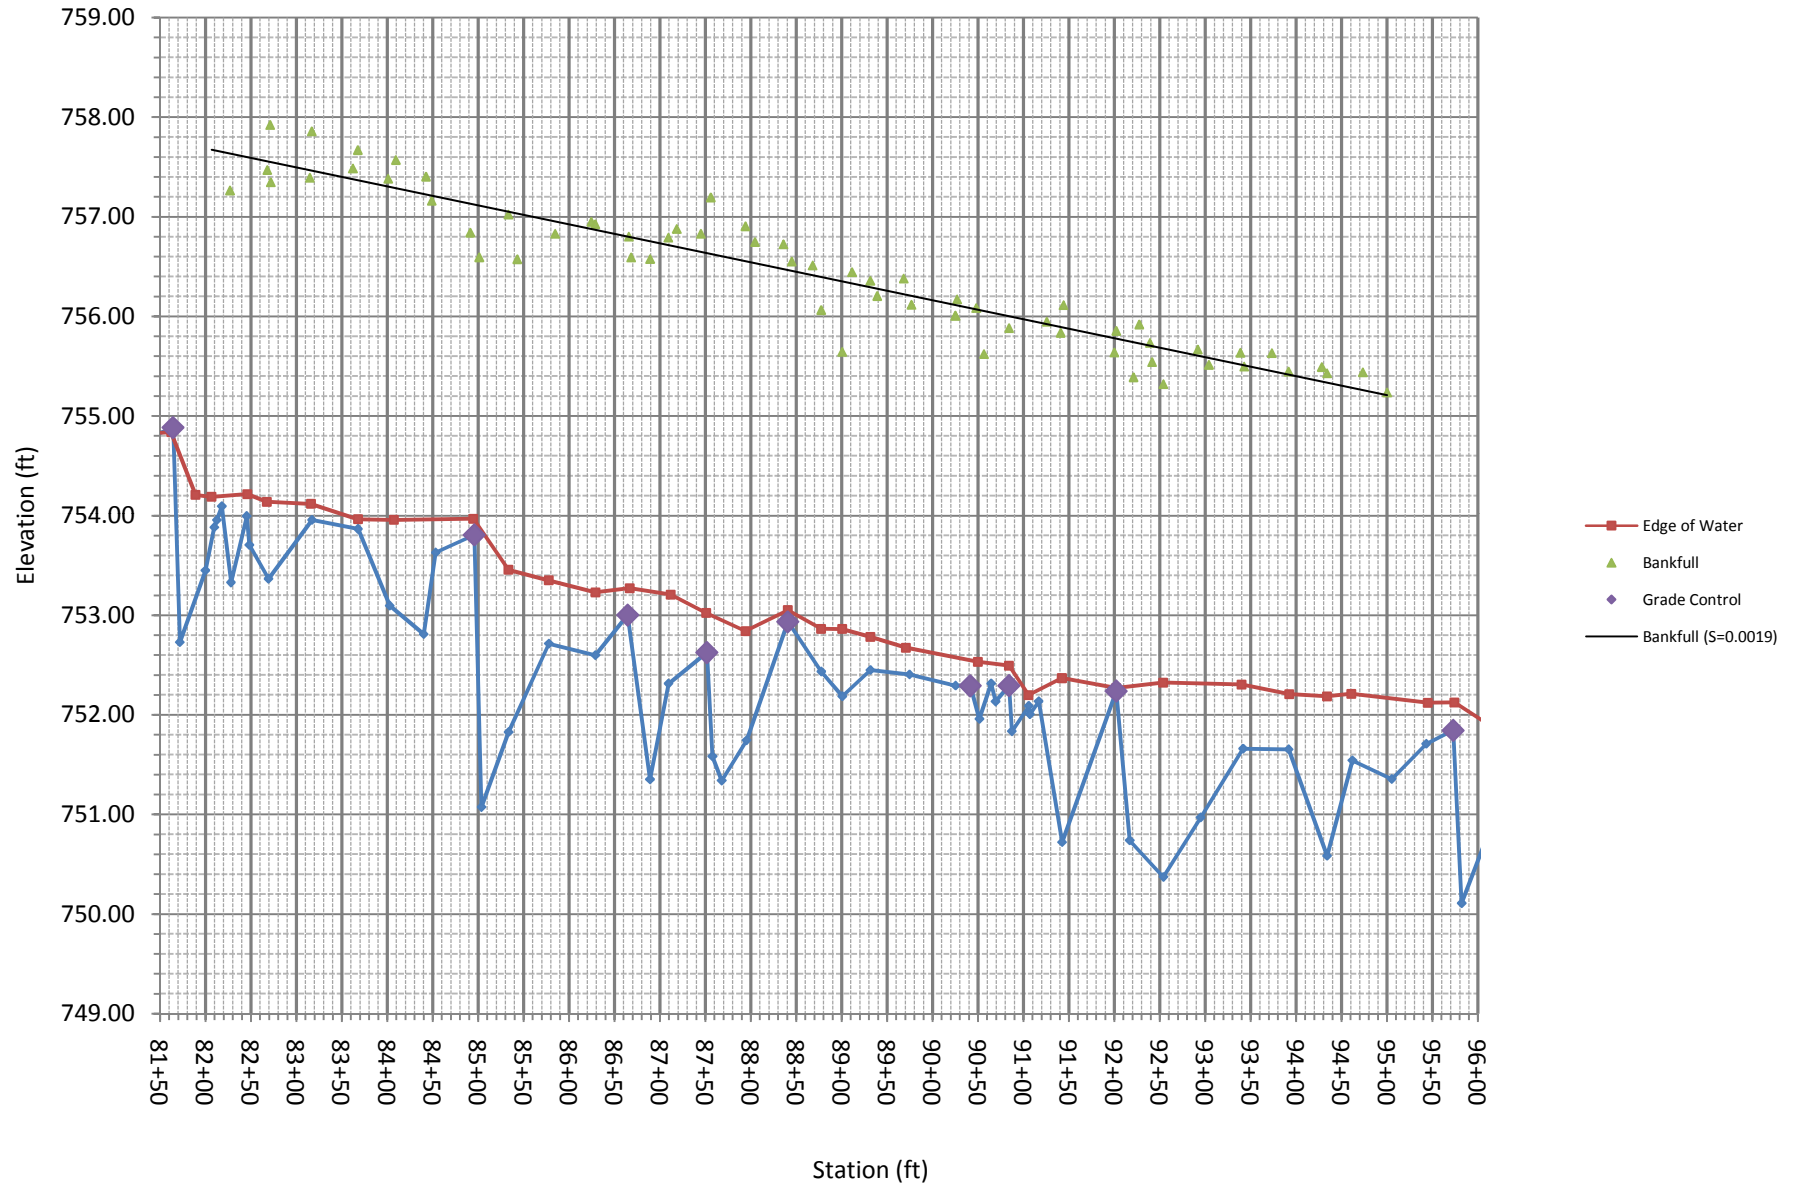


Longitudinal Profile - Reach B - 155+50 to 157+30 - July 2009

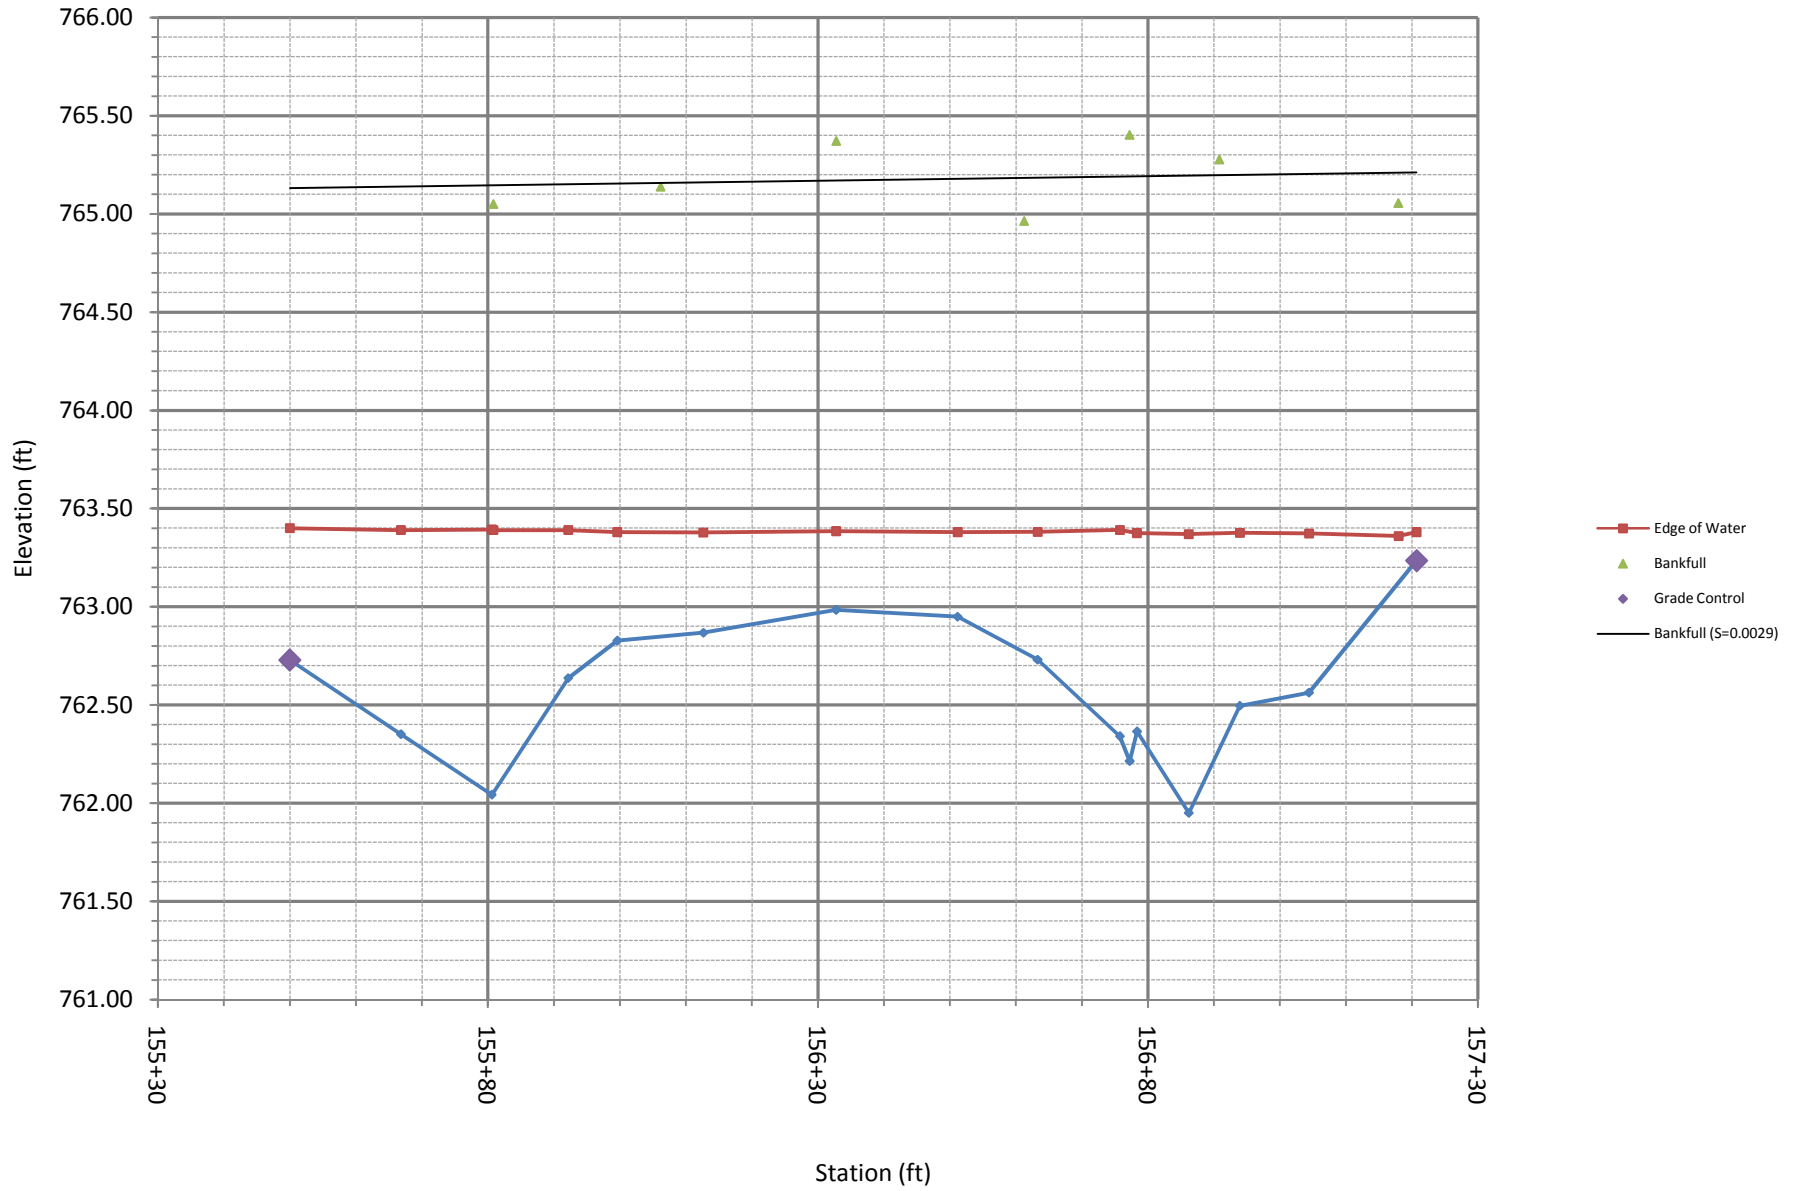


Longitudinal Profile - Reach B (2) - 168+40 to 170+50 - July 2009

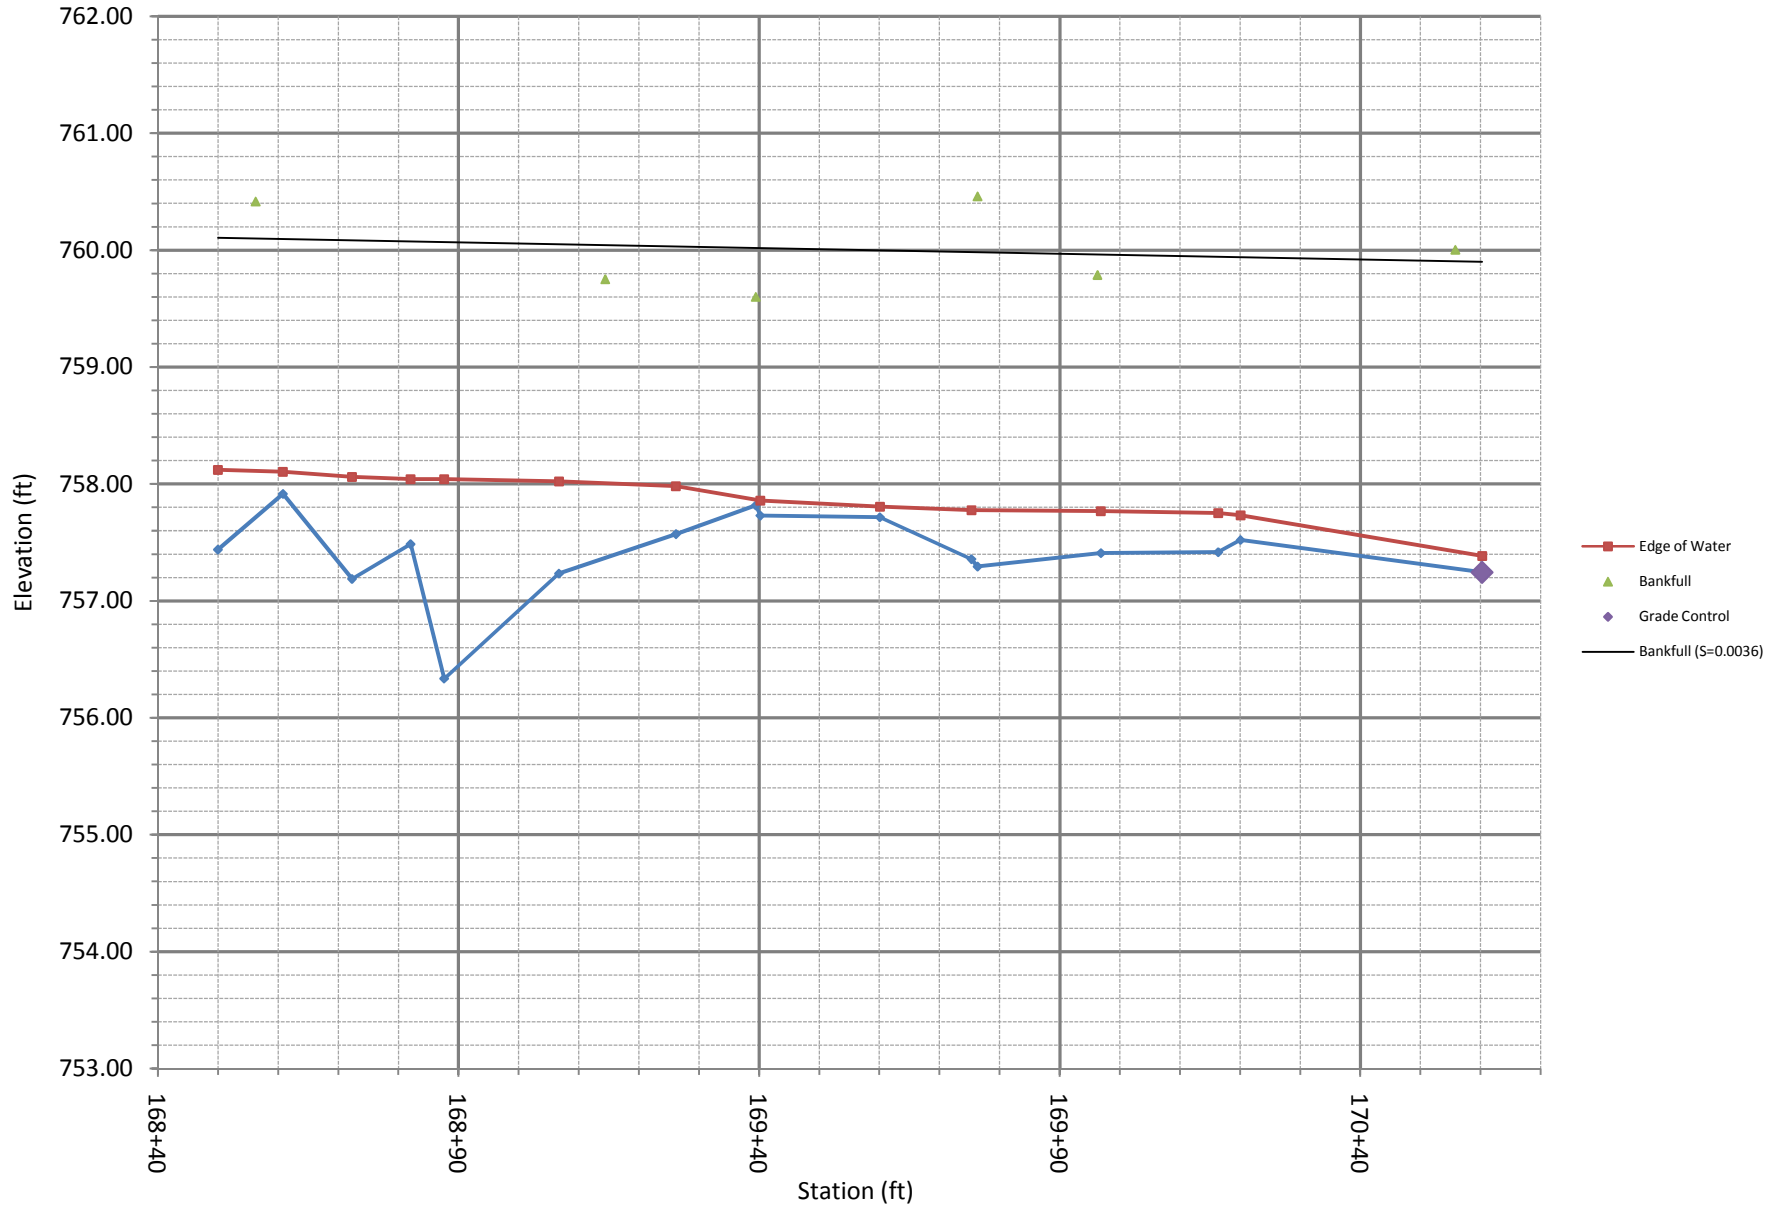

Longitudinal Profile - Reach C - 100+00 to 113+18 - May 2008

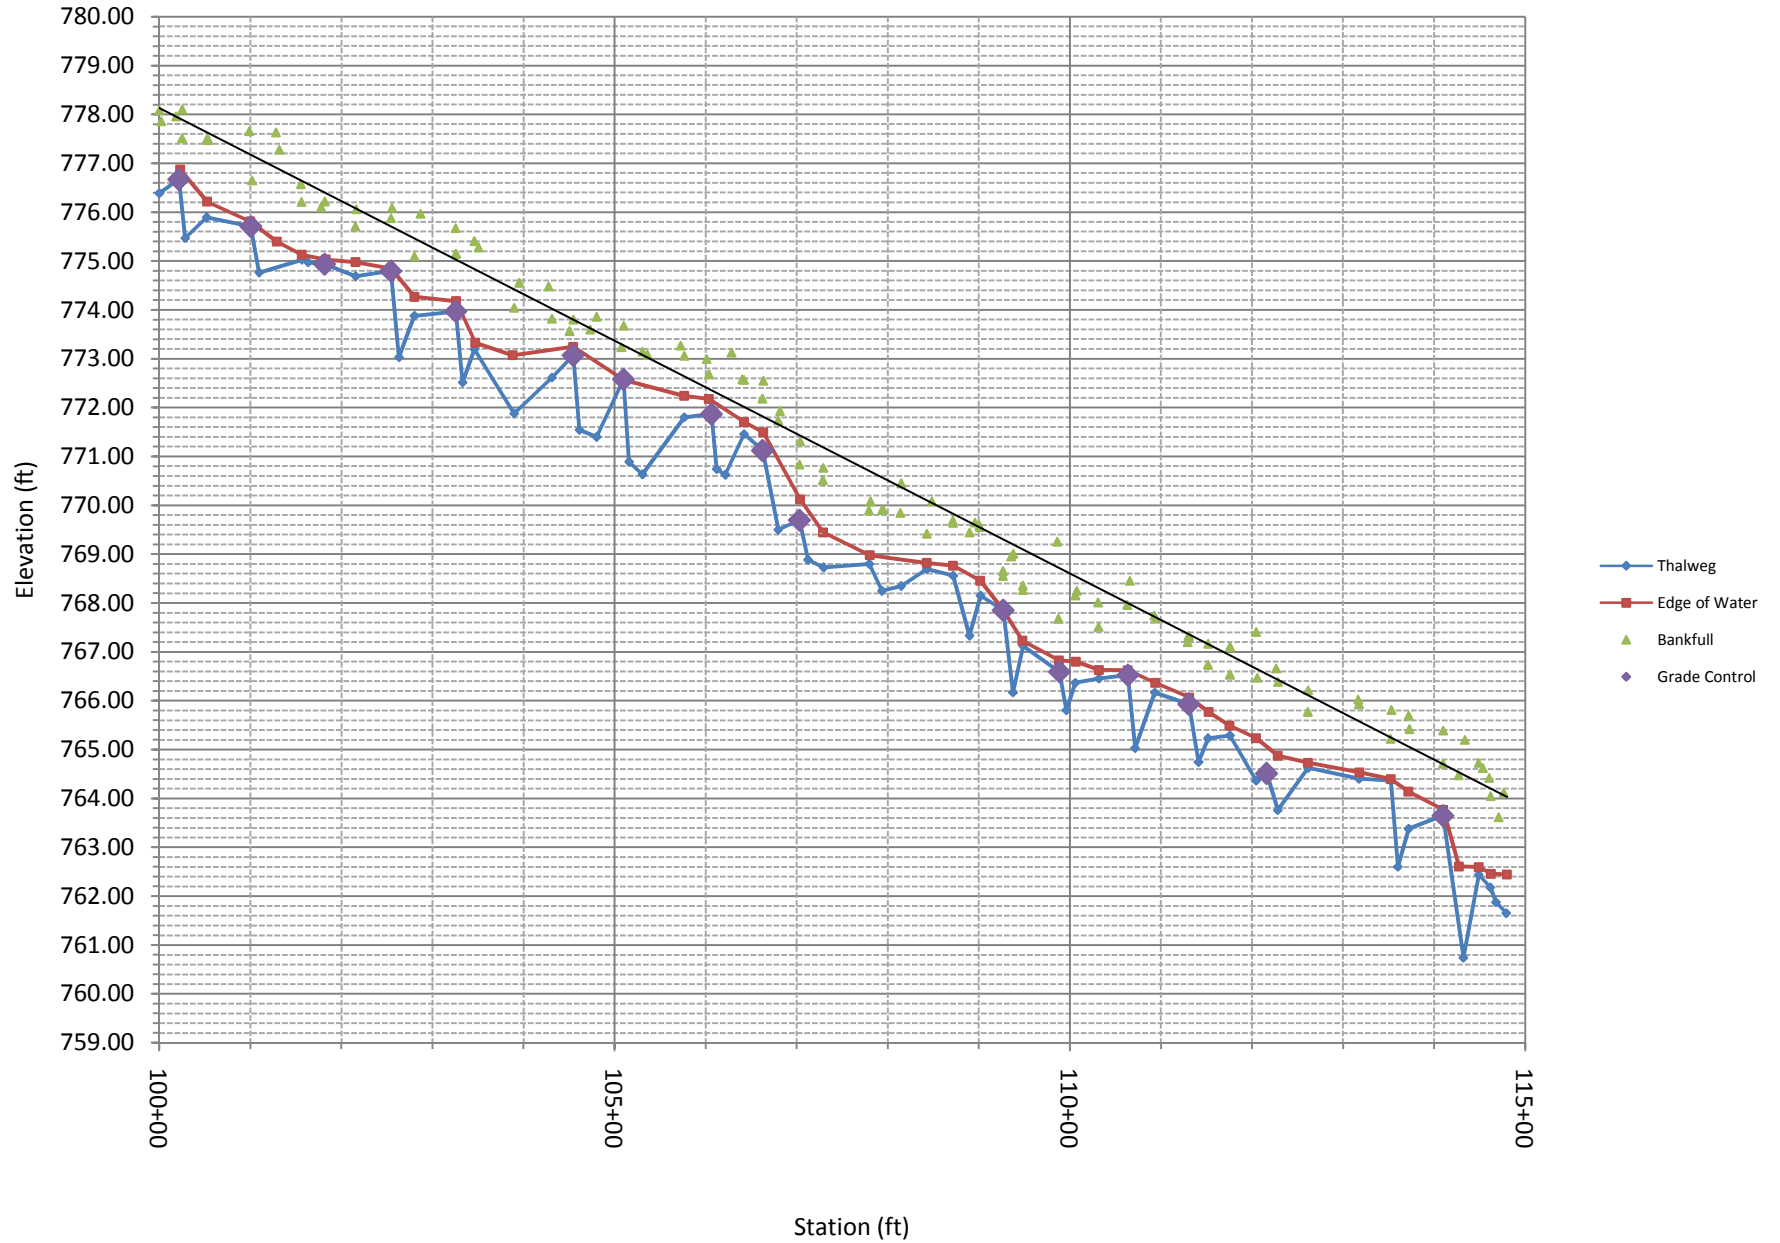

Permanent Cross Sections

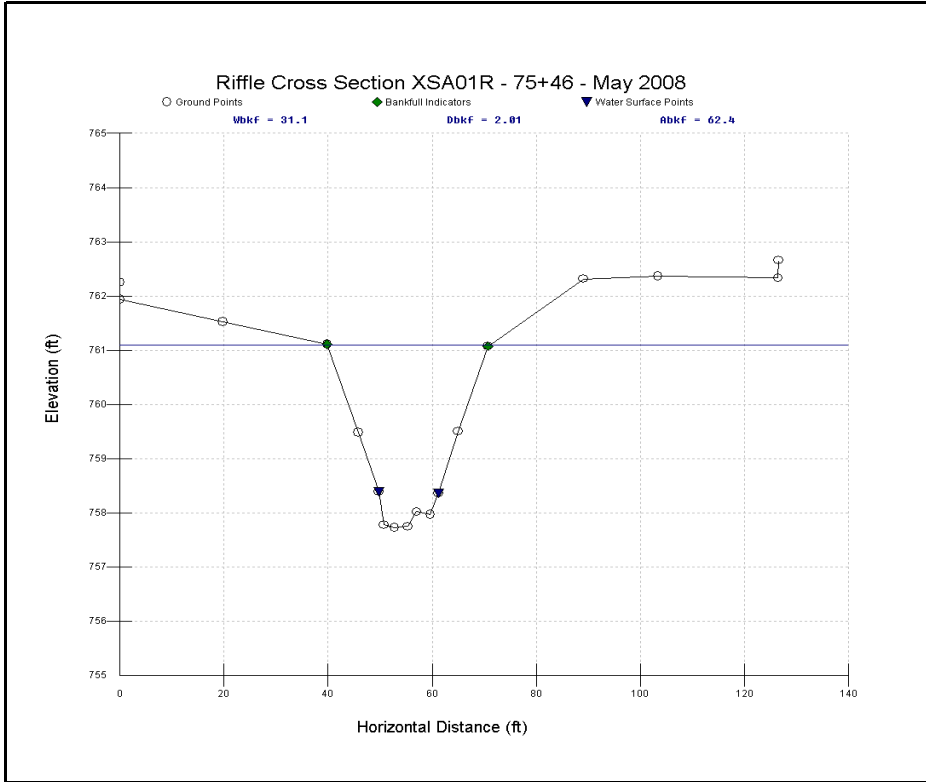

Upstream



Downstream




Left Bank



Right Bank

Pool Cross Section XSA02P - 74+99 - May 2008

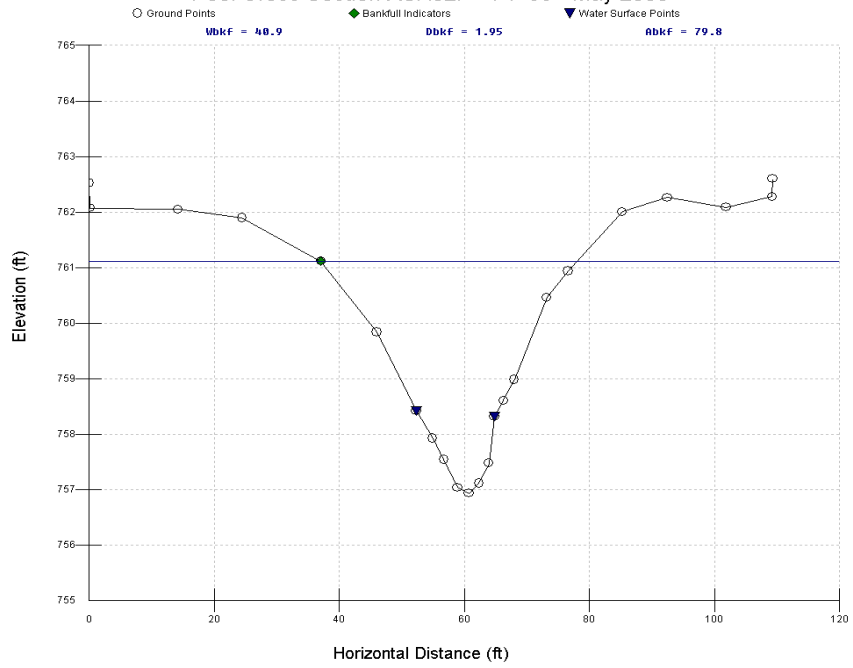

Upstream




Downstream



Left Bank

Right Bank

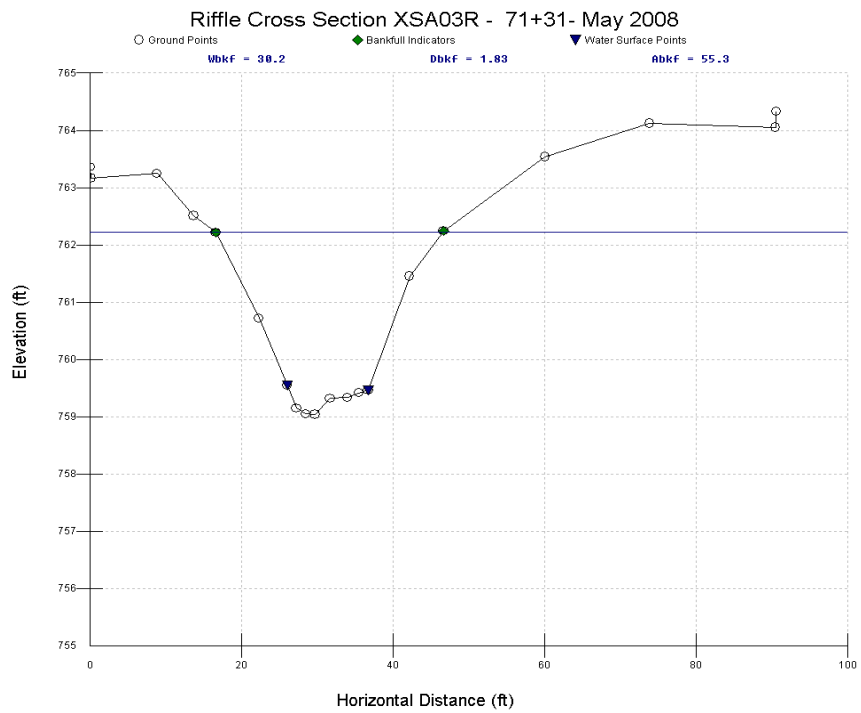

Upstream




Downstream



Left Bank



Right Bank

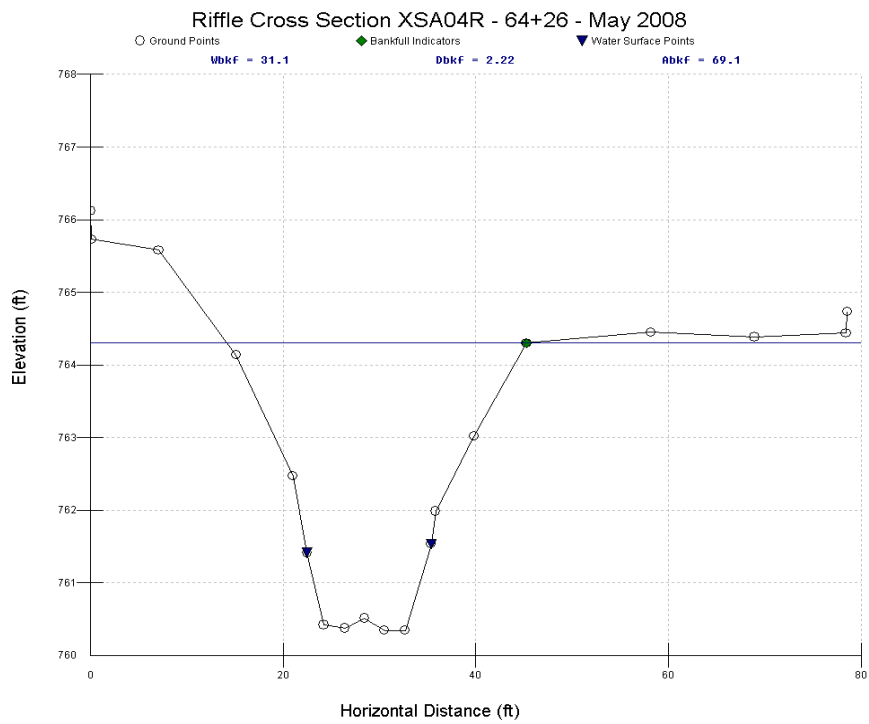

Upstream




Downstream



Left Bank




Right Bank

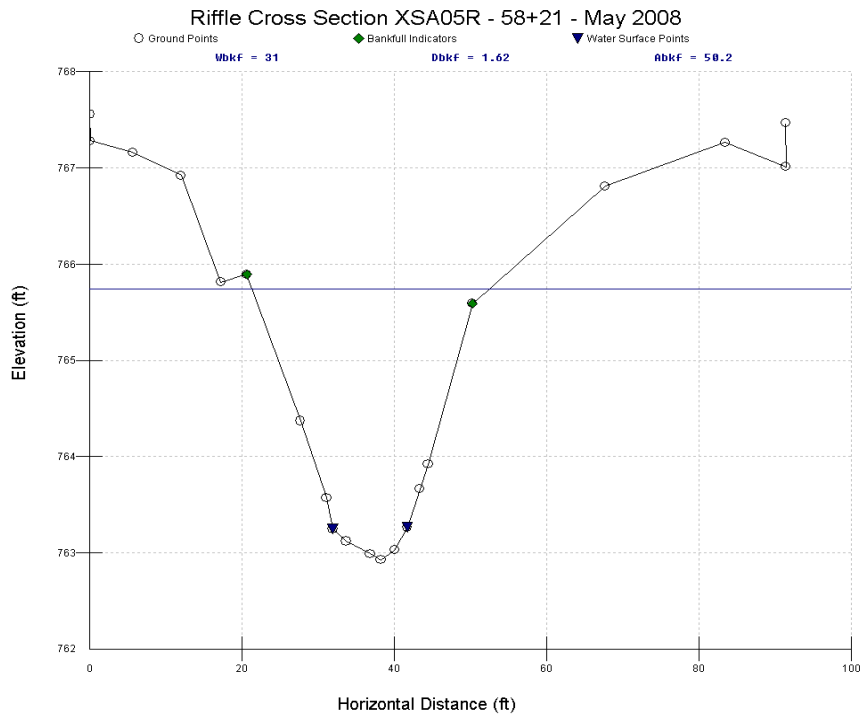

Upstream




Downstream

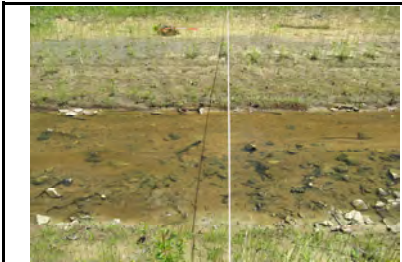

Left Bank



Right Bank

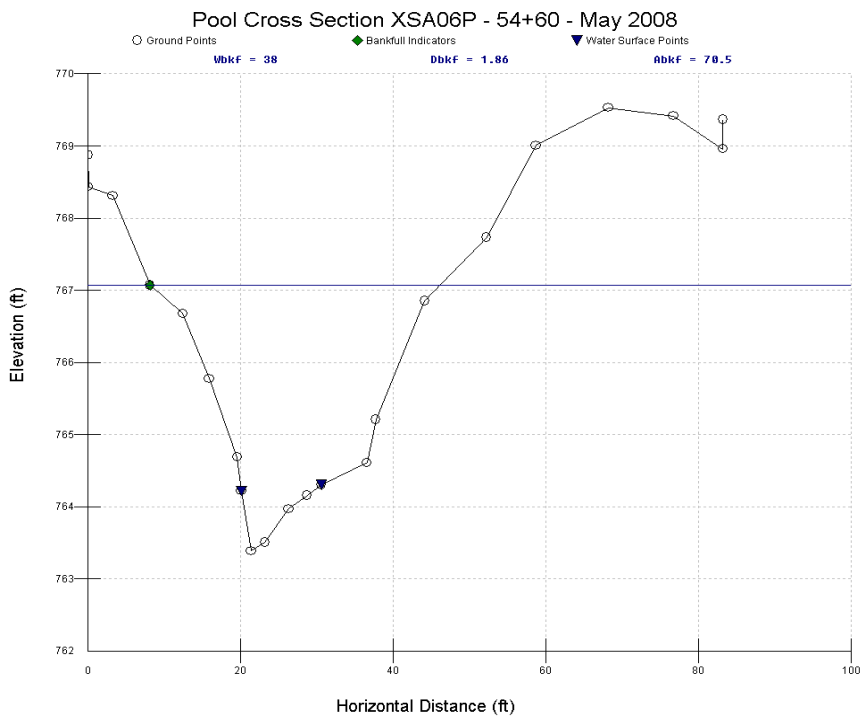

Upstream




Downstream



Left Bank



Right Bank

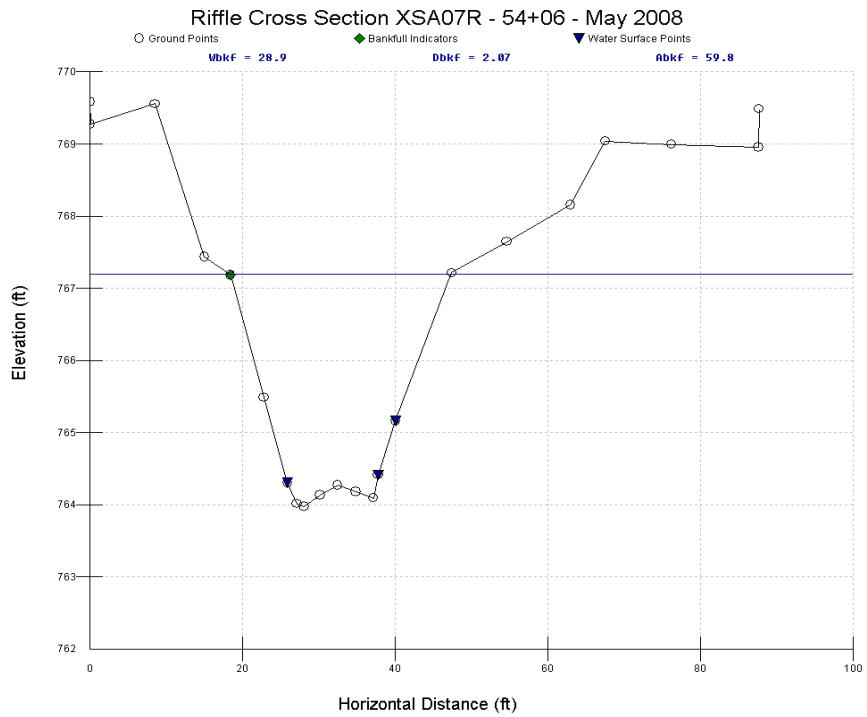

Upstream




Downstream



Left Bank



Right Bank

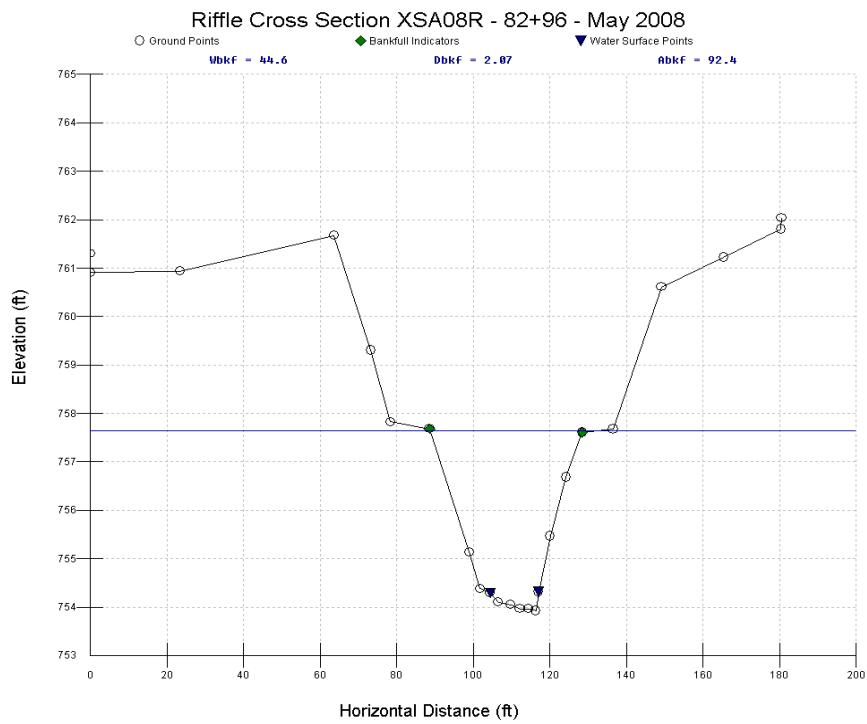


Upstream




Downstream



Left Bank

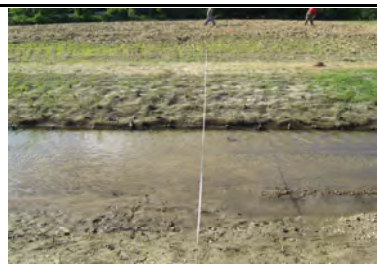

Right Bank

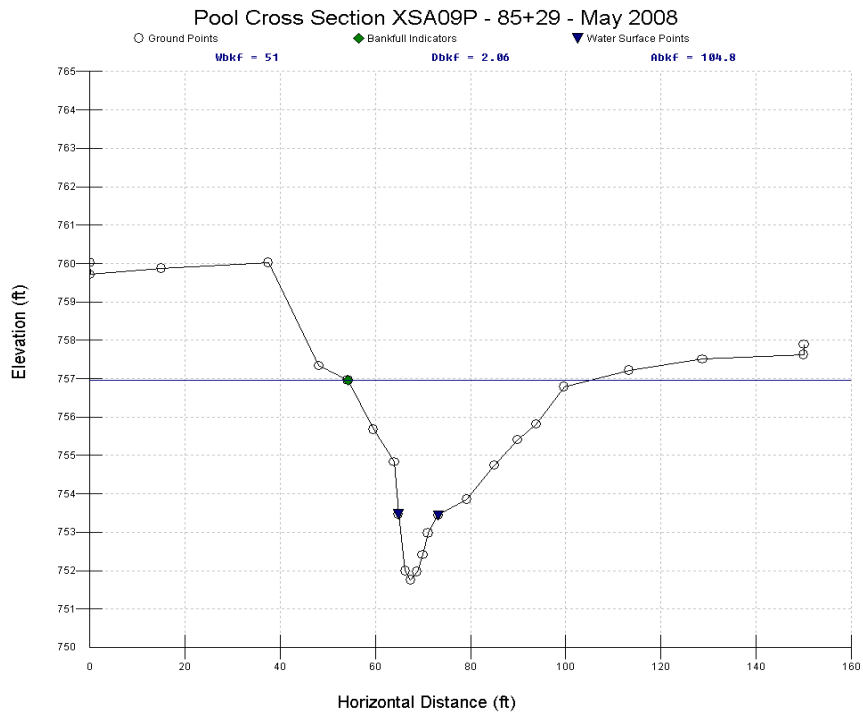

Upstream




Downstream



Left Bank




Right Bank

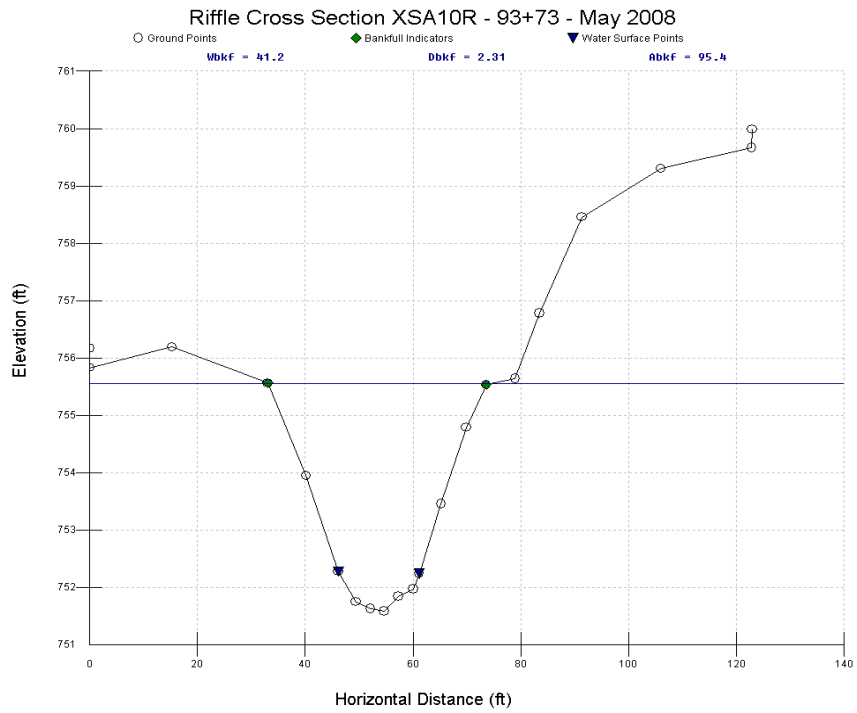

Upstream




Downstream

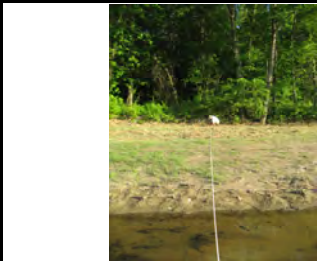

Left Bank



Right Bank

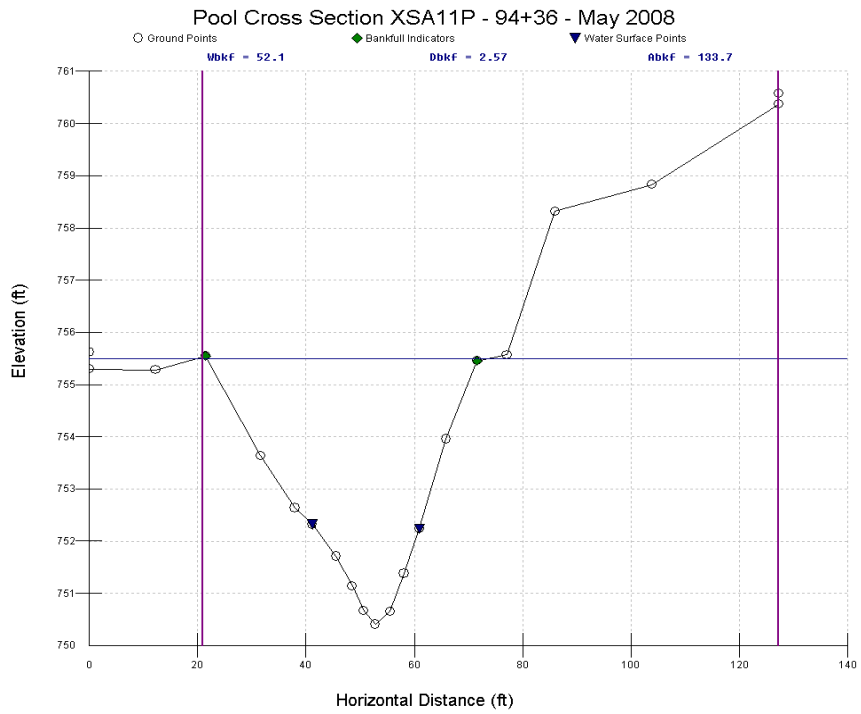

Upstream




Downstream



Left Bank



Right Bank

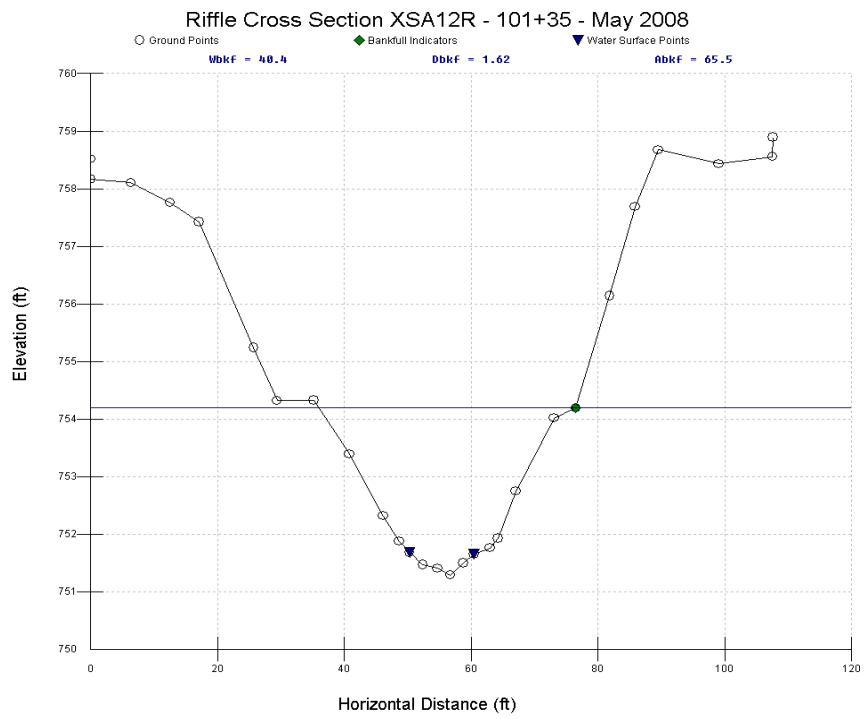

Upstream



Downstream




Left Bank



Right Bank

Riffle Cross Section XSB01R - 153+72 - July 2009

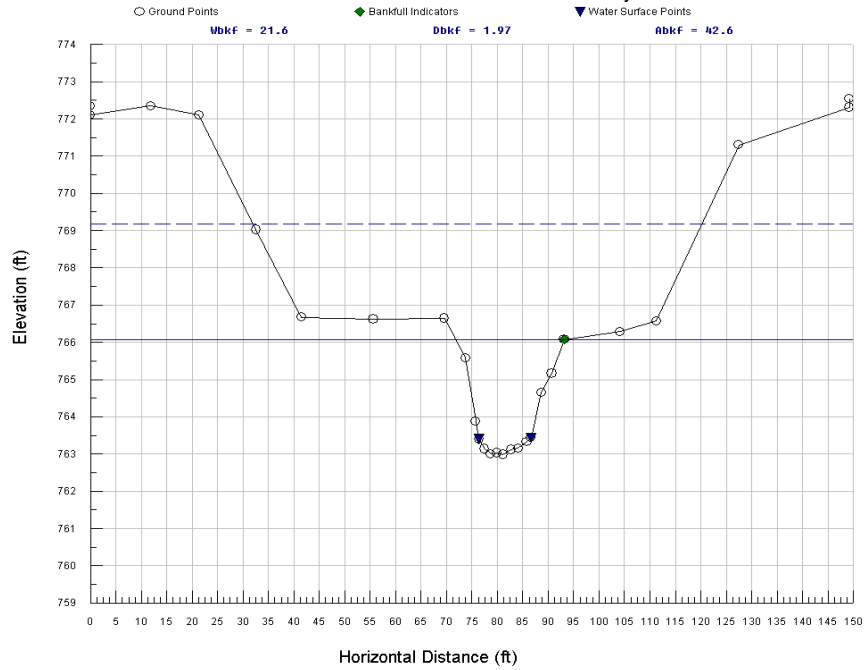

Upstream




Downstream



Left Bank



Right Bank

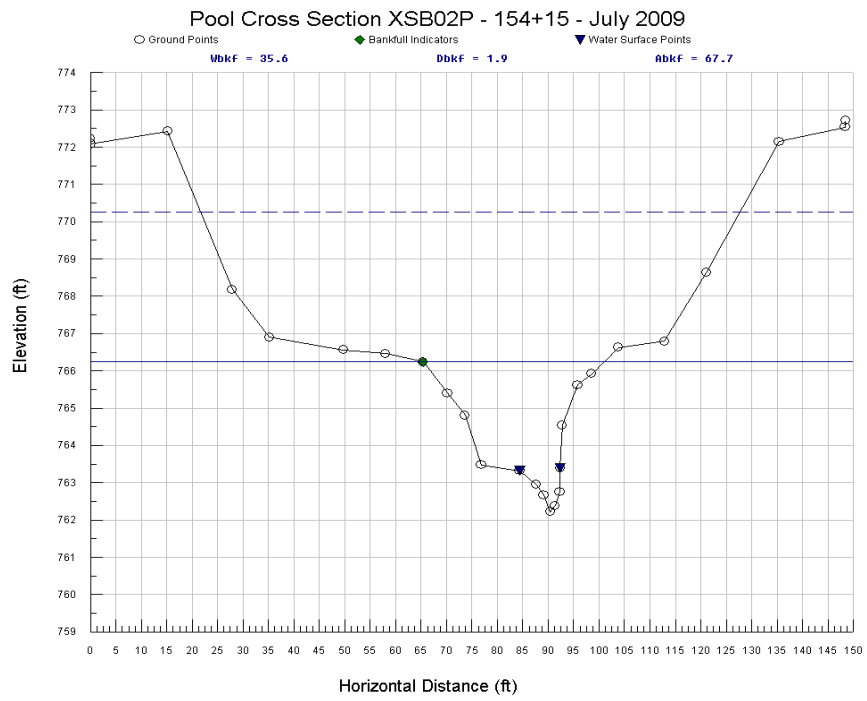

Upstream



Downstream




Left Bank



Right Bank

Riffle Cross Section XSB03R - 166+50 - July 2009

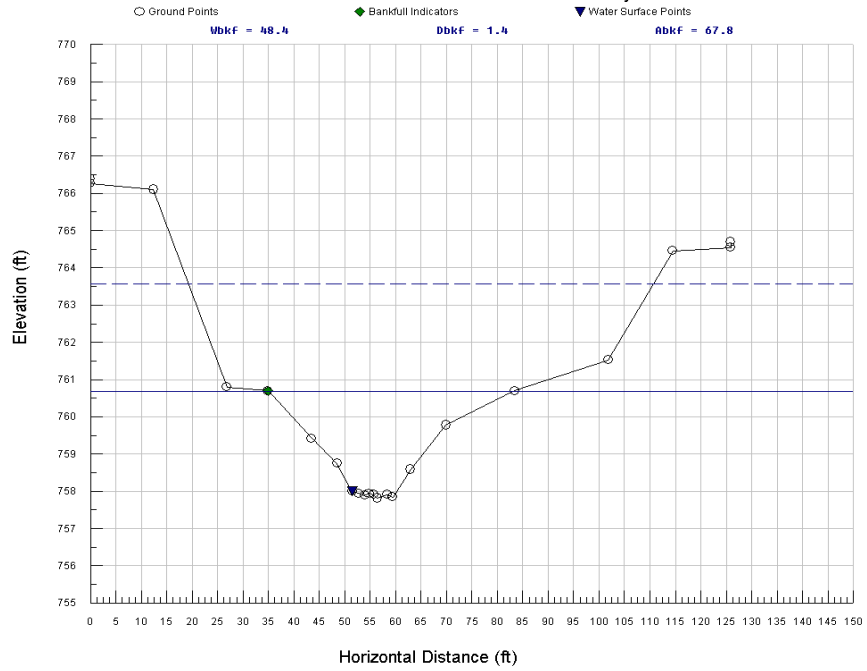

Upstream



Downstream




Left Bank



Right Bank

Pool Cross Section XSB04P - 166+85 - July 2009

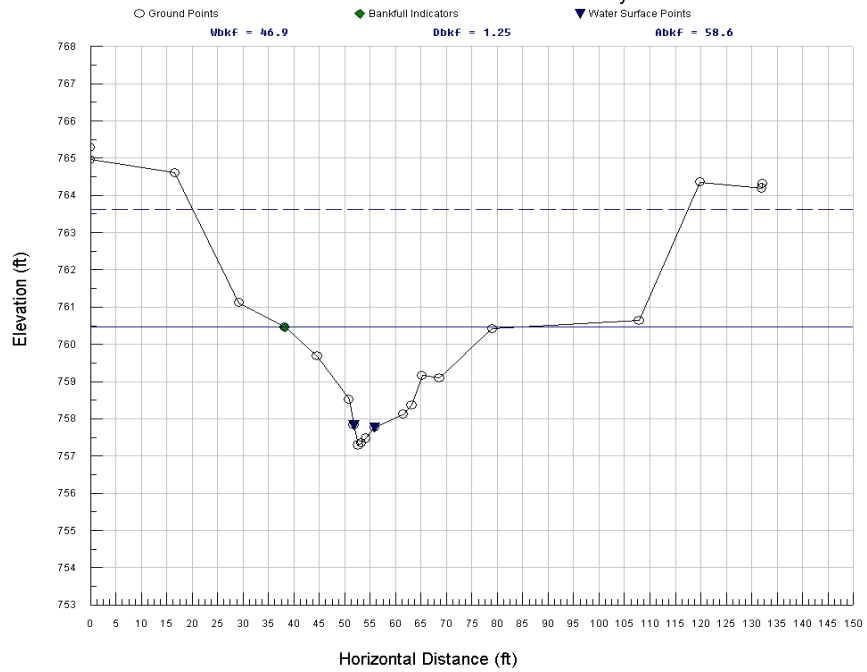

Upstream



Downstream



Left Bank




Right Bank

Riffle Cross Section XSB05R - 172+33 - July 2009

○ Ground Points ◆ Bankfull Indicators ▼ Water Surface Points

MBkF = 48.8 DBkF = .97 ABkF = 47.3

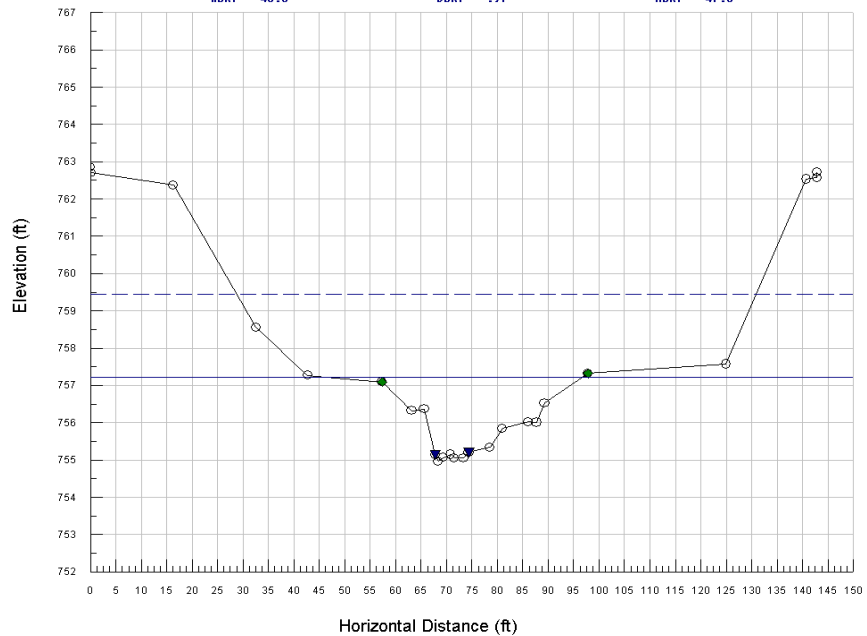

Upstream



Downstream




Left Bank



Right Bank

Pool Cross Section XSB06P - 172+60 - July 2009

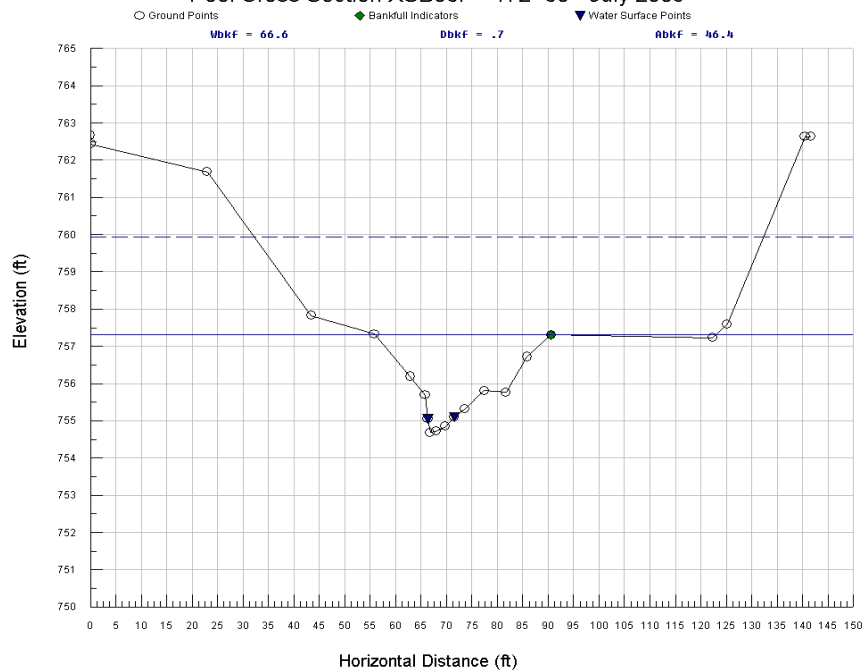

Upstream



Downstream




Left Bank



Right Bank

Riffle Cross Section XSC01R - 103+14 - May 2008

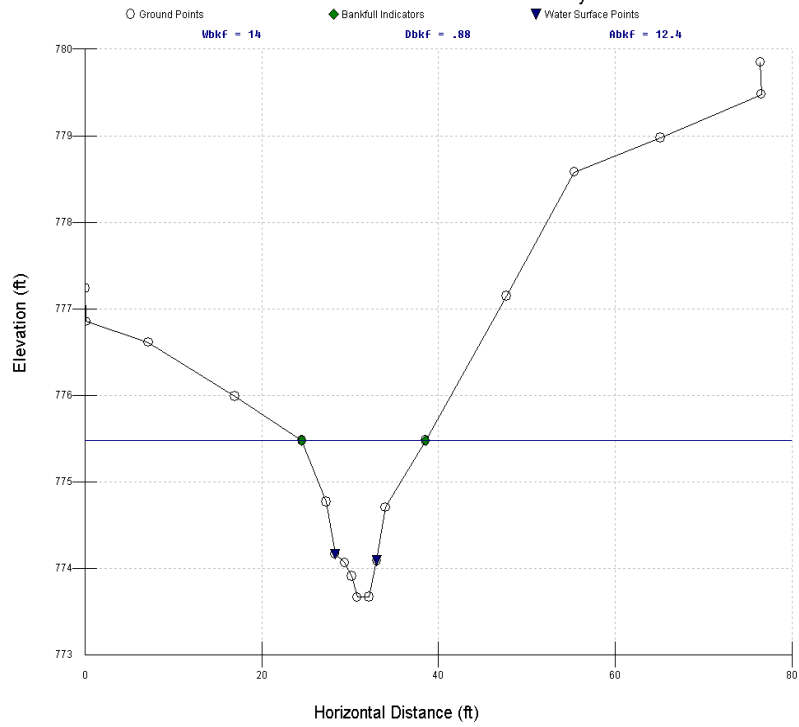

Upstream



Downstream




Left Bank



Right Bank


Pool Cross Section XSC02P - 103+95 - May 2008

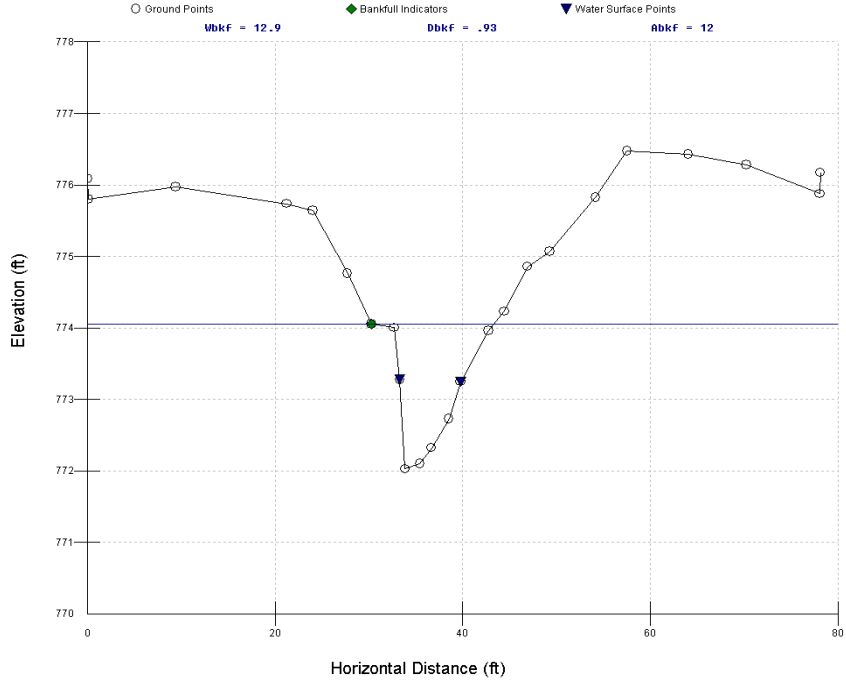

Upstream




Downstream

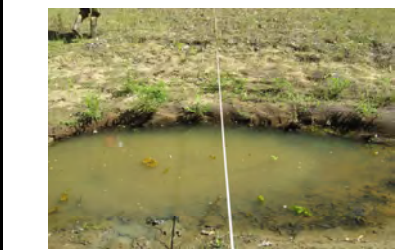

Left Bank



Right Bank

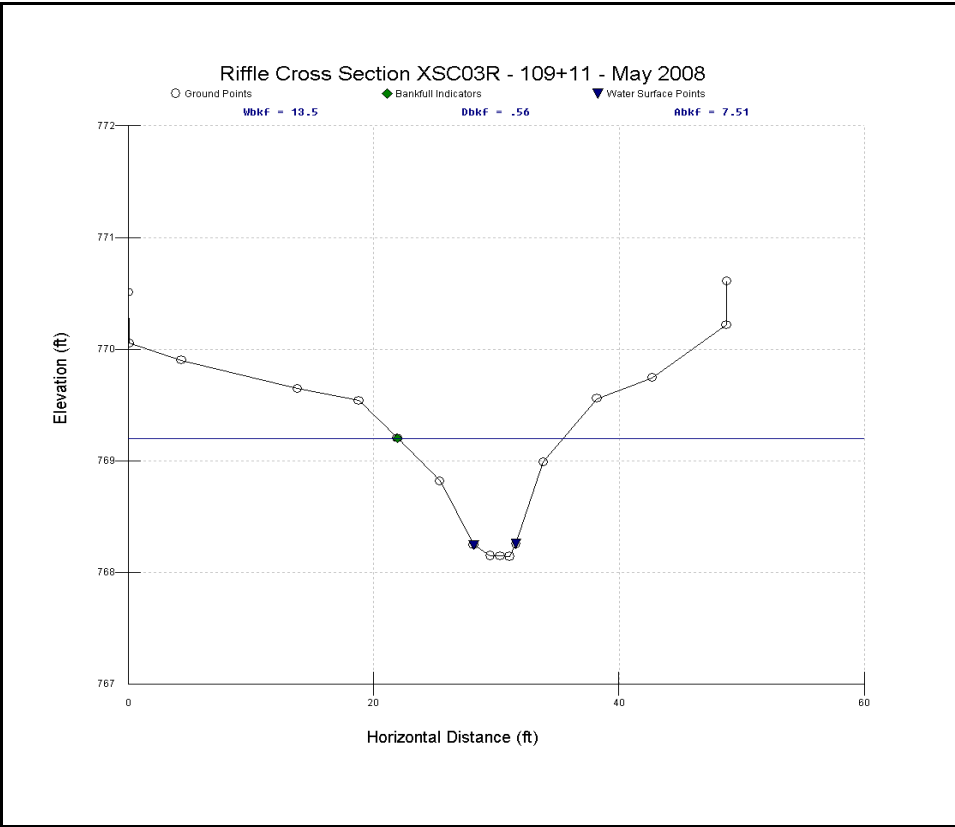

Upstream




Downstream



Left Bank



Right Bank

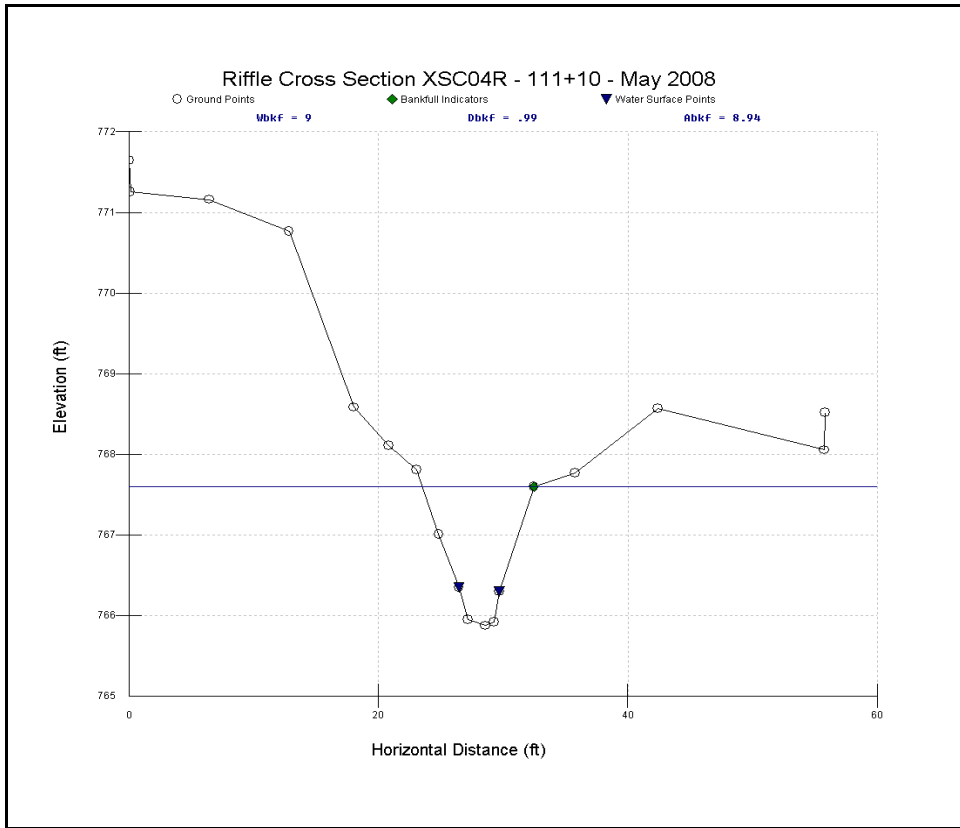

Upstream



Downstream



Left Bank



Right Bank

Vegetation Data

Stem counts for each species arranged by plot.

Valley Fields Farm/407

REACH A

Plots	1				2				3				4				5				6				7				8				9				10							
Year	2009				2008				2008				2008				2008				2008				2008				2008				2008				2008							
Species																																												
<i>Liriodendron tulipifera</i>	1																1				1																							
Unknown	3				1				1								1								2												4				6			
Unidentified					3				3				6				8								1				3								4				6			
<i>Alnus serrulata</i>																																												
<i>Betula nigra</i>	1																																											
<i>Carpinus caroliniana</i>	2																																											
<i>Quercus nigra</i>																																												
<i>Fraxinus pennsylvanica</i>																	1																											
<i>Cephalanthus occidentalis</i>																																												
<i>Crataegou crus-galli</i>					1																																							
<i>Sassafras albidum</i>																	1																											
<i>Quercus michauxii</i>					1																1																							
<i>Plantanus occidentalis</i>													2												3																			
<i>Acer rubrum</i>													1																3															
<i>Pinus echinata</i>																																												
<i>Acer negundo</i>																																												
Total Stems	7	0	0	0	6	0	0	0	6	0	0	0	7	0	0	0	13	0	0	0	4	0	0	0	8	0	0	0	3	0	0	0	6	0	0	0	12	0	0	0	0	0	0	0
Plot Size (acres)	0.0247	0.0247	Stems Per Acre	283	0	0	0	243	0	0	0	243	0	0	0	283	0	0	0	526	0	0	0	162	0	0	0	324	0	0	0	121	0	0	0	243	0	0	0	486	0	0	0	0	0	0	0
Stems Per acre Requirements	260	260	260	260	260	260	260	260	260	260	260	260	260	260	260	260	260	260	260	260	260	260	260	260	260	260	260	260	260	260	260	260	260	260	260	260	260	260	260	260				

Plots	11				12				13							
Year	2009				2008				2008							
Species																
<i>Liriodendron tulipifera</i>													1			
Unknown	10				10								4			
Unidentified	1												2			
<i>Alnus serrulata</i>																
<i>Betula nigra</i>																
<i>Carpinus caroliniana</i>																
<i>Quercus nigra</i>																
<i>Fraxinus pennsylvanica</i>					1											
<i>Cephalanthus occidentalis</i>																
<i>Crataegou crus-galli</i>																
<i>Sassafras albidum</i>																
<i>Quercus michauxii</i>																
<i>Plantanus occidentalis</i>																
<i>Acer rubrum</i>																
<i>Ilex opaca</i>					1											
<i>Acer negundo</i>													1			
Total Stems	11	0	0	0	12	0	0	0	8	0	0	0				
Plot Size (acres)	0.0247	0.0247	0.0247	0.0247	0.0247	0.0247	0.0247	0.0247	0.0247	0.0247	0.0247	0.0247	0.0247	0.0247	0.0247	0.0247
Stems Per Acre	445	0	0	0	486	0	0	0	324	0	0	0				
Stems Per acre Requirements	260	260	260	260	260	260	260	260	260	260	260	260				

Stem counts for each species arranged by plot.

Valley Fields Farm/407

WETLAND

Plots	1				2				3				4			
	2008				2008				2008				2008			
Year	2008				2008				2008				2008			
Species																
<i>Liriodendron tulipera</i>													1			
Unknown	3								4				4			
Unidentified	4				4				5							
<i>Alnus serrulata</i>																
<i>Betula nigra</i>																
<i>Carpinus caroliniana</i>																
<i>Quercus nigra</i>																
<i>Fraxinus pennsylvanica</i>																
<i>Cephalanthus occidentalis</i>																
<i>Crataegou crus-galli</i>																
<i>Sassafras albidum</i>																
<i>Quercus michauxii</i>																
<i>Plantanus occidentalis</i>																
<i>Acer rubrum</i>																
<i>Pinus echinata</i>																
<i>Salix nigra</i>																
<i>Ulmus americana</i>																
<i>Cornus amomum</i>	1				3								1			
<i>Ilex opaca</i>					1											
Total Stems	8	0	0	0	8	0	0	0	9	0	0	0	6	0	0	0
Plot Size (acres)	0.0247	0.0247	0.0247	0.0247	0.0247	0.0247	0.0247	0.0247	0.0247	0.0247	0.0247	0.0247	0.0247	0.0247	0.0247	0.0247
Stems Per Acre	324	0	0	0	324	0	0	0	364	0	0	0	243	0	0	0
Stems Per acre Requirements	260	260	260	260	260	260	260	260	260	260	260	260	260	260	260	260

Permanent Monitoring Photographs

Photo Page 1



Monitoring Photo PA01: Looking downstream (July 1, 2008)



Monitoring Photo PA02: Looking downstream (July 1, 2008)

Photo Page 2



Monitoring Photo PA03: Looking upstream (July 1, 2008)



Monitoring Photo PA04: Looking upstream, where Reach C joins Reach A (July 1, 2008)

Photo Page 3



Monitoring Photo PA05: Looking downstream (July 1, 2008)



Monitoring Photo PA06: Looking at right bank (July 1, 2008)

Photo Page 4



Monitoring Photo PA07: Looking at right bank (July 1, 2008)



Monitoring Photo PA08: Looking downstream (July 1, 2008)

Photo Page 5



Monitoring Photo PA09: Looking at right bank (July 1, 2008)



Monitoring Photo PA10: Looking at left bank (July 9, 2009)

Photo Page 6



Monitoring Photo PA13: Looking upstream (July 9, 2009)



Monitoring Photo PA14: Looking upstream (July 1, 2008)

Photo Page 7



Monitoring Photo PA11: Looking upstream, where Reach B joins Reach A (July 9, 2009)



Monitoring Photo PA12: Looking downstream (July 1, 2008)

Photo Page 8



Monitoring Photo PA13: Looking downstream (July 1, 2008)



Monitoring Photo PA14: Looking at left bank (July 1, 2008)

Photo Page 9



Monitoring Photo PA15: Looking downstream (July 1, 2008)



Monitoring Photo PA16: Looking downstream (July 1, 2008)

Photo Page 10



Monitoring Photo PA17: Looking downstream (July 1, 2008)



Monitoring Photo PB01: Looking towards road (July 9, 2009)

Photo Page 11



Monitoring Photo PB02: Looking upstream (July 9, 2009)



Monitoring Photo PB03: Looking downstream (July 9, 2009)

Photo Page 12



Monitoring Photo PB04: Looking upstream (July 9, 2009)



Monitoring Photo PB05: Looking across stream (July 9, 2009)

Photo Page 13



Monitoring Photo PB06: Looking downstream (July 9, 2009)



Monitoring Photo PB07: Looking across stream (July 9, 2009)

Photo Page 14



Monitoring Photo PB08: Looking downstream (July 9, 2009)



Monitoring Photo PB09: Looking downstream (July 9, 2009)

Photo Page 15



Monitoring Photo PB10: Looking downstream, where Reach B joins Reach A (July 9, 2009)



Monitoring Photo PB11: Looking upstream (July 9, 2009)



Monitoring Photo PC01: Looking downstream (July 1, 2008)



Monitoring Photo PC02: Looking upstream (July 1, 2008)



Monitoring Photo PC03: Looking upstream (July 1, 2008)



Monitoring Photo PC04: Looking downstream (July 1, 2008)

Photo Page 18



Monitoring Photo PC05: Looking upstream (July 1, 2008)



Monitoring Photo PC06: Looking upstream (July 1, 2008)



Monitoring Photo PD01: Looking downstream (July 9, 2009)



Monitoring Photo PD02: Looking upstream (July 9, 2009)

Vegetation Quad
Photographs

Photo Page 1



Vegetation Quad Photo VQA1: Looking into Quad from Origin (July 9, 2009)



Vegetation Quad Photo VQA2: Looking into Quad from Origin (June 19, 2008)

Photo Page 2



Vegetation Quad Photo VQA3: Looking into Quad from Origin (July 1, 2008)



Vegetation Quad Photo VQA4: Looking into Quad from Origin (July 1, 2008)



Vegetation Quad Photo VQA5: Looking into Quad from Origin (July 1, 2008)



Vegetation Quad Photo VQA6: Looking into Quad from Origin (July 1, 2008)

Photo Page 4



Vegetation Quad Photo VQA7: Looking into Quad from Origin (July 1, 2008)



Vegetation Quad Photo VQA8: Looking into Quad from Origin (June 19, 2008)

Photo Page 5



Vegetation Quad Photo VQA9: Looking into Quad from Origin (June 19, 2008)



Vegetation Quad Photo VQA10: Looking into Quad from Origin (June 19, 2008)

Photo Page 6



Vegetation Quad Photo VQA11: Looking into Quad from Origin (July 1, 2008)



Vegetation Quad Photo VQA12: Looking into Quad from Origin (July 1, 2008)

Photo Page 7



Vegetation Quad Photo VQA13: Looking into Quad from Origin (July 1, 2008)



Vegetation Quad Photo VQB1: Looking into Quad from Origin (July 9, 2009)

Photo Page 8



Vegetation Quad Photo VQB2: Looking into Quad from Origin (July 9, 2009)



Vegetation Quad Photo VQB3: Looking into Quad from Origin (July 9, 2009)

Photo Page 9



Vegetation Quad Photo VQB4: Looking into Quad from Origin (July 9, 2009)



Vegetation Quad Photo VQB5: Looking into Quad from Origin (July 9, 2009)



Raw Data

Reach	Station (ft)	Elevation (ft)			Grade Control
		Thalweg	Edge of Water	Bankfull	
A	5000.00	763.78			
	5001.26		765.15		
	5043.65	765.07			x
	5044.39		765.22		
	5044.89		765.31		
	5053.25	763.90			
	5067.88			766.74	
	5071.39		764.65		
	5074.98	763.93		768.19	
	5075.58				
	5091.73			767.29	
	5100.22				
	5100.69		764.63		
	5100.95	764.28		767.75	
	5110.57			767.36	
	5165.67			767.59	
	5167.07		764.50		
	5167.17	764.16			
	5170.04				
	5172.28			767.56	
	5196.74			767.29	
	5206.32		764.48		
	5208.86				
	5208.92	763.66		767.07	
	5257.21			767.20	
	5257.61				
	5257.62		764.61		
	5257.81	764.23		767.22	
	5306.12				
	5308.47		764.48		
	5310.87	764.12		767.86	
	5343.80		764.35		
	5344.80	764.02		767.08	
	5355.14			766.89	
	5378.02	764.02			
	5378.45			767.10	
	5379.57		764.27		
	5381.67			766.80	
	5457.36			766.70	
	5465.42	763.26			
	5467.84		764.08		
	5468.43			766.91	
	5510.46			767.15	
	5511.14		763.62		
	5511.39				

	5512.12	763.63		767.16	x
	5523.40	761.59			
	5542.40			766.69	
	5544.27		763.28		
	5545.86	761.45		767.09	
	5548.21				
	5570.71			766.71	
	5580.44				
	5582.58	762.37		766.39	
	5610.63			766.60	
	5612.98	763.04			
	5613.01				
	5614.17				
	5615.55			766.35	
	5663.74			766.07	
	5667.15	762.75		766.16	
	5667.23		762.92		
	5668.41				
	5681.14			766.38	
	5688.76				
	5689.93	762.47		765.70	
	5709.21	762.58	762.97		
	5709.50			766.29	
	5710.07		763.03		
	5713.21			766.08	
	5762.82			765.88	
	5768.52	763.05			
	5769.01		763.08		
	5772.30			765.54	
	5807.56			765.92	
	5808.25				
	5808.92	763.02	763.04		
	5836.77	762.99			x
	5836.95			765.66	
	5837.20				
	5837.45				
	5838.20			765.43	
	5844.78	762.35			
	5882.27			764.80	
	5887.56		762.88		
	5890.02	761.94		765.61	
	5917.48			765.51	
	5918.73				
	5919.34	762.72			
	5920.31				
	5922.18			765.27	
	5961.89			765.39	

	5962.63		762.85		
	5963.87	762.69		764.63	
	6005.77	762.74		765.40	x
	6007.04				
	6008.47		762.94		
	6010.91			765.37	
	6014.43	762.49			
	6037.24				
	6037.77		762.70		
	6038.39	761.94		765.17	
	6100.28	762.50	762.89	765.23	
	6102.48				
	6108.02				
	6115.30			765.56	
	6115.71		762.82		
	6120.12	761.97			
	6133.28				
	6138.38	762.28			
	6141.84		762.73		
	6146.93	761.91			
	6147.41				
	6147.54				
	6170.23				
	6170.28		762.66		
	6170.95	762.25			
	6202.30				
	6203.84	761.37			
	6204.33		762.41		
	6205.20				
	6225.06	759.98		765.24	
	6237.38		762.27		
	6249.23		762.20		
	6252.88	759.39			
	6256.38			764.86	
	6269.11				
	6269.97			764.33	
	6275.63			765.00	
	6276.69				
	6277.11	762.01	762.21		
	6277.50				
	6280.46			764.11	
	6282.79				
	6313.45				
	6313.50			764.40	
	6313.68	761.62		764.40	x
	6314.31			764.26	
	6314.52		761.82		

	6320.60	758.91			
	6339.40			764.44	
	6340.82	759.44			
	6341.18		761.37		
	6343.65				
	6343.67			764.32	
	6363.67		761.23		
	6363.68			764.19	
	6366.95	758.46			
	6367.35				
	6368.01			764.16	
	6408.51				
	6408.60			764.28	
	6409.83	759.87		764.14	
	6410.85		761.15		
	6434.32	760.16		764.26	
	6436.83				
	6437.30			764.15	
	6484.03			764.03	
	6485.20	760.82		764.27	x
	6485.69		761.06		
	6485.73				
	6494.81	758.12			
	6523.35			763.32	
	6527.82				
	6531.02	760.26		763.75	
	6532.27		760.92		
	6563.07	759.26		763.75	
	6563.36				
	6564.69				
	6566.40			763.44	
	6604.74			763.01	
	6606.51	760.67			x
	6606.57		760.73		
	6607.93				
	6608.55				
	6613.00	757.75			
	6632.69			762.50	
	6633.56				
	6635.83	758.05		763.03	
	6687.59	759.64		763.37	
	6687.66				
	6689.46		760.40		
	6690.10			762.96	
	6735.40				
	6736.40	759.82	760.29	762.35	
	6738.28			763.26	

	6773.76			762.82	
	6774.91	760.07			x
	6775.33				
	6775.69		760.26		
	6776.35			763.01	
	6782.18	758.28			
	6811.94			762.46	
	6814.66		759.85		
	6819.00	758.14		762.83	
	6842.69			763.14	
	6844.51		759.76		
	6845.40	759.53			
	6845.80				
	6846.10			762.37	
	6891.56			762.79	
	6892.67				
	6892.90	759.25			
	6893.55				
	6893.62			762.69	
	6894.26			762.79	
	6937.21			762.74	
	6937.50				
	6938.26	759.64			
	6939.38		759.93		
	6940.64			762.87	
	6976.00				
	6976.22		759.85		
	6976.70			762.52	
	6977.52	759.10			
	6979.14			762.43	
	7019.97				
	7020.78	759.71	759.88	762.20	x
	7022.61			762.21	
	7030.15	757.54			
	7056.79		759.52		
	7058.03			762.20	
	7062.60	757.85			
	7063.14				
	7064.11			761.77	
	7107.52	758.70			
	7107.97				
	7109.11			762.25	
	7109.97			762.22	
	7110.49		759.25		
	7144.69		759.34		
	7145.57	759.28			x
	7154.80	757.39			

	7174.23				
	7177.59		758.96		
	7178.15	757.35			
	7178.21	757.36			
	7206.27				
	7207.67	758.93		761.29	
	7208.87				
	7216.74	757.71			
	7217.43		759.00		
	7254.80				
	7255.63	758.09	758.74	761.46	
	7297.42	758.46		761.53	x
	7297.42		758.72		
	7300.13				
	7310.93	756.16			
	7324.17			761.57	
	7324.22				
	7326.79	757.19			
	7330.34				
	7345.21	757.20	758.54		
	7347.34				
	7351.55			761.54	
	7382.34			761.13	
	7383.30				
	7384.69		758.36		
	7385.05	757.65			
	7426.65			761.31	
	7426.70		758.46		
	7426.76				
	7428.33	758.28			x
	7441.32	756.36			
	7472.35		758.24		
	7475.78	756.36		760.46	
	7517.93		758.05		
	7521.74	757.04		760.51	
	7522.79				
	7560.51			761.03	
	7564.76	757.10	757.85		x
	7565.17			760.89	
	7565.86				
	7574.65	755.82			
	7604.06			759.85	
	7608.44		757.67		
	7611.60	757.13			x
	7612.92				
	7615.43			760.52	
	7621.06	755.83			

	7644.90	756.20	757.22	760.11	
	7647.16				
	7651.17			760.04	
	7695.50			759.98	
	7697.09	756.81			x
	7697.83		757.02		
	7699.43			759.73	
	7710.55			759.64	
	7713.76			758.95	
	7720.22	754.60			
	7726.04				
	7726.95		756.36		
	7740.81			759.72	
	7744.61			759.35	
	7751.52				
	7753.59	754.86			
	7803.37	755.72	756.31	759.21	
	7803.70				
	7803.94			759.14	
	7850.33			758.59	
	7857.58		756.13		
	7858.01	756.01		759.10	x
	7858.49				
	7865.52	753.88			
	7886.33	754.25	755.93	759.08	
	7892.93				
	7894.84			758.13	
	7902.77				
	7903.65	755.73			
	7905.27				
	7911.40	755.03			
	7922.10			758.78	
	7922.58			757.73	
	7925.60	754.27			
	7928.53		755.74		
	7960.03				
	7960.58	755.43		758.71	
	7960.85		755.50		
	7962.82			758.22	
	7996.77				
	7997.46		755.68		
	7998.02	755.56			x
	8001.54			757.93	
	8003.12			757.45	
	8005.08	753.16			
	8019.29			757.18	
	8025.45				

	8027.77	753.56		758.06	
	8035.13				
	8037.27	753.88		758.25	
	8052.77			758.07	
	8056.88		755.01		
	8057.64				
	8057.95	754.07			
	8061.92			757.63	
	8103.65			757.78	
	8103.78	754.66	754.81	757.78	
	8104.78				
	8106.12			757.59	
	8154.41			757.52	
	8154.84				
	8155.63			757.48	
	8162.27		754.84		
	8163.80				
	8164.32	754.88			x
	8171.71	752.73			
	8185.05			756.87	
	8189.14		754.21		
	8191.38				
	8193.60				
	8199.93	753.45			
	8206.72		754.19		
	8209.64	753.88			
	8212.47	753.95			
	8212.56				
	8214.65				
	8217.99	754.09			
	8227.19			757.26	
	8227.61				
	8228.02	753.33			
	8245.31	753.99			
	8246.05		754.22		
	8248.26	753.70			
	8248.35				
	8267.58		754.14		
	8268.20			757.47	
	8269.25	753.37			
	8271.33			757.92	
	8272.02			757.35	
	8315.01			757.39	
	8316.06		754.12		
	8317.15	753.96		757.86	
	8317.63				
	8362.37			757.48	

	8367.79	753.87	753.96	757.67	x
	8401.18			757.38	
	8401.55				
	8402.65	753.09			
	8407.43		753.96		
	8409.63			757.57	
	8440.09	752.81			
	8440.20				
	8440.84				
	8442.81			757.40	
	8449.10			757.16	
	8453.30	753.63			
	8454.23				
	8456.58				
	8491.51			756.84	
	8494.76		753.97		
	8495.83	753.81			x
	8496.26				
	8501.42			756.59	
	8503.63	751.07			
	8514.44				
	8529.30				
	8533.47	751.83	753.46	757.02	
	8543.20			756.57	
	8577.77	752.71	753.35		
	8579.86				
	8584.86			756.83	
	8624.68			756.95	
	8627.15				
	8628.97	752.60	753.23	756.92	
	8664.57	753.00			x
	8665.86			756.80	
	8666.80		753.27		
	8668.45			756.59	
	8689.04	751.35			
	8689.33			756.57	
	8709.34	752.31		756.79	
	8711.75		753.21		
	8718.61			756.88	
	8745.16			756.83	
	8749.21				
	8751.09		753.02		
	8751.68	752.63			
	8755.43				
	8756.07			757.19	
	8757.70	751.58			
	8760.29				

	8767.92	751.34			
	8794.16		752.84		
	8794.18			756.90	
	8795.24	751.74			
	8798.95				
	8804.72			756.75	
	8835.95			756.72	
	8840.67	752.93			
	8840.86		753.05		
	8841.78				
	8845.09			756.55	
	8868.11			756.51	
	8877.47	752.43	752.86	756.06	
	8900.62	752.19	752.86	755.64	
	8911.49			756.44	
	8931.51	752.45	752.78	756.36	
	8939.12			756.20	
	8968.26			756.38	
	8970.77		752.67		
	8974.44	752.40			
	8976.77			756.11	
	9025.03			756.01	
	9025.17	752.29		756.01	
	9027.01			756.17	
	9041.41	752.29			x
	9048.07			756.08	
	9049.84		752.53		
	9051.49	751.96			
	9052.30				
	9056.54			755.62	
	9064.38	752.31			
	9066.25				
	9068.42				
	9069.23	752.13			
	9084.16	752.29	752.49	755.88	
	9087.12	751.83			
	9087.64				
	9105.64		752.20		
	9105.72	752.09			
	9106.99	752.00			
	9107.89				
	9116.69	752.13			
	9125.72			755.94	
	9140.96			755.83	
	9140.96				
	9142.17		752.37		
	9142.41	750.72			

	9142.51		752.37		
	9144.09			756.11	
	9200.01			755.64	
	9200.93				
	9202.08	752.24	752.27	755.85	x
	9216.81	750.74			
	9220.37				
	9221.07			755.39	
	9227.41			755.92	
	9239.14			755.73	
	9239.46				
	9241.45			755.54	
	9242.66				
	9248.95				
	9251.72				
	9253.92	750.37	752.32	755.32	
	9255.29				
	9256.66				
	9289.84				
	9291.78			755.67	
	9293.80				
	9294.81	750.97			
	9303.97			755.51	
	9338.66			755.63	
	9340.05		752.30		
	9341.45				
	9341.57	751.66			
	9342.80			755.50	
	9373.24			755.63	
	9391.63				
	9391.69	751.65		755.45	
	9392.40		752.21		
	9428.17			755.49	
	9431.88				
	9433.94	750.58	752.18	755.43	
	9460.63		752.21		
	9461.82	751.54			
	9461.97				
	9465.22				
	9473.34			755.44	
	9500.03			755.24	
	9501.35				
	9505.04	751.35			
	9505.95				
	9508.53			755.37	
	9542.18				
	9543.02	751.71			

	9544.19			755.23	
	9544.54			755.10	
	9545.10		752.12		
	9572.82	751.84			x
	9573.18				
	9573.85			754.95	
	9574.16		752.12		
	9577.13			755.39	
	9582.03	750.11			
	9595.59				
	9617.23			755.07	
	9620.54				
	9621.26	751.05			
	9623.81		751.83		
	9625.69			755.12	
	9672.75				
	9673.07	751.50			
	9673.16		751.95		
	9673.48			754.43	
	9675.11			754.55	
	9721.83	751.48		754.45	
	9722.77		751.78		
	9724.35			754.63	
	9755.33	750.51		754.58	
	9759.55		751.70		
	9765.03			754.81	
	9802.58			754.79	
	9806.80	750.32			
	9807.57				
	9807.59			754.54	
	9808.10		751.72		
	9869.47			754.29	
	9870.75				
	9873.18		752.03		
	9873.26	751.37		754.58	
	9924.55			754.51	
	9927.83	751.36		754.55	
	9927.90				
	9932.22		751.92		
	9932.93				
	9948.83			754.20	
	9955.75		751.92		
	9958.17			754.24	
	9960.03				
	9960.57	751.58			
	9966.21				
	9987.93			754.39	

	9989.21				
	9989.29	751.45			x
	9993.00				
	9994.72			753.45	
	9997.76	749.18		754.49	
	10001.84			754.24	
	10025.86	749.67		754.13	
	10028.00		751.54		
	10029.83			753.68	
	10053.72			754.05	
	10055.57		751.61		
	10059.62	750.54		754.04	
	10135.03			754.12	
	10135.47		751.60		
	10135.60	751.12		754.16	
	10135.77				
	10135.84		751.60		
	10136.07			754.12	
	10178.82			754.21	
	10180.25				
	10180.99	751.14			x
	10182.10			754.09	
	10182.10		751.38		
	10192.08	749.72			
	10206.08				
	10206.25			753.76	
	10207.57		751.37		
	10209.05	750.38			
	10211.76			753.28	
	10255.21			754.05	
	10255.75				
	10256.02	748.58			
	10258.23				
	10260.04			753.82	
	10291.58	750.07			
	10293.78			753.92	
	10293.97		751.26		
	10294.44				
	10298.95			754.00	
	10322.47		751.25		
	10325.20				
	10326.19	750.88		754.02	

B	15550.00	762.73	763.40		x
	15566.82	762.35	763.39		
	15580.60	762.04	763.39		
	15580.82		763.39	765.05	

	15592.17	762.64	763.39		
	15599.60	762.83	763.38		
	15606.17			765.14	
	15612.65	762.87	763.38		
	15632.75	762.99	763.39		
	15632.78	762.99		765.37	
	15651.15	762.95	763.38		
	15661.26			764.96	
	15663.27	762.73	763.38		
	15675.75	762.34	763.39		
	15677.23	762.21		765.40	
	15678.35	762.37	763.38		
	15686.20	761.95	763.37		
	15690.84			765.28	
	15693.92	762.50	763.38		
	15704.38	762.56	763.37		
	15717.96		763.36	765.06	
	15720.69	763.24	763.38		x
	16850.00	757.44	758.12		
	16856.27			760.41	
	16860.82	757.91	758.10		
	16872.30	757.19	758.06		
	16882.04	757.48	758.04		
	16887.61	756.33	758.04		
	16906.71	757.23	758.02		
	16914.41			759.75	
	16926.17	757.57	757.98		
	16939.44	757.82		759.60	
	16940.20	757.73	757.86		
	16960.09	757.71	757.80		
	16975.30	757.36	757.78		
	16976.33	757.29		760.46	
	16996.27			759.79	
	16996.84	757.41	757.77		
	17016.34	757.42	757.75		
	17020.05	757.52	757.73		
	17055.79			760.00	
	17060.24	757.24	757.38		x

C	10000.00	776.38		778.08	
	10002.09			777.86	
	10018.50			777.96	
	10020.33				
	10021.64	776.67			x
	10021.95				
	10022.98		776.87		
	10024.98			777.51	

	10025.13			778.10	
	10028.54	775.47			
	10052.00	775.89		777.49	
	10052.55		776.21		
	10053.96			777.48	
	10098.73			777.66	
	10099.88		775.81		
	10100.60	775.71			x
	10101.94			776.65	
	10109.65	774.76			
	10128.09			777.63	
	10129.11		775.40		
	10131.83			777.28	
	10155.54			776.57	
	10156.13			776.21	
	10156.45	775.02			
	10156.53		775.13		
	10157.25				
	10163.41	774.97			x
	10177.71			776.10	
	10181.65	774.94		776.22	
	10182.71		775.03		
	10215.22			775.70	
	10215.32				
	10215.60				
	10215.65	774.68	774.98		
	10216.22			776.06	
	10253.84				
	10254.43	774.80	774.84	775.88	x
	10255.58			776.09	
	10263.32	773.03			
	10280.20	773.88	774.27	775.10	
	10286.81			775.97	
	10325.36			775.67	
	10325.72			775.15	
	10325.78	773.97		775.15	x
	10325.92		774.17		
	10326.16				
	10333.09	772.51			
	10346.04	773.19		775.41	
	10347.01		773.33		
	10350.63			775.28	
	10387.99		773.07		
	10389.66	771.88		774.04	
	10389.75				
	10395.14			774.56	
	10427.56			774.48	

	10431.09				
	10431.16	772.61		773.82	
	10432.20				
	10450.54			773.57	
	10453.42				
	10454.67	773.07	773.24	773.80	x
	10461.33	771.54			
	10473.17			773.60	
	10474.93				
	10480.27	771.40		773.86	
	10507.47			773.24	
	10509.46				
	10509.89	772.58	772.57	773.68	x
	10515.94	770.89			
	10530.65	770.63		773.15	
	10533.79				
	10535.93			773.08	
	10572.49			773.27	
	10574.93				
	10576.58	771.80	772.24	773.06	
	10601.23			773.00	
	10603.47		772.18		
	10603.56			772.68	
	10603.66				
	10606.48	771.87			x
	10612.19	770.74			
	10621.68	770.63			
	10623.76				
	10624.42				
	10628.06				
	10628.35			773.12	
	10640.16			772.58	
	10641.19				
	10642.16	771.46	771.71	772.57	
	10662.25			772.19	
	10662.54	771.12			x
	10662.97				
	10663.17		771.49		
	10663.33			772.55	
	10679.71	769.50		771.74	
	10680.04				
	10681.69			771.93	
	10703.01	769.70			x
	10703.04			770.83	
	10703.09				
	10703.72		770.12		
	10703.84			771.31	

	10712.38	768.88			
	10728.65			770.52	
	10729.05		769.45		
	10729.28			770.77	
	10729.55	768.73			
	10729.73				
	10778.92				
	10779.24			769.90	
	10779.73	768.80			
	10780.37		768.98		
	10781.07			770.08	
	10793.58	768.25			
	10793.63			769.90	
	10793.64				
	10794.38				
	10794.91			769.91	
	10813.75			769.85	
	10814.18				
	10814.70				
	10814.74	768.35		770.45	
	10842.24				
	10842.94	768.69	768.82	769.42	
	10848.37			770.08	
	10871.47			769.69	
	10871.71	768.56		769.64	x
	10871.71				
	10871.78		768.77		
	10889.80	767.33		769.45	
	10894.41				
	10895.82			769.65	
	10900.54			769.59	
	10901.21			769.55	
	10901.38		768.46		
	10901.77	768.15			
	10926.29		767.86		
	10926.46			768.56	
	10926.53			768.65	
	10926.62				
	10926.81	767.85			x
	10935.48			768.95	
	10936.91				
	10937.47	766.17			
	10937.67				
	10937.87			769.01	
	10948.03		767.23		
	10948.31				
	10948.32			768.27	

	10948.32			768.36	
	10948.57	767.12			
	10986.08			769.26	
	10987.38			767.68	
	10988.02		766.83		
	10988.52	766.59			x
	10996.17	765.80			
	11005.69				
	11006.02	766.37		768.16	
	11006.56		766.80		
	11007.61			768.25	
	11030.97			768.01	
	11031.46			767.51	
	11031.65				
	11031.81		766.63		
	11031.92	766.46			
	11062.92			767.96	
	11063.43		766.63		
	11063.68	766.53			x
	11063.83				
	11065.80			768.46	
	11071.66	765.03			
	11092.70			767.75	
	11093.21				
	11093.21	766.17			
	11093.28				
	11093.79		766.37		
	11094.18			767.68	
	11129.24			767.20	
	11130.40			767.32	
	11130.46				
	11130.52	765.93		767.32	x
	11130.88		766.06		
	11141.29	764.74			
	11151.58				
	11151.62	765.23			
	11151.69			766.74	
	11151.85			767.17	
	11152.36		765.77		
	11175.31				
	11175.36		765.49		
	11175.65			767.10	
	11175.68			766.54	
	11175.74	765.29		766.54	
	11175.85			767.10	
	11204.52	764.37		767.41	
	11204.56		765.23		

	11205.37				
	11205.74			766.47	
	11215.96	764.51			x
	11226.49			766.66	
	11227.03				
	11228.22	763.76	764.88		
	11228.55			766.39	
	11261.31			765.77	
	11261.41				
	11261.45		764.73		
	11261.70	764.62		766.22	
	11316.56			766.02	
	11317.40			765.93	
	11317.51	764.40		765.93	
	11317.59				
	11317.82		764.54		
	11352.10				
	11352.13			765.22	
	11352.26		764.40		
	11352.41	764.36			x
	11353.10			765.81	
	11360.11	762.60			
	11371.70				
	11371.75		764.14		
	11372.05	763.38		765.70	
	11372.91			765.42	
	11409.59	763.65			x
	11409.74			764.71	
	11409.85				
	11409.89		763.77		
	11409.91			765.39	
	11426.98			764.48	
	11427.20		762.61		
	11432.15	760.74			
	11433.18				
	11433.82			765.20	
	11448.87	762.44	762.59	764.73	
	11449.49				
	11453.50			764.62	
	11460.48			764.42	
	11461.74	762.18			x
	11461.89				
	11462.04			764.05	
	11462.19		762.46		
	11467.86	761.88			
	11470.90			763.62	
	11475.67				

	11476.36			764.12	
	11479.20	761.65			
	11479.93		762.45		

TAPE	ELEV	ELEV (CORR.)	NOTE	TAPE	ELEV	ELEV (CORR.)	NOTE
REACH A				XSA01R			
0	99.15402	762.25436	pin	0	100.518717	758.51343	pin
0.05	98.83588	761.93622	fp	0	100.173414	758.168127	
19.77	98.42372	761.524064	fp	6.34	100.109465	758.104178	
39.83	98.00844	761.108781	bkf	12.56	99.761786	757.756499	
45.86	96.38009	759.480437		17.12	99.430084	757.424797	lb
49.75	95.28922	758.389568	lew	25.71	97.242165	755.236878	
50.72	94.67882	757.779164		29.41	96.32637	754.321083	
52.77	94.628	757.728343		35.24	96.32912	754.323833	
55.29	94.65002	757.750364		40.84	95.399397	753.39411	
57.05	94.91995	758.020291		46.17	94.32261	752.317323	
59.63	94.8687	757.96904		48.7	93.881214	751.875927	
61.22	95.26348	758.363825	rew	50.32	93.687777	751.68249	lew
65	96.40034	759.500684		52.38	93.471954	751.466667	
70.76	97.97194	761.072287	bkf	54.68	93.412779	751.407492	
89.04	99.21282	762.313163		56.73	93.294839	751.289552	
103.33	99.26684	762.36718		58.75	93.500108	751.494821	
126.47	99.23083	762.331176		60.46	93.660086	751.654799	rew
126.55	99.55666	762.657006	pin	63.03	93.764952	751.759665	
XSA02P				XSA12R			
0	99.44153	762.52534	pin	64.27	93.929502	751.924215	
0.11	98.98816	762.07197		67.06	94.752151	752.746864	
14.24	98.96382	762.047629		73.09	96.022759	754.017472	
24.45	98.81304	761.896855		76.54	96.199332	754.194045	bkf
37.09	98.03071	761.114524	bkf	81.88	98.14304	756.137753	
46.02	96.75376	759.837568		85.91	99.689234	757.683947	
52.3	95.33774	758.421551	lew	89.49	100.679002	758.673715	rb
54.95	94.84119	757.925004		99.1	100.43516	758.429873	
56.71	94.4542	757.538009		107.54	100.559481	758.554194	
58.96	93.95003	757.033844		107.62	100.898395	758.893108	pin
60.72	93.84953	756.933346		REACH B			
62.33	94.02845	757.112263		XSB01R			
63.93	94.38843	757.472242		0	99.943155	772.344	pin
64.84	95.23334	758.317156	rew	0.01	99.701412	772.102	
66.26	95.5203	758.604111		11.82	100.049951	772.344	
68	95.89743	758.98124		21.33	100.133096	772.102	
73.19	97.38018	760.463996		32.52	96.626042	769.027	
76.61	97.8511	760.934914		41.46	94.273426	766.674	
85.26	98.92021	762.004026		55.64	94.217466	766.619	
92.47	99.17545	762.259262		69.59	94.239858	766.641	
101.86	99.00203	762.085838		73.75	93.176398	765.577	
109.22	99.19381	762.277624		75.75	91.482089	763.883	
109.29	99.51559	762.5994	pin	76.34	91.00336	763.404	lew
XSA03R				77.51	90.736227	763.137	
0	100.3529	763.35623	pin	78.75	90.595982	762.997	
0.12	100.1624	763.165725		79.97	90.62825	763.029	
8.83	100.2432	763.246535		81.14	90.584354	762.985	
13.64	99.50423	762.507594		82.68	90.714643	763.116	
16.56	99.21339	762.216756	bkf	84.12	90.749108	763.15	
22.27	97.71667	760.72003		85.78	90.931705	763.333	
26.03	96.53879	759.542154	lew	86.66	91.031509	763.433	rew
27.21	96.14205	759.145415		88.65	92.251956	764.653	
				90.7	92.764953	765.166	

28.44	96.04532	759.048679	93.16	93.674653	766.076 bkf
29.7	96.03738	759.040739	104.17	93.8835	766.285
31.67	96.31816	759.321521	111.24	94.169732	766.571
33.96	96.3306	759.333958	127.5	98.902458	771.304
35.45	96.41316	759.416524	149.21	99.906425	772.307
36.69	96.46013	759.463491 rew	149.25	100.143909	772.545 pin
42.14	98.44712	761.450481		XSB02P	
46.66	99.23931	762.242677 bkf	0	99.824567	772.226 pin
60.03	100.5334	763.536811	0.11	99.688063	772.089
73.81	101.1172	764.120612	15.18	100.023845	772.425
90.47	101.0488	764.052172	27.85	95.775982	768.177
90.56	101.3271	764.33049 pin	35.17	94.499719	766.901
	XSA04R		49.68	94.162787	766.564
0	100.1607	766.1209 pin	58.06	94.054956	766.456
0.11	99.76873	765.728922	65.39	93.837362	766.238 bkf
7.06	99.61916	765.579345	70.17	93.001653	765.403
15.12	98.17613	764.136321	73.64	92.401603	764.803
21.02	96.51036	762.470552	76.85	91.074218	763.475
22.48	95.45299	761.413181 lew	84.4	90.916645	763.318 lew
24.23	94.46016	760.420346	87.66	90.548738	762.95
26.42	94.41449	760.374681	89.11	90.262789	762.664
28.43	94.55429	760.51448	90.44	89.813356	762.214
30.52	94.3867	760.346894	91.38	89.982397	762.383
32.66	94.38468	760.344874	92.29	90.348601	762.75
35.36	95.57314	761.533331 rew	92.35	91.000899	763.402 rew
35.82	96.02578	761.985971	92.77	92.140031	764.541
39.81	97.05827	763.018455	95.79	93.217735	765.619
45.29	98.34261	764.302802 bkf	98.52	93.521867	765.923
58.16	98.48768	764.447867	103.79	94.22558	766.627
68.95	98.42312	764.38331	112.82	94.390058	766.791
78.47	98.47993	764.440119	121.13	96.233055	768.634
78.56	98.77394	764.734129 pin	135.41	99.743987	772.145
	XSA05R		148.4	100.136788	772.538
0	98.24607	767.55917 pin	148.45	100.310987	772.712 pin
0.06	97.96897	767.28207		XSB03R	
5.64	97.84851	767.161616	0	100.623945	766.391 pin
11.99	97.60952	766.922624 lb	0.01	100.498434	766.265
17.23	96.5009	765.813999	12.41	100.337732	766.105
20.63	96.58159	765.89469 bkf	26.86	95.033573	760.8
27.66	95.05797	764.371077	34.93	94.92718	760.694 bkf
31.12	94.25902	763.572127	43.49	93.656296	759.423
31.9	93.93668	763.249782 lew	48.52	92.978194	758.745
33.68	93.80769	763.12079	51.5	92.232003	757.999 lew
36.82	93.67869	762.991791	52.7	92.172597	757.94
38.21	93.614	762.927106	53.9	92.119086	757.886
40.05	93.71674	763.02984	54.78	92.174744	757.942
41.7	93.95331	763.266417 rew	55.7	92.14222	757.909
43.33	94.35055	763.663658	56.42	92.047809	757.815
44.41	94.60842	763.921526	58.3	92.142158	757.909
50.23	96.27776	765.59086 bkf	59.44	92.078316	757.845
67.66	97.49733	766.81043	62.92	92.820298	758.587
83.41	97.95029	767.26339	69.89	94.008582	759.775
91.41	97.69972	767.012822	83.39	94.927766	760.695
91.37	98.15499	767.468093 pin	101.77	95.758703	761.526

XSA06P		
0	100.1074	768.87571 pin
0.04	99.66505	768.433348
3.27	99.54393	768.312232 lb
8.11	98.30495	767.073248 bkf
12.44	97.90916	766.677457
15.86	97.00609	765.774391
19.57	95.91852	764.686825
20.08	95.45043	764.218728 lew
21.35	94.61977	763.38807
23.19	94.73739	763.505692
26.3	95.20316	763.971457
28.71	95.39218	764.160477
30.58	95.53874	764.307038 rew
36.55	95.8444	764.612696
37.7	96.43868	765.206976
44.1	98.08432	766.852617
52.24	98.96661	767.734914
58.72	100.2418	769.010131
68.2	100.7607	769.528967
76.72	100.6474	769.415655
83.2	100.1897	768.958012
83.19	100.5977	769.366009 pin

XSA07R		
0	100.7604	769.58628 pin
0.07	100.4497	769.275538
8.52	100.7304	769.556269 lb
14.99	98.61021	767.436082
18.41	98.36051	767.186378 bkf
22.81	96.66265	765.488521
25.86	95.48226	764.308136 lew
27.1	95.18621	764.012083
28.06	95.14883	763.974705
30.17	95.3081	764.133968
32.47	95.44714	764.273008
34.86	95.35254	764.17841
37.12	95.26772	764.093591
37.78	95.58848	764.414354 rew
40.04	96.33485	765.160717 rew
47.38	98.38705	767.212919
54.61	98.81879	767.644664
62.94	99.32948	768.155354
67.53	100.2136	769.039429
76.2	100.1665	768.992326
87.58	100.1312	768.957072
87.67	100.6584	769.484223 pin

XSA08R		
0	102.3783	761.296179 pin
0.02	101.9901	760.907994 fp
23.48	102.02	760.937888 fp
63.71	102.759	761.676946 lb
73.27	100.3846	759.30248
78.41	98.90836	757.826273
88.65	98.7631	757.681012 bkf

114.48	98.693252	764.46
125.86	98.784527	764.551
125.9	98.924588	764.691 pin

XSB04P		
0	99.509452	765.276 pin
0	99.187798	764.955
16.56	98.839327	764.606
29.19	95.345265	761.112
38.21	94.692487	760.459 bkf
44.56	93.911634	759.679
50.82	92.754943	758.522
51.76	92.071898	757.839 lew
52.66	91.525457	757.292
53.26	91.575765	757.343
54.09	91.702665	757.47
55.88	91.996539	757.763 rew
61.52	92.356501	758.123 pb
63.17	92.593071	758.36 pb
65.24	93.393256	759.16 pb
68.6	93.325553	759.092 pb
79.02	94.647168	760.414
107.86	94.865066	760.632
119.89	98.582626	764.35
132.05	98.425104	764.192
132.15	98.548202	764.315 pin

XSB05R		
0	105.526713	762.857 pin
0.04	105.372185	762.702
16.3	105.042628	762.373
32.54	101.223885	758.554
42.74	99.942059	757.272
57.37	99.763592	757.093 bkf
63.17	98.994809	756.325
65.62	99.039575	756.369
67.77	97.804962	755.135 lew
68.4	97.634285	754.964
69.38	97.737116	755.067
70.82	97.813272	755.143
71.58	97.722657	755.053
73.33	97.719034	755.049
74.37	97.871316	755.201 rew
78.56	98.008627	755.339
81.03	98.518818	755.849
86.12	98.686853	756.017
87.71	98.6758	756.006
89.29	99.200774	756.531
97.82	99.988909	757.319 bkf
124.97	100.238238	757.568
140.71	105.199125	762.529
142.83	105.236337	762.566
142.87	105.392824	762.723 pin

XSB06P		
0	105.340843	762.671 pin
0.1	105.10286	762.433

99.01	96.2144	755.132319	22.98	104.355736	761.686
101.83	95.46265	754.380567	43.42	100.491749	757.822
104.47	95.36952	754.287437 lew	55.79	99.997771	757.328
106.54	95.18433	754.102251	62.88	98.858378	756.188
109.83	95.13104	754.048957	65.82	98.354114	755.684
112.24	95.04716	753.965081	66.31	97.715619	755.045 lew
114.47	95.04724	753.965154	66.82	97.348852	754.679
116.37	95.00417	753.922083	68	97.388442	754.718
117.06	95.40394	754.32186 rew	69.75	97.516672	754.847
120.11	96.54661	755.464526	71.52	97.775127	755.105 rew
124.29	97.76575	756.683671	73.66	97.997192	755.327
128.48	98.69143	757.609342 bkf	77.41	98.478956	755.809
136.54	98.75801	757.675926	81.68	98.426873	755.757
149.16	101.6961	760.614034 lb	85.81	99.388789	756.719
165.42	102.3079	761.225864 fp	90.54	99.980635	757.311 bkf
180.4	102.8861	761.803971 fp	122.31	99.90324	757.233
180.51	103.1216	762.03949 pin	125.22	100.264553	757.594

XSA09P

0	101.1301	760.02597 pin
0.08	100.8156	759.711423
15.04	100.9799	759.875743 fp
37.49	101.1305	760.026324 lb
48.14	98.44219	757.33801
54.25	98.06037	756.956193 bkf
59.61	96.77198	755.6678
63.99	95.93916	754.83498
64.83	94.57591	753.471734 lew
66.25	93.09743	751.993258
66.26	93.09804	751.993863
67.42	92.85668	751.752502
68.78	93.07216	751.967988
69.94	93.51419	752.410009
71.1	94.07645	752.972271
73.24	94.53843	753.434252 rew
79.2	94.9547	753.850523
84.98	95.84594	754.741762
89.91	96.51393	755.40975
93.78	96.91291	755.808729
99.63	97.88934	756.785164
113.3	98.32128	757.217104
128.77	98.61301	757.508831
150.01	98.72935	757.625174
150.11	98.9974	757.893226 pin

XSA10R

0	96.22121	756.16682 pin
0	95.88522	755.830833 fp
15.25	96.24452	756.190127 fp
33.04	95.61827	755.563876 bkf
40.16	94.00368	753.949292
46.13	92.32652	752.272124 lew
49.38	91.80238	751.747986

140.5	105.302105	762.632
141.7	105.299519	762.629 pin

REACH C

XSC01R

0	104.744435	777.23594 pin
0.06	104.363731	776.855236
7.17	104.120976	776.612481
16.94	103.495942	775.987447
24.52	102.988078	775.479583 bkf
27.29	102.278208	774.769713
28.29	101.67263	774.164135 lew
29.37	101.574999	774.066504
30.2	101.418014	773.909519
30.79	101.173649	773.665154
32.13	101.175563	773.667068
33.01	101.599792	774.091297 rew
34	102.211888	774.703393
38.53	102.988335	775.47984 bkf
47.68	104.655858	777.147363
55.38	106.087136	778.578641 rb
65.13	106.485735	778.97724
76.55	106.989188	779.480693
76.43	107.360733	779.852238 pin

XSC02P

0	103.522905	776.09012 pin
0.07	103.23504	775.802255
9.37	103.403866	775.971081
21.25	103.16826	775.735475
24.02	103.077213	775.644428 lb
27.72	102.192893	774.760108
30.27	101.485775	774.05299 bkf
32.68	101.436451	774.003666
33.28	100.708826	773.276041 lew
33.84	99.461714	772.028929

52.15	91.68314	751.628748	35.44	99.532665	772.09988
54.69	91.63972	751.585329	36.67	99.75628	772.323495
57.26	91.89427	751.839875	38.53	100.160566	772.727781
60.1	92.02426	751.96987	39.79	100.679268	773.246483 rew
61.17	92.29401	752.239622 rew	42.76	101.396299	773.963514
65.21	93.50951	753.455122	44.44	101.66303	774.230245
69.88	94.84186	754.787466	46.91	102.291429	774.858644
73.62	95.59134	755.536947 bkf	49.27	102.504327	775.071542
78.96	95.69317	755.63878	54.18	103.255332	775.822547
83.47	96.83927	756.784879	57.52	103.908436	776.475651 rb
91.34	98.51096	758.456568 rb	64.03	103.86525	776.432465
106.01	99.35818	759.303792 fp	70.25	103.715464	776.282679
122.84	99.72316	759.668764 fp	78.08	103.310992	775.878207
122.94	100.0439	759.989536 pin	78.13	103.608053	776.175268 pin

XSA11P

0	95.56217	755.622 pin
0.04	95.23733	755.297156 fp
12.22	95.22258	755.282408 fp
21.47	95.48829	755.548113 bkf
31.63	93.57682	753.636651
37.94	92.57733	752.637156
41.2	92.26484	752.32467 lew
45.53	91.64777	751.707595
48.54	91.07819	751.138012
50.69	90.60165	750.661476
52.79	90.3453	750.405126
55.56	90.59488	750.654706
58.13	91.32064	751.380468
60.94	92.17831	752.238133 rew
65.86	93.89894	753.958771
71.61	95.39468	755.454506 bkf
77.1	95.50808	755.567908
86.01	98.25809	758.317918 rb
103.83	98.77213	758.831952 fp
127.24	100.3115	760.371358 fp
127.26	100.5121	760.571954 pin

XSC03R

0	98.109987	770.50952 pin
0.08	97.652054	770.051587
4.31	97.500543	769.900076
13.78	97.244629	769.644162
18.78	97.138917	769.53845
21.94	96.80252	769.202053 bkf
25.39	96.417942	768.817475
28.14	95.847868	768.247401 lew
29.5	95.747258	768.146791
30.31	95.746487	768.14602
31.07	95.742524	768.142057
31.6	95.856787	768.25632 rew
33.85	96.589427	768.98896
38.21	97.158874	769.558407
42.72	97.343878	769.743411
48.78	97.817492	770.217025
48.8	98.209466	770.608999 pin

XSC04R

0	105.789172	771.64449 pin
0.1	105.401934	771.257252
6.42	105.30359	771.158908
12.82	104.912536	770.767854 lb
18.02	102.728526	768.583844 lb
20.83	102.250413	768.105731
23.07	101.951734	767.807052
24.82	101.151911	767.007229
26.44	100.492844	766.348162 lew
27.18	100.092046	765.947364
28.59	100.019519	765.874837
29.28	100.062668	765.917986
29.7	100.44213	766.297448 rew
32.47	101.742097	767.597415 bkf
35.78	101.91072	767.766038
42.43	102.712779	768.568097
55.75	102.199062	768.05438
55.84	102.664283	768.519601 pin

Appendix 2

EEP Baseline Morphology Tables

**Table 2. Project Activity and Reporting History
Valley Fields Farm/407**

Activity or Deliverable	Data Collection Complete	Completion or Delivery
Restoration Plan	N/A	March 1, 2006
Final Design – Construction Plans	N/A	September 6, 2006
Construction	N/A	May 16, 2008
Temporary S&E mix applied to entire project area	N/A	May 16, 2008
Permanent seed mix applied	N/A	May 16, 2008
Baseline Monitoring Report	May-08	N/A
Final Design – Construction Plans (Reach B - redesign)	N/A	November 12, 2008
Structural maintenance (new alignment, bench expansion) Reach B	N/A	December 5, 2008
Temporary S&E mix applied to Reach B	N/A	December 5, 2008
Permanent seed mix applied to Reach B	N/A	December 5, 2008
Baseline Monitoring Report	Jun-09	August 17, 2009
Year 1 Monitoring		
Year 2 Monitoring		
Year 3 Monitoring		
Year 4 Monitoring		
Year 5 Monitoring		
Closeout		

**Table 3. Project Contacts Table
Valley Fields Farm/407**

Designer	P.O. BOX 33068
	Raleigh, North Carolina 27636-3068
Kimley-Horn and Associates, Inc.	Will Wilhelm Phone: (704) 333-5131
Construction Contractor	2889 Lowery Street
	Winston-Salem, NC 27101
North State Environmental	Phone: (336)725-2010
Survey Contractor	530 North Trade Street, Suite 302
	Winston-Salem, NC 27101
Cavanaugh and Associates, P.A.	Phone: (336)759.9001
Planting Contractor	2889 Lowery Street
	Winston-Salem, NC 27101
North State Environmental	Phone: (336)725-2010
Seeding Contractor	2889 Lowery Street
	Winston-Salem, NC 27101
North State Environmental	Phone: (336)725-2010
Seed Mix Sources	Green Resource, LLC (800) 225-6061
Nursery Stock Suppliers	Green Resource, LLC (800) 225-6061
Monitoring Performers	Kimley-Horn and Associates, Inc.
	P.O. BOX 33068
	Raleigh, North Carolina 27636-3068
Stream Monitoring POC	Will Wilhelm Phone: (704) 333-5131
Vegetation Monitoring POC	Will Wilhelm Phone: (704) 333-5131
Wetland Monitoring POC	Will Wilhelm Phone: (704) 333-5131

**Table 4. Project Attribute Table
Valley Fields Farm/407**

Project County	Davidson County					
Physiographic Region	Piedmont					
Ecoregion	Southern Oter Piedmont					
Project River Basin	Yadkin					
USGS HUC for Project (14 digit)	3040103030030					
NCDWQ Sub-basin for Project	Yadking Sub Basin					
Within extent of EEP Watershed Plan?	Yadkin Pee-Dee River Basin Restoration Priorities 2009					
WRC Hab Class (Warm, Cool, Cold)	-					
% of project easement fenced or demarcated	0					
Beaver activity observed during design phase?	Yes					
Restoration Component Attribute Table						
	Reach A	Reach B	Reach C	Reach D	Reach J	Wetland A-5
Drainage area (mi ²)	6.5	2.3	0.2	0.2	0.1	N/A
Stream order	3	2	1	1	1	N/A
Restored length (feet)	5013	2492	1489	295	61	N/A
Perennial or Intermittent	P	P	P	P	P	N/A
Watershed type (Rural, Urban, Developing etc.)	Developing	Developing	Developing	Developing	Developing	N/A
Watershed LULC Distribution (e.g.)						
Developed	35%					
Cultivated	22%					
Forested	43%					
Watershed impervious cover (%)	5	124	2	1	1	N/A
NCDWQ AU/Index number	C/3	C/2	C/1	C/1	C/1	N/A
NCDWQ classification	C	C	C	C	C	N/A
303d listed?	Yes	Yes	Yes	Yes	Yes	N/A
Upstream of a 303d listed segment?	Yes	Yes	Yes	Yes	Yes	N/A
Reasons for 303d listing or stressor	Degraded water quality due to sediment					N/A
Total acreage of easement	31.0	8.5	2.3	0.5	0.1	N/A
Total vegetated acreage within the easement	22.4	6.9	1.7	0.4	0.1	N/A
Total planted acreage as part of the restoration	22.4	6.9	1.7	0.4	0.1	N/A
Rosgen classification of pre-existing	G5	G5	Incised B5	Incised B5	G	N/A
Rosgen classification of As-built	B5	B5c	C5	B5c	Ba	N/A
Valley type	VIII	VIII	VIII	VIII	VIII	N/A
	0.30%	0.50%	1.10%	1.10%	15%	N/A
Valley side slope range (e.g. 2-3.%)	15-20%	12-20%	15-40%	25-30%	30-35%	N/A
Valley toe slope range (e.g. 2-3.%)	2-3%	1-3%	3-5%	10-14%	1-2%	N/A
Cowardin classification	N/A	N/A	N/A	N/A	N/A	NC
Trout waters designation	No	No	No	No	No	N/A
Species of concern, endangered etc.? (Y/N)	Greensbor burrowing crayfish is of concern					
Dominant soil series and characteristics	Chewacla loam and Wehadkee loam					
Series	N/A	N/A	N/A	N/A	N/A	ChA
Depth	N/A	N/A	N/A	N/A	N/A	80"
Clay%	N/A	N/A	N/A	N/A	N/A	5-40%
K	N/A	N/A	N/A	N/A	N/A	0.28
T	N/A	N/A	N/A	N/A	N/A	5.00

Use N/A for items that may not apply. Use "--" for items that are unavailable and "U" for items that are unknown

Attachment 1

As-Built/Record Drawings

February 09, 2010 - 1:01pm By: nancy.mumford



K:\CHL_Environmental\01795_EEP_Raleigh\020_Valley_Fields_Farm\CADD\Record Drawings - 01-2010\BlackandWhite\COVER-AS BUILT.dwg

STATE OF NORTH CAROLINA ECOSYSTEM ENHANCEMENT PROGRAM

AS BUILT/RECORD DRAWINGS FOR **VALLEY FIELDS FARM** STREAM AND WETLAND RESTORATION PROJECT

DAVIDSON COUNTY, NORTH CAROLINA
STATE PROJECT NO.: 020593902

NC-EEP CONTACT: MELONIE ALLEN (919) 368-9352
KIMLEY-HORN AND ASSOCIATES CONTACT: WILLIAM R. WILHELM, P.E. (704) 319-7684
REVIEW COORDINATOR: LIN XU (919) 715-7571
DISTURBED AREA: 43.0 ACRES

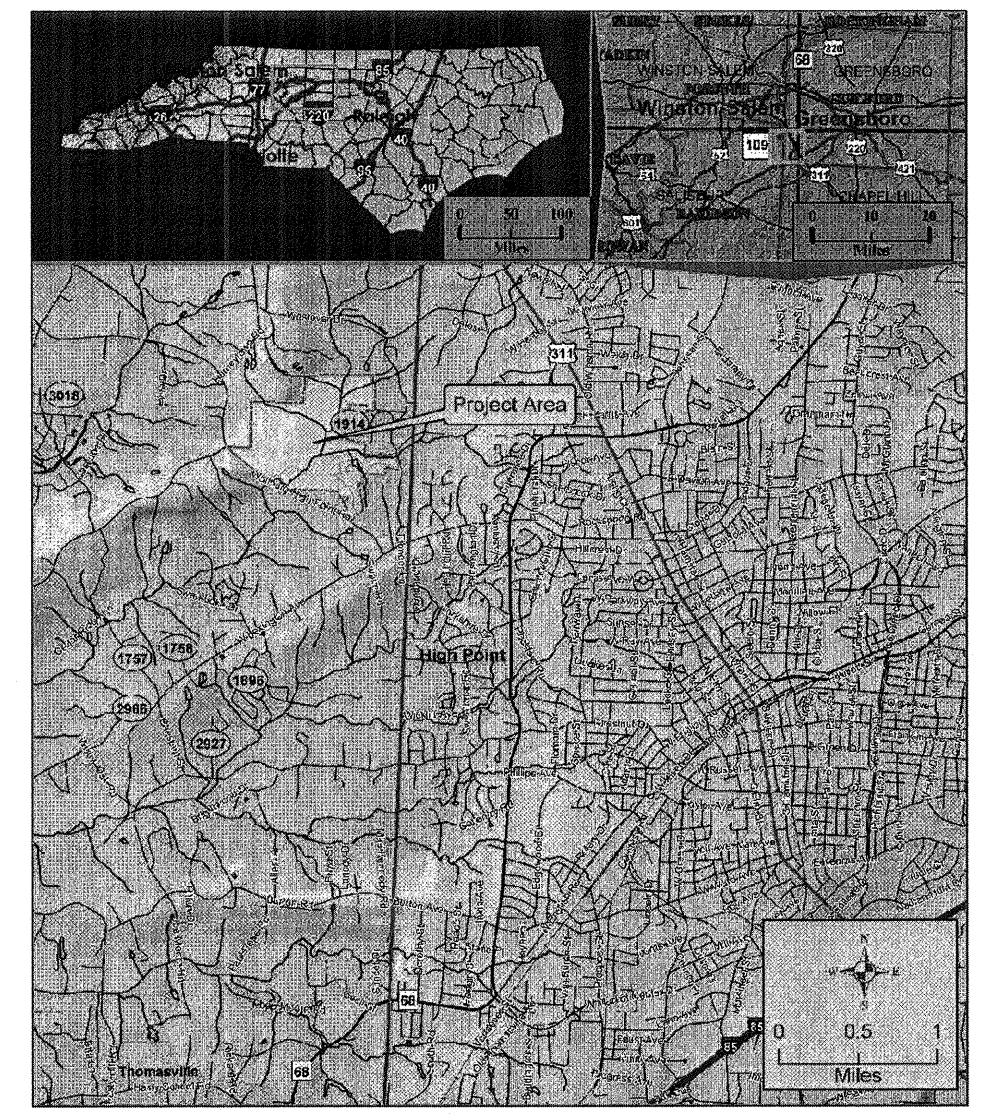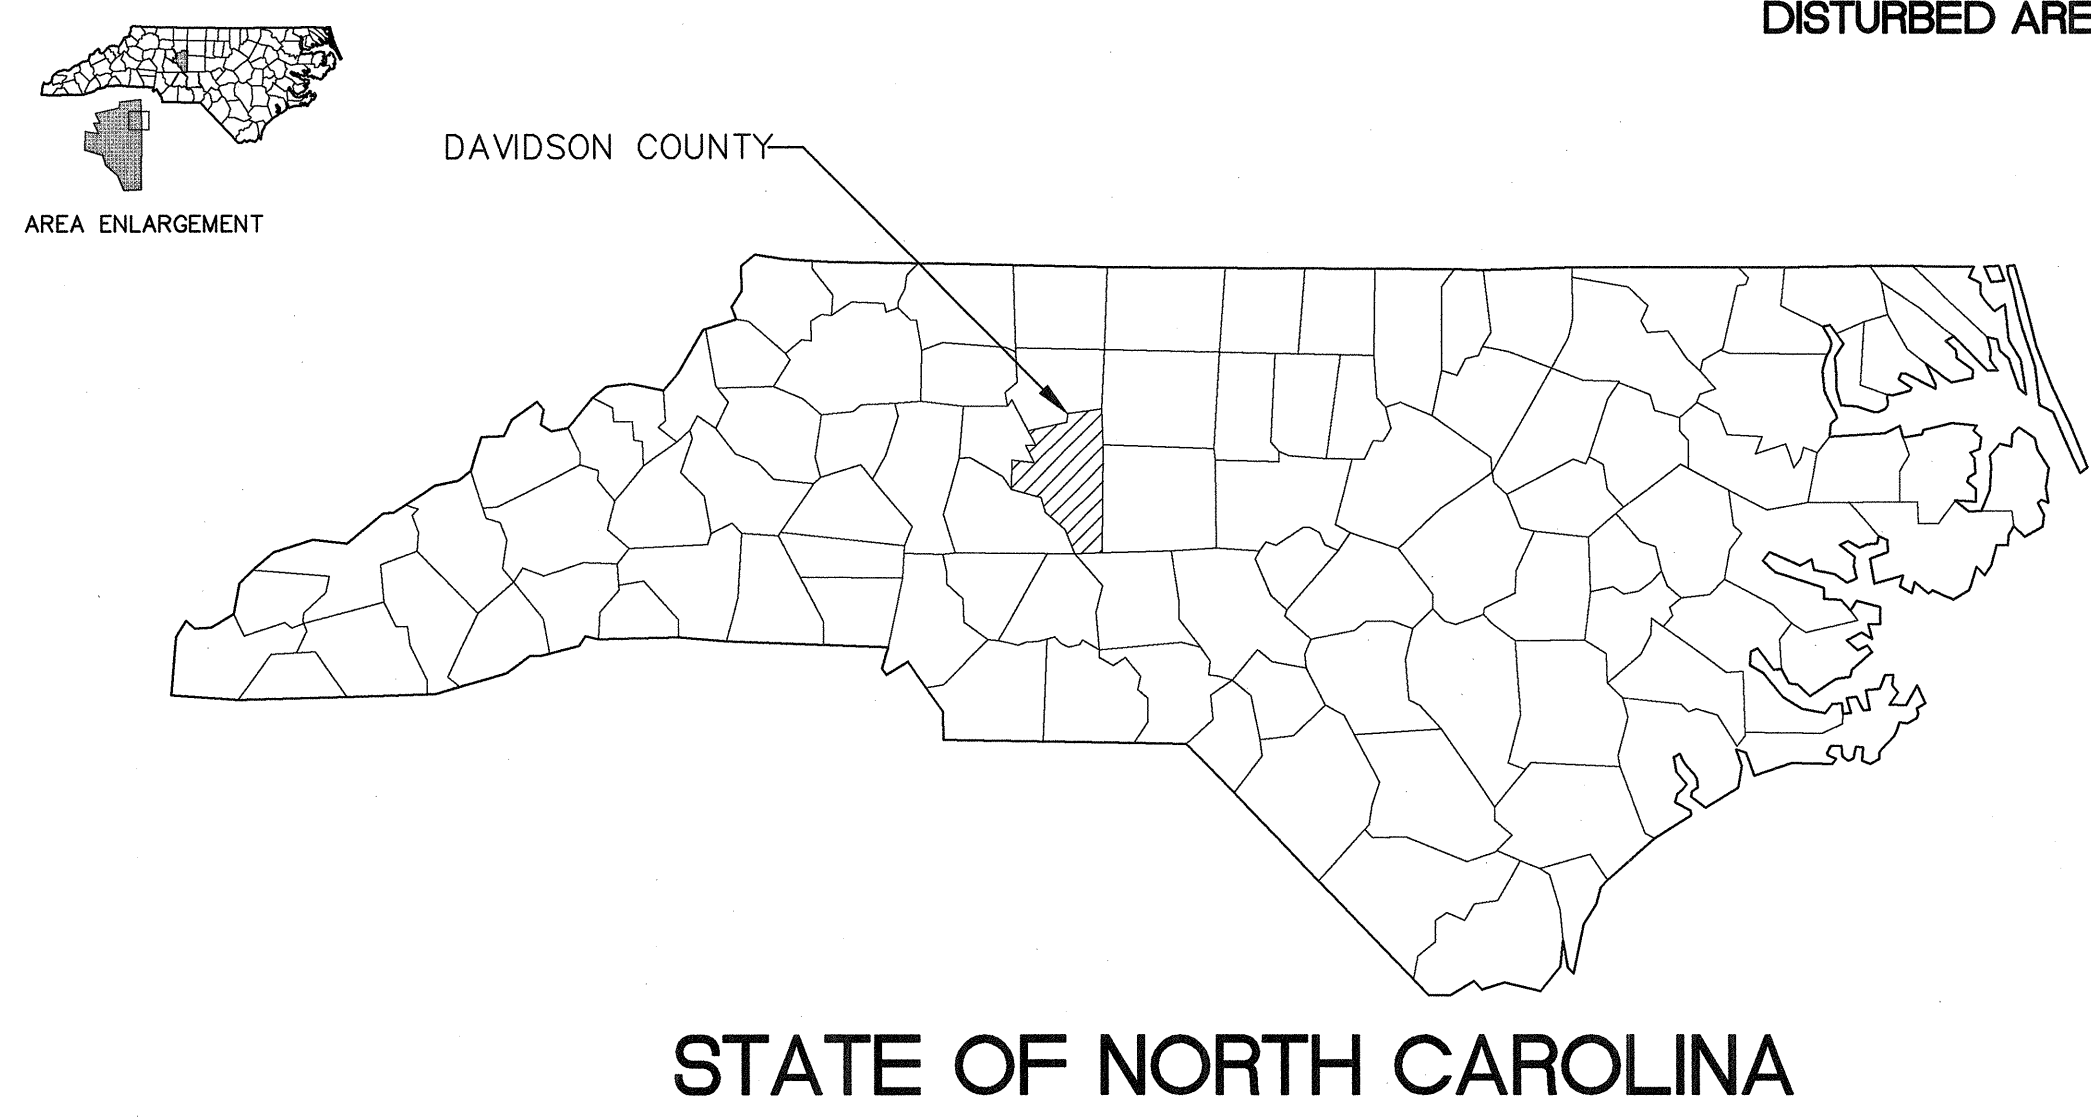

INDEX OF SHEETS

SHEET NO.	DESCRIPTION
1	COVER SHEET
2	KEY/SYMBOLGY SHEET
P1-P12	PLAN SHEETS
P13	WETLAND PLAN
1-8	SURVEYOR'S AS-BUILTS
M1-M13	MONITORING PLAN SHEETS
M14	WETLAND MONITORING SHEET
V1	VEGETATION PLAN SHEET

LOCATION MAP

REACH A CENTERLINE STATION 50+00 = LAT 35.988356 LONG -80.052202
NAD83 WGS80

RECORD DOCUMENT

CAVANAUGH
Solutions through integrity and partnership
Cavanaugh & Associates, P.A. 305 West Fourth Street, Suite 1A, Winston-Salem, NC 27101
336/759-9001 fax: 336/759-1005 www.cavanaughassociates.com

SURVEY PREPARED BY: _____ CONTRACTOR: NORTH STATE ENVIRONMENTAL, INC.


REV. NO.	REVISION	DATE	DRAWN BY	CHECKED BY

This document, together with the concepts and designs presented herein, is intended only for the specific purpose and client for which it was prepared. Reuse of and improper reliance on this document without written authorization and adaptation by Kimley-Horn and Associates, Inc., shall be without liability to Kimley-Horn and Associates, Inc.
Copyright Kimley-Horn and Associates, Inc., 2010

PREPARED IN THE OFFICE OF:

Kimley-Horn and Associates, Inc.
NC LICENSE #F-0102
P.O. BOX 33068 - RALEIGH, NORTH CAROLINA 27636-3068
PHONE: (919) 677-2000 FAX: (919) 677-2050

CLIENT: **NC-EEP**
TITLE: **VALLEY FIELDS FARM**


DATE: 01-28-10
HORIZONTAL SCALE: N/A
VERTICAL SCALE: N/A
DRAWN BY: JIK
DESIGNED BY: ARK/JCD
CHECKED BY: WRW

PROJECT: **VALLEY FIELDS FARM**
ATTACHED REFERENCE FILES:
JOB NUMBER: 011795020
SHEET NUMBER: 1

February 09, 2010 - 1:01pm By: nancy.mumford

K:\CHL_Environmental\011795_EEP_Raleigh\020_Valley_Fields_Field_Form\CADD\Record Drawings - 01-2010\BlackandWhite\2-KEY_SHEET.dwg

REACH A DESIGN CENTERLINE STA 50+00=LAT 35.988356 LONG -80.052202

FINAL DESIGN LEGEND:

AS-BUILT SURVEY LEGEND

- PERMANENT CONSERVATION EASEMENT
- FINAL DESIGN CREEK
- FINAL DESIGN ROOT WAD
- FINAL DESIGN LOG VANE
- FINAL DESIGN ROCK CROSS VANE
- FINAL DESIGN ROCK A-VANE
- FINAL DESIGN J-HOOK VANE
- FINAL DESIGN CONSTRUCTED RIFFLE
- CHANNEL BLOCK
- FILL (OLD CHANNEL)
- OXBOW LAKE (PRESERVE/EXPAND ABANDONED STREAM)
- EXISTING WETLANDS

- AS-BUILT SURVEY CREEK
- AS-BUILT SURVEY TOE
- AS-BUILT SURVEY TOP
- AS-BUILT SURVEY ROCK CROSS VANE
- AS-BUILT SURVEY ROCK A-VANE
- AS-BUILT SURVEY J-HOOK VANE
- AS-BUILT SURVEY CONSTRUCTED RIFFLE OR RIP-RAP
- AS-BUILT SURVEY LOG STEP POOL
- AS-BUILT SURVEY BED ROCK
- AS-BUILT SURVEY ROOT WAD
- AS-BUILT SURVEY LOG VANE

EXISTING CONDITIONS SURVEY LEGEND:

- PRECONSTRUCTION STREAM
- PROPERTY LINE
- SANITARY SEWER
- OVERHEAD POWER
- NATURAL GAS
- FIBER OPTIC
- UTILITY EASEMENT
- MAJOR CONTOURS
- MINOR CONTOURS
- PROPERTY LINE
- TREELINE
- WATER METER
- SEWER MANHOLE
- POWER / UTILITY POLE
- CAPPED REBAR


MONITORING LEGEND:

- MONITORING CROSS SECTION
- MONITORING CROSS SECTION BENCHMARKS
- MONITORING GAUGE
- MONITORING VEGETATION PLOT
- MONITORING VEGETATION PLOT ORIGIN
- MONITORING PHOTO POINT

WETLAND GRADING LEGEND:

- ISLAND POCKET
- DEPRESSION POCKET
- CONFLUENCE WETLAND
- CHANNEL FILL
- EXISTING WETLAND
- CHANNEL BLOCK

NOTE: AS-BUILT SURVEY INFORMATION PROVIDED BY NORTH STATE ENVIRONMENTAL'S SURVEY SUB-CONSULTANT, CAVENAUGH ASSOCIATES, PA

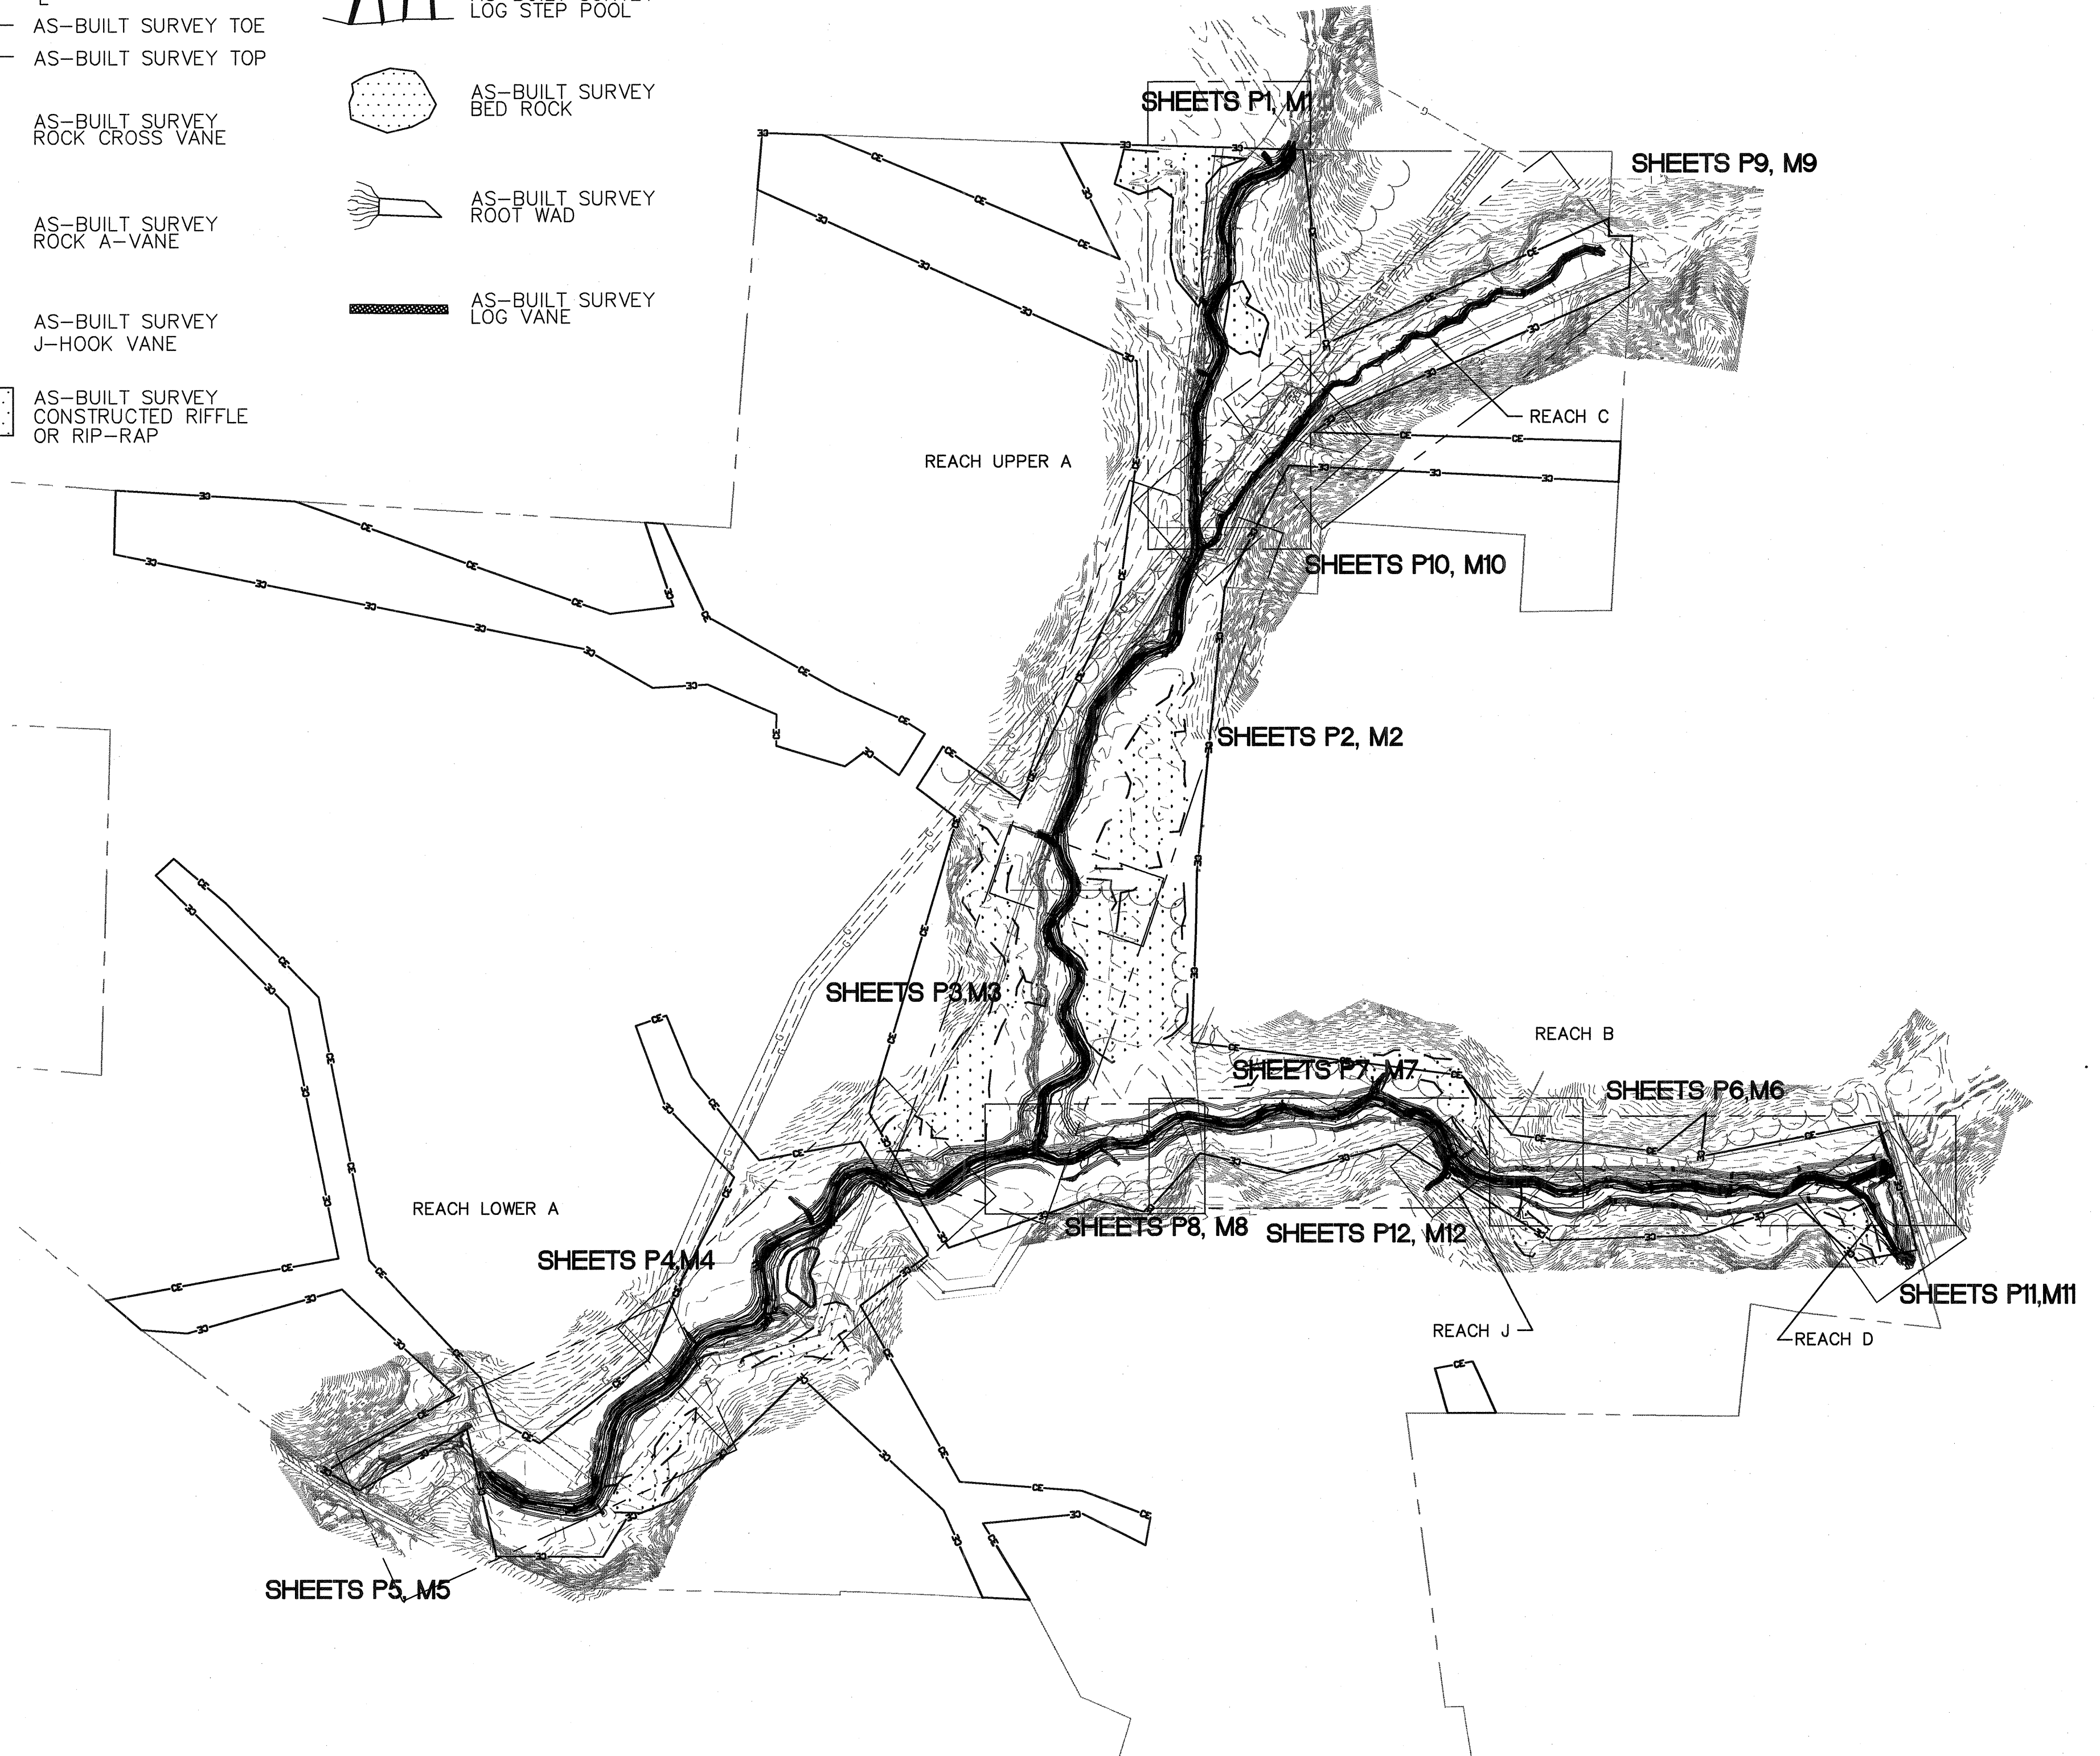

RECORD DOCUMENT

REV. No.	REVISION	DATE	DRAWN BY	CHECKED BY

PREPARED IN THE OFFICE OF:

Kimley-Horn and Associates, Inc.
 NC LICENSE #F-0102
 P.O. BOX 33068 - RALEIGH, NORTH CAROLINA 27636-3068
 PHONE: (919) 677-2000 FAX: (919) 677-2050

CLIENT: **NC-EEP**

TITLE: **KEY/SYMBOLGY SHEET**



DATE: 01-28-10
 HORIZONTAL SCALE: N.T.S.
 VERTICAL SCALE: N/A
 DRAWN BY: JJK
 DESIGNED BY: ARK/JCD
 CHECKED BY: WRW

PROJECT: **VALLEY FIELDS FARM**

ATTACHED REFERENCE FILES:

JOB NUMBER: 011795020
 SHEET NUMBER: **2**

This document, together with the concepts and designs presented herein, as an instrument of service, is intended only for the specific purpose and client for which it was prepared. Reuse of and improper reliance on this document without written authorization and adaptation by Kimley-Horn and Associates, Inc., shall be without liability to Kimley-Horn and Associates, Inc. Copyright Kimley-Horn and Associates, Inc., 2010

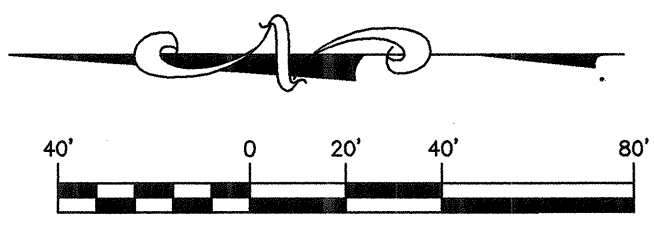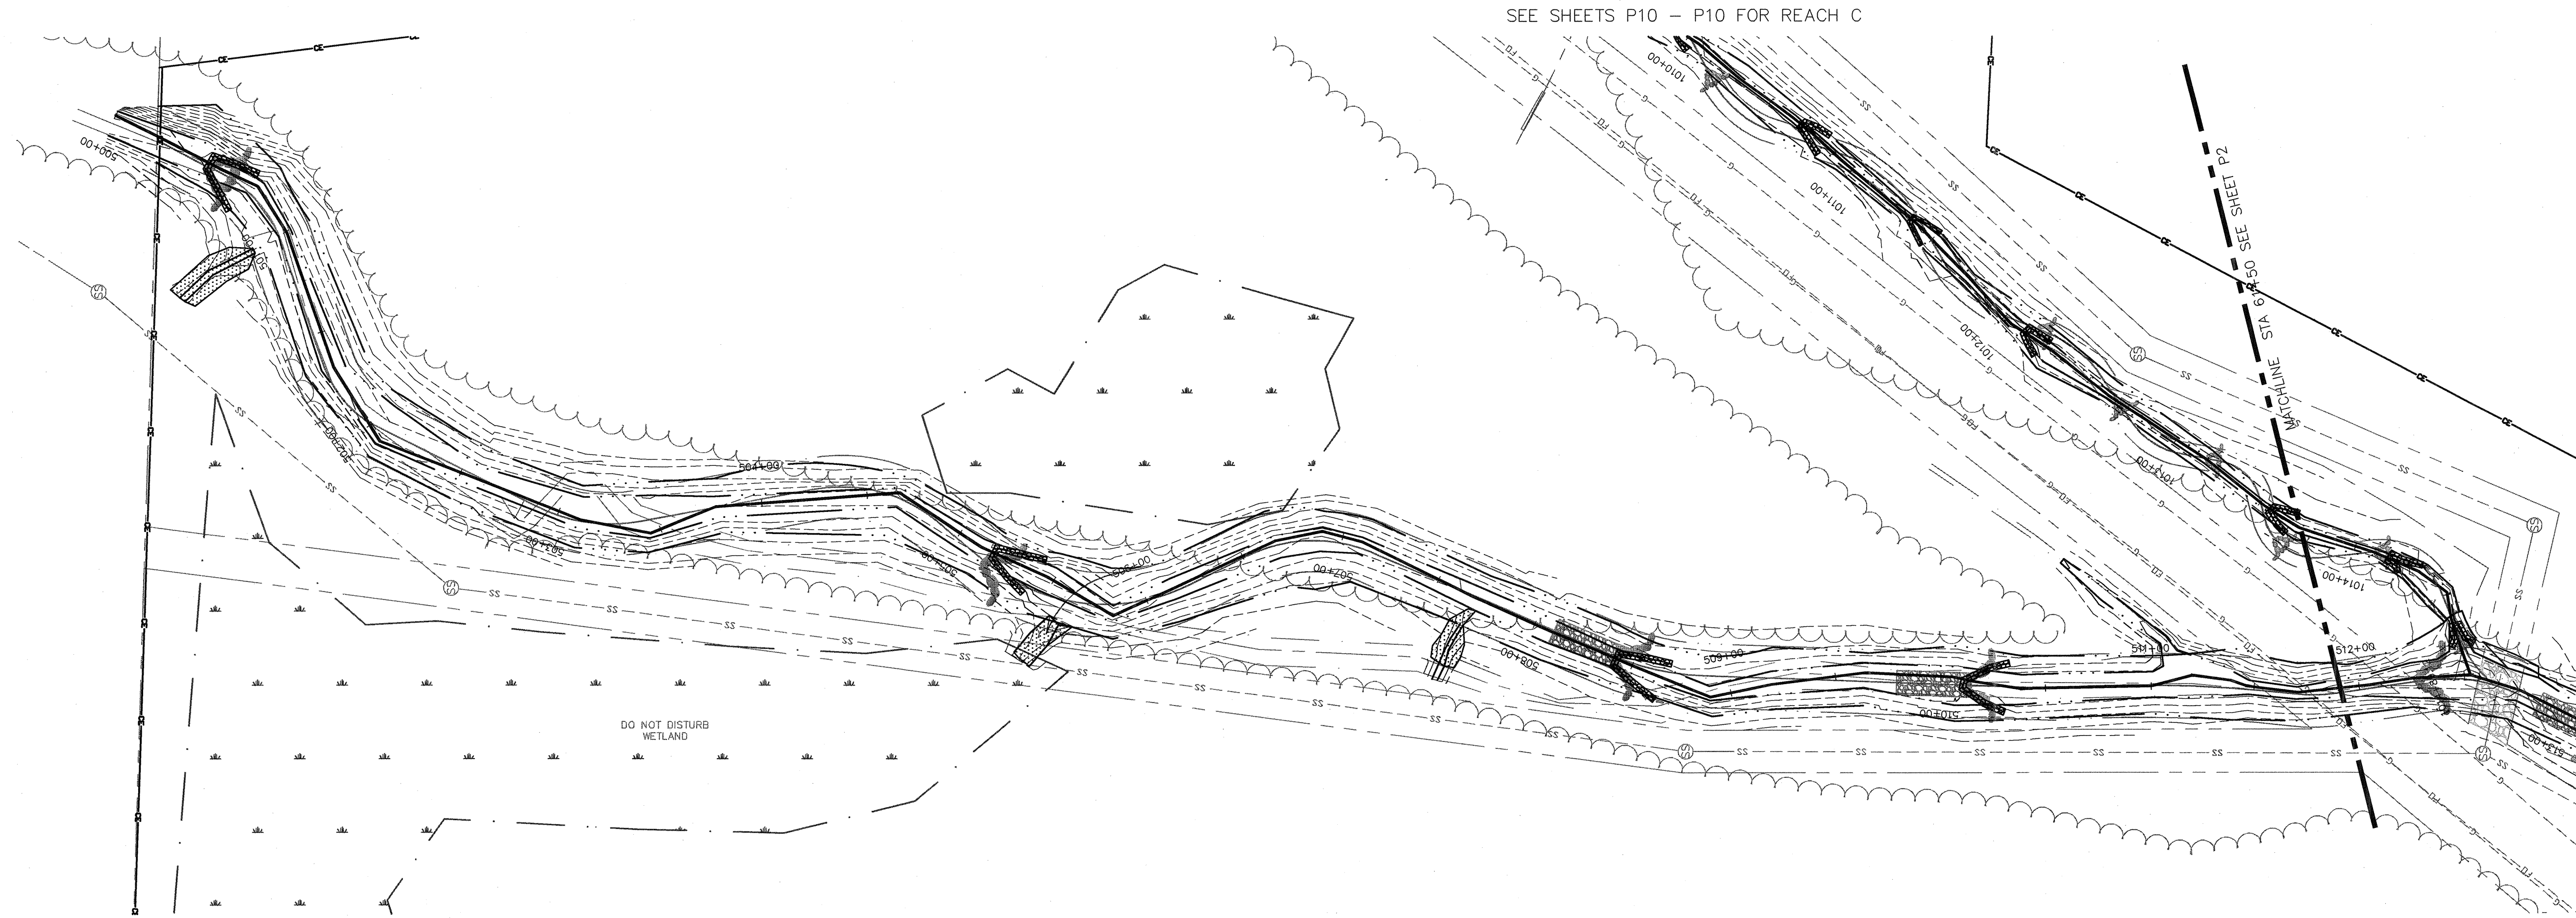

RECORD DOCUMENT

REV. No.	REVISION	DATE	DRAWN BY	CHECKED BY


PREPARED IN THE OFFICE OF:



Kimley-Horn and Associates, Inc.
 NC LICENSE #F-0102
 P.O. BOX 33068 - RALEIGH, NORTH CAROLINA 27636-3068
 PHONE: (919) 677-2000 FAX: (919) 677-2050

CLIENT: **NC-EEP**

TITLE: **PLAN - REACH A**





DATE: 01-28-10
 HORIZONTAL SCALE:
 VERTICAL SCALE:
 DRAWN BY: JJK
 DESIGNED BY: ARK/JCD
 CHECKED BY: WRW

PROJECT: **VALLEY FIELDS FARM**

ATTACHED REFERENCE FILES:
 JOB NUMBER: 011795020
 SHEET NUMBER: P1

This document, together with the concepts and designs presented herein, as an instrument of service, is intended only for the specific purpose and client for which it was prepared. Reuse of and improper reliance on this document without written authorization and adaptation by Kimley-Horn and Associates, Inc., shall be without liability to Kimley-Horn and Associates, Inc.
 Copyright Kimley-Horn and Associates, Inc., 2010

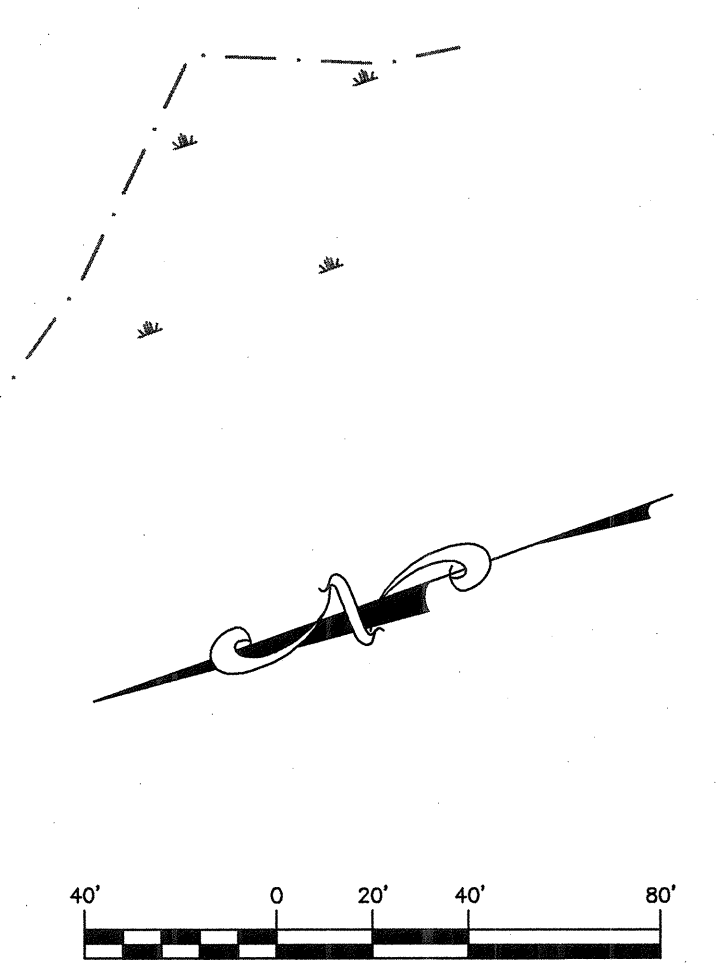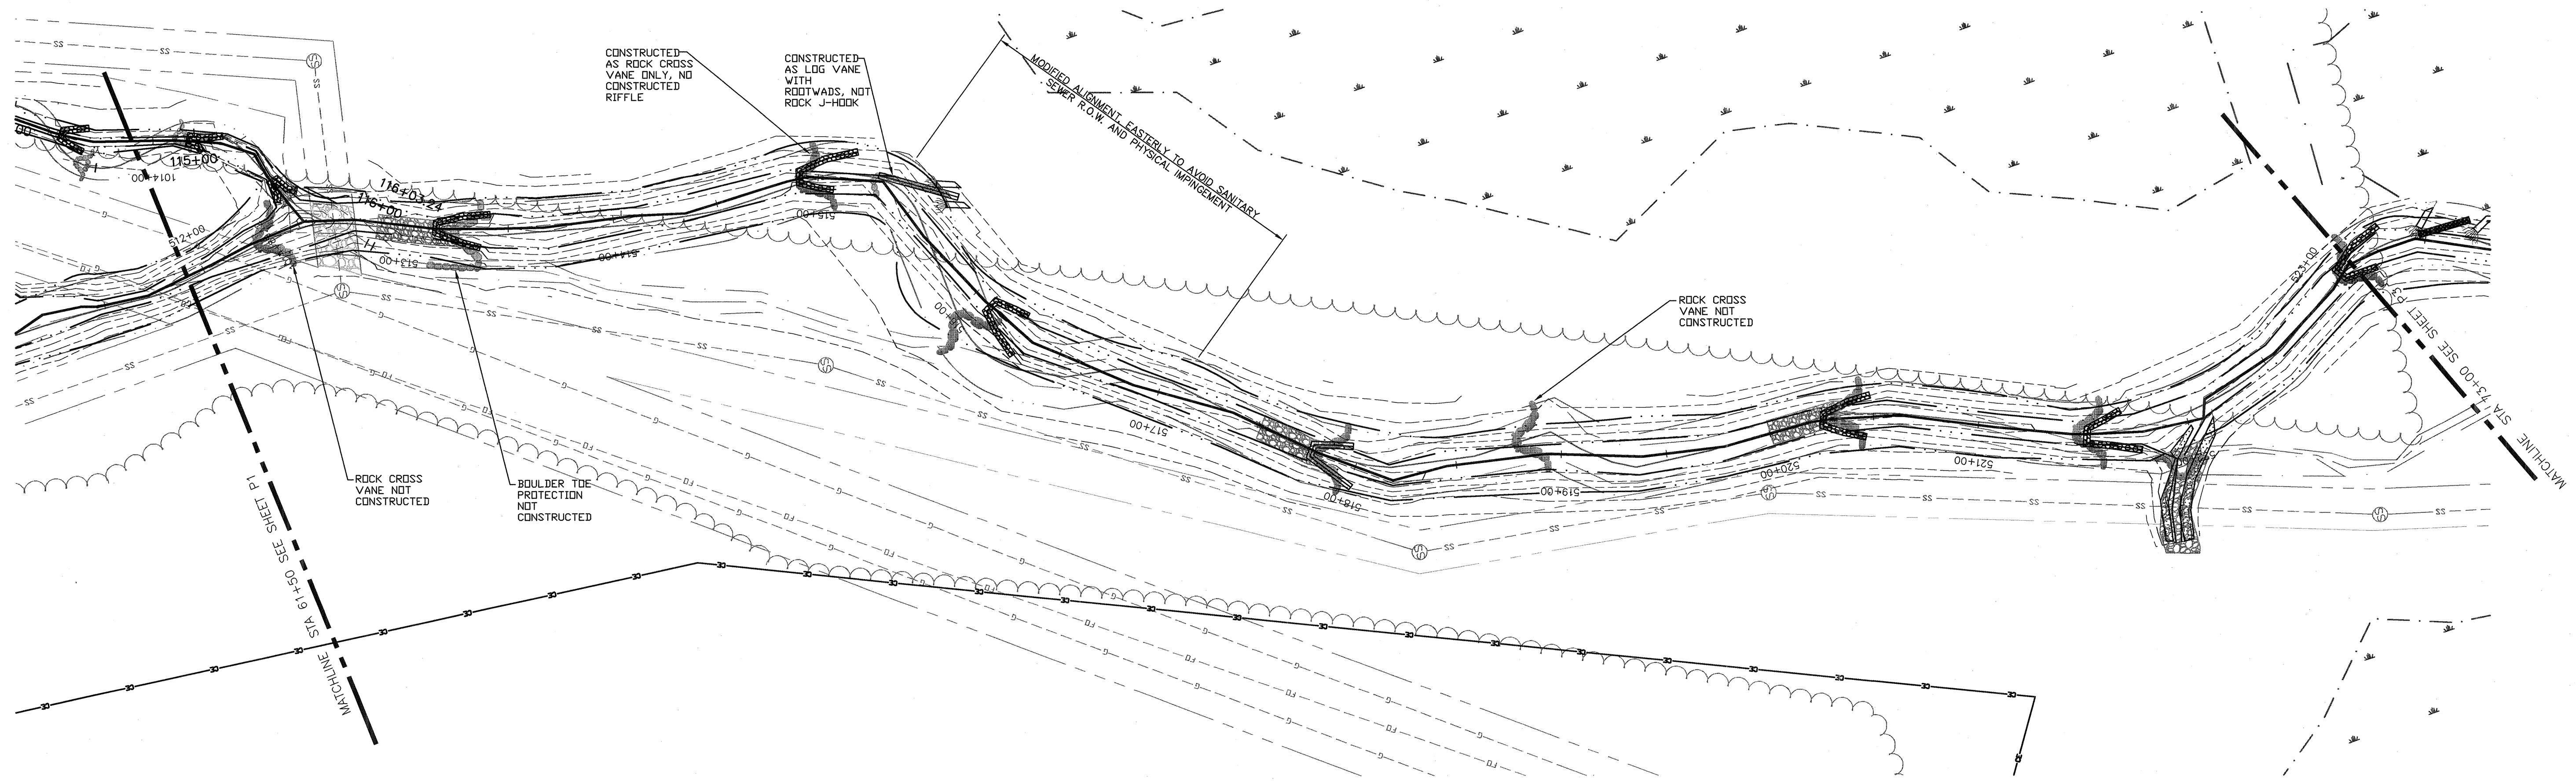

RECORD DOCUMENT

REV. No.	REVISION	DATE	DRAWN BY	CHECKED BY

This document, together with the concepts and designs presented herein, as an instrument of service, is intended only for the specific purpose and client for which it was prepared. Reuse of and improper reliance on this document without written authorization and adaptation by Kimley-Horn and Associates, Inc., shall be without liability to Kimley-Horn and Associates, Inc.
Copyright Kimley-Horn and Associates, Inc., 2010


PREPARED IN THE OFFICE OF:



Kimley-Horn and Associates, Inc.
 NC LICENSE #F-0102
 P.O. BOX 33068 - RALEIGH, NORTH CAROLINA 27636-3068
 PHONE: (919) 677-2000 FAX: (919) 677-2050

CLIENT: **NC-EEP**

TITLE: **PLAN - REACH A**




DATE: 01-28-10
 HORIZONTAL SCALE:
 VERTICAL SCALE:
 DRAWN BY: JIK
 DESIGNED BY: ARK/JCD
 CHECKED BY: WRW

PROJECT: **VALLEY FIELDS FARM**

ATTACHED REFERENCE FILES:
 JOB NUMBER: 011795020
 SHEET NUMBER: **P2**

NOTE:
SEE SHEET P13 FOR WETLAND GRADING PLAN

SEE SHEETS P6 - P8 FOR REACH B

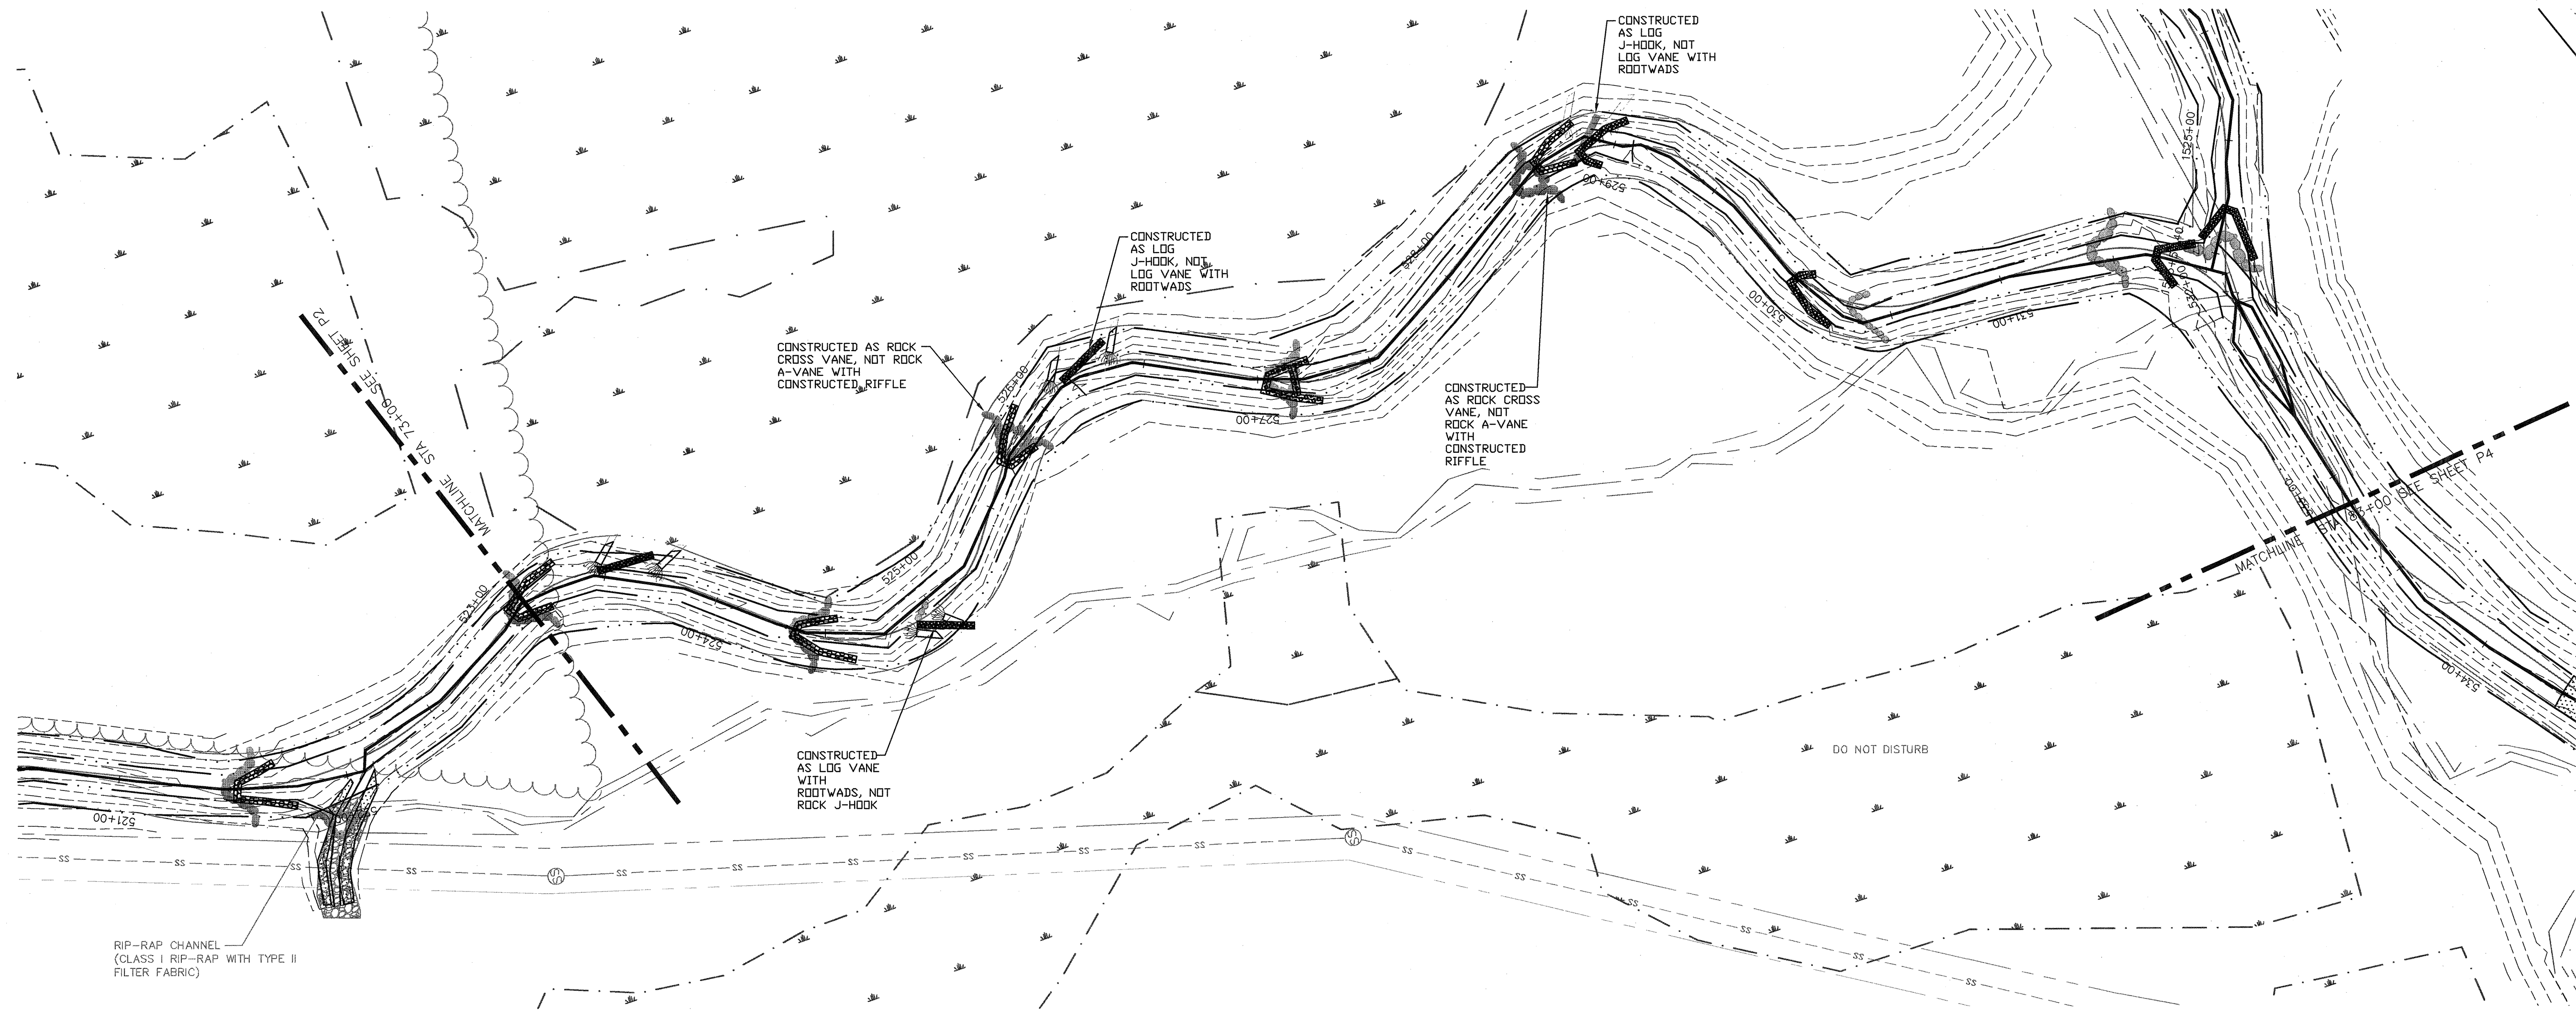

RIP-RAP CHANNEL
(CLASS I RIP-RAP WITH TYPE II
FILTER FABRIC)

CONSTRUCTED AS ROCK
CROSS VANE, NOT ROCK
A-VANE WITH
CONSTRUCTED RIFFLE


CONSTRUCTED
AS LOG
J-HOOK, NOT
LOG VANE WITH
ROOTWADS

CONSTRUCTED
AS ROCK CROSS
VANE, NOT
ROCK A-VANE
WITH
CONSTRUCTED
RIFFLE

CONSTRUCTED
AS LOG
J-HOOK, NOT
LOG VANE WITH
ROOTWADS

CONSTRUCTED
AS LOG VANE
WITH
ROOTWADS, NOT
ROCK J-HOOK


DO NOT DISTURB

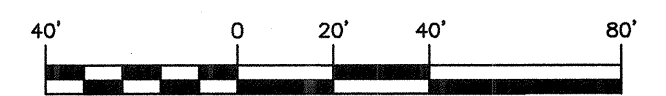

RECORD DOCUMENT

REV. No.	REVISION	DATE	DRAWN BY	CHECKED BY

PREPARED IN THE OFFICE OF:

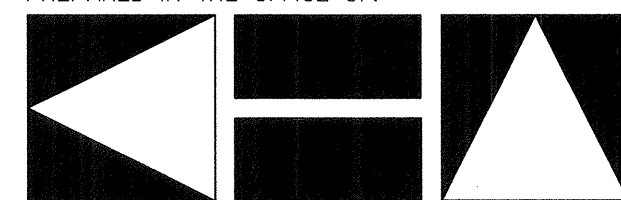

**Kimley-Horn
and Associates, Inc.**


NC LICENSE #F-0102
P.O. BOX 33068 - RALEIGH, NORTH CAROLINA 27636-3068
PHONE: (919) 677-2000 FAX: (919) 677-2050

CLIENT:

NC-EEP

TITLE:

PLAN- REACH A

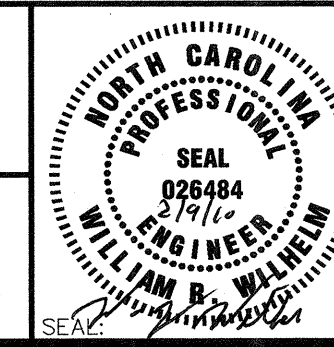

DATE: 01-28-10
 HORIZONTAL SCALE:
 VERTICAL SCALE:
 DRAWN BY: JJK
 DESIGNED BY: ARK/JCD
 CHECKED BY: WRW



PROJECT:

VALLEY FIELDS FARM

ATTACHED REFERENCE FILES:

JOB NUMBER: 011795020

SHEET NUMBER: P3

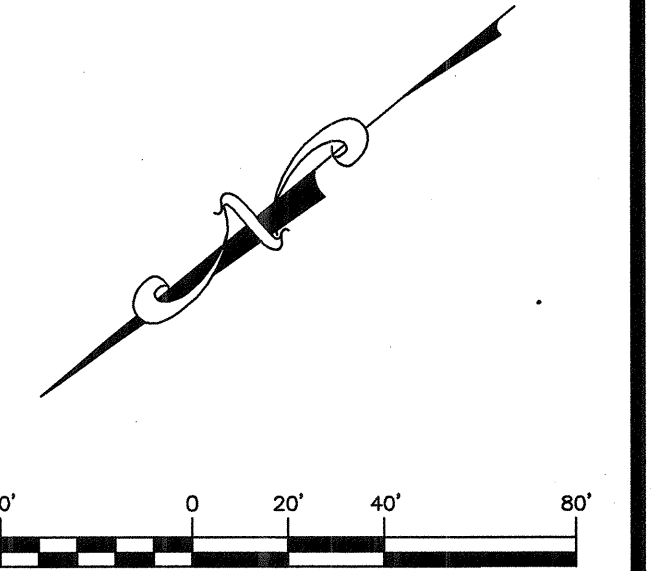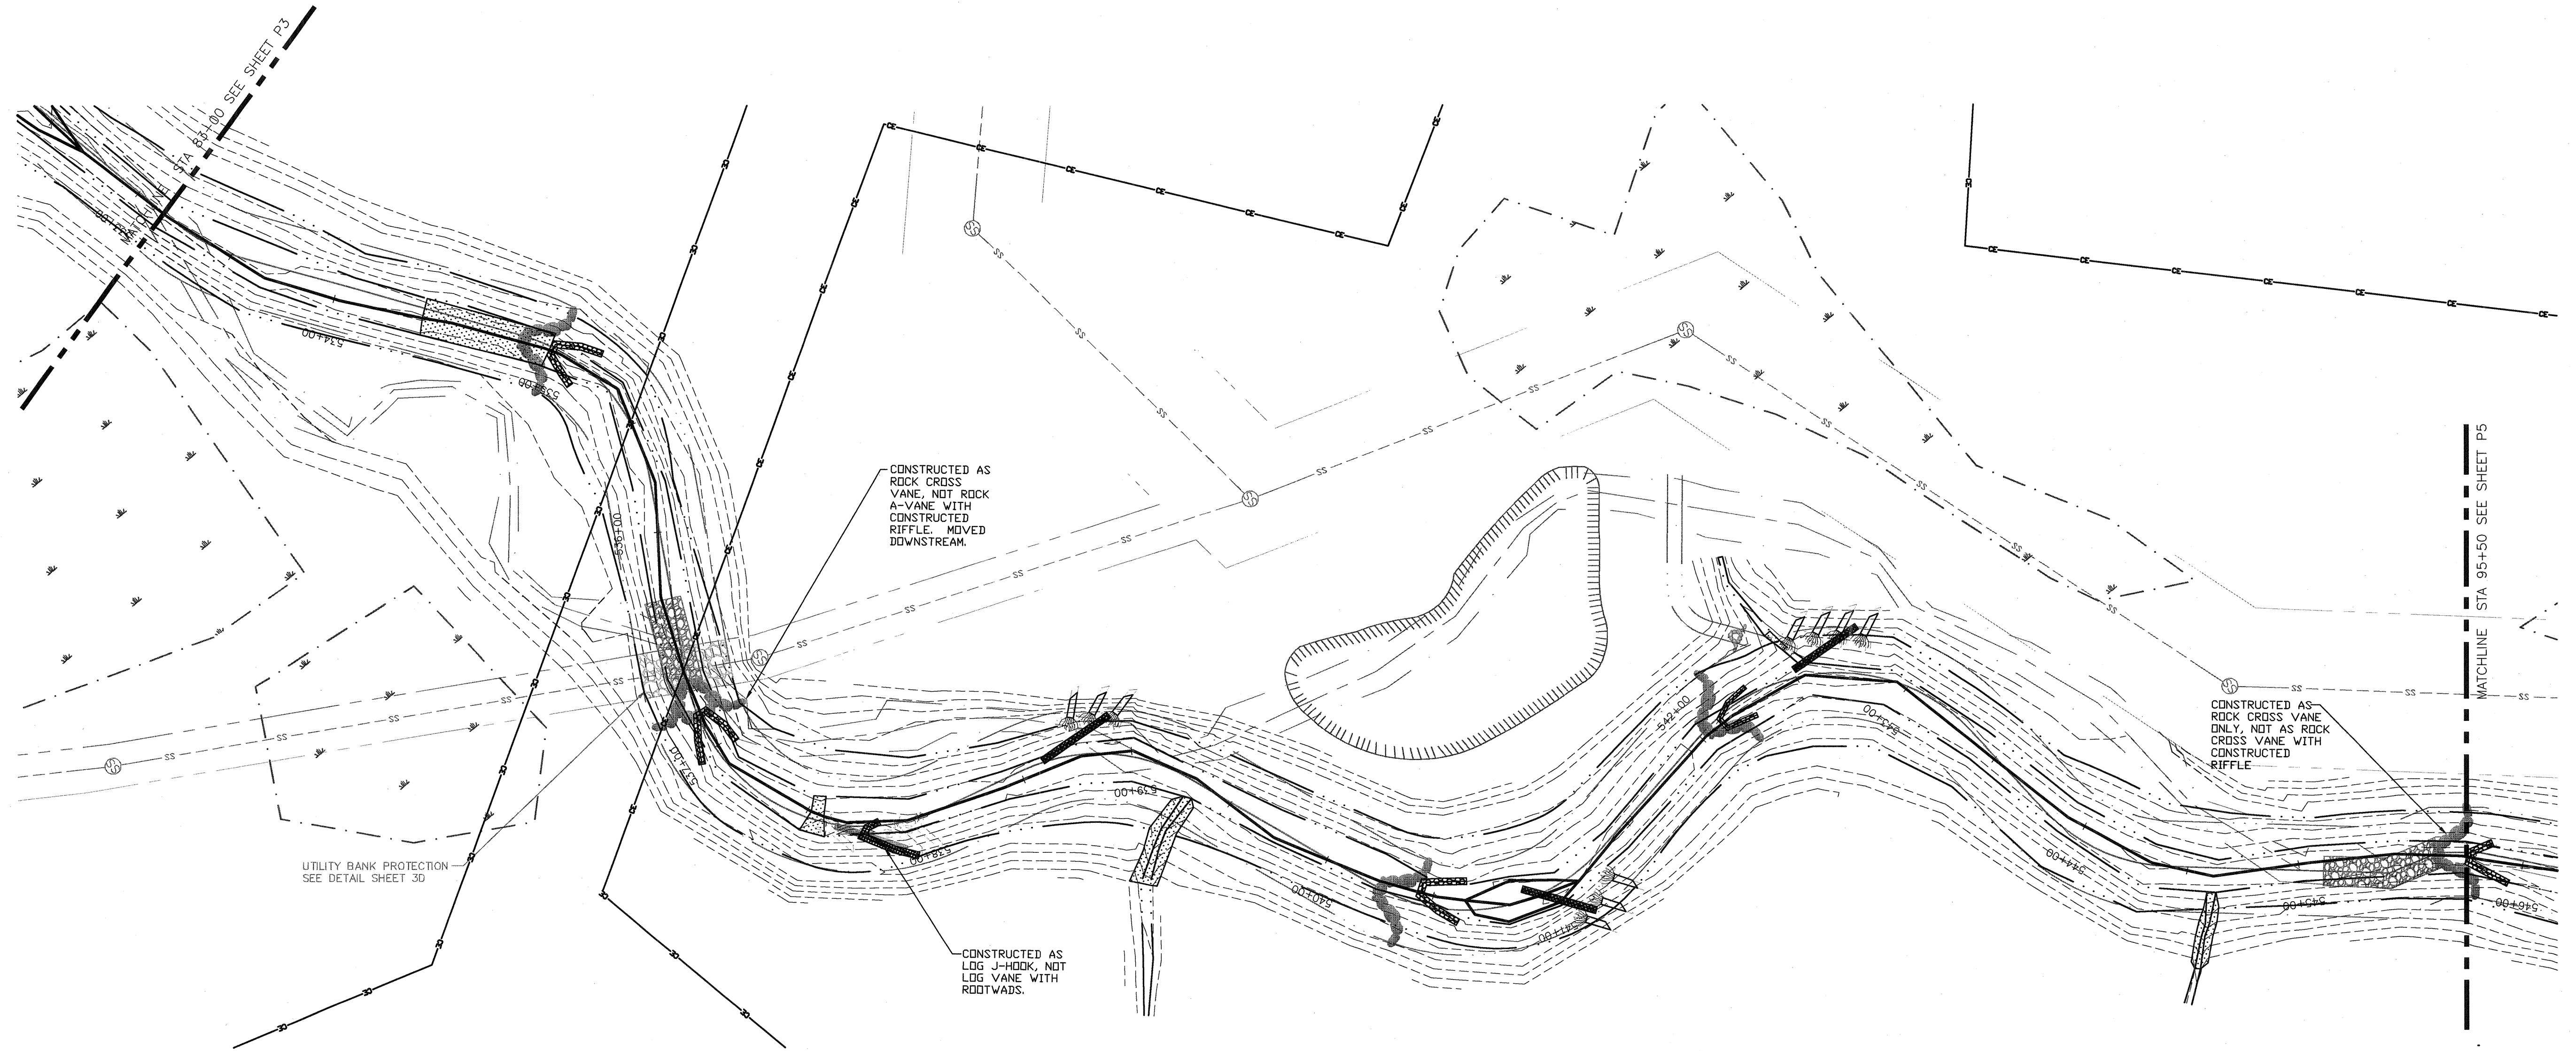

RECORD DOCUMENT

REV. No.	REVISION	DATE	DRAWN BY	CHECKED BY

PREPARED IN THE OFFICE OF:



Kimley-Horn and Associates, Inc.
 NC LICENSE #F-0102
 P.O. BOX 33068 - RALEIGH, NORTH CAROLINA 27636-3068
 PHONE: (919) 677-2000 FAX: (919) 677-2050

CLIENT: **NC-EEP**


TITLE: **PLAN - REACH A**



DATE: 01-28-10
 HORIZONTAL SCALE:
 VERTICAL SCALE:
 DRAWN BY: JJK
 DESIGNED BY: ARK/JCD
 CHECKED BY: WRW

PROJECT: **VALLEY FIELDS FARM**

ATTACHED REFERENCE FILES:
 JOB NUMBER: 011795020
 SHEET NUMBER: **P4**

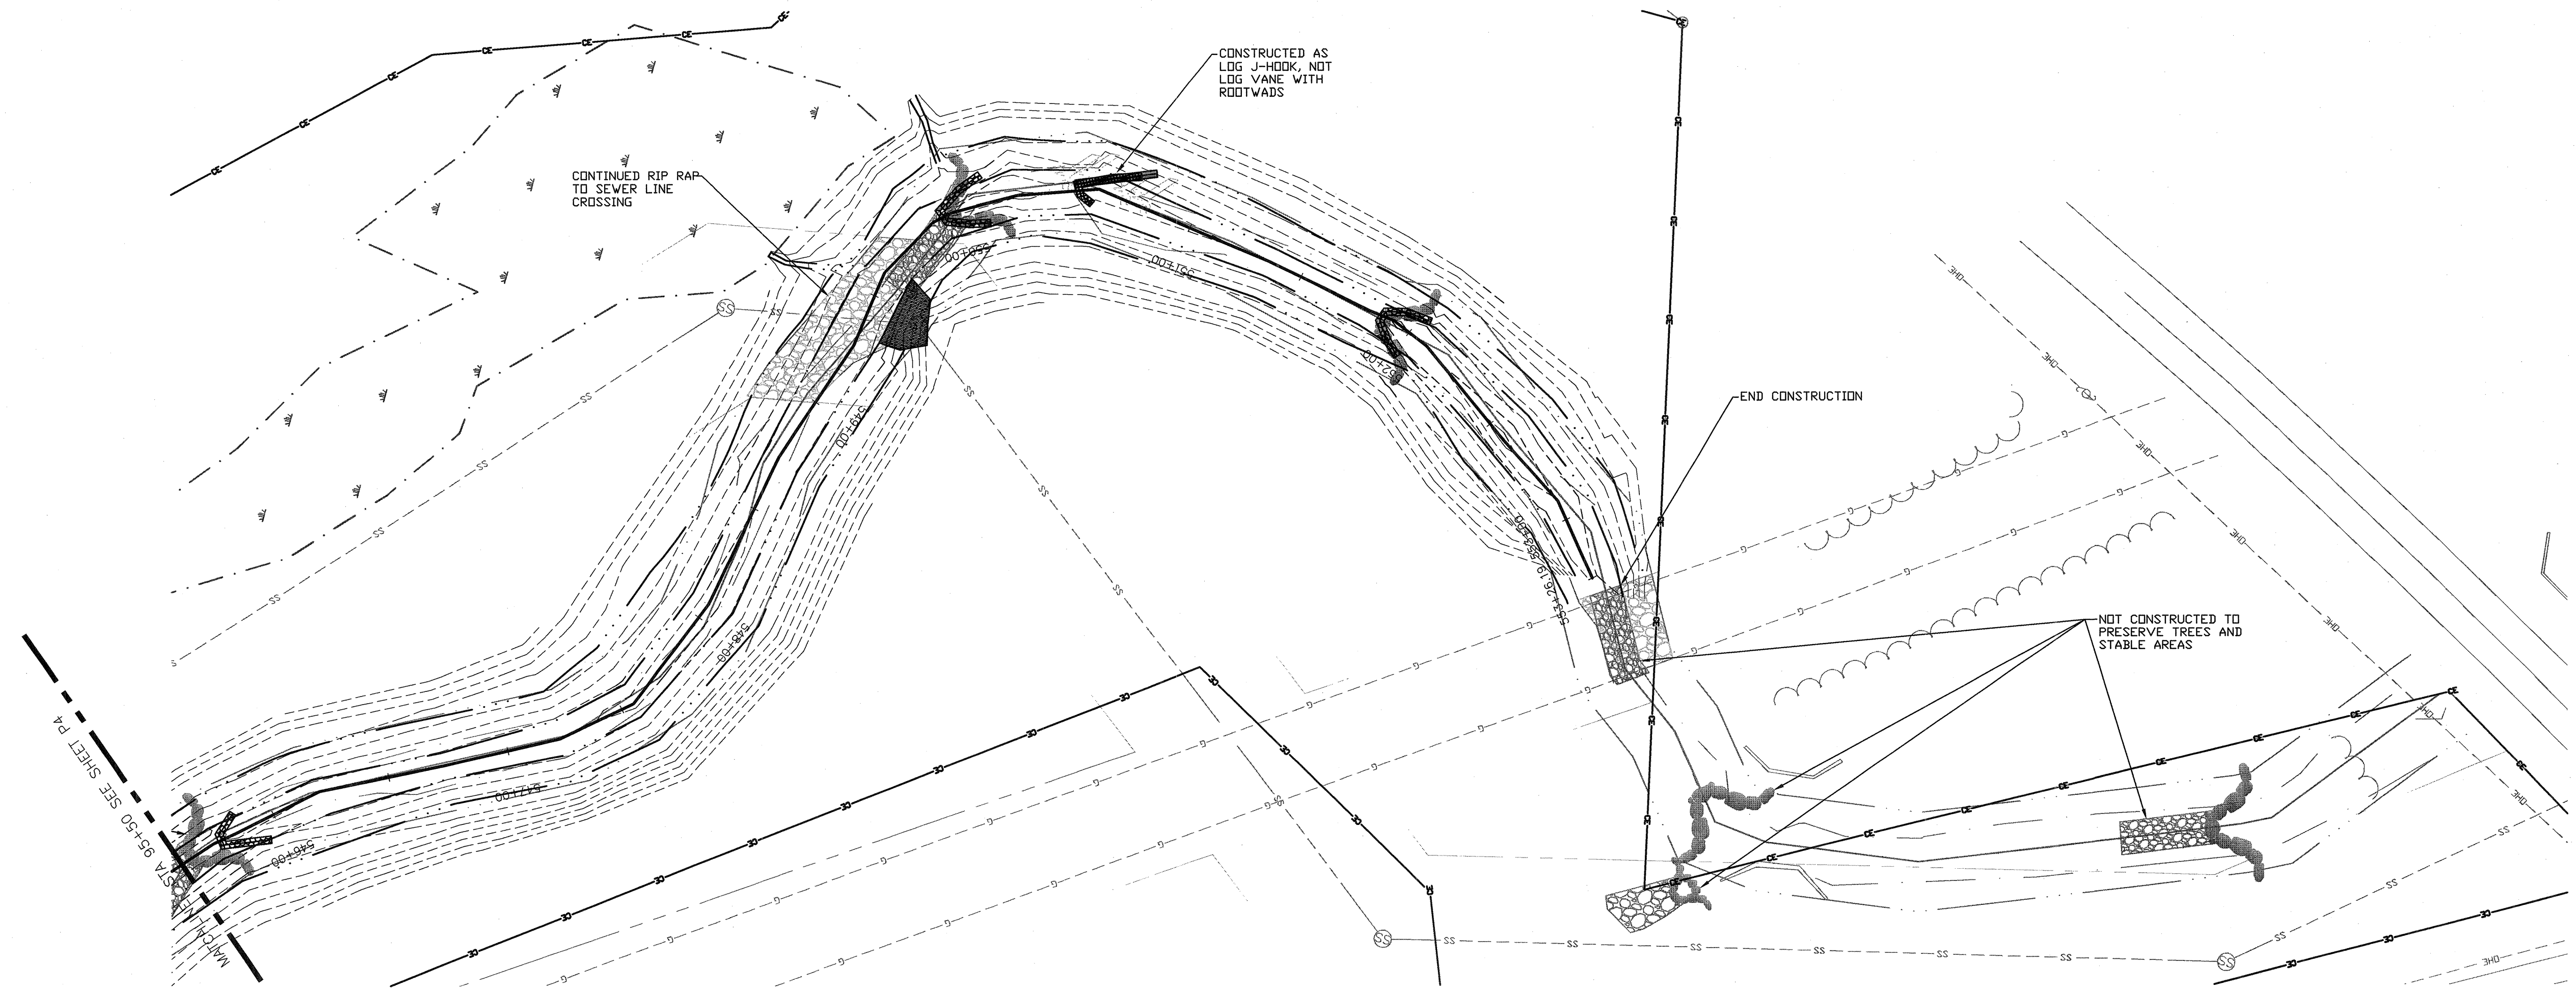

RECORD DOCUMENT

REV. No.	REVISION	DATE	DRAWN BY	CHECKED BY

This document, together with the concepts and designs presented herein, as an instrument of service, is intended only for the specific purpose and client for which it was prepared. Reuse of and improper reliance on this document without written authorization and adaptation by Kimley-Horn and Associates, Inc., shall be without liability to Kimley-Horn and Associates, Inc.
Copyright Kimley-Horn and Associates, Inc., 2010

PREPARED IN THE OFFICE OF:



Kimley-Horn and Associates, Inc.
 NC LICENSE #F-0102
 P.O. BOX 33068 - RALEIGH, NORTH CAROLINA 27636-3068
 PHONE: (919) 677-2000 FAX: (919) 677-2050

CLIENT: **NC-EEP**


TITLE: **PLAN - REACH A**




DATE: 01-28-10
 HORIZONTAL SCALE:
 VERTICAL SCALE:
 DRAWN BY: JIK
 DESIGNED BY: ARK/JCD
 CHECKED BY: WRW

PROJECT: **VALLEY FIELDS FARM**

ATTACHED REFERENCE FILES:
 JOB NUMBER: 011795020
 SHEET NUMBER: **P5**

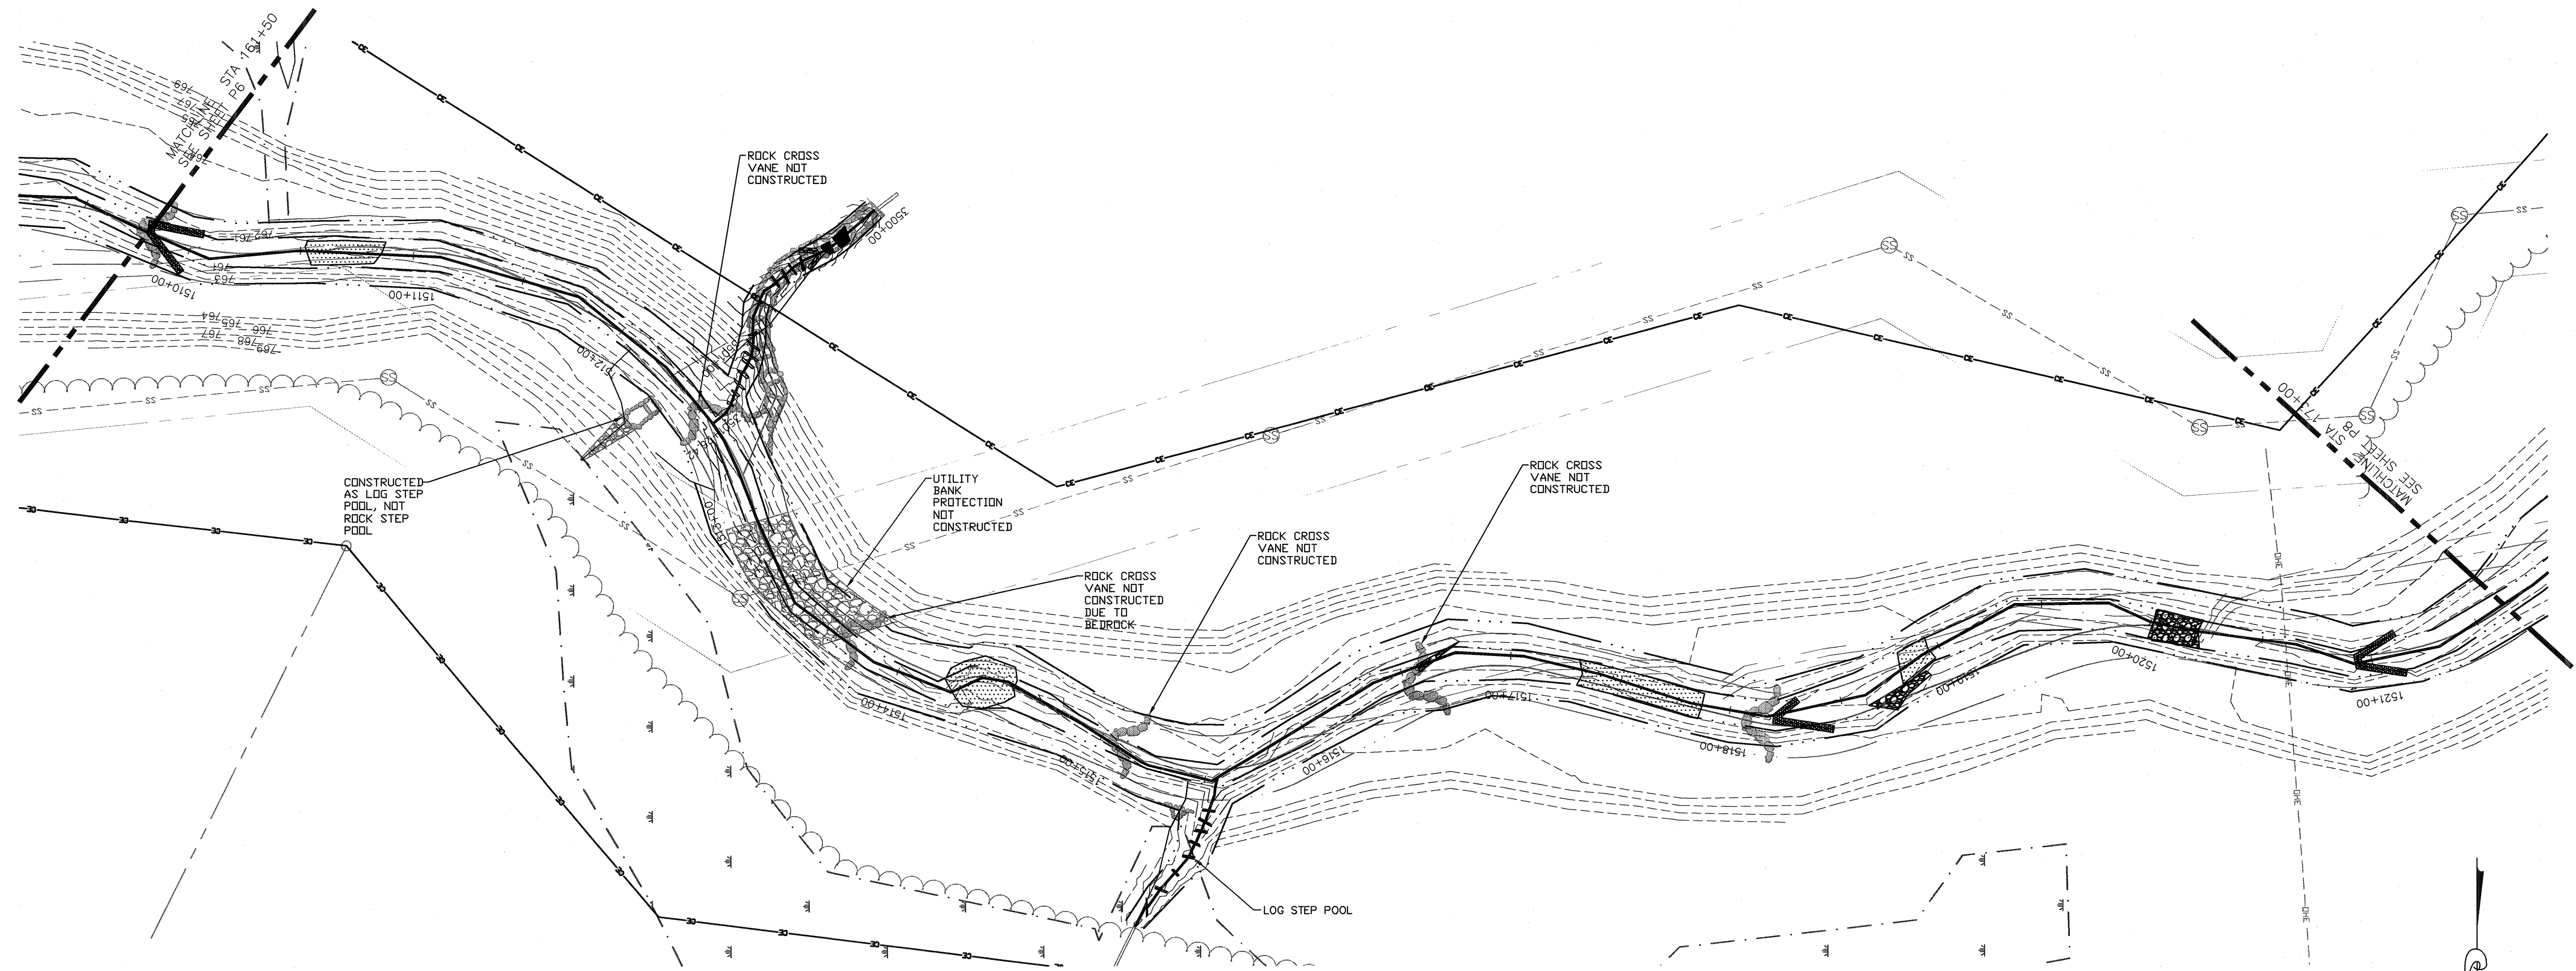

NOTE:
 STA 150+00 TO STA 175+24 AND STA 200+00 TO STA 202+98
 WAS REPAIRED AFTER HURRICANE STORM DAMAGE PER CHANGE
 ORDER 2 AND 3. FOR CLARITY.

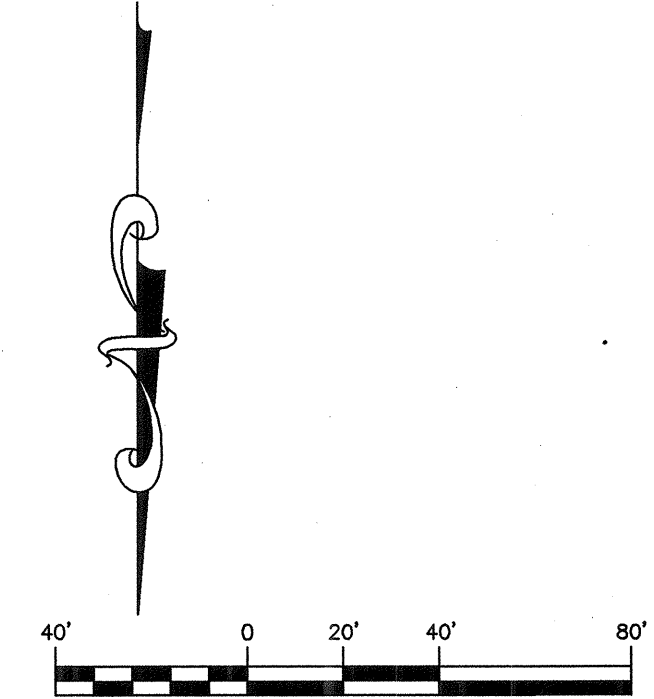

RECORD DOCUMENT

REV. No.	REVISION	DATE	DRAWN BY	CHECKED BY

PREPARED IN THE OFFICE OF:



**Kimley-Horn
and Associates, Inc.**

NC LICENSE # 0102
 P.O. BOX 33068 - RALEIGH, NORTH CAROLINA 27636-3068
 PHONE: (919) 677-2000 FAX: (919) 677-2050

CLIENT: **NC-EEP**


TITLE: **PLAN - REACH B**




DATE: 01-28-10
 HORIZONTAL SCALE:
 VERTICAL SCALE:
 DRAWN BY: JIK
 DESIGNED BY: ARK/JCD
 CHECKED BY: WRW

PROJECT: **VALLEY FIELDS FARM**

ATTACHED REFERENCE FILES:
 JOB NUMBER: 011795020
 SHEET NUMBER: **P7**

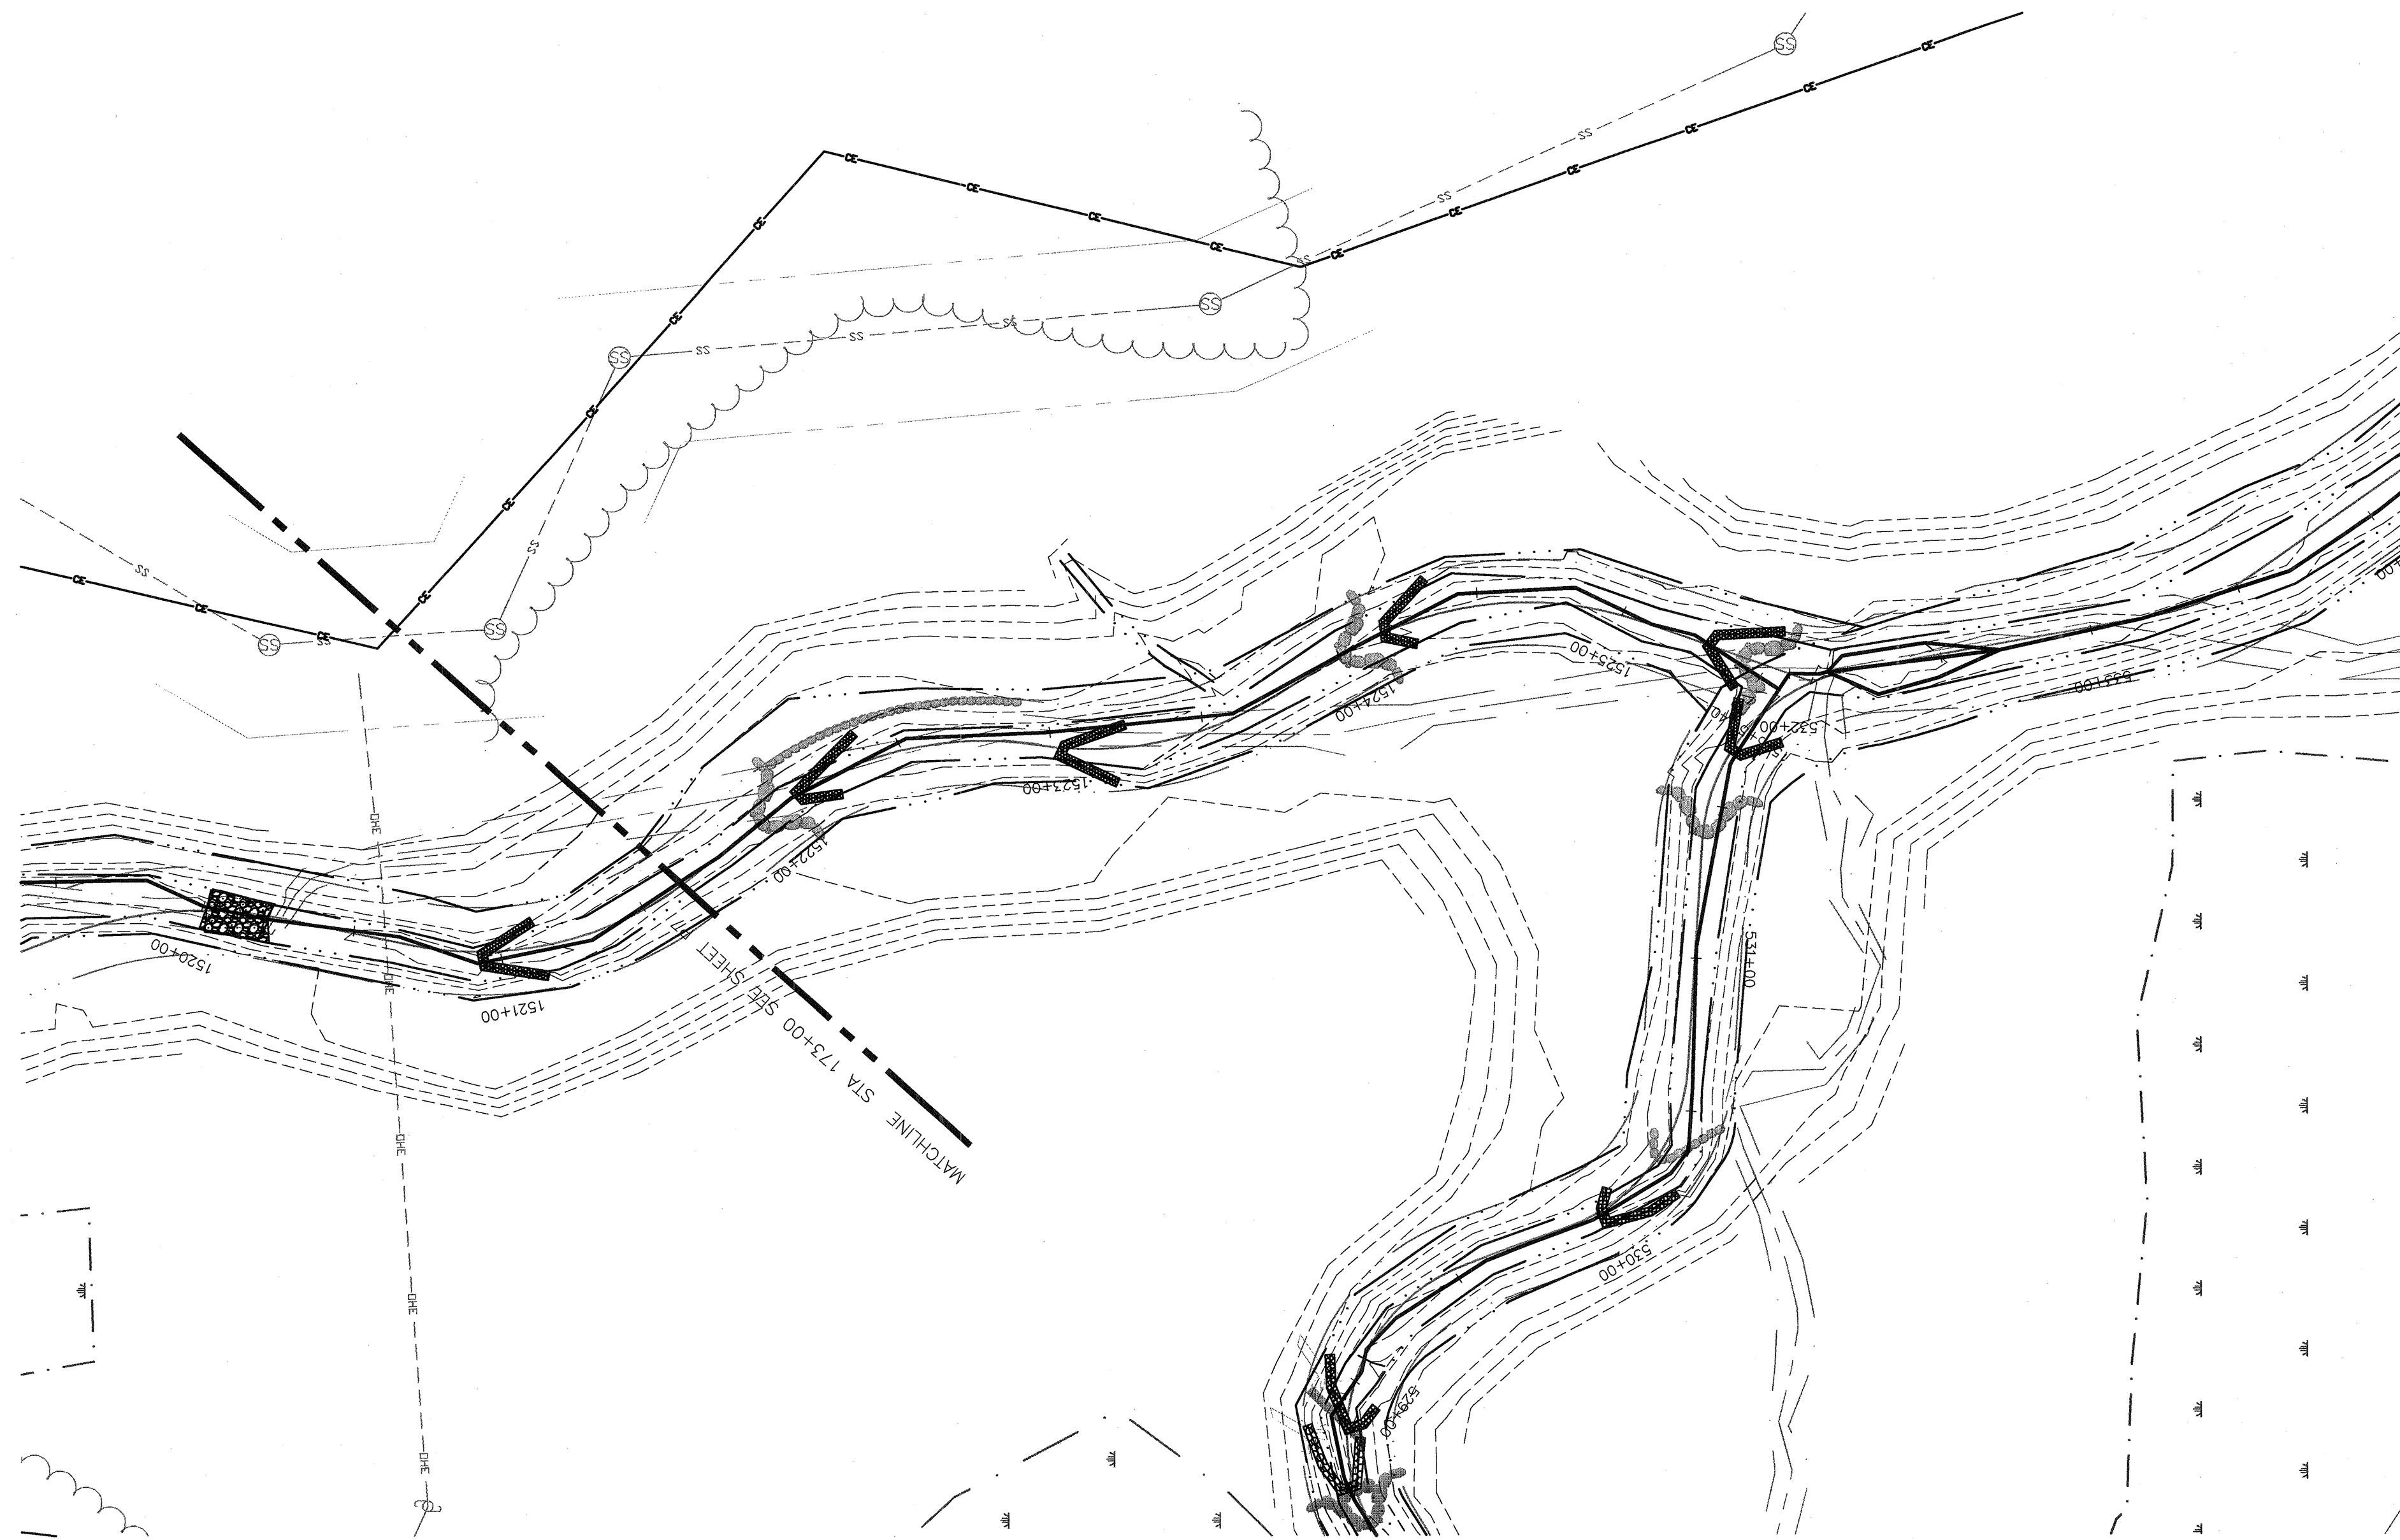

NOTE:
 STA 150+00 TO STA 175+24 AND STA 200+00 TO STA 202+98
 WAS REPAIRED AFTER HURRICANE STORM DAMAGE PER CHANGE
 ORDER 2 AND 3.

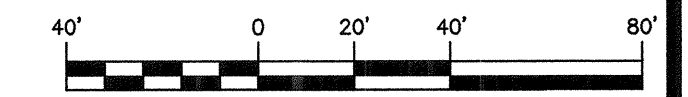

RECORD DOCUMENT

REV. No.	REVISION	DATE	DRAWN BY	CHECKED BY

This document, together with the concepts and designs presented herein, as an instrument of service, is intended only for the specific purpose and client for which it was prepared. Reuse of and improper reliance on this document without written authorization and adaptation by Kimley-Horn and Associates, Inc., shall be without liability to Kimley-Horn and Associates, Inc.
 Copyright Kimley-Horn and Associates, Inc., 2010

PREPARED IN THE OFFICE OF:

**Kimley-Horn
and Associates, Inc.**

NC LICENSE #F-0102
 P.O. BOX 33068 - RALEIGH, NORTH CAROLINA 27636-3068
 PHONE: (919) 677-2000 FAX: (919) 677-2050


CLIENT: **NC-EEP**

TITLE: **PLAN - REACH B**

DATE: 01-28-10
 HORIZONTAL SCALE:
 PROJECT: **VALLEY FIELDS FARM**

VERTICAL SCALE:
 DRAWN BY: JIK
 DESIGNED BY: ARK/JCD
 CHECKED BY: WRW

ATTACHED REFERENCE FILES:
 JOB NUMBER: 011795020
 SHEET NUMBER: **P8**

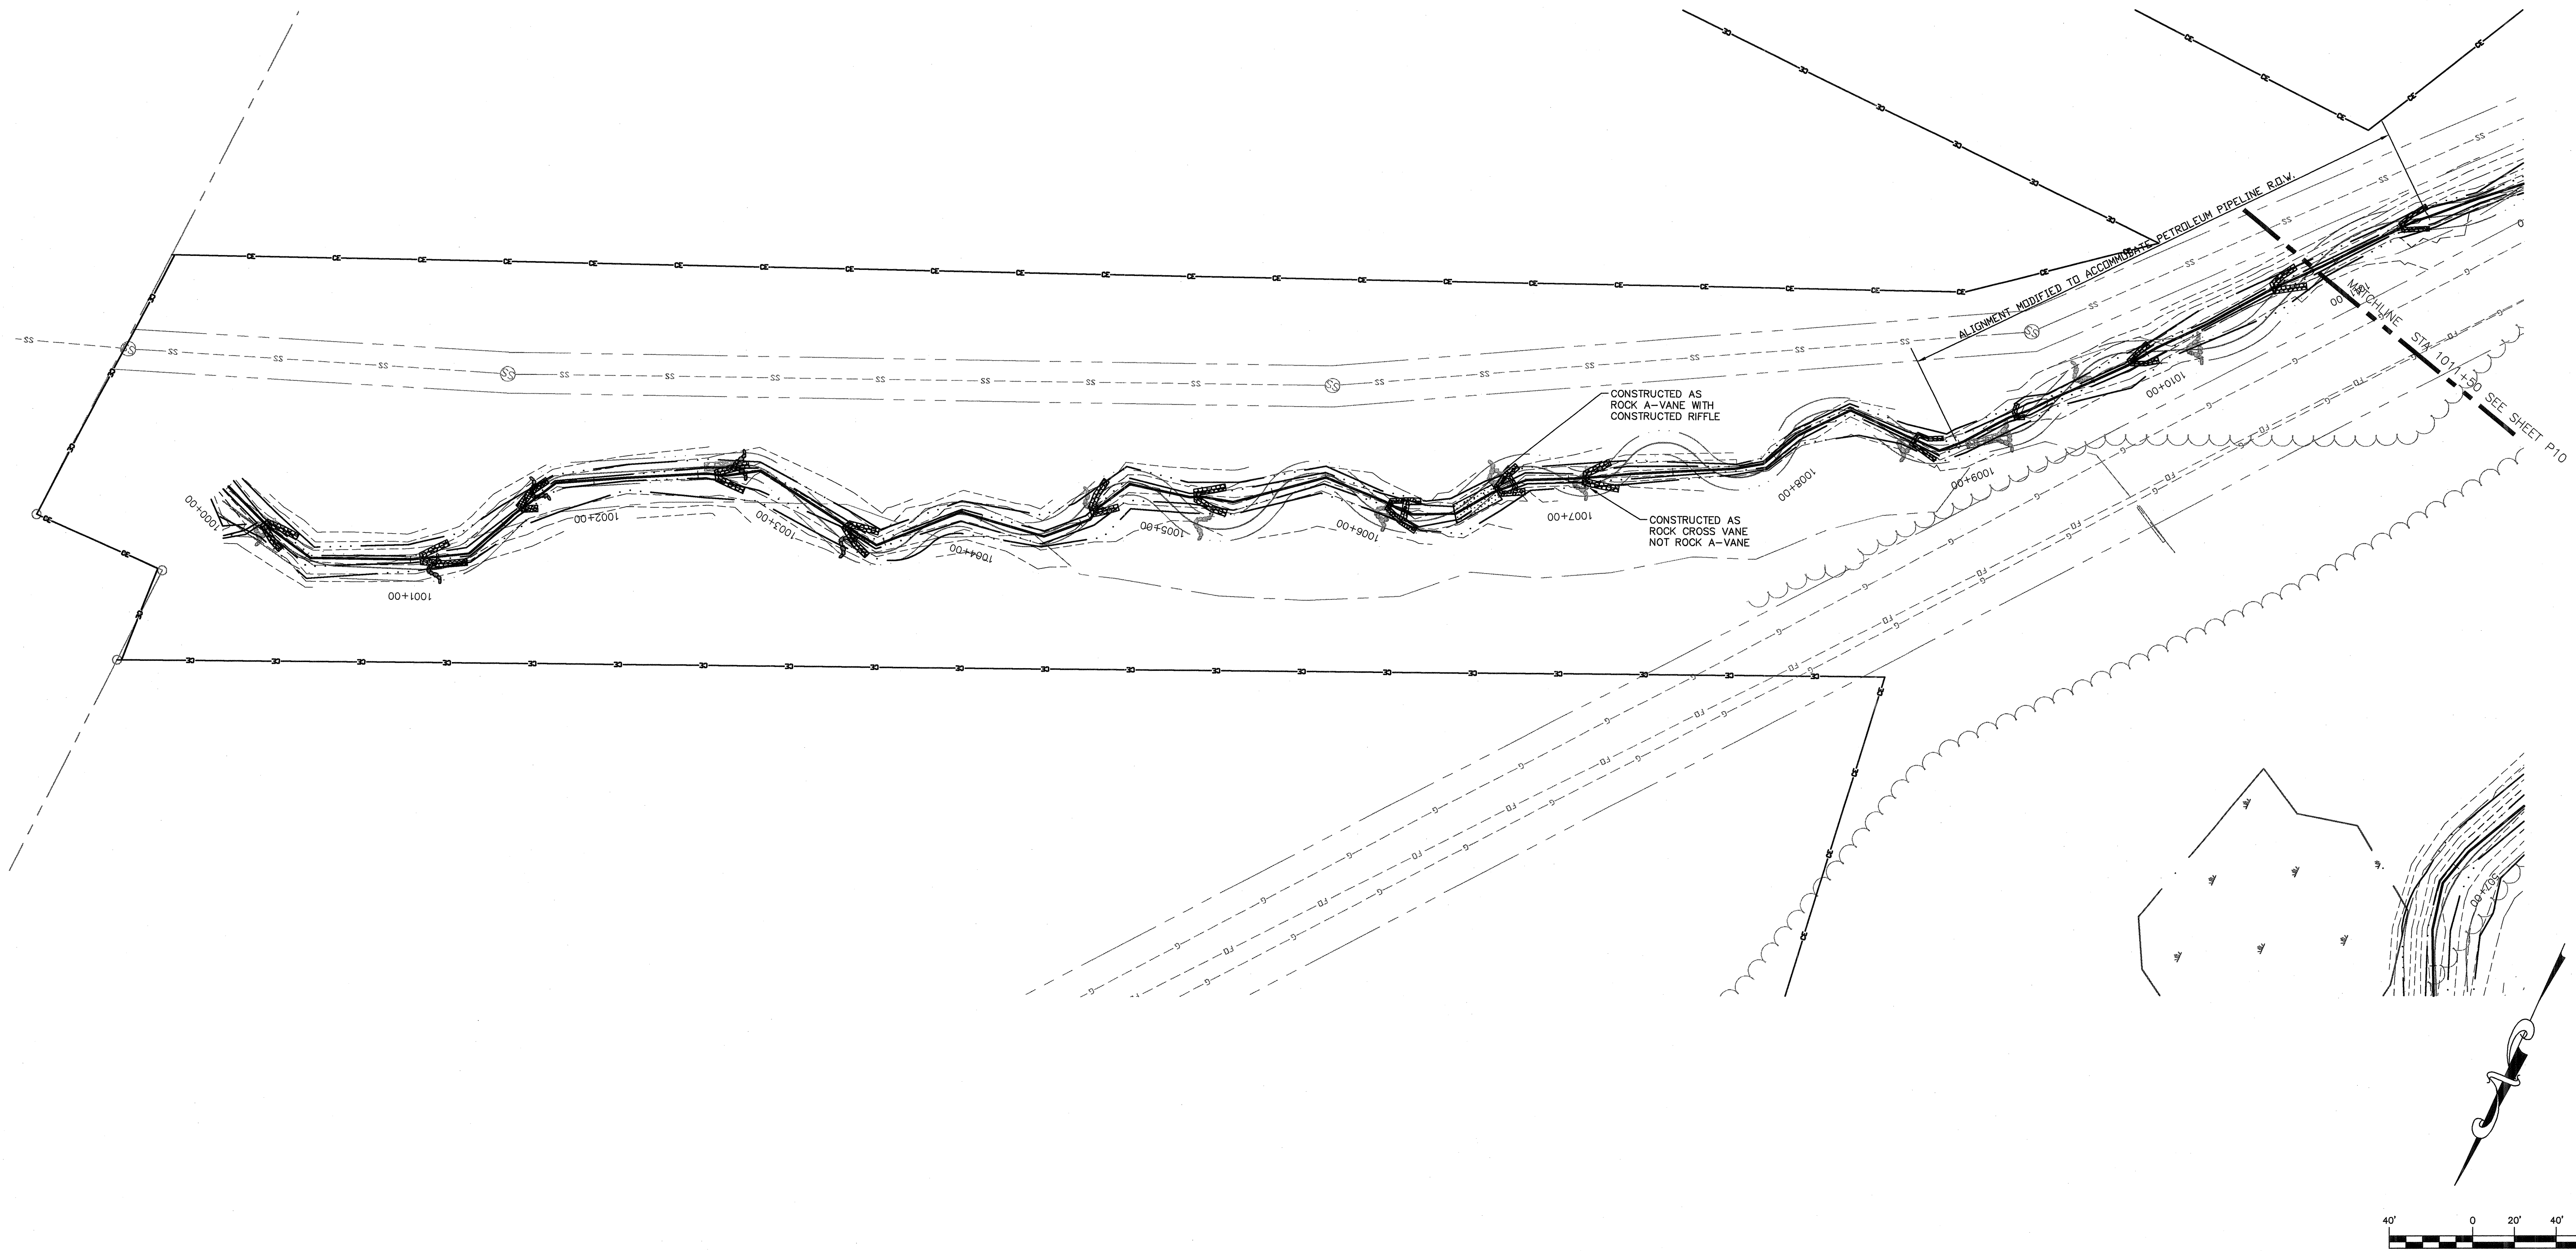

REV. No.	REVISION	DATE	DRAWN BY	CHECKED BY

This document, together with the concepts and designs presented herein, as an instrument of service, is intended only for the specific purpose and client for which it was prepared. Reuse of and improper reliance on this document without written authorization and adaptation by Kimley-Horn and Associates, Inc., shall be without liability to Kimley-Horn and Associates, Inc. Copyright Kimley-Horn and Associates, Inc., 2010.


PREPARED IN THE OFFICE OF:



Kimley-Horn and Associates, Inc.
 NC LICENSE #F-0102
 P.O. BOX 33068 - RALEIGH, NORTH CAROLINA 27636-3068
 PHONE: (919) 677-2000 FAX: (919) 677-2050

CLIENT: **NC-EEP**

TITLE: **PLAN - REACH C**




DATE: 01-28-10
 HORIZONTAL SCALE:
 VERTICAL SCALE:
 DRAWN BY: JJK
 DESIGNED BY: ARK/JCD
 CHECKED BY: WRW

PROJECT: **VALLEY FIELDS FARM**

ATTACHED REFERENCE FILES:
 JOB NUMBER: 011795020
 SHEET NUMBER: **P9**

RECORD DOCUMENT

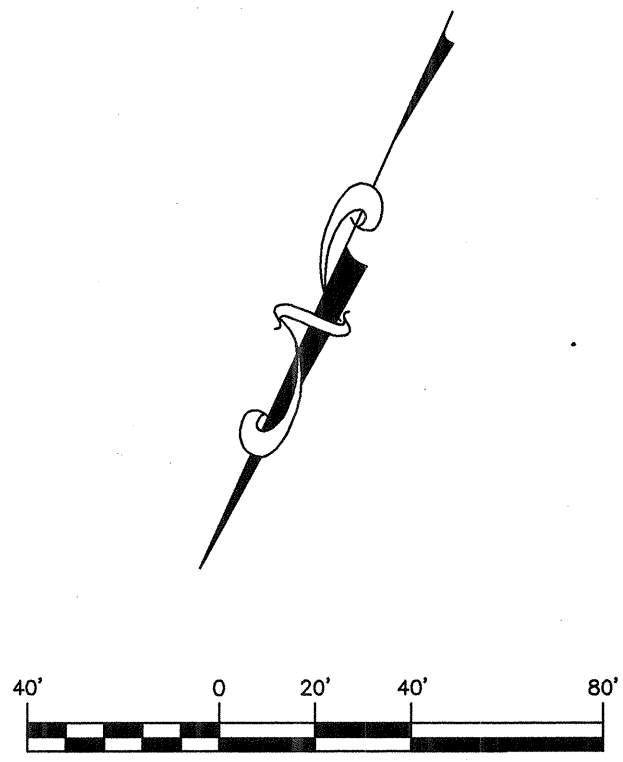

RECORD DOCUMENT

REV. No.	REVISION	DATE	DRAWN BY	CHECKED BY

PREPARED IN THE OFFICE OF:



Kimley-Horn and Associates, Inc.
 NC LICENSE #F-0102
 P.O. BOX 33068 - RALEIGH, NORTH CAROLINA 27636-3068
 PHONE: (919) 677-2000 FAX: (919) 677-2050

CLIENT: **NC-EEP**

TITLE: **PLAN - REACH C**




DATE: 01-28-10
 HORIZONTAL SCALE:
 VERTICAL SCALE:
 DRAWN BY: JIK
 DESIGNED BY: ARK/JCD
 CHECKED BY: WRW


PROJECT: **VALLEY FIELDS FARM**

ATTACHED REFERENCE FILES:
 JOB NUMBER: 011795020
 SHEET NUMBER: **P10**

This document, together with the concepts and designs presented herein, as an instrument of service, is intended only for the specific purpose and client for which it was prepared. Reuse of and improper reliance on this document without written authorization and adoption by Kimley-Horn and Associates, Inc., shall be without liability to Kimley-Horn and Associates, Inc.
 Copyright Kimley-Horn and Associates, Inc., 2010

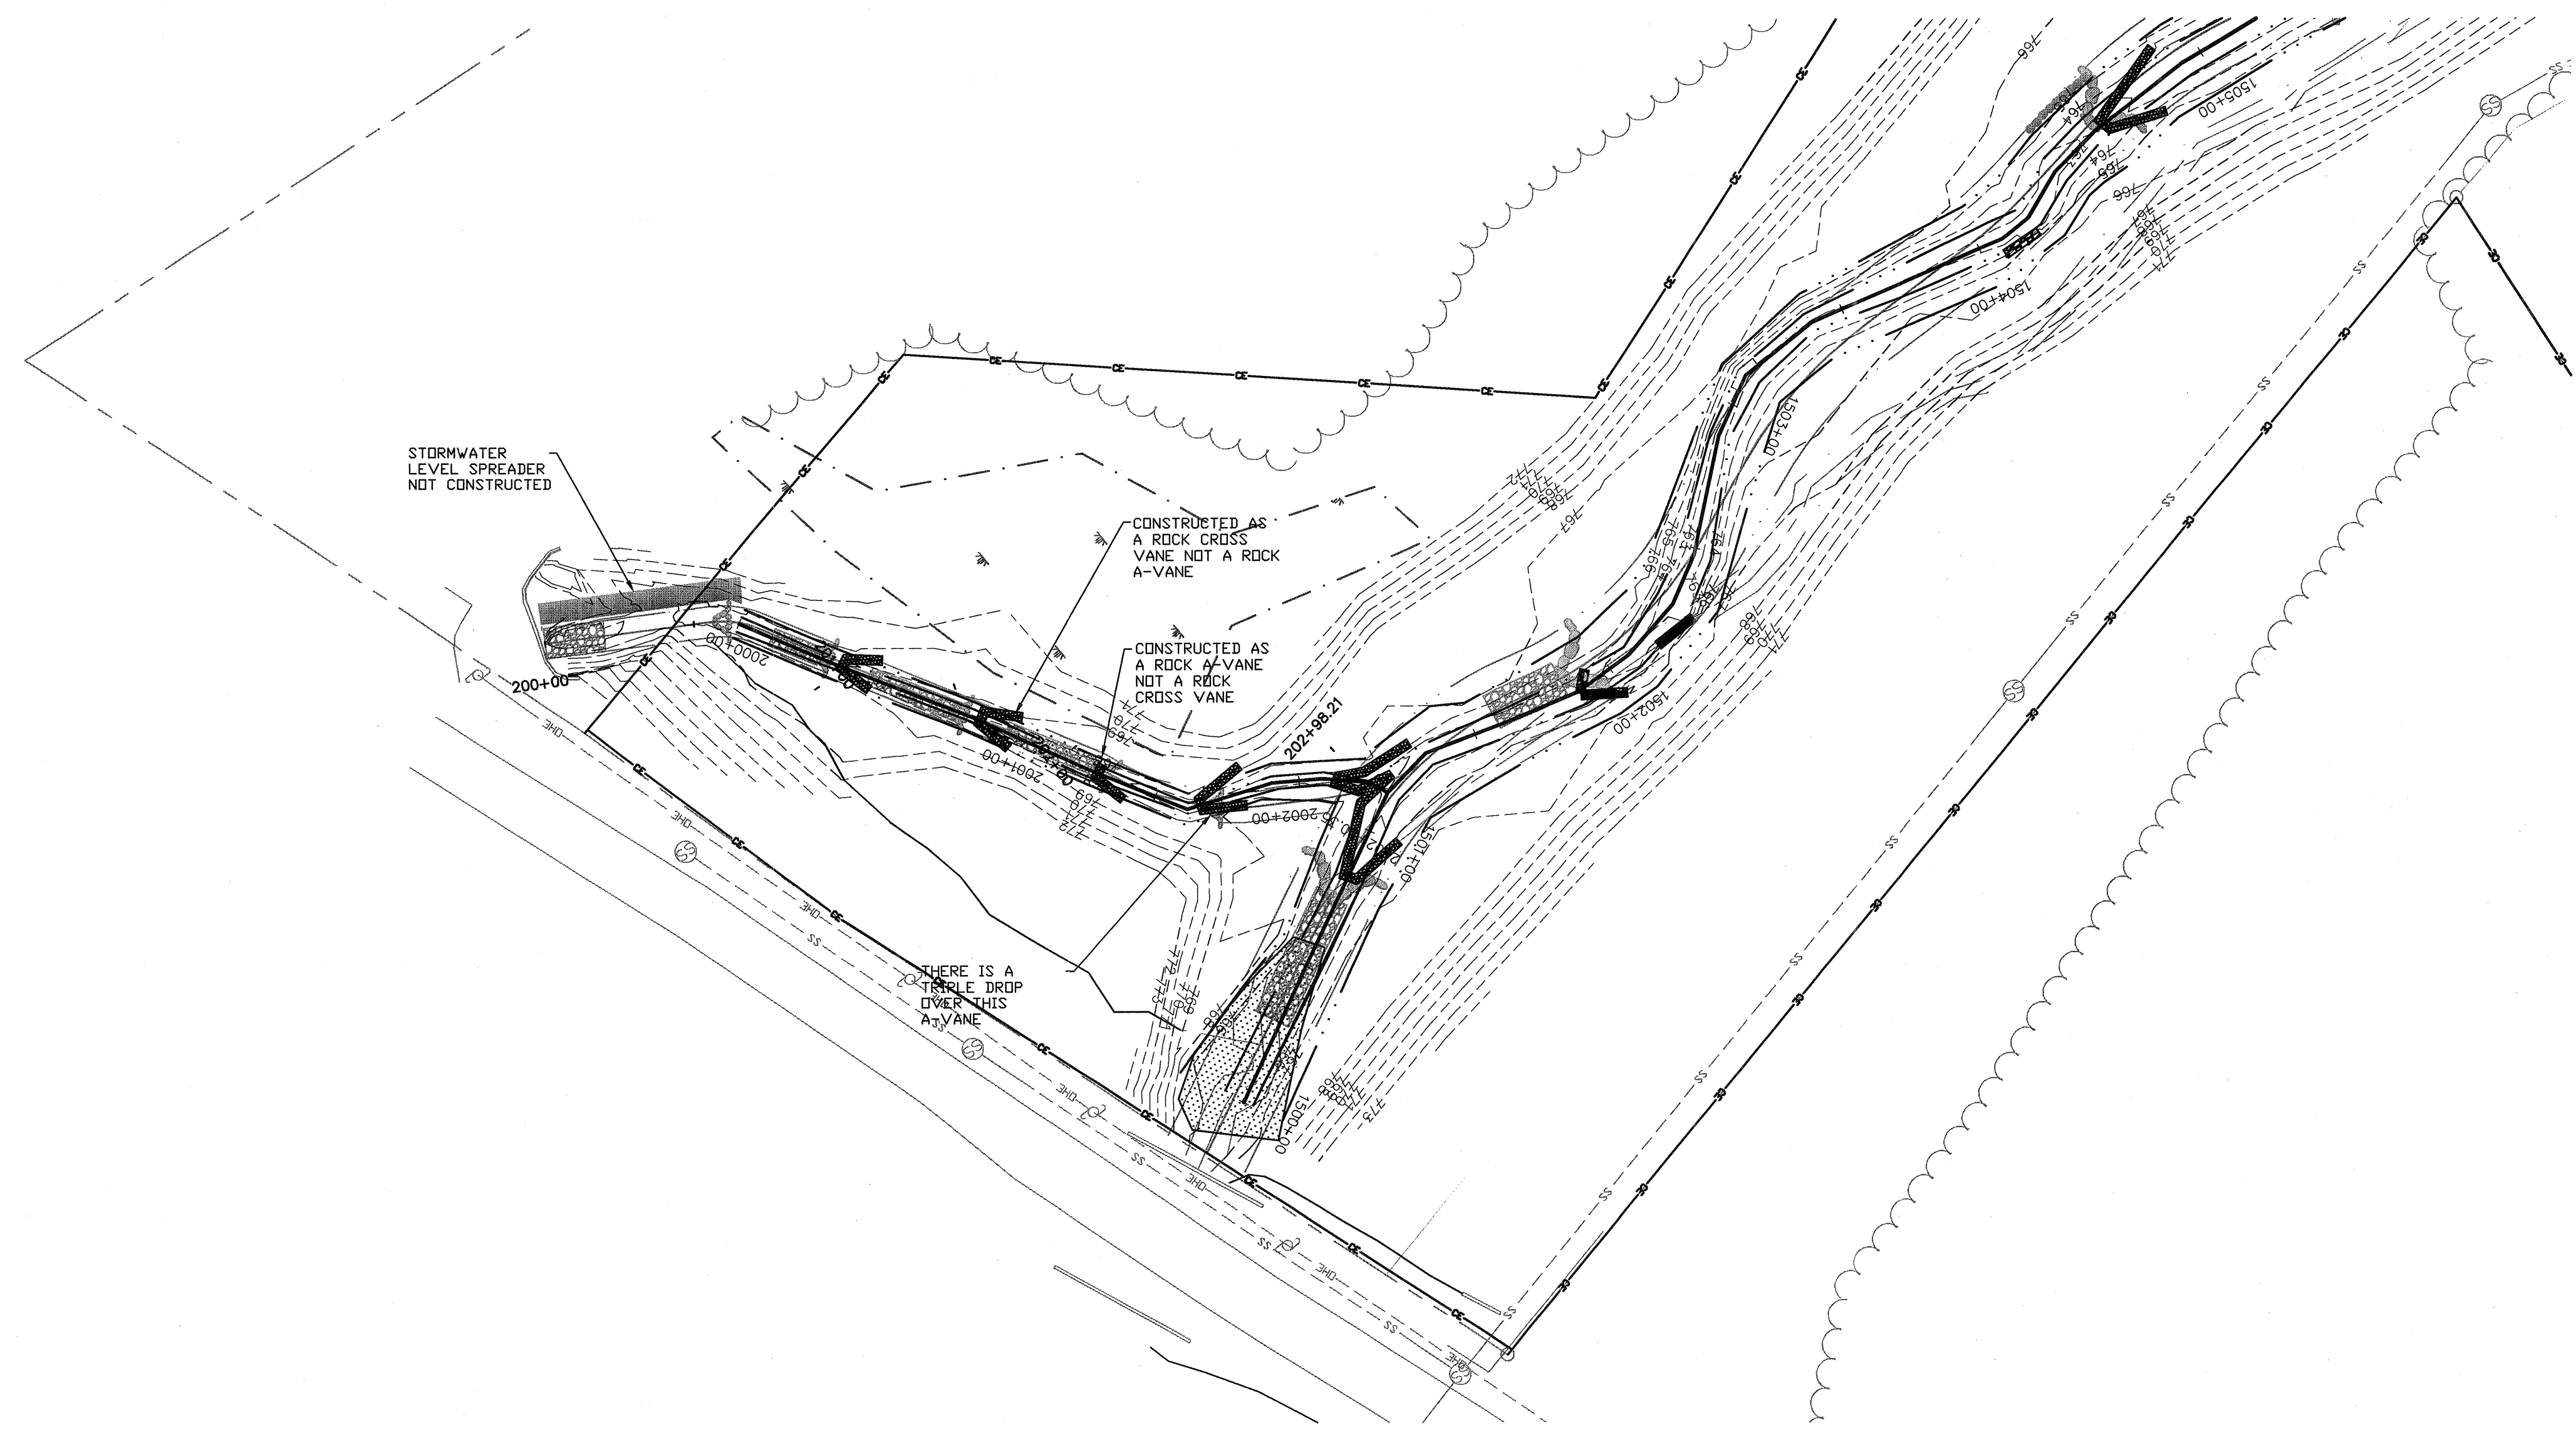

NOTE:
 STA 150+00 TO STA 175+24 AND STA 200+00 TO STA 202+98
 WAS REPAIRED AFTER HURRICANE STORM DAMAGE PER CHANGE
 ORDER 2 AND 3.

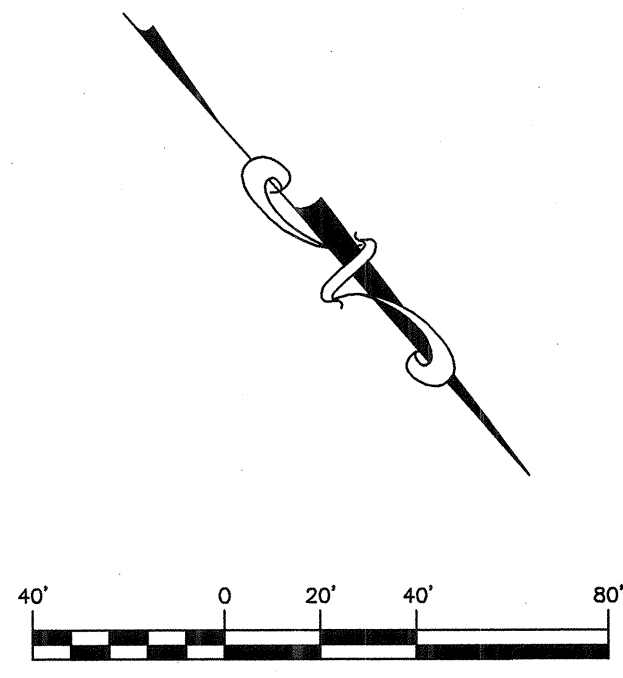

RECORD DOCUMENT

REV. No.	REVISION	DATE	DRAWN BY	CHECKED BY

PREPARED IN THE OFFICE OF:




**Kimley-Horn
and Associates, Inc.**

NC LICENSE # 0102
 P.O. BOX 33068 - RALEIGH, NORTH CAROLINA 27636-3068
 PHONE: (919) 677-2000 FAX: (919) 677-2050

CLIENT: **NC-EEP**

TITLE: **PLAN - REACH D**


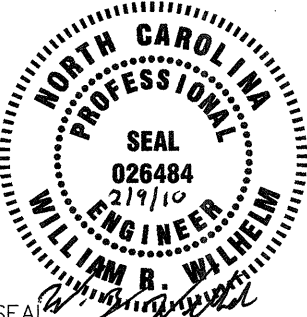


DATE: 01-28-10
 HORIZONTAL SCALE:
 VERTICAL SCALE:
 DRAWN BY: JIK
 DESIGNED BY: ARK/JCD
 CHECKED BY: WRW

PROJECT: **VALLEY FIELDS FARM**

ATTACHED REFERENCE FILES: JOB NUMBER: 011795020 SHEET NUMBER: **P11**

This document, together with the concepts and designs presented herein, as an instrument of service, is intended only for the specific purpose and client for which it was prepared. Reuse of and improper reliance on this document without written authorization and adaptation by Kimley-Horn and Associates, Inc., shall be without liability to Kimley-Horn and Associates, Inc. Copyright Kimley-Horn and Associates, Inc., 2010.

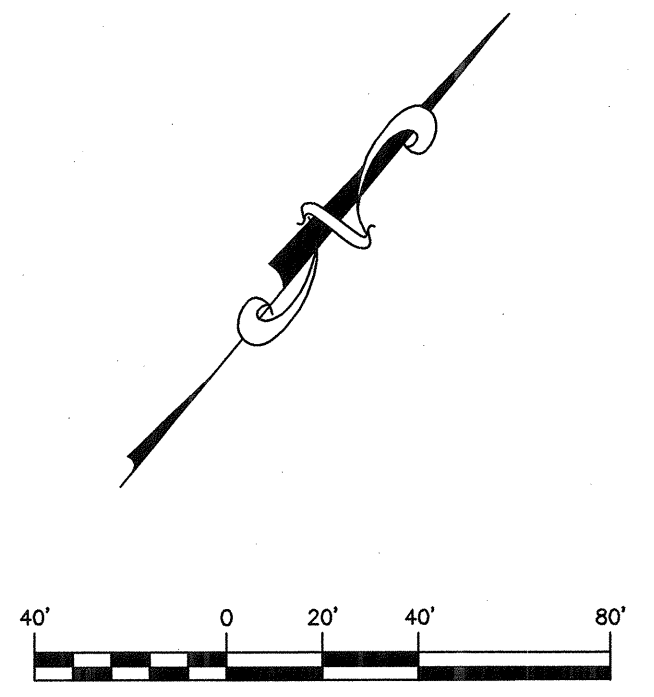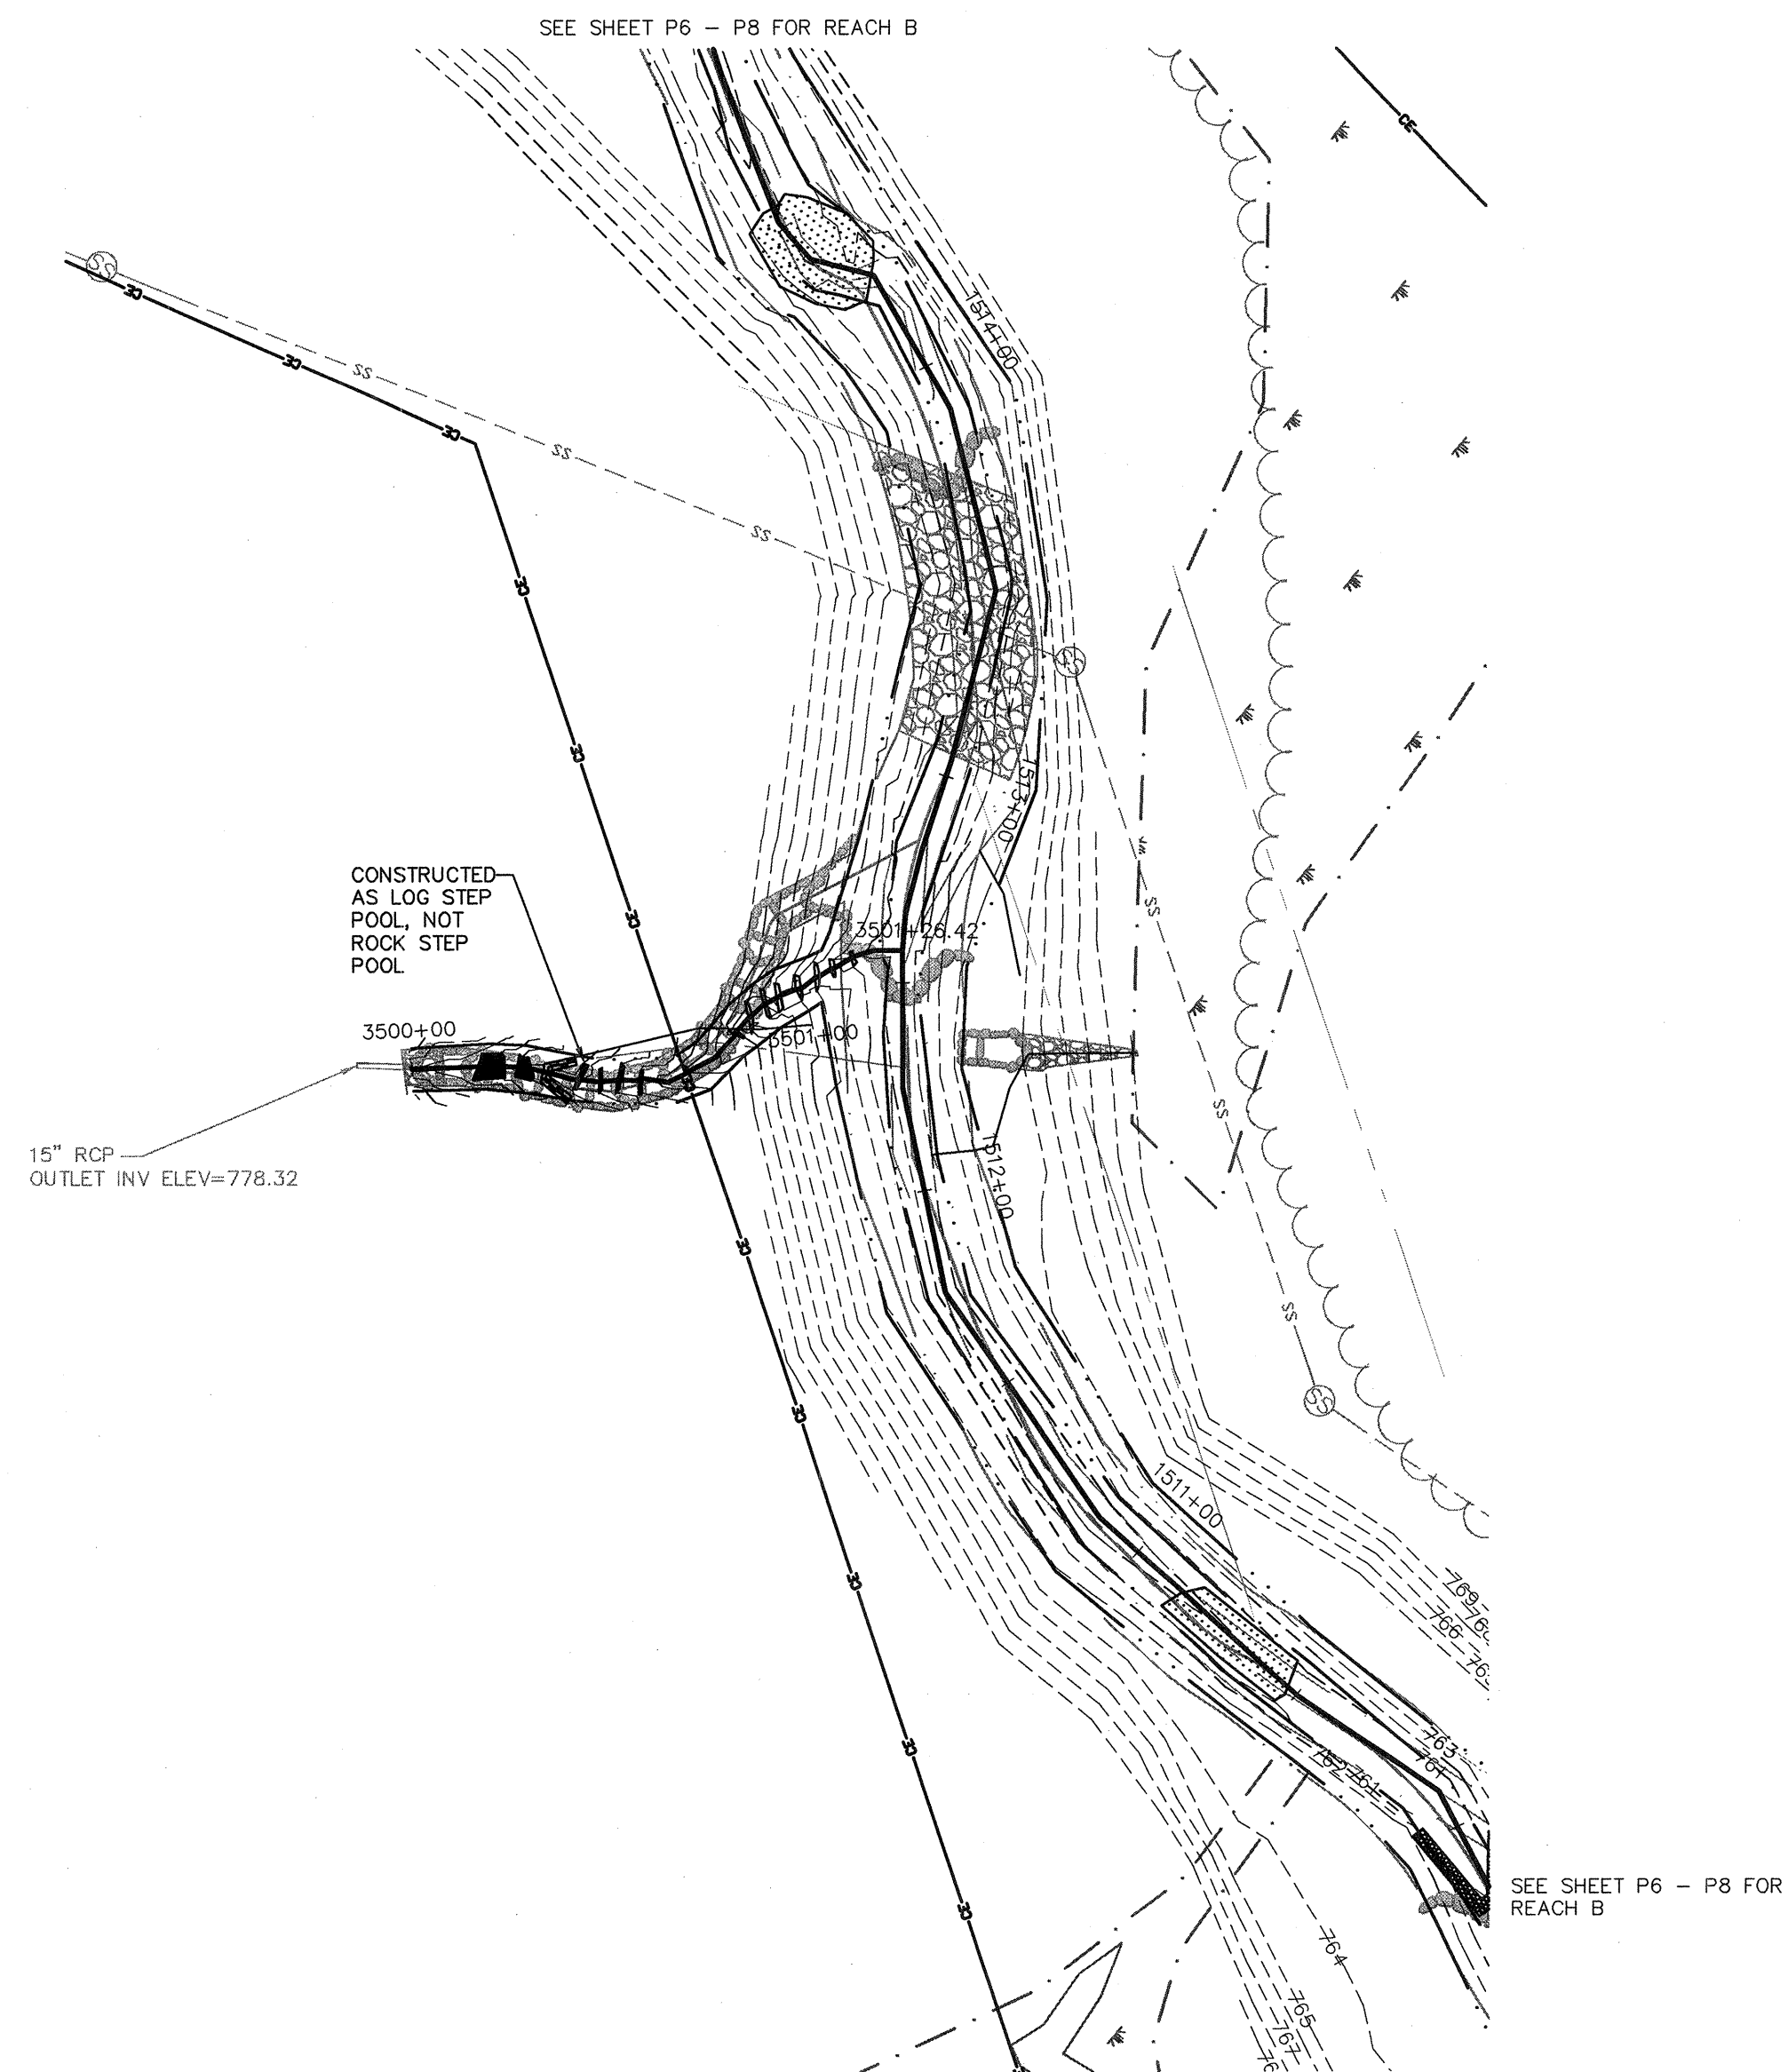

RECORD DOCUMENT

REV. No.	REVISION	DATE	DRAWN BY	CHECKED BY

This document, together with the concepts and designs presented herein, is intended only for the specific purpose and client for which it was prepared. Reuse of and improper reliance on this document without written authorization and adaptation by Kimley-Horn and Associates, Inc., shall be without liability to Kimley-Horn and Associates, Inc. Copyright Kimley-Horn and Associates, Inc., 2010.

PREPARED IN THE OFFICE OF:

Kimley-Horn and Associates, Inc.

NC LICENSE #F-0102
 P.O. BOX 33068 - RALEIGH, NORTH CAROLINA 27636-3068
 PHONE: (919) 677-2000 FAX: (919) 677-2050


CLIENT: **NC-EEP**

TITLE: **PLAN - REACH J**

DATE: 01-28-10
 HORIZONTAL SCALE:
 VERTICAL SCALE:
 DRAWN BY: JJK
 DESIGNED BY: ARK/JCD
 CHECKED BY: WRW

PROJECT: **VALLEY FIELDS FARM**

ATTACHED REFERENCE FILES:
 JOB NUMBER: 011795020
 SHEET NUMBER: **P12**

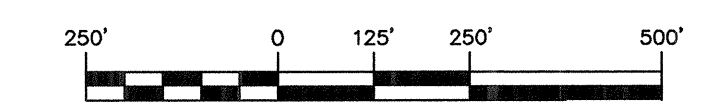

RECORD DOCUMENT

REV. No.	REVISION	DATE	DRAWN BY	CHECKED BY

PREPARED IN THE OFFICE OF:



**Kimley-Horn
and Associates, Inc.**

NC LICENSE #F-0102
P.O. BOX 33068 - RALEIGH, NORTH CAROLINA 27636-3068
PHONE: (919) 677-2000 FAX: (919) 677-2050

CLIENT: **NC-EEP**

TITLE: **OVERALL
MONITORING PLAN**

DATE: 01-28-10
HORIZONTAL SCALE:
VERTICAL SCALE:
DRAWN BY: JIK
DESIGNED BY: ARK/JCD
CHECKED BY: WRW

PROJECT: **VALLEY FIELDS FARM**

ATTACHED REFERENCE FILES:
JOB NUMBER: 011795020
SHEET NUMBER: **M1**

This document, together with the concepts and designs presented herein, as an instrument of service, is intended only for the specific purpose and client for which it was prepared. Reuse of and improper reliance on this document without written authorization and adaptation by Kimley-Horn and Associates, Inc., shall be without liability to Kimley-Horn and Associates, Inc.
Copyright Kimley-Horn and Associates, Inc., 2010



FINAL DESIGN NOTES

1. Redistribute crown materials throughout restoration area

2. Grade site to base elevation

Base elevation will be set at designer's direction and will be set at a target height above the adjacent stream's base flow water surface elevation. The target height will be set in the reference wetland and should equal the elevation difference between point A, base flow water surface elevation, and point B, a point on the ground that is 6" above the mean ground water elevation during the growing season as derived from monitoring wells in the reference wetland. The base elevation will be set from the target height above the newly constructed stream's base flow water surface elevation for transects (A# - B#) throughout the restoration area.

3. Create depressional and island pockets. Depressional pockets should be set 8-12" below base elevation and island pockets should be set 8-12" above base elevation.

4. Disk entire restoration area to loosen soils and create microtopography

RECORD DOCUMENT

REV. No.:	REVISION:	DATE:	DRAWN BY:	CHECKED BY:

This document, together with the concepts and designs presented herein, as an instrument of service, is intended only for the specific purpose and client for which it was prepared. Reuse of old improper reliance on this document without written authorization and adaptation by Kimley-Horn and Associates, Inc., shall be without liability to Kimley-Horn and Associates, Inc.
Copyright Kimley-Horn and Associates, Inc., 2010

PREPARED IN THE OFFICE OF:



Kimley-Horn and Associates, Inc.
 NC LICENSE #F-0102
 P.O. BOX 33068 - RALEIGH, NORTH CAROLINA 27636-3068
 PHONE: (919) 677-2000 FAX: (919) 677-2050

CLIENT: **NC-EEP**

TITLE: **WETLAND GRADING PLAN**




DATE: 01-28-10
 HORIZONTAL SCALE: N.T.S.
 VERTICAL SCALE: N/A
 DRAWN BY: JJK
 DESIGNED BY: ARK/JCD
 CHECKED BY: WRW

PROJECT: **VALLEY FIELDS FARM**

ATTACHED REFERENCE FILES:

JOB NUMBER: 011795020
 SHEET NUMBER: **P13**

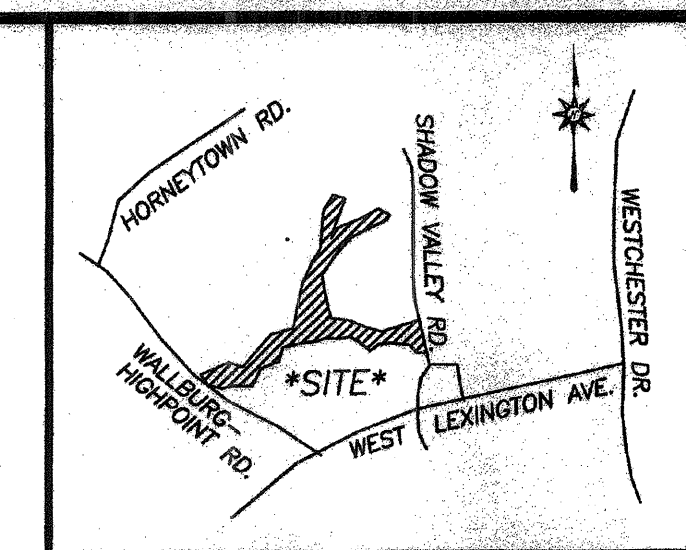


LEGEND:



THESE STANDARD SYMBOLS WILL BE FOUND IN THE DRAWING.

- UNMARKED POINT
- EXISTING IRON REBAR (EIR)
- 5/8" NEW IRON REBAR (NIR)
- EXISTING IRON PIPE (EIP)
- R.R. SPIKE FOUND
- R.R. SPIKE SET
- PK NAIL FOUND
- PK NAIL SET
- CONCRETE MONUMENT FOUND
- CONCRETE MONUMENT SET
- FIRE HYDRANT
- WATER VALVE
- WATER METER
- WELL
- GAS VALVE
- GAS METER
- TELEPHONE PEDESTAL
- TELEPHONE MANHOLE
- ELECTRICAL MANHOLE
- ELECTRICAL BOX
- TRANSFORMER
- POWER / UTILITY POLE
- LIGHT POLE
- SEWER MANHOLE
- SEWER CLEAN-OUT
- CURB INLET
- YARD INLET
- IRRIGATION CONTROL VALVE
- SIGN
- △ CONTROL POINT
- ROCKS
- ▲ ROCK CROSS VANE

- W — WATER
- SS — SANITARY SEWER
- E — UNDERGROUND POWER
- G — NATURAL GAS
- - - X - - - BARB WIRE FENCE
- - - RIGHT OF WAY LINE
- - - CENTERLINE

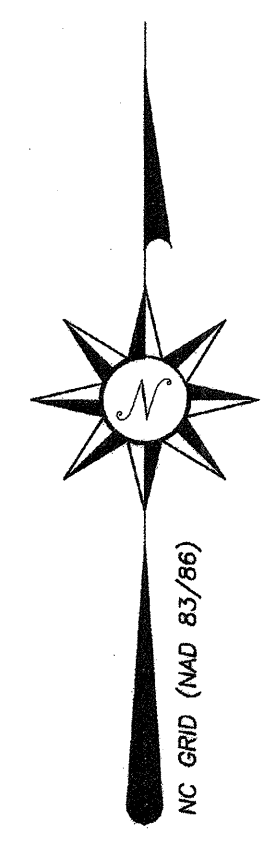

- NOTES**
- 1.) ALL PROPERTIES SHOWN HEREON ARE SUBJECT TO ANY EASEMENT (WRITTEN OR UNWRITTEN).
 - 2.) ALL FEATURES ARE MARKED AS SHOWN IN THE LEGEND UNLESS OTHERWISE NOTED.
 - 3.) DEED REFERENCES: CONSERVATION EASEMENT AND EASEMENT OF INGRESS AND EGRESS DEED BOOK 1488 PG. 985-993.
 - 4.) THIS MAP IS NOT INTENDED TO BE PREPARED FOR RECORDING IN ACCORDANCE WITH G.S. 47-30, AS AMENDED.
 - 5.) THE BENCH MARK FOR ALL ELEVATIONS SHOWN HEREON IS A NCDOT TRAVERSE DISK NUMBER "R2588WM GPS 1" HAVING NC GRID NAD 83/86" COORDINATES AS FOLLOWS: N:812497.152 US FT, E:1686318.780 US FT, ELEV: 775.03 US FT (NGVD 29) AS SHOWN ON A SURVEY DONE BY M.L. MOTSINGER, DATED 12/04/2003 ENTITLED: SURVEY OF VALLEYFIELDS FARM, INC. CONSERVATION EASEMENTS ACQUIRED BY NORTH CAROLINA DEPARTMENT OF TRANSPORTATION FOR NORTH CAROLINA WILDLIFE RESOURCE COMMISSION.
 - 6.) ALL DISTANCES SHOWN HEREON ARE HORIZONTAL GROUND DISTANCES UNLESS OTHERWISE NOTED.
 - 7.) THE COMBINED SCALE FACTOR FOR THE ENTIRE PROJECT IS 0.999920223 (GROUND TO GRID).
 - 8.) ALL UTILITIES SHOWN WERE LOCATED BY PHYSICAL ABOVE GROUND EVIDENCE AND THEREFORE ALL SUBSURFACE UTILITIES MY NOT BE SHOWN ON THIS SURVEY.
 - 9.) ALL CONTOURS ARE AT A 1 FOOT CONTOUR INTERVAL.
 - 10.) ALL EASEMENT AND BOUNDARY INFORMATION BASED ON A DIGITAL FILE OBTAINED FROM KIMLEY-HORN & ASSOCIATES AND IS SUBJECT TO ACCURACY THEREOF.
 - 11.) PROPERTY IS ZONED "RS".

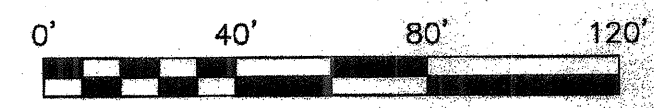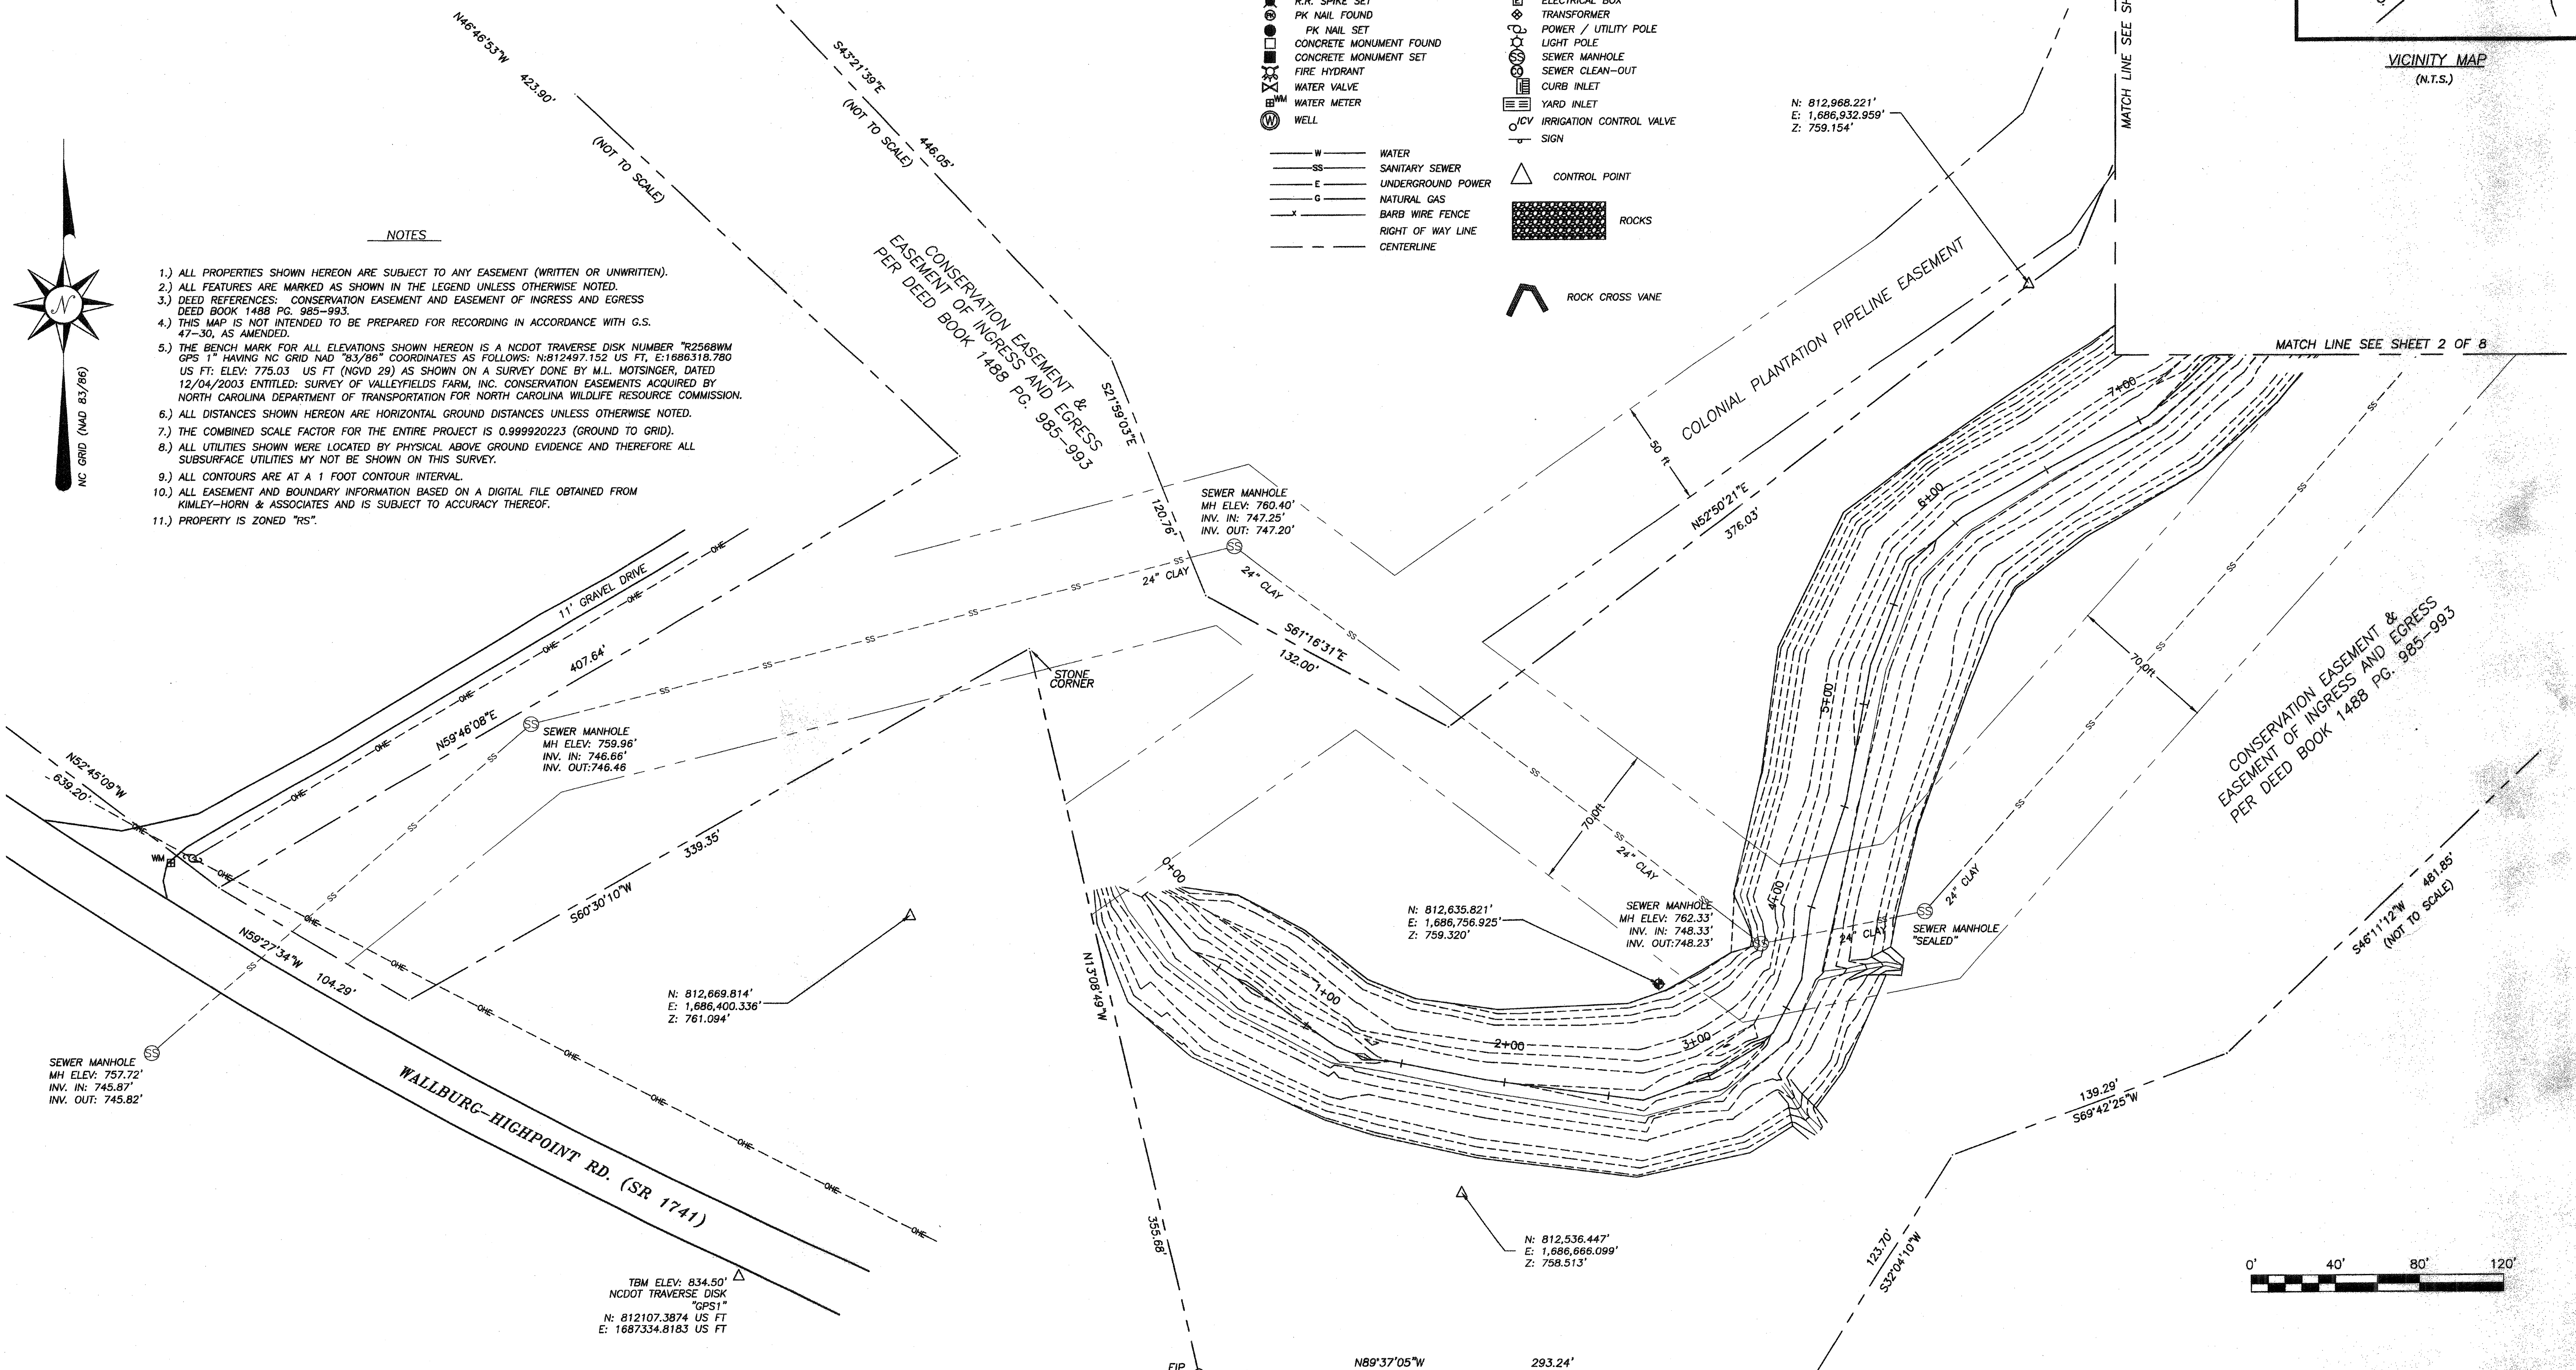


NCBELS LICENSE NO. C-1273
CAVANAUGH
 Solutions through integrity and partnership
 Cavanaugh & Associates, P.A. 530 North Trade Street, Suite 302, Winston-Salem, NC 27101
 336/759-9001 fax: 336/759-1005 www.cavanaughassociates.com

STATE OF NORTH CAROLINA
 COUNTY OF DAVIDSON

I, DAVID KEITH ALLEY, CERTIFY THAT THIS PROJECT WAS COMPLETED UNDER MY DIRECT AND RESPONSIBLE CHARGE FROM AN ACTUAL GROUND SURVEY MADE UNDER MY SUPERVISION; THAT THIS TOPOGRAPHIC SURVEY WAS PERFORMED TO MEET FEDERAL GEOGRAPHIC DATA COMMITTEE STANDARDS AS APPLICABLE; THAT THE ORIGINAL DATA WAS OBTAINED IN JULY, 2008; THAT THE SURVEY WAS COMPLETED ON AUGUST, 2008; AND ALL COORDINATES ARE BASED ON NC GRID 83/86.

DKA 2-9-10
 DAVID KEITH ALLEY, P.L.S. L-4492


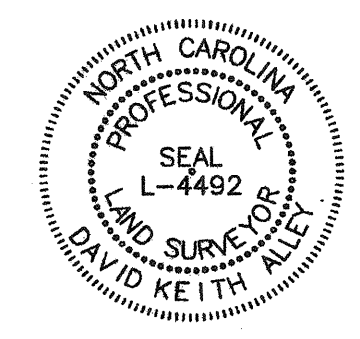


PROPERTY OWNED UNDER:
 VALLEYFIELD FARM INC.
 STANLEY DAVIS PHILLIPS


DATE:		SHEET NO.		REV.		DESCRIPTION		DATE	
SEPTEMBER 17, 2009		1		REV1					
PROJECT NO.: 12.05.007		OF:		REV2					
FIELD WORK: CA/BC/DD/RC/NJ		8		REV3					
CHECKED: DKA				REV4					
SCALE: 1"=40'									

TOPOGRAPHIC SURVEY OF:
VALLEYFIELDS FARM, INC.
STREAM RESTORATION

SURVEY REQUESTED BY: KIMLEY-HORN & ASSOCIATES
 ABBOTTS CREEK TOWNSHIP, DAVIDSON COUNTY, NC

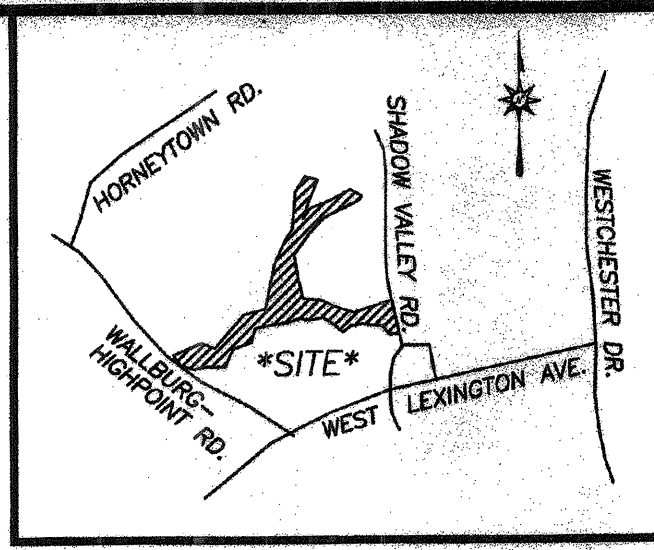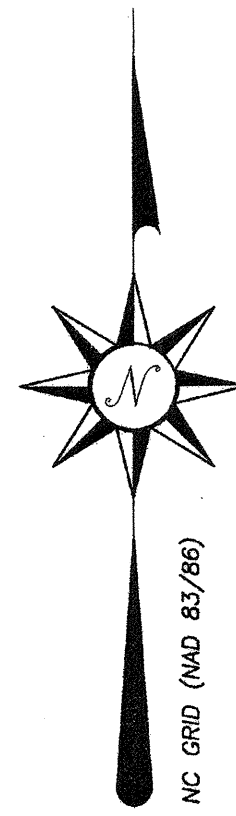

VICINITY MAP
(N.T.S.)

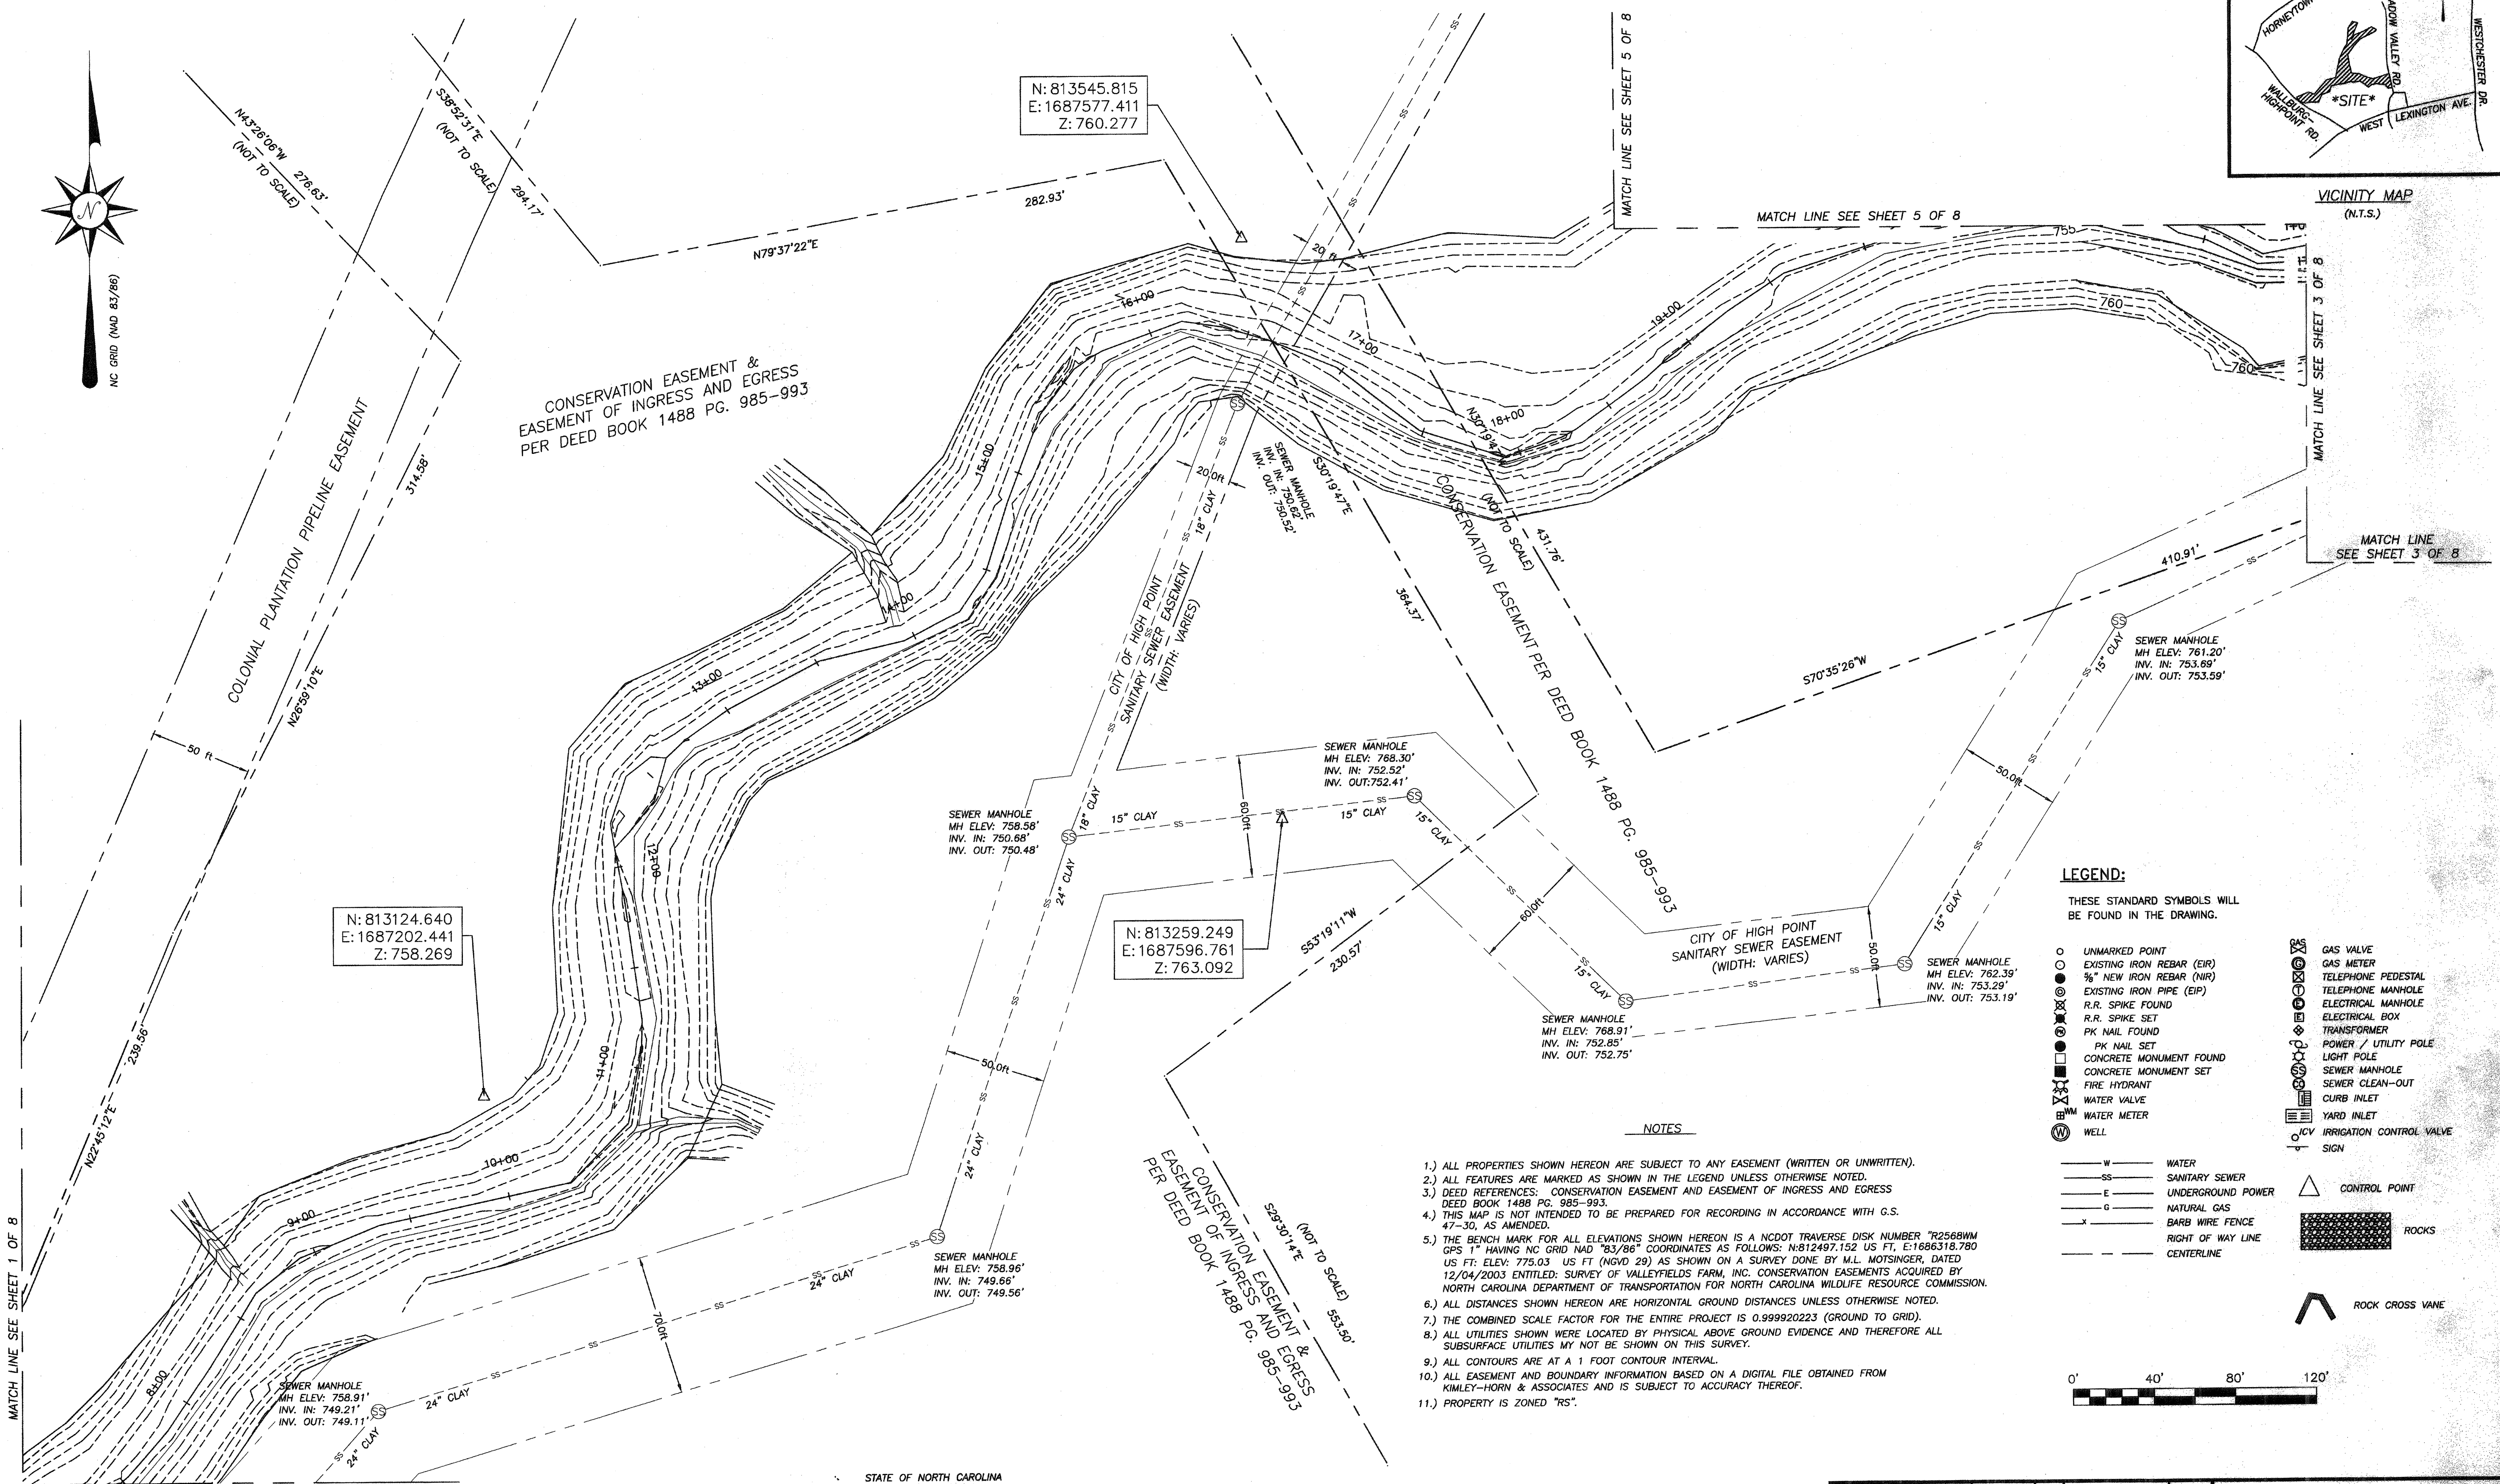

N: 813124.640
E: 1687202.441
Z: 758.269

N: 813545.815
E: 1687577.411
Z: 760.277


N: 813259.249
E: 1687596.761
Z: 763.092

LEGEND:

- THESE STANDARD SYMBOLS WILL BE FOUND IN THE DRAWING.
- UNMARKED POINT
 - EXISTING IRON REBAR (EIR)
 - 5/8" NEW IRON REBAR (NIR)
 - EXISTING IRON PIPE (EIP)
 - R.R. SPIKE FOUND
 - R.R. SPIKE SET
 - PK NAIL FOUND
 - PK NAIL SET
 - CONCRETE MONUMENT FOUND
 - CONCRETE MONUMENT SET
 - FIRE HYDRANT
 - WATER VALVE
 - WATER METER
 - WELL
 - GAS VALVE
 - GAS METER
 - TELEPHONE PEDESTAL
 - TELEPHONE MANHOLE
 - ELECTRICAL MANHOLE
 - ELECTRICAL BOX
 - TRANSFORMER
 - POWER / UTILITY POLE
 - LIGHT POLE
 - SEWER MANHOLE
 - SEWER CLEAN-OUT
 - CURB INLET
 - YARD INLET
 - IRRIGATION CONTROL VALVE
 - SIGN
 - △ CONTROL POINT
 - ROCKS
 - ∧ ROCK CROSS VANE

NOTES

- 1.) ALL PROPERTIES SHOWN HEREON ARE SUBJECT TO ANY EASEMENT (WRITTEN OR UNWRITTEN).
- 2.) ALL FEATURES ARE MARKED AS SHOWN IN THE LEGEND UNLESS OTHERWISE NOTED.
- 3.) DEED REFERENCES: CONSERVATION EASEMENT AND EASEMENT OF INGRESS AND EGRESS DEED BOOK 1488 PG. 985-993.
- 4.) THIS MAP IS NOT INTENDED TO BE PREPARED FOR RECORDING IN ACCORDANCE WITH G.S. 47-30, AS AMENDED.
- 5.) THE BENCH MARK FOR ALL ELEVATIONS SHOWN HEREON IS A NCDOT TRAVERSE DISK NUMBER 'R2568WM GPS 1' HAVING NC GRID NAD '83/86' COORDINATES AS FOLLOWS: N:812497.152 US FT, E:1686318.780 US FT, ELEV: 775.03 US FT (NGVD 29) AS SHOWN ON A SURVEY DONE BY M.L. MOTSINGER, DATED 12/04/2003 ENTITLED: SURVEY OF VALLEYFIELDS FARM, INC. CONSERVATION EASEMENTS ACQUIRED BY NORTH CAROLINA DEPARTMENT OF TRANSPORTATION FOR NORTH CAROLINA WILDLIFE RESOURCE COMMISSION.
- 6.) ALL DISTANCES SHOWN HEREON ARE HORIZONTAL GROUND DISTANCES UNLESS OTHERWISE NOTED.
- 7.) THE COMBINED SCALE FACTOR FOR THE ENTIRE PROJECT IS 0.999920223 (GROUND TO GRID).
- 8.) ALL UTILITIES SHOWN WERE LOCATED BY PHYSICAL ABOVE GROUND EVIDENCE AND THEREFORE ALL SUBSURFACE UTILITIES MAY NOT BE SHOWN ON THIS SURVEY.
- 9.) ALL CONTOURS ARE AT A 1 FOOT CONTOUR INTERVAL.
- 10.) ALL EASEMENT AND BOUNDARY INFORMATION BASED ON A DIGITAL FILE OBTAINED FROM KIMLEY-HORN & ASSOCIATES AND IS SUBJECT TO ACCURACY THEREOF.
- 11.) PROPERTY IS ZONED "RS".

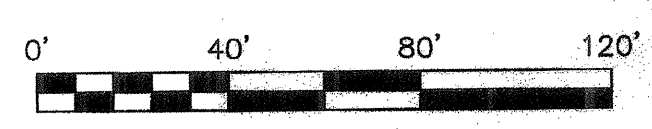

STATE OF NORTH CAROLINA
COUNTY OF DAVIDSON

I, DAVID KEITH ALLEY, CERTIFY THAT THIS PROJECT WAS COMPLETED UNDER MY DIRECT AND RESPONSIBLE CHARGE FROM AN ACTUAL GROUND SURVEY MADE UNDER MY SUPERVISION; THAT THIS TOPOGRAPHIC SURVEY WAS PERFORMED TO MEET FEDERAL GEOGRAPHIC DATA COMMITTEE STANDARDS AS APPLICABLE; THAT THE ORIGINAL DATA WAS OBTAINED IN JULY, 2008; THAT THE SURVEY WAS COMPLETED ON AUGUST, 2008; AND ALL COORDINATES ARE BASED ON NC GRID 83/86.

DAVID KEITH ALLEY, P.L.S. 2-9-10 L-4492



PROPERTY OWNED UNDER:
VALLEYFIELD FARM INC.
STANLEY DAVIS PHILLIPS

DATE: SEPTEMBER 17, 2008	SHEET NO. 2	REV.	DESCRIPTION	DATE
PROJECT NO.: 12.05.007	OF: 8	REV1		
FIELD WORK: CA/BC/DD/RC/NJ		REV2		
CHECKED: DKA		REV3		
SCALE: 1"=40'		REV4		

TOPOGRAPHIC SURVEY OF:
VALLEYFIELDS FARM, INC.
STREAM RESTORATION

SURVEY REQUESTED BY: KIMLEY-HORN & ASSOCIATES
ABBOTTS CREEK TOWNSHIP, DAVIDSON COUNTY, NC

NCBELS LICENSE NO. C-1273
CAVANAUGH
Solutions through integrity and partnership

Cavanaugh & Associates, P.A. 530 North Trade Street, Suite 302, Winston-Salem, NC 27101
336/759-9001 fax: 336/759-1005 www.cavanaugh-solutions.com


LEGEND:

THESE STANDARD SYMBOLS WILL BE FOUND IN THE DRAWING.



- | | |
|-----------------------------|----------------------------|
| ○ UNMARKED POINT | ⊗ GAS VALVE |
| ● EXISTING IRON REBAR (EIR) | ⊗ GAS METER |
| ⊙ 3/4" NEW IRON REBAR (NIR) | ⊗ TELEPHONE PEDESTAL |
| ⊗ EXISTING IRON PIPE (EIP) | ⊗ TELEPHONE MANHOLE |
| ⊗ R.R. SPIKE FOUND | ⊗ ELECTRICAL MANHOLE |
| ⊗ R.R. SPIKE SET | ⊗ ELECTRICAL BOX |
| ⊗ PK NAIL FOUND | ⊗ TRANSFORMER |
| ⊗ PK NAIL SET | ⊗ POWER / UTILITY POLE |
| ⊗ CONCRETE MONUMENT FOUND | ⊗ LIGHT POLE |
| ⊗ CONCRETE MONUMENT SET | ⊗ SEWER MANHOLE |
| ⊗ FIRE HYDRANT | ⊗ SEWER CLEAN-OUT |
| ⊗ WATER VALVE | ⊗ CURB INLET |
| ⊗ WATER METER | ⊗ YARD INLET |
| ⊗ WELL | ⊗ IRRIGATION CONTROL VALVE |
| — W — WATER | △ CONTROL POINT |
| — SS — SANITARY SEWER | ⊗ ROCKS |
| — E — UNDERGROUND POWER | ⊗ ROCK CROSS VANE |
| — G — NATURAL GAS | |
| — X — BARB WIRE FENCE | |
| — — — RIGHT OF WAY LINE | |
| — — — CENTERLINE | |

NOTES

- 1.) ALL PROPERTIES SHOWN HEREON ARE SUBJECT TO ANY EASEMENT (WRITTEN OR UNWRITTEN).
- 2.) ALL FEATURES ARE MARKED AS SHOWN IN THE LEGEND UNLESS OTHERWISE NOTED.
- 3.) DEED REFERENCES: CONSERVATION EASEMENT AND EASEMENT OF INGRESS AND EGRESS PER DEED BOOK 1488 PG. 985-993.
- 4.) THIS MAP IS NOT INTENDED TO BE PREPARED FOR RECORDING IN ACCORDANCE WITH G.S. 47-30, AS AMENDED.
- 5.) THE BENCH MARK FOR ALL ELEVATIONS SHOWN HEREON IS A NCDOT TRAVERSE DISK NUMBER 72568WM GPS 1" HAVING NC GRID MAD 83/86 COORDINATES AS FOLLOWS: N:812497.152 US FT, E:1686318.780 US FT; ELEV: 775.03 US FT (NGVD 29) AS SHOWN ON A SURVEY DONE BY M.L. MOTSINGER, DATED 12/04/2003 ENTITLED: SURVEY OF VALLEYFIELDS FARM, INC. CONSERVATION EASEMENTS ACQUIRED BY NORTH CAROLINA DEPARTMENT OF TRANSPORTATION FOR NORTH CAROLINA WILDLIFE RESOURCE COMMISSION.
- 6.) ALL DISTANCES SHOWN HEREON ARE HORIZONTAL GROUND DISTANCES UNLESS OTHERWISE NOTED.
- 7.) THE COMBINED SCALE FACTOR FOR THE ENTIRE PROJECT IS 0.999920223 (GROUND TO GRID).
- 8.) ALL UTILITIES SHOWN WERE LOCATED BY PHYSICAL ABOVE GROUND EVIDENCE AND THEREFORE ALL SUBSURFACE UTILITIES MY NOT BE SHOWN ON THIS SURVEY.
- 9.) ALL CONTOURS ARE AT A 1 FOOT CONTOUR INTERVAL.
- 10.) ALL EASEMENT AND BOUNDARY INFORMATION BASED ON A DIGITAL FILE OBTAINED FROM KIMLEY-HORN & ASSOCIATES AND IS SUBJECT TO ACCURACY THEREOF.
- 11.) PROPERTY IS ZONED "RS".

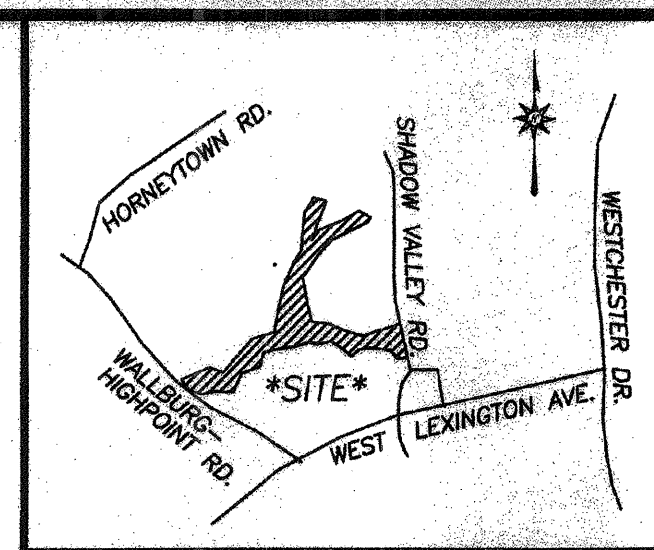


VICINITY MAP (N.T.S.)

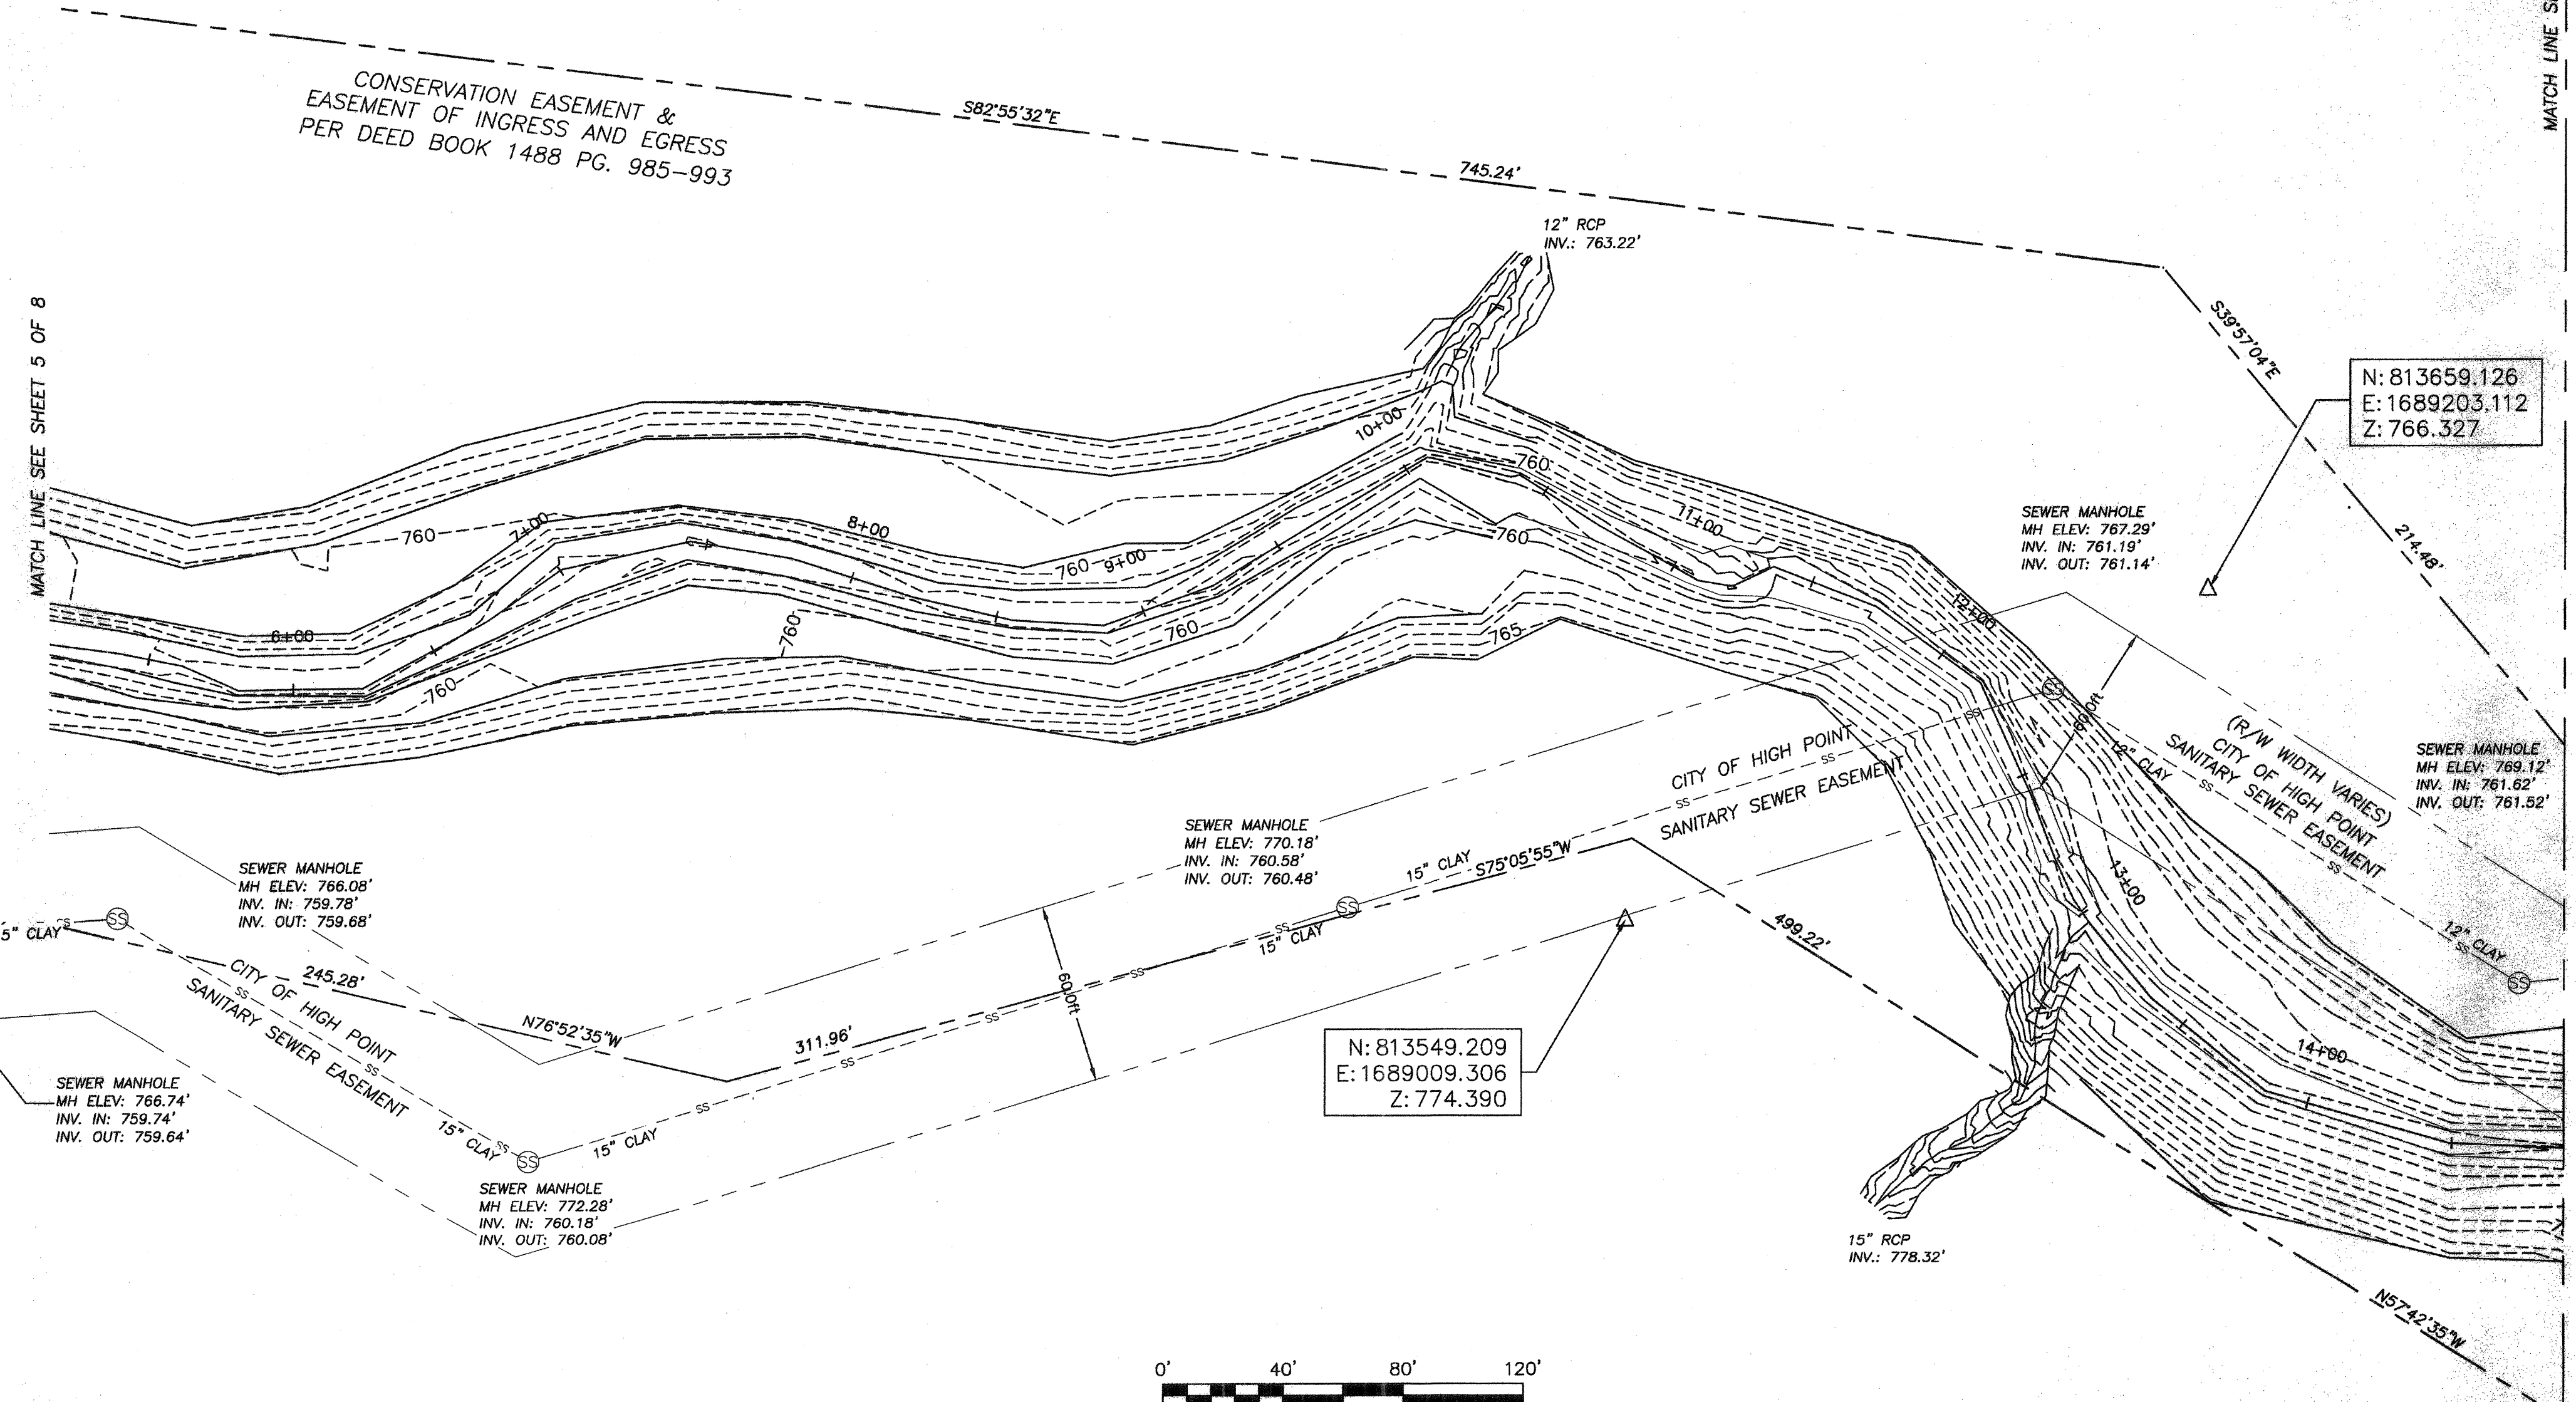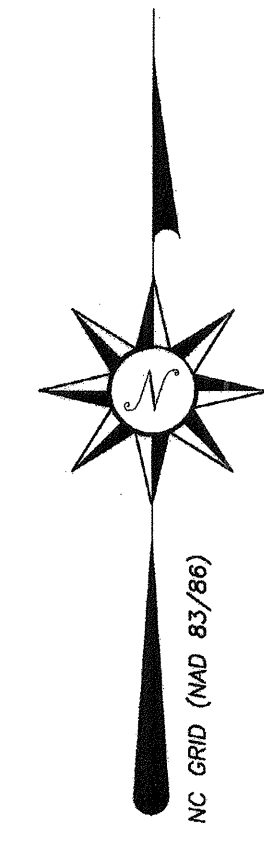

STATE OF NORTH CAROLINA
COUNTY OF DAVIDSON

I, DAVID KEITH ALLEY, CERTIFY THAT THIS PROJECT WAS COMPLETED UNDER MY DIRECT AND RESPONSIBLE CHARGE FROM AN ACTUAL GROUND SURVEY MADE UNDER MY SUPERVISION; THAT THIS TOPOGRAPHIC SURVEY WAS PERFORMED TO MEET FEDERAL GEOGRAPHIC DATA COMMITTEE STANDARDS AS APPLICABLE; THAT THE ORIGINAL DATA WAS OBTAINED IN JULY, 2008; THAT THE SURVEY WAS COMPLETED ON AUGUST, 2008; AND ALL COORDINATES ARE BASED ON NC GRID 83/86.

442 2-9-10
DAVID KEITH ALLEY, P.L.S. L-4492

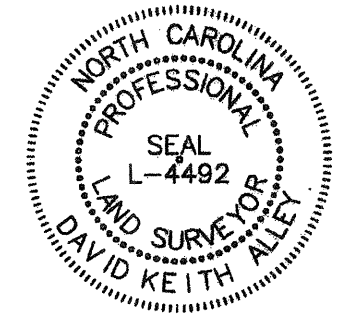

PROPERTY OWNED UNDER:
VALLEYFIELD FARM INC.
STANLEY DAVIS PHILLIPS

DATE: SEPTEMBER 17, 2009	SHEET NO. 3	REV.	DESCRIPTION	DATE
PROJECT NO.: 12.05.007		REV1		
FIELD WORK: CA/BC/DD/RC/NU	OF: 8	REV2		
CHECKED: DKA		REV3		
SCALE: 1"=40'		REV4		

TOPOGRAPHIC SURVEY OF:
**VALLEYFIELDS FARM, INC.
STREAM RESTORATION**

SURVEY REQUESTED BY: KIMLEY-HORN & ASSOCIATES
ABBOTTS CREEK TOWNSHIP, DAVIDSON COUNTY, NC

NCBELS LICENSE NO. C-1273
CAVANAUGH
Solutions through integrity and partnership

Cavanaugh & Associates, P.A. 530 North Trade Street, Suite 302, Winston-Salem, NC 27101
336/759-9001 fax: 336/759-1005 www.cavanaughassociates.com

MATCH LINE SEE SHEET 4 OF 8



LEGEND:

THESE STANDARD SYMBOLS WILL BE FOUND IN THE DRAWING.


- UNMARKED POINT
- EXISTING IRON REBAR (EIR)
- ⊙ ½" NEW IRON REBAR (NIR)
- ⊙ EXISTING IRON PIPE (EIP)
- ⊙ R.R. SPIKE FOUND
- ⊙ R.R. SPIKE SET
- ⊙ PK NAIL FOUND
- ⊙ PK NAIL SET
- ⊙ CONCRETE MONUMENT FOUND
- ⊙ CONCRETE MONUMENT SET
- ⊙ FIRE HYDRANT
- ⊙ WATER VALVE
- ⊙ WATER METER
- ⊙ WELL
- ⊙ GAS VALVE
- ⊙ GAS METER
- ⊙ TELEPHONE PEDESTAL
- ⊙ TELEPHONE MANHOLE
- ⊙ ELECTRICAL MANHOLE
- ⊙ ELECTRICAL BOX
- ⊙ TRANSFORMER
- ⊙ POWER / UTILITY POLE
- ⊙ LIGHT POLE
- ⊙ SEWER MANHOLE
- ⊙ SEWER CLEAN-OUT
- ⊙ CURB INLET
- ⊙ YARD INLET
- ⊙ I/CV IRRIGATION CONTROL VALVE
- ⊙ SIGN
- △ CONTROL POINT
- ⊙ ROCKS
- ⊙ ROCK CROSS VANE
- W — WATER
- SS — SANITARY SEWER
- E — UNDERGROUND POWER
- G — NATURAL GAS
- x- BARB WIRE FENCE
- - - RIGHT OF WAY LINE
- - - CENTERLINE

NOTES

- 1.) ALL PROPERTIES SHOWN HEREON ARE SUBJECT TO ANY EASEMENT (WRITTEN OR UNWRITTEN).
- 2.) ALL FEATURES ARE MARKED AS SHOWN IN THE LEGEND UNLESS OTHERWISE NOTED.
- 3.) DEED REFERENCES: CONSERVATION EASEMENT AND EASEMENT OF INGRESS AND EGRESS PER DEED BOOK 1488 PG. 985-993.
- 4.) THIS MAP IS NOT INTENDED TO BE PREPARED FOR RECORDING IN ACCORDANCE WITH G.S. 47-30, AS AMENDED.
- 5.) THE BENCH MARK FOR ALL ELEVATIONS SHOWN HEREON IS A NCDOT TRAVERSE DISK NUMBER "R2568WM GPS 1" HAVING NC GRID NAD "83/86" COORDINATES AS FOLLOWS: N:812497.152 US FT, E:1686318.780 US FT; ELEV: 775.03 US FT (NGVD 29) AS SHOWN ON A SURVEY DONE BY M.L. MOTSINGER, DATED 12/04/2003 ENTITLED: SURVEY OF VALLEYFIELDS FARM, INC. CONSERVATION EASEMENTS ACQUIRED BY NORTH CAROLINA DEPARTMENT OF TRANSPORTATION FOR NORTH CAROLINA WILDLIFE RESOURCE COMMISSION.
- 6.) ALL DISTANCES SHOWN HEREON ARE HORIZONTAL GROUND DISTANCES UNLESS OTHERWISE NOTED.
- 7.) THE COMBINED SCALE FACTOR FOR THE ENTIRE PROJECT IS 0.999820223 (GROUND TO GRID).
- 8.) ALL UTILITIES SHOWN WERE LOCATED BY PHYSICAL ABOVE GROUND EVIDENCE AND THEREFORE ALL SUBSURFACE UTILITIES MAY NOT BE SHOWN ON THIS SURVEY.
- 9.) ALL CONTOURS ARE AT A 1 FOOT CONTOUR INTERVAL.
- 10.) ALL EASEMENT AND BOUNDARY INFORMATION BASED ON A DIGITAL FILE OBTAINED FROM KIMLEY-HORN & ASSOCIATES AND IS SUBJECT TO ACCURACY THEREOF.
- 11.) PROPERTY IS ZONED "RS".

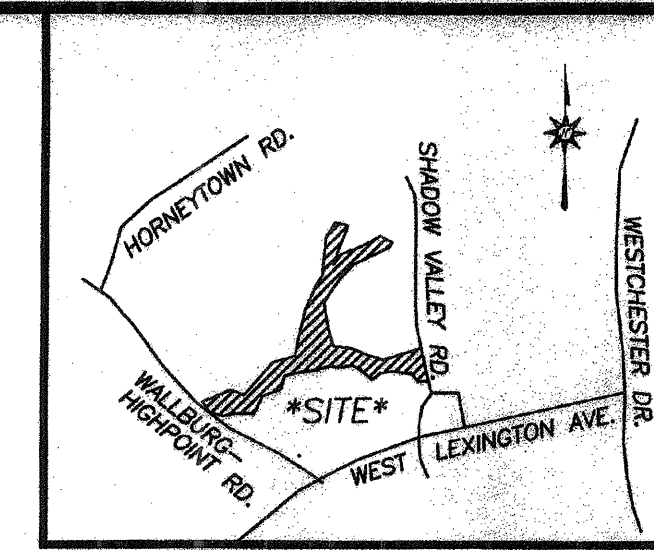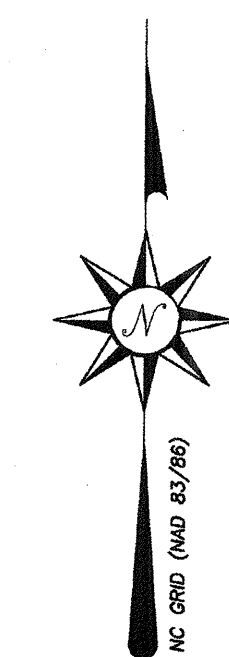


VICINITY MAP (N.T.S.)

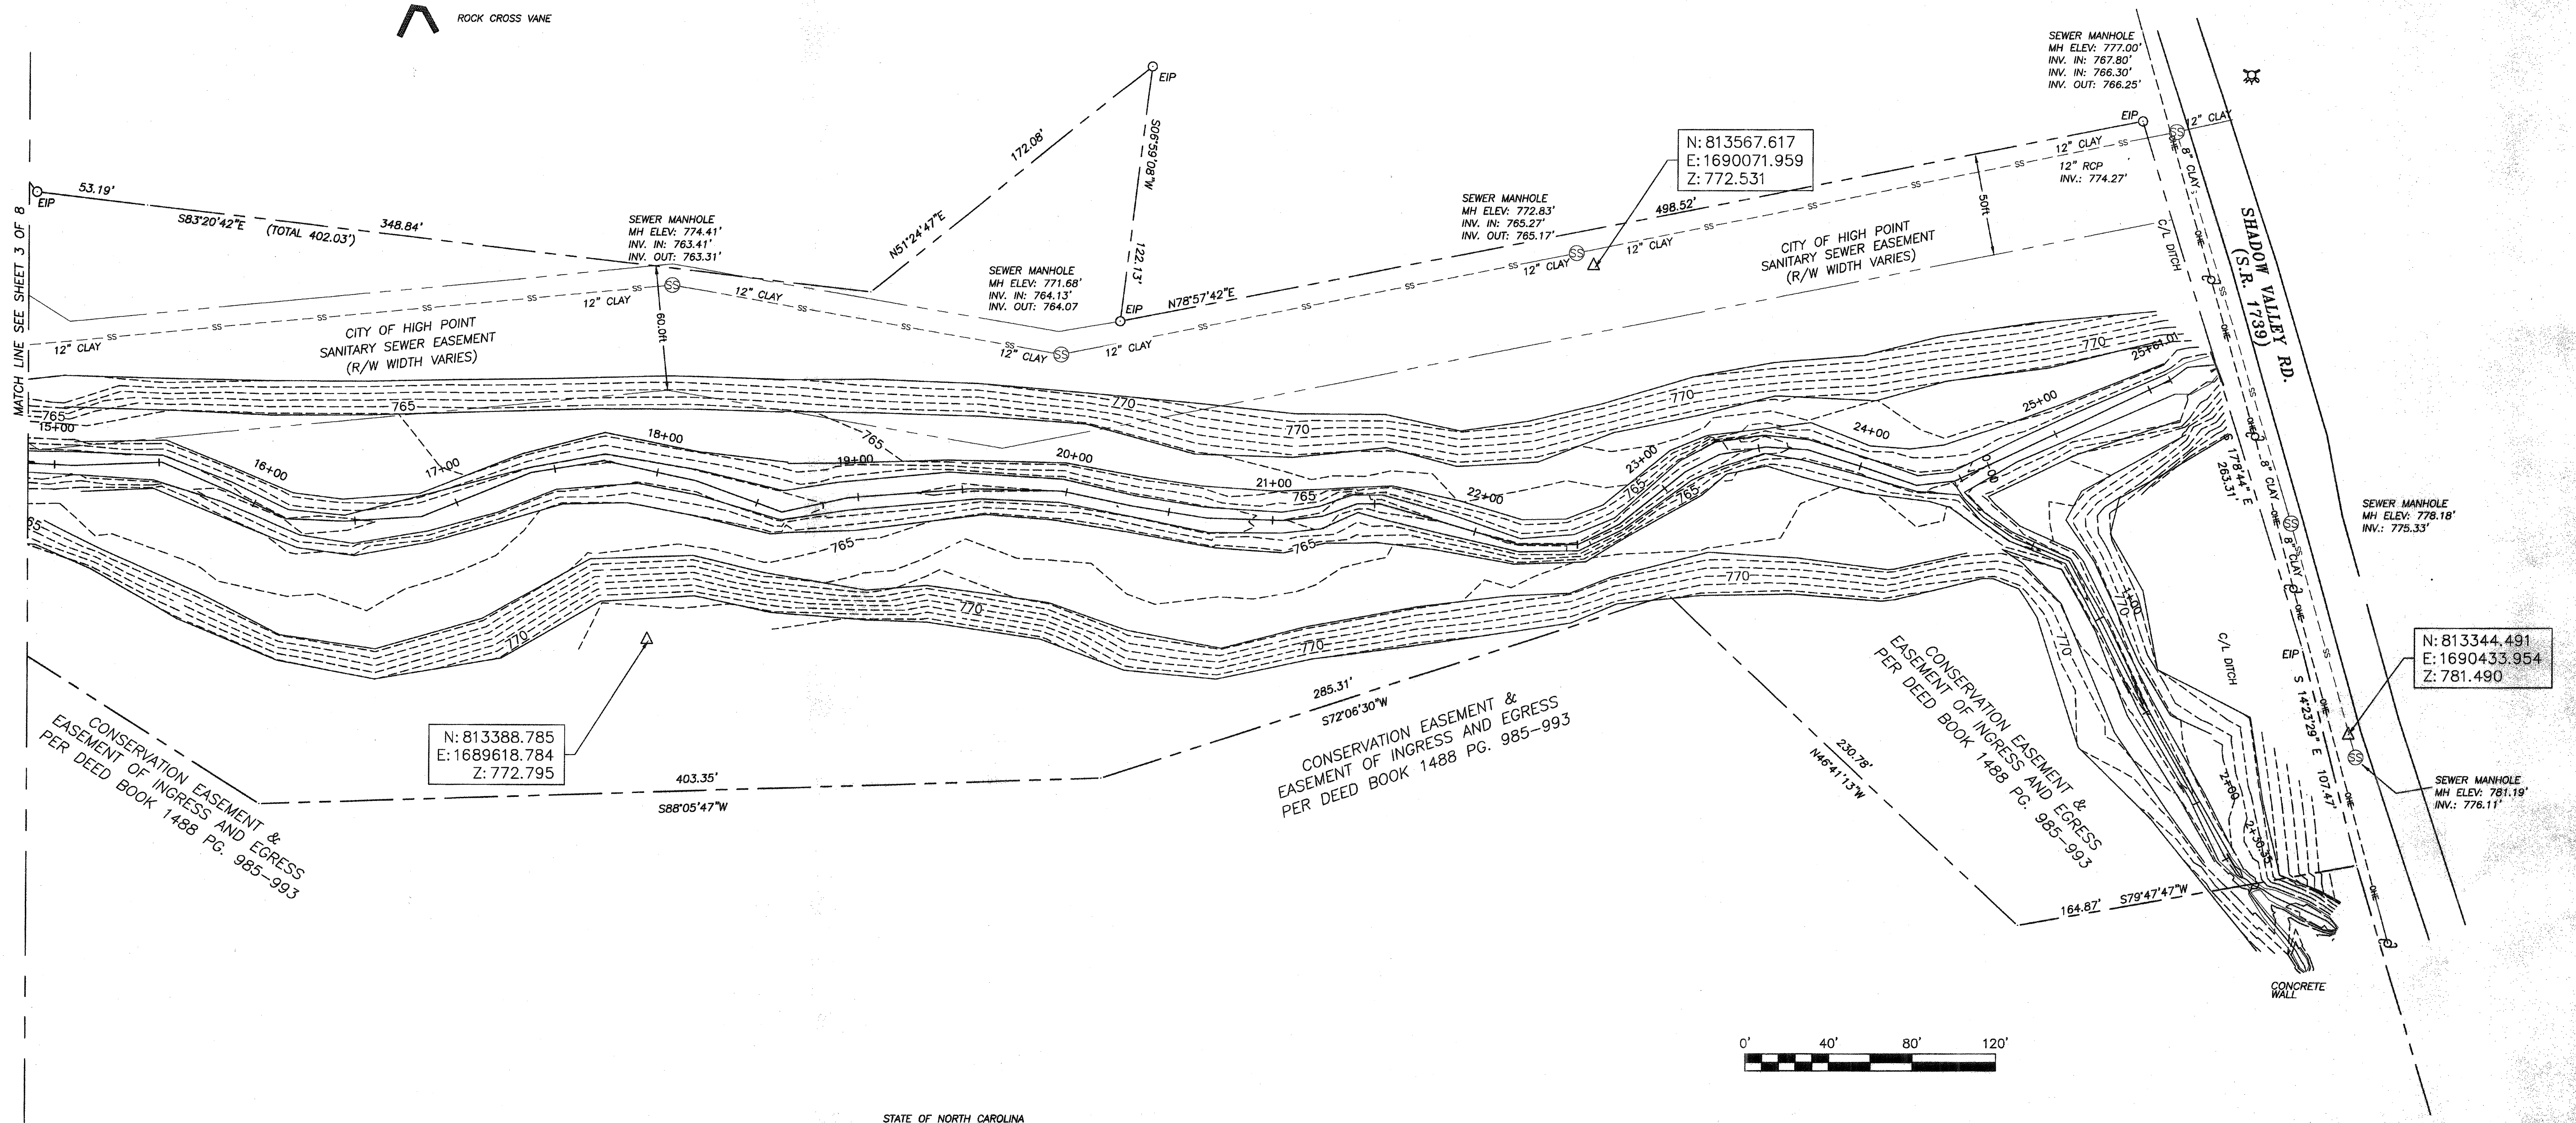

STATE OF NORTH CAROLINA
COUNTY OF DAVIDSON

I, DAVID KEITH ALLEY, CERTIFY THAT THIS PROJECT WAS COMPLETED UNDER MY DIRECT AND RESPONSIBLE CHARGE FROM AN ACTUAL GROUND SURVEY MADE UNDER MY SUPERVISION; THAT THIS TOPOGRAPHIC SURVEY WAS PERFORMED TO MEET FEDERAL GEOGRAPHIC DATA COMMITTEE STANDARDS AS APPLICABLE; THAT THE ORIGINAL DATA WAS OBTAINED IN JULY, 2008; THAT THE SURVEY WAS COMPLETED ON AUGUST, 2008; AND ALL COORDINATES ARE BASED ON NC GRID 83/86.

2-9-10
DAVID KEITH ALLEY, P.L.S. L-4492

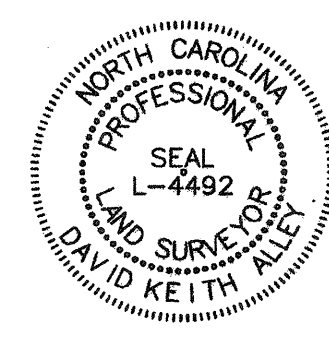

PROPERTY OWNED UNDER:
VALLEYFIELD FARM INC.
STANLEY DAVIS PHILLIPS


DATE: SEPTEMBER 17, 2009	SHEET NO. 4	REV.	DESCRIPTION	DATE
PROJECT NO.: 12.05.007		REV1		
FIELD WORK: CA/BC/DD/RC/NJ		REV2		
CHECKED: DKA	8	REV3		
SCALE: 1"=40'		REV4		

TOPOGRAPHIC SURVEY OF:
**VALLEYFIELDS FARM, INC.
STREAM RESTORATION**

SURVEY REQUESTED BY: KIMLEY-HORN & ASSOCIATES
ABBOTTS CREEK TOWNSHIP, DAVIDSON COUNTY, NC


NCBELS LICENSE NO. C-1273
CAVANAUGH
Solutions through integrity and partnership

Cavanaugh & Associates, P.A. 530 North Trade Street, Suite 302, Winston-Salem, NC 27101
336/759-9001 fax: 336/759-1005 www.cavanaugh-solutions.com

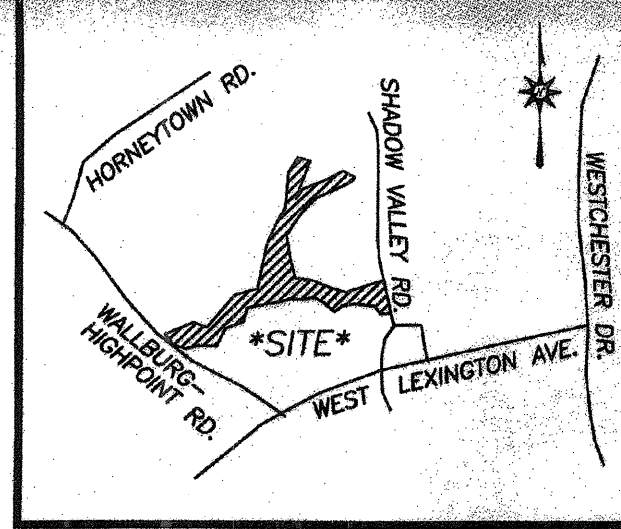

LEGEND:
THESE STANDARD SYMBOLS WILL BE FOUND IN THE DRAWING.

- UNMARKED POINT
- EXISTING IRON REBAR (EIR)
- /● ½" NEW IRON REBAR (NIR)
- /● EXISTING IRON PIPE (EIP)
- ⊗ R.R. SPIKE FOUND
- ⊗ PK NAIL SET
- ⊗ PK NAIL FOUND
- ⊗ CONCRETE MONUMENT FOUND
- ⊗ CONCRETE MONUMENT SET
- ⊗ FIRE HYDRANT
- ⊗ WATER VALVE
- ⊗ WATER METER
- ⊗ WELL
- W WATER
- SS SANITARY SEWER
- E UNDERGROUND POWER
- G NATURAL GAS
- X BARB WIRE FENCE
- RIGHT OF WAY LINE
- CENTERLINE
- ⊗ GAS VALVE
- ⊗ GAS METER
- ⊗ TELEPHONE PEDESTAL
- ⊗ TELEPHONE MANHOLE
- ⊗ ELECTRICAL MANHOLE
- ⊗ ELECTRICAL BOX
- ⊗ TRANSFORMER
- ⊗ POWER / UTILITY POLE
- ⊗ LIGHT POLE
- ⊗ SEWER MANHOLE
- ⊗ SEWER CLEAN-OUT
- ⊗ CURB INLET
- ⊗ YARD INLET
- ⊗ IRRIGATION CONTROL VALVE
- ⊗ SIGN
- △ CONTROL POINT
- ROCKS
- ▲ ROCK CROSS VANE

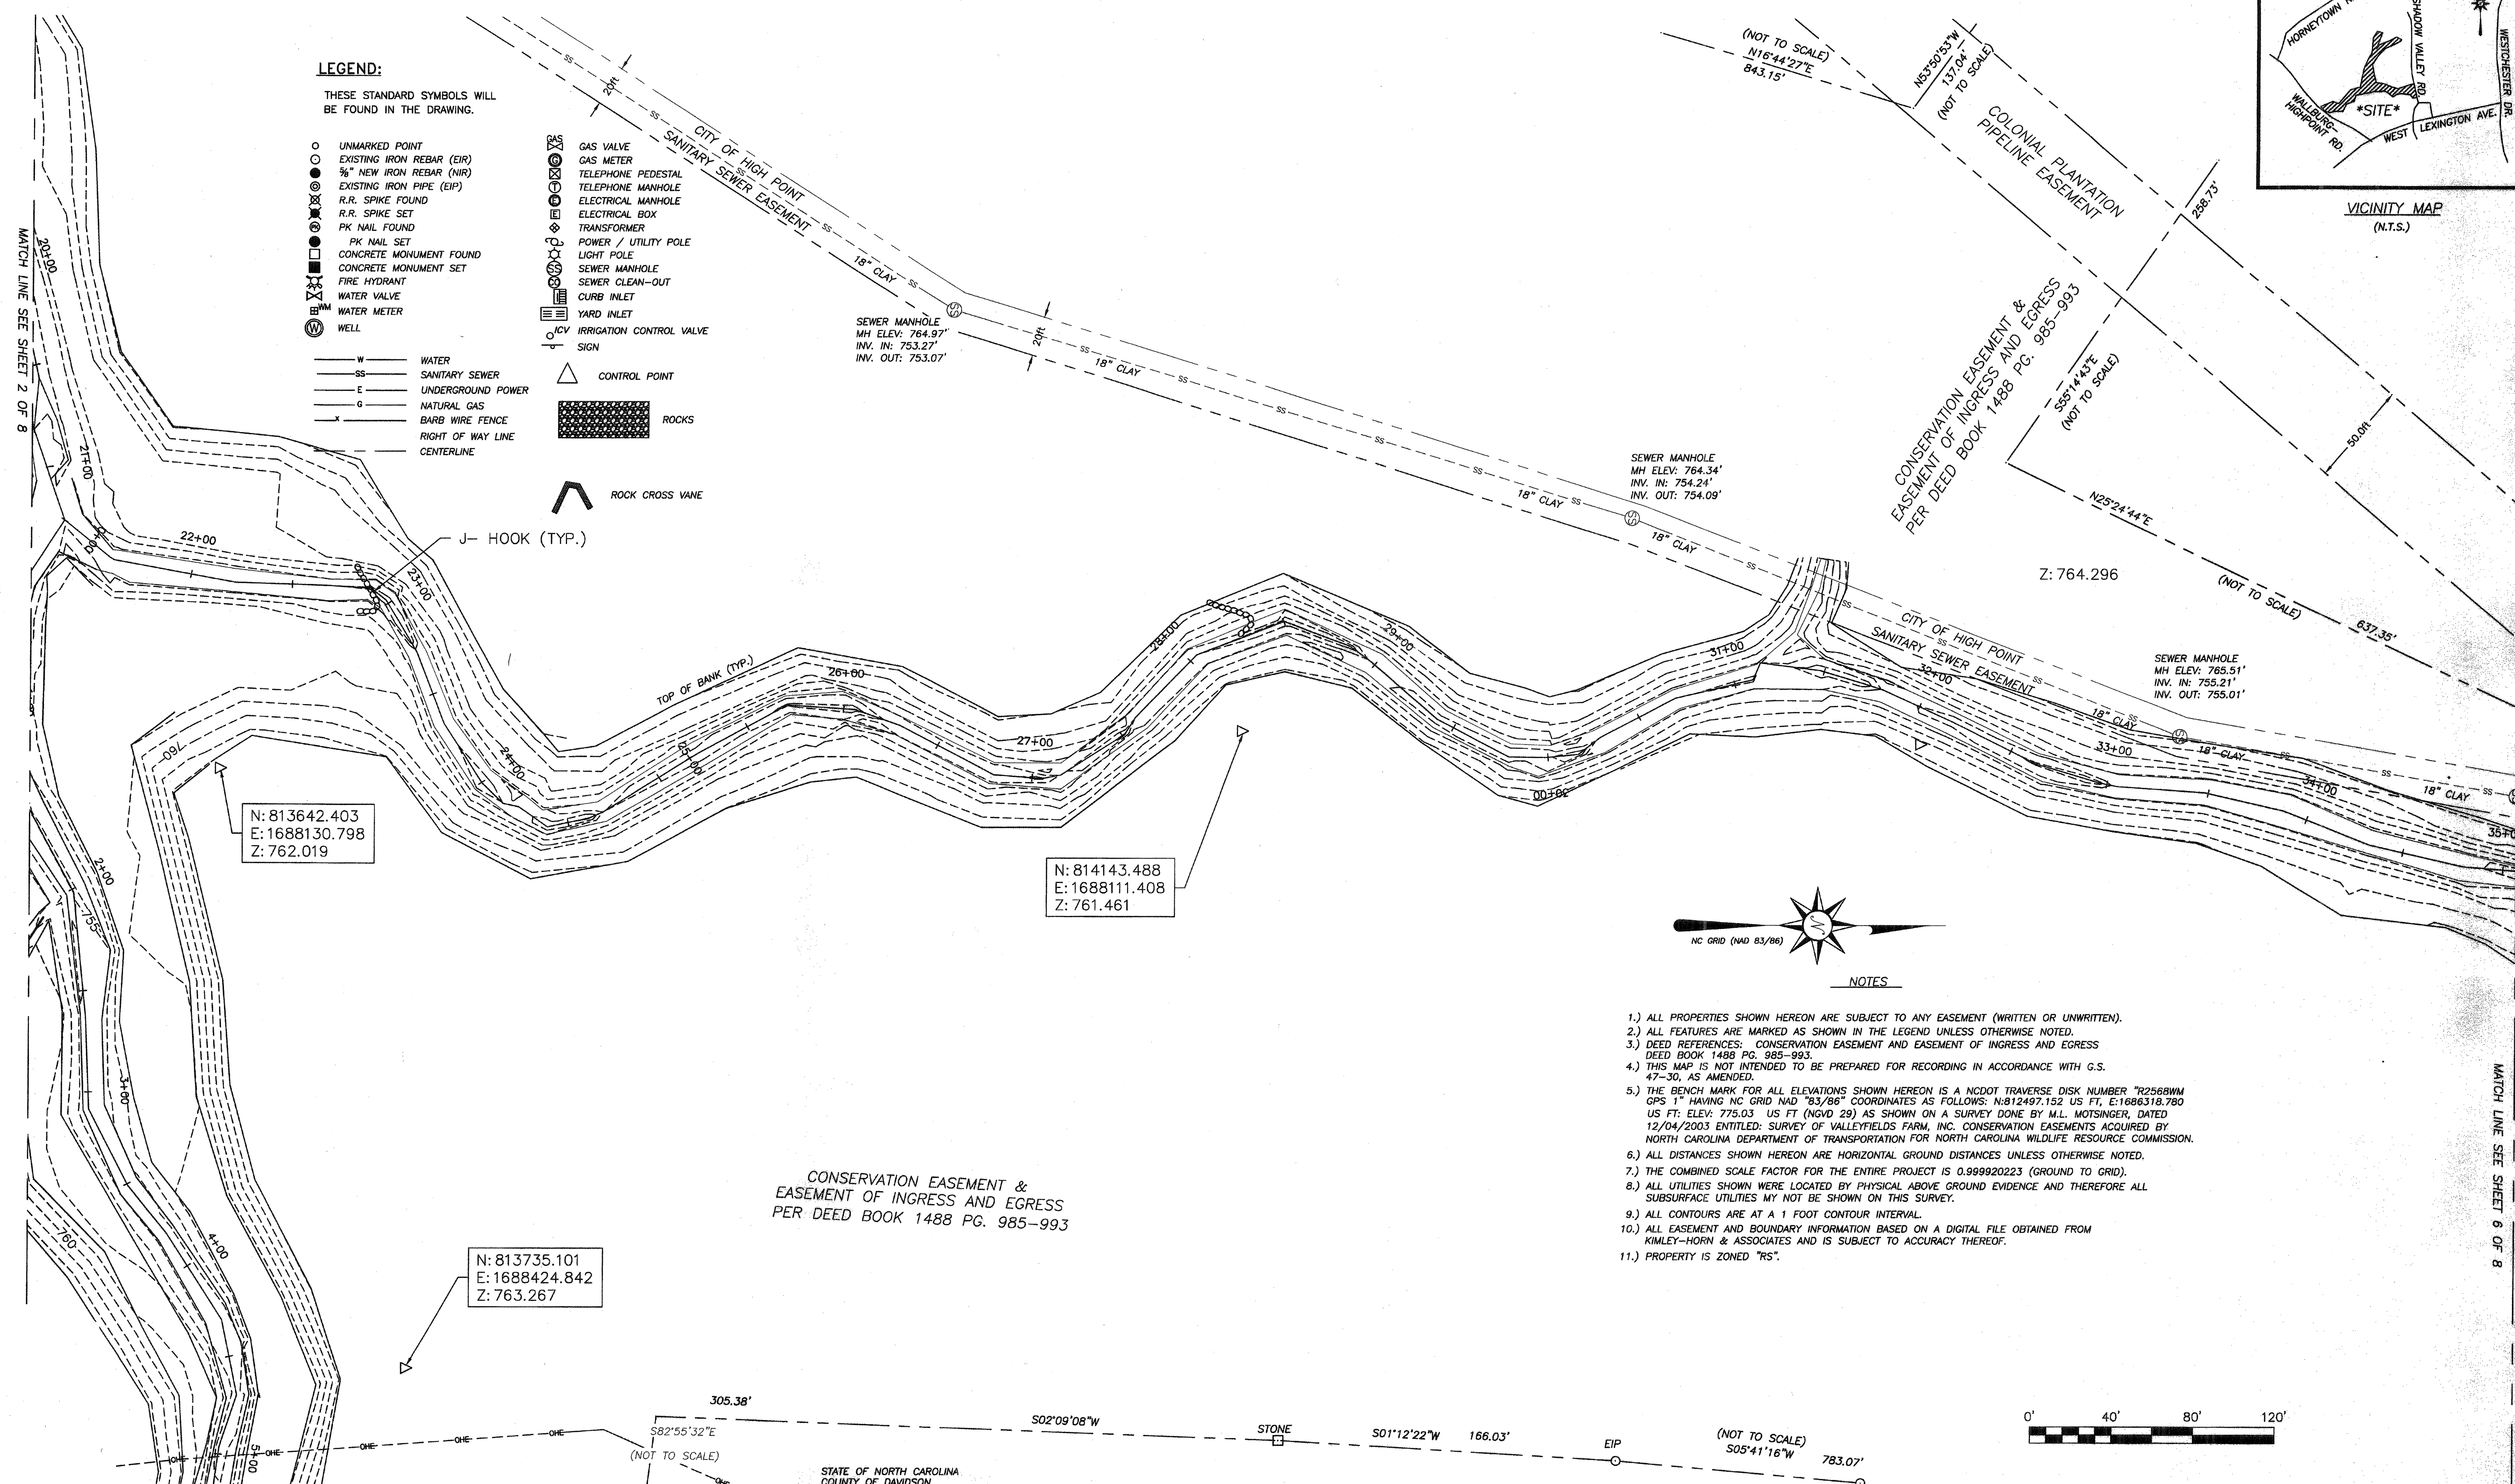


N: 813642.403
E: 1688130.798
Z: 762.019

N: 814143.488
E: 1688111.408
Z: 761.461


N: 813735.101
E: 1688424.842
Z: 763.267

CONSERVATION EASEMENT &
EASEMENT OF INGRESS AND EGRESS
PER DEED BOOK 1488 PG. 985-993

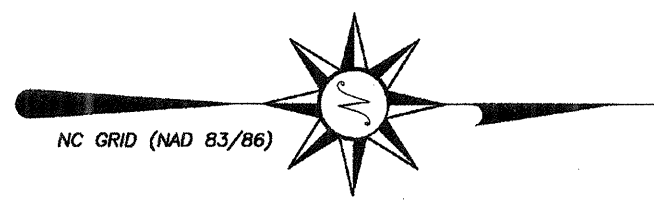

NOTES

- 1.) ALL PROPERTIES SHOWN HEREON ARE SUBJECT TO ANY EASEMENT (WRITTEN OR UNWRITTEN).
- 2.) ALL FEATURES ARE MARKED AS SHOWN IN THE LEGEND UNLESS OTHERWISE NOTED.
- 3.) DEED REFERENCES: CONSERVATION EASEMENT AND EASEMENT OF INGRESS AND EGRESS DEED BOOK 1488 PG. 985-993.
- 4.) THIS MAP IS NOT INTENDED TO BE PREPARED FOR RECORDING IN ACCORDANCE WITH G.S. 47-30, AS AMENDED.
- 5.) THE BENCH MARK FOR ALL ELEVATIONS SHOWN HEREON IS A NCDOT TRAVERSE DISK NUMBER "R2568WM GPS 1" HAVING NC GRID NAD "83/86" COORDINATES AS FOLLOWS: N:812497.152 US FT, E:1686318.780 US FT; ELEV: 775.03 US FT (NGVD 29) AS SHOWN ON A SURVEY DONE BY M.L. MOTSINGER, DATED 12/04/2003 ENTITLED: SURVEY OF VALLEYFIELDS FARM, INC. CONSERVATION EASEMENTS ACQUIRED BY NORTH CAROLINA DEPARTMENT OF TRANSPORTATION FOR NORTH CAROLINA WILDLIFE RESOURCE COMMISSION.
- 6.) ALL DISTANCES SHOWN HEREON ARE HORIZONTAL GROUND DISTANCES UNLESS OTHERWISE NOTED.
- 7.) THE COMBINED SCALE FACTOR FOR THE ENTIRE PROJECT IS 0.999920223 (GROUND TO GRID).
- 8.) ALL UTILITIES SHOWN WERE LOCATED BY PHYSICAL ABOVE GROUND EVIDENCE AND THEREFORE ALL SUBSURFACE UTILITIES MAY NOT BE SHOWN ON THIS SURVEY.
- 9.) ALL CONTOURS ARE AT A 1 FOOT CONTOUR INTERVAL.
- 10.) ALL EASEMENT AND BOUNDARY INFORMATION BASED ON A DIGITAL FILE OBTAINED FROM KIMLEY-HORN & ASSOCIATES AND IS SUBJECT TO ACCURACY THEREOF.
- 11.) PROPERTY IS ZONED "RS".

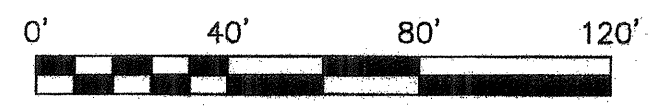

STATE OF NORTH CAROLINA
COUNTY OF DAVIDSON

I, DAVID KEITH ALLEY, CERTIFY THAT THIS PROJECT WAS COMPLETED UNDER MY DIRECT AND RESPONSIBLE CHARGE FROM AN ACTUAL GROUND SURVEY MADE UNDER MY SUPERVISION; THAT THIS TOPOGRAPHIC SURVEY WAS PERFORMED TO MEET FEDERAL GEOGRAPHIC DATA COMMITTEE STANDARDS AS APPLICABLE; THAT THE ORIGINAL DATA WAS OBTAINED IN JULY, 2008; THAT THE SURVEY WAS COMPLETED ON AUGUST, 2008; AND ALL COORDINATES ARE BASED ON NC GRID 83/86.



2-9-10
DAVID KEITH ALLEY, P.L.S. L-4492

PROPERTY OWNED UNDER:
VALLEYFIELD FARM INC.
STANLEY DAVIS PHILLIPS


DATE: SEPTEMBER 17, 2009	SHEET NO. 5	REV.	DESCRIPTION	DATE
PROJECT NO.: 12.05.007		REV1		
FIELD WORK: CA/BC/DD/RC/NJ	OF: 8	REV2		
CHECKED: DKA		REV3		
SCALE: 1"=40'		REV4		

TOPOGRAPHIC SURVEY OF:
**VALLEYFIELDS FARM, INC.
STREAM RESTORATION**

SURVEY REQUESTED BY: KIMLEY-HORN & ASSOCIATES
ABBOTTS CREEK TOWNSHIP, DAVIDSON COUNTY, NC



NCBELS LICENSE NO. C-1273
CAVANAUGH
Solutions through integrity and partnership

Cavanaugh & Associates, P.A. 530 North Trade Street, Suite 302, Winston-Salem, NC 27101
336/759-9001 fax: 336/759-1005 www.cavanaughassociates.com

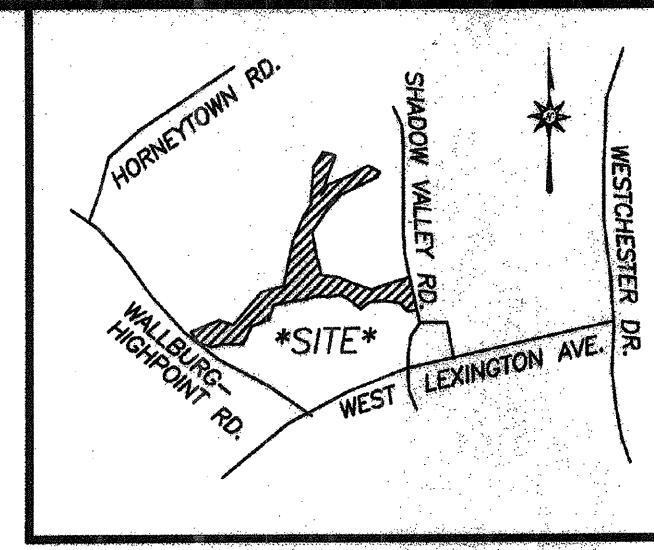

NOTES


- 1.) ALL PROPERTIES SHOWN HEREON ARE SUBJECT TO ANY EASEMENT (WRITTEN OR UNWRITTEN).
- 2.) ALL FEATURES ARE MARKED AS SHOWN IN THE LEGEND UNLESS OTHERWISE NOTED.
- 3.) DEED REFERENCES: CONSERVATION EASEMENT AND EASEMENT OF INGRESS AND EGRESS DEED BOOK 1488 PG. 985-993.
- 4.) THIS MAP IS NOT INTENDED TO BE PREPARED FOR RECORDING IN ACCORDANCE WITH G.S. 47-30, AS AMENDED.
- 5.) THE BENCH MARK FOR ALL ELEVATIONS SHOWN HEREON IS A NCDOT TRAVERSE DISK NUMBER 7R2568WM GPS 1" HAVING NC GRID NAD 83/86" COORDINATES AS FOLLOWS: N:812497.152 US FT, E:1686318.780 US FT; ELEV: 775.03 US FT (NGVD 29) AS SHOWN ON A SURVEY DONE BY M.L. MOTSINGER, DATED 12/04/2003 ENTITLED: SURVEY OF VALLEYFIELDS FARM, INC. CONSERVATION EASEMENTS ACQUIRED BY NORTH CAROLINA DEPARTMENT OF TRANSPORTATION FOR NORTH CAROLINA WILDLIFE RESOURCE COMMISSION.
- 6.) ALL DISTANCES SHOWN HEREON ARE HORIZONTAL GROUND DISTANCES UNLESS OTHERWISE NOTED.
- 7.) THE COMBINED SCALE FACTOR FOR THE ENTIRE PROJECT IS 0.999920223 (GROUND TO GRID).
- 8.) ALL UTILITIES SHOWN WERE LOCATED BY PHYSICAL ABOVE GROUND EVIDENCE AND THEREFORE ALL SUBSURFACE UTILITIES MY NOT BE SHOWN ON THIS SURVEY.
- 9.) ALL CONTOURS ARE AT A 1 FOOT CONTOUR INTERVAL.
- 10.) ALL EASEMENT AND BOUNDARY INFORMATION BASED ON A DIGITAL FILE OBTAINED FROM KIMLEY-HORN & ASSOCIATES AND IS SUBJECT TO ACCURACY THEREOF.
- 11.) PROPERTY IS ZONED "RS".

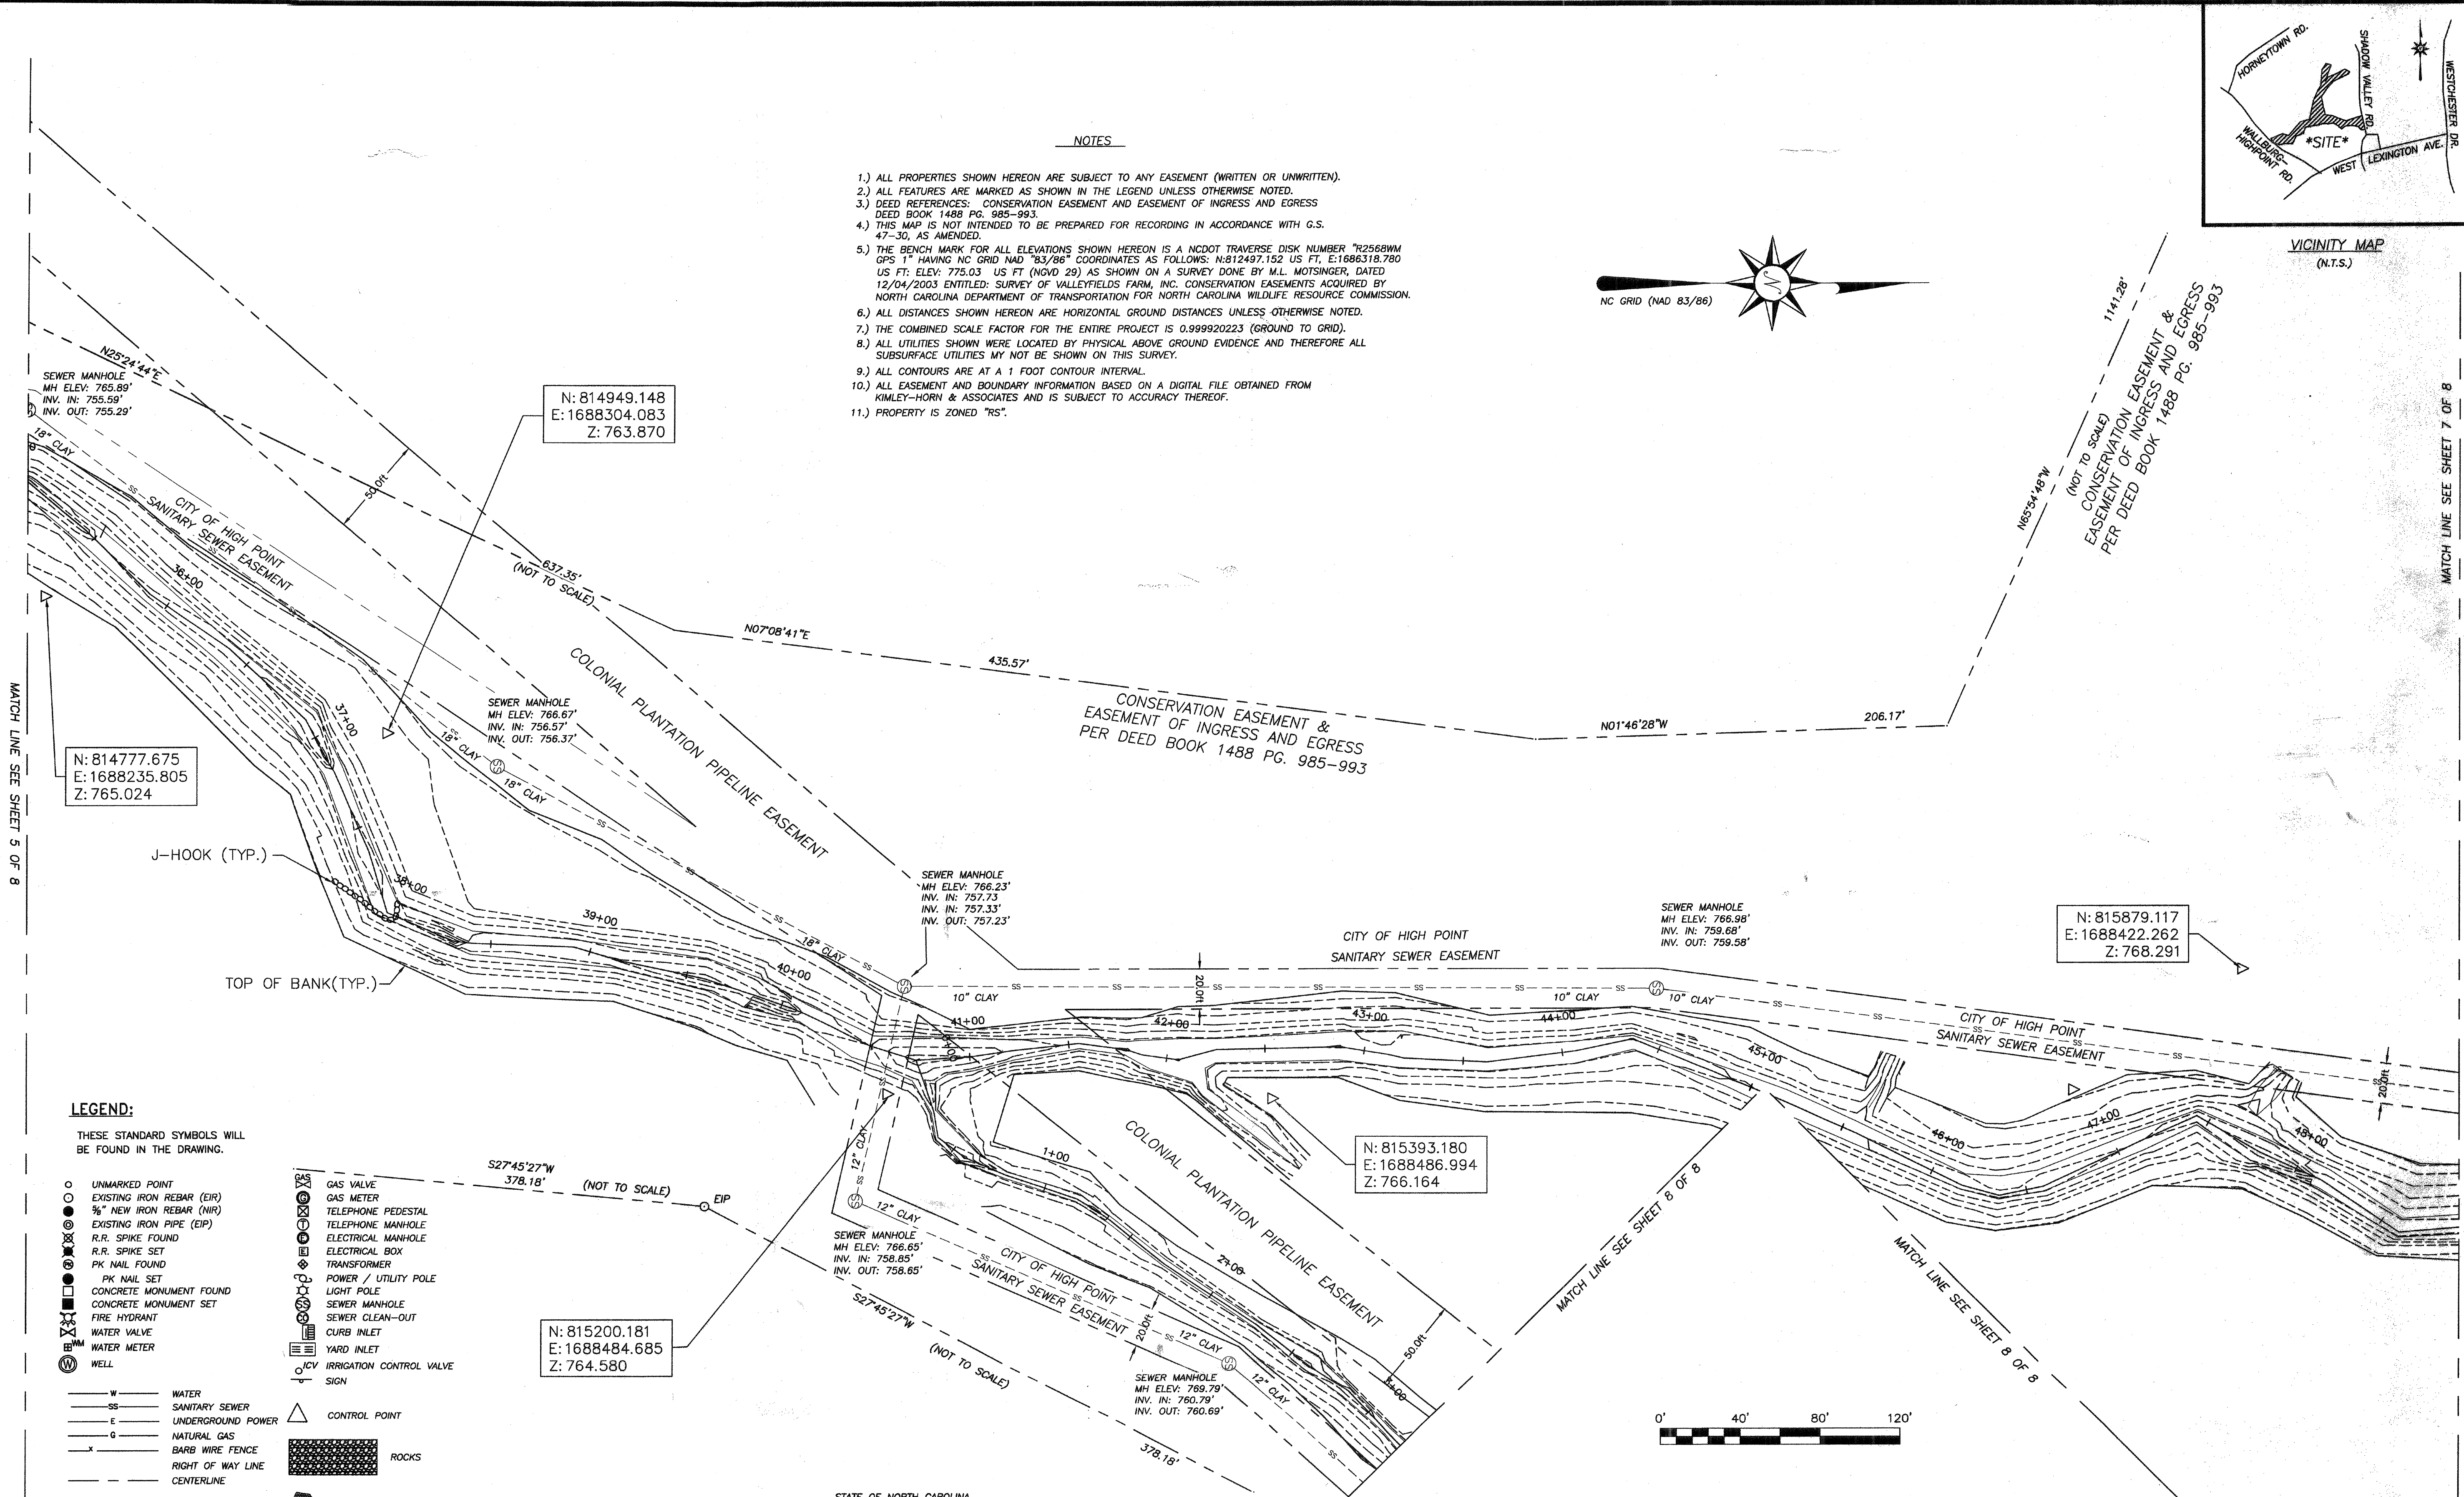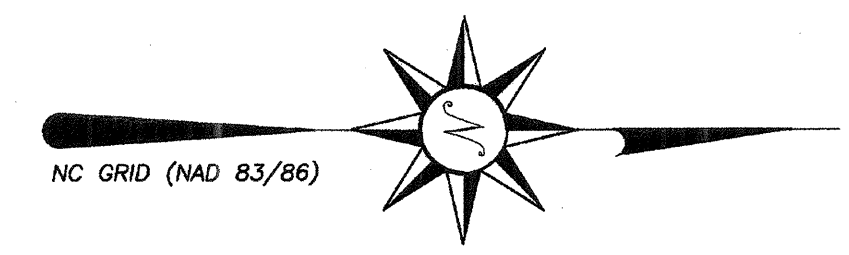

LEGEND:

THESE STANDARD SYMBOLS WILL BE FOUND IN THE DRAWING.


- | | |
|-----------------------------|----------------------------|
| ○ UNMARKED POINT | ⊗ GAS VALVE |
| ● EXISTING IRON REBAR (EIR) | ⊗ GAS METER |
| ● ¾" NEW IRON REBAR (NIR) | ⊗ TELEPHONE PEDESTAL |
| ⊗ EXISTING IRON PIPE (EIP) | ⊗ TELEPHONE MANHOLE |
| ⊗ R.R. SPIKE FOUND | ⊗ ELECTRICAL MANHOLE |
| ⊗ R.R. SPIKE SET | ⊗ ELECTRICAL BOX |
| ⊗ PK NAIL FOUND | ⊗ TRANSFORMER |
| ⊗ PK NAIL SET | ⊗ POWER / UTILITY POLE |
| ⊗ CONCRETE MONUMENT FOUND | ⊗ LIGHT POLE |
| ⊗ CONCRETE MONUMENT SET | ⊗ SEWER MANHOLE |
| ⊗ FIRE HYDRANT | ⊗ SEWER CLEAN-OUT |
| ⊗ WATER VALVE | ⊗ CURB INLET |
| ⊗ WATER METER | ⊗ YARD INLET |
| ⊗ WELL | ⊗ IRRIGATION CONTROL VALVE |
| — W — WATER | ⊗ SIGN |
| — SS — SANITARY SEWER | △ CONTROL POINT |
| — E — UNDERGROUND POWER | ⊗ ROCKS |
| — G — NATURAL GAS | ⊗ ROCK CROSS VANE |
| — x — BARB WIRE FENCE | |
| — — RIGHT OF WAY LINE | |
| — — CENTERLINE | |

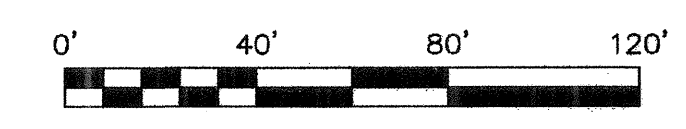

STATE OF NORTH CAROLINA
COUNTY OF DAVIDSON

I, DAVID KEITH ALLEY, CERTIFY THAT THIS PROJECT WAS COMPLETED UNDER MY DIRECT AND RESPONSIBLE CHARGE FROM AN ACTUAL GROUND SURVEY MADE UNDER MY SUPERVISION; THAT THIS TOPOGRAPHIC SURVEY WAS PERFORMED TO MEET FEDERAL GEOGRAPHIC DATA COMMITTEE STANDARDS AS APPLICABLE; THAT THE ORIGINAL DATA WAS OBTAINED IN JULY, 2008; THAT THE SURVEY WAS COMPLETED ON AUGUST, 2008; AND ALL COORDINATES ARE BASED ON NC GRID 83/86.

448 2-9-10
DAVID KEITH ALLEY, P.L.S. L-4492

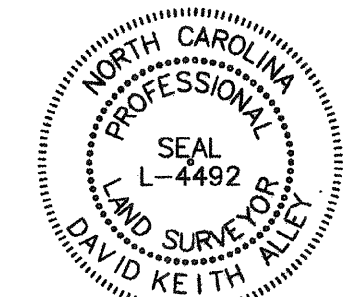


PROPERTY OWNED UNDER:
VALLEYFIELD FARM INC.
STANLEY DAVIS PHILLIPS



DATE: SEPTEMBER 17, 2009	SHEET NO. 6	REV.	DESCRIPTION	DATE
PROJECT NO.: 12.05.007		REV1		
FIELD WORK: CA/BC/DD/RC/NJ	OF: 8	REV2		
CHECKED: DKA		REV3		
SCALE: 1"=40'		REV4		

TOPOGRAPHIC SURVEY OF:
VALLEYFIELDS FARM, INC.
STREAM RESTORATION

SURVEY REQUESTED BY: KIMLEY-HORN & ASSOCIATES
ABBOTTS CREEK TOWNSHIP, DAVIDSON COUNTY, NC

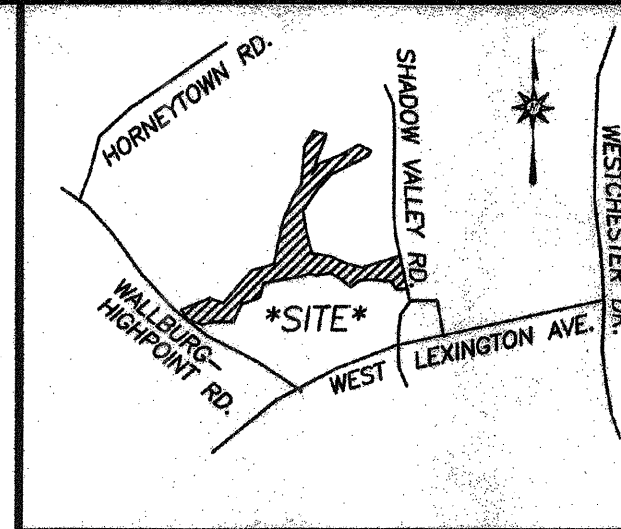

VICINITY MAP
(N.T.S.)

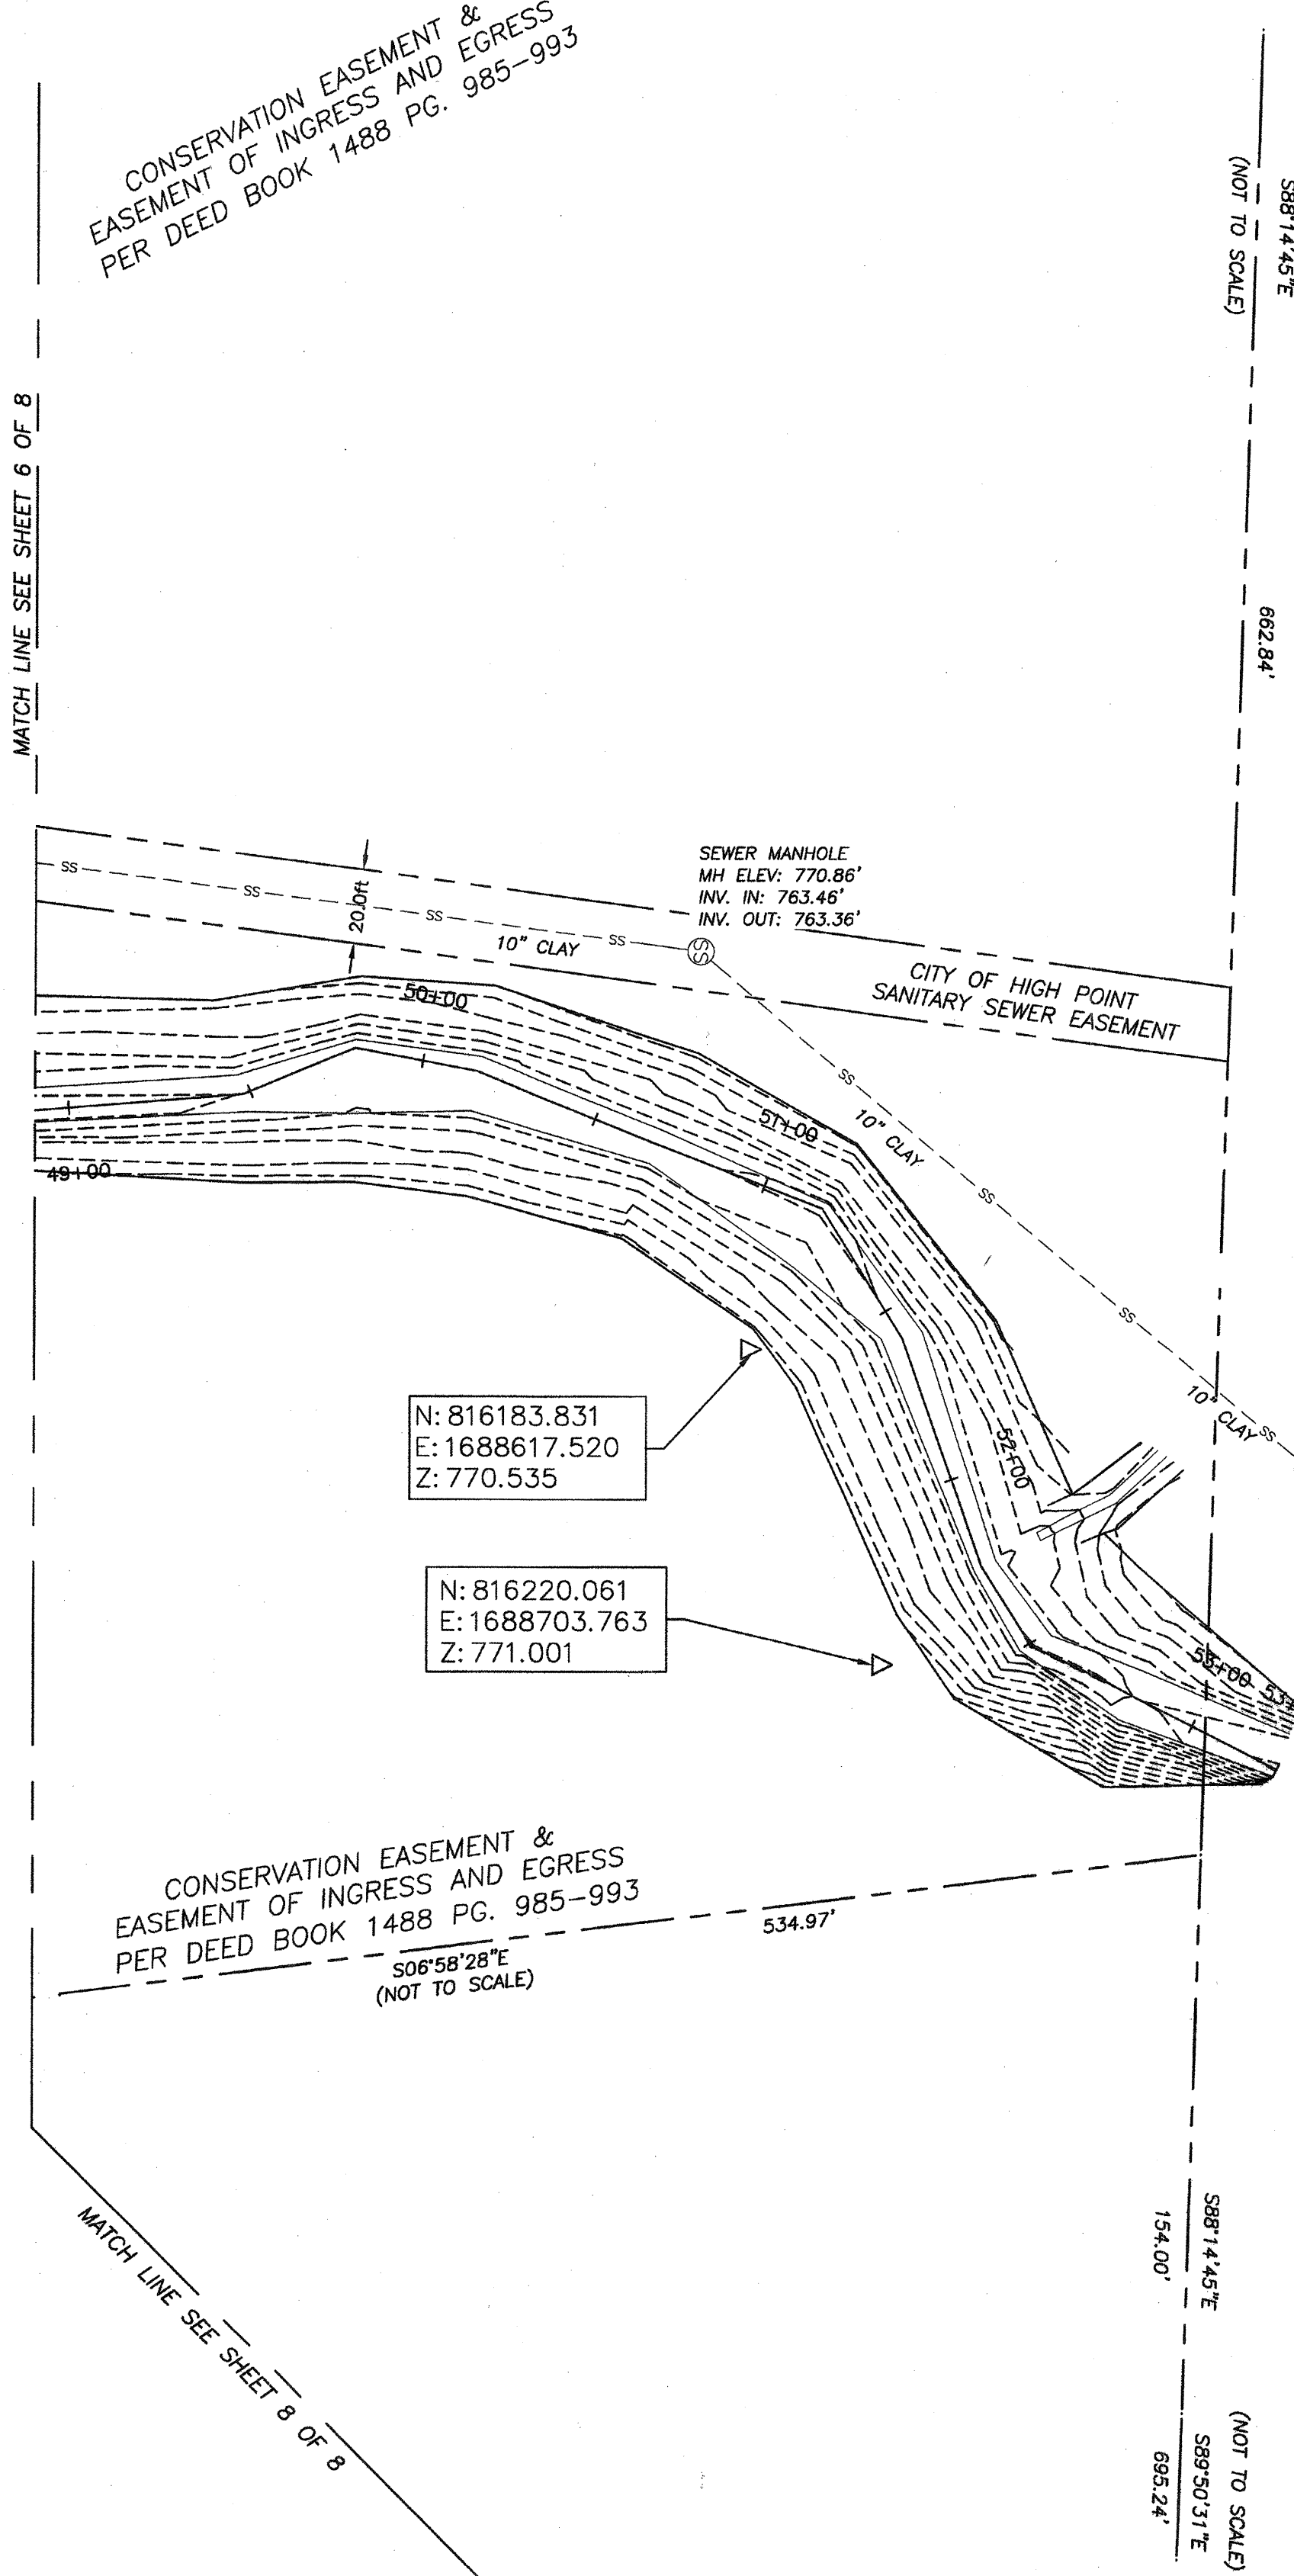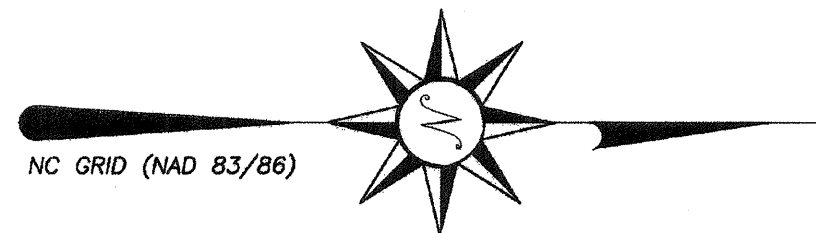


LEGEND:

THESE STANDARD SYMBOLS WILL BE FOUND IN THE DRAWING.

- UNMARKED POINT
- EXISTING IRON REBAR (EIR)
- 3/4" NEW IRON REBAR (NIR)
- EXISTING IRON PIPE (EIP)
- ⊗ R.R. SPIKE FOUND
- ⊗ R.R. SPIKE SET
- ⊗ PK NAIL FOUND
- ⊗ PK NAIL SET
- ⊗ CONCRETE MONUMENT FOUND
- ⊗ CONCRETE MONUMENT SET
- ⊗ FIRE HYDRANT
- ⊗ WATER VALVE
- ⊗ WATER METER
- ⊗ WELL
- ⊗ GAS VALVE
- ⊗ GAS METER
- ⊗ TELEPHONE PEDESTAL
- ⊗ TELEPHONE MANHOLE
- ⊗ ELECTRICAL MANHOLE
- ⊗ ELECTRICAL BOX
- ⊗ TRANSFORMER
- ⊗ POWER / UTILITY POLE
- ⊗ LIGHT POLE
- ⊗ SEWER MANHOLE
- ⊗ SEWER CLEAN-OUT
- ⊗ CURB INLET
- ⊗ YARD INLET
- ⊗ IRRIGATION CONTROL VALVE
- ⊗ SIGN
- △ CONTROL POINT
- ⊞ ROCKS
- ⊞ ROCK CROSS VANE
- W — WATER
- SS — SANITARY SEWER
- E — UNDERGROUND POWER
- G — NATURAL GAS
- x — BARB WIRE FENCE
- — — RIGHT OF WAY LINE
- — — CENTERLINE

NOTES


- 1.) ALL PROPERTIES SHOWN HEREON ARE SUBJECT TO ANY EASEMENT (WRITTEN OR UNWRITTEN).
- 2.) ALL FEATURES ARE MARKED AS SHOWN IN THE LEGEND UNLESS OTHERWISE NOTED.
- 3.) DEED REFERENCES: CONSERVATION EASEMENT AND EASEMENT OF INGRESS AND EGRESS DEED BOOK 1488 PG. 985-993.
- 4.) THIS MAP IS NOT INTENDED TO BE PREPARED FOR RECORDING IN ACCORDANCE WITH G.S. 47-30, AS AMENDED.
- 5.) THE BENCH MARK FOR ALL ELEVATIONS SHOWN HEREON IS A NCDOT TRAVERSE DISK NUMBER "R2568WM GPS 1" HAVING NC GRID NAD "83/86" COORDINATES AS FOLLOWS: N:812497.152 US FT, E:1686318.780 US FT, ELEV: 775.03 US FT (NGVD 29) AS SHOWN ON A SURVEY DONE BY M.L. MOTSINGER, DATED 12/04/2003 ENTITLED: SURVEY OF VALLEYFIELDS FARM, INC. CONSERVATION EASEMENTS ACQUIRED BY NORTH CAROLINA DEPARTMENT OF TRANSPORTATION FOR NORTH CAROLINA WILDLIFE RESOURCE COMMISSION.
- 6.) ALL DISTANCES SHOWN HEREON ARE HORIZONTAL GROUND DISTANCES UNLESS OTHERWISE NOTED.
- 7.) THE COMBINED SCALE FACTOR FOR THE ENTIRE PROJECT IS 0.999920223 (GROUND TO GRID).
- 8.) ALL UTILITIES SHOWN WERE LOCATED BY PHYSICAL ABOVE GROUND EVIDENCE AND THEREFORE ALL SUBSURFACE UTILITIES MY NOT BE SHOWN ON THIS SURVEY.
- 9.) ALL CONTOURS ARE AT A 1 FOOT CONTOUR INTERVAL.
- 10.) ALL EASEMENT AND BOUNDARY INFORMATION BASED ON A DIGITAL FILE OBTAINED FROM KIMLEY-HORN & ASSOCIATES AND IS SUBJECT TO ACCURACY THEREOF.
- 11.) PROPERTY IS ZONED "RS".

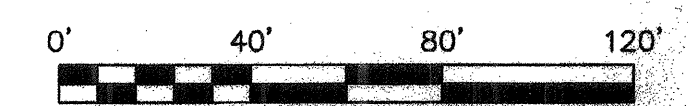

STATE OF NORTH CAROLINA
COUNTY OF DAVIDSON

I, DAVID KEITH ALLEY, CERTIFY THAT THIS PROJECT WAS COMPLETED UNDER MY DIRECT AND RESPONSIBLE CHARGE FROM AN ACTUAL GROUND SURVEY MADE UNDER MY SUPERVISION; THAT THIS TOPOGRAPHIC SURVEY WAS PERFORMED TO MEET FEDERAL GEOGRAPHIC DATA COMMITTEE STANDARDS AS APPLICABLE; THAT THE ORIGINAL DATA WAS OBTAINED IN JULY, 2008; THAT THE SURVEY WAS COMPLETED ON AUGUST, 2008; AND ALL COORDINATES ARE BASED ON NC GRID 83/86.

DKA 2-7-10
DAVID KEITH ALLEY, P.L.S. L-4492

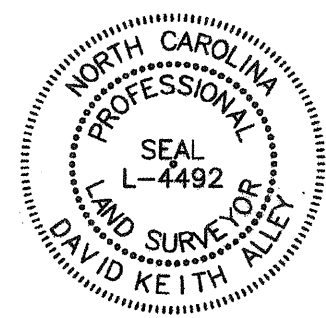

PROPERTY OWNED UNDER:
VALLEYFIELD FARM INC.
STANLEY DAVIS PHILLIPS

DATE:		SHEET NO.		TOPOGRAPHIC SURVEY OF:	
SEPTEMBER 17, 2009		7		VALLEYFIELDS FARM, INC.	
PROJECT NO.: 12.05.007		REV1		STREAM RESTORATION	
FIELD WORK: CA/BC/DD/RC/NJ		REV2		SURVEY REQUESTED BY: KIMLEY-HORN & ASSOCIATES	
CHECKED: DKA		REV3		ABBOTTS CREEK TOWNSHIP, DAVIDSON COUNTY, NC	
SCALE: 1"=40'		REV4			

NCBELS LICENSE NO. C-1273
CAVANAUGH
Solutions through integrity and partnership

Cavanaugh & Associates, P.A. 530 North Trade Street, Suite 302, Winston-Salem, NC 27101
336/769-9001 fax: 336/769-1005 www.cavanaughassociates.com

LEGEND:


THESE STANDARD SYMBOLS WILL BE FOUND IN THE DRAWING.

- UNMARKED POINT
- EXISTING IRON REBAR (EIR)
- 3/4" NEW IRON REBAR (NIR)
- EXISTING IRON PIPE (EIP)
- R.R. SPIKE FOUND
- R.R. SPIKE SET
- PK NAIL FOUND
- PK NAIL SET
- CONCRETE MONUMENT FOUND
- CONCRETE MONUMENT SET
- FIRE HYDRANT
- WATER VALVE
- WATER METER
- WELL
- GAS VALVE
- GAS METER
- TELEPHONE PEDESTAL
- TELEPHONE MANHOLE
- ELECTRICAL MANHOLE
- ELECTRICAL BOX
- TRANSFORMER
- POWER / UTILITY POLE
- LIGHT POLE
- SEWER MANHOLE
- SEWER CLEAN-OUT
- CURB INLET
- YARD INLET
- IRRIGATION CONTROL VALVE
- SIGN
- △ CONTROL POINT



- W — WATER
- SS — SANITARY SEWER
- E — UNDERGROUND POWER
- G — NATURAL GAS
- X — BARB WIRE FENCE
- — RIGHT OF WAY LINE
- — CENTERLINE

ROCK CROSS VANE

ROCKS

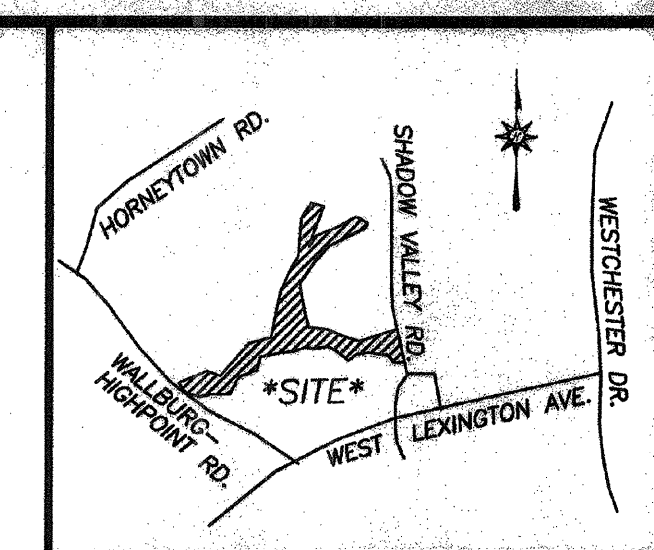

VICINITY MAP (N.T.S.)

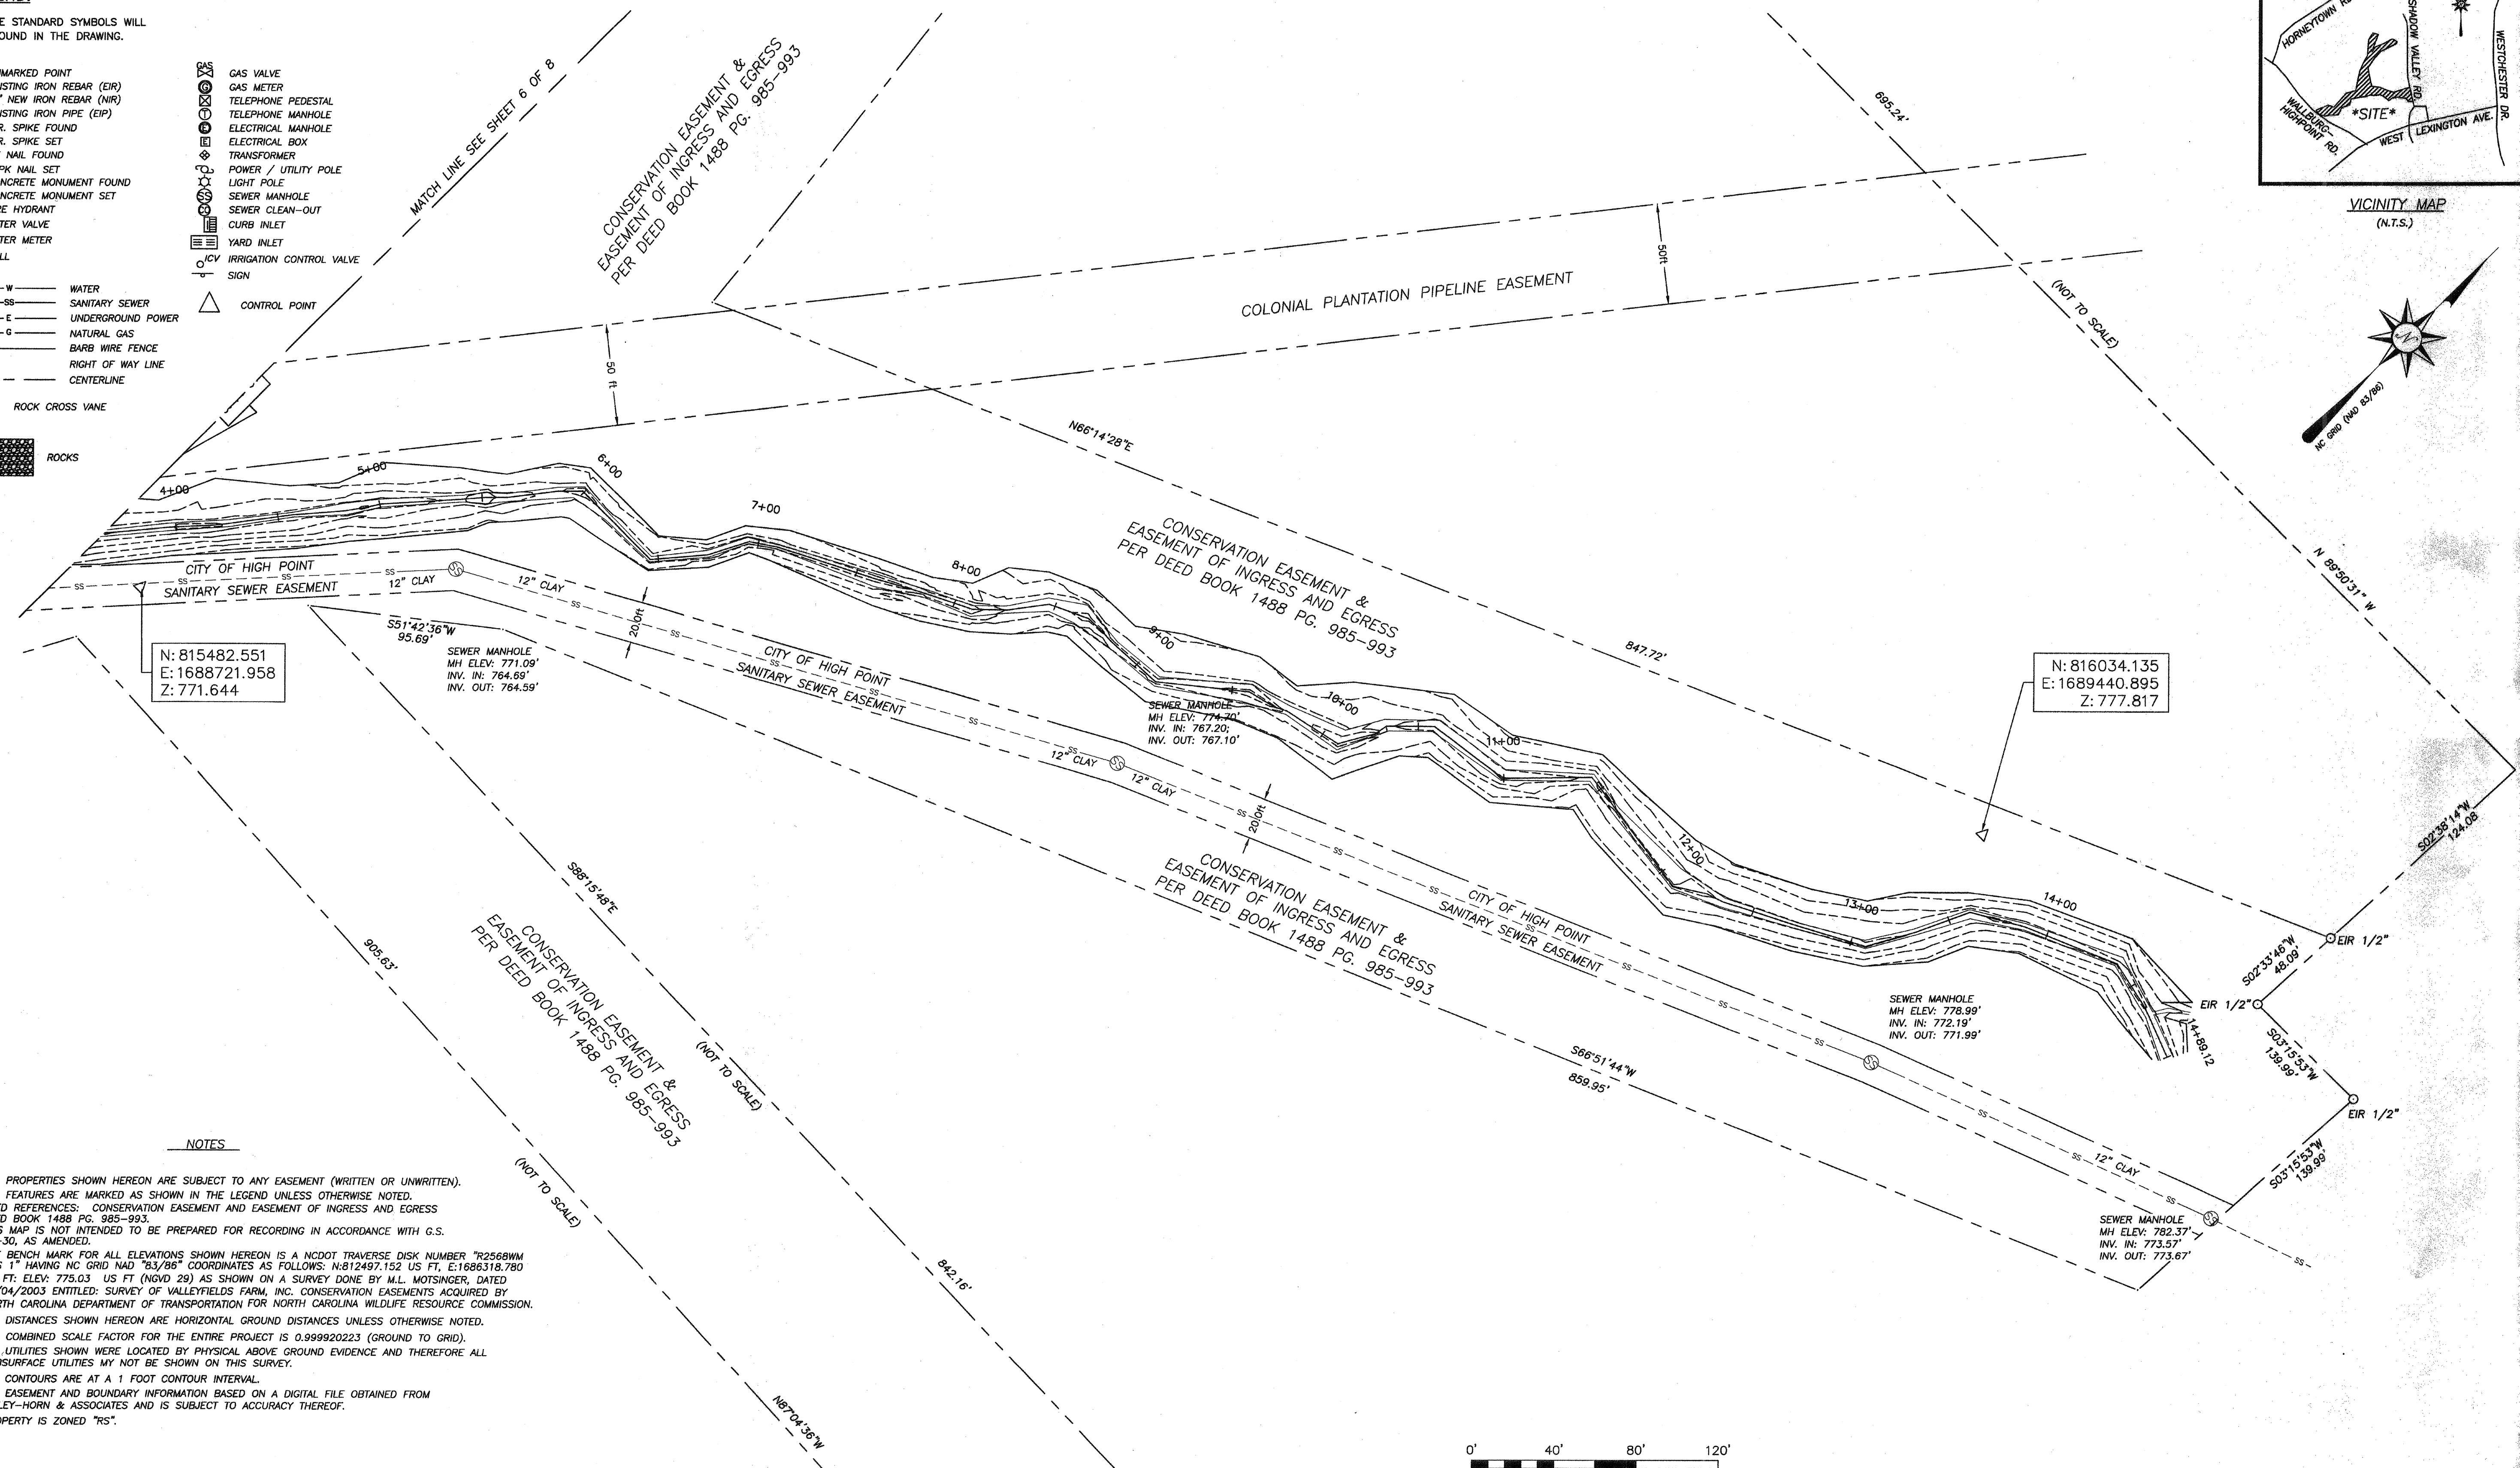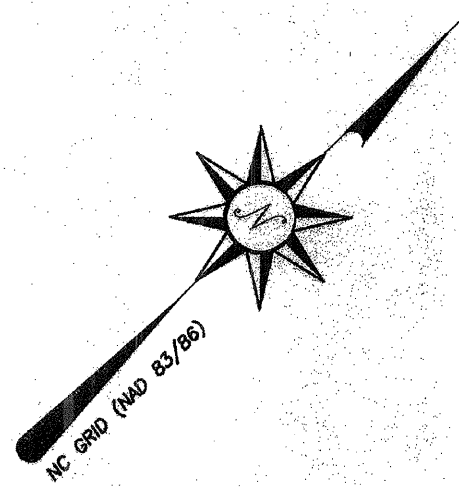


N: 815482.551
E: 1688721.958
Z: 771.644

N: 816034.135
E: 1689440.895
Z: 777.817

NOTES

- 1.) ALL PROPERTIES SHOWN HEREON ARE SUBJECT TO ANY EASEMENT (WRITTEN OR UNWRITTEN).
- 2.) ALL FEATURES ARE MARKED AS SHOWN IN THE LEGEND UNLESS OTHERWISE NOTED.
- 3.) DEED REFERENCES: CONSERVATION EASEMENT AND EASEMENT OF INGRESS AND EGRESS DEED BOOK 1488 PG. 985-993.
- 4.) THIS MAP IS NOT INTENDED TO BE PREPARED FOR RECORDING IN ACCORDANCE WITH G.S. 47-30, AS AMENDED.
- 5.) THE BENCH MARK FOR ALL ELEVATIONS SHOWN HEREON IS A NCDOT TRAVERSE DISK NUMBER "R2568WM GPS 1" HAVING NC GRID NAD "83/86" COORDINATES AS FOLLOWS: N:812497.152 US FT, E:1686318.780 US FT; ELEV: 775.03 US FT (NGVD 29) AS SHOWN ON A SURVEY DONE BY M.L. MOTSINGER, DATED 12/04/2003 ENTITLED: SURVEY OF VALLEYFIELDS FARM, INC. CONSERVATION EASEMENTS ACQUIRED BY NORTH CAROLINA DEPARTMENT OF TRANSPORTATION FOR NORTH CAROLINA WILDLIFE RESOURCE COMMISSION.
- 6.) ALL DISTANCES SHOWN HEREON ARE HORIZONTAL GROUND DISTANCES UNLESS OTHERWISE NOTED.
- 7.) THE COMBINED SCALE FACTOR FOR THE ENTIRE PROJECT IS 0.999920223 (GROUND TO GRID).
- 8.) ALL UTILITIES SHOWN WERE LOCATED BY PHYSICAL ABOVE GROUND EVIDENCE AND THEREFORE ALL SUBSURFACE UTILITIES MAY NOT BE SHOWN ON THIS SURVEY.
- 9.) ALL CONTOURS ARE AT A 1 FOOT CONTOUR INTERVAL.
- 10.) ALL EASEMENT AND BOUNDARY INFORMATION BASED ON A DIGITAL FILE OBTAINED FROM KIMLEY-HORN & ASSOCIATES AND IS SUBJECT TO ACCURACY THEREOF.
- 11.) PROPERTY IS ZONED "RS".

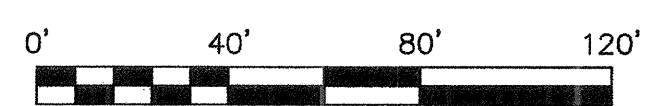

STATE OF NORTH CAROLINA
COUNTY OF DAVIDSON

I, DAVID KEITH ALLEY, CERTIFY THAT THIS PROJECT WAS COMPLETED UNDER MY DIRECT AND RESPONSIBLE CHARGE FROM AN ACTUAL GROUND SURVEY MADE UNDER MY SUPERVISION, THAT THIS TOPOGRAPHIC SURVEY WAS PERFORMED TO MEET FEDERAL GEOGRAPHIC DATA COMMITTEE STANDARDS AS APPLICABLE; THAT THE ORIGINAL DATA WAS OBTAINED IN JULY, 2008; THAT THE SURVEY WAS COMPLETED ON AUGUST, 2008; AND ALL COORDINATES ARE BASED ON NC GRID 83/86.

442 2-9-10
DAVID KEITH ALLEY, P.L.S. L-4492



PROPERTY OWNED UNDER:
VALLEYFIELD FARM INC.
STANLEY DAVIS PHILLIPS


DATE:		SHEET NO.		TOPOGRAPHIC SURVEY OF:	
SEPTEMBER 17, 2009	8	VALLEYFIELDS FARM, INC.			
PROJECT NO.: 12.05.007	8	STREAM RESTORATION			
FIELD WORK: CA/BC/DD/RC/NJ	OF:	REV.	DESCRIPTION	DATE	
CHECKED: DKA	8	REV1			
SCALE: 1"=40'		REV2			
		REV3			
		REV4			
SURVEY REQUESTED BY: KIMLEY-HORN & ASSOCIATES ABBOTTS CREEK TOWNSHIP, DAVIDSON COUNTY, NC					

NCBELS LICENSE NO. C-1273

CAVANAUGH


Solutions through integrity and partnership

Cavanaugh & Associates, P.A. 530 North Trade Street, Suite 302, Winston-Salem, NC 27101
336/759-9001 fax: 336/759-1005 www.cavanaugh-solutions.com

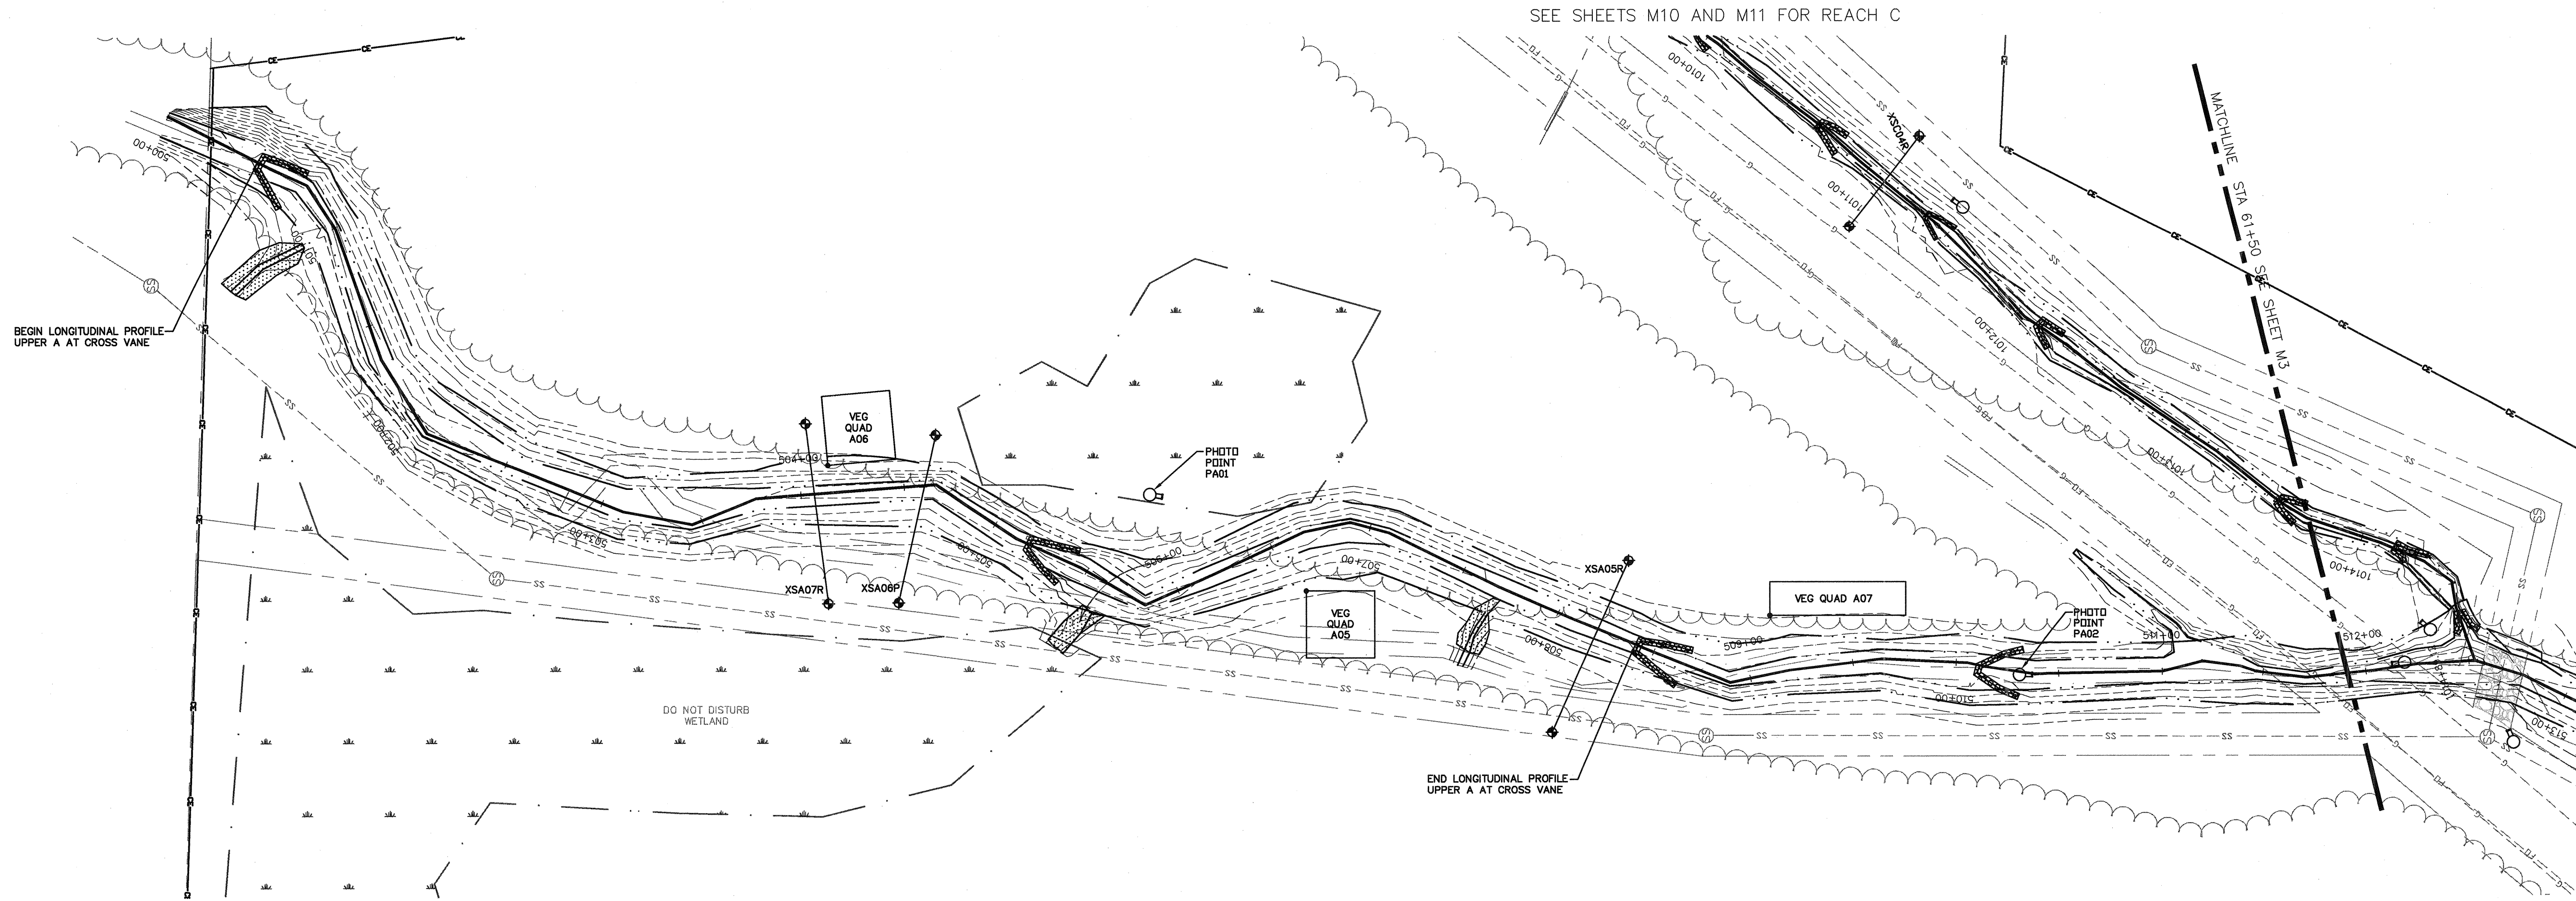

SEE SHEETS M10 AND M11 FOR REACH C

MATCHLINE STA 61+50 SEE SHEET N3

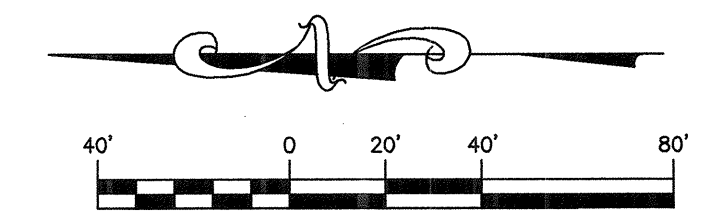

RECORD DOCUMENT

REV. No.	REVISION	DATE	DRAWN BY	CHECKED BY


PREPARED IN THE OFFICE OF:



Kimley-Horn and Associates, Inc.
 NC LICENSE #F-0102
 P.O. BOX 33068 - RALEIGH, NORTH CAROLINA 27636-3068
 PHONE: (919) 677-2000 FAX: (919) 677-2050

CLIENT: **NC-EEP**

TITLE: **MONITORING PLAN REACH A**





DATE: 01-28-10
 HORIZONTAL SCALE: JJK
 VERTICAL SCALE: JJK
 DRAWN BY: JJK
 DESIGNED BY: ARK/JCD
 CHECKED BY: WRW

PROJECT: **VALLEY FIELDS FARM**

ATTACHED REFERENCE FILES: _____
 JOB NUMBER: 011795020
 SHEET NUMBER: **M2**

This document, together with the concepts and designs presented herein, as an instrument of service, is intended only for the specific purpose and client for which it was prepared. Reuse of and improper reliance on this document without written authorization and adoption by Kimley-Horn and Associates, Inc., shall be without liability to Kimley-Horn and Associates, Inc. Copyright Kimley-Horn and Associates, Inc., 2010.

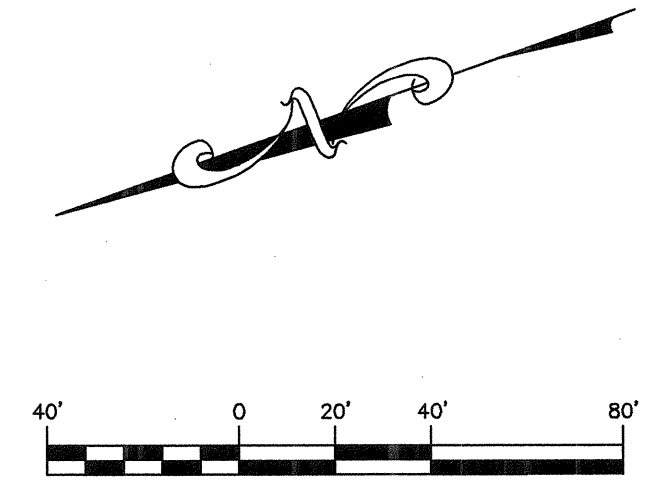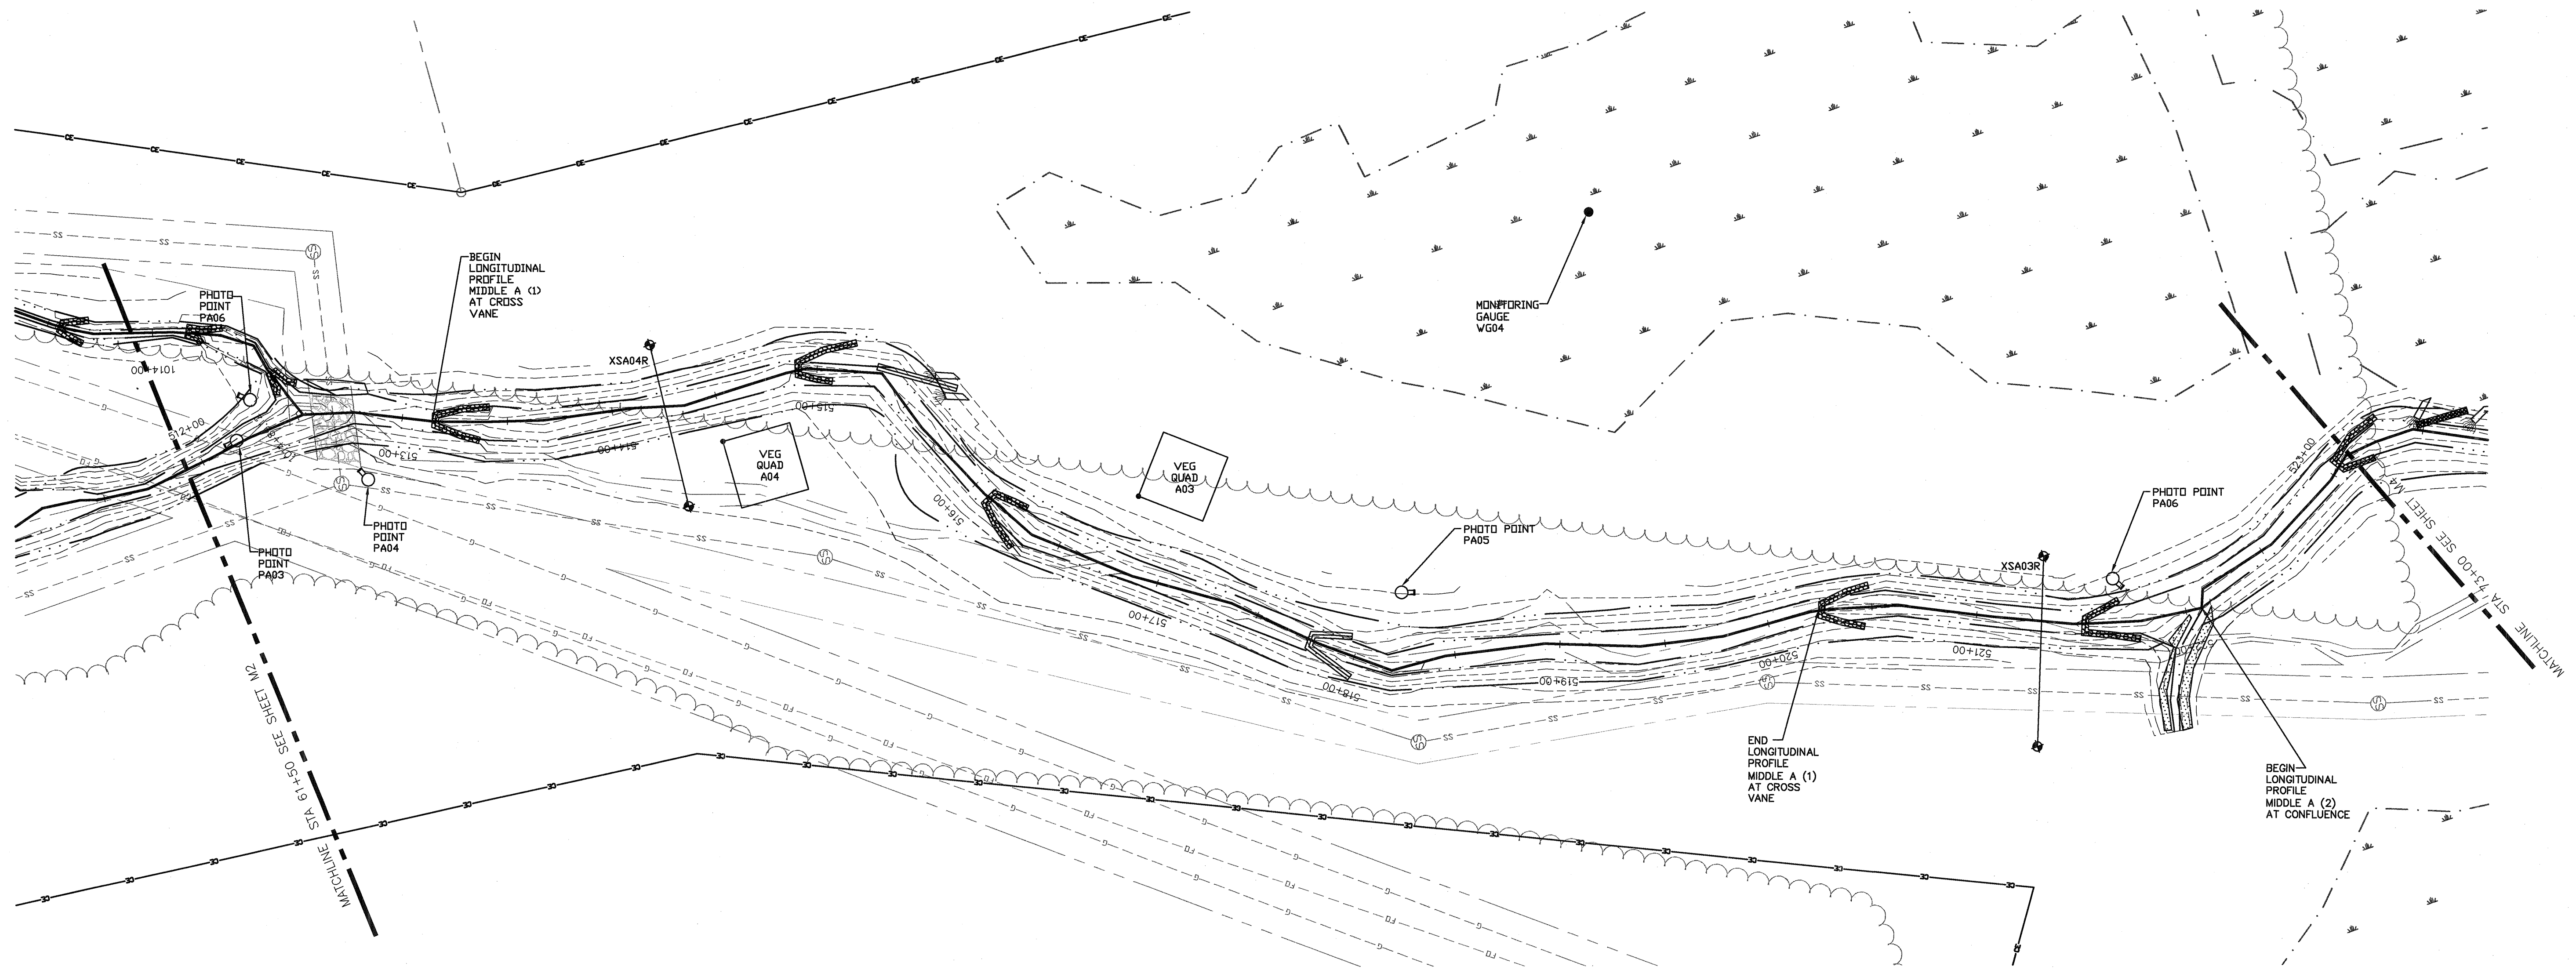

RECORD DOCUMENT

REV. No.	REVISION	DATE	DRAWN BY	CHECKED BY

PREPARED IN THE OFFICE OF:

Kimley-Horn and Associates, Inc.
 NC LICENSE #F-0102
 P.O. BOX 33068 - RALEIGH, NORTH CAROLINA 27636-3068
 PHONE: (919) 677-2000 FAX: (919) 677-2050

CLIENT: **NC-EEP**

TITLE: **MONITORING PLAN REACH A**

DATE: 01-28-10
 PROJECT: **VALLEY FIELDS FARM**



DESIGNED BY: ARK/JCD
 CHECKED BY: WRW

ATTACHED REFERENCE FILES: _____
 JOB NUMBER: 011795020
 SHEET NUMBER: **M3**

This document, together with the concepts and designs presented herein, as an instrument of service, is intended only for the specific purpose and client for which it was prepared. Reuse of and improper reliance on this document without written authorization and adaptation by Kimley-Horn and Associates, Inc., shall be without liability to Kimley-Horn and Associates, Inc. Copyright Kimley-Horn and Associates, Inc., 2010

NOTE:
SEE SHEET P13 FOR WETLAND GRADING PLAN

SEE SHEETS M7 - M9 FOR REACH B

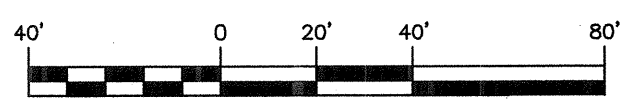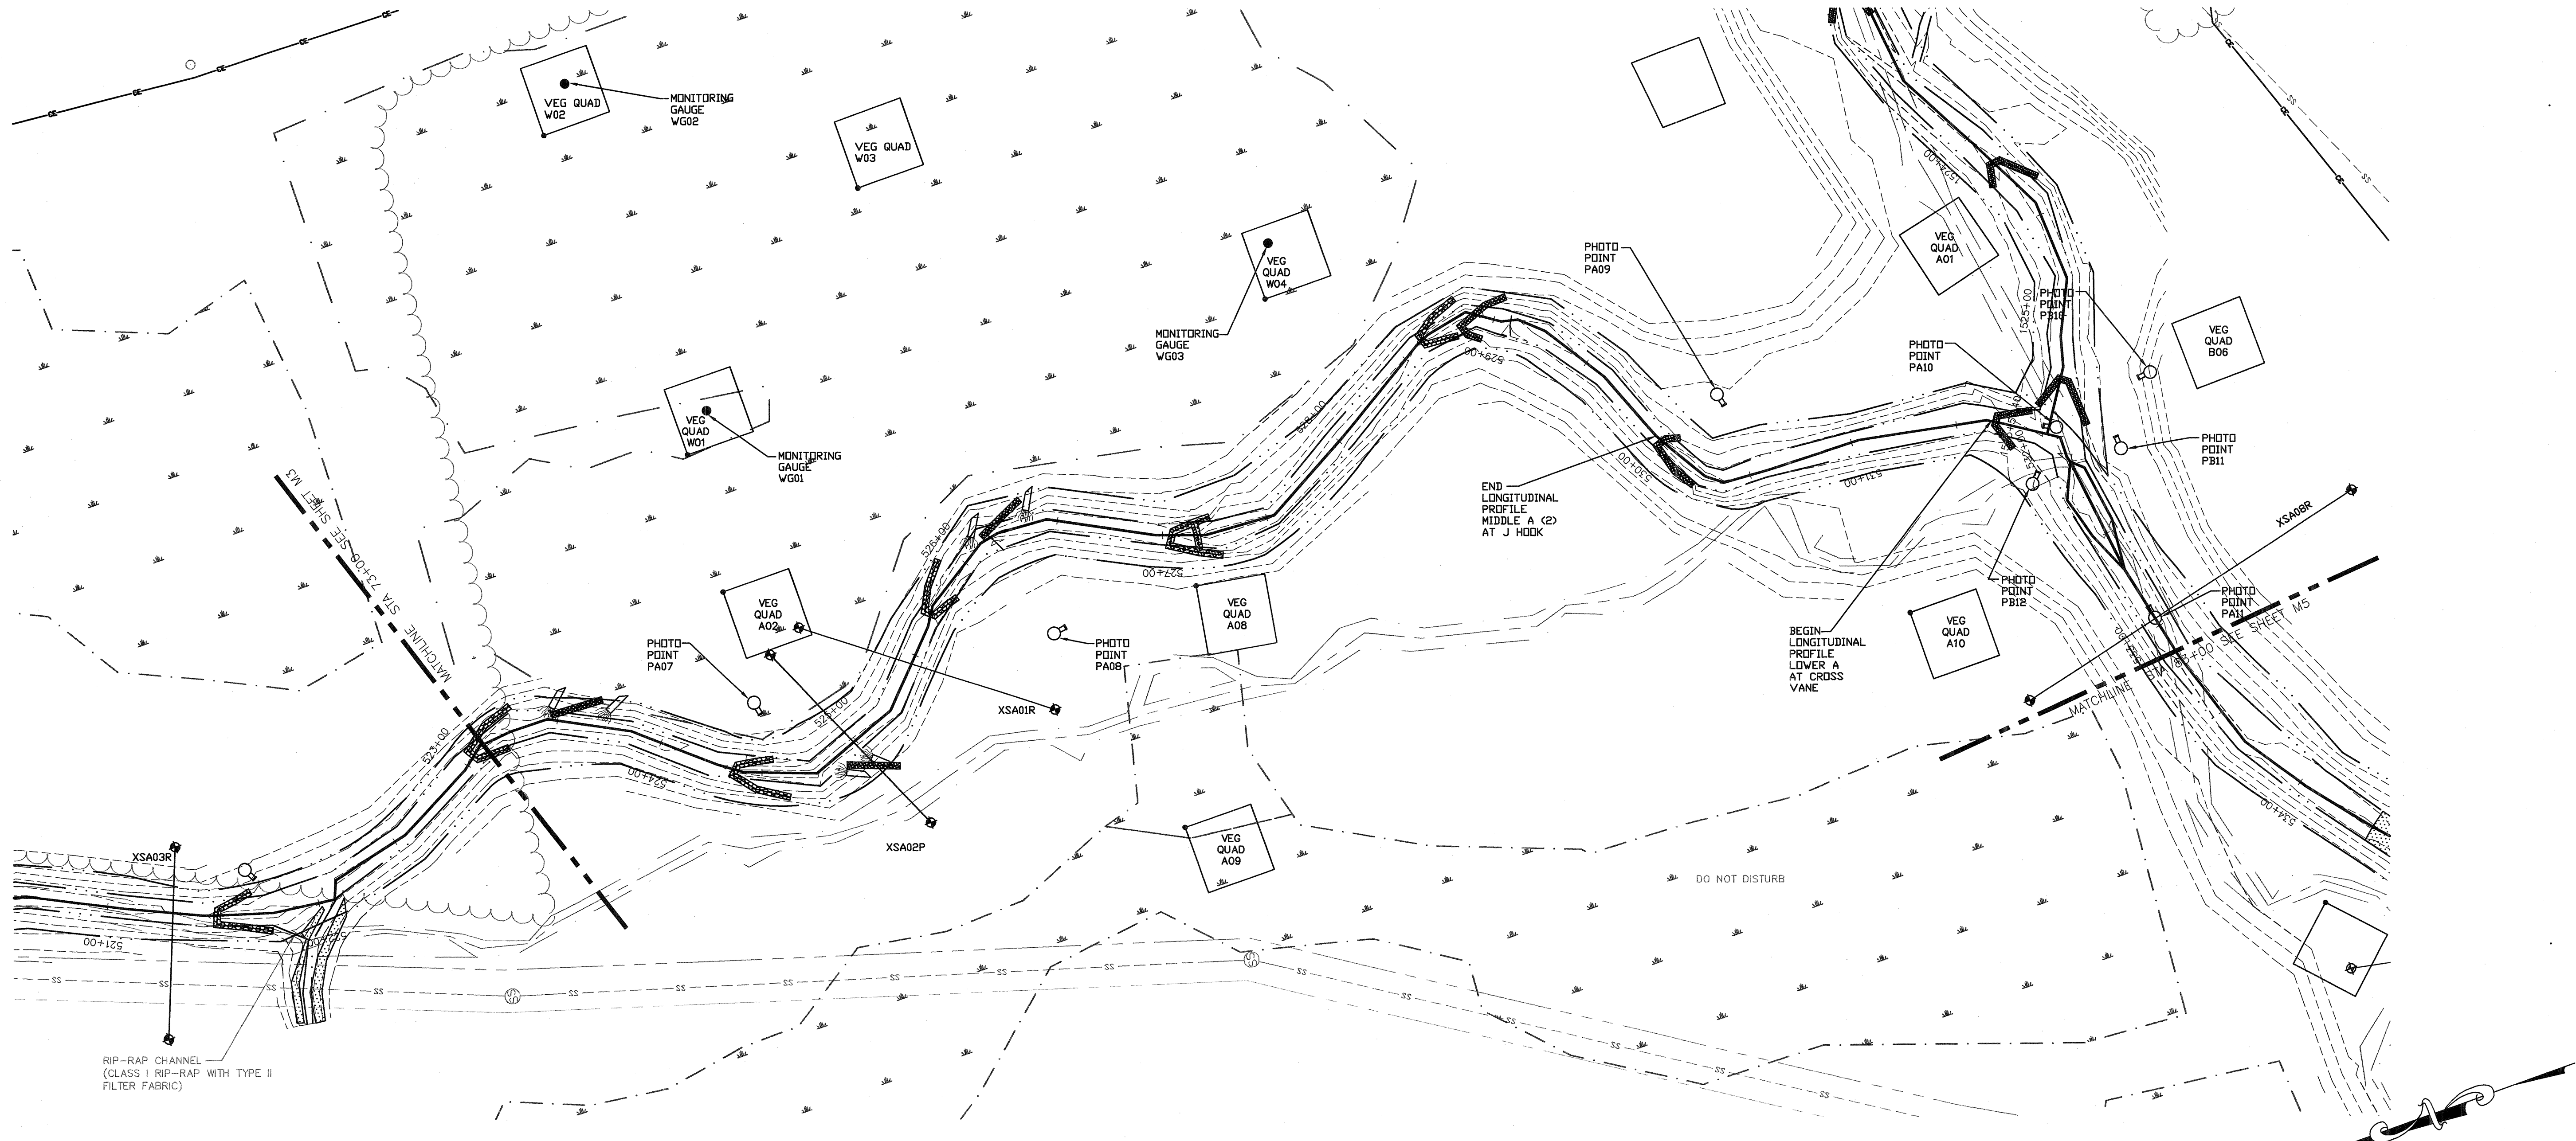

RECORD DOCUMENT

REV. No.	REVISION	DATE	DRAWN BY	CHECKED BY

PREPARED IN THE OFFICE OF:

Kimley-Horn and Associates, Inc.
 NC LICENSE #F-0102
 P.O. BOX 33068 - RALEIGH, NORTH CAROLINA 27636-3068
 PHONE: (919) 677-2000 FAX: (919) 677-2050

CLIENT: **NC-EEP**



TITLE: **MONITORING PLAN REACH A**

DATE: 01-28-10
 HORIZONTAL SCALE:
 VERTICAL SCALE:
 DRAWN BY: JIK
 DESIGNED BY: ARK/JCD
 CHECKED BY: WRW

PROJECT: **VALLEY FIELDS FARM**

ATTACHED REFERENCE FILES:
 JOB NUMBER: 011795020
 SHEET NUMBER: **M4**

This document, together with the concepts and designs presented herein, as an instrument of service, is intended only for the specific purpose and client for which it was prepared. Reuse of and improper reliance on this document without written authorization and adaptation by Kimley-Horn and Associates, Inc., shall be without liability to Kimley-Horn and Associates, Inc.
 Copyright Kimley-Horn and Associates, Inc., 2010

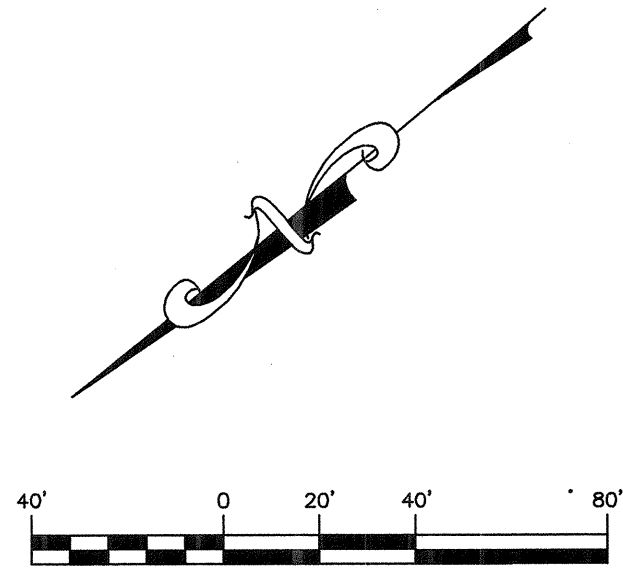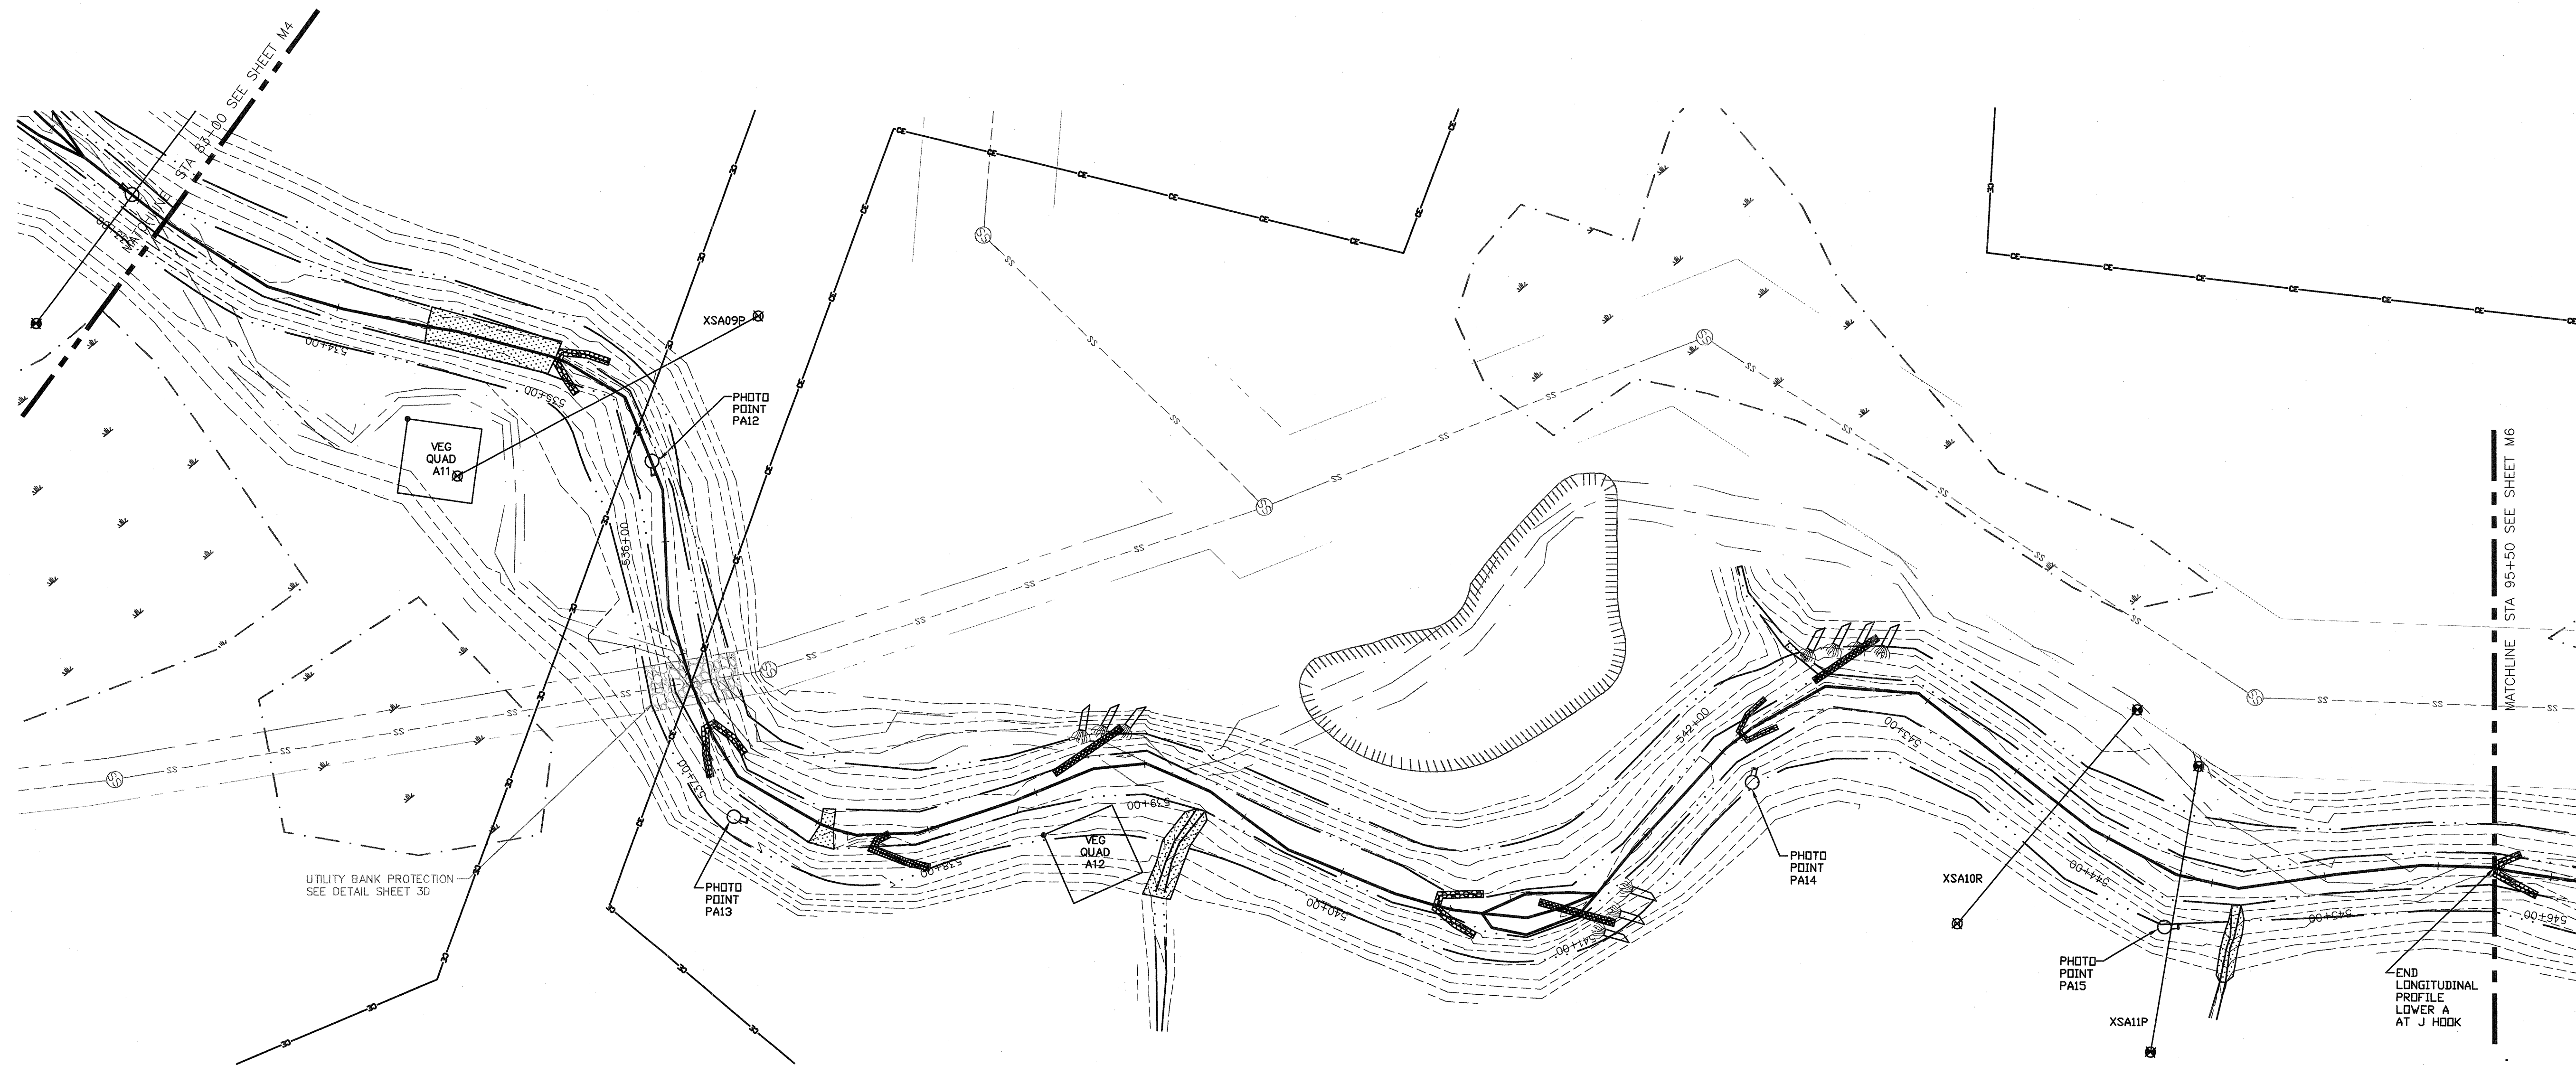

RECORD DOCUMENT

REV. No.	REVISION	DATE	DRAWN BY	CHECKED BY

This document, together with the concepts and designs presented herein, as an instrument of service, is intended only for the specific purpose and client for which it was prepared. Reuse of and improper reliance on this document without written authorization and adaptation by Kimley-Horn and Associates, Inc., shall be without liability to Kimley-Horn and Associates, Inc. Copyright Kimley-Horn and Associates, Inc., 2010.


PREPARED IN THE OFFICE OF:



Kimley-Horn and Associates, Inc.
 NC LICENSE #F-0102
 P.O. BOX 33068 - RALEIGH, NORTH CAROLINA 27636-3068
 PHONE: (919) 677-2000 FAX: (919) 677-2050

CLIENT: **NC-EEP**



TITLE: **MONITORING PLAN REACH A**

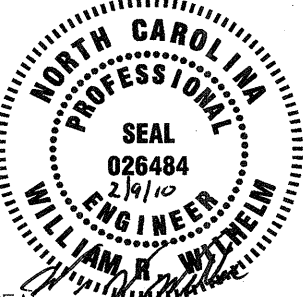

DATE: 01-28-10
 HORIZONTAL SCALE:
 VERTICAL SCALE:
 DRAWN BY: JJK
 DESIGNED BY: ARK/JCD
 CHECKED BY: WRW

PROJECT: **VALLEY FIELDS FARM**

ATTACHED REFERENCE FILES:
 JOB NUMBER: 011795020
 SHEET NUMBER: **M5**

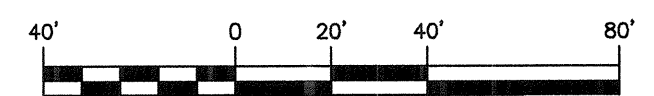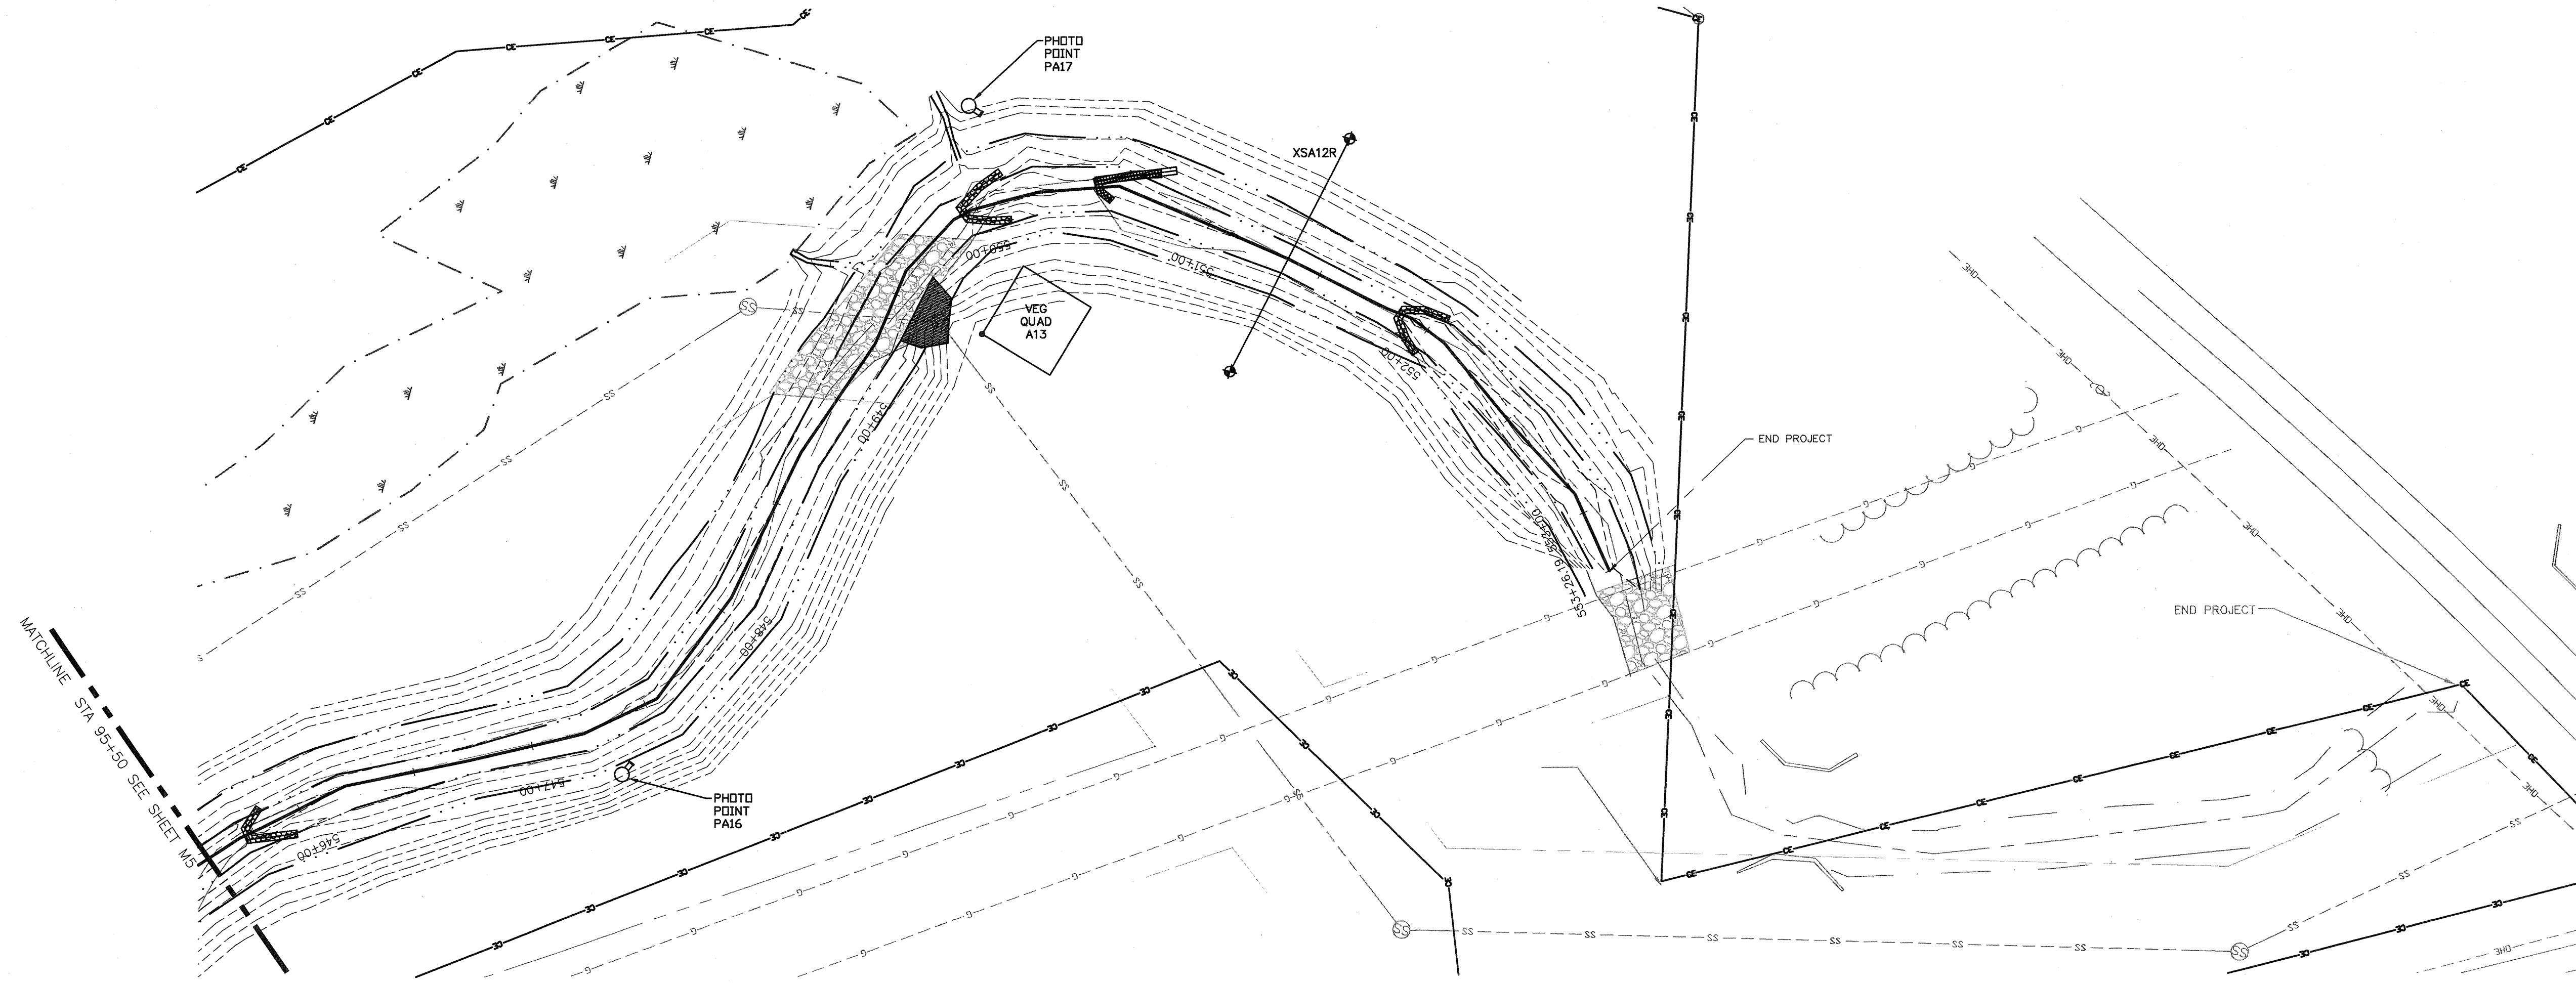

RECORD DOCUMENT

REV. No.	REVISION	DATE	DRAWN BY	CHECKED BY


PREPARED IN THE OFFICE OF:



Kimley-Horn and Associates, Inc.
 NC LICENSE #F-0102
 P.O. BOX 33068 - RALEIGH, NORTH CAROLINA 27636-3068
 PHONE: (919) 677-2000 FAX: (919) 677-2050

CLIENT: **NC-EEP**

TITLE: **MONITORING PLAN REACH A**


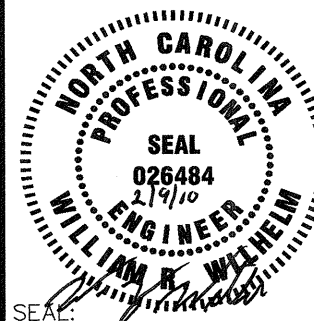


DATE: 01-28-10
 HORIZONTAL SCALE:
 VERTICAL SCALE:
 DRAWN BY: JIK
 DESIGNED BY: ARK/JCD
 CHECKED BY: WRW

PROJECT: **VALLEY FIELDS FARM**

ATTACHED REFERENCE FILES:
 JOB NUMBER: 011795020
 SHEET NUMBER: **M6**

This document, together with the concepts and designs presented herein, as an instrument of service, is intended only for the specific purpose and client for which it was prepared. Reuse of and improper reliance on this document without written authorization and adaptation by Kimley-Horn and Associates, Inc., shall be without liability to Kimley-Horn and Associates, Inc.
 Copyright Kimley-Horn and Associates, Inc., 2010

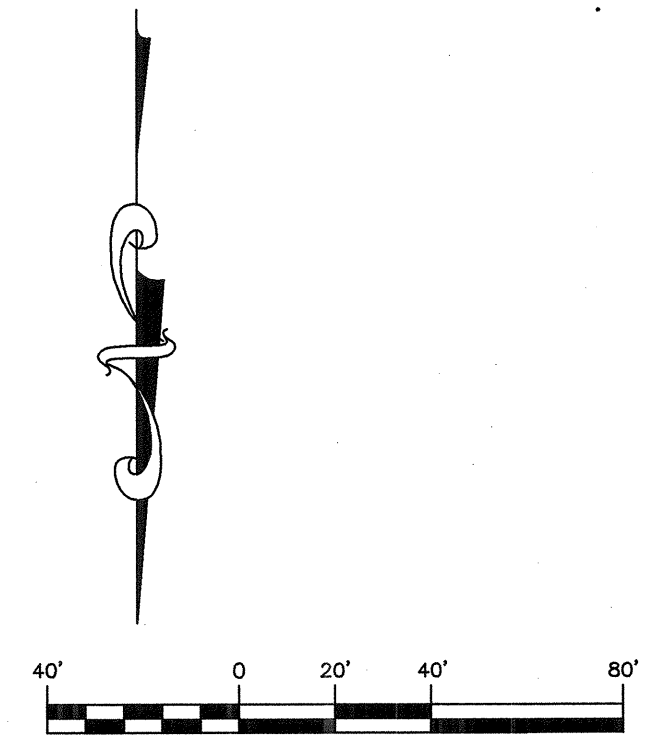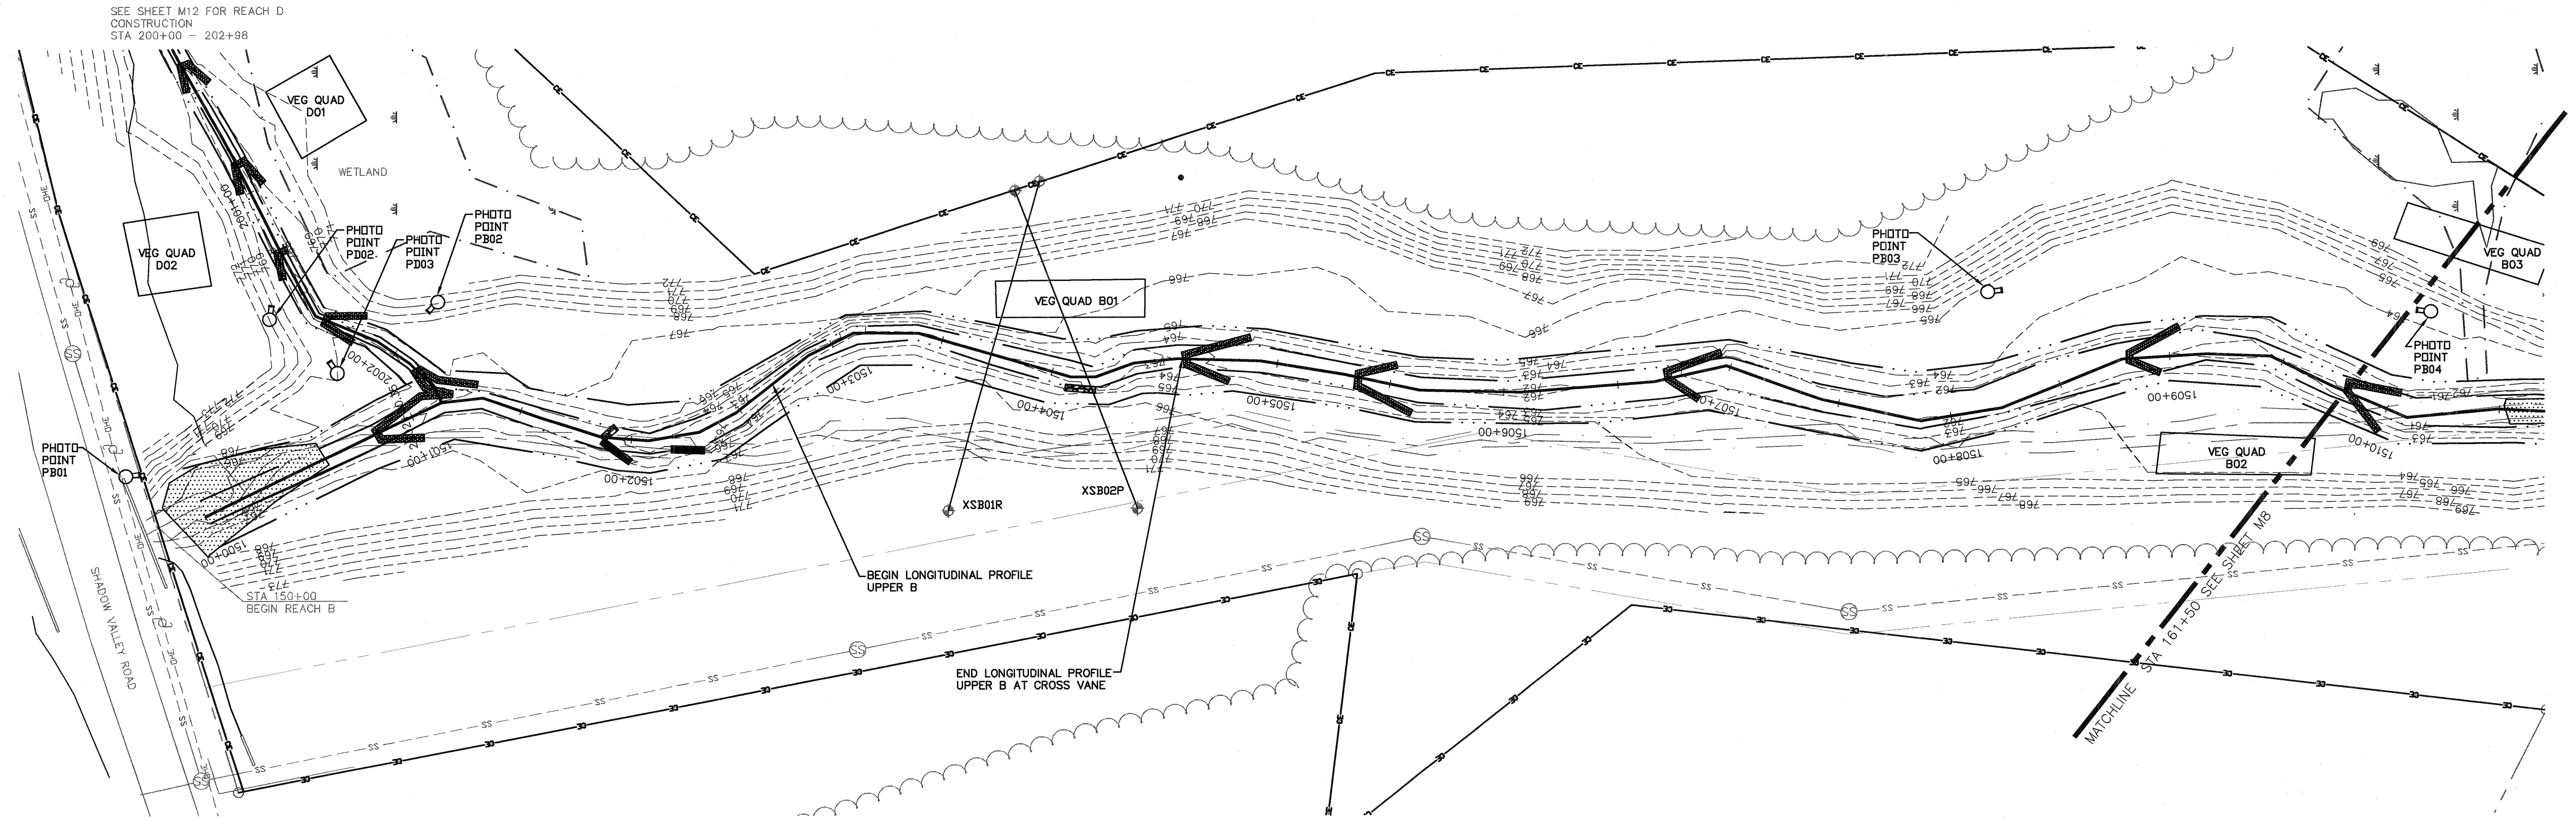

RECORD DOCUMENT

REV. No.	REVISION	DATE	DRAWN BY	CHECKED BY

PREPARED IN THE OFFICE OF:



Kimley-Horn and Associates, Inc.
 NC LICENSE #F-0102
 P.O. BOX 33068 - RALEIGH, NORTH CAROLINA 27636-3068
 PHONE: (919) 677-2000 FAX: (919) 677-2050

CLIENT: **NC-EEP**

TITLE: **MONITORING PLAN REACH B**




DATE: 01-28-10
 HORIZONTAL SCALE:
 VERTICAL SCALE:
 DRAWN BY: JIK
 DESIGNED BY: ARK/JCD
 CHECKED BY: WRW

PROJECT: **VALLEY FIELDS FARM**

ATTACHED REFERENCE FILES:
 JOB NUMBER: 011795020
 SHEET NUMBER: **M7**

This document, together with the concepts and designs presented herein, as an instrument of service, is intended only for the specific purpose and client for which it was prepared. Reuse of and improper reliance on this document without written authorization and adaptation by Kimley-Horn and Associates, Inc. shall be without liability to Kimley-Horn and Associates, Inc. Copyright Kimley-Horn and Associates, Inc., 2010.

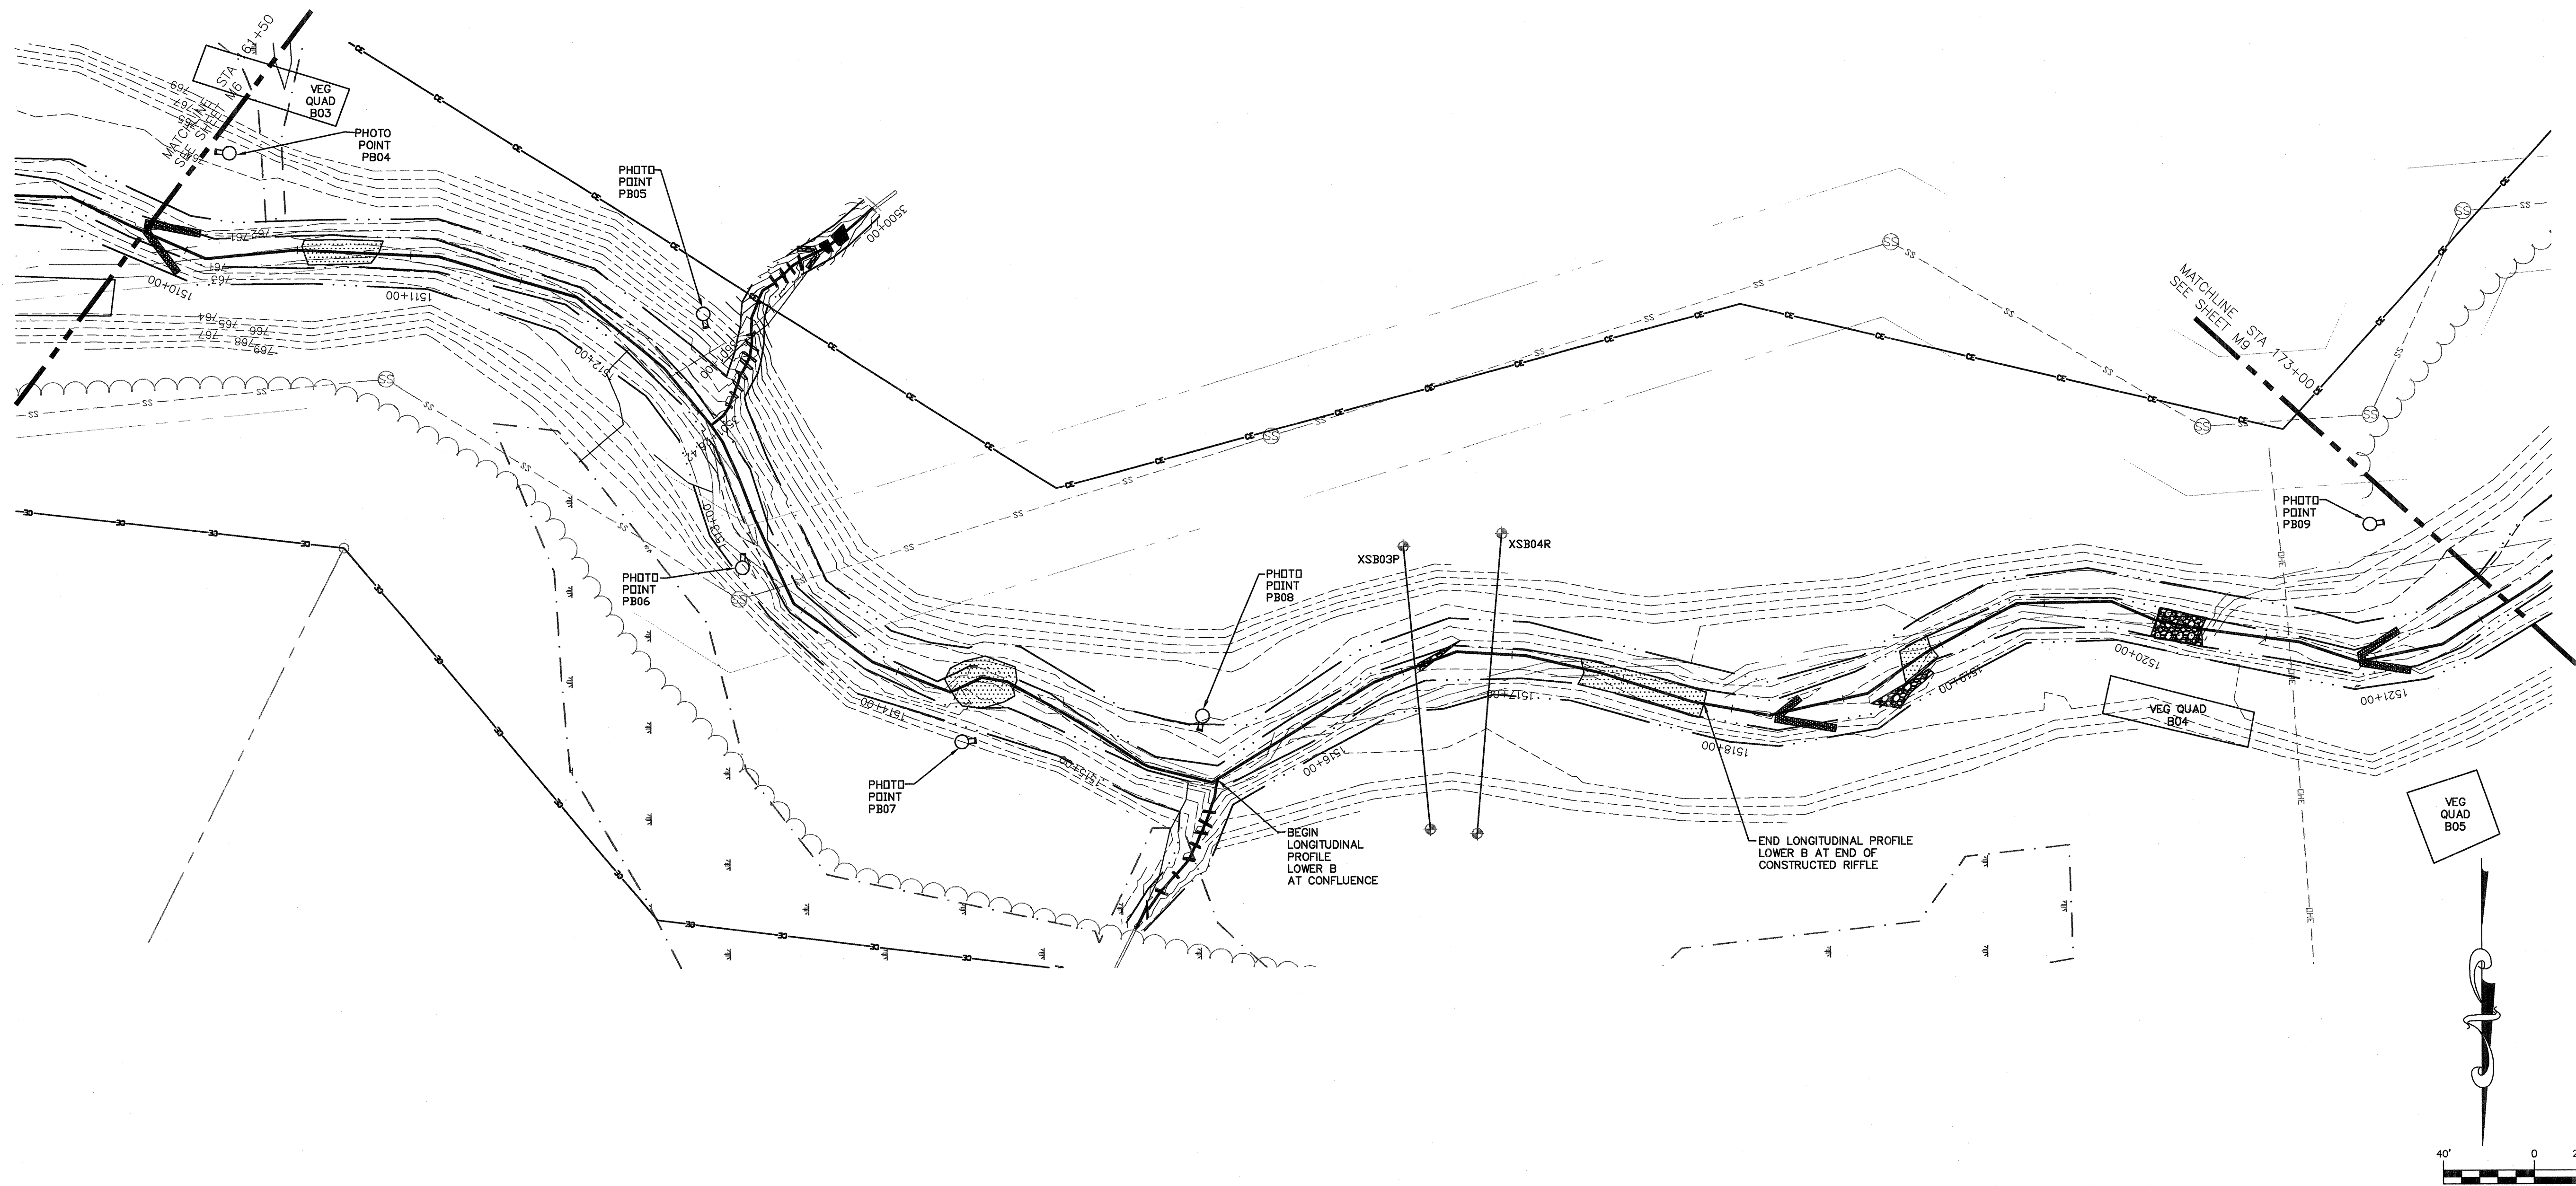

RECORD DOCUMENT

REV. No.	REVISION	DATE	DRAWN BY	CHECKED BY

This document, together with the concepts and designs presented herein, as an instrument of service, is intended only for the specific purpose and client for which it was prepared. Reuse of and improper reliance on this document without written authorization and adaptation by Kimley-Horn and Associates, Inc., shall be without liability to Kimley-Horn and Associates, Inc. Copyright Kimley-Horn and Associates, Inc., 2010

PREPARED IN THE OFFICE OF:

Kimley-Horn and Associates, Inc.

NC LICENSE #F-0102
 P.O. BOX 33068 - RALEIGH, NORTH CAROLINA 27636-3068
 PHONE: (919) 677-2000 FAX: (919) 677-2050

CLIENT: **NC-EEP**

TITLE: **MONITORING PLAN REACH B**


DATE: 01-28-10
 HORIZONTAL SCALE:
 VERTICAL SCALE:
 DRAWN BY: JJK
 DESIGNED BY: ARK/JCD
 CHECKED BY: WRW

PROJECT: **VALLEY FIELDS FARM**

ATTACHED REFERENCE FILES:

JOB NUMBER: 011795020

SHEET NUMBER: **M8**

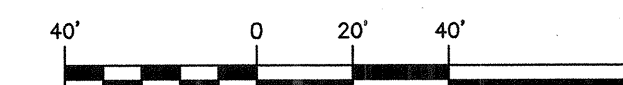

RECORD DOCUMENT

REV. No.	REVISION	DATE	DRAWN BY	CHECKED BY

PREPARED IN THE OFFICE OF:



Kimley-Horn and Associates, Inc.
 NC LICENSE # 0102
 P.O. BOX 33068 - RALEIGH, NORTH CAROLINA 27636-3068
 PHONE: (919) 677-2000 FAX: (919) 677-2050

CLIENT: **NC-EEP**

TITLE: **MONITORING PLAN REACH B**




DATE: 01-28-10
 HORIZONTAL SCALE:
 VERTICAL SCALE:
 DRAWN BY: JJK
 DESIGNED BY: ARK/JCD
 CHECKED BY: WRW


PROJECT: **VALLEY FIELDS FARM**

ATTACHED REFERENCE FILES:
 JOB NUMBER: 011795020
 SHEET NUMBER: **M9**

This document, together with the concepts and designs presented herein, as an instrument of service, is intended only for the specific purpose and client for which it was prepared. Reuse of and improper reliance on this document without written authorization and adaptation by Kimley-Horn and Associates, Inc., shall be without liability to Kimley-Horn and Associates, Inc. Copyright Kimley-Horn and Associates, Inc., 2010

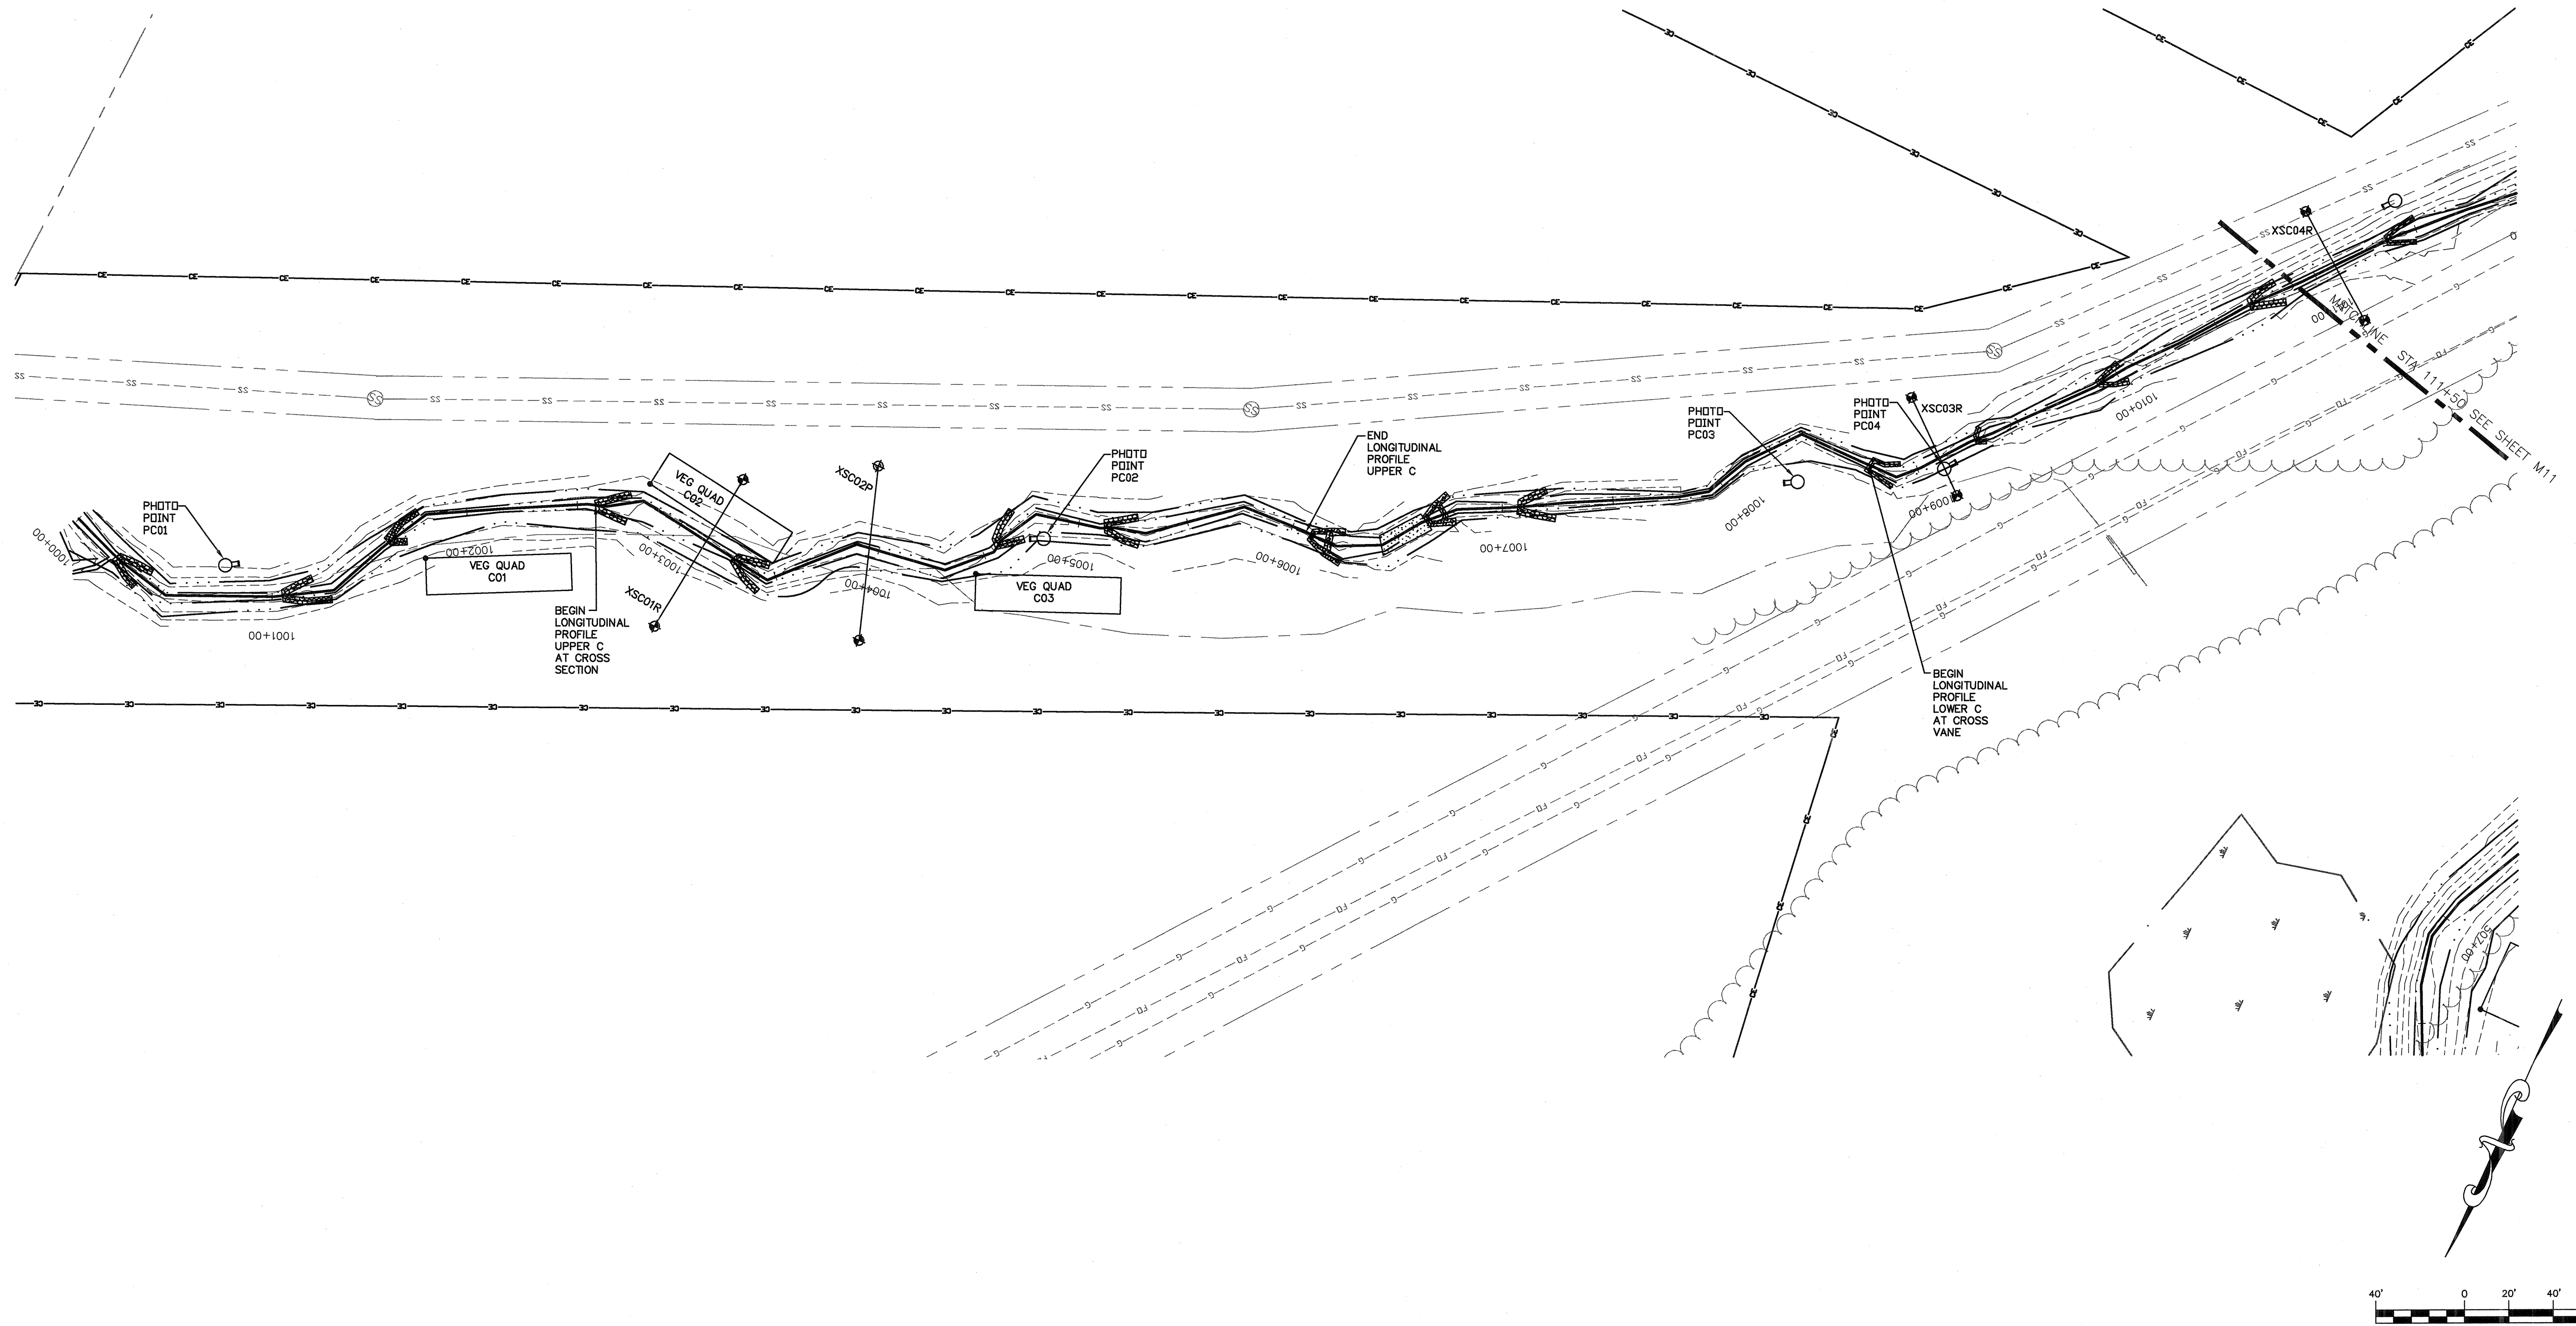

RECORD DOCUMENT

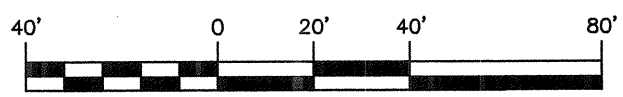

REV. No.	REVISION	DATE	DRAWN BY	CHECKED BY
1	CORRECTED ELEVATION	11-09-07	JIK	DMP
2	REVISED DUE TO FIELD LOCATION OF GAS PIPELINE	11-01-07	JIK	WRW

PREPARED IN THE OFFICE OF:

Kimley-Horn and Associates, Inc.
 NC LICENSE #F-0102
 P.O. BOX 33068 - RALEIGH, NORTH CAROLINA 27636-3068
 PHONE: (919) 677-2000 FAX: (919) 677-2050

CLIENT: **NC-EEP**



TITLE: **MONITORING PLAN REACH C**

DATE: 01-28-10
 HORIZONTAL SCALE:
 VERTICAL SCALE:
 DRAWN BY: JIK
 DESIGNED BY: ARK/JCD
 CHECKED BY: WRW

PROJECT: **VALLEY FIELDS FARM**

ATTACHED REFERENCE FILES:
 JOB NUMBER: 011795020
 SHEET NUMBER: **M10**

This document, together with the concepts and designs presented herein, as an instrument of service, is intended only for the specific purpose and client for which it was prepared. Reuse of and improper reliance on this document without written authorization and adaptation by Kimley-Horn and Associates, Inc., shall be without liability to Kimley-Horn and Associates, Inc. Copyright Kimley-Horn and Associates, Inc., 2010

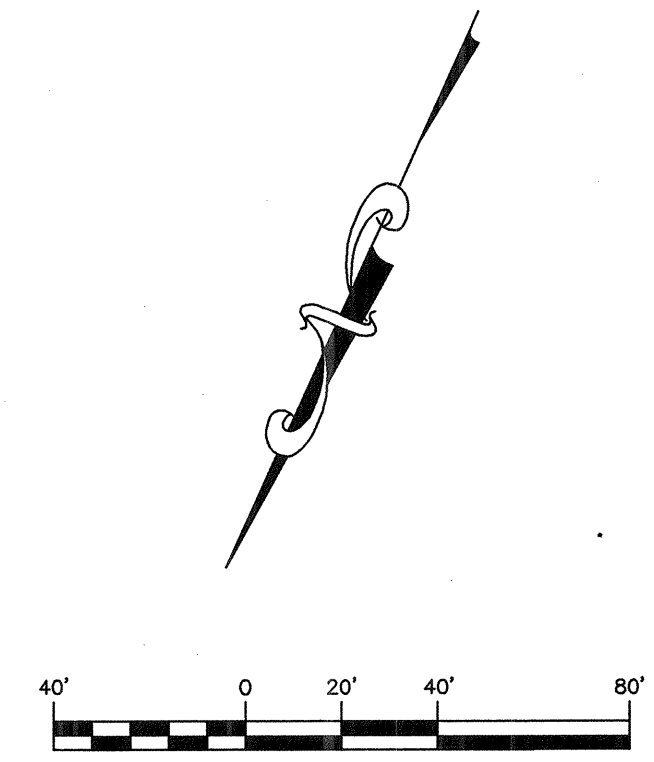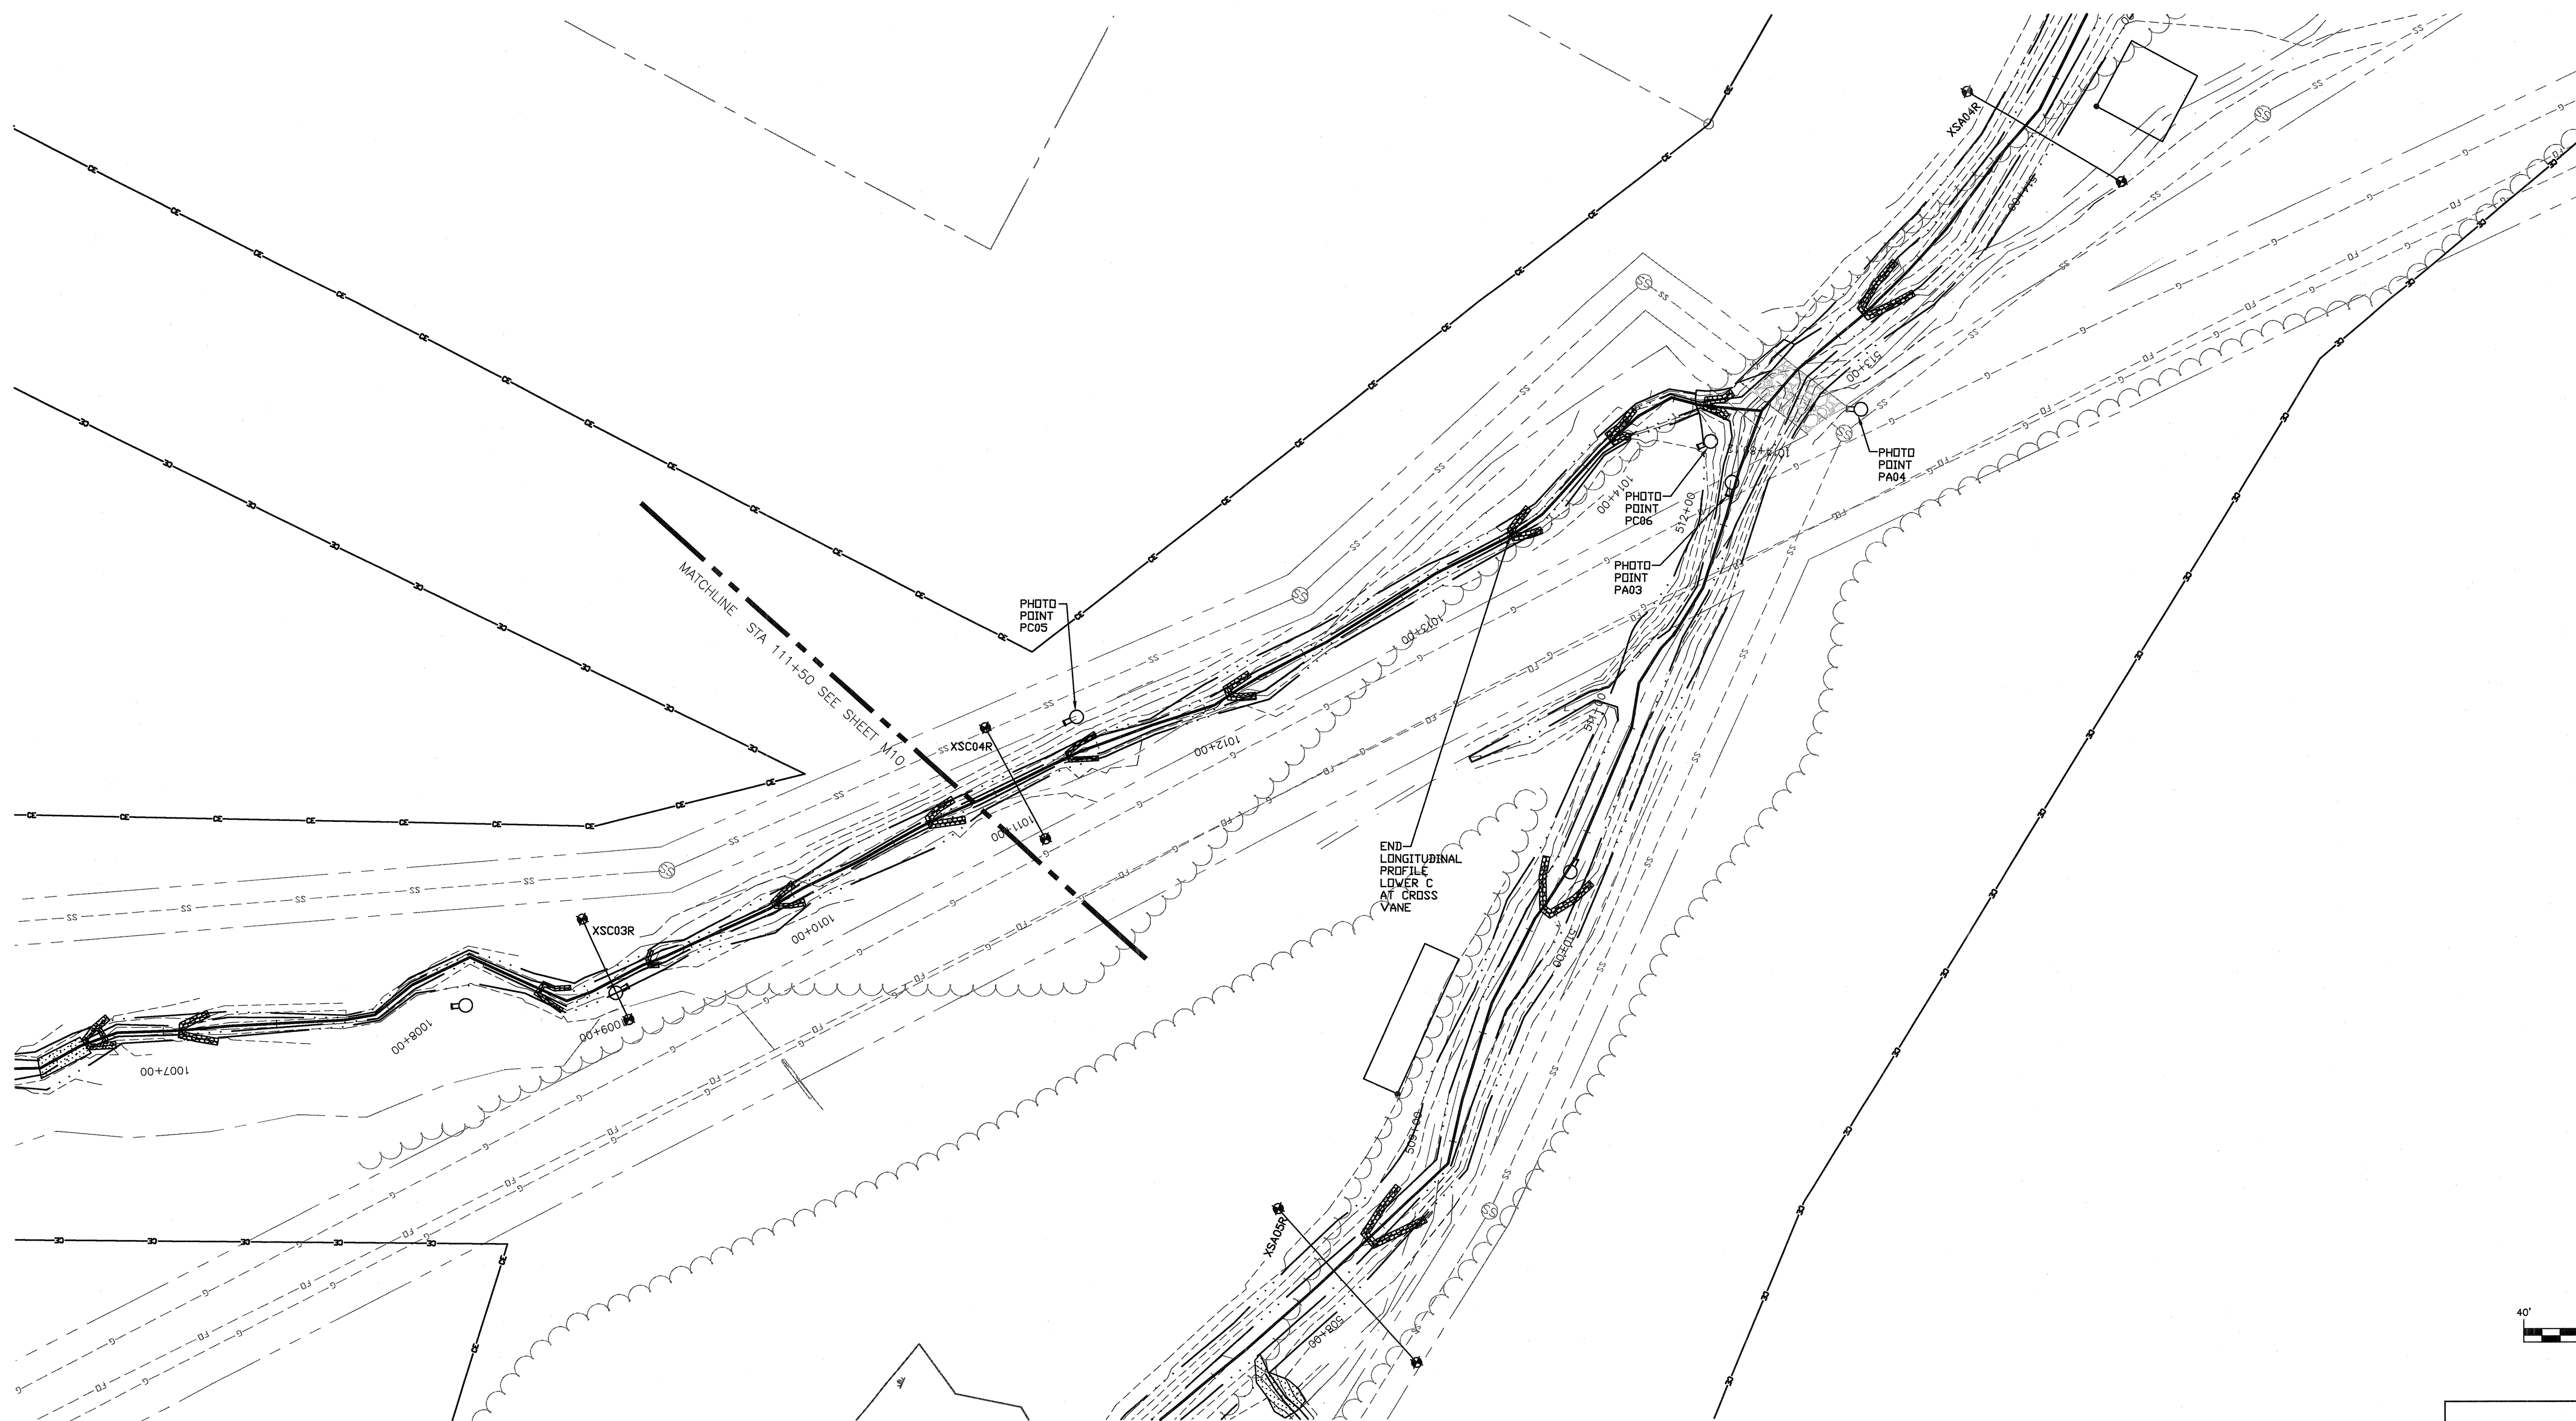

RECORD DOCUMENT

REV. No.	REVISION	DATE	DRAWN BY	CHECKED BY
1	REVISED DUE TO FIELD LOCATION OF GAS PIPELINE	11-01-07	JIK	WRW

This document, together with the concepts and designs presented herein, as an instrument of service, is intended only for the specific purpose and client for which it was prepared. Reuse of and improper reliance on this document without written authorization and adaptation by Kimley-Horn and Associates, Inc., shall be without liability to Kimley-Horn and Associates, Inc.
Copyright Kimley-Horn and Associates, Inc., 2010



PREPARED IN THE OFFICE OF:

Kimley-Horn and Associates, Inc.
 NC LICENSE #F-0102
 P.O. BOX 33068 - RALEIGH, NORTH CAROLINA 27636-3068
 PHONE: (919) 677-2000 FAX: (919) 677-2050

CLIENT: **NC-EEP**

TITLE: **MONITORING PLAN REACH C**

DATE: 01-28-10	PROJECT: VALLEY FIELDS FARM
HORIZONTAL SCALE:	
VERTICAL SCALE:	
DRAWN BY: JIK	
DESIGNED BY: ARK/JCD	
CHECKED BY: WRW	
ATTACHED REFERENCE FILES:	
JOB NUMBER: 011795020	SHEET NUMBER: M11

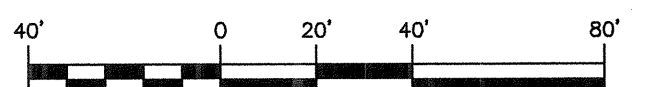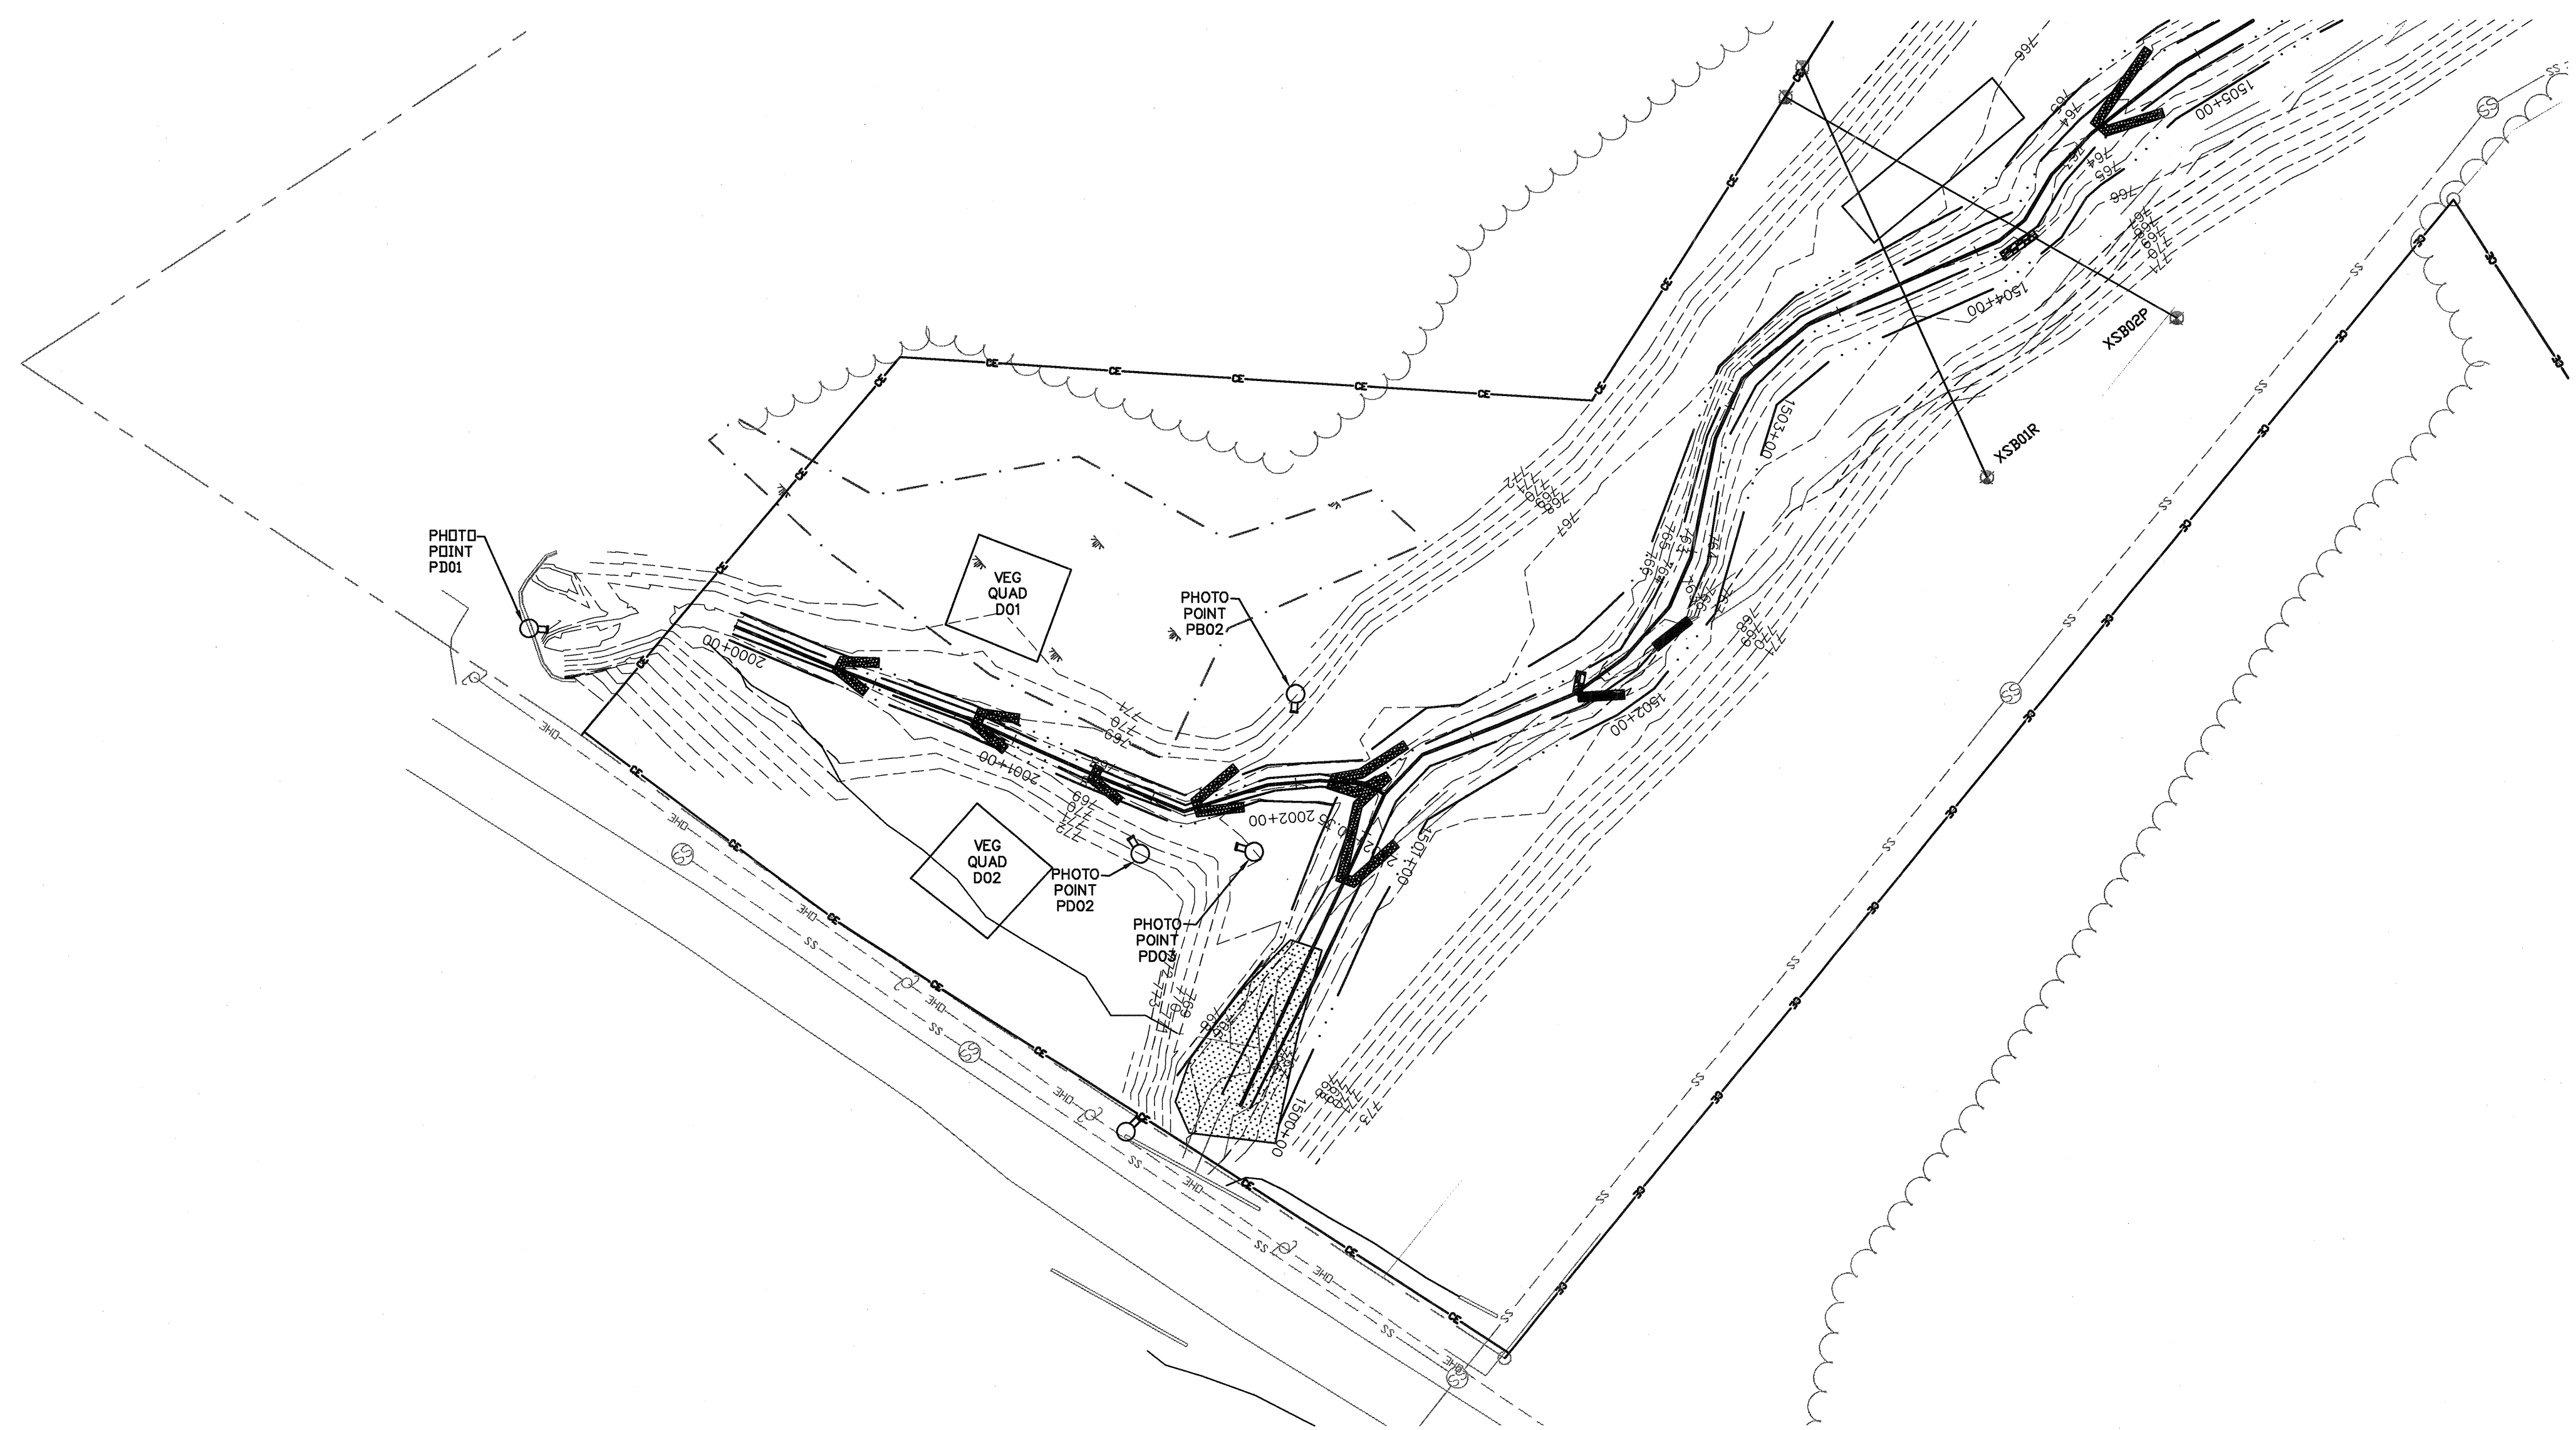

RECORD DOCUMENT

REV. No.	REVISION	DATE	DRAWN BY	CHECKED BY

This document, together with the concepts and designs presented herein, as an instrument of service, is intended only for the specific purpose and client for which it was prepared. Reuse of and improper reliance on this document without written authorization and adaptation by Kimley-Horn and Associates, Inc., shall be without liability to Kimley-Horn and Associates, Inc.
Copyright Kimley-Horn and Associates, Inc., 2010

PREPARED IN THE OFFICE OF:




**Kimley-Horn
and Associates, Inc.**

NC LICENSE #F-0102
P.O. BOX 33068 - RALEIGH, NORTH CAROLINA 27636-3068
PHONE: (919) 677-2000 FAX: (919) 677-2050

CLIENT: **NC-EEP**



TITLE: **MONITORING PLAN
REACH D**

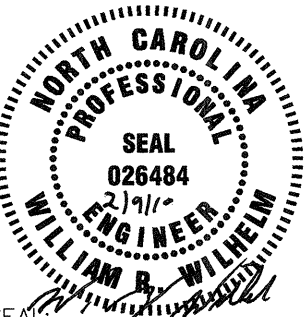

DATE: 01-28-10
HORIZONTAL SCALE:
VERTICAL SCALE:
DRAWN BY: JIK
DESIGNED BY: ARK/JCD
CHECKED BY: WRW

PROJECT: **VALLEY FIELDS FARM**

ATTACHED REFERENCE FILES:
JOB NUMBER: 011795020
SHEET NUMBER: **M12**

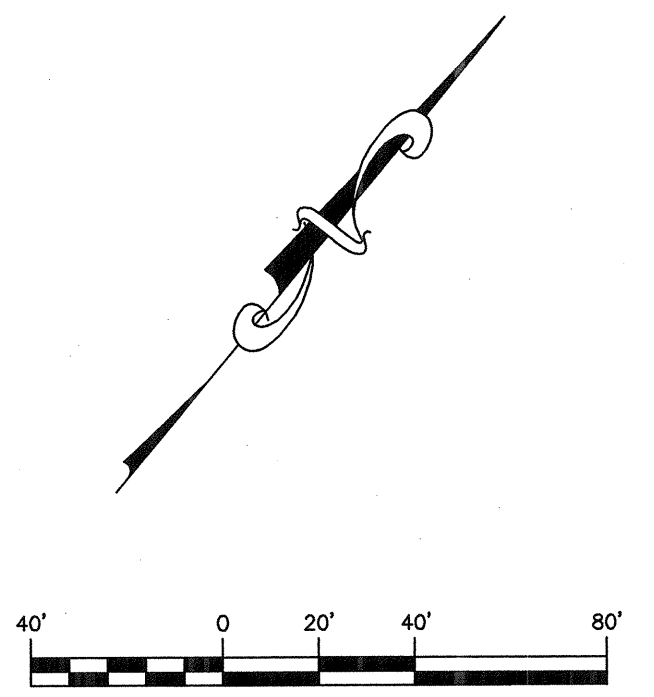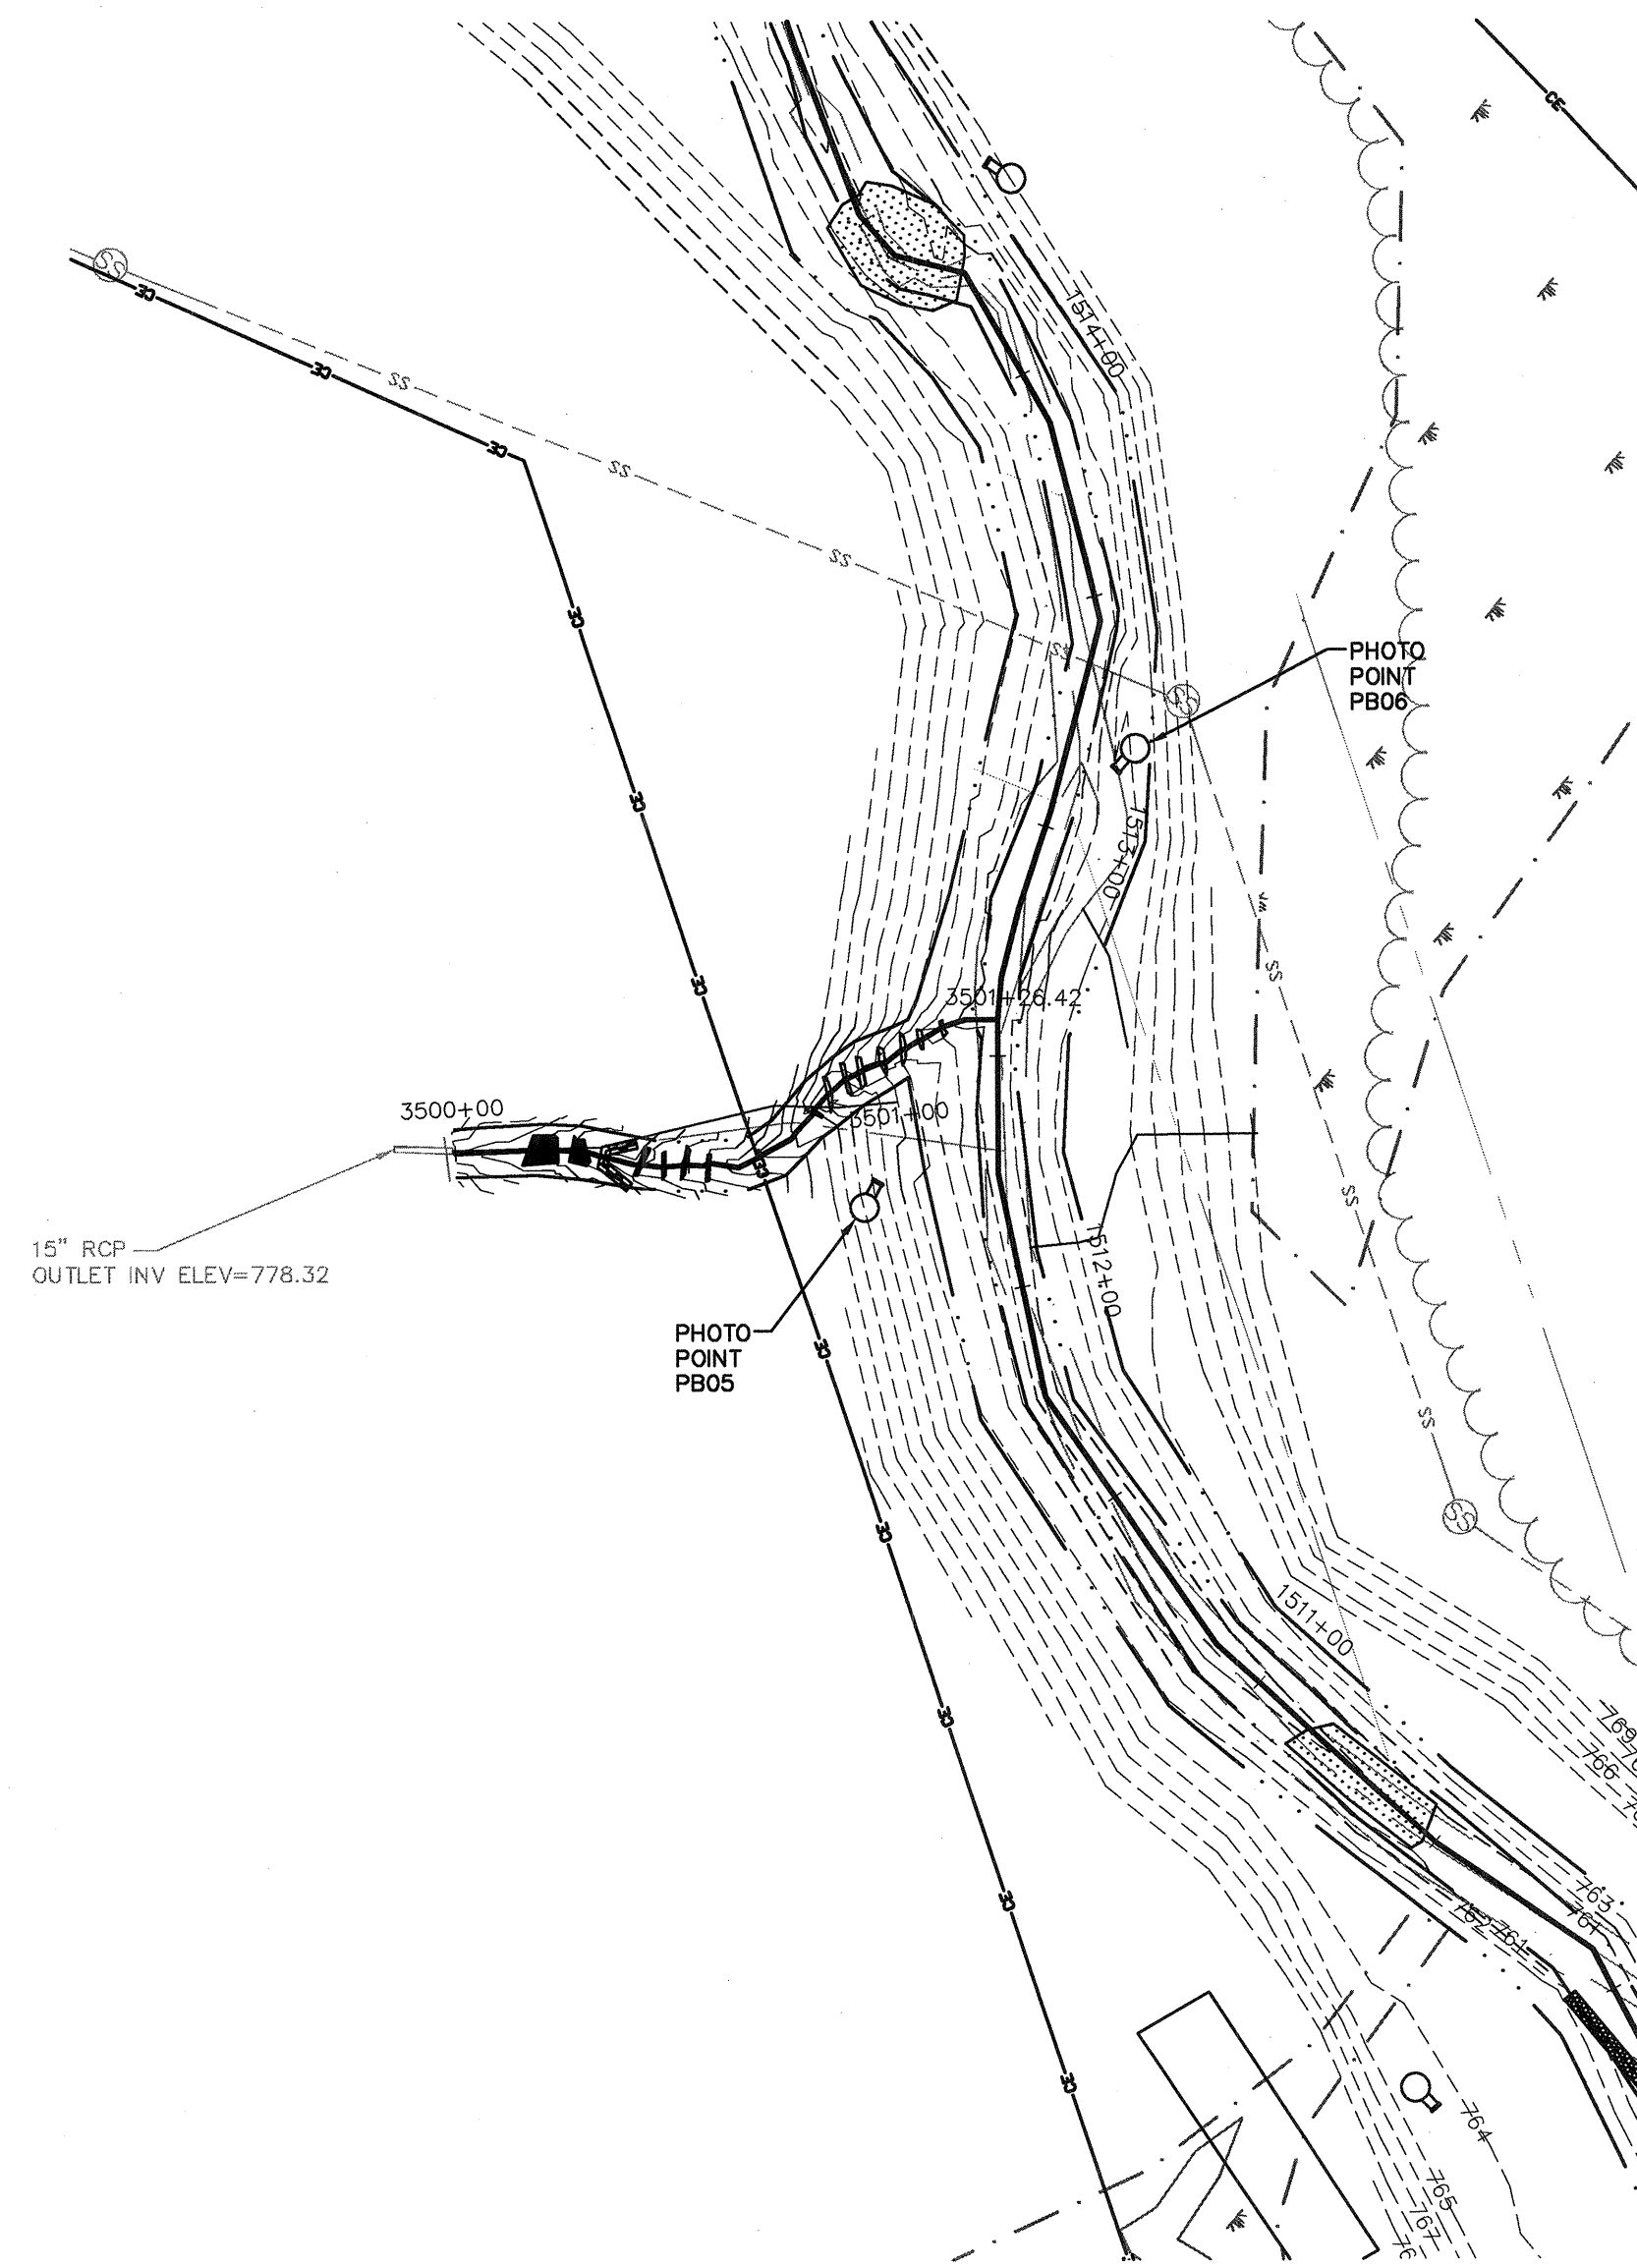

RECORD DOCUMENT

REV. No.	REVISION	DATE	DRAWN BY	CHECKED BY

This document, together with the concepts and designs presented herein, as an instrument of service, is intended only for the specific purpose and client for which it was prepared. Reuse of and improper reliance on this document without written authorization and adaptation by Kimley-Horn and Associates, Inc., shall be without liability to Kimley-Horn and Associates, Inc.
Copyright Kimley-Horn and Associates, Inc., 2010

PREPARED IN THE OFFICE OF:

**Kimley-Horn
and Associates, Inc.**

NC LICENSE #F-0102
P.O. BOX 33068 - RALEIGH, NORTH CAROLINA 27636-3068
PHONE: (919) 677-2000 FAX: (919) 677-2050

CLIENT: **NC-EEP**

TITLE: **MONITORING PLAN
REACH J**


DATE: 01-28-10
HORIZONTAL SCALE:
VERTICAL SCALE:
DRAWN BY: JJK
DESIGNED BY: ARK/JCD
CHECKED BY: WRW

PROJECT: **VALLEY FIELDS FARM**

ATTACHED REFERENCE FILES:
JOB NUMBER: 011795020
SHEET NUMBER: **M13**

February 09, 2010 - 1:10pm By: nancy.mumford

K:\CHL_Environmental\011795 EEP Raleigh\020 Valley Field Farm\CADD\Record Drawings - 01-2010\BlackandWhite\7-MONITOR-WETLAND.dwg

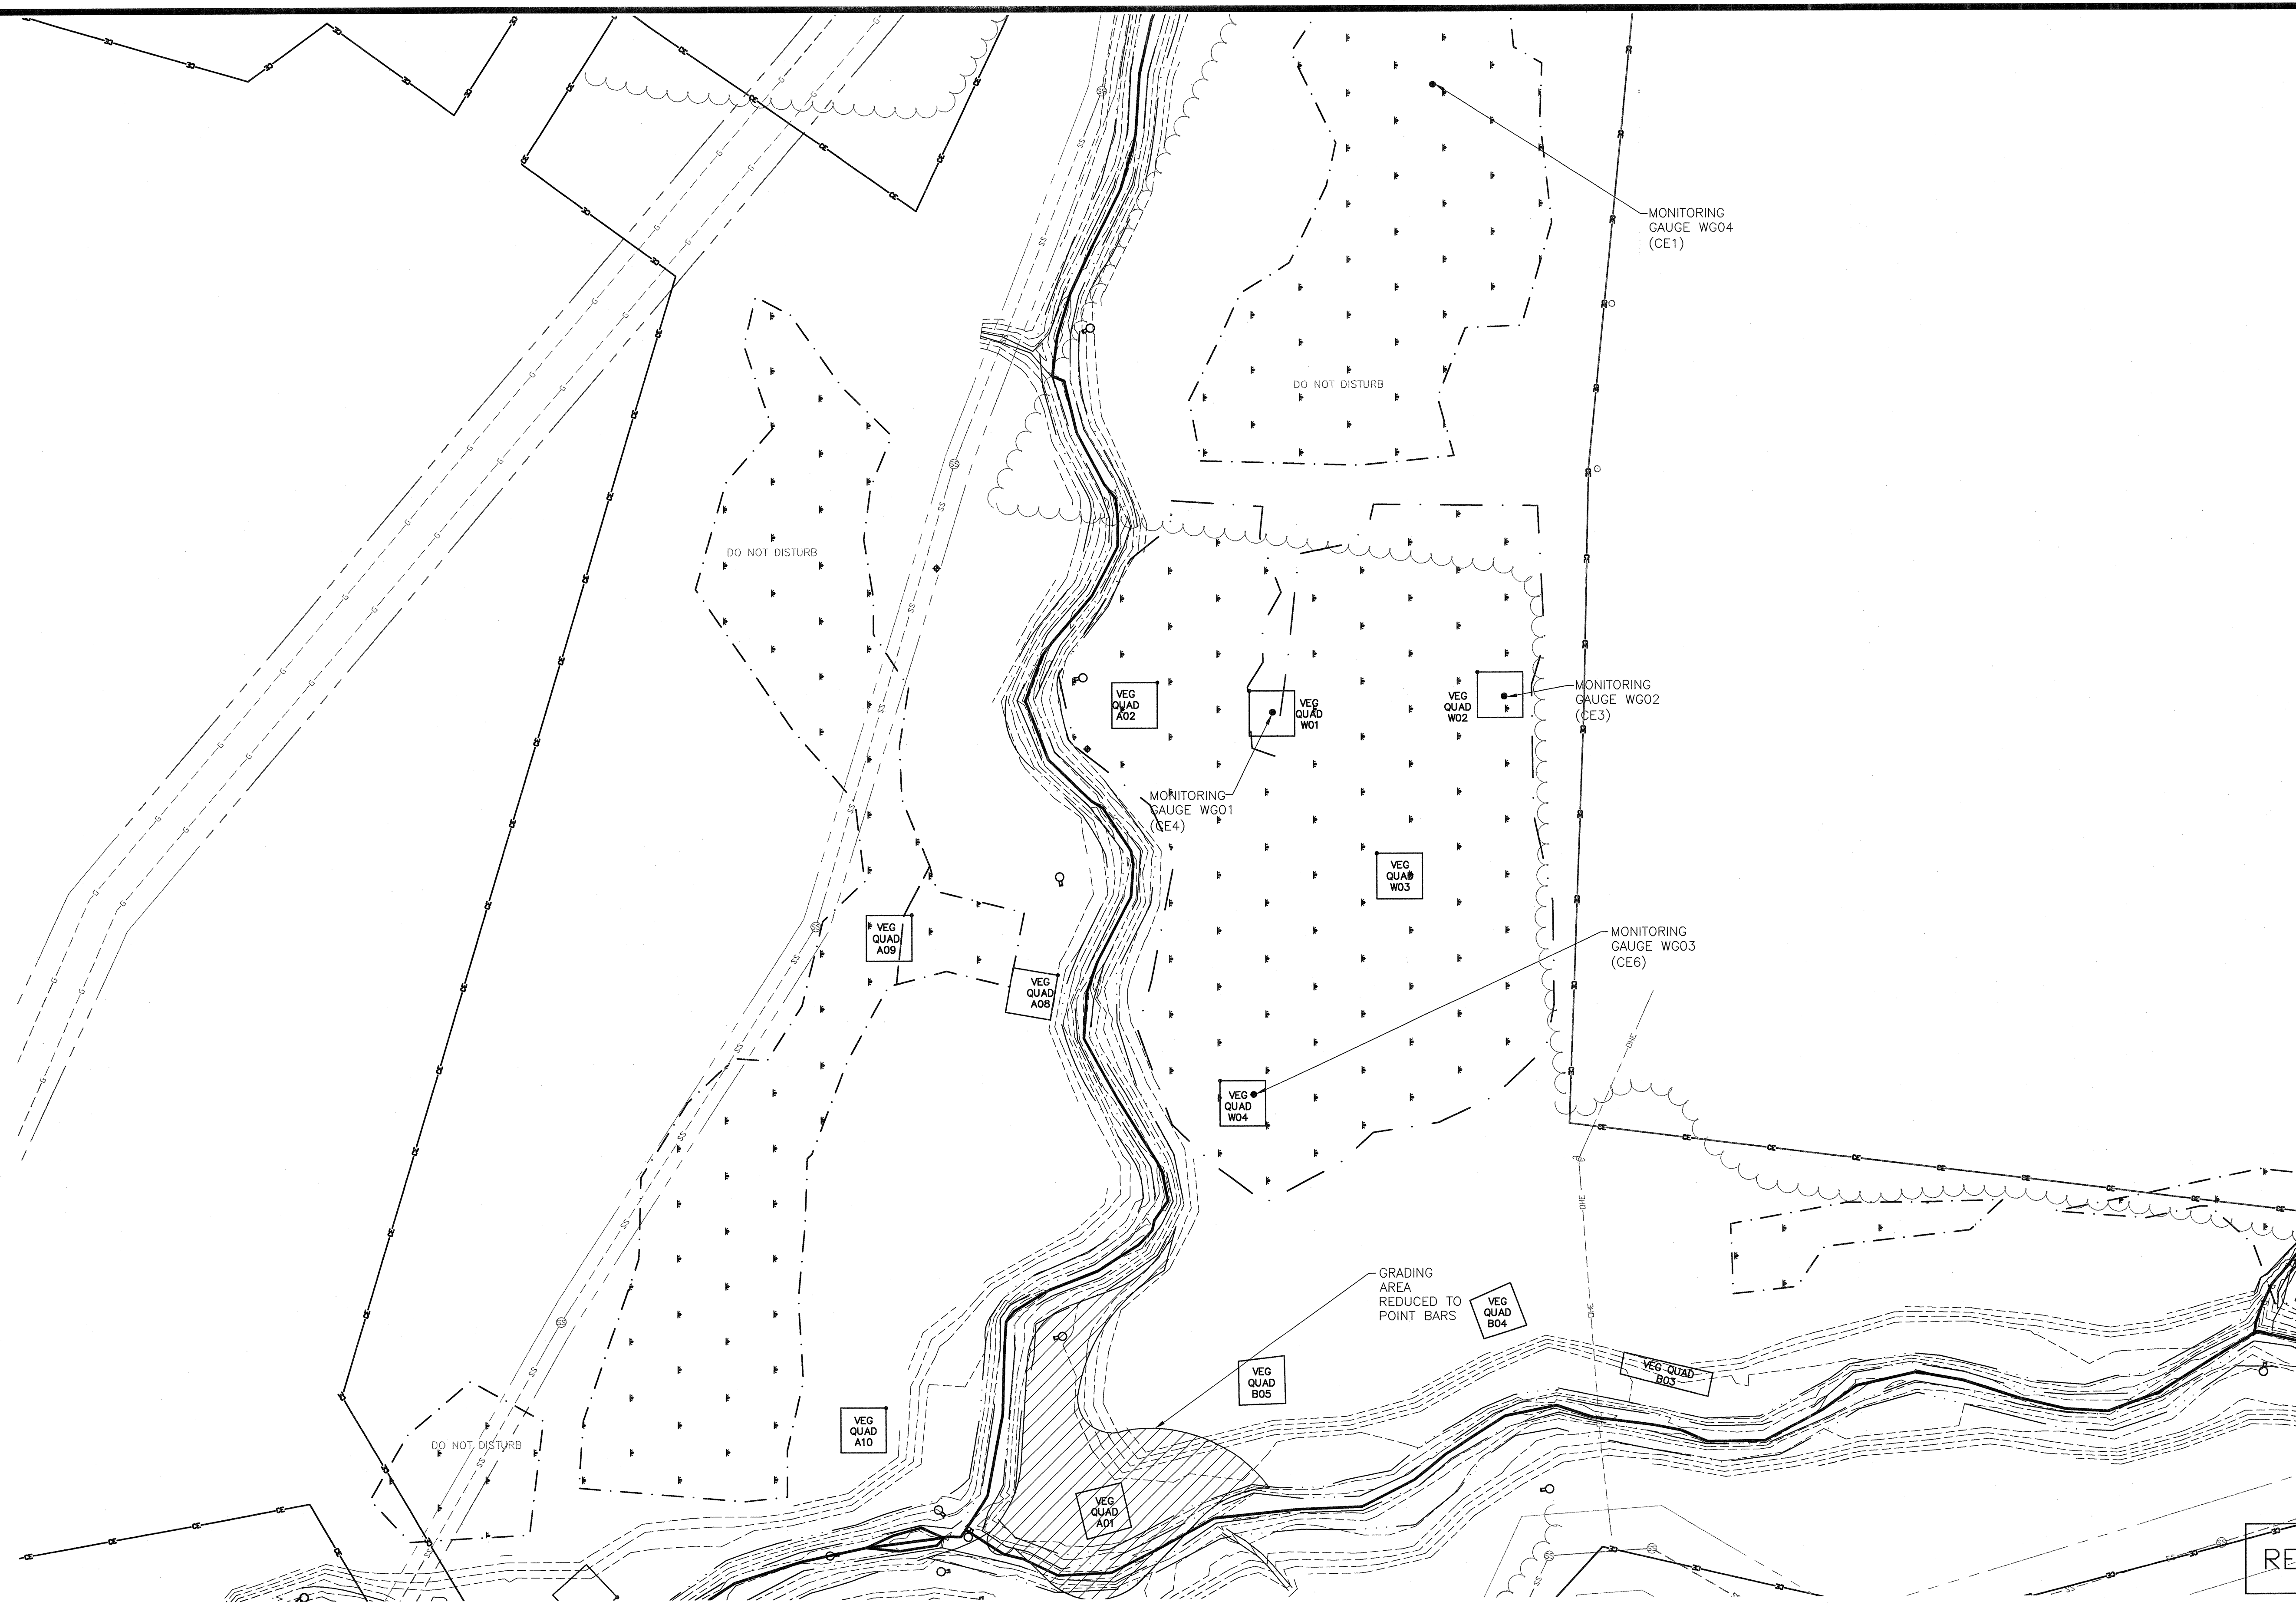

RECORD DOCUMENT

REV. No.	REVISION	DATE	DRAWN BY	CHECKED BY

PREPARED IN THE OFFICE OF:




**Kimley-Horn
and Associates, Inc.**

NC LICENSE #F-0102
P.O. BOX 33068 - RALEIGH, NORTH CAROLINA 27636-3068
PHONE: (919) 677-2000 FAX: (919) 677-2050

CLIENT: **NC-EEP**

TITLE: **WETLAND
MONITORING PLAN**

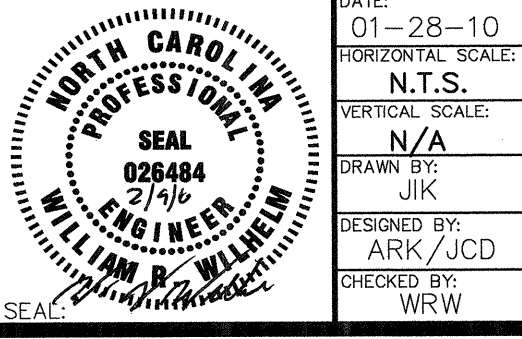


DATE: 01-28-10
HORIZONTAL SCALE: N.T.S.
VERTICAL SCALE: N/A
DRAWN BY: JIK
DESIGNED BY: ARK/JCD
CHECKED BY: WRW







PROJECT: **VALLEY FIELDS FARM**


ATTACHED REFERENCE FILES: _____
JOB NUMBER: 011795020
SHEET NUMBER: **M14**

This document, together with the concepts and designs presented herein, as an instrument of service, is intended only for the specific purpose and client for which it was prepared. Reuse of and improper reliance on this document without written authorization and adaptation by Kimley-Horn and Associates, Inc., shall be without liability to Kimley-Horn and Associates, Inc.
Copyright Kimley-Horn and Associates, Inc., 2010

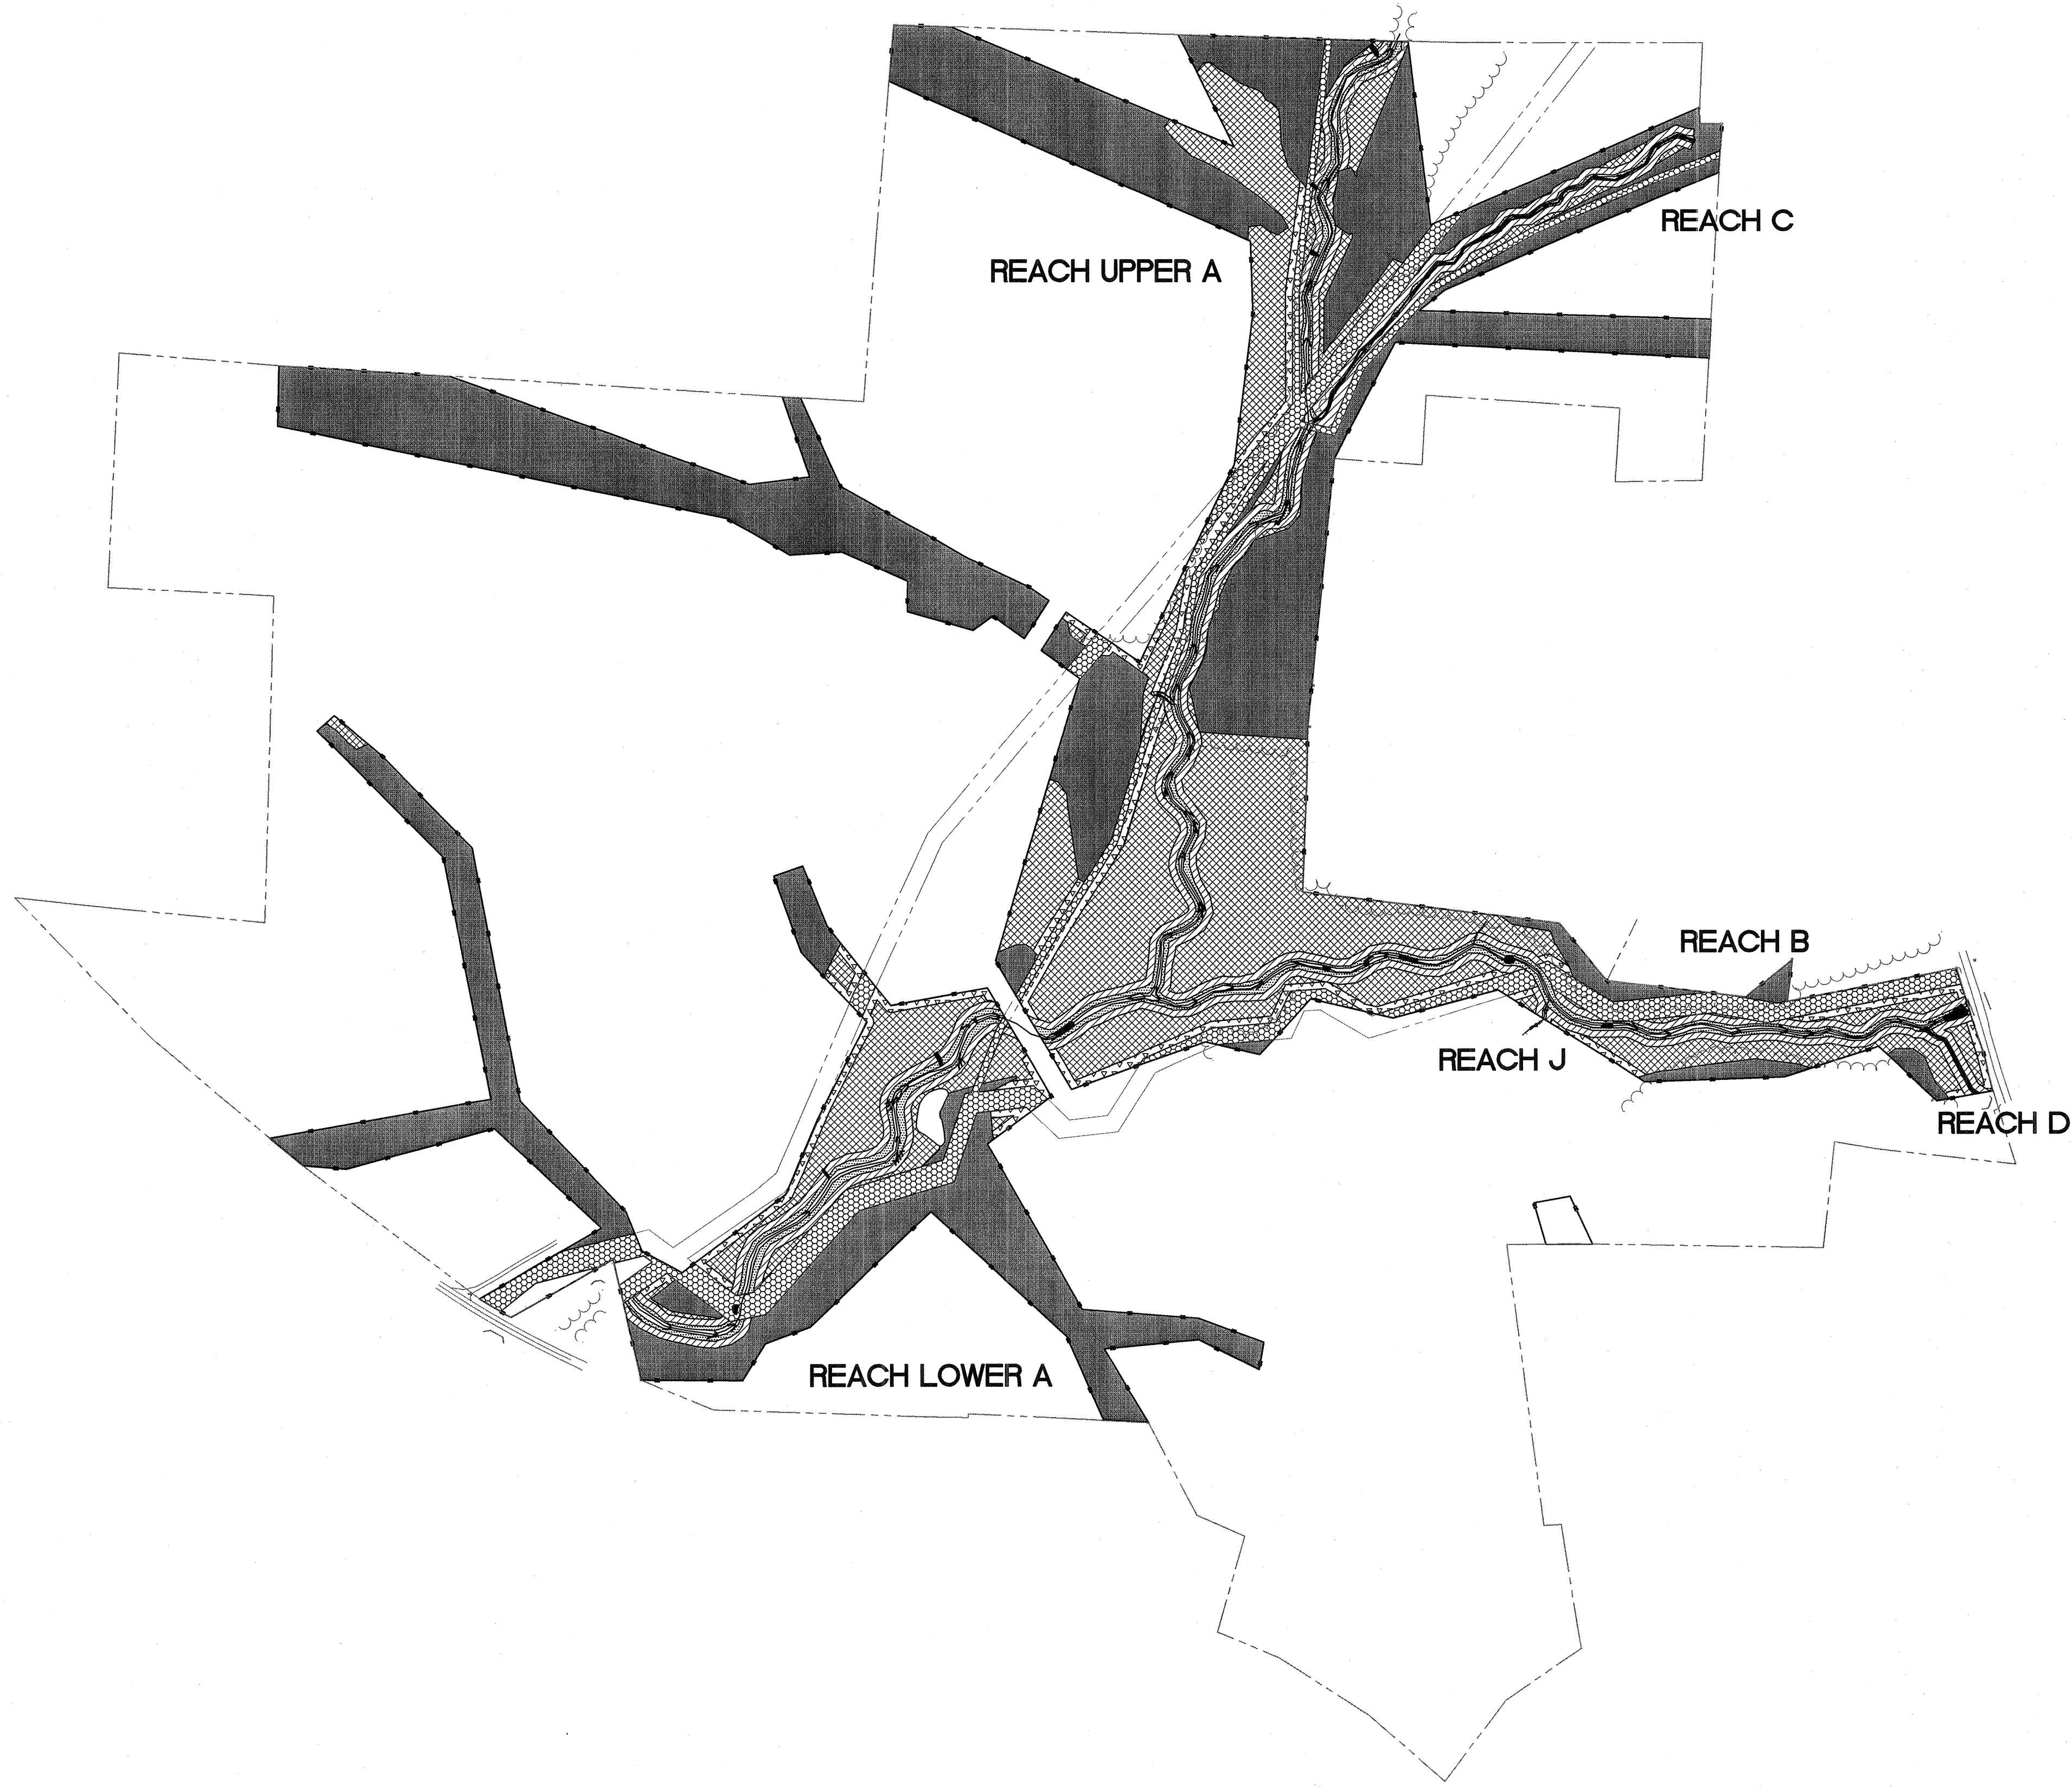

PLANTING PLAN LEGEND

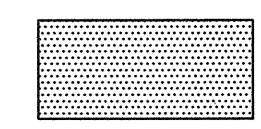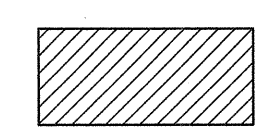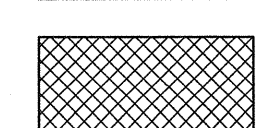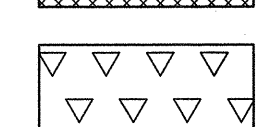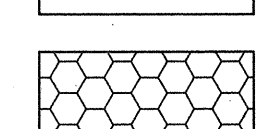-  ZONE 1
-  ZONE 2
-  ZONE 3
-  ZONE 4
-  ZONE 5 (UTILITY EASEMENT)
-  EXISTING VEGETATION (TO BE LEFT UNDISTURBED)

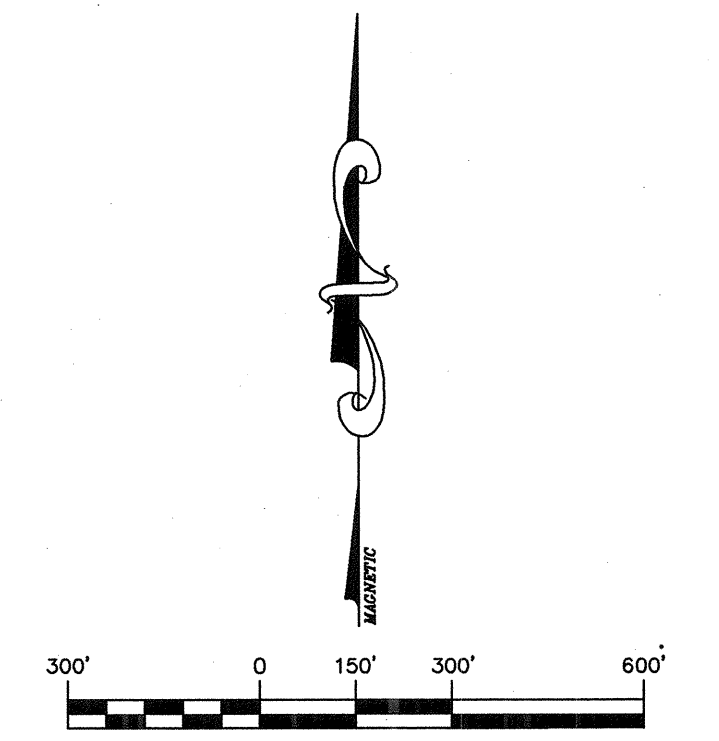

RECORD DOCUMENT

REV. No.	REVISION	DATE	DRAWN BY	CHECKED BY

This document, together with the concepts and designs presented herein, as an instrument of service, is intended only for the specific purpose and client for which it was prepared. Reuse of and improper reliance on this document without written authorization and adaptation by Kimley-Horn and Associates, Inc., shall be without liability to Kimley-Horn and Associates, Inc. Copyright Kimley-Horn and Associates, Inc., 2010


PREPARED IN THE OFFICE OF:



Kimley-Horn and Associates, Inc.
 NC LICENSE # F-0102
 P.O. BOX 33068 - RALEIGH, NORTH CAROLINA 27636-3068
 PHONE: (919) 677-2000 FAX: (919) 677-2050

CLIENT: **NC-EEP**

TITLE: **VEGETATION PLAN**



DATE: 01-28-10
 HORIZONTAL SCALE:
 VERTICAL SCALE:
 DRAWN BY: JJK
 DESIGNED BY: ARK/JCD
 CHECKED BY: WRW

PROJECT: **VALLEY FIELDS FARM**

ATTACHED REFERENCE FILES: _____

JOB NUMBER: 011795020

SHEET NUMBER: VI