

# **MY0 MONITORING REPORT**

## **Wits End Stream and Wetland Mitigation Site**

Union County, North Carolina

Yadkin River Basin

Cataloging Unit 03040105

DMS Project No. 100164

Full Delivery Contract No. 7968

DMS RFQ No. 16-032819-YD05 (Date of Issue: May 9, 2019)

USACE Action ID No. SAW-2020-00455

DWR Project No. 20200369

Data Collection: February 2023

Submission: April 2023



**Prepared for:**

NORTH CAROLINA DEPARTMENT OF ENVIRONMENTAL QUALITY

DIVISION OF MITIGATION SERVICES

1652 MAIL SERVICE CENTER

RALEIGH, NORTH CAROLINA 27699-1652





## Response to DMS Comments

DMS Project ID No. 100164  
Full Delivery Contract No. 7968  
USACE Action ID No. SAW-2020-00455  
DWR Project No. 2020-0369  
IFB 16-032819, RFQ 16-032819-YD05

Comments Received (Black Text) & Responses (Blue Text)

### General

1. The assets requested in Table 1 are different than the approved Mitigation Plan. The total stream assets were reduced by 227.162 SMUs and the wetlands reduced by .053 WMUs. The majority of changes are due to a change in the alignment of UT3 during construction. The alignment change resulted in a change in approach level, reduction in wetland reestablishment, and changes to the buffer and benthic credit calculations. ATV paths and forded crossings were also not constructed and removed from conservation easement. Credit in these sections is now being requested. These changes will require a Mitigation Plan Addendum be submitted to the IRT for review and approval. Please provide this addendum with the revised MYO along with comment responses behind the title page.

Response: A Mitigation Plan Addendum will be submitted along with MYO Report for IRT review.

### Title Page:

1. Please change RFP to RFQ on the title page and second page and add (Date of Issue: May 9, 2019) after the RFQ number.  
Response: "RFP" was revised to "RFQ" and the date of issue was added.
2. Table of Contents: Please add section 2.2 Site Planting Effort to Table of Contents.  
Response: The table of contents was updated.
3. Table of Contents: Table 6C. Mitigation Plan Planting Plan and Asbuilt Planting Comparison is mislabeled. Table 6c in Appendix C is titled Permanent Seed Mix – March Treatments, Pools, Seeps. Please update.  
Response: The title of this table was updated in the list of Appendices.
4. Table of Contents: Appendix C section shows Table 9A-D and Table 10A-C. Appendix C on page 60 shows Table 9A-I and 10A-F. Please update for consistency.  
Response: Appendix C contains Tables 9A-I and 10A-F. The document was updated for consistency.
5. Table A: Recommend adding growing season dates to this table. There is a reference to 3/18 – 11/14, 241 days in the Mitigation Plan, but the groundwater gauge graphs show 3/1 – 10/22, 235 days. Please revise as necessary.  
Response: The growing season is modified and is described in detail in Section 8.1 of the approved mitigation plan. Proposed growing season dates are March 1 to November 14, with the March 1 start date to be confirmed by documentation of soil temperature greater than 41°F at 12 inches below the surface and bud burst of two or more different non-evergreen vascular plant species. Footnotes have been added to Table A- Project Success Criteria and Table E- Monitoring Summary. Additionally, preconstruction gauge graphs have been updated.
6. Page 6: Include installation date (July 28, 2022) to the discussion of the 440 1-gallon containerized plants. Please include plant list of 1-gallon plants in Appendix B with other planting lists.  
Response: The date of the containerized planting was added to the discussion, and Table 6A (Appendix B) was revised to include the species and quantities of containerized plantings.

7. Table 6A: Recommend including a % column.  
Response: Percent columns were added to the planted stem tables.
8. Table 6A: Tupelo Gum (*Nyssa aquatica*) was not on the approved mitigation planting list. Please revise.  
Response: A small quantity (500 stems) of *Nyssa aquatica* was planted in the original 2022 planting due to nursery availability, even though it was not on the approved mitigation plan planting list. No *Nyssa aquatica* was counted during MY0 for success.
9. Table 8: Mitigation Plan indicates common buttonbush (*Cephalanthus occidentalis*) and silky dogwood (*Cornus amomum*) are lives stake species. Lives stakes should not be included in vegetation monitoring plots. Please revise.  
Response: Silky dogwood plantings included both bare-root and live-staked stems. Only bare-root stems were counted in vegetation plots.
10. Table 8: Please add Indicator Status for mockernut hickory (*Carya tomentosa*).  
Response: Indicator status was added.
11. Cross sections: Please revise elevation axis labels to show decimal places. For example, XS3 has three entries for 579', five entries for 578', and four entries for 577'.  
Response: Elevations on the cross-section plots have been revised to show 1 decimal place.
12. UT1, UT2, UT3, UT4, UT5 and top of Waxhaw Branch profiles indicate no water is present in the channel. If flow gauge data has been collected in MY0, please include.  
Response: Available stream gauge data is included in Appendix D.
13. Table 11: Please add two lines below MY0 for Stream Survey and Vegetation Survey Dates. Please include the month/year that field work was completed for these tasks and include this information for future monitoring report submittals.  
Response: These rows were added.
14. Appendix A Photolog: Header for Task 5 Planting and Monitoring Devices: Devises is accidentally misspelled in the header.  
Response: The misspelling was corrected.
15. The Asbuilt plan sheet profiles show the stream was constructed lower than the proposed design. Specifically, downstream sections of Waxhaw Branch, UT2, UT3, UT3A, UT4, and UT5. Were the deviations caused by site conditions during construction or was it a survey issue?  
Response: Deviations were not caused by site conditions during construction. Site channels visually appear correctly constructed, which is confirmed by the MY0 cross sections and profile. The deviations (approximately 2 – 4 inches) are likely caused by as-built surveyor conditions, and possible unconsolidated bed material post construction.
16. Please include PLS sealed asbuilt with digital submittal.  
Response: PLS sealed as-built is included with the digital submittal

**Digital Deliverable Review:**

17. Please provide updated shapefile or ID for the stream flow and crest gauge points below for inclusion in database.

<b>FID</b>	<b>Shape *</b>	<b>Id</b>	<b>Gauge Type</b>	<b>POINT_X</b>	<b>POINT_Y</b>
26	Point	0	Stream Flow	34.911724	-80.448368
27	Point	0	Stream Flow	34.912925	-80.447423
28	Point	0	Stream Crest	34.911705	-80.444483
29	Point	0	Stream Flow	34.908282	-80.44228
30	Point	0	Stream Flow	34.908944	-80.444166
31	Point	0	Stream Crest	34.911899	-80.442928
32	Point	0	Stream Crest	34.915294	-80.44433
33	Point	0	Stream Flow	34.917624	-80.442479

Response: [The shapefile was revised to include ID labels for the stream flow and crest gauges.](#)



# **MYO MONITORING REPORT**

## **Wits End Stream and Wetland Mitigation Site**

Union County, North Carolina  
Yadkin River Basin  
Cataloging Unit 03040105

DMS Project No. 100164  
Full Delivery Contract No. 7968  
DMS RFQ No. 16-032819-YD05 (Date of Issue: May 9, 2019)  
USACE Action ID No. SAW-2020-00455  
DWR Project No. 20200369

Data Collection: February 2023  
Submission: April 2023

### **Prepared for:**

NORTH CAROLINA DEPARTMENT OF ENVIRONMENTAL QUALITY  
DIVISION OF MITIGATION SERVICES  
1652 MAIL SERVICE CENTER  
RALEIGH, NORTH CAROLINA 27699-1652




### **Prepared by:**



**Restoration Systems, LLC**  
1101 Haynes Street, Suite 211  
Raleigh, North Carolina 27604  
Contact: Worth Creech  
919-755-9490 (phone)  
919-755-9492 (fax)

**And**

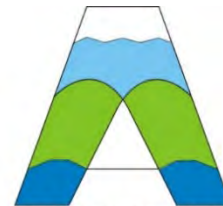

Axiom Environmental, Inc.

**Axiom Environmental, Inc.**  
218 Snow Avenue  
Raleigh, North Carolina 27603  
Contact: Grant Lewis  
919-215-1693 (phone)

## TABLE OF CONTENTS

<b>1</b>	<b>PROJECT SUMMARY</b> .....	<b>1</b>
1.1	Project Background, Components, and Structure .....	1
1.2	Project Success Criteria.....	5
<b>2</b>	<b>AS-BUILT CONDITION (BASELINE)</b> .....	<b>5</b>
2.1	Project Modifications.....	6
2.2	Site Planting Effort .....	8
<b>3</b>	<b>PROJECT MONITORING – METHODS</b> .....	<b>9</b>
3.1	Monitoring .....	9
<b>4</b>	<b>MONITORING YEAR 0 – DATA ASSESSMENT</b> .....	<b>11</b>
4.1	Stream Assessment.....	11
4.2	Hydrology Assessment.....	11
4.3	Vegetative Assessment.....	11
4.4	Monitoring Year 0 Summary.....	11
<b>5</b>	<b>REFERENCES</b> .....	<b>12</b>

## LIST OF REPORT TABLES

Table 1.	Project Mitigation Quantities and Credits .....	2
Table 2.	Summary: Goals, Performance, and Results.....	3
Table 3.	Project Attribute Table.....	4
Table A.	Project Success Criteria.....	5
Table B.	Deviations from Construction Plans .....	6
Table C.	Wits End Planting Dates:.....	8
Table D.	Monitoring Schedule .....	9
Table E.	Monitoring Summary .....	10

## APPENDICES

### Appendix A. Visual Assessment Data

- Figure 1. Current Conditions Plan View
- Table 4A-H. Visual Stream Morphology Stability Assessment Table
- Table 5. Vegetation Condition Assessment Table
- Vegetation Plot Photographs
- Site Photo Log

### Appendix B. Vegetation Plot Data

- Table 6A. Planted Woody Vegetation
- Table 6B. Permanent Seed Mix - Sitewide
- Table 6C. Permanent Seed Mix - Marsh Treatments, Pools, Seeps
- Table 7. Vegetation Plot Counts and Densities
- Table 8. Vegetation Plot Data Table from Vegetation Data Entry Tool

### Appendix C. Stream Geomorphology Data

- Cross-Sections with Annual Overlays
- Longitudinal Profile
- Table 9A-I. Baseline Stream Data Summary Tables
- Table 10A-F. Cross-Section Morphology Monitoring Summary

### Appendix D. Hydrologic Data

- Groundwater Gauge Soil Profiles
- Pre-Construction Groundwater Gauge Data (2020 & 2021)
- Figure 2. Pre-Construction Groundwater Gauge Locations
- Stream Gauge Graphs

### Appendix E. Project Timeline and Contact Info

- Table 11. Project Timeline
- Table 12. Project Contacts

### Appendix F. Other Data

- Figures 3A-B. Stream Buffer Credit Adjustment Output
- Wilmington District Stream Buffer Credit Calculator
- UT 3 Redesign Summary Sheet
- Recorded Release and Removal of Trails from Conservation Easement

### Appendix G. Record Drawings & As-built Survey

## **1 PROJECT SUMMARY**

Restoration Systems, LLC (RS) has established the North Carolina Division of Mitigation Services (NCDMS) Wits End Stream and Wetland Mitigation Site (Site). The Site is on five contiguous parcels in the Carolina Slate Belt portion of the Southeastern Plains ecoregion of North Carolina. Located in the Yadkin River Basin, Cataloging Unit 03040105, the Site is in the Targeted Local Watershed (TLW) 03040105081020 and North Carolina Division of Water Resources [NCDWR] subbasin number 03-07-14. The Site is not located in a Local Watershed Plan (LWP), Regional Watershed Plan (RWP), or Targeted Resource Area (TRA). Site watersheds range from approximately 0.04 of a square mile (25 acres) on UT5 to 1.09 square miles (700 acres) at the Site's outfall.

### **1.1 Project Background, Components, and Structure**

Located approximately 5 miles south of Wingate, NC, and seven miles north of the NC/SC state line, the Site encompasses 71.7 acres. Mitigation work within the Site included 1) stream restoration, 2) stream enhancement (Level I), 3) stream enhancement (Level II), 4) wetland reestablishment, 5) wetland enhancement, 6) wetland creation, 7) wetland preservation, and 8) vegetation planting. The Site is expected to provide 11,525.946 warm water stream credits and 24.163 riparian wetland credits by closeout (Table 1, Page 2). A conservation easement was granted to the State of North Carolina and recorded in the Union County Register of Deeds on September 30, 2021.

Before construction, land use at the Site was characterized by open water and maintained fields. Site design was completed on January 27, 2022; construction started on February 1, 2022, and ended with a final walkthrough on July 22, 2022. The Site was planted between April 7, 2022 and January 23, 2023. Completed project activities, reporting history, completion dates, and project contacts are summarized in Tables 11-12 (Appendix E).

*Space Purposefully Left Blank*

**Table 1. Wits End Mitigation Site (ID-100164) Project Mitigation Quantities and Credits**

Project Segment	Original Mitigation Plan Ft/Ac	As-Built Ft/Ac	Original Mitigation Category	Original Restoration Level	Original Mitigation Ratio (X:1)	Credits	Comments
<b>Stream</b>							
Waxhaw Br Upstream R1	330	329	Warm	EII*	5.000	66.000	
Waxhaw Br Upstream R2**	42	52	Warm	R	1.000	52.000	
Waxhaw Br Upstream R3	2547	2533	Warm	R	1.000	2,547.000	62 ft of piped crossing between R3 and R4 receives no credit
Waxhaw Br Upstream R4	1051	1042	Warm	R	1.000	1,051.000	
Waxhaw Br Downstream	1362	1368	Warm	R	1.000	1,362.000	
UT 1 R1**	2	14	Warm	EII*	5.000	2.800	
UT 1 R2	96	97	Warm	EII*	5.000	19.200	
UT 1 R3	78	77	Warm	R	1.000	78.000	
UT 2 R1	583	579	Warm	R	1.000	583.000	49 ft of forded crossing between R1 and R2 receives no credit
UT 2 R2**	36	46	Warm	R	1.000	46.000	
UT 2 R3	562	560	Warm	R	1.000	562.000	
UT 3A	780	792	Warm	R	1.000	780.000	
UT 3 Upstream R1	168	171	Warm	EII*	5.000	33.600	
UT 3 Upstream R2	232	232	Warm	EI	1.500	154.667	
UT 3 Upstream R3	770	757	Warm	R	1.000	770.000	
UT 3 Downstream R1^	1459	41	Warm	R	1.000	41.000	
UT 3 Downstream R2^	NA	292	Warm	EII*	5.000	58.400	
UT 3 Downstream R3^	NA	1109	Warm	R	1.000	1,109.000	
UT 4	1223	1215	Warm	R	1.000	1,223.000	
UT 5 R1	73	73	Warm	EII*	5.000	14.600	
UT 5 R2	119	118	Warm	R	1.000	119.000	
					<b>Total:</b>	<b>10,672.267</b>	
<b>Wetland</b>							
Wetland Reestablish <sup>@</sup>	22.886	22.833	NA	REE	1.000	22.833	
Wetland Enhancement	1.442	1.442	NA	E	2.000	0.721	
Wetland Creation	0.351	0.351	R	P	10.000	0.117	
Wetland Preservation	4.923	4.916	R	C	3.000	0.492	
					<b>Total:</b>	<b>24.163</b>	

**Project Credits**

Restoration Level	Stream			Riparian	Non-Rip	Coastal
	Warm	Cool	Cold	Wetland	Wetland	Marsh
Restoration	10,323.000					
Re-establishment				22.833		
Rehabilitation						
Enhancement				0.721		
Enhancement I	154.667					
Enhancement II						
Enhancement II*	194.600					
Creation				0.117		
Preservation				0.492		
Benthics	212.989					
Wider Buffer <sup>%</sup>	640.690					
<b>Totals</b>	<b>11,525.946</b>			<b>24.163</b>		

**Total Stream Credit 11,525.946**  
**Total Wetland Credit 24.163**

\* Enhancement at reduced ratio

\*\* The ATV paths and forded crossings proposed in the Mitigation Plan were legally abandoned and were not constructed

^ UT 3 channel realigned during construction back into old channel. This reach (R2) is now Enhancement (level II) at 5:1 with 2 smaller reaches of Restoration above and below (R1 and R3).

@ Wetland reestablishment credit reduced due to UT 3 realignment

% Wider buffer credit updated due to UT 3 channel realignment

**Wetland Mitigation Category**

CM Coastal Marsh  
R Riparian  
NR Non-Riparian

**Restoration Level**

HQP High Quality Preservation  
P Preservation  
E Wetland Enhancement - Veg and Hydro  
EII Stream Enhancement II  
EI Stream Enhancement I  
C Wetland Creation  
RH Wetland Rehabilitation - Veg and Hydro  
REE Wetland Re-establishment Veg and Hydro  
R Restoration

**Table 2. Summary: Goals, Performance, and Results**

Goals	Objectives	Success Criteria
<b>(1) HYDROLOGY</b>		
Restore proper hydrodynamics to the Site and downstream receiving waters.	<ul style="list-style-type: none"> <li>• Construct new channels at historic floodplain elevation to restore overbank flows</li> <li>• Remove impoundment and restore valley topography</li> <li>• Plant woody riparian buffer 150' from stream and wetland features</li> <li>• Deep rip floodplain soils to reduce compaction and increase soil surface roughness</li> <li>• Protect riparian buffers with a perpetual conservation easement</li> </ul>	<ul style="list-style-type: none"> <li>• BHR not to exceed 1.2</li> <li>• &lt; 10% change in BHR in any given year</li> <li>• Document four overbank events in separate monitoring years</li> <li>• Attain Wetland Hydrology Success Criteria</li> <li>• Attain Vegetation Success Criteria</li> <li>• Cross-section measurements indicate a stable channel with the appropriate substrate</li> <li>• Visual documentation of stable channels and structures</li> </ul>
<b>(1) WATER QUALITY</b>		
Remove direct nutrient and pollutant inputs from the Site and reduce contributions to downstream waters.	<ul style="list-style-type: none"> <li>• Plant a woody riparian buffer 150 feet off 90% of the Site's streams and wetlands and a 100-foot buffer on the Site's ephemeral streams.</li> <li>• Re-establish and enhance jurisdictional wetlands</li> <li>• Provide surface roughness and reduce compaction through deep ripping/plowing.</li> <li>• Restore overbank flooding by constructing channels at historic floodplain elevation.</li> <li>• Enhance existing wetlands by removing stressors and returning existing wetlands back to appropriate hydroperiods.</li> </ul>	<ul style="list-style-type: none"> <li>• Attain Wetland Hydrology Success Criteria</li> <li>• Attain Vegetation Success Criteria</li> </ul>
<b>(1) HABITAT</b>		
Improve instream and stream-side habitat.	<ul style="list-style-type: none"> <li>• Construct stable channels with the appropriate substrate and at historic floodplain elevations to restore overbank flows.</li> <li>• Remove impoundment &amp; restore the Waxhaw Branch FEMA floodplain to historic conditions.</li> <li>• Plant woody riparian buffer to provide organic matter and shade</li> <li>• Re-establish and enhance existing jurisdictional wetlands</li> <li>• Provide large-woody debris in floodplain wetlands and project buffers to historic conditions.</li> <li>• Re-establish and enhance existing jurisdictional wetlands</li> </ul>	<ul style="list-style-type: none"> <li>• Cross-section measurement indicates a stable channel with the appropriate substrate</li> <li>• Visual documentation of stable channels and in-stream structures</li> <li>• Attain Wetland Hydrology Success Criteria</li> <li>• Attain Vegetation Success Criteria</li> </ul>



Table 3. Project Attribute Table									
Project Name	Wits End Site								
County	Union County, North Carolina								
Project Area (acres)	71.7								
Project Coordinates (latitude and longitude decimal degrees)	34.913353, -80.442090								
Project Watershed Summary Information									
Physiographic Province	Carolina Slate Belt								
River Basin	Yadkin								
USGS Hydrologic Unit 8-digit	03040105								
DWR Sub-basin	03-07-14								
Project Drainage Area (acres)	700								
Project Drainage Area Percentage of Impervious Area	<2%								
Land Use Classification	Managed Herbaceous Cover								
Reach Summary Information									
Parameters	Waxhaw Br	UT1	UT2	UT3	UT3A	UT4	UT5		
Pre-project length (feet)	3047	133	696	2371	734	818	161		
Post-project (feet)	5386	188	1234	2602	792	1215	191		
Valley confinement (Confined, moderately confined, moderate, unconfined)	Moderate	Confined	Confined	Confined	Confined	Confined	Confined		
Drainage area (acres)	700	32	59	161	61	66	25		
Perennial, Intermittent, Ephemeral	Per	Int	Int	Per/Int	Int	Int	Int		
NCDWR Water Quality Classification	WS-V								
Dominant Stream Classification (existing)	Eg 4/5	Eg 4	E 6	G 4/5	G 4	Cg & D 4/5	Eg 4		
Dominant Stream Classification (proposed)	Ce 3/4	Ce 3/4	Ce 3/4	Ce 3/4	Ce 3/4	Ce 3/4	Ce 3/4		
Dominant Evolutionary class (Simon) if applicable	III	III	III	III/IV	III/IV	V	III		
Wetland Summary Information									
Parameters	Wetlands								
Pre-project (acres)	25.4 acre drained & 6.38 acre degraded								
Post-project (acres)	29.602 (Total)								
Wetland Type (non-riparian, riparian)	Riparian								
Mapped Soil Series	Cid channery silt loam and Goldston-Badin complex, and field verified Secrest-Cid complex Variant								
Soil Hydric Status	Nonhydric and Nonhydric-Nonhydric								
Regulatory Considerations									
Parameters	Applicable?	Resolved?		Supporting Docs?					
Water of the United States - Section 404	Yes	Yes		Section 404 Permit					
Water of the United States - Section 401	Yes	Yes		Section 401					
Endangered Species Act	Yes	Yes		CE Document					
Historic Preservation Act	Yes	Yes		CE Document					
Coastal Zone Management Act (CZMA or CAMA)	No	N/A		N/A					
Essential Fisheries Habitat	No	N/A		N/A					

## 1.2 Project Success Criteria

Monitoring and success criteria for stream restoration should relate to project goals and objectives identified from on-site NC SAM and NC WAM data collection. From a mitigation perspective, several goals and objectives are assumed to be functionally elevated by restoration activities without direct measurement. Other goals and objectives will be considered successful upon achieving success criteria. Table A summarizes Site success criteria.

**Table A. Project Success Criteria**

<b>Streams</b>
<ul style="list-style-type: none"> <li>• All streams must maintain an Ordinary High-Water Mark (OHWM), per RGL 05-05.</li> <li>• Continuous surface flow in each intermittent tributary should occur each year for at least 30 consecutive days.</li> <li>• Bank height ratio (BHR) cannot exceed 1.2 at any measured cross-section over the monitoring period.</li> <li>• BHR at any measure riffle cross-section should not change by more than 10% from baseline condition during any single monitoring year.</li> <li>• The stream project shall remain stable, and all other performance standards shall be met through four separate bankfull events, occurring in separate years, during the monitoring years 1-7.</li> </ul>
<b>Wetland Hydrology &amp; Soils</b>
<ul style="list-style-type: none"> <li>• During average climatic conditions, saturation or inundation within the upper 12 inches of the soil surface for 8 percent of the growing season*.</li> <li>• Soil profile descriptions must meet one of the hydric soil indicators identified in the Field Indicators of Hydric Soils in the United States, Version 8.2 (USDA 2018) in monitoring years 4 and 7.</li> </ul>
<b>Vegetation</b>
<ul style="list-style-type: none"> <li>• Within planted portions of the Site, a minimum of 320 stems per acre must be present at year 3, a minimum of 260 stems per acre must be present at year 5, and a minimum of 210 stems per acre must be present at year 7.</li> <li>• Trees must average 7 feet in height at year 5 and 10 feet at year 7.</li> <li>• Planted and volunteer stems are counted, provided they are included in the approved planting list for the Site; natural recruits not on the planting list may be considered by the IRT on a case-by-case basis.</li> <li>• Any single species can only account for up to 50% of the required number of stems within any vegetation plot.</li> </ul>

\* The growing season is defined as March 1 to November 14, with the March 1 start date to be confirmed by documentation of soil temperature greater than 41°F at 12 inches below the surface and bud burst of two or more different non-evergreen vascular plant species (Section 8.1, Mitigation Plan).

## 2 AS-BUILT CONDITION (BASELINE)

Site construction started on February 1, 2022, and ended with a final walkthrough on July 22, 2022. The Site was planted between April 7, 2022 and January 23, 2023. As-built and MYO data collection occurred in between June 2022 and February 2023.

In general, no significant issues arose during the construction of the Site. A sealed half-size set of record drawings are provided in Appendix G, which includes the post-construction survey, alignments, structures, and monitoring features. These include redlines for any significant field adjustments made during construction that differ from the design plans. Where needed, adjustments were made during construction based on field evaluations/landowner constraints. These modifications are detailed in Table B.

**Table B. Deviations from Construction Plans**

Location	Deviation	Explanation
Waxhaw Br sta. 29+58 to 29+70	Bridge installed in place of culvert	Improvement of crossings for landowner use, hydraulics, and aquatic life passage
Waxhaw Br sta. 3+75 to 3+85	Forded ATV crossing not constructed	Paths legally abandoned (Appendix F)
UT-1 sta. 0+02 to 0+14	Forded ATV crossing not constructed	Paths legally abandoned (Appendix F)
UT-2 sta. 5+70	Log cross vane location adjusted	Moved upstream to be inside the easement
UT-2 sta. 7+70 to 7+80	Forded ATV crossing not constructed	Paths legally abandoned (Appendix F)
UT-2 sta. 12+35	Log cross vane not constructed	Slope in field conditions did not require structure
UT-3 sta. 11+08 to 16+03	Stream channel was left in its existing channel location. Drop structure was installed, and all designed structures within the reach were not constructed. One additional log cross vane was installed near the downstream extent of the reach (sta. 15+75).	Landowner request – See Section 2.1

Additional activities that occurred at the Site included the following.

- Planting 58 acres of the Site with 75,769 stems between April 7, 2023 and January 23, 2023 – planted species are included in Table 6A (Appendix B).
- Planting an additional 520 1-gallon containerized trees on July 28, 2022 along the old road access near the Waxhaw Branch bridge crossing and along the southern easement boundary adjacent to UT-3.
- Applying a permanent seed mix at 2 lbs per acre across the Site, with an additional seed mix applied at 5 lbs per acre in marsh treatment areas, pools, and seeps. Species lists are included in Tables 6B and 6C (Appendix B).

## 2.1 Project Modifications

### Waxhaw Branch Crossing Modification:

Due to inflation and general supply/availability of the engineered Waxhaw Branch aluminum, wing-walled box culvert, it became clear in late April 2022 that a modification of the crossing from an aluminum box culvert to a spanned bridge would have to occur. RS worked with Sungate (engineer of record) and the civil engineering firm CGM3 to design a bridge crossing to meet the Union County FEMA requirements. Those requirements mandated that the bridge allow a 100-year storm event to pass without impounding water and emergency vehicle access during such an event. In an abundance of caution, RS expanded the bridge's capacity by adding four 36-inch and two 24-inch floodplain pipes to the crossing. This modification occurred in a non-credit generating area outside the conservation easement.

### Removal of ATV Paths/Crossings:

The layout of the Conservation Easement bisected portions of the original fee-simple property, and legally, RS had to provide access to the isolated portion. As detailed in the Mitigation Plan, RS accomplished this

by adding internal ATV crossings/trails. Between approval of the Mitigation Plan and completion of construction, RS was able to sell the isolated portion of the parcel to the adjacent neighbor. As a result, the internal ATV trails and crossings were no longer necessary, and RS did not construct the ATV crossings/trails. RS worked with Blane Rice at the State Property Office to remove the trails/crossings from the conservation easement. This effort was completed on July 22, 2022, by recording a Release and Removal document at the Union County Register of Deeds (attached). Stream credit was added to the footprint of the forded ATV crossings, where credit was initially removed: Waxhaw Branch – Restoration at 1:1, UT 1 – Enhancement Level II at 5:1, and UT 2 – Restoration at 1:1. Additionally, the footprint of the ATV paths, which were removed from the wider buffer calculation, were added into a revised wider buffer calculation Appendix F – Other Data.

Modification of UT 3:

The husband of the fee-simple landowner of UT 3, where the modification occurred, passed in 2021. The modified area of UT 3 and the adjacent floodplain is a "sacred" place for her, with many memories of her late husband. During construction, it became clear to RS that disturbing this area would cause her significant and, in our opinion, unneeded stress and anxiety. To maintain positive, long-term relations with her, RS decided to keep this portion of UT 3 in its current location. This portion of the UT 3 has bedrock control, has an existing mature buffer on its right bank, and is laterally stable. RS tied the newly constructed (restored) UT 3 into the existing bedrock. Credit within this area was converted from Restoration at 1:1 to Enhancement Level II at 5:1, and a revised wider buffer calculation was conducted based on the as-built location of the stream, Appendix F – Other Data.



**Image 1 & 2 – UT 3 Drop Structure into Enhancement 2 Reach & UT 3 Enhancement 2 Reach Bedrock**



## 2.2 Site Planting Effort

Planting of the Site occurred in stages as construction was completed and as evaluations were made regarding planted stem viability. Ample rain and cooler temperatures helped during the latter 2022 planting efforts. Before the May 2022 planting efforts, bare roots were kept in a refrigerated truck to prevent budburst, and live stakes were kept submerged in water. However, after inspection in late 2022, it was determined that an additional planting effort would help ensure Site vegetative success. Table C details site planting efforts.

**Table C. Wits End Planting Dates:**

Type / Date	Planting Location	Notes
<b>Bare root</b>		
Thursday, April 7, 2022	- UT-1, UT-2, Waxhaw Branch (within the old pond bed down to the confluence with UT-3), UT-4 to the Waxhaw Branch floodplain	Temperature Range: 60°F - 80°F Week of Precipitation: +/- 1.46 inches
Tuesday, May 24, 2022	- UT-3, from its confluence of Waxhaw Branch to where UT-3 enters the Site, and the origin point of UT-3A - Streamside and wetland areas along Waxhaw Branch starting at the confluence of UT3 (the forested portion of Waxhaw Branch) down to Snyder Store Road (Site outfall)	Temperature Range: 62°F - 75°F  The previous night, the Site received +/- 0.64 inches of rain, and a light drizzle occurred during the morning of May 24
Monday, January 23, 2023	- Sitewide	Temperature Range: 33°F - 54°F Previous day rain: +/- 0.82 inches
<b>1-gallon containerized planting</b>		
Thursday, July 28, 2022	- Waxhaw Branch – old road access and construction area for Waxhaw Branch bridge. - UT-3 southern easement edge - 520 1-gal.	Temperature Range: 77°F - 96°F  A trace amount of rainfall occurred on July 29
<b>Live stakes</b>		
Monday, March 21, 2022	- Waxhaw Branch to the confluence with UT-2, UT-1, UT-2, and UT-4 down to Waxhaw Branch floodplain	Temperature Range: 38°F - 71°F Week of Precipitation: +/- 0.85 inches
Thursday, April 7, 2022	- Marsh treatment areas, Waxhaw Branch from UT-2 confluence down to UT-3 confluence	Temperature Range: 60°F – 80°F Week of Precipitation: +/- 1.46 inches
Sunday, May 15, 2022	- UT-3/3A to its confluence with Waxhaw Branch and down to Snyder Store Road (Site outfall)	Planting occurred in the morning, with temperatures ranging from 66°F to 82°F. +/- 0.25 inches of rain fell that afternoon after planting



### 3 PROJECT MONITORING – METHODS

Monitoring will be conducted by Axiom Environmental, Inc. Annual monitoring reports of the data collected will be submitted to the NCDMS by Restoration Systems no later than December 31 of each monitoring year data is collected. The monitoring schedule is summarized in Table D.

**Table D. Monitoring Schedule**

Resource	Year 1	Year 2	Year 3	Year 4	Year 5	Year 6	Year 7
Streams	x	x	x		x		x
Wetlands	x	x	x	x	x	x	x
Vegetation	x	x	x		x		x
Macroinvertebrates			x		x		x
Visual Assessment	x	x	x	x	x	x	x
Report Submittal	x	x	x	x	x	x	x

#### 3.1 Monitoring

The monitoring parameters are summarized in Table E.

*Space purposefully left blank*

**Table E. Monitoring Summary**

Stream Parameters				
Parameter	Method	Schedule/Frequency	Number/Extent	Data Collected/Reported
Stream Profile	Full longitudinal survey	As-built (unless otherwise required)	All restored stream channels	Graphic and tabular data.
Stream Dimension	Cross-sections	Years 1, 2, 3, 5, and 7	Total of 28 cross-sections on restored channels	Graphic and tabular data.
Channel Stability	Visual Assessments	Yearly	All restored stream channels	Areas of concern depicted on the plan view figure with a written assessment and photograph of the area included in the report
	Additional Cross-sections	Yearly	Only if instability is documented during monitoring	Graphic and tabular data.
Stream Hydrology	Continuous monitoring surface water gauges and/or trail camera	Continuous recording through the monitoring period	5 surface water gauges on UT 2, 3A, 3, 4, and 5	Surface water data for each monitoring period
Bankfull Events	Continuous monitoring surface water gauges and/or trail camera	Continuous recording through the monitoring period	3 crest gauges (pressure transducers on Waxhaw Br up-and downstream, and UT 3	Surface water data for each monitoring period
	Visual/Physical Evidence	Continuous through the monitoring period	Visual monitoring and photographic evidence as needed	Visual evidence, photo documentation, and/or rain data.
Benthic Macroinvertebrates	“Qual 4” method described in <i>Standard Operating Procedures for Collection and Analysis of Benthic Macroinvertebrates, Version 5.0</i> (NCDWR 2016)	Pre-construction, Years 3, 5, and 7 during the “index period” referenced in <i>Small Streams Biocriteria Development</i> (NCDWQ 2009)	2 stations (on Waxhaw Br upstream and UT 3 downstream); however, the exact locations will be determined at the time pre-construction benthics are collected	Results will be presented on a site-by-site basis. They will include a list of taxa collected, an enumeration of <i>Ephemeroptera</i> , <i>Plecoptera</i> , <i>Tricopetera</i> taxa, and Biotic Index values. *
Wetland Parameters				
Parameter	Method	Schedule/Frequency	Number/Extent	Data Collected/Reported
Wetland Restoration	Groundwater gauges	Years 1, 2, 3, 4, 5, 6, and 7 throughout the year, with the modified growing season** as defined in the approved Site mitigation plan	27 gauges spread throughout restored wetlands	Soil temperature and bud burst of two woody species at the beginning of each monitoring period to verify the start of the modified growing season, groundwater and rain data for each monitoring period
	Soil profile descriptions	As-built and Years 3, 5, and 7	27 soil profile descriptions, one at each groundwater gauge	Soil profile descriptions completed to assess the development of hydric soil morphologic features
Vegetation Parameters				
Parameter	Method	Schedule/Frequency	Number/Extent	Data Collected/Reported
Vegetation establishment and vigor	Permanent vegetation plots 0.0247 acres (100 square meters) in size	As-built, Years 1, 2, 3, 5, and 7	37 plots spread across the Site	Species, height, planted vs. volunteer, stems/acre
	Annual random vegetation plots, 0.0247 acres (100 square meters) in size	As-built, Years 1, 2, 3, 5, and 7	12 plots randomly selected each year	Species and height

\* Benthic Macroinvertebrate sampling data will not be tied to success criteria; however, the data may be used to observe positive gains to in-stream habitat.

\*\* The growing season is defined as March 1 to November 14, with the March 1 start date to be confirmed by documentation of soil temperature greater than 41°F at 12 inches below the surface and bud burst of two or more different non-evergreen vascular plant species (Section 8.1, Mitigation Plan).

#### **4 MONITORING YEAR 0 – DATA ASSESSMENT**

Annual monitoring and site visits were conducted between June 2022 and February 2023 to assess the condition of the project. Stream, wetland, and vegetation criteria for the Site follow the approved success criteria presented in the Mitigation Plan and summarized in Section 1.2; monitoring methods are detailed in Section 3.0.

##### **4.1 Stream Assessment**

Morphological surveys for MY0 were conducted on June 2, 2022. All streams within the Site are stable and functioning as designed. Refer to Appendix A for the Visual Stream Morphology Stability Assessment Table and Stream Photographs. Refer to Appendix C for Stream Geomorphology Data. No stream areas of concern were identified during MY0.

##### **4.2 Hydrology Assessment**

28 groundwater monitoring gauges were installed throughout the Site's wetlands. Hydrologic data will be collected and reported during MY1 (2023).

##### **4.3 Vegetative Assessment**

The MY0 vegetative survey was completed in February 2023. Vegetation monitoring resulted in a sitewide stem density average of 426 planted stems per acre permanent plot average (413 stems per acre/sitewide average), above the interim requirement of 320 stems per acre required at MY3. Additionally, 31 of the 37 fixed vegetation plots and 7 of the 12 temporary plots met the interim success criteria. Please refer to Appendix A for Vegetation Plot Photographs, the Vegetation Condition Assessment Table, and Appendix B for Vegetation Plot Data.

##### **4.4 Monitoring Year 0 Summary**

Overall, the Site looks good, is performing as intended, and is on track to meet success criteria. Site vegetation is trending toward exceeding the MY3 interim requirement of 320 planted stems per acre, and all streams within the Site are stable and are meeting project goals.

## 5 REFERENCES

Lee, M.T., R.K. Peet, S.D. Roberts, and T.R. Wentworth. 2008. CVS-EEP Protocol for Recording Vegetation. Version 4.2. North Carolina Department of Environment and Natural Resources, Ecosystem Enhancement Program. Raleigh, North Carolina.

North Carolina Ecosystem Enhancement Program (NCEEP 2009). Lower Yadkin/Pee-Dee River Basin Restoration Priorities 2009 (online). Available: <https://deq.nc.gov/about/divisions/mitigation-services/dms-planning/watershed-planning-documents/yadkin-river-basin>

North Carolina Stream Functional Assessment Team. (NC SFAT 2015). N.C. Stream Assessment Method (NC SAM) User Manual. Version 2.1.

North Carolina Wetland Functional Assessment Team. (NC WFAT 2010). N.C. Wetland Assessment Method (NC WAM) User Manual. Version 4.1.



Rosgen, D. 1996. Applied River Morphology. Wildland Hydrology (Publisher). Pagosa Springs, Colorado

Simon A, Hupp CR. 1986. Geomorphic and Vegetative Recovery Processes Along Modified Tennessee Streams: An Interdisciplinary Approach to Disturbed Fluvial Systems. Forest Hydrology and Watershed Management. IAHS-AISH Publ.167.

## **Appendix A: Visual Assessment Data**

Figure 1. Current Conditions Plan View  
Tables 4A-H. Stream Visual Stability Assessment  
Table 5. Visual Vegetation Assessment  
Vegetation Plot Photographs  
Site Photo Log



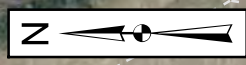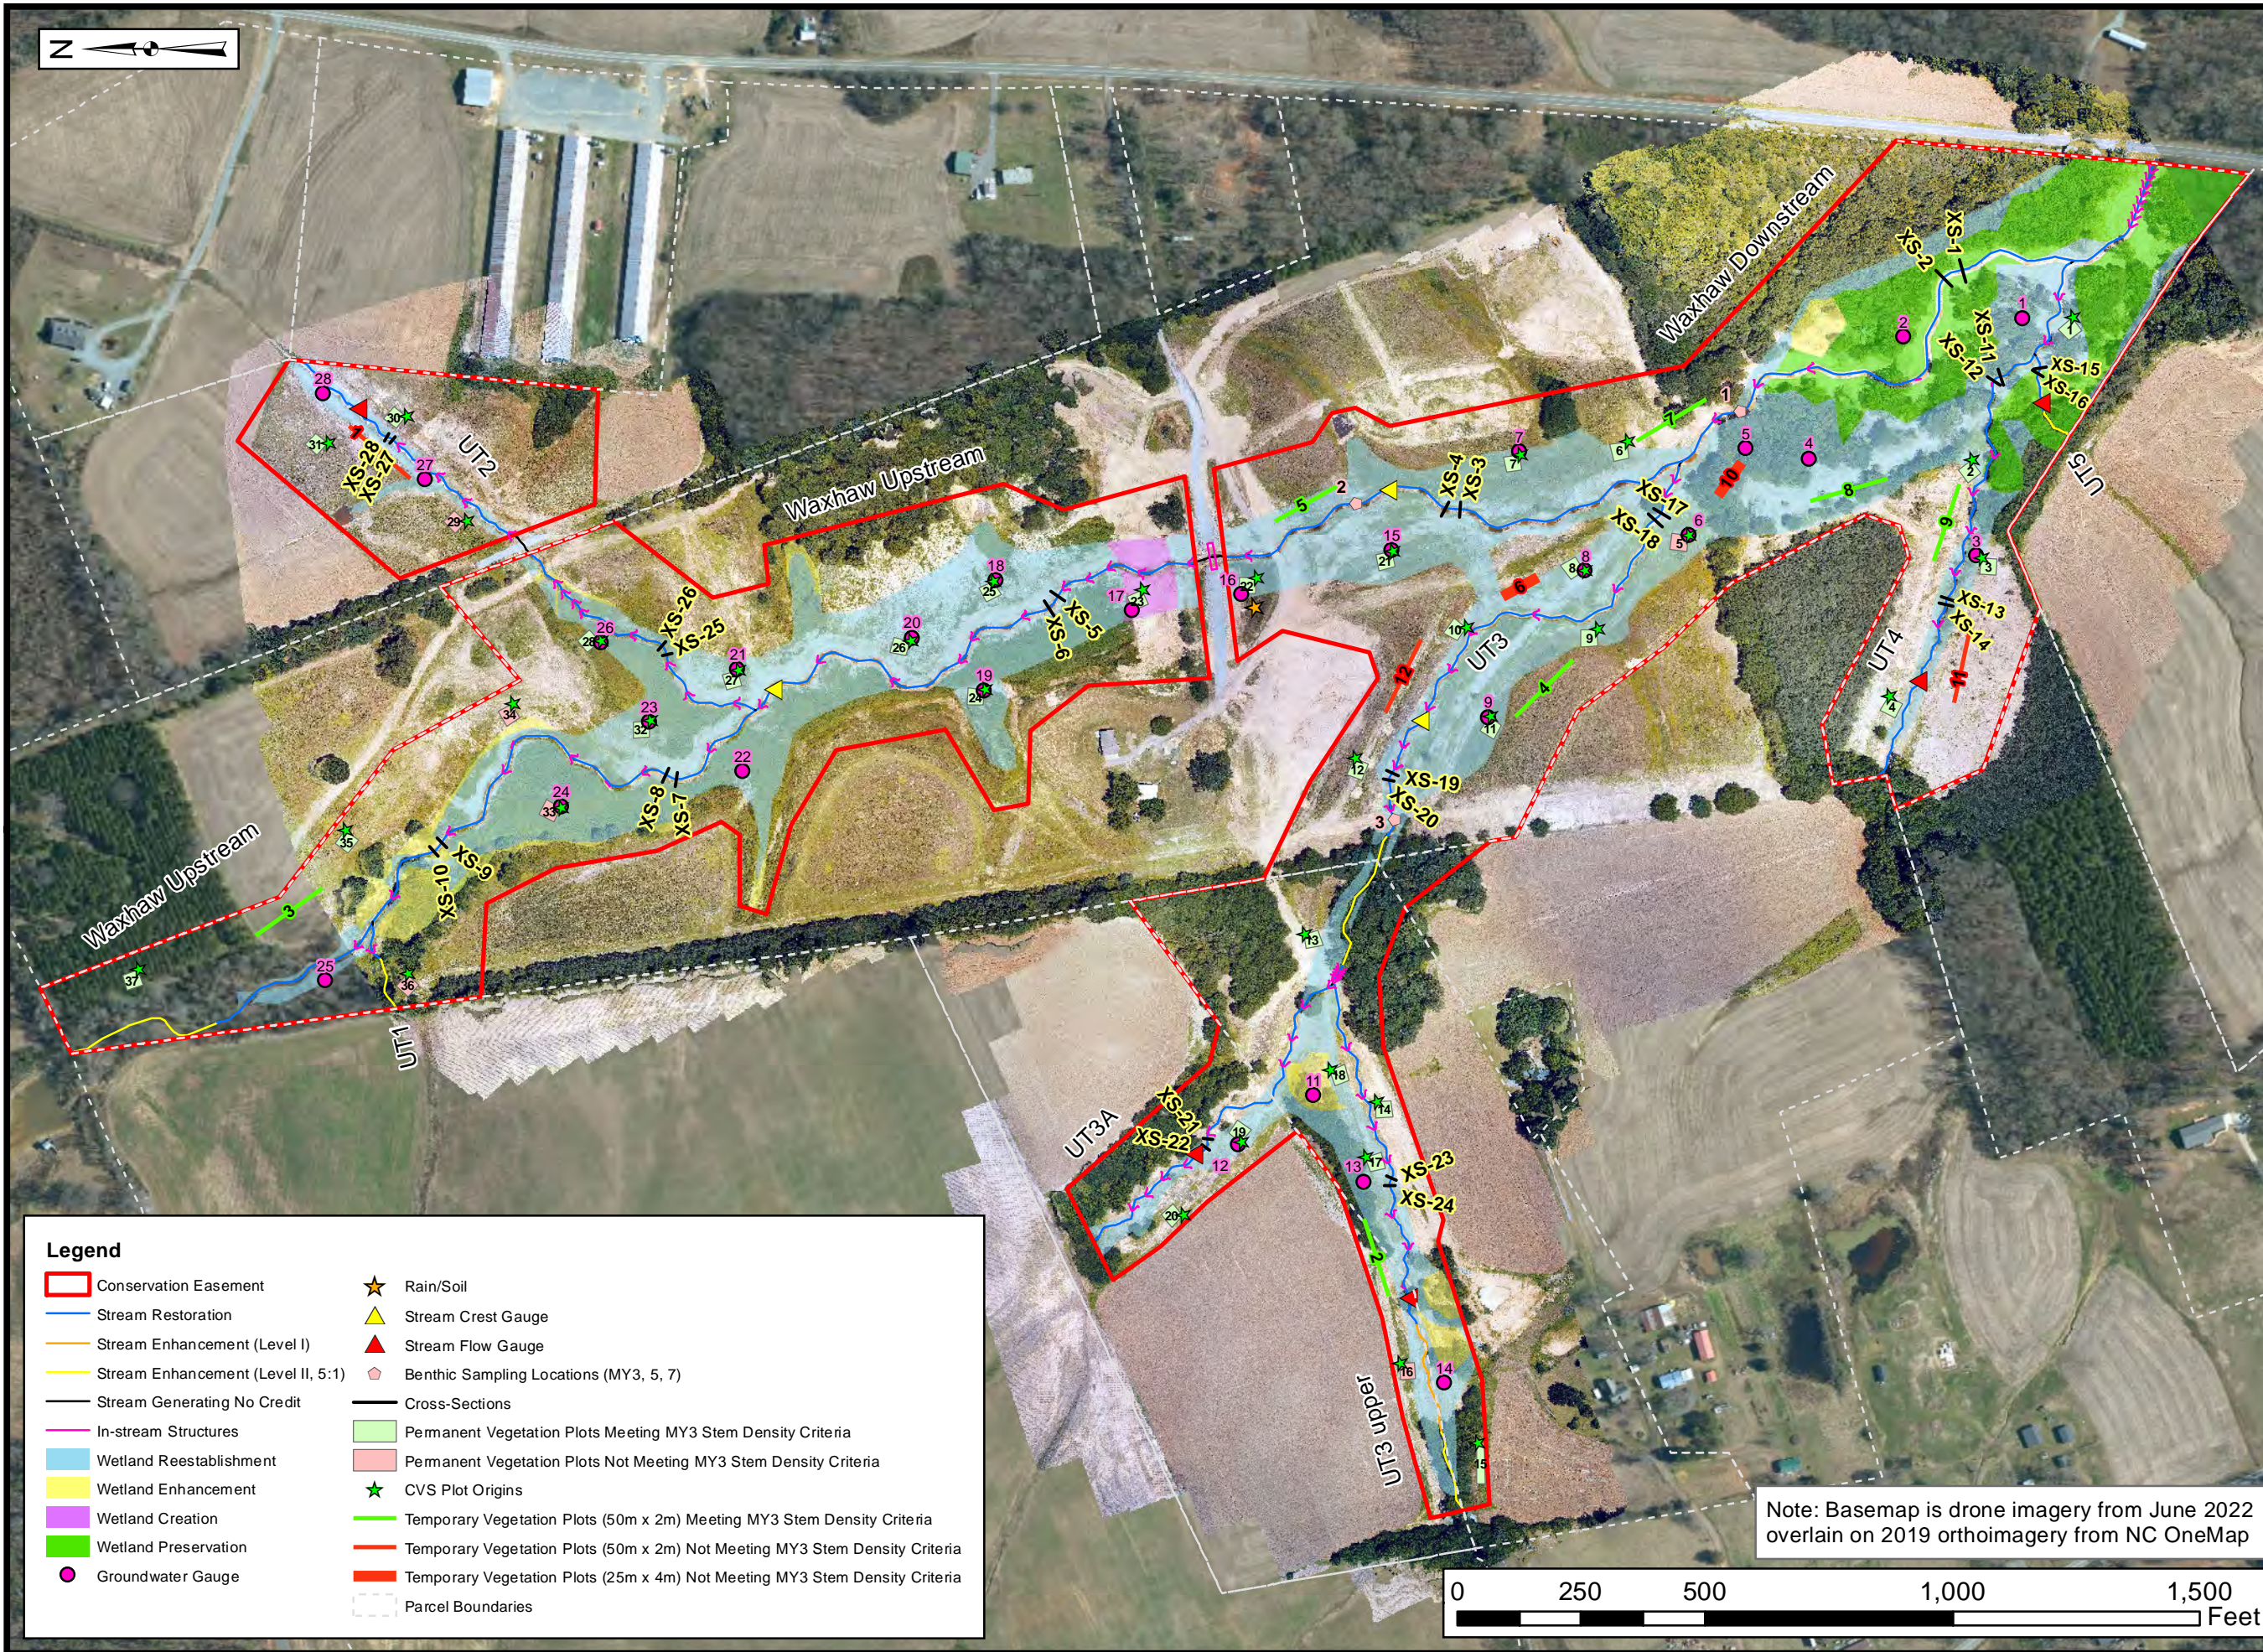

Project:

**WITS END**

Union County, NC

Title:

**CURRENT CONDITIONS PLAN VIEW**

Drawn by: KRJ

Date: Mar 2023

Scale: 1:3900

Project No.: 20-011

**FIGURE**

**1**

- Legend**
- Conservation Easement
  - Stream Restoration
  - Stream Enhancement (Level I)
  - Stream Enhancement (Level II, 5:1)
  - Stream Generating No Credit
  - In-stream Structures
  - Wetland Reestablishment
  - Wetland Enhancement
  - Wetland Creation
  - Wetland Preservation
  - Groundwater Gauge
  - ★ Rain/Soil
  - ▲ Stream Crest Gauge
  - ▲ Stream Flow Gauge
  - ◇ Benthic Sampling Locations (MY3, 5, 7)
  - Cross-Sections
  - Permanent Vegetation Plots Meeting MY3 Stem Density Criteria
  - Permanent Vegetation Plots Not Meeting MY3 Stem Density Criteria
  - ★ CVS Plot Origins
  - Temporary Vegetation Plots (50m x 2m) Meeting MY3 Stem Density Criteria
  - Temporary Vegetation Plots (50m x 2m) Not Meeting MY3 Stem Density Criteria
  - Temporary Vegetation Plots (25m x 4m) Not Meeting MY3 Stem Density Criteria
  - Parcel Boundaries

Note: Basemap is drone imagery from June 2022 overlain on 2019 orthoimagery from NC OneMap

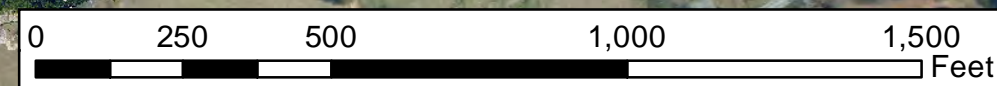




Table 4A. Visual Stream Stability Assessment

Reach Waxhaw Branch  
 Assessed Stream Length 5386  
 Assessed Bank Length 10772

Survey Date: June 22, 2022

Major Channel Category		Metric	Number Stable, Performing as Intended	Total Number in As-built	Amount of Unstable Footage	% Stable, Performing as Intended
Bank	Surface Scour/Bare Bank	Bank lacking vegetative cover resulting simply from poor growth and/or surface scour			0	100%
	Toe Erosion	Bank toe eroding to the extent that bank failure appears likely. Does <u>NOT</u> include undercuts that are modest, appear sustainable and are providing habitat.			0	100%
	Bank Failure	Fluvial and geotechnical - rotational, slumping, calving, or collapse			0	100%
<b>Totals</b>					0	100%
Structure	Grade Control	Grade control structures exhibiting maintenance of grade across the sill.	26	26		100%
	Bank Protection	Bank erosion within the structures extent of influence does <u>not</u> exceed 15%. (See guidance for this table in DMS monitoring guidance document)	26	26		100%

Table 4B. Visual Stream Stability Assessment

Reach UT 1  
 Assessed Stream Length 188  
 Assessed Bank Length 376

Survey Date: June 22, 2022

Major Channel Category		Metric	Number Stable, Performing as Intended	Total Number in As-built	Amount of Unstable Footage	% Stable, Performing as Intended
Bank	Surface Scour/Bare Bank	Bank lacking vegetative cover resulting simply from poor growth and/or surface scour			0	100%
	Toe Erosion	Bank toe eroding to the extent that bank failure appears likely. Does <u>NOT</u> include undercuts that are modest, appear sustainable and are providing habitat.			0	100%
	Bank Failure	Fluvial and geotechnical - rotational, slumping, calving, or collapse			0	100%
<b>Totals</b>					0	100%
Structure	Grade Control	Grade control structures exhibiting maintenance of grade across the sill.	1	1		100%
	Bank Protection	Bank erosion within the structures extent of influence does <u>not</u> exceed 15%. (See guidance for this table in DMS monitoring guidance document)	1	1		100%

Table 4C. Visual Stream Stability Assessment

Reach UT 2  
 Assessed Stream Length 1234  
 Assessed Bank Length 2468

Survey Date: June 22, 2022

Major Channel Category		Metric	Number Stable, Performing as Intended	Total Number in As-built	Amount of Unstable Footage	% Stable, Performing as Intended
Bank	Surface Scour/Bare Bank	Bank lacking vegetative cover resulting simply from poor growth and/or surface scour			0	100%
	Toe Erosion	Bank toe eroding to the extent that bank failure appears likely. Does <u>NOT</u> include undercuts that are modest, appear sustainable and are providing habitat.			0	100%
	Bank Failure	Fluvial and geotechnical - rotational, slumping, calving, or collapse			0	100%
<b>Totals</b>					0	100%
Structure	Grade Control	Grade control structures exhibiting maintenance of grade across the sill.	12	12		100%
	Bank Protection	Bank erosion within the structures extent of influence does <u>not</u> exceed 15%. (See guidance for this table in DMS monitoring guidance document)	12	12		100%

Table 4D. Visual Stream Stability Assessment

Reach UT 3 Lower  
 Assessed Stream Length 1442  
 Assessed Bank Length 2884

Survey Date: June 22, 2022

Major Channel Category		Metric	Number Stable, Performing as Intended	Total Number in As-built	Amount of Unstable Footage	% Stable, Performing as Intended
Bank	Surface Scour/Bare Bank	Bank lacking vegetative cover resulting simply from poor growth and/or surface scour			0	100%
	Toe Erosion	Bank toe eroding to the extent that bank failure appears likely. Does <u>NOT</u> include undercuts that are modest, appear sustainable and are providing habitat.			0	100%
	Bank Failure	Fluvial and geotechnical - rotational, slumping, calving, or collapse			0	100%
<b>Totals</b>					0	100%
Structure	Grade Control	Grade control structures exhibiting maintenance of grade across the sill.	11	11		100%
	Bank Protection	Bank erosion within the structures extent of influence does <u>not</u> exceed 15%. (See guidance for this table in DMS monitoring guidance document)	11	11		100%



Table 4E. Visual Stream Stability Assessment

Reach UT 3 Upper  
 Assessed Stream Length 1160  
 Assessed Bank Length 2320

Survey Date: June 22, 2022

Major Channel Category		Metric	Number Stable, Performing as Intended	Total Number in As-built	Amount of Unstable Footage	% Stable, Performing as Intended
Bank	Surface Scour/Bare Bank	Bank lacking vegetative cover resulting simply from poor growth and/or surface scour			0	100%
	Toe Erosion	Bank toe eroding to the extent that bank failure appears likely. Does <u>NOT</u> include undercuts that are modest, appear sustainable and are providing habitat.			0	100%
	Bank Failure	Fluvial and geotechnical - rotational, slumping, calving, or collapse			0	100%
<b>Totals</b>					0	100%
Structure	Grade Control	Grade control structures exhibiting maintenance of grade across the sill.	7	7		100%
	Bank Protection	Bank erosion within the structures extent of influence does <u>not</u> exceed 15%. (See guidance for this table in DMS monitoring guidance document)	7	7		100%

Table 4F. Visual Stream Stability Assessment

Reach UT 3A  
 Assessed Stream Length 792  
 Assessed Bank Length 1584

Survey Date: June 22, 2022

Major Channel Category		Metric	Number Stable, Performing as Intended	Total Number in As-built	Amount of Unstable Footage	% Stable, Performing as Intended
Bank	Surface Scour/Bare Bank	Bank lacking vegetative cover resulting simply from poor growth and/or surface scour			0	100%
	Toe Erosion	Bank toe eroding to the extent that bank failure appears likely. Does NOT include undercuts that are modest, appear sustainable and are providing habitat.			0	100%
	Bank Failure	Fluvial and geotechnical - rotational, slumping, calving, or collapse			0	100%
<b>Totals</b>					0	100%
Structure	Grade Control	Grade control structures exhibiting maintenance of grade across the sill.	9	9		100%
	Bank Protection	Bank erosion within the structures extent of influence does <u>not</u> exceed 15%. (See guidance for this table in DMS monitoring guidance document)	9	9		100%

Table 4G. Visual Stream Stability Assessment

Reach UT 4  
 Assessed Stream Length 1215  
 Assessed Bank Length 2430

Survey Date: June 22, 2022

Major Channel Category		Metric	Number Stable, Performing as Intended	Total Number in As-built	Amount of Unstable Footage	% Stable, Performing as Intended
Bank	Surface Scour/Bare Bank	Bank lacking vegetative cover resulting simply from poor growth and/or surface scour			0	100%
	Toe Erosion	Bank toe eroding to the extent that bank failure appears likely. Does <u>NOT</u> include undercuts that are modest, appear sustainable and are providing habitat.			0	100%
	Bank Failure	Fluvial and geotechnical - rotational, slumping, calving, or collapse			0	100%
<b>Totals</b>					0	100%
Structure	Grade Control	Grade control structures exhibiting maintenance of grade across the sill.	8	8		100%
	Bank Protection	Bank erosion within the structures extent of influence does <u>not</u> exceed 15%. (See guidance for this table in DMS monitoring guidance document)	8	8		100%

Table 4H. Visual Stream Stability Assessment

Reach UT 5  
 Assessed Stream Length 191  
 Assessed Bank Length 382

Survey Date: June 22, 2022

Major Channel Category		Metric	Number Stable, Performing as Intended	Total Number in As-built	Amount of Unstable Footage	% Stable, Performing as Intended
Bank	Surface Scour/Bare Bank	Bank lacking vegetative cover resulting simply from poor growth and/or surface scour			0	100%
	Toe Erosion	Bank toe eroding to the extent that bank failure appears likely. Does <u>NOT</u> include undercuts that are modest, appear sustainable and are providing habitat.			0	100%
	Bank Failure	Fluvial and geotechnical - rotational, slumping, calving, or collapse			0	100%
<b>Totals</b>					0	100%
Structure	Grade Control	Grade control structures exhibiting maintenance of grade across the sill.	0	0		100%
	Bank Protection	Bank erosion within the structures extent of influence does <u>not</u> exceed 15%. (See guidance for this table in DMS monitoring guidance document)	0	0		100%

**Visual Vegetation Assessment**







**Planted acreage 58**

Vegetation Category	Definitions	Mapping Threshold	Combined Acreage	% of Planted Acreage
Bare Areas	Very limited cover of both woody and herbaceous material.	0.10 acres	0.00	0.0%
Low Stem Density Areas	Woody stem densities clearly below target levels based on current MY stem count criteria.	0.10acres	0.00	0.0%
<b>Total</b>			0.00	0.0%
Areas of Poor Growth Rates	Planted areas where average height is not meeting current MY Performance Standard.	0.10 acres	0.00	0.0%
<b>Cumulative Total</b>			0.00	0.0%

**Easement Acreage 71.7**








Vegetation Category	Definitions	Mapping Threshold	Combined Acreage	% of Easement Acreage
Invasive Areas of Concern	Invasives may occur outside of planted areas and within the easement and will therefore be calculated against the total easement acreage- Include species with the potential to directly outcompete native, young, woody stems in the short-term or community structure for existing communities. Species included in summation above should be identified in report summary.	0.10 acres	0.00	0.0%
Easement Encroachment Areas	Encroachment may be point, line, or polygon. Encroachment to be mapped consists of any violation of restrictions specified in the conservation easement. Common encroachments are mowing, cattle access, vehicular access. Encroachment has no threshold value as will need to be addressed regardless of impact area.	none	0 Encroachments noted	

Wits End Stream and Wetland Mitigation Site  
MYO (2022) Vegetation Monitoring Photographs (taken February 6-10, 2023)

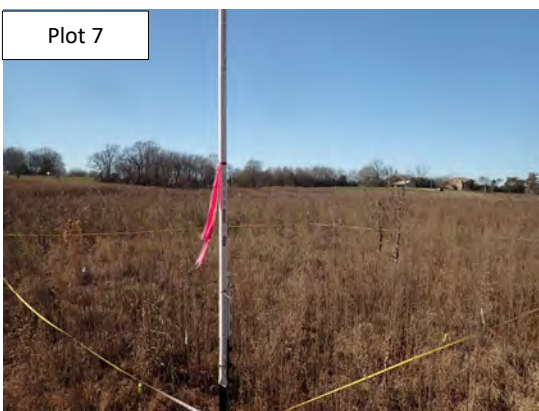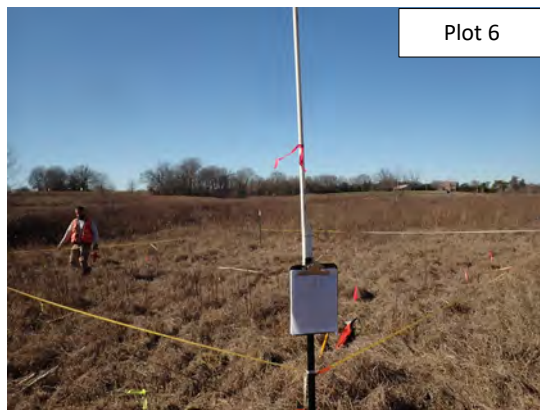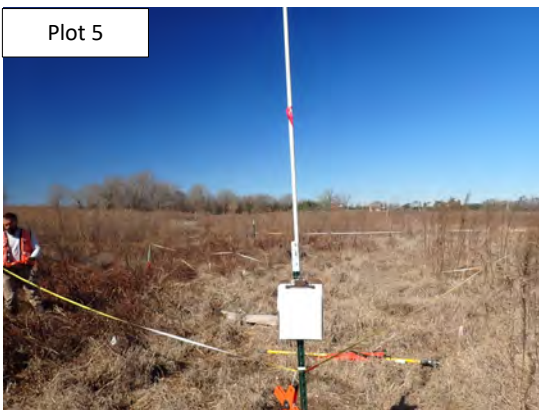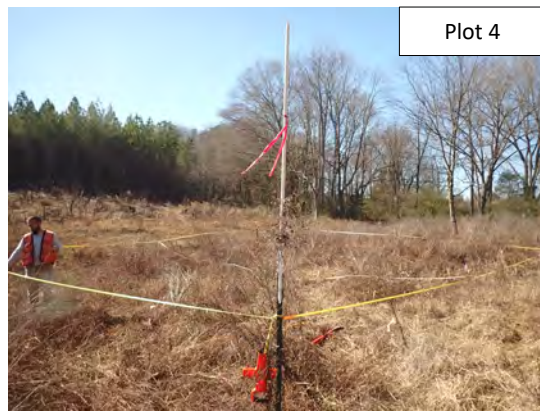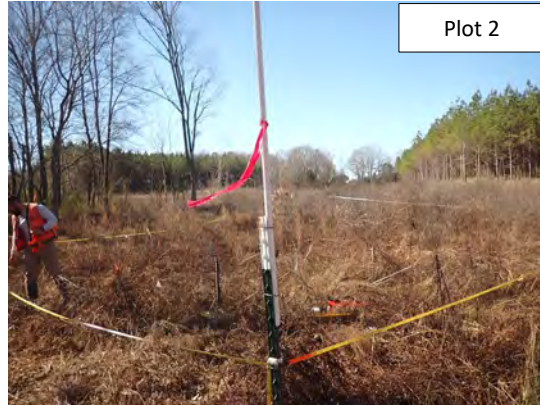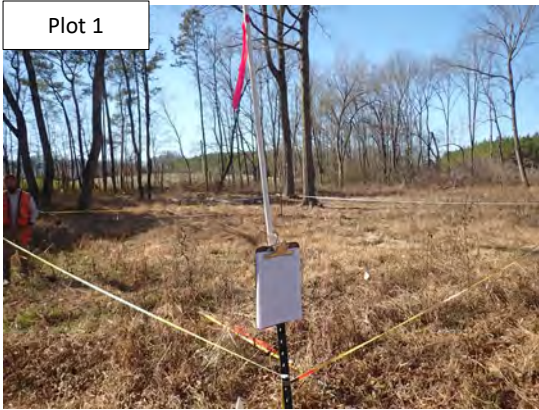








Wits End Stream and Wetland Mitigation Site  
MYO (2022) Vegetation Monitoring Photographs (taken February 6-10, 2023)

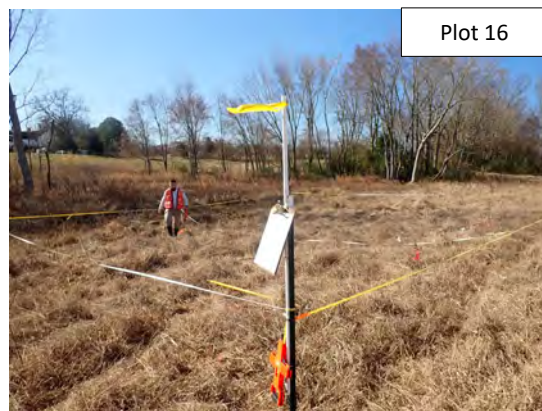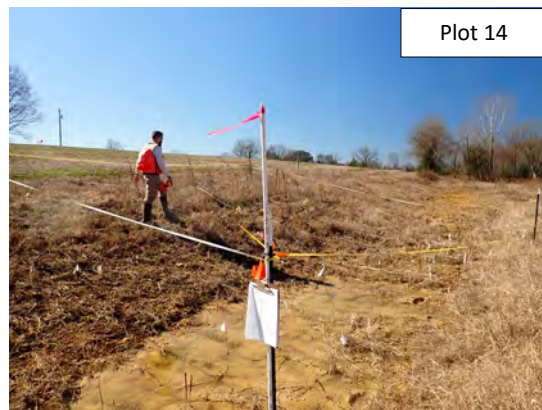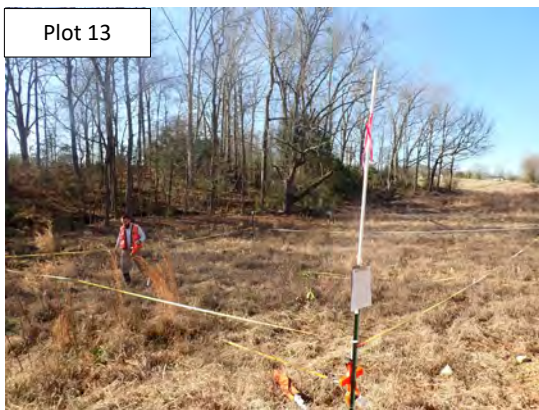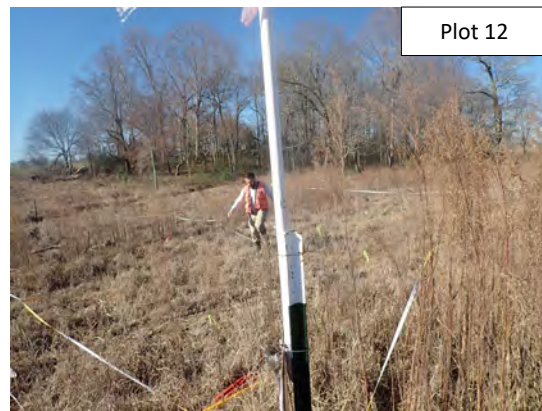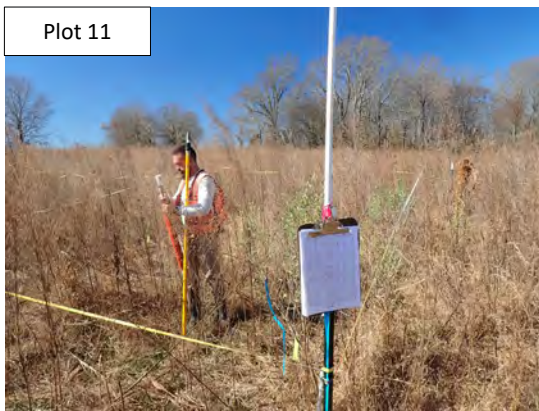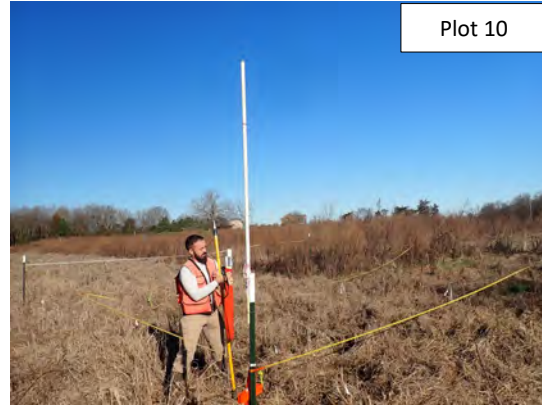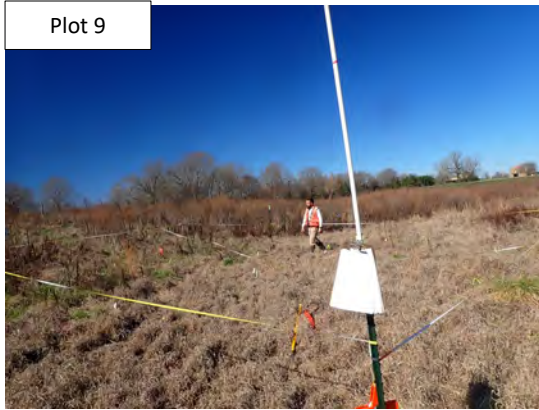










Wits End Stream and Wetland Mitigation Site  
MYO (2022) Vegetation Monitoring Photographs (taken February 6-10, 2023)

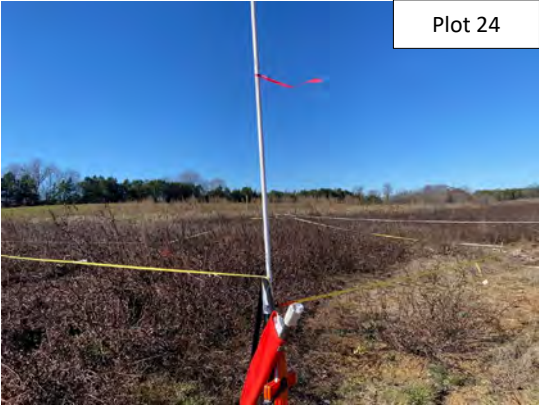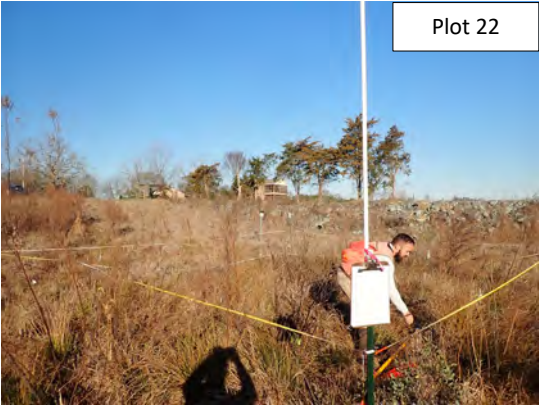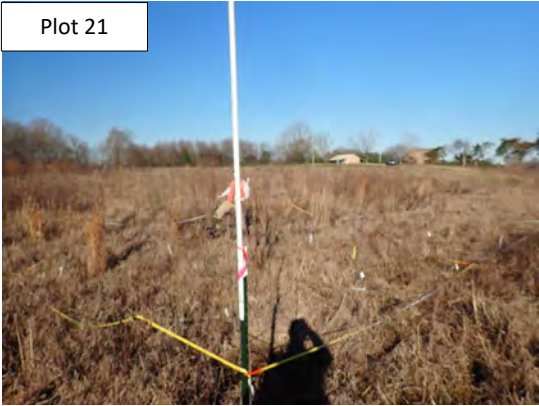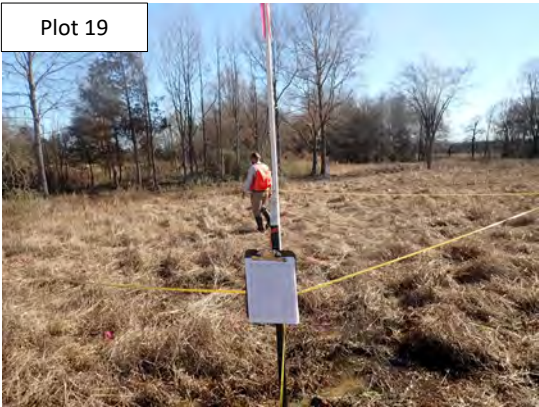
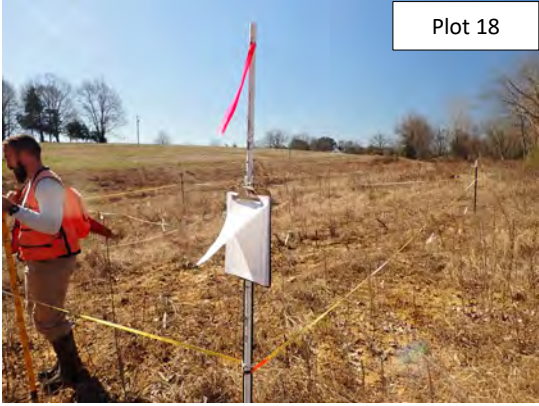




Wits End Stream and Wetland Mitigation Site  
MYO (2022) Vegetation Monitoring Photographs (taken February 6-10, 2023)

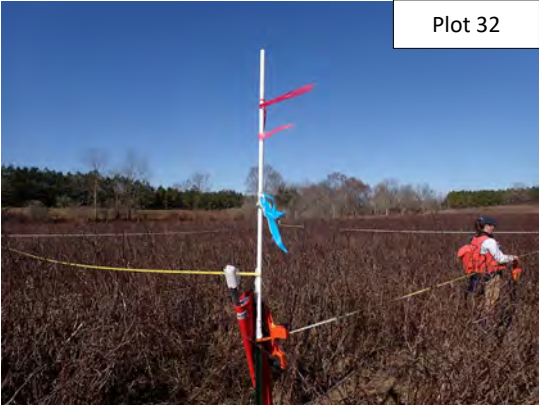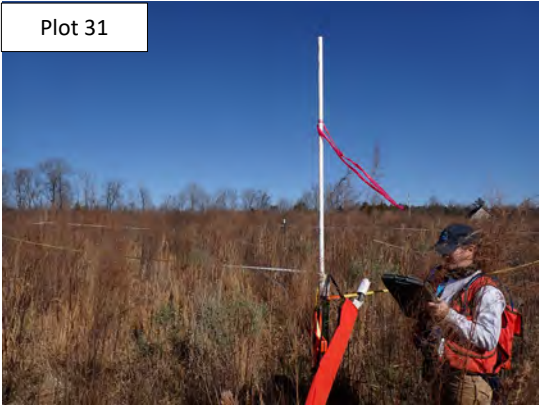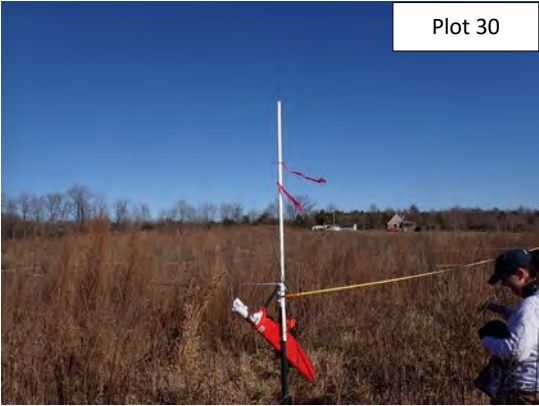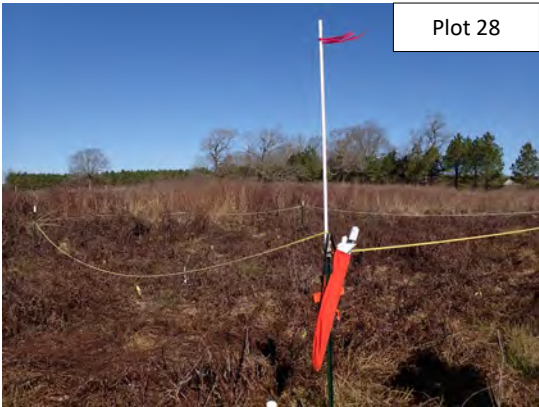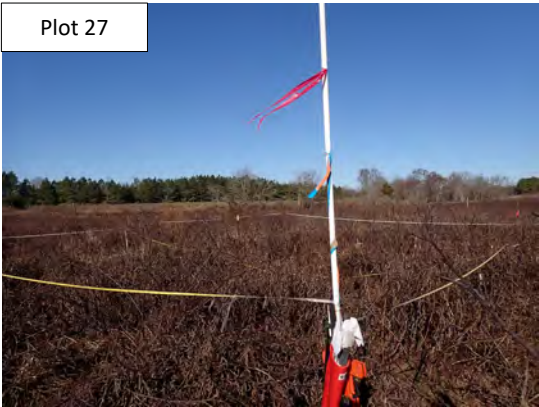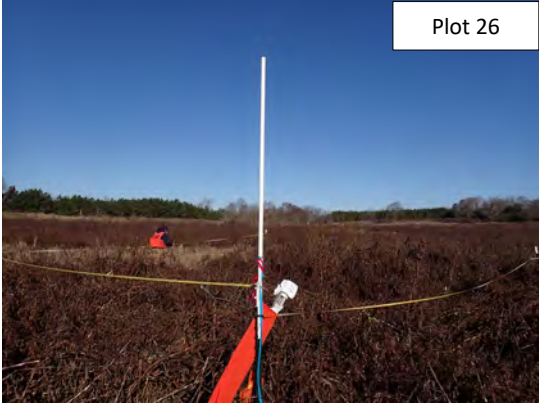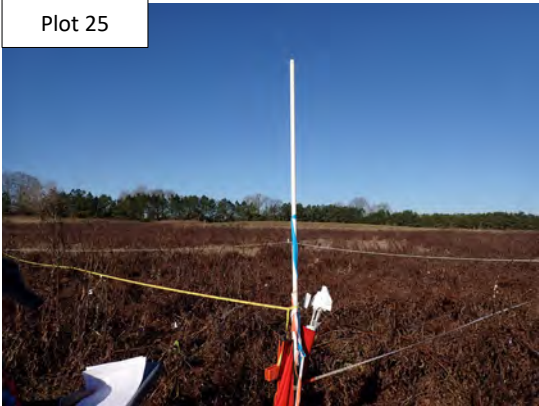

**Wits End Stream and Wetland Mitigation Site  
MYO (2022) Vegetation Monitoring Photographs (taken February 6-10, 2023)**

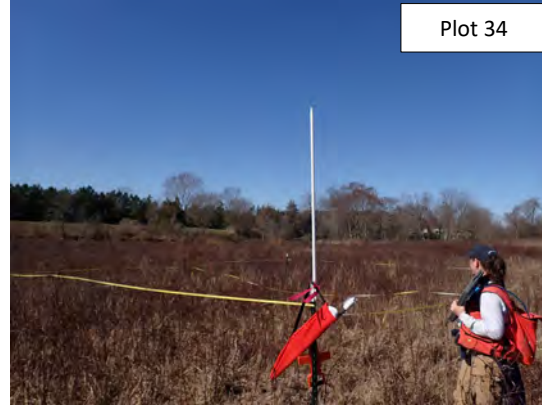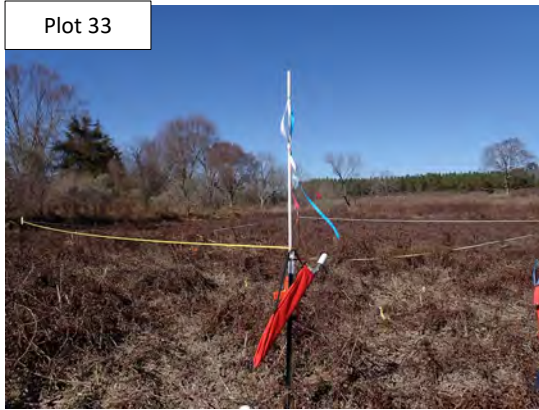



**Wits End Stream and Wetland Mitigation Site  
Photo Log**



Bridge Crossing on Waxhaw Branch, taken July 15, 2022



Forced Crossing UT 2, taken May 13, 2022



**Wits End Stream and Wetland Mitigation Site  
Photo Log (continued)**



Old Road Removed, New Road Build, taken July 22, 2022



Site Outfall and Drop Structure, taken July 15, 2022



Wits End Stream and Wetland Mitigation Site  
Photo Log (continued)



UT 4, taken March 2, 2022



UT4 and 5 Confluence, taken July 15, 2022



Wits End Stream and Wetland Mitigation Site  
Photo Log (continued)



Upper UT 3, taken May 13, 2022



UT 3, taken July 15, 2022



**Wits End Stream and Wetland Mitigation Site  
Photo Log (continued)**



Waxhaw Branch in Old Pond Bed, taken July 15, 2022



Lower Waxhaw Branch, taken May 13, 2022





Live stake planting, Waxhaw Branch, 04/07/2022



Live stake planting, UT2 Marsh Treatment Area, 04/07/2022





Live stake planting & bare root planting, UT 2, 04/07/2022



Live stake planting, Waxhaw Branch ephemeral draws/wetlands, 04/07/2022





Bare root planting, old pond bed, 04/07/2022



Live stake planting, UT3, 05/14/2022





Live stake planting, UT3, 05/14/2022



Bare root planting, UT3 / 3A, 05/24/2022





Bare root planting, Waxhaw Branch, 05/24/2022



Bare root planting, Waxhaw Branch & UT 3 confluence, 05/24/2022





1-gallon containerized planting, Waxhaw Branch, old access road/bridge construction area, 07/28/2022



1-gallon containerized planting, Waxhaw Branch, old access road/bridge construction area, 07/28/2022





1-gallon containerized planting, Waxhaw Branch, old access road/bridge construction area, 07/28/2022



1-gallon containerized planting, UT3, right bank easement edge, 07/28/2022





Plot 2



Plot 6





Plot 17



Plot 35





Vegetation transect 2



Vegetation transect 11





Stream cross-section 1, Waxhaw Branch



Stream cross-section 5, Waxhaw Branch





Stream cross-section 9, Waxhaw Branch



Stream cross-section 11, UT4





Stream cross-section 15, UT5



Stream cross-section 20, UT3





Ground water gauge 12



Ground water gauge 5



## **Appendix B: Vegetation Data**

Table 6A. Planted Woody Vegetation

Table 6B. Permanent Seed Mix – Sitewide

Table 6C. Permanent Seed Mix – Marsh Treatments, Pools, Seeps

Table 7. Vegetation Plot Counts and Densities

Table 8. Vegetation Plot Data Table from Vegetation Data Entry Tool

**Table 6A. Planted Woody Vegetation  
Wits End Stream and Wetland Mitigation Site**

<b>Bare-Root Planting</b>		
<b>Species</b>	<b>Total</b>	<b>Percent</b>
<b>Acres</b>	<b>58</b>	<b>%</b>
American Elm ( <i>Ulmus americana</i> )	3,000	4.0
American Holly ( <i>Ilex opaca</i> )	2,220	2.9
Birch River ( <i>Betula nigra</i> )	6,300	8.3
Black Gum ( <i>Nyssa sylvatica</i> )	5,049	6.7
Hackberry ( <i>Celtis occidentalis</i> )	2,900	3.8
Hickory Mockernut ( <i>Carya tomentosa</i> )	1,500	2.0
Hickory Shagbark ( <i>Carya ovata</i> )	3,500	4.6
Oak Red ( <i>Quercus rubra</i> )	4,000	5.3
Oak Swamp Chestnut ( <i>Quercus michauxii</i> )	1,700	2.2
Oak Water ( <i>Quercus nigra</i> )	12,200	16.1
Oak White ( <i>Quercus alba</i> )	4,850	6.4
Oak Willow ( <i>Quercus phellos</i> )	1,400	1.8
Persimmon ( <i>Diospyros virginiana</i> )	4,250	5.6
Red Bud ( <i>Cercis canadensis</i> )	1,900	2.5
Silky Dogwood ( <i>Cornus amomum</i> )	7,550	10.0
Sycamore ( <i>Platanus occidentalis</i> )	7,900	10.4
Tulip Poplar ( <i>Liriodendron tulipifera</i> )	5,050	6.7
Tupelo Gum ( <i>Nyssa aquatica</i> )	500	0.7
<b>TOTALS</b>	<b>75,769</b>	<b>100</b>
<b>Average Stems/Acre</b>	<b>1306</b>	
<b>1-Gallon Containerized Planting</b>		
<b>Species</b>	<b>Total</b>	<b>Percent</b>
<b>Acres</b>	<b>1.5</b>	<b>%</b>
American Elm ( <i>Ulmus americana</i> )	40	7.7
Birch River ( <i>Betula nigra</i> )	40	7.7
Black Gum ( <i>Nyssa sylvatica</i> )	70	13.5
Oak Red ( <i>Quercus rubra</i> )	60	11.5
Oak Water ( <i>Quercus nigra</i> )	90	17.3
Oak White ( <i>Quercus alba</i> )	90	17.3
Red Bud ( <i>Cercis canadensis</i> )	60	11.5
Sycamore ( <i>Platanus occidentalis</i> )	30	5.8
Tulip Poplar ( <i>Liriodendron tulipifera</i> )	40	7.7
<b>TOTALS</b>	<b>520</b>	<b>100</b>
<b>Average Stems/Acre</b>	<b>347</b>	

**Table 6B. Permanent Seed Mix - Sitewide  
Wits End Stream and Wetland Mitigation Site**

Species*	%	Species*	%
Common Yarrow ( <i>Achillea millefolium</i> )	0.98	Boneset ( <i>Eupatorium perfoliatum</i> )	0.25
Redtop ( <i>Agrostis gigantea</i> )	14.98	Perennial Gaillardia (Blanketflower) ( <i>Gaillardia perennialis</i> )	0.49
Winter Bentgrass ( <i>Agrostis hyemalis</i> )	4.90	Narrowleaf Sunflower ( <i>Helianthus angustifolius</i> )	0.50
Autumn Bentgrass ( <i>Agrostis perennans</i> )	4.97	Oxeye Sunflower ( <i>Heliopsis helianthoides</i> )	0.50
Creeping Bentgrass ( <i>Agrostis stolonifera</i> )	4.98	Crimson-eyed Rosemallow ( <i>Hibiscus moscheutos</i> )	0.50
Blue False Indigo ( <i>Baptisia australis</i> )	2.00	Path Rush ( <i>Juncus tenuis</i> )	0.45
Fox Sedge ( <i>Carex vulpinoidea</i> )	0.94	Roundhead Lespedeza ( <i>Lespedeza capitata</i> )	0.50
Partridge Pea ( <i>Chamaecrista fasciculata</i> )	1.00	Marsh Blazing Star ( <i>Liatis spicata</i> )	0.49
Sensitive Pea ( <i>Chamaecrista nictitans</i> )	1.00	Wild Bergamot ( <i>Monarda fistulosa</i> )	0.50
Oxeye Daisy ( <i>Leucanthemum vulgare</i> )	4.98	Beaked Panicgrass ( <i>Panicum anceps</i> )	0.46
Shasta Daisy ( <i>Leucanthemum superbum</i> )	2.99	Deertongue, Tioga ( <i>Dichanthelium clandestinum</i> )	4.95
Lanceleaf Coreopsis ( <i>Coreopsis lanceolata</i> )	3.96	Tall White Beardtongue ( <i>Penstemon digitalis</i> )	0.99
Plains Coreopsis ( <i>Coreopsis tinctoria</i> )	3.95	Clasping Coneflower ( <i>Dracopis amplexicaulis</i> )	1.00
Cosmos ( <i>Cosmos bipinnatus</i> )	1.00	Black-eyed Susan ( <i>Rudbeckia hirta</i> )	2.99
Rocket Larkspur ( <i>Consolida ajacis</i> )	1.99	Wild Senna ( <i>Senna hebecarpa</i> )	0.50
Showy Ticktrefoil ( <i>Desmodium canadense</i> )	0.98	Purpletop ( <i>Tridens flavus</i> )	16.76
Purple Coneflower ( <i>Echinacea purpurea</i> )	4.75	Blue Vervain ( <i>Verbena hastata</i> )	1.00
Virginia Wildrye ( <i>Elymus virginicus</i> )	4.06		
			<b>Total = 100%</b>

\* This seed mix was applied at 2 lbs per acre sitewide.

**Table 6C. Permanent Seed Mix – Marsh Treatments, Pools, Seeps  
Wits End Stream and Wetland Mitigation Site**

Species*	%	Species*	%
Switchgrass ( <i>Panicum rigidulum</i> )	36	Virginia Wildrye ( <i>Elymus virginicus</i> )	6
Bearded Beggarticks ( <i>Bidens aristosa</i> )	20	Soft Rush ( <i>Juncus effusus</i> )	5
Narrowleaf Sunflower ( <i>Helianthus angustifolius</i> )	18	Common Hop Sedge ( <i>Carex lupulina</i> )	5
Greenwhite sedge ( <i>Carex albolutescens</i> )	8	Fox Sedge ( <i>Carex vulpinoidea</i> )	2
			<b>Total = 100%</b>

\* This seed mix was applied at 5 lbs per acre in marsh treatment areas, pools, and seeps.



**Table 7. Planted Vegetation Totals  
Wits End Stream and Wetland Mitigation Site**

<b>Plot #</b>	<b>Planted Stems/Acre</b>	<b>Success Criteria Met?</b>
1	405	Yes
2	324	Yes
3	405	Yes
4	486	Yes
5	283	No
6	486	Yes
7	729	Yes
8	445	Yes
9	526	Yes
10	607	Yes
11	405	Yes
12	324	Yes
13	486	Yes
14	810	Yes
15	405	Yes
16	283	No
17	526	Yes
18	607	Yes
19	526	Yes
20	364	Yes
21	688	Yes
22	405	Yes
23	648	Yes
24	324	Yes
25	324	Yes
26	324	Yes
27	364	Yes
28	405	Yes
29	283	No
30	324	Yes
31	405	Yes
32	486	Yes
33	283	No
34	162	No
35	445	Yes
36	40	No
37	405	Yes

**Table 7. Planted Vegetation Totals (Continued)**  
**Wits End Stream and Wetland Mitigation Site**

<b>Plot #</b>	<b>Planted Stems/Acre</b>	<b>Success Criteria Met?</b>
T-1	162	No
T-2	1417	Yes
T-3	486	Yes
T-4	364	Yes
T-5	364	Yes
T-6	81	No
T-7	364	Yes
T-8	405	Yes
T-9	405	Yes
T-10	202	No
T-11	81	No
T-12	162	No
<b>Average Planted Stems/Acre</b>	<b>413</b>	<b>Yes</b>

**Table 8. Vegetation Plot Data Table from Vegetation Data Entry Tool**

Planted Acreage	58
Date of Initial Plant	2023-01-23
Date(s) of Supplemental Plant(s)	NA
Date(s) Mowing	NA
Date of Current Survey	2023-02-10
Plot size (ACRES)	0.0247

	Scientific Name	Common Name	Tree/Shrub	Indicator Status	Veg Plot 1 F		Veg Plot 2 F		Veg Plot 3 F		Veg Plot 4 F		Veg Plot 5 F		Veg Plot 6 F		Veg Plot 7 F		Veg Plot 8 F		Veg Plot 9 F	
					Planted	Total	Planted	Total	Planted	Total	Planted	Total	Planted	Total	Planted	Total	Planted	Total	Planted	Total	Planted	Total
Species Included in Approved Mitigation Plan	<i>Betula nigra</i>	river birch	Tree	FACW	4	4	1	1					1	1	3	3	4	4			2	2
	<i>Carya ovata</i>	shagbark hickory	Tree	FACU																		
	<i>Celtis occidentalis</i>	common hackberry	Tree	FACU																		
	<i>Cercis canadensis</i>	eastern redbud	Tree	FACU																		
	<i>Cornus amomum</i>	silky dogwood	Shrub	FACW	1	1	1	1			1	1	2	2	3	3					2	2
	<i>Diospyros virginiana</i>	common persimmon	Tree	FAC			1	1			1	1	1	1	1	1					1	1
	<i>Liriodendron tulipifera</i>	tuliptree	Tree	FACU	1	1			2	2	1	1										
	<i>Nyssa sylvatica</i>	blackgum	Tree	FAC							1	1									1	1
	<i>Platanus occidentalis</i>	American sycamore	Tree	FACW			7	7	3	3	4	7	1	1	1	1	2	2	3	3		
	<i>Quercus alba</i>	white oak	Tree	FACU													2	2				
	<i>Quercus michauxii</i>	swamp chestnut oak	Tree	FACW															4	4		
	<i>Quercus nigra</i>	water oak	Tree	FAC	2	2			1	1	1	1					10	10	2	2	3	3
	<i>Quercus phellos</i>	willow oak	Tree	FAC					2	2	1	1			4	4	1	1	1	1	1	1
<i>Quercus rubra</i>	northern red oak	Tree	FACU					1	1											2	2	
<i>Quercus sp.</i>					2	2			1	1										1	1	
<i>Ulmus americana</i>	American elm	Tree	FACW									2	2							1	1	
Sum	Performance Standard				10	10	3	10	7	10	10	13	7	7	12	12	19	19	11	11	13	13
Mitigation Plan Performance Standard	Current Year Stem Count				10		10		10		13		7		12		19		11		13	
	Stems/Acre				405		324		405		486		283		486		729		445		526	
	Species Count				5		4		6		7		5		5		5		5		8	
	Dominant Species Composition (%)				40		70		30		54		29		33		53		36		23	
	Average Plot Height (ft.)				2		3		2		2		2		2		2		2		2	
% Invasives				0		0		0		0		0		0		0		0		0		
Post Mitigation Plan Performance Standard	Current Year Stem Count				10		10		10		13		7		12		19		11		13	
	Stems/Acre				405		324		405		486		283		486		729		445		526	
	Species Count				5		4		6		7		5		5		5		5		8	
	Dominant Species Composition (%)				40		70		30		54		29		33		53		36		23	
	Average Plot Height (ft.)				2		3		2		2		2		2		2		2		2	
% Invasives				0		0		0		0		0		0		0		0		0		

1). Bolded species are proposed for the current monitoring year, italicized species are not approved, and a regular font indicates that the species has been approved.  
 2). The "Species Included in Approved Mitigation Plan" section contains only those species that were included in the original approved mitigation plan. The "Post Mitigation Plan Species" section includes species that are being proposed through a mitigation plan addendum for the current monitoring year (bolded) , species that have been approved in prior monitoring years through a mitigation plan addendum (regular font), and species that are not approved (italicized).  
 3). The "Mitigation Plan Performance Standard" section is derived only from stems included in the original mitigation plan, whereas the "Post Mitigation Plan Performance Standard" includes data from mitigation plan approved, post mitigation plan approved, and proposed stems.

**Table 8. Vegetation Plot Data Table from Vegetation Data Entry Tool (continued)**

Planted Acreage	58
Date of Initial Plant	2023-01-23
Date(s) of Supplemental Plant(s)	NA
Date(s) Mowing	NA
Date of Current Survey	2023-02-10
Plot size (ACRES)	0.0247

	Scientific Name	Common Name	Tree/Shrub	Indicator Status	Veg Plot 10 F		Veg Plot 11 F		Veg Plot 12 F		Veg Plot 13 F		Veg Plot 14 F		Veg Plot 15 F		Veg Plot 16 F		Veg Plot 17 F		Veg Plot 18 F	
					Planted	Total	Planted	Total	Planted	Total	Planted	Total	Planted	Total	Planted	Total	Planted	Total	Planted	Total	Planted	Total
Species Included in Approved Mitigation Plan	<i>Betula nigra</i>	river birch	Tree	FACW	1	1	1	1			2	2	2	2	2	2			2	2	5	5
	<i>Carya ovata</i>	shagbark hickory	Tree	FACU																		
	<i>Celtis occidentalis</i>	common hackberry	Tree	FACU																		
	<i>Cercis canadensis</i>	eastern redbud	Tree	FACU											2	2						
	<i>Cornus amomum</i>	silky dogwood	Shrub	FACW	7	7			2	2	1	1	3	3					1	1	2	2
	<i>Diospyros virginiana</i>	common persimmon	Tree	FAC																		
	<i>Liriodendron tulipifera</i>	tuliptree	Tree	FACU					3	3												
	<i>Nyssa sylvatica</i>	blackgum	Tree	FAC									1	1							1	1
	<i>Platanus occidentalis</i>	American sycamore	Tree	FACW									6	6	3	3					9	9
	<i>Quercus alba</i>	white oak	Tree	FACU																		
	<i>Quercus michauxii</i>	swamp chestnut oak	Tree	FACW	1	1	2	2	1	1	1	1					1	1				
	<i>Quercus nigra</i>	water oak	Tree	FAC	2	2	1	1			3	3	2	2	1	1	2	2	1	1		
	<i>Quercus phellos</i>	willow oak	Tree	FAC	3	3	1	1	1	1	1	1	1	1					1	1	1	1
<i>Quercus rubra</i>	northern red oak	Tree	FACU			4	4			3	3											
<i>Quercus sp.</i>					1	1	1	1			1	1	2	2			2	2				
<i>Ulmus americana</i>	American elm	Tree	FACW					1	1			3	3	2	2	1	1					
Sum	Performance Standard				15	15	10	10	8	8	12	12	20	20	10	10	7	7	15	15	17	17
Mitigation Plan Performance Standard	Current Year Stem Count				15		10		8		12		20		10		7		15		17	
	Stems/Acre				607		405		324		486		810		405		283		526		607	
	Species Count				6		6		5		7		8		5		5		6		3	
	Dominant Species Composition (%)				47		40		38		25		30		30		29		60		59	
	Average Plot Height (ft.)				2		2		1		1		2		1		1		2		2	
	% Invasives				0		0		0		0		0		0		0		0		0	
Post Mitigation Plan Performance Standard	Current Year Stem Count				15		10		8		12		20		10		7		15		17	
	Stems/Acre				607		405		324		486		810		405		283		526		607	
	Species Count				6		6		5		7		8		5		5		6		3	
	Dominant Species Composition (%)				47		40		38		25		30		30		29		60		59	
	Average Plot Height (ft.)				2		2		1		1		2		1		1		2		2	
	% Invasives				0		0		0		0		0		0		0		0		0	

- 1). Bolded species are proposed for the current monitoring year, italicized species are not approved, and a regular font indicates that the species has been approved.
- 2). The "Species Included in Approved Mitigation Plan" section contains only those species that were included in the original approved mitigation plan. The "Post Mitigation Plan Species" section includes species that are being proposed through a mitigation plan addendum for the current monitoring year (bolded), species that have been approved in prior monitoring years through a mitigation plan addendum (regular font), and species that are not approved (italicized).
- 3). The "Mitigation Plan Performance Standard" section is derived only from stems included in the original mitigation plan, whereas the "Post Mitigation Plan Performance Standard" includes data from mitigation plan approved, post mitigation plan approved, and proposed stems.



**Table 8. Vegetation Plot Data Table from Vegetation Data Entry Tool (continued)**

Planted Acreage	58
Date of Initial Plant	2023-01-23
Date(s) of Supplemental Plant(s)	NA
Date(s) Mowing	NA
Date of Current Survey	2023-02-10
Plot size (ACRES)	0.0247

	Scientific Name	Common Name	Tree/Shrub	Indicator Status	Veg Plot 19 F		Veg Plot 20 F		Veg Plot 21 F		Veg Plot 22 F		Veg Plot 23 F		Veg Plot 24 F		Veg Plot 25 F		Veg Plot 26 F		Veg Plot 27 F	
					Planted	Total	Planted	Total	Planted	Total	Planted	Total	Planted	Total	Planted	Total	Planted	Total	Planted	Total	Planted	Total
Species Included in Approved Mitigation Plan	<i>Betula nigra</i>	river birch	Tree	FACW	1	1	1	1	7	7			9	9			5	5	1	1	2	2
	<i>Carya ovata</i>	shagbark hickory	Tree	FACU									1	1	1	1	2	2				
	<i>Celtis occidentalis</i>	common hackberry	Tree	FACU																	1	1
	<i>Cercis canadensis</i>	eastern redbud	Tree	FACU																		
	<i>Cornus amomum</i>	silky dogwood	Shrub	FACW	4	4						2	2						3	3	1	1
	<i>Diospyros virginiana</i>	common persimmon	Tree	FAC							1	1					1	1				
	<i>Liriodendron tulipifera</i>	tuliptree	Tree	FACU											2	2	1	1				
	<i>Nyssa sylvatica</i>	blackgum	Tree	FAC	4	4	2	2	1	1											3	3
	<i>Platanus occidentalis</i>	American sycamore	Tree	FACW					7	7											2	2
	<i>Quercus alba</i>	white oak	Tree	FACU									6	6	2	2						
	<i>Quercus michauxii</i>	swamp chestnut oak	Tree	FACW	2	2	1	1	1	1	1	1										
	<i>Quercus nigra</i>	water oak	Tree	FAC			2	2			2	2	1	1	3	3			4	4		
	<i>Quercus phellos</i>	willow oak	Tree	FAC							3	3										
<i>Quercus rubra</i>	northern red oak	Tree	FACU					1	1	1	1											
<i>Quercus sp.</i>					2	2	1	1														
<i>Ulmus americana</i>	American elm	Tree	FACW			2	2															
Sum	Performance Standard				13	13	9	9	17	17	10	10	17	17	8	8	9	9	8	8	9	9
Mitigation Plan Performance Standard	Current Year Stem Count				13		9		17		10		17		8		9		8		9	
	Stems/Acre				526		364		688		405		648		324		324		324		364	
	Species Count				5		6		5		6		4		4		4		3		5	
	Dominant Species Composition (%)				31		22		41		30		53		38		56		50		33	
	Average Plot Height (ft.)				1		2		2		2		2		1		1		2		3	
% Invasives				0		0		0		0		0		0		0		0		0		
Post Mitigation Plan Performance Standard	Current Year Stem Count				13		9		17		10		17		8		9		8		9	
	Stems/Acre				526		364		688		405		648		324		324		324		364	
	Species Count				5		6		5		6		4		4		4		3		5	
	Dominant Species Composition (%)				31		22		41		30		53		38		56		50		33	
	Average Plot Height (ft.)				1		2		2		2		2		1		1		2		3	
% Invasives				0		0		0		0		0		0		0		0		0		

- 1). Bolded species are proposed for the current monitoring year, italicized species are not approved, and a regular font indicates that the species has been approved.
- 2). The "Species Included in Approved Mitigation Plan" section contains only those species that were included in the original approved mitigation plan. The "Post Mitigation Plan Species" section includes species that are being proposed through a mitigation plan addendum for the current monitoring year (bolded) , species that have been approved in prior monitoring years through a mitigation plan addendum (regular font), and species that are not approved (italicized).
- 3). The "Mitigation Plan Performance Standard" section is derived only from stems included in the original mitigation plan, whereas the "Post Mitigation Plan Performance Standard" includes data from mitigation plan approved, post mitigation plan approved, and proposed stems.

**Table 8. Vegetation Plot Data Table from Vegetation Data Entry Tool (continued)**

Planted Acreage	58
Date of Initial Plant	2023-01-23
Date(s) of Supplemental Plant(s)	NA
Date(s) Mowing	NA
Date of Current Survey	2023-02-10
Plot size (ACRES)	0.0247

	Scientific Name	Common Name	Tree/Shrub	Indicator Status	Veg Plot 28 F		Veg Plot 29 F		Veg Plot 30 F		Veg Plot 31 F		Veg Plot 32 F		Veg Plot 33 F		Veg Plot 34 F		Veg Plot 35 F		Veg Plot 36 F	
					Planted	Total	Planted	Total	Planted	Total	Planted	Total	Planted	Total	Planted	Total	Planted	Total	Planted	Total	Planted	Total
Species Included in Approved Mitigation Plan	<i>Betula nigra</i>	river birch	Tree	FACW	1	1	1	1	1	1			1	1					1	1	2	2
	<i>Carya ovata</i>	shagbark hickory	Tree	FACU	4	4	1	1			1	1	1	1					1	1		
	<i>Celtis occidentalis</i>	common hackberry	Tree	FACU	1	1																
	<i>Cercis canadensis</i>	eastern redbud	Tree	FACU																		
	<i>Cornus amomum</i>	silky dogwood	Shrub	FACW	4	4					1	1	1	1	3	3	1	1			2	2
	<i>Diospyros virginiana</i>	common persimmon	Tree	FAC																		
	<i>Liriodendron tulipifera</i>	tuliptree	Tree	FACU					2	2												
	<i>Nyssa sylvatica</i>	blackgum	Tree	FAC							2	2										
	<i>Platanus occidentalis</i>	American sycamore	Tree	FACW			1	1														
	<i>Quercus alba</i>	white oak	Tree	FACU			1	1	2	2	1	1	2	2	1	1	1	1	2	2		
	<i>Quercus michauxii</i>	swamp chestnut oak	Tree	FACW																		
	<i>Quercus nigra</i>	water oak	Tree	FAC			1	1	2	2	5	5	2	2	8	8			1	1	1	1
	<i>Quercus phellos</i>	willow oak	Tree	FAC			1	1											1	1		
<i>Quercus rubra</i>	northern red oak	Tree	FACU										3	3			3	3	1	1		
<i>Quercus sp.</i>																						
<i>Ulmus americana</i>	American elm	Tree	FACW			1	1											3	3			
Sum	Performance Standard				10	10	7	7	8	8	10	10	12	12	10	10	5	5	11	11	2	2
Mitigation Plan Performance Standard	Current Year Stem Count				10		7		8		10		12		10		5		11		2	
	Stems/Acre				405		283		324		405		486		283		162		445		40	
	Species Count				4		7		5		5		6		3		3		7		1	
	Dominant Species Composition (%)				40		14		25		50		25		80		60		27		100	
	Average Plot Height (ft.)				1		1		1		2		2		2		2		1		2	
	% Invasives				0		0		0		0		0		0		0		0		0	
Post Mitigation Plan Performance Standard	Current Year Stem Count				10		7		8		10		12		10		5		11		2	
	Stems/Acre				405		283		324		405		486		283		162		445		40	
	Species Count				4		7		5		5		6		3		3		7		1	
	Dominant Species Composition (%)				40		14		25		50		25		80		60		27		100	
	Average Plot Height (ft.)				1		1		1		2		2		2		2		1		2	
	% Invasives				0		0		0		0		0		0		0		0		0	

- 1). Bolded species are proposed for the current monitoring year, italicized species are not approved, and a regular font indicates that the species has been approved.
- 2). The "Species Included in Approved Mitigation Plan" section contains only those species that were included in the original approved mitigation plan. The "Post Mitigation Plan Species" section includes species that are being proposed through a mitigation plan addendum for the current monitoring year (bolded) , species that have been approved in prior monitoring years through a mitigation plan addendum (regular font), and species that are not approved (italicized).
- 3). The "Mitigation Plan Performance Standard" section is derived only from stems included in the original mitigation plan, whereas the "Post Mitigation Plan Performance Standard" includes data from mitigation plan approved, post mitigation plan approved, and proposed stems.

**Table 8. Vegetation Plot Data Table from Vegetation Data Entry Tool (continued)**

Planted Acreage	58
Date of Initial Plant	2023-01-23
Date(s) of Supplemental Plant(s)	NA
Date(s) Mowing	NA
Date of Current Survey	2023-02-10
Plot size (ACRES)	0.0247

	Scientific Name	Common Name	Tree/S hrub	Indicator Status	Veg Plot 37 F		Veg Plot 1 R	Veg Plot 2 R	Veg Plot 3 R	Veg Plot 4 R	Veg Plot 5 R	Veg Plot 6 R	Veg Plot 7 R	Veg Plot 8 R	Veg Plot 9 R	Veg Plot 10 R	Veg Plot 11 R	Veg Plot 12 R
					Planted	Total	Total	Total	Total	Total	Total	Total	Total	Total	Total	Total	Total	Total
Species Included in Approved Mitigation Plan	<i>Betula nigra</i>	river birch	Tree	FACW	1	1		3	4	3	2			1	1			
	<i>Carya ovata</i>	shagbark hickory	Tree	FACU				1						9				
	<i>Celtis occidentalis</i>	common hackberry	Tree	FACU				1		1								1
	<i>Cercis canadensis</i>	eastern redbud	Tree	FACU														
	<i>Cornus amomum</i>	silky dogwood	Shrub	FACW			1	17	2	2					3	2	1	1
	<i>Diospyros virginiana</i>	common persimmon	Tree	FAC	4	4		1						2				
	<i>Liriodendron tulipifera</i>	tuliptree	Tree	FACU														
	<i>Nyssa sylvatica</i>	blackgum	Tree	FAC				2	3					1		1		
	<i>Platanus occidentalis</i>	American sycamore	Tree	FACW					1	3	1				4	4		
	<i>Quercus alba</i>	white oak	Tree	FACU										2				
	<i>Quercus michauxii</i>	swamp chestnut oak	Tree	FACW			1				1							
	<i>Quercus nigra</i>	water oak	Tree	FAC	4	4	2	9	2				3	1				
	<i>Quercus phellos</i>	willow oak	Tree	FAC							3							
	<i>Quercus rubra</i>	northern red oak	Tree	FACU	1	1					1	1						
<i>Quercus sp.</i>										1			1					
<i>Ulmus americana</i>	American elm	Tree	FACW				1										1	
Sum	Performance Standard				10	10	4	35	12	9	9	2	9	13	10	6	2	4
Mitigation Plan Performance Standard	Current Year Stem Count				10	4	35	12	9	9	2	9	13	10	6	2	4	
	Stems/Acre				405	162	1417	486	364	364	81	364	405	405	202	81	162	
	Species Count				4	3	8	5	4	6	2	5	4	5	2	2	4	
	Dominant Species Composition (%)				40	50	49	33	33	33	50	33	69	40	67	50	25	
	Average Plot Height (ft.)				2	2	2	1	2	2	1	2	3	2	2	2	1	
	% Invasives				0	0	0	0	0	0	0	0	0	0	0	0	0	
Post Mitigation Plan Performance Standard	Current Year Stem Count				10	4	35	12	9	9	2	9	13	10	6	2	4	
	Stems/Acre				405	162	1417	486	364	364	81	364	405	405	202	81	162	
	Species Count				4	3	8	5	4	6	2	5	4	5	2	2	4	
	Dominant Species Composition (%)				40	50	49	33	33	33	50	33	69	40	67	50	25	
	Average Plot Height (ft.)				2	2	2	1	2	2	1	2	3	2	2	2	1	
	% Invasives				0	0	0	0	0	0	0	0	0	0	0	0	0	

1). Bolded species are proposed for the current monitoring year, italicized species are not approved, and a regular font indicates that the species has been approved.

2). The "Species Included in Approved Mitigation Plan" section contains only those species that were included in the original approved mitigation plan. The "Post Mitigation Plan Species" section includes species that are being proposed through a mitigation plan addendum for the current monitoring year (bolded) , species that have been approved in prior monitoring years through a mitigation plan addendum (regular font), and species that are not approved (italicized).

3). The "Mitigation Plan Performance Standard" section is derived only from stems included in the original mitigation plan, whereas the "Post Mitigation Plan Performance Standard" includes data from mitigation plan approved, post mitigation plan approved, and proposed stems.



## **Appendix C: Stream Geomorphology Data**

Cross-Sections with Annual Overlays

Longitudinal Profile

Table 9A-I. Baseline Stream Data Summary Tables

Table 10A-F. Cross-Section Morphology Monitoring Summary


<b>Site</b>	Wits End Site
<b>Watershed:</b>	Yadkin River Basin, 03040105
<b>XS ID</b>	Waxhaw Br, XS -1
<b>Feature</b>	Riffle
<b>Date:</b>	6/2/2022
<b>Field Crew:</b>	Perkinson



Station	Elevation
0.0	573.0
2.9	573.0
8.9	573.0
12.8	572.9
13.7	572.6
14.5	572.2
15.0	572.1
16.0	572.0
16.7	571.8
17.5	571.6
18.4	571.4
19.5	571.4
21.1	571.3
22.6	571.4
24.0	571.3
26.1	571.3
27.5	571.6
28.4	571.8
29.2	572.0
30.0	572.3
30.7	572.66
31.2	572.8
34.8	572.9
38.5	572.9
41.8	573.1
45.5	572.9

SUMMARY DATA	
<b>Bankfull Elevation:</b>	572.78
<b>Bank Height Ratio:</b>	1.00
<b>Thalweg Elevation:</b>	571.33
<b>LTOB Elevation:</b>	572.78
<b>LTOB Max Depth:</b>	1.45
<b>LTOB Cross Sectional Area:</b>	19.0

<b>Stream Type</b>	E/C
--------------------	-----

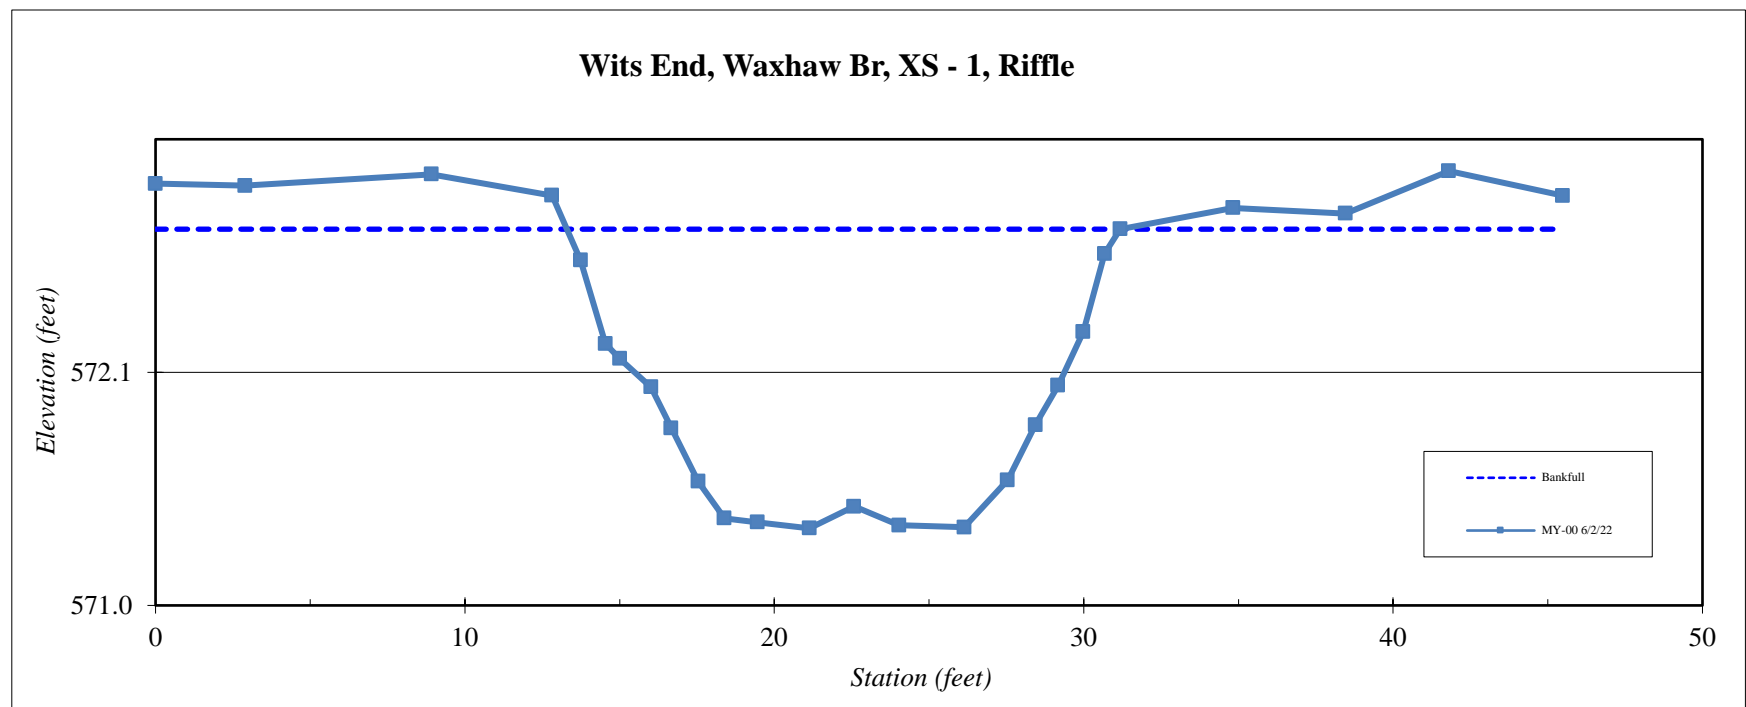










<b>Site</b>	Wits End Site
<b>Watershed:</b>	Yadkin River Basin, 03040105
<b>XS ID</b>	Waxhaw Br, XS -4
<b>Feature</b>	Pool
<b>Date:</b>	6/2/2022
<b>Field Crew:</b>	Perkinson



SUMMARY DATA	
<b>Bankfull Elevation:</b>	578.36
<b>Bank Hieght Ratio:</b>	1.00
<b>Thalweg Elevation:</b>	576.45
<b>LTOB Elevation:</b>	578.36
<b>LTOB Max Depth:</b>	1.92
<b>LTOB Cross Sectional Area:</b>	18.6

Station	Elevation
0.0	578.5
3.9	578.5
6.4	578.4
8.1	578.0
9.3	577.7
9.6	577.5
10.4	577.0
11.8	576.5
12.7	576.6
13.8	576.6
15.8	576.4
16.8	576.5
17.7	576.7
18.4	576.8
19.1	577.1
19.4	577.4
20.5	578.0
21.2	578.3
22.0	578.5
23.9	578.6
26.2	578.35
29.3	578.5
31.3	578.5

<b>Stream Type</b>	E/C
--------------------	-----

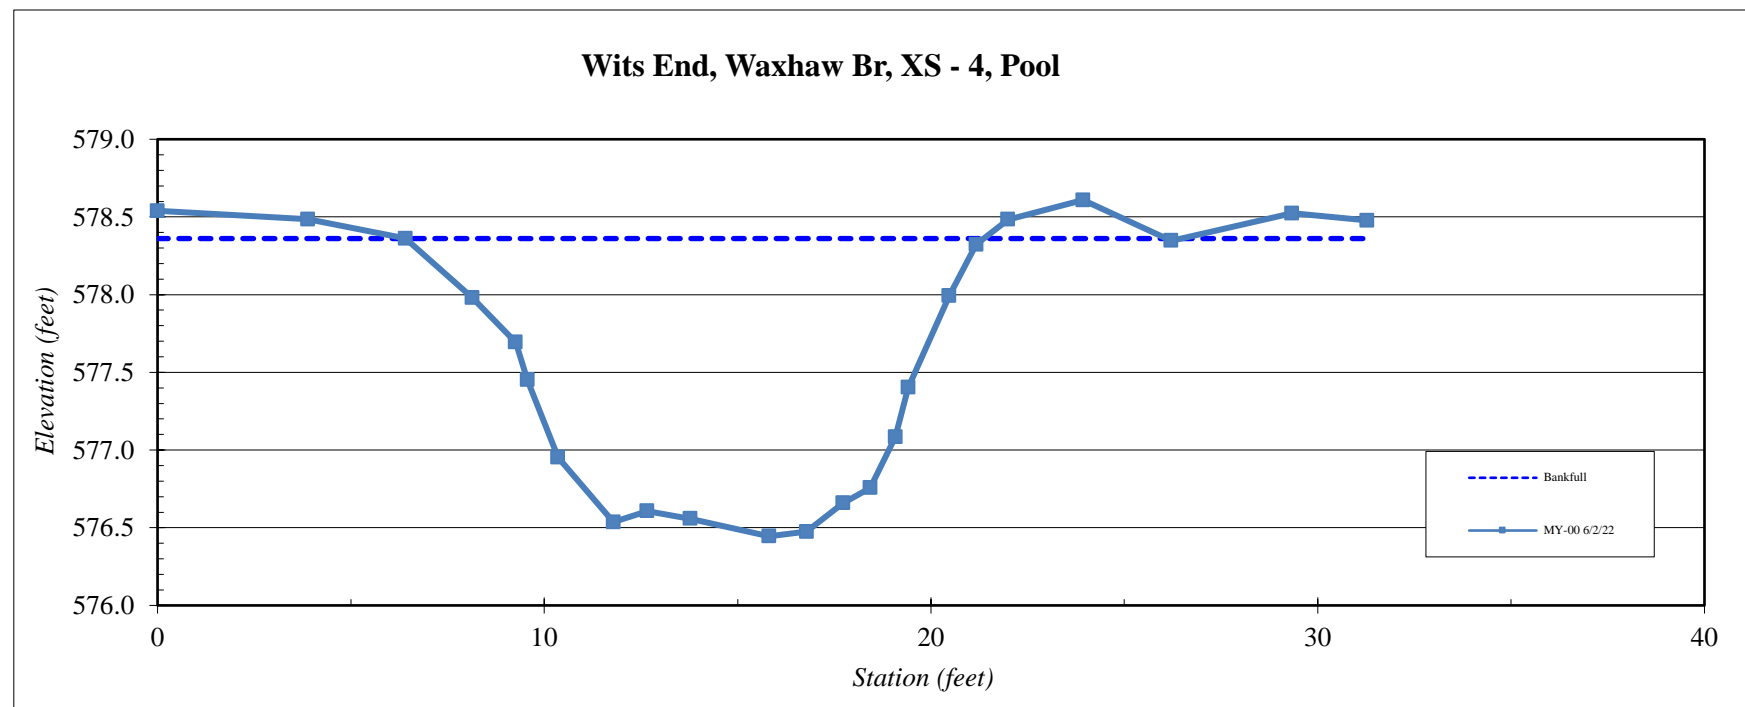


<b>Site</b>	Wits End Site
<b>Watershed:</b>	Yadkin River Basin, 03040105
<b>XS ID</b>	Waxhaw Br, XS -5
<b>Feature</b>	Riffle
<b>Date:</b>	6/2/2022
<b>Field Crew:</b>	Perkinson



Station	Elevation
0.0	583.9
4.0	584.0
7.1	584.1
9.3	584.0
10.4	583.6
11.0	583.3
11.6	583.1
12.7	582.7
15.0	582.7
16.9	582.6
18.8	582.6
20.6	582.6
21.8	582.8
22.6	582.9
23.5	583.2
24.4	583.6
25.6	584.1
28.4	583.9
31.1	583.9
33.6	583.7

SUMMARY DATA	
<b>Bankfull Elevation:</b>	583.96
<b>Bank Height Ratio:</b>	1.00
<b>Thalweg Elevation:</b>	582.57
<b>LTOB Elevation:</b>	583.96
<b>LTOB Max Depth:</b>	1.39
<b>LTOB Cross Sectional Area:</b>	16.3

Stream Type	E/C
-------------	-----

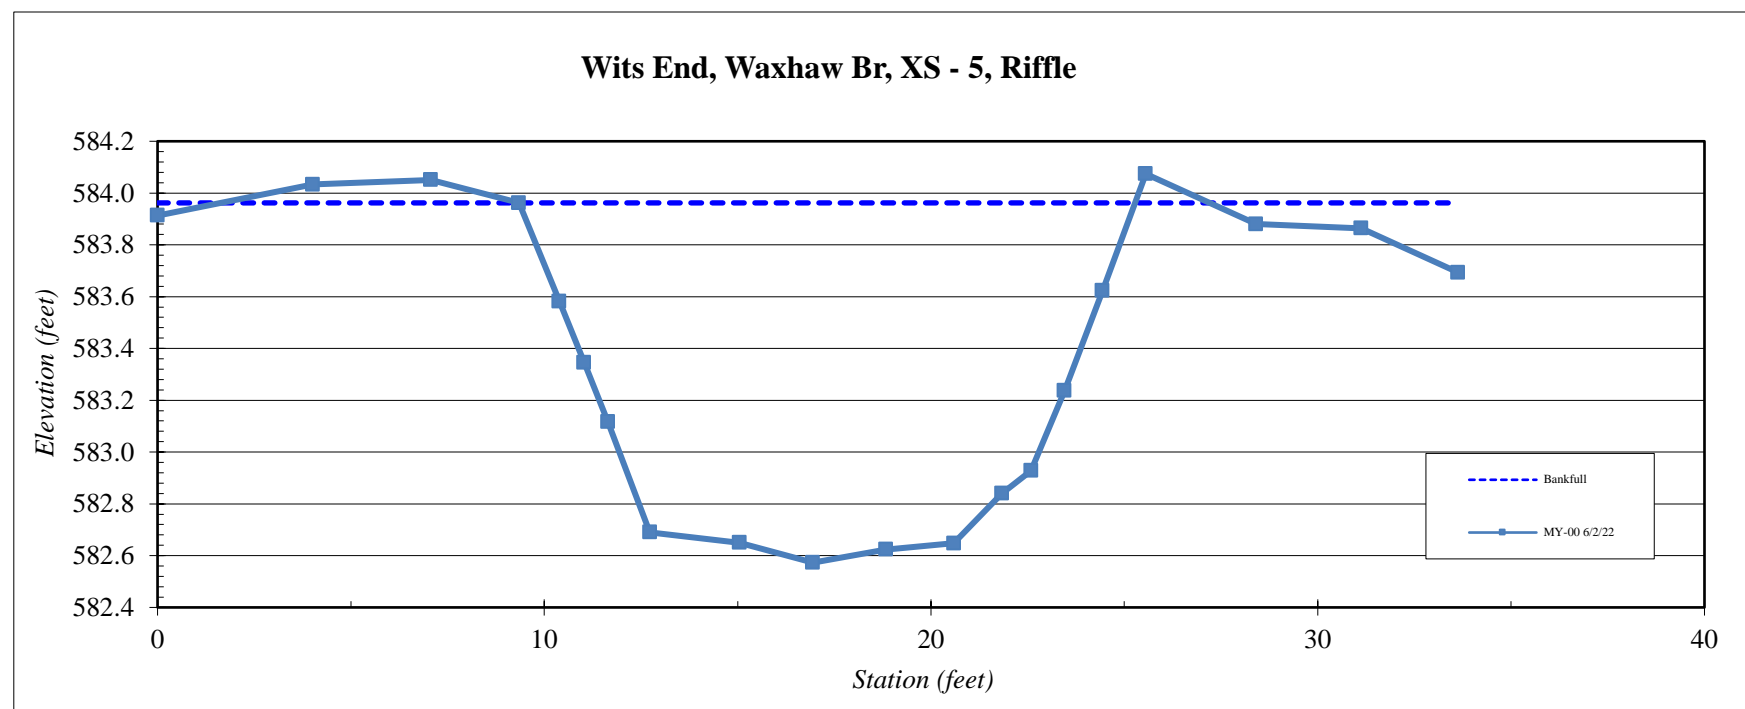




<b>Site</b>	Wits End Site
<b>Watershed:</b>	Yadkin River Basin, 03040105
<b>XS ID</b>	Waxhaw Br, XS -6
<b>Feature</b>	Pool
<b>Date:</b>	6/2/2022
<b>Field Crew:</b>	Perkinson



Station	Elevation
0.0	584.0
3.3	584.0
6.4	583.9
8.4	583.9
9.8	583.5
11.3	583.1
12.5	582.7
13.4	582.4
14.4	582.1
15.6	581.8
16.4	581.8
17.5	582.0
18.5	582.0
19.7	581.9
20.3	582.0
21.5	581.9
21.9	582.1
22.4	582.9
23.1	583.0
24.4	583.3
25.2	583.77
26.4	584.1
28.3	584.2
30.7	583.9
33.4	583.7
35.3	583.7

SUMMARY DATA	
<b>Bankfull Elevation:</b>	583.94
<b>Bank Height Ratio:</b>	1.00
<b>Thalweg Elevation:</b>	581.80
<b>LTOB Elevation:</b>	583.94
<b>LTOB Max Depth:</b>	2.14
<b>LTOB Cross Sectional Area:</b>	23.5

<b>Stream Type</b>	E/C
--------------------	-----

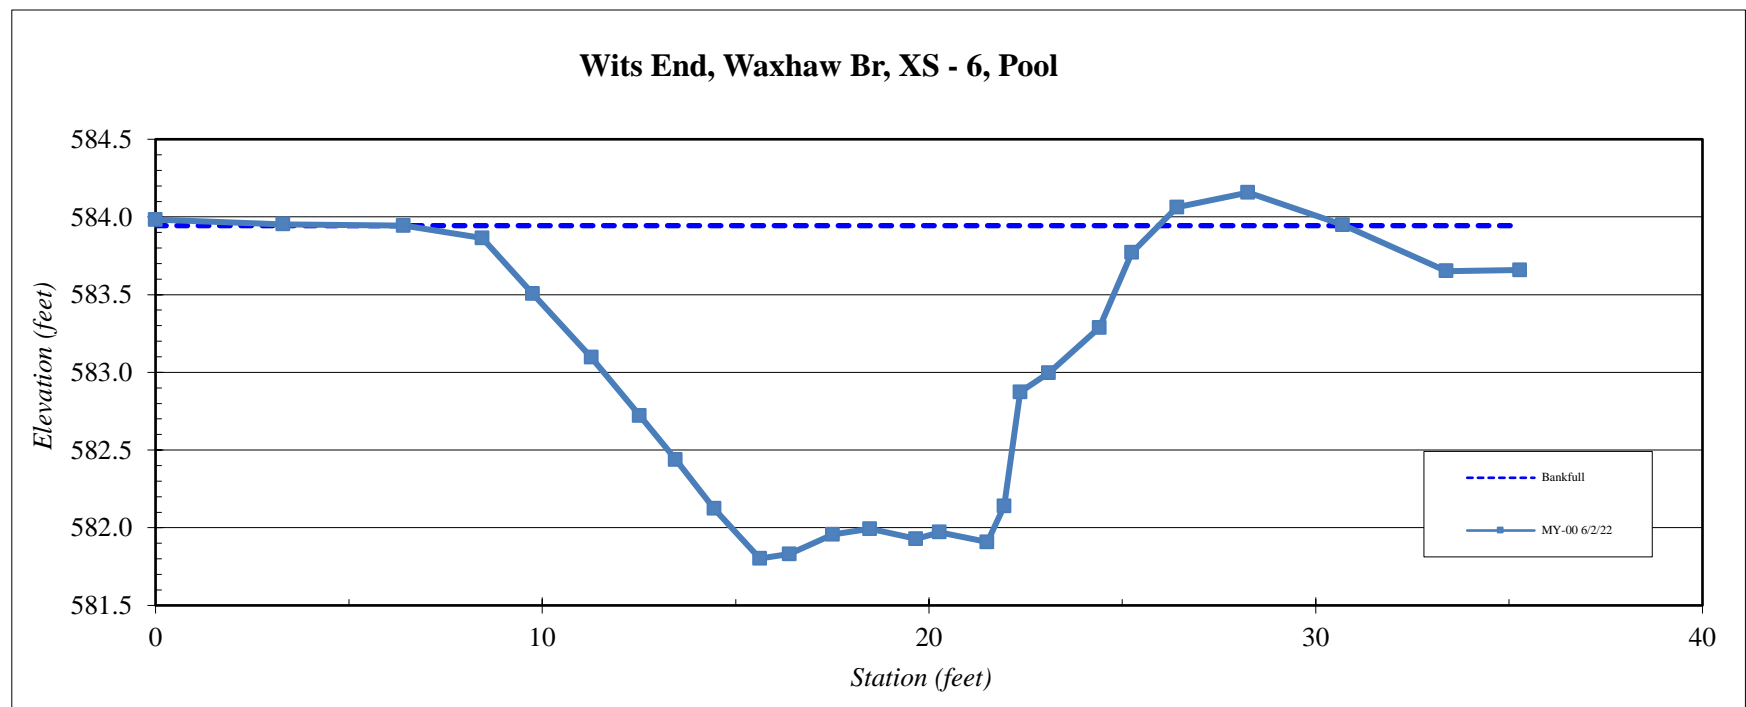
















































































<b>Project Name</b>	Wits End - Baseline (2022) Profile
<b>Reach</b>	Waxhaw Branch (Sta 40+00 to 51+00)
<b>Feature</b>	Profile
<b>Date</b>	6/2/22
<b>Crew</b>	Perkinson

2022 Baseline Survey				As needed				As needed				As needed			
Station	Bed Elevation	Water Elevation	TOB	Station	Bed Elevation	Water Elevation	TOB	Station	Bed Elevation	Water Elevation	TOB	Station	Bed Elevation	Water Elevation	TOB
3977.4	587.31														
4005.6	587.32		588.89												
4011.9	586.16	587.20													
4022.5	585.48	587.22													
4023.8	587.44														
4060.2	587.50		588.40												
4069.2	587.18	587.53													
4081.0	587.11	587.53													
4085.8	587.65														
4133.0	587.66		589.21												
4137.5	587.11	587.73													
4150.5	587.03														
4160.6	587.24														
4171.1	587.67														

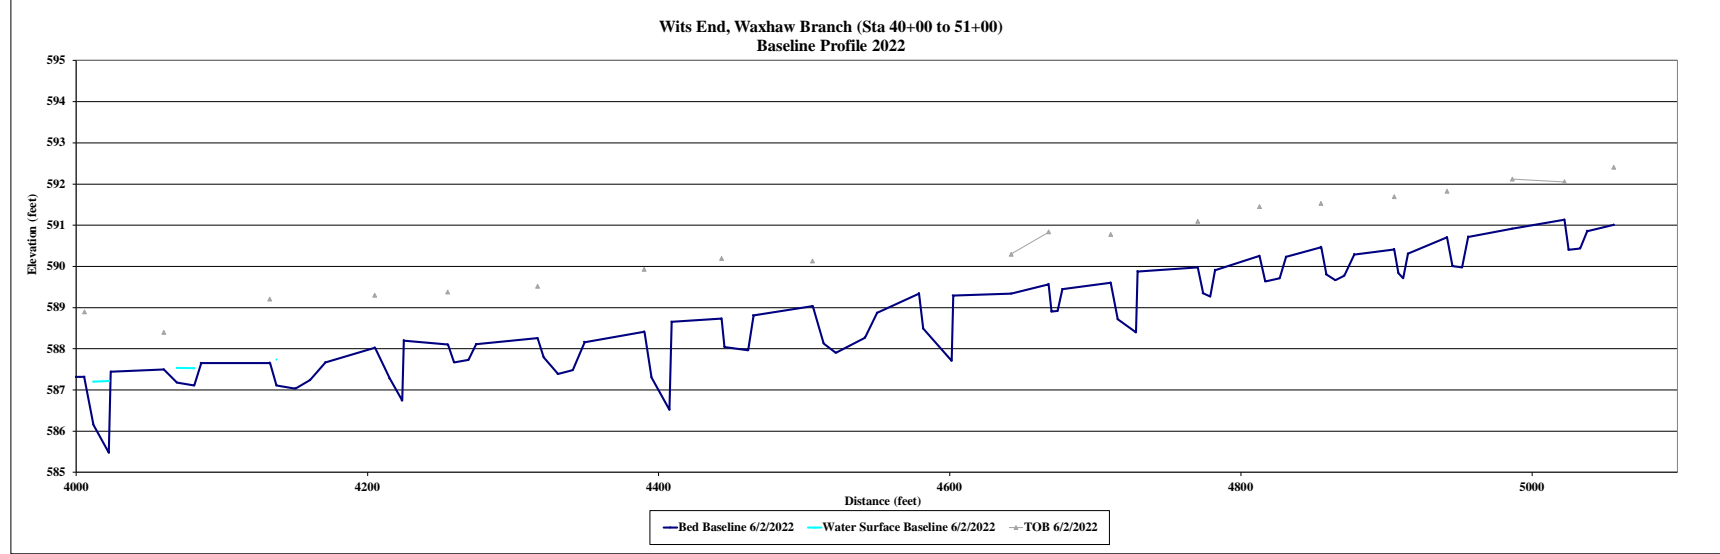


4727.929729	589.972	591.092			
4770.447514	589.973	589.347			
4773.970587	589.347				
4778.999094	589.269				
4782.272011	589.91				
4812.812082	590.256	591.145			
4816.791173	589.637				
4826.552252	589.709				
4830.960825	590.232				
4855.119403	590.469	591.525			
4858.630208	589.805				
4864.873868	589.662				
4870.912105	589.774				
4877.780967	590.29				



<b>Project Name</b>	Wits End - Baseline (2022) Profile
<b>Reach</b>	UT 1 (Sta 00+00 to 01+00)
<b>Feature</b>	Profile
<b>Date</b>	6/2/22
<b>Crew</b>	Perkinson

2022 Baseline Survey				As needed				As needed				As needed			
Station	Bed Elevation	Water Elevation	TOB	Station	Bed Elevation	Water Elevation	TOB	Station	Bed Elevation	Water Elevation	TOB	Station	Bed Elevation	Water Elevation	TOB
0.0	589.34		590.28												
17.8	589.57														
18.9	589.10														
22.6	589.01														
24.0	589.80														
40.9	589.76		590.66												
45.3	588.88														
53.7	588.54														
57.7	588.45														
59.1	589.77														
73.7	589.91														
87.2	590.33		591.23												

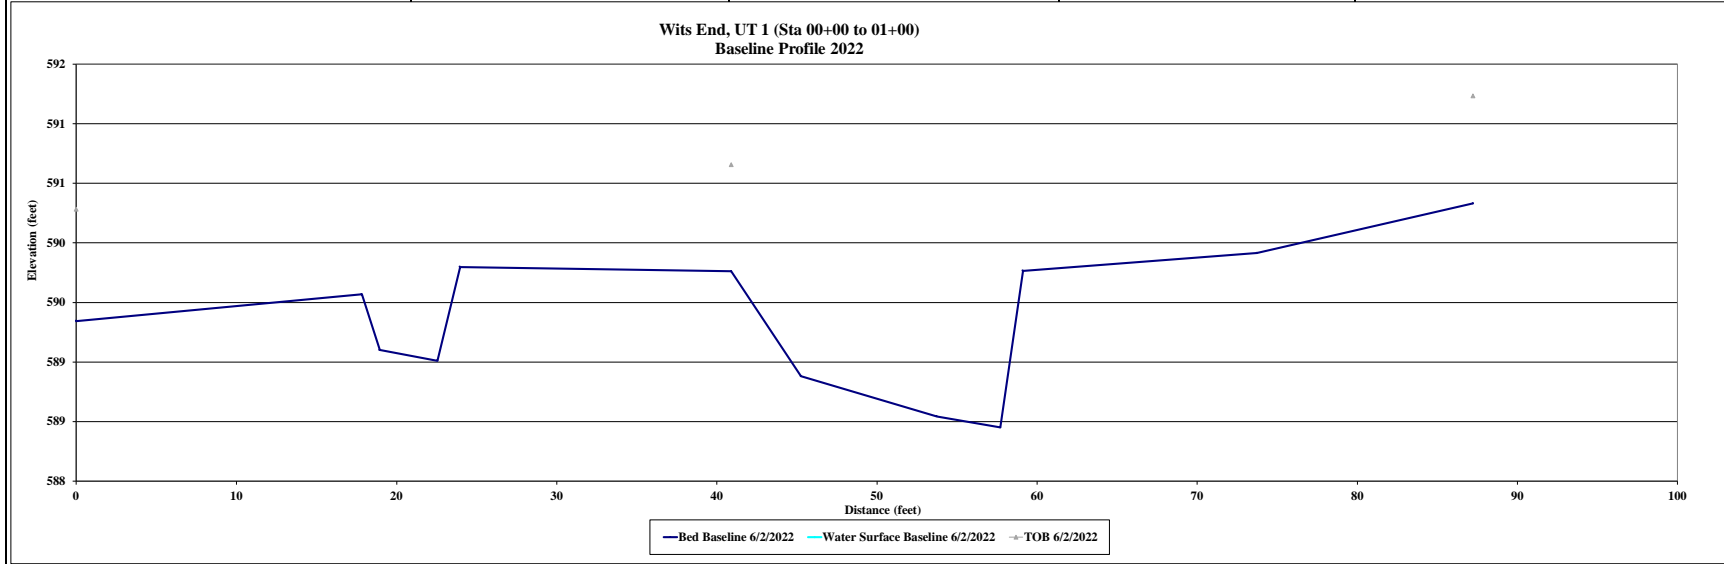

--	--	--








<b>Project Name</b>	Wits End - Baseline (2022) Profile
<b>Reach</b>	UT 3 Upstream (Sta 00+00 to 10+00)
<b>Feature</b>	Profile
<b>Date</b>	6/2/22
<b>Crew</b>	Perkinson

2022 Baseline Survey				As needed				As needed				As needed			
Station	Bed Elevation	Water Elevation	TOB	Station	Bed Elevation	Water Elevation	TOB	Station	Bed Elevation	Water Elevation	TOB	Station	Bed Elevation	Water Elevation	TOB
0.0	585.46														
2.1	585.45														
3.5	584.94														
6.4	585.04														
8.8	585.73														
53.7	586.48														
54.8	585.68														
57.1	585.52		587.04												
58.8	586.28														
80.7	586.62														
82.7	585.93														
88.3	585.85														
92.3	586.77														
108.5	586.89														

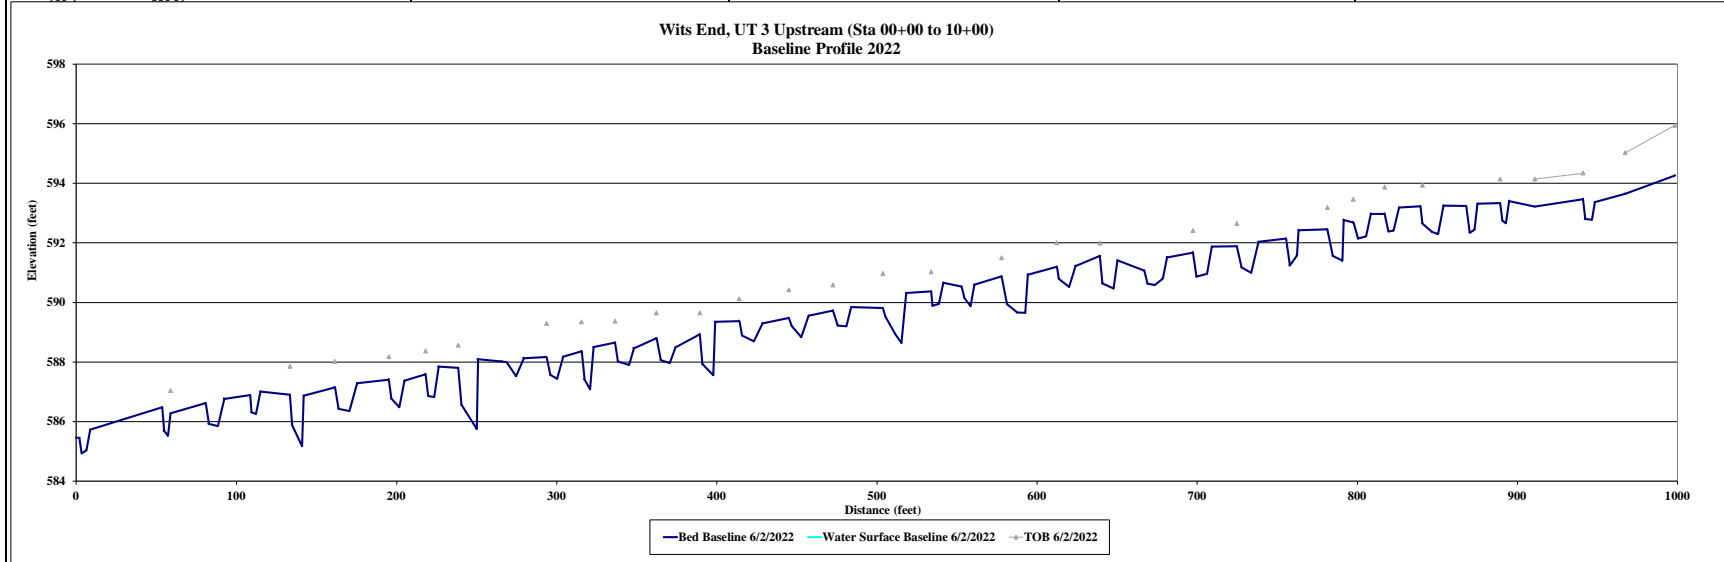

362.3	588.80	589.65			
364.9	588.06				
370.5	587.97				
374.2	588.49				
389.4	588.93	589.65			
391.0	587.93				
397.7	587.55				
399.0	589.35				
414.1	589.38	590.12			
415.8	588.89				
423.1	588.70				
428.5	589.30				
444.9	589.48	590.43			








Project Name	Wits End - Baseline (2022) Profile
Reach	UT 5 (Sta 00+00 to 01+20)
Feature	Profile
Date	6/2/22
Crew	Perkinson

2022 Baseline Survey				As needed				As needed				As needed			
Station	Bed Elevation	Water Elevation	TOB	Station	Bed Elevation	Water Elevation	TOB	Station	Bed Elevation	Water Elevation	TOB	Station	Bed Elevation	Water Elevation	TOB
0.0	572.33														
1.5	571.85														
3.8	571.85														
6.2	572.28														
17.6	572.09														
20.8	571.77														
24.0	571.60														
27.3	571.64														
29.2	572.01														
40.3	572.25														
41.9	572.02														
47.6	571.98														
50.7	572.29														
63.3	572.29		573.06												

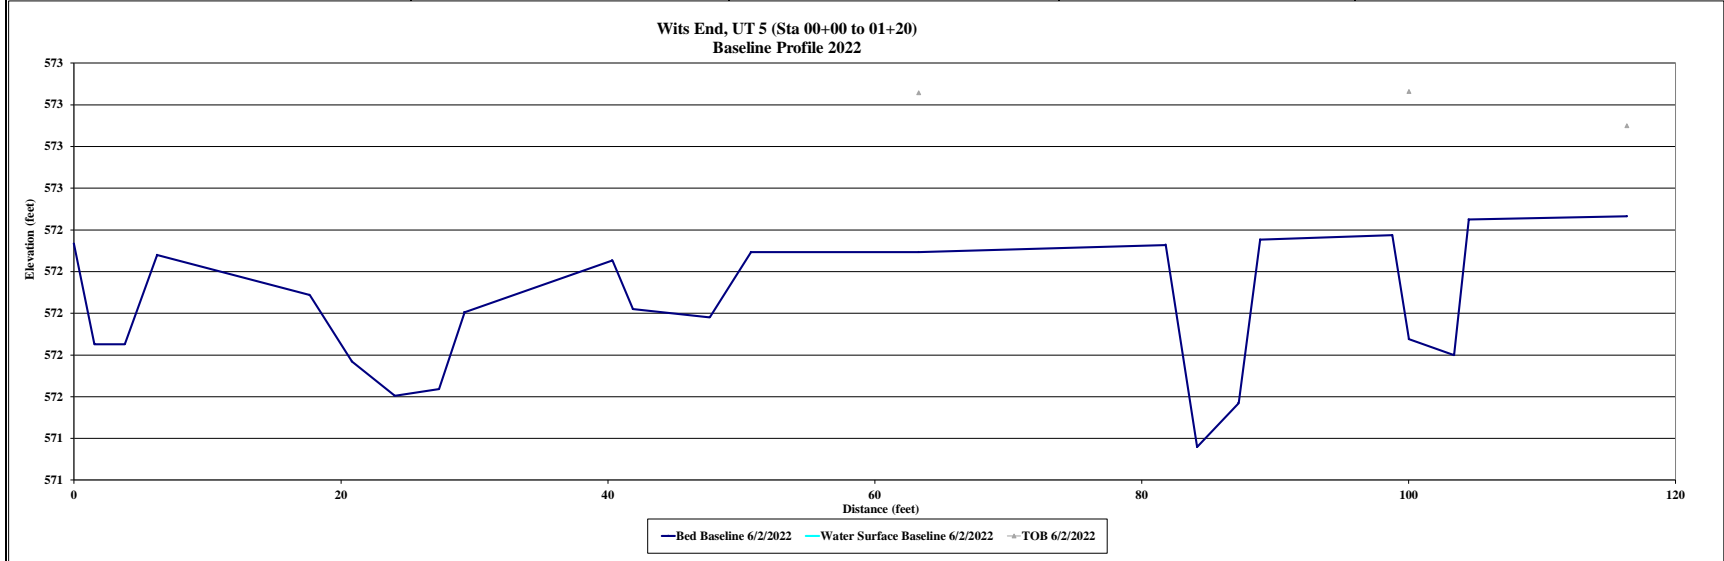

--	--	--	--



**Table 9A. Baseline Stream Data Summary  
Wits End - Waxhaw Branch downstream**

Parameter	Pre-Existing Condition (applicable)					Design		Monitoring Baseline (MY0)		
	Min	Mean	Med	Max	n	Min	Max	Min	Max	n
<b>Riffle Only</b>										
Bankfull Width (ft)	12.0		13.2	13.4		15.9	18.4	18.0	18.0	1
Floodprone Width (ft)	20		32	150		100	200	150	150	1
Bankfull Mean Depth (ft)	1.5		1.6	1.7		1.2	1.3	1.1	1.1	1
Bankfull Max Depth (ft)	2.1		2.4	2.7		1.5	2	1.5	1.5	1
Bankfull Cross Sectional Area (ft <sup>2</sup> )	21.2		21.2	21.2		21.2	21.2	19.2	19.2	1
Width/Depth Ratio	7.1		8.3	8.9		12	16	16.9	16.9	1
Entrenchment Ratio	1.5		2.7	11.3		6.3	10.9	8.3	8.3	1
Bank Height Ratio	1.5		1.8	2.2		1	1.3	1	1	1
Max part size (mm) mobilized at bankfull										
Rosgen Classification	Eg 4/5					Ce 3/4		Ce 3/4		
Bankfull Discharge (cfs)	88.3					88.3		88.3		
Sinuosity (ft)	1.06					1.15		1.15		
Water Surface Slope (Channel) (ft/ft)	0.0042					0.0039		0.004		
Other										

**Table 9B. Baseline Stream Data Summary  
Wits End - Waxhaw Branch upstream**

Parameter	Pre-Existing Condition (applicable)					Design		Monitoring Baseline (MY0)		
	Min	Mean	Med	Max	n	Min	Max	Min	Max	n
<b>Riffle Only</b>										
Bankfull Width (ft)	10.4		11.6	13.3		13.4	15.5	18.0	18.0	1
Floodprone Width (ft)	150		150	150		50	150	150	150	1
Bankfull Mean Depth (ft)	1.1		1.3	1.4		1	1.1	1.1	1.1	1
Bankfull Max Depth (ft)	2		2.1	2.3		1.2	1.7	1.5	1.5	1
Bankfull Cross Sectional Area (ft <sup>2</sup> )	15		15	15		15	15	19.2	19.2	1
Width/Depth Ratio	7.4		8.9	12.2		12	16	16.9	16.9	1
Entrenchment Ratio	11.2		12.9	14.4		3.7	9.7	8.3	8.3	1
Bank Height Ratio	1.3		1.5	1.6		1	1.3	1	1	1
Max part size (mm) mobilized at bankfull										
Rosgen Classification	Eg 4/5					Ce 3/4		Ce 3/4		
Bankfull Discharge (cfs)	61.3					61.3		61.3		
Sinuosity (ft)	1.01					1.15		1.15		
Water Surface Slope (Channel) (ft/ft)	0.0052					0.0046		0.0043		
Other										

**Table 9C. Baseline Stream Data Summary**  
**Wits End - UT 1**

Parameter	Pre-Existing Condition (applicable)					Design		Monitoring Baseline (MY0)		
	Min	Mean	Med	Max	n	Min	Max	Min	Max	n
<b>Riffle Only</b>										
Bankfull Width (ft)	4.0		4.6	5.1		5.8	6.7	18.0	18.0	1
Floodprone Width (ft)	40		45	50		25	75	150	150	1
Bankfull Mean Depth (ft)	0.5		0.6	0.7		0.4	0.5	1.1	1.1	1
Bankfull Max Depth (ft)	0.9		1	1		0.5	0.7	1.5	1.5	1
Bankfull Cross Sectional Area (ft <sup>2</sup> )	2.8		2.8	2.8		2.8	2.8	19.2	19.2	1
Width/Depth Ratio	5.7		8	10.2		12	16	16.9	16.9	1
Entrenchment Ratio	7.8		10.2	12.5		4.3	11.2	8.3	8.3	1
Bank Height Ratio	1.1		1.3	1.5		1	1.3	1	1	1
Max part size (mm) mobilized at bankfull										
Rosgen Classification	Eg 4/5					Ce 3/4		Ce 3/4		
Bankfull Discharge (cfs)	61.3					61.3		61.3		
Sinuosity (ft)	1.06					1.1		1.1		
Water Surface Slope (Channel) (ft/ft)	0.0262					0.0253		0.0071		
Other										

**Table 9D. Baseline Stream Data Summary**  
**Wits End - UT 2**

Parameter	Pre-Existing Condition (applicable)					Design		Monitoring Baseline (MY0)		
	Min	Mean	Med	Max	n	Min	Max	Min	Max	n
<b>Riffle Only</b>										
Bankfull Width (ft)	4.1		4.8	7		6.9	8	7.7	8.7	1
Floodprone Width (ft)	22		33	40		25	75	50	50	1
Bankfull Mean Depth (ft)	0.6		0.8	1		0.5	0.6	0.3	0.4	1
Bankfull Max Depth (ft)	1.2		1.4	1.4		0.6	0.9	0.6	0.6	1
Bankfull Cross Sectional Area (ft <sup>2</sup> )	4		4	4		4	4	2.4	2.8	1
Width/Depth Ratio	2		4.1	6		12	16	21.2	31.4	1
Entrenchment Ratio	4.7		5.4	8.3		3.1	9.6	5.8	6.5	1
Bank Height Ratio	1		1.1	1.5		1	1.3	1	1	1
Max part size (mm) mobilized at bankfull										
Rosgen Classification	E 6					Ce 3/4		Ce 4		
Bankfull Discharge (cfs)	14.8					14.8		14.8		
Sinuosity (ft)	1					1.1		1.1		
Water Surface Slope (Channel) (ft/ft)	0.0089					0.0076		0.0077		
Other										

**Table 9E. Baseline Stream Data Summary**  
**Wits End - UT 3 Lower**

Parameter	Pre-Existing Condition (applicable)					Design		Monitoring Baseline (MY0)		
	Min	Mean	Med	Max	n	Min	Max	Min	Max	n
<b>Riffle Only</b>										
Bankfull Width (ft)	7.1		8	10.3		9.7	11.2	9.7	10.3	1
Floodprone Width (ft)	8		10	23		50	100	75	75	1
Bankfull Mean Depth (ft)	0.8		1	1.1		0.7	0.8	0.5	0.7	1
Bankfull Max Depth (ft)	1.1		1.3	1.5		0.9	1.2	0.6	1.0	1
Bankfull Cross Sectional Area (ft <sup>2</sup> )	7.8		7.8	7.8		7.8	7.8	5.4	6.7	1
Width/Depth Ratio	6.5		8	19.8		12	16	14.1	19.7	1
Entrenchment Ratio	1.1		1.3	2.2		5.2	9	7.3	7.7	1
Bank Height Ratio	1.7		2.3	3		1	1.3	1	1	1
Max part size (mm) mobilized at bankfull										
Rosgen Classification	G 4/5					Ce 3/4		Ce 3/4		
Bankfull Discharge (cfs)	30.6					30.6		30.6		
Sinuosity (ft)	1.03					1.1		1.1		
Water Surface Slope (Channel) (ft/ft)	0.0071					0.0066		0.0065		
Other										

**Table 9F. Baseline Stream Data Summary**  
**Wits End - UT 3A**

Parameter	Pre-Existing Condition (applicable)					Design		Monitoring Baseline (MY0)		
	Min	Mean	Med	Max	n	Min	Max	Min	Max	n
<b>Riffle Only</b>										
Bankfull Width (ft)	5.8		5.8	5.8		7	8.1	8.5	8.5	1
Floodprone Width (ft)	8		9	8		25	75	75	50	1
Bankfull Mean Depth (ft)	0.7		0.7	0.7		0.5	0.6	0.5	0.5	1
Bankfull Max Depth (ft)	0.9		1	1		0.6	0.9	0.7	0.7	1
Bankfull Cross Sectional Area (ft <sup>2</sup> )	4.1		4.1	4.1		4.1	4.1	4.0	4.0	1
Width/Depth Ratio	8.3		8.3	8.3		12	16	18.2	18.2	1
Entrenchment Ratio	1.4		1.6	1.8		1	1.3	5.9	5.9	1
Bank Height Ratio	1.4		1.8	1.8		1	1.3	1	1	1
Max part size (mm) mobilized at bankfull										
Rosgen Classification	G 4					Ce 3/4		Ce 3/4		
Bankfull Discharge (cfs)	15.2					15.2		15.2		
Sinuosity (ft)	1.02					1.1		1.1		
Water Surface Slope (Channel) (ft/ft)	0.009					0.0084		0.008		
Other										



**Table 9G. Baseline Stream Data Summary**  
**Wits End - UT 3 Upstream**

Parameter	Pre-Existing Condition (applicable)					Design		Monitoring Baseline (MY0)		
	Min	Mean	Med	Max	n	Min	Max	Min	Max	n
<b>Riffle Only</b>										
Bankfull Width (ft)	5.3		5.7	6.1		7	8.1	7.2	7.2	1
Floodprone Width (ft)	7		8	8		25	75	50	50	1
Bankfull Mean Depth (ft)	0.8		0.9	0.9		0.5	0.6	0.4	0.4	1
Bankfull Max Depth (ft)	0.9		1	1.1		0.6	0.9	0.6	0.6	1
4.7	15		4.7	4.7		4.1	4.1	3.1	3.1	1
Width/Depth Ratio	5.9		6.8	7.6		12	16	16.8	16.8	1
Entrenchment Ratio	1.1		1.3	1.5		1	1.3	7.0	7.0	1
Bank Height Ratio	<b>2.3</b>		<b>2.9</b>	<b>3.4</b>		<b>1</b>	<b>1.3</b>	<b>1</b>	<b>1</b>	<b>1</b>
Max part size (mm) mobilized at bankfull										
Rosgen Classification	G 4/5					Ce 3/4		Ce 3/4		
Bankfull Discharge (cfs)	17.6					15.2		15.2		
Sinuosity (ft)	1.03					1.1		1.1		
Water Surface Slope (Channel) (ft/ft)	0.0089					0.0084		0.0083		
Other										

**Table 9H. Baseline Stream Data Summary**  
**Wits End - UT 4 Upstream**

Parameter	Pre-Existing Condition (applicable)					Design		Monitoring Baseline (MY0)		
	Min	Mean	Med	Max	n	Min	Max	Min	Max	n
<b>Riffle Only</b>										
Bankfull Width (ft)	4.4		10.6	17.9		6.9	8	18.0	18.0	1
Floodprone Width (ft)	30		50	60		25	75	150	150	1
Bankfull Mean Depth (ft)	0.2		0.6	1		0.5	0.6	1.1	1.1	1
Bankfull Max Depth (ft)	0.4		0.9	1.4		0.6	0.9	1.5	1.5	1
Bankfull Cross Sectional Area (ft <sup>2</sup> )	4.3		4.3	4.3		4	4	19.2	19.2	1
Width/Depth Ratio	4.4		29.8	89.5		12	16	16.9	16.9	1
Entrenchment Ratio	3.1		5.1	9.6		3.1	9.6	8.3	8.3	1
Bank Height Ratio	<b>1</b>		<b>1.4</b>	<b>1.8</b>		<b>1</b>	<b>1.3</b>	<b>1</b>	<b>1</b>	<b>1</b>
Max part size (mm) mobilized at bankfull										
Rosgen Classification	Cg D 4/5					Ce 3/4		Ce 4		
Bankfull Discharge (cfs)	16					14.8		14.8		
Sinuosity (ft)	1.02					1.1		1.1		
Water Surface Slope (Channel) (ft/ft)	0.0076					0.0076		0.0058		
Other										

**Table 9I. Baseline Stream Data Summary  
Wits End - UT 5 Upstream**

Parameter	Pre-Existing Condition (applicable)					Design		Monitoring Baseline (MY0)		
	Min	Mean	Med	Max	n	Min	Max	Min	Max	n
<b>Riffle Only</b>										
Bankfull Width (ft)	3.1		3.4	3.7		5.4	6.2	7.3	7.3	1
Floodprone Width (ft)	10		13	15		15	50	30	30	1
Bankfull Mean Depth (ft)	0.7		0.8	0.8		0.4	0.4	0.4	0.4	1
Bankfull Max Depth (ft)	1		1.3	1.6		0.5	0.7	0.6	0.6	1
Bankfull Cross Sectional Area (ft <sup>2</sup> )	2.4		2.4	2.4		2.4	2.4	3.0	3.0	1
Width/Depth Ratio	3.9		4.6	5.3		12	16	17.7	17.7	1
Entrenchment Ratio	3.2		3.6	4.1		2.8	8.1	4.1	4.1	1
Bank Height Ratio	<b>1</b>		<b>1.3</b>	<b>1.6</b>		<b>1</b>	<b>1.3</b>	<b>1</b>	<b>1</b>	<b>1</b>
Max part size (mm) mobilized at bankfull										
Rosgen Classification	Eg 4					Ce 3/4		Ce 3/4		
Bankfull Discharge (cfs)	8					8		8		
Sinuosity (ft)	1.04					1.1		1.1		
Water Surface Slope (Channel) (ft/ft)	0.0113					0.0107		0.0011		
Other										

**Table 10A. Monitoring Data - Cross Section Morphology Monitoring Summary**

(Wits End/ DMS:100164) Waxhaw Branch

	Waxhaw Br - Cross Section 1 (Riffle)							Waxhaw Br - Cross Section 2 (Pool)							Waxhaw Br - Cross Section 3 (Riffle)							Waxhaw Br - Cross Section 4 (Pool)							Waxhaw Br - Cross Section 5 (Riffle)						
	MY0	MY1	MY2	MY3	MY5	MY7	MY+	MY0	MY1	MY2	MY3	MY5	MY7	MY+	MY0	MY1	MY2	MY3	MY5	MY7	MY+	MY0	MY1	MY2	MY3	MY5	MY7	MY+	MY0	MY1	MY2	MY3	MY5	MY7	MY+
Bankfull Elevation (ft) - Based on AB-Bankfull <sup>1</sup> Area	572.78							572.99							578.32							578.36							583.96						
Bank Height Ratio_Based on AB Bankfull <sup>1</sup> Area	1.00							1.00							1.00							1.00							1.00						
Thalweg Elevation	571.33							570.29							577.06							576.45							582.57						
LTOB <sup>2</sup> Elevation	572.78							572.99							578.32							578.36							583.96						
LTOB <sup>2</sup> Max Depth (ft)	1.45							2.70							1.27							1.92							1.39						
LTOB <sup>2</sup> Cross Sectional Area (ft <sup>2</sup> )	19.0							32.2							11.5							18.6							16.3						
	Waxhaw Br - Cross Section 6 (Pool)							Waxhaw Br - Cross Section 7 (Pool)							Waxhaw Br - Cross Section 8 (Riffle)							Waxhaw Br - Cross Section 9 (Riffle)							Waxhaw Br - Cross Section 10 (Pool)						
	MY0	MY1	MY2	MY3	MY5	MY7	MY+	MY0	MY1	MY2	MY3	MY5	MY7	MY+	MY0	MY1	MY2	MY3	MY5	MY7	MY+	MY0	MY1	MY2	MY3	MY5	MY7	MY+	MY0	MY1	MY2	MY3	MY5	MY7	MY+
Bankfull Elevation (ft) - Based on AB-Bankfull <sup>1</sup> Area	583.94							587.97							587.88							589.98							589.92						
Bank Height Ratio_Based on AB Bankfull <sup>1</sup> Area	1.00							1.00							1.00							1.00							1.00						
Thalweg Elevation	581.80							586.03							586.78							588.56							587.92						
LTOB <sup>2</sup> Elevation	583.94							587.97							587.88							589.98							589.92						
LTOB <sup>2</sup> Max Depth (ft)	2.14							1.93							1.11							1.42							2.00						
LTOB <sup>2</sup> Cross Sectional Area (ft <sup>2</sup> )	23.5							18.2							10.0							13.9							16.3						
Bankfull Elevation (ft) - Based on AB-Bankfull <sup>1</sup> Area																																			
Bank Height Ratio_Based on AB Bankfull <sup>1</sup> Area																																			
Thalweg Elevation																																			
LTOB <sup>2</sup> Elevation																																			
LTOB <sup>2</sup> Max Depth (ft)																																			
LTOB <sup>2</sup> Cross Sectional Area (ft <sup>2</sup> )																																			

The above morphology parameters reflect the 2018 guidance that arose from the mitigation technical workgroup consisting of DMS, the IRT and industry mitigation providers/practitioners. The outcome resulted in the focus on three primary morphological parameters of interest for the purposes of tracking channel change moving forward. They are the bank height ratio using a constant As-built bankfull area and the cross sectional area and max depth based on each years low top of bank. These are calculated as follows:

- 1 - Bank Height Ratio (BHR)** takes the As-built bankfull area as the basis for adjusting each subsequent years bankfull elevation. For example if the As-built bankfull area was 10 ft<sup>2</sup>, then the MY1 bankfull elevation would be adjusted until the calculated bankfull area within the MY1 cross section survey = 10 ft<sup>2</sup>. The BHR would then be calculated with the difference between the low top of bank (LTOB) elevation for MY1 and the thalweg elevation for MY1 in the numerator with the difference between the MY1 bankfull elevation and the MY1 thalweg elevation in the denominator. This same process is then carried out in each successive year.
- 2 - LTOB Area and Max depth** - These are based on the LTOB elevation for each years survey (The same elevation used for the LTOB in the BHR calculation). Area below the LTOB elevation will be used and tracked for each year as above. The difference between the LTOB elevation and the thalweg elevation (same as in the BHR calculation) will be recorded and tracked above as LTOB max depth.

Note: The smaller the channel the closer the survey measurements are to their limit of reliable detection, therefore inter-annual variation in morphological measurement (as a percentage) is by default magnified as channel size decreases. Some of the variability above is the result of this factor and some is due to the large amount of depositional sediments observed.



**Table 10B. Monitoring Data - Cross Section Morphology Monitoring Summary**  
**(Wits End/ DMS:100164) UT 2**

	UT 2 - Cross Section 25 (Riffle)							UT 2 - Cross Section 26 (Pool)							UT 2 - Cross Section 27 (Pool)							UT 3 - Cross Section 28 (Riffle)														
	MY0	MY1	MY2	MY3	MY5	MY7	MY+	MY0	MY1	MY2	MY3	MY5	MY7	MY+	MY0	MY1	MY2	MY3	MY5	MY7	MY+	MY0	MY1	MY2	MY3	MY5	MY7	MY+	MY0	MY1	MY2	MY3	MY5	MY7	MY+	
Bankfull Elevation (ft) - Based on AB-Bankfull <sup>1</sup> Area	588.14							588.02							594.68								594.73													
Bank Height Ratio_Based on AB Bankfull <sup>1</sup> Area	1.00							1.00							1.00								1.00													
Thalweg Elevation	587.49							586.55							593.44								594.11													
LTOB <sup>2</sup> Elevation	588.14							588.02							594.68								594.73													
LTOB <sup>2</sup> Max Depth (ft)	0.65							1.48							1.24								0.62													
LTOB <sup>2</sup> Cross Sectional Area (ft <sup>2</sup> )	2.4							7.6							6.1								2.88													
Bankfull Elevation (ft) - Based on AB-Bankfull <sup>1</sup> Area																																				
Bank Height Ratio_Based on AB Bankfull <sup>1</sup> Area																																				
Thalweg Elevation																																				
LTOB <sup>2</sup> Elevation																																				
LTOB <sup>2</sup> Max Depth (ft)																																				
LTOB <sup>2</sup> Cross Sectional Area (ft <sup>2</sup> )																																				
								<p>The above morphology parameters reflect the 2018 guidance that arose from the mitigation technical workgroup consisting of DMS, the IRT and industry mitigation providers/practitioners. The outcome resulted in the focus on three primary morphological parameters of interest for the purposes of tracking channel change moving forward. They are the bank height ratio using a constant As-built bankfull area and the cross sectional area and max depth based on each years low top of bank. These are calculated as follows:</p> <p><b>1 - Bank Height Ratio (BHR)</b> takes the As-built bankfull area as the basis for adjusting each subsequent years bankfull elevation. For example if the As-built bankfull area was 10 ft<sup>2</sup>, then the MY1 bankfull elevation would be adjusted until the calculated bankfull area within the MY1 cross section survey = 10 ft<sup>2</sup>. The BHR would then be calculated with the difference between the low top of bank (LTOB) elevation for MY1 and the thalweg elevation for MY1 in the numerator with the difference between the MY1 bankfull elevation and the MY1 thalweg elevation in the denominator. This same process is then carried out in each successive year.</p> <p><b>2 - LTOB Area and Max depth</b> - These are based on the LTOB elevation for each years survey (The same elevation used for the LTOB in the BHR calculation). Area below the LTOB elevation will be used and tracked for each year as above. The difference between the LTOB elevation and the thalweg elevation (same as in the BHR calculation) will be recorded and tracked above as LTOB max depth.</p>																												
Bankfull Elevation (ft) - Based on AB-Bankfull <sup>1</sup> Area																																				
Bank Height Ratio_Based on AB Bankfull <sup>1</sup> Area																																				
Thalweg Elevation																																				
LTOB <sup>2</sup> Elevation																																				
LTOB <sup>2</sup> Max Depth (ft)																																				
LTOB <sup>2</sup> Cross Sectional Area (ft <sup>2</sup> )																																				

Note: The smaller the channel the closer the survey measurements are to their limit of reliable detection, therefore inter-annual variation in morphological measurement (as a percentage) is by default magnified as channel size decreases. Some of the variability above is the result of this factor and some is due to the large amount of depositional sediments observed.

**Table 10C. Monitoring Data - Cross Section Morphology Monitoring Summary**  
**(Wits End/ DMS:100164) UT 3**

	UT 3 - Cross Section 17 (Pool)							UT 2 - Cross Section 18 (Riffle)							UT 3 - Cross Section 19 (Riffle)							UT 3 - Cross Section 20 (Pool)							UT 3 - Cross Section 23 (Riffle)							
	MY0	MY1	MY2	MY3	MY5	MY7	MY+	MY0	MY1	MY2	MY3	MY5	MY7	MY+	MY0	MY1	MY2	MY3	MY5	MY7	MY+	MY0	MY1	MY2	MY3	MY5	MY7	MY+	MY0	MY1	MY2	MY3	MY5	MY7	MY+	
Bankfull Elevation (ft) - Based on AB-Bankfull <sup>1</sup> Area	577.89							577.89							582.95								582.62							590.06						
Bank Height Ratio, Based on AB Bankfull <sup>1</sup> Area	1.00							1.00							1.00								1.00							1.00						
Thalweg Elevation	576.32							577.27							581.96								581.40							589.47						
LTOB <sup>2</sup> Elevation	577.89							577.89							582.95								582.62							590.06						
LTOB <sup>2</sup> Max Depth (ft)	1.57							0.63							0.99								1.22							0.60						
LTOB <sup>2</sup> Cross Sectional Area (ft <sup>2</sup> )	13.3							5.4							6.7								7.7							3.1						
	UT 3 - Cross Section 24 (Pool)																																			
	MY0	MY1	MY2	MY3	MY5	MY7	MY+																													
Bankfull Elevation (ft) - Based on AB-Bankfull <sup>1</sup> Area	590.43																																			
Bank Height Ratio, Based on AB Bankfull <sup>1</sup> Area	1.00																																			
Thalweg Elevation	588.89																																			
LTOB <sup>2</sup> Elevation	590.43																																			
LTOB <sup>2</sup> Max Depth (ft)	1.54																																			
LTOB <sup>2</sup> Cross Sectional Area (ft <sup>2</sup> )	11.3																																			
								<p>The above morphology parameters reflect the 2018 guidance that arose from the mitigation technical workgroup consisting of DMS, the IRT and industry mitigation providers/practitioners. The outcome resulted in the focus on three primary morphological parameters of interest for the purposes of tracking channel change moving forward. They are the bank height ratio using a constant As-built bankfull area and the cross sectional area and max depth based on each years low top of bank. These are calculated as follows:</p> <p><b>1 - Bank Height Ratio (BHR)</b> takes the As-built bankfull area as the basis for adjusting each subsequent years bankfull elevation. For example if the As-built bankfull area was 10 ft<sup>2</sup>, then the MY1 bankfull elevation would be adjusted until the calculated bankfull area within the MY1 cross section survey = 10 ft<sup>2</sup>. The BHR would then be calculated with the difference between the low top of bank (LTOB) elevation for MY1 and the thalweg elevation for MY1 in the numerator with the difference between the MY1 bankfull elevation and the MY1 thalweg elevation in the denominator. This same process is then carried out in each successive year.</p> <p><b>2 - LTOB Area and Max depth</b> - These are based on the LTOB elevation for each years survey (The same elevation used for the LTOB in the BHR calculation). Area below the LTOB elevation will be used and tracked for each year as above. The difference between the LTOB elevation and the thalweg elevation (same as in the BHR calculation) will be recorded and tracked above as LTOB max depth.</p>																												
Bankfull Elevation (ft) - Based on AB-Bankfull <sup>1</sup> Area																																				
Bank Height Ratio, Based on AB Bankfull <sup>1</sup> Area																																				
Thalweg Elevation																																				
LTOB <sup>2</sup> Elevation																																				
LTOB <sup>2</sup> Max Depth (ft)																																				
LTOB <sup>2</sup> Cross Sectional Area (ft <sup>2</sup> )																																				

Note: The smaller the channel the closer the survey measurements are to their limit of reliable detection, therefore inter-annual variation in morphological measurement (as a percentage) is by default magnified as channel size decreases. Some of the variability above is the result of this factor and some is due to the large amount of depositional sediments observed.





**Table 10E. Monitoring Data - Cross Section Morphology Monitoring Summary**  
**(Wits End/ DMS:100164) UT 4**

	UT 4 - Cross Section 11 (Pool)							UT 4 - Cross Section 12 (Riffle)							UT 4 - Cross Section 13 (Pool)							UT 4 - Cross Section 14 (Riffle)													
	MY0	MY1	MY2	MY3	MY5	MY7	MY+	MY0	MY1	MY2	MY3	MY5	MY7	MY+	MY0	MY1	MY2	MY3	MY5	MY7	MY+	MY0	MY1	MY2	MY3	MY5	MY7	MY+							
Bankfull Elevation (ft) - Based on AB-Bankfull <sup>1</sup> Area	573.37							573.37							576.28								576.50												
Bank Height Ratio_Based on AB Bankfull <sup>1</sup> Area	1.00							1.00							1.00								1.00												
Thalweg Elevation	572.21							572.72							574.88								575.81												
LTOB <sup>2</sup> Elevation	573.37							573.37							576.28								576.50												
LTOB <sup>2</sup> Max Depth (ft)	1.16							0.65							1.39								0.69												
LTOB <sup>2</sup> Cross Sectional Area (ft <sup>2</sup> )	6.7							4.0							6.4								3.2												
Bankfull Elevation (ft) - Based on AB-Bankfull <sup>1</sup> Area																																			
Bank Height Ratio_Based on AB Bankfull <sup>1</sup> Area																																			
Thalweg Elevation																																			
LTOB <sup>2</sup> Elevation																																			
LTOB <sup>2</sup> Max Depth (ft)																																			
LTOB <sup>2</sup> Cross Sectional Area (ft <sup>2</sup> )																																			
								<p>The above morphology parameters reflect the 2018 guidance that arose from the mitigation technical workgroup consisting of DMS, the IRT and industry mitigation providers/practitioners. The outcome resulted in the focus on three primary morphological parameters of interest for the purposes of tracking channel change moving forward. They are the bank height ratio using a constant As-built bankfull area and the cross sectional area and max depth based on each years low top of bank. These are calculated as follows:</p> <p><b>1 - Bank Height Ratio (BHR)</b> takes the As-built bankfull area as the basis for adjusting each subsequent years bankfull elevation. For example if the As-built bankfull area was 10 ft<sup>2</sup>, then the MY1 bankfull elevation would be adjusted until the calculated bankfull area within the MY1 cross section survey = 10 ft<sup>2</sup>. The BHR would then be calculated with the difference between the low top of bank (LTOB) elevation for MY1 and the thalweg elevation for MY1 in the numerator with the difference between the MY1 bankfull elevation and the MY1 thalweg elevation in the denominator. This same process is then carried out in each successive year.</p> <p><b>2 - LTOB Area and Max depth</b> - These are based on the LTOB elevation for each years survey (The same elevation used for the LTOB in the BHR calculation). Area below the LTOB elevation will be used and tracked for each year as above. The difference between the LTOB elevation and the thalweg elevation (same as in the BHR calculation) will be recorded and tracked above as LTOB max depth.</p>																											
Bankfull Elevation (ft) - Based on AB-Bankfull <sup>1</sup> Area																																			
Bank Height Ratio_Based on AB Bankfull <sup>1</sup> Area																																			
Thalweg Elevation																																			
LTOB <sup>2</sup> Elevation																																			
LTOB <sup>2</sup> Max Depth (ft)																																			
LTOB <sup>2</sup> Cross Sectional Area (ft <sup>2</sup> )																																			

Note: The smaller the channel the closer the survey measurements are to their limit of reliable detection, therefore inter-annual variation in morphological measurement (as a percentage) is by default magnified as channel size decreases. Some of the variability above is the result of this factor and some is due to the large amount of depositional sediments observed.



## **Appendix D: Hydrologic Data**

Groundwater Gauge Soil Profiles

Pre-Construction Groundwater Gauge Data (2020 & 2021)

Figure 2. Pre-Construction Groundwater Gauge Locations

Stream Gauge Graphs



AXIOM ENVIRONMENTAL, INC  
 218 Snow Avenue  
 Raleigh, North Carolina 27603  
 919-215-1693



# SOIL BORING LOG

Date: 6/1/2022

Project/Site: Wits End

County, State: Union County, NC

Sampling Point/  
 Coordinates: Soil Profile GW 1 (34.908395, -80.441709)

Investigator: W. Grant Lewis

Soil Series: CmB - Cid channery silt loam

Notes: Location is shown on Figure 1 CCPV.

Depth (inches)	Matrix		Mottling		Type	Location	Texture
	Color	%	Color	%			
0-2	2.5 Y 4/2	100					Silty Loam
2-12	2.5 Y 6/4	90	2.5 Y 6/3	5	D	M	Silty Loam
			2.5 Y 5/8	5	C	PL	
12+	2.5 Y 6/3	97	2.5 Y 6/3	3	C	M	Clay Loam

Type: C=Concentration, D=Depletion, RM=Reduced Matrix, MS=Masked Sand Grains. Location: PL=Pore Lining, M=Matrix.

North Carolina Licensed Soil Scientist

Number: 1233

Signature: *W Grant Lewis*

Name/Print: W. Grant Lewis

AXIOM ENVIRONMENTAL, INC  
 218 Snow Avenue  
 Raleigh, North Carolina 27603  
 919-215-1693



# SOIL BORING LOG

Date: 6/1/2022

Project/Site: Wits End

County, State: Union County, NC

Sampling Point/  
Coordinates: Soil Profile GW 2 (35.831389, -79.887733)

Investigator: W. Grant Lewis

Soil Series: CmB - Cid channery silt loam

Notes: Location is shown on Figure 1 CCPV.

Depth (inches)	Matrix		Mottling		Type	Location	Texture
	Color	%	Color	%			
0-2	2.5 Y 5/2	100					Silty Loam
2-9	2.5 Y 6/3	75	2.5 Y 6/2	20	D	M	Silty Loam
			2.5 Y 5/6	5	C	M	
9-18	2.5 Y 7/2	80	2.5 Y 6/2	20	D	M	Silty Loam
18+	2.5 Y 6/4	85	2.5 Y 6/6	10	C	M	Silty Clay Loam
			2.5 Y 7/2	5	D	M	

Type: C=Concentration, D=Depletion, RM=Reduced Matrix, MS=Masked Sand Grains. Location: PL=Pore Lining, M=Matrix.

North Carolina Licensed Soil Scientist

Number: 1233

Signature: W Grant Lewis

Name/Print: W. Grant Lewis

AXIOM ENVIRONMENTAL, INC  
 218 Snow Avenue  
 Raleigh, North Carolina 27603  
 919-215-1693



# SOIL BORING LOG

Date: 6/1/2022  
 Project/Site: Wits End  
 County, State: Union County, NC  
 Sampling Point/  
 Coordinates: Soil Profile GW 3 (34.908623, -80.443312)  
 Investigator: W. Grant Lewis  
 Soil Series: CmB - Cid channery silt loam

Notes: Location is shown on Figure 1 CCPV.

Depth (inches)	Matrix		Mottling		Type	Location	Texture
	Color	%	Color	%			
0-6	2.5 Y 5/3	98	2.5 Y 5/6	2	C	PL	Silty Clay Loam
6-15	2.5 Y 6/3	95	2.5 Y 6/6	2			Silty Loam
			2.5 Y 4/4	3			
15+	2.5 Y 6/6	80	2.5 Y 6/3	10	D	M	Sandy Clay Loam
			2.5 Y 6/8	10	C	M	

Type: C=Concentration, D=Depletion, RM=Reduced Matrix, MS=Masked Sand Grains. Location: PL=Pore Lining, M=Matrix.

North Carolina Licensed Soil Scientist

Number: 1233  
 Signature: W Grant Lewis  
 Name/Print: W. Grant Lewis



AXIOM ENVIRONMENTAL, INC  
 218 Snow Avenue  
 Raleigh, North Carolina 27603  
 919-215-1693



# SOIL BORING LOG

Date: 6/1/2022  
 Project/Site: Wits End  
 County, State: Union County, NC  
 Sampling Point/  
 Coordinates: Soil Profile GW 4 (34.909572, -80.442676)  
 Investigator: W. Grant Lewis  
 Soil Series: CmB - Cid channery silt loam

Notes: Location is shown on Figure 1 CCPV.

Depth (inches)	Matrix		Mottling		Type	Location	Texture
	Color	%	Color	%			
0-4	2.5 Y 4/3	100					Silty Loam
4-12	2.5 Y 6/6	100					Silty Loam
12-20	2.5 Y 6/3	95	2.5 Y 6/6	3	C	M	Silty Loam
			2.5 Y 4/4	2	C	M	
20+	2.5 Y 6/3	95	2.5 Y 6/6	3	C	M	Silty Clay Loam
			2.5 Y 4/4	2	C	M	

Type: C=Concentration, D=Depletion, RM=Reduced Matrix, MS=Masked Sand Grains. Location: PL=Pore Lining, M=Matrix.

North Carolina Licensed Soil Scientist

Number: 1233  
 Signature: W Grant Lewis  
 Name/Print: W. Grant Lewis

AXIOM ENVIRONMENTAL, INC  
 218 Snow Avenue  
 Raleigh, North Carolina 27603  
 919-215-1693



# SOIL BORING LOG

Date: 6/1/2022  
 Project/Site: Wits End  
 County, State: Union County, NC  
 Sampling Point/  
 Coordinates: Soil Profile GW 5 (34.909931, -80.442588)  
 Investigator: W. Grant Lewis  
 Soil Series: CmB - Cid channery silt loam

Notes: Location is shown on Figure 1 CCPV.

Depth (inches)	Matrix		Mottling		Type	Location	Texture
	Color	%	Color	%			
0-4	2.5 Y 6/4	100					Silty Loam
4-17	2.5 Y 6/4	98	2.5 Y 5/6	2	C	M	Silty Loam
17+	2.5 Y 6/8	100					Silty Loam

Type: C=Concentration, D=Depletion, RM=Reduced Matrix, MS=Masked Sand Grains. Location: PL=Pore Lining, M=Matrix.

North Carolina Licensed Soil Scientist

Number: 1233  
 Signature: W Grant Lewis  
 Name/Print: W. Grant Lewis

AXIOM ENVIRONMENTAL, INC  
 218 Snow Avenue  
 Raleigh, North Carolina 27603  
 919-215-1693



# SOIL BORING LOG

Date: 6/1/2022  
 Project/Site: Wits End  
 County, State: Union County, NC  
 Sampling Point/  
 Coordinates: Soil Profile GW 6 (34.910248, -80.44328)  
 Investigator: W. Grant Lewis  
 Soil Series: CmB - Cid channery silt loam

Notes: Location is shown on Figure 1 CCPV.

Depth (inches)	Matrix		Mottling		Type	Location	Texture
	Color	%	Color	%			
0-4	2.5 Y 5/3	100					Silty Loam
4-13	2.5 Y 6/4	100					Silty Loam
13-20+	2.5 Y 6/4	96	2.5 Y 6/8	2	C	M	Fine Sandy Loam
			2.5 Y 4/4	2	C	M	

Type: C=Concentration, D=Depletion, RM=Reduced Matrix, MS=Masked Sand Grains. Location: PL=Pore Lining, M=Matrix.

North Carolina Licensed Soil Scientist

Number: 1233  
 Signature: W Grant Lewis  
 Name/Print: W. Grant Lewis



AXIOM ENVIRONMENTAL, INC  
 218 Snow Avenue  
 Raleigh, North Carolina 27603  
 919-215-1693



# SOIL BORING LOG

Date: 6/1/2022

Project/Site: Wits End

County, State: Union County, NC

Sampling Point/  
Coordinates: Soil Profile GW 7 (34.910815, -80.442702)

Investigator: W. Grant Lewis

Soil Series: CmB - Cid channery silt loam

Notes: Location is shown on Figure 1 CCPV.

Depth (inches)	Matrix		Mottling		Type	Location	Texture
	Color	%	Color	%			
0-3	2.5 Y 5/2	100					Silt Loam
3-12	2.5 Y 6/4	70	2.5 Y 6/6	30	C	M	Gravel Silt Loam
12-21+	2.5 Y 6/6	95	2.5 Y 6/4	3	D	M	Clay Loam
			2.5 Y 6/8	2	C	M	

Type: C=Concentration, D=Depletion, RM=Reduced Matrix, MS=Masked Sand Grains. Location: PL=Pore Lining, M=Matrix.

North Carolina Licensed Soil Scientist

Number: 1233

Signature: *W Grant Lewis*

Name/Print: W. Grant Lewis

AXIOM ENVIRONMENTAL, INC  
 218 Snow Avenue  
 Raleigh, North Carolina 27603  
 919-215-1693



# SOIL BORING LOG

Date: 6/1/2022

Project/Site: Wits End

County, State: Union County, NC

Sampling Point/  
 Coordinates: Soil Profile GW 8 (34.910834, -80.443475)

Investigator: W. Grant Lewis

Soil Series: CmB - Cid channery silt loam

Notes: Location is shown on Figure 1 CCPV.

Depth (inches)	Matrix		Mottling		Type	Location	Texture
	Color	%	Color	%			
0-1	10 YR 5/3	100					Silt Loam
1-9	2.5 Y 4/2	100					Fine Sandy Loam
9-18	2.5 Y 6/4	100					Fine Sandy Loam
18+	2.5 Y 6/3	80	2.5 Y 6/6	10			Gravel Loam
			2.5 Y 4/3	10			

Type: C=Concentration, D=Depletion, RM=Reduced Matrix, MS=Masked Sand Grains. Location: PL=Pore Lining, M=Matrix.

North Carolina Licensed Soil Scientist

Number: 1233

Signature: *W Grant Lewis*

Name/Print: W. Grant Lewis

AXIOM ENVIRONMENTAL, INC  
 218 Snow Avenue  
 Raleigh, North Carolina 27603  
 919-215-1693



# SOIL BORING LOG

Date: 6/1/2022  
 Project/Site: Wits End  
 County, State: Union County, NC  
 Sampling Point/  
 Coordinates: Soil Profile GW 9 (34.911343, -80.444421)  
 Investigator: W. Grant Lewis  
 Soil Series: CmB - Cid channery silt loam

Notes: Location is shown on Figure 1 CCPV.

Depth (inches)	Matrix		Mottling		Type	Location	Texture
	Color	%	Color	%			
0-2	2.5 Y 5/3	100					Silt Loam
2-9	2.5 Y 5/4	97	2.5 Y 6/8	3	C	PL	Silt Loam
9-18	2.5 Y 6/4	95	2.5 Y 6/3	3	D	M	Loam
			2.5 Y 6/8	2	C	PL	
18+	2.5 Y 6/4	95	2.5 Y 6/3	3	D	M	Clay
			2.5 Y 6/8	2	C	PL	

Type: C=Concentration, D=Depletion, RM=Reduced Matrix, MS=Masked Sand Grains. Location: PL=Pore Lining, M=Matrix.

North Carolina Licensed Soil Scientist

Number: 1233  
 Signature: W Grant Lewis  
 Name/Print: W. Grant Lewis



AXIOM ENVIRONMENTAL, INC  
 218 Snow Avenue  
 Raleigh, North Carolina 27603  
 919-215-1693



# SOIL BORING LOG

Date: 6/1/2022

Project/Site: Wits End

County, State: Union County, NC

Sampling Point/  
Coordinates: Soil Profile GW 11 (34.912335, -80.447071)

Investigator: W. Grant Lewis

Soil Series: CmB - Cid channery silt loam

Notes: Location is shown on Figure 1 CCPV.

Depth (inches)	Matrix		Mottling		Type	Location	Texture
	Color	%	Color	%			
0-11	2.5 Y 6/4	100					Sandy Clay Loam
11-16	2.5 Y 4/2	100					Silt Loam
16+	2.5 Y 6/4	95	2.5 Y 6/2	3	D	M	Loamy Clay
			2.5 Y 5/6	2	C	M	

Type: C=Concentration, D=Depletion, RM=Reduced Matrix, MS=Masked Sand Grains. Location: PL=Pore Lining, M=Matrix.

North Carolina Licensed Soil Scientist

Number: 1233

Signature: W Grant Lewis

Name/Print: W. Grant Lewis

AXIOM ENVIRONMENTAL, INC  
 218 Snow Avenue  
 Raleigh, North Carolina 27603  
 919-215-1693



# SOIL BORING LOG

Date: 6/1/2022  
 Project/Site: Wits End  
 County, State: Union County, NC  
 Sampling Point/  
 Coordinates: Soil Profile GW 12 (34.912704, -80.447368)  
 Investigator: W. Grant Lewis  
 Soil Series: CmB - Cid channery silt loam

Notes: Location is shown on Figure 1 CCPV.

Depth (inches)	Matrix		Mottling		Type	Location	Texture
	Color	%	Color	%			
0-3	2.5 Y 6/4	70	2.5 Y 5/2	28	C	M	Silt Loam
			2.5 Y 5/6	2	C	M	
3-17	2.5 Y 6/4	98	2.5 Y 6/8	2	C	M	Silt Loam
17+	2.5 Y 6/6	85	2.5 Y 6/4	12	D	M	Loamy Clay
			2.5 Y 6/8	3	C	M	

Type: C=Concentration, D=Depletion, RM=Reduced Matrix, MS=Masked Sand Grains. Location: PL=Pore Lining, M=Matrix.

North Carolina Licensed Soil Scientist

Number: 1233  
 Signature: *W Grant Lewis*  
 Name/Print: W. Grant Lewis

AXIOM ENVIRONMENTAL, INC  
 218 Snow Avenue  
 Raleigh, North Carolina 27603  
 919-215-1693



# SOIL BORING LOG

Date: 6/1/2022  
 Project/Site: Wits End  
 County, State: Union County, NC  
 Sampling Point/  
 Coordinates: Soil Profile GW 13 (34.912023, -80.447574)  
 Investigator: W. Grant Lewis  
 Soil Series: CmB - Cid channery silt loam

Notes: Location is shown on Figure 1 CCPV.

Depth (inches)	Matrix		Mottling		Type	Location	Texture
	Color	%	Color	%			
0-3	2.5 Y 3/3	100					Loam
3-9	2.5 Y 6/4	100					Silt Loam
9-19	2.5 Y 5/3	97	2.5 Y 5/6	3	C	M	Fine Sandy Loam
19+	2.5 Y 6/6	100					Loam

Type: C=Concentration, D=Depletion, RM=Reduced Matrix, MS=Masked Sand Grains. Location: PL=Pore Lining, M=Matrix.

North Carolina Licensed Soil Scientist

Number: 1233  
 Signature: *W Grant Lewis*  
 Name/Print: W. Grant Lewis



AXIOM ENVIRONMENTAL, INC  
 218 Snow Avenue  
 Raleigh, North Carolina 27603  
 919-215-1693



# SOIL BORING LOG

Date: 6/1/2022  
 Project/Site: Wits End  
 County, State: Union County, NC  
 Sampling Point/  
 Coordinates: Soil Profile GW 14 (34.911495, -80.448929)  
 Investigator: W. Grant Lewis  
 Soil Series: CmB - Cid channery silt loam

Notes: Location is shown on Figure 1 CCPV.

Depth (inches)	Matrix		Mottling		Type	Location	Texture
	Color	%	Color	%			
0-5	2.5 Y 4/4	100					Loam
5-18	2.5 Y 6/4	97	2.5 Y 6/8	3	C	M	Fine Sandy Loam
18+	2.5 Y 6/4	80	2.5 Y 6/8	15	C	M	Sandy Clay Loam
			2.5 Y 6/3	5	D	M	

Type: C=Concentration, D=Depletion, RM=Reduced Matrix, MS=Masked Sand Grains. Location: PL=Pore Lining, M=Matrix.

North Carolina Licensed Soil Scientist

Number: 1233  
 Signature: W Grant Lewis  
 Name/Print: W. Grant Lewis



AXIOM ENVIRONMENTAL, INC  
 218 Snow Avenue  
 Raleigh, North Carolina 27603  
 919-215-1693



# SOIL BORING LOG

Date: 6/1/2022  
 Project/Site: Wits End  
 County, State: Union County, NC  
 Sampling Point/  
 Coordinates: Soil Profile GW 16 (34.912721, -80.443728)  
 Investigator: W. Grant Lewis  
 Soil Series: CmB - Cid channery silt loam

Notes: Location is shown on Figure 1 CCPV.

Depth (inches)	Matrix		Mottling		Type	Location	Texture
	Color	%	Color	%			
0-5	10 YR 5/3	97	10 YR 3/4	3	C	M	Silt
5-11	2.5 Y 6/4	80	2.5 Y 6/2	5	D	M	Sandy Clay Loam
			2.5 Y 3/2	10	C	M	
			2.5 Y 5/6	5	P	L	
11+	2.5 Y 6/6	97	10 YR 5/6	3	C	M	Sandy Clay Loam

Type: C=Concentration, D=Depletion, RM=Reduced Matrix, MS=Masked Sand Grains. Location: PL=Pore Lining, M=Matrix.

North Carolina Licensed Soil Scientist

Number: 1233  
 Signature: *W Grant Lewis*  
 Name/Print: W. Grant Lewis



AXIOM ENVIRONMENTAL, INC  
 218 Snow Avenue  
 Raleigh, North Carolina 27603  
 919-215-1693



# SOIL BORING LOG

Date: 6/1/2022  
 Project/Site: Wits End  
 County, State: Union County, NC  
 Sampling Point/  
 Coordinates: Soil Profile GW 17 (34.913352, -80.443761)  
 Investigator: W. Grant Lewis  
 Soil Series: CmB - Cid channery silt loam\*

**Notes:** Location is shown on Figure 1 CCPV. \*Gauge located in drained pond, most appropriate soil series based on landscape position.

Depth (inches)	Matrix		Mottling		Type	Location	Texture
	Color	%	Color	%			
0-3	2.5 Y 6/4	97	10 YR 5/6	3	C	M	Silt
3-10	2.5 Y 6/3	60	2.5 Y 5/1	35	D	M	Clay Loam (Pond Sediment)
			2.5 Y 4/3	3	C	M	
			2.5 Y 6/8	2	C	M	
10-15+	2.5 Y 5/2	95	2.5 Y 4/4	5	C	M	Silt (Pond Sediment)

Type: C=Concentration, D=Depletion, RM=Reduced Matrix, MS=Masked Sand Grains. Location: PL=Pore Lining, M=Matrix.

North Carolina Licensed Soil Scientist

Number: 1233  
 Signature: *W Grant Lewis*  
 Name/Print: W. Grant Lewis

AXIOM ENVIRONMENTAL, INC  
218 Snow Avenue  
Raleigh, North Carolina 27603  
919-215-1693



# SOIL BORING LOG

Date: 6/1/2022  
Project/Site: Wits End  
County, State: Union County, NC  
Sampling Point/  
Coordinates: Soil Profile GW 18 (34.914105, -80.443531)  
Investigator: W. Grant Lewis  
Soil Series: CmB - Cid channery silt loam\*

**Notes:** Location is shown on Figure 1 CCPV. \*Gauge located in drained pond, most appropriate soil series based on landscape position.

Depth (inches)	Matrix		Mottling		Type	Location	Texture
	Color	%	Color	%			
0+	2.5 Y 5/2	60	2.5 Y 2/1	40	C	M	Silt (Pond Sediment)

Type: C=Concentration, D=Depletion, RM=Reduced Matrix, MS=Masked Sand Grains. Location: PL=Pore Lining, M=Matrix.

North Carolina Licensed Soil Scientist

Number: 1233  
Signature: W Grant Lewis  
Name/Print: W. Grant Lewis

AXIOM ENVIRONMENTAL, INC  
 218 Snow Avenue  
 Raleigh, North Carolina 27603  
 919-215-1693



# SOIL BORING LOG

Date: 6/1/2022  
 Project/Site: Wits End  
 County, State: Union County, NC  
 Sampling Point/  
 Coordinates: Soil Profile GW 19 (34.914131, -80.444315)  
 Investigator: W. Grant Lewis  
 Soil Series: CmB - Cid channery silt loam\*

**Notes:** Location is shown on Figure 1 CCPV. \*Gauge located in drained pond, most appropriate soil series based on landscape position.

Depth (inches)	Matrix		Mottling		Type	Location	Texture
	Color	%	Color	%			
0-4	10 YR 5/3	90	10 YR 5/1	5	D	M	Loam
			10 YR 5/6	5	C	M	
4-8	2.5 Y 6/2	90	10 YR 5/1	5	D	M	Sandy Loam
			10 YR 5/6	5	C	M	
8-18+	2.5 Y 6/2	100					Loamy Sand

Type: C=Concentration, D=Depletion, RM=Reduced Matrix, MS=Masked Sand Grains. Location: PL=Pore Lining, M=Matrix.

North Carolina Licensed Soil Scientist

Number: 1233  
 Signature: *W Grant Lewis*  
 Name/Print: W. Grant Lewis



AXIOM ENVIRONMENTAL, INC  
 218 Snow Avenue  
 Raleigh, North Carolina 27603  
 919-215-1693



# SOIL BORING LOG

Date: 6/1/2022  
 Project/Site: Wits End  
 County, State: Union County, NC  
 Sampling Point/  
 Coordinates: Soil Profile GW 20 (35.831389, -79.887733)  
 Investigator: W. Grant Lewis  
 Soil Series: CmB - Cid channery silt loam\*

**Notes:** Location is shown on Figure 1 CCPV. \*Gauge located in drained pond, most appropriate soil series based on landscape position.

Depth (inches)	Matrix		Mottling		Type	Location	Texture
	Color	%	Color	%			
0-4	2.5 Y 6/4	95	10 YR 5/6	3	C	M	Silt
4+	10 YR 5/1	70	10 YR 6/3	28	C	M	Silt
			10 YR 5/6	2	C	M	

Type: C=Concentration, D=Depletion, RM=Reduced Matrix, MS=Masked Sand Grains. Location: PL=Pore Lining, M=Matrix.

North Carolina Licensed Soil Scientist

Number: 1233  
 Signature: W Grant Lewis  
 Name/Print: W. Grant Lewis

AXIOM ENVIRONMENTAL, INC  
 218 Snow Avenue  
 Raleigh, North Carolina 27603  
 919-215-1693



# SOIL BORING LOG

Date: 6/1/2022  
 Project/Site: Wits End  
 County, State: Union County, NC  
 Sampling Point/  
 Coordinates: Soil Profile GW 21 (34.915517, -80.444192)  
 Investigator: W. Grant Lewis  
 Soil Series: CmB - Cid channery silt loam\*

**Notes:** Location is shown on Figure 1 CCPV. \*Gauge located in drained pond, most appropriate soil series based on landscape position.

Depth (inches)	Matrix		Mottling		Type	Location	Texture
	Color	%	Color	%			
0-3	10 YR 6/3	98	10 YR 6/2	2	D	M	Silt Loam
3-12	10 YR 6/3	65	10 YR 7/1	30	D	M	Clay Loam
			10 YR 6/6	5	C	M	
12-21	10 YR 4/1	70	10 YR 3/1	20	C	M	Silt
			10 YR 4/4	10	C	M	
21+	2.5 Y 6/3	98	2.5 Y 6/6	2	C	M	Gravel Loam

Type: C=Concentration, D=Depletion, RM=Reduced Matrix, MS=Masked Sand Grains. Location: PL=Pore Lining, M=Matrix.

North Carolina Licensed Soil Scientist

Number: 1233  
 Signature: *W Grant Lewis*  
 Name/Print: W. Grant Lewis

AXIOM ENVIRONMENTAL, INC  
 218 Snow Avenue  
 Raleigh, North Carolina 27603  
 919-215-1693



# SOIL BORING LOG

Date: 6/1/2022  
 Project/Site: Wits End  
 County, State: Union County, NC  
 Sampling Point/  
 Coordinates: Soil Profile GW 22 (34.915434, -80.444929)  
 Investigator: W. Grant Lewis  
 Soil Series: CmB - Cid channery silt loam\*

**Notes:** Location is shown on Figure 1 CCPV. \*Gauge located in drained pond, most appropriate soil series based on landscape position.

Depth (inches)	Matrix		Mottling		Type	Location	Texture
	Color	%	Color	%			
0-6	10 YR 5/2	100					Silt Loam
6-15	10 YR 6/3	50	10 YR 3/1	45	C	M	Sandy Clay Loam
			10 YR 4/6	5	C	M	
15-18	10 YR 6/2	100					Gravel Loam
18+	2.58 Y 6/3	100					Clay Loam

Type: C=Concentration, D=Depletion, RM=Reduced Matrix, MS=Masked Sand Grains. Location: PL=Pore Lining, M=Matrix.

North Carolina Licensed Soil Scientist

Number: 1233  
 Signature: *W Grant Lewis*  
 Name/Print: W. Grant Lewis



AXIOM ENVIRONMENTAL, INC  
 218 Snow Avenue  
 Raleigh, North Carolina 27603  
 919-215-1693



# SOIL BORING LOG

Date: 6/1/2022  
 Project/Site: Wits End  
 County, State: Union County, NC  
 Sampling Point/  
 Coordinates: Soil Profile GW 23 (34.915962, -80.444648)  
 Investigator: W. Grant Lewis  
 Soil Series: CmB - Cid channery silt loam\*

**Notes:** Location is shown on Figure 1 CCPV. \*Gauge located in drained pond, most appropriate soil series based on landscape position.

Depth (inches)	Matrix		Mottling		Type	Location	Texture
	Color	%	Color	%			
0-3	10 YR 6/2	98	10 YR 6/6	2	C	PL	Silt Loam
3-8	10 YR 6/2	75	2.5 Y 7/4	24	C	M	Sandy Clay Loam
			10 YR 6/6	1	C	M	
8-18	2.5 Y 5/6	80	2.5 Y 6/6	20	C	M	Loamy Clay
18-24	2.5 Y 5/6	100					Clay
24+	2.5 Y 6/6	75	2.5 Y 6/3	23	D	M	Clay
			2.5 Y 5/4	2	C	M	

Type: C=Concentration, D=Depletion, RM=Reduced Matrix, MS=Masked Sand Grains. Location: PL=Pore Lining, M=Matrix.

North Carolina Licensed Soil Scientist

Number: 1233  
 Signature: *W Grant Lewis*  
 Name/Print: W. Grant Lewis

AXIOM ENVIRONMENTAL, INC  
 218 Snow Avenue  
 Raleigh, North Carolina 27603  
 919-215-1693



# SOIL BORING LOG

Date: 6/1/2022  
 Project/Site: Wits End  
 County, State: Union County, NC  
 Sampling Point/  
 Coordinates: Soil Profile GW 24 (34.916465, -80.445179)  
 Investigator: W. Grant Lewis  
 Soil Series: CmB - Cid channery silt loam\*

**Notes:** Location is shown on Figure 1 CCPV. \*Gauge located in drained pond, most appropriate soil series based on landscape position.

Depth (inches)	Matrix		Mottling		Type	Location	Texture
	Color	%	Color	%			
0-11	10 YR 6/2	90	10 YR 6/1	6	D	M	Silt Loam
			10 YR 5/6	4	C	M	
11-18	10 YR 5/1	97	10 YR 5/3	3	C	PL	Clay
18+	10 YR 6/1	90	10 YR 7/2	10	C	M	Fine Sandy Loam

Type: C=Concentration, D=Depletion, RM=Reduced Matrix, MS=Masked Sand Grains. Location: PL=Pore Lining, M=Matrix.

North Carolina Licensed Soil Scientist

Number: 1233  
 Signature: *W Grant Lewis*  
 Name/Print: W. Grant Lewis

AXIOM ENVIRONMENTAL, INC  
 218 Snow Avenue  
 Raleigh, North Carolina 27603  
 919-215-1693



# SOIL BORING LOG

Date: 6/1/2022  
 Project/Site: Wits End  
 County, State: Union County, NC  
 Sampling Point/  
 Coordinates: Soil Profile GW 25 (34.917795, -80.446322)  
 Investigator: W. Grant Lewis  
 Soil Series: CmB - Cid channery silt loam

Notes: Location is shown on Figure 1 CCPV.

Depth (inches)	Matrix		Mottling		Type	Location	Texture
	Color	%	Color	%			
0-3	10 YR 5/2	100					Silt Loam
3-15	10 YR 7/4	70	10 YR 6/2	25	D	M	Silt Loam
			10 YR 6/8	5	C	M	
15+	10 YR 7/3	80	10 YR 4/6	20	C	M	Fine Sand

Type: C=Concentration, D=Depletion, RM=Reduced Matrix, MS=Masked Sand Grains. Location: PL=Pore Lining, M=Matrix.

North Carolina Licensed Soil Scientist

Number: 1233  
 Signature: *W Grant Lewis*  
 Name/Print: W. Grant Lewis



AXIOM ENVIRONMENTAL, INC  
 218 Snow Avenue  
 Raleigh, North Carolina 27603  
 919-215-1693



# SOIL BORING LOG

Date: 6/1/2022  
 Project/Site: Wits End  
 County, State: Union County, NC  
 Sampling Point/  
 Coordinates: Soil Profile GW 26 (34.916283, -80.444017)  
 Investigator: W. Grant Lewis  
 Soil Series: CmB - Cid channery silt loam\*

**Notes:** Location is shown on Figure 1 CCPV. \*Gauge located in drained pond, most appropriate soil series based on landscape position.

Depth (inches)	Matrix		Mottling		Type	Location	Texture
	Color	%	Color	%			
0-6	10 YR 6/3	97	10 YR 5/4	3	C	PL	Silt Loam
6-15	10 YR 6/2	95	10 YR 4/6	5	C	PL	Fine Sandy Loam
15-20	10 YR 6/4	95	10 YR 5/2	5	D	M	Gravel Loam
20+	2.5 Y 7/4	98	2.5 Y 6/3	1	C	M	Clay
			10 YR 5/6	1	C	M	

Type: C=Concentration, D=Depletion, RM=Reduced Matrix, MS=Masked Sand Grains. Location: PL=Pore Lining, M=Matrix.

North Carolina Licensed Soil Scientist

Number: 1233  
 Signature: *W Grant Lewis*  
 Name/Print: W. Grant Lewis

AXIOM ENVIRONMENTAL, INC  
 218 Snow Avenue  
 Raleigh, North Carolina 27603  
 919-215-1693



# SOIL BORING LOG

Date: 6/1/2022  
 Project/Site: Wits End  
 County, State: Union County, NC  
 Sampling Point/  
 Coordinates: Soil Profile GW 27 (34.917262, -80.442973)  
 Investigator: W. Grant Lewis  
 Soil Series: CmB - Cid channery silt loam

Notes: Location is shown on Figure 1 CCPV.

Depth (inches)	Matrix		Mottling		Type	Location	Texture
	Color	%	Color	%			
0-4	10 YR 6/4	98	10 YR 5/6	2	C	PL	Silt Loam
4-9	10 YR 7/6	78	10 YR 7/4	20	D	M	Fine Sandy Loam
			10 YR 6/8	2	C	M	
9-21	10 YR 7/8	99	10 YR 6/8	1	C	M	Clay Loam
21+	10 YR 6/8	70	10 YR 7/4	25	D	M	Sandy Clay Loam
			10 YR 5/8	5			

Type: C=Concentration, D=Depletion, RM=Reduced Matrix, MS=Masked Sand Grains. Location: PL=Pore Lining, M=Matrix.

North Carolina Licensed Soil Scientist

Number: 1233  
 Signature: *W Grant Lewis*  
 Name/Print: W. Grant Lewis

AXIOM ENVIRONMENTAL, INC  
 218 Snow Avenue  
 Raleigh, North Carolina 27603  
 919-215-1693



# SOIL BORING LOG

Date: 6/1/2022  
 Project/Site: Wits End  
 County, State: Union County, NC  
 Sampling Point/  
 Coordinates: Soil Profile GW 28 (34.917856, -80.442393)  
 Investigator: W. Grant Lewis  
 Soil Series: CmB - Cid channery silt loam

Notes: Location is shown on Figure 1 CCPV.

Depth (inches)	Matrix		Mottling		Type	Location	Texture
	Color	%	Color	%			
0-4	10 YR 6/2	100					Silt Loam
4-9	10 YR 6/4	95	10 YR 6/8	5	C	M	Gravel Loam
9+	10 YR 6/6	60	10 YR 6/2	35	D	M	Sandy Clay Loam
			10 YR 5/8	5	C	M	


Type: C=Concentration, D=Depletion, RM=Reduced Matrix, MS=Masked Sand Grains. Location: PL=Pore Lining, M=Matrix.

North Carolina Licensed Soil Scientist


Number: 1233  
 Signature: *W Grant Lewis*  
 Name/Print: W. Grant Lewis




# Wits End Groundwater Gauge 1 Preconstruction (2020 Data)

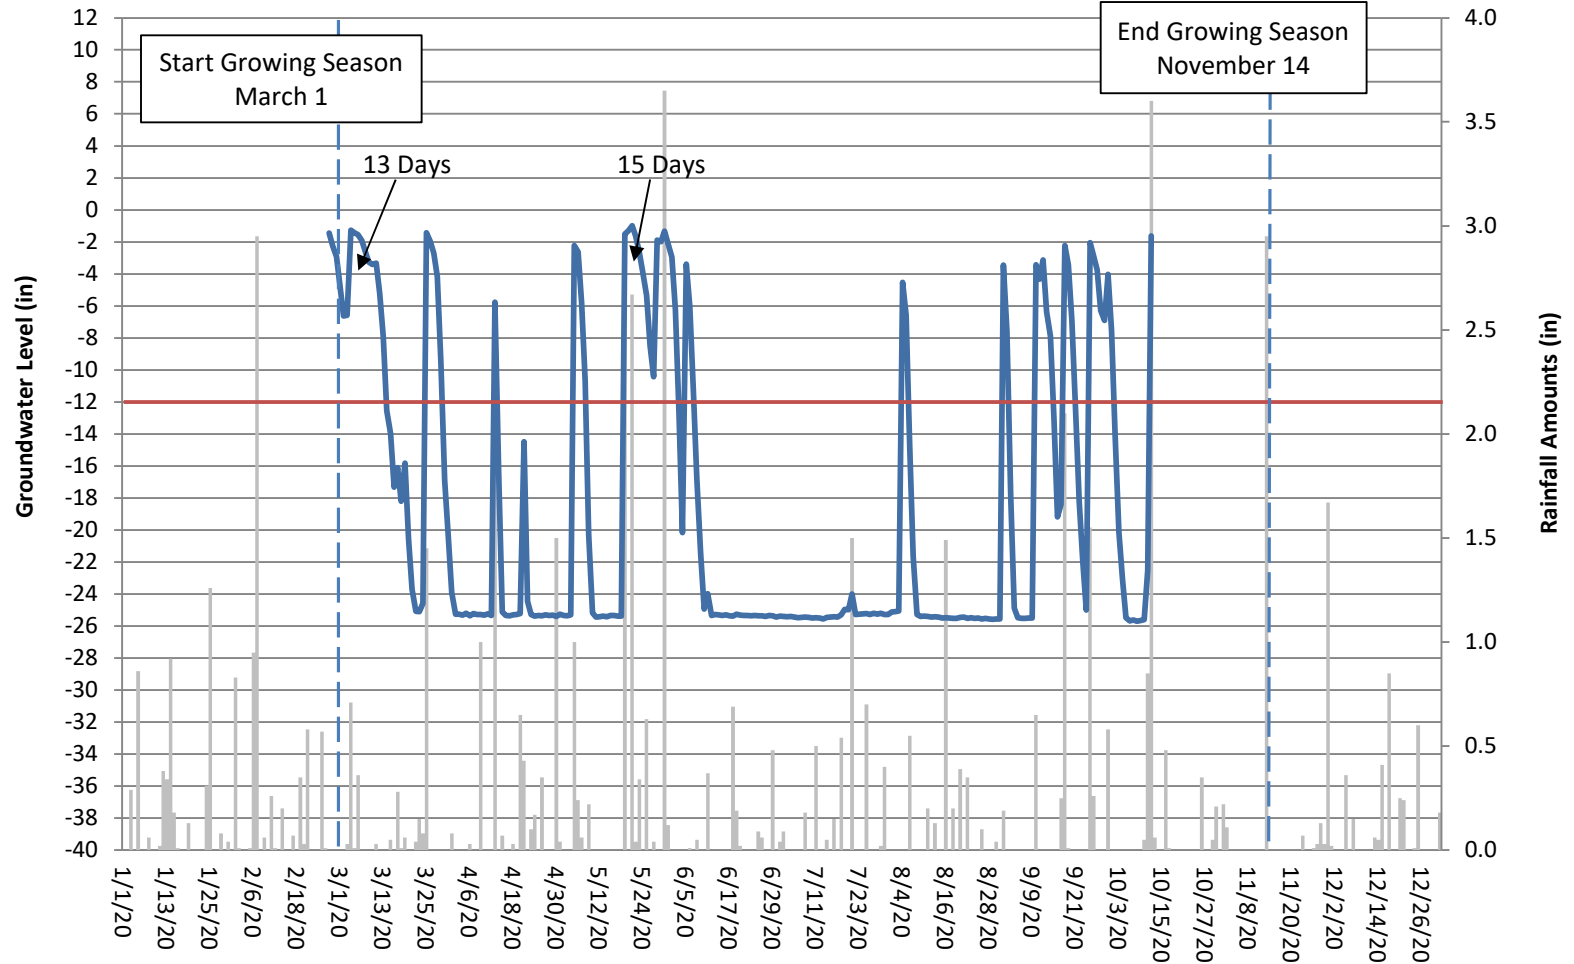

# Wits End Groundwater Gauge 2 Preconstruction (2020 Data)

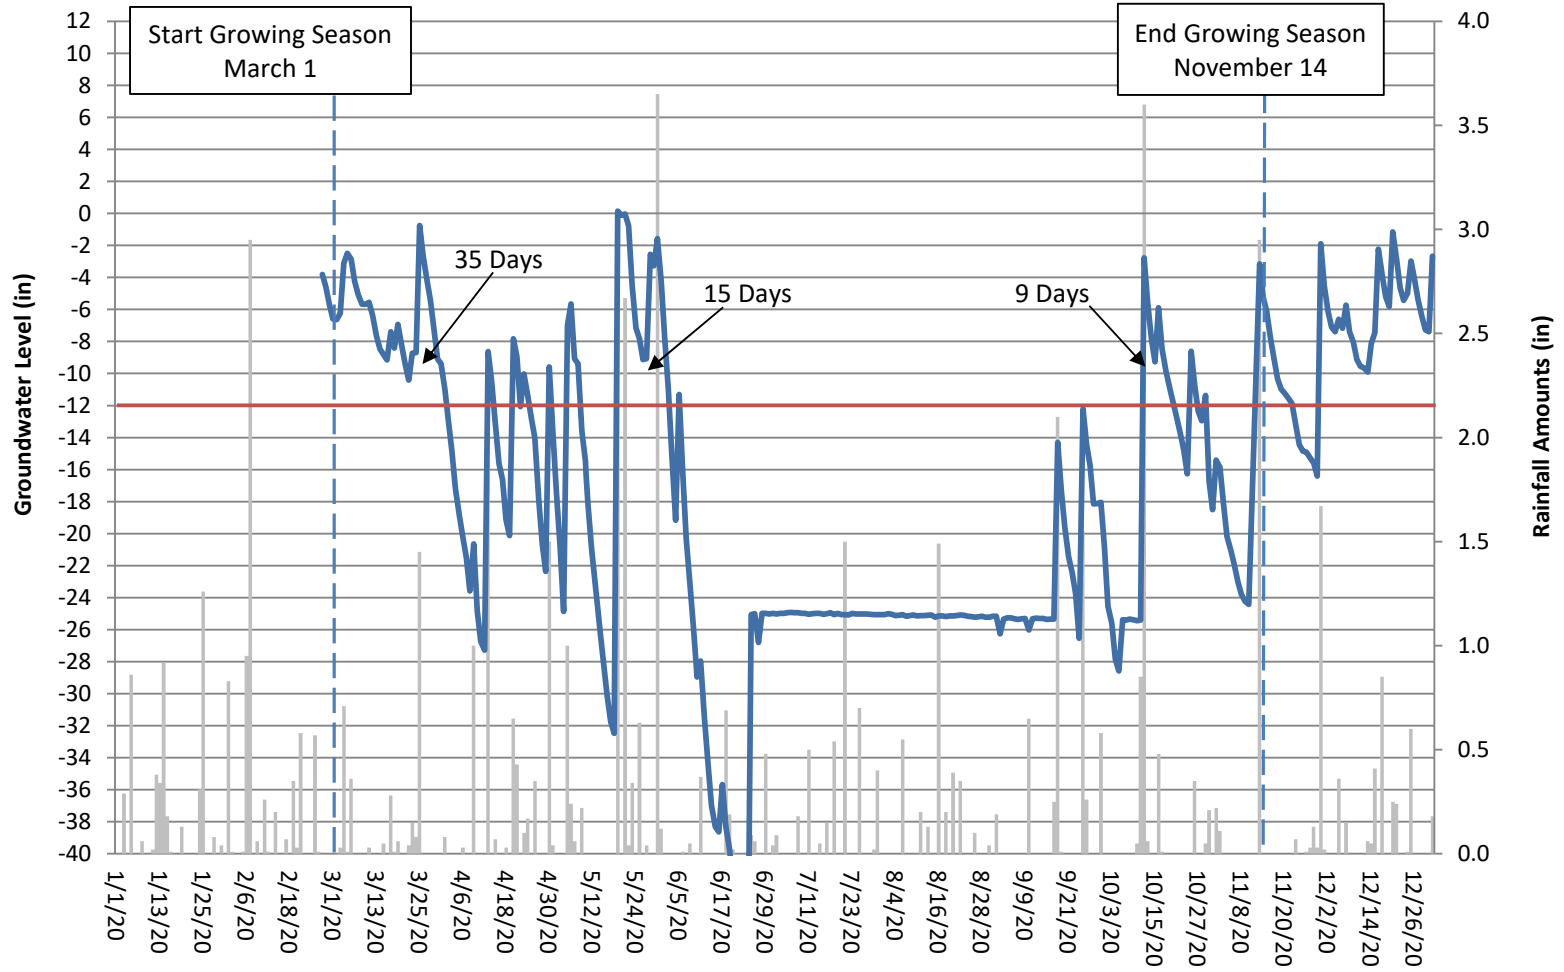


# Wits End Groundwater Gauge 3 Preconstruction (2020 Data)

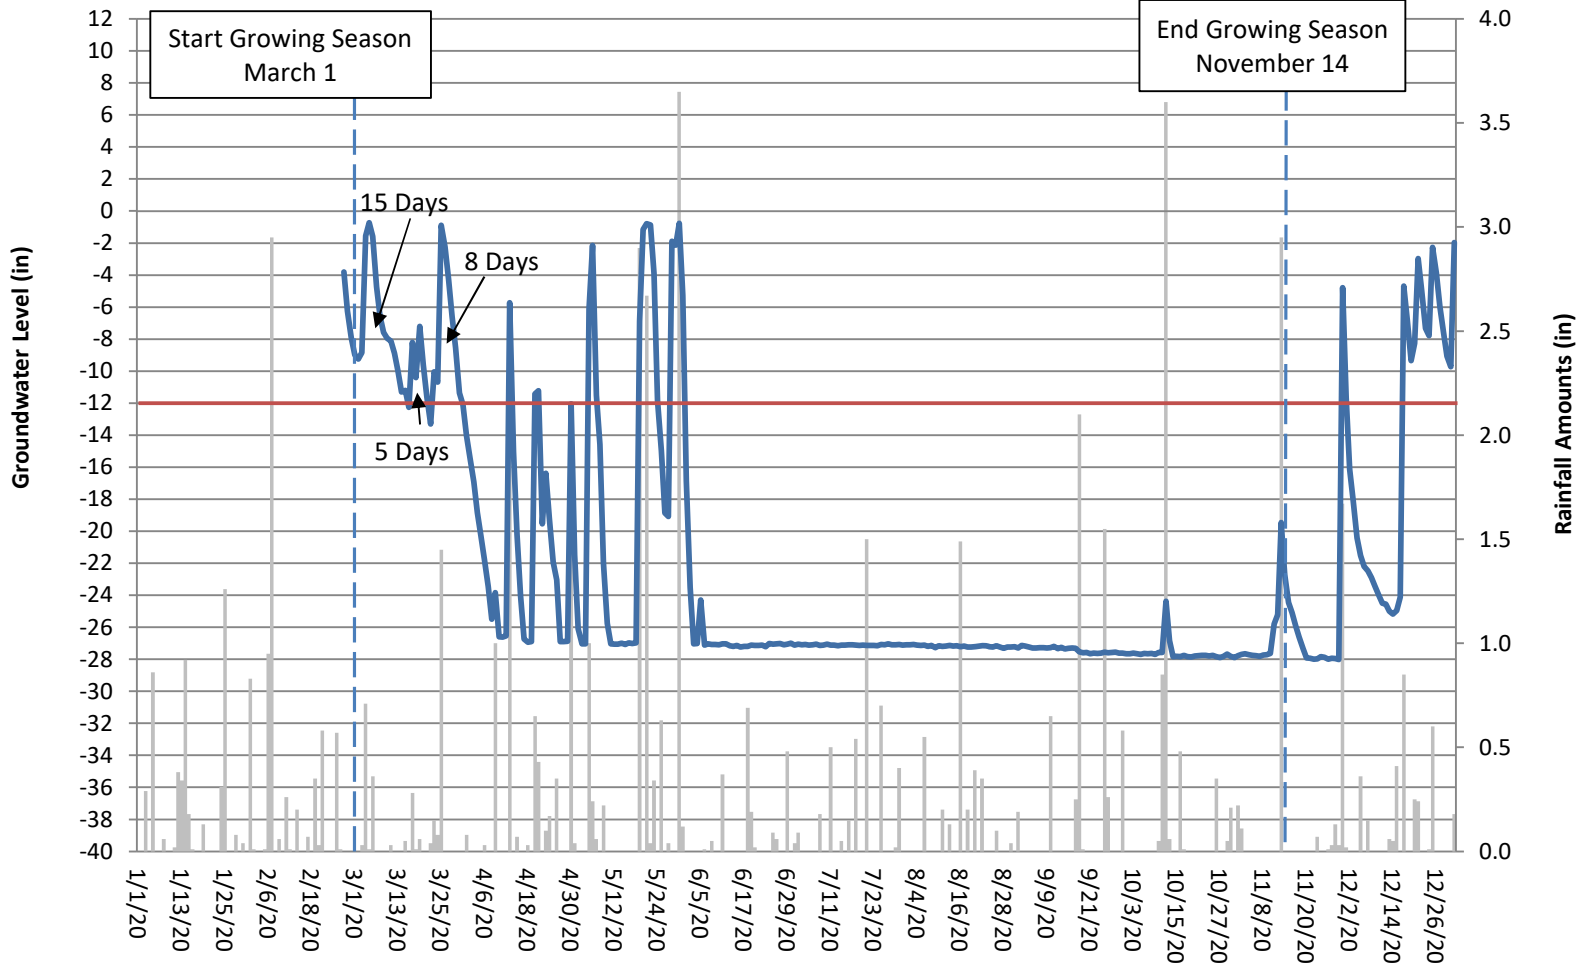





# Wits End Groundwater Gauge 4 Preconstruction (2020 Data)

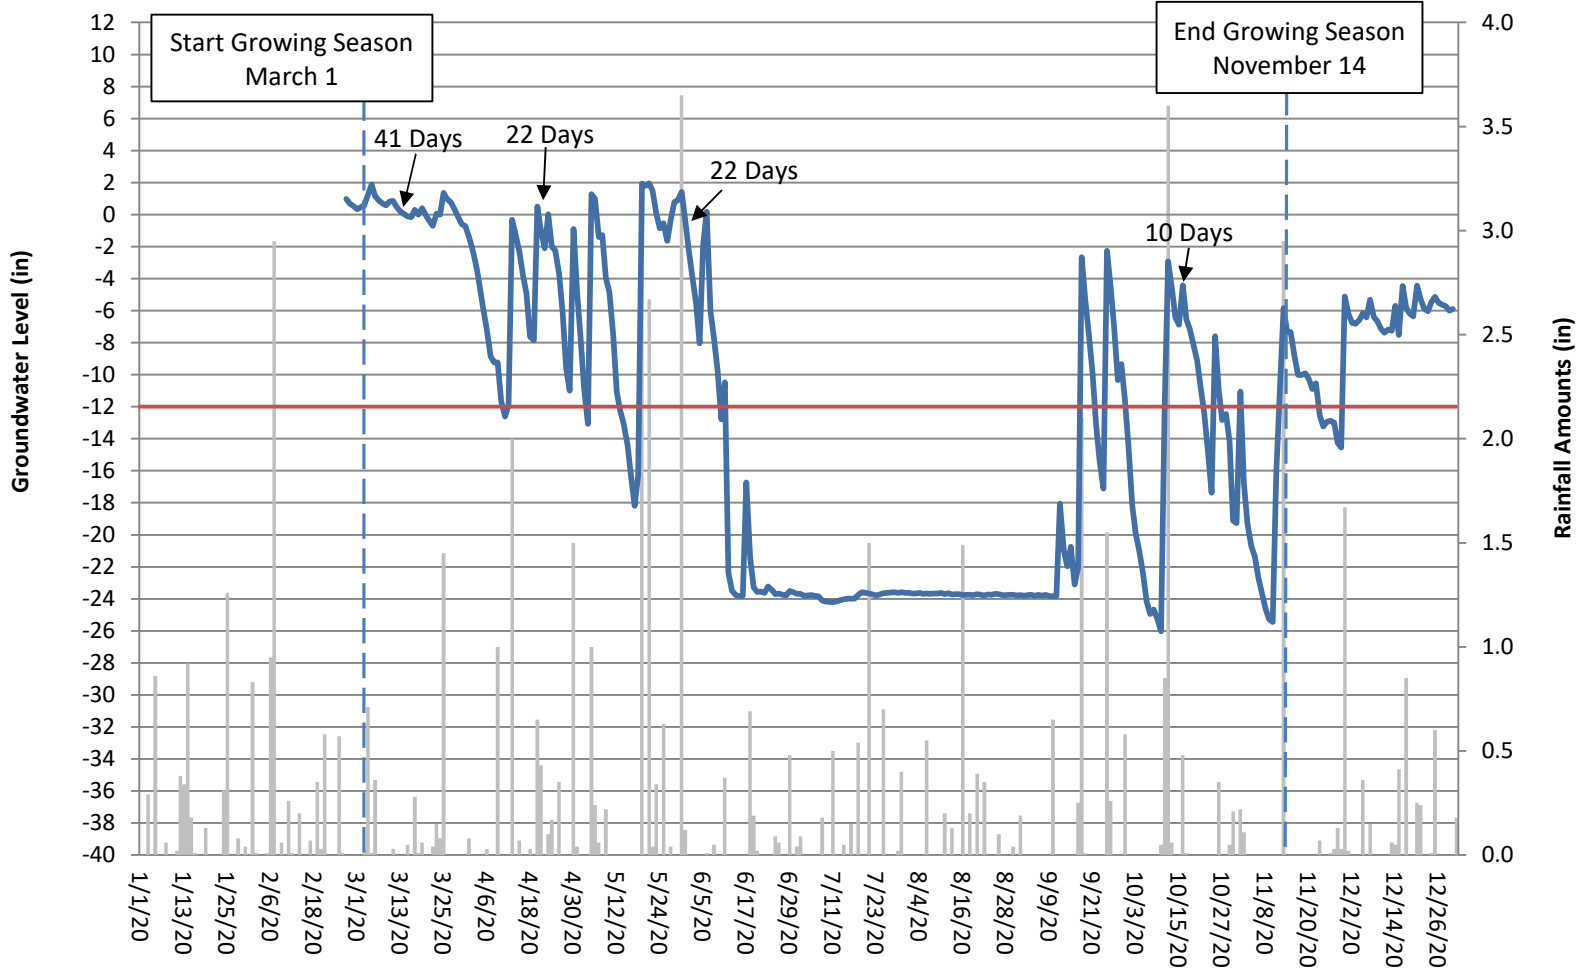


# Wits End Groundwater Gauge 5 Preconstruction (2020 Data)

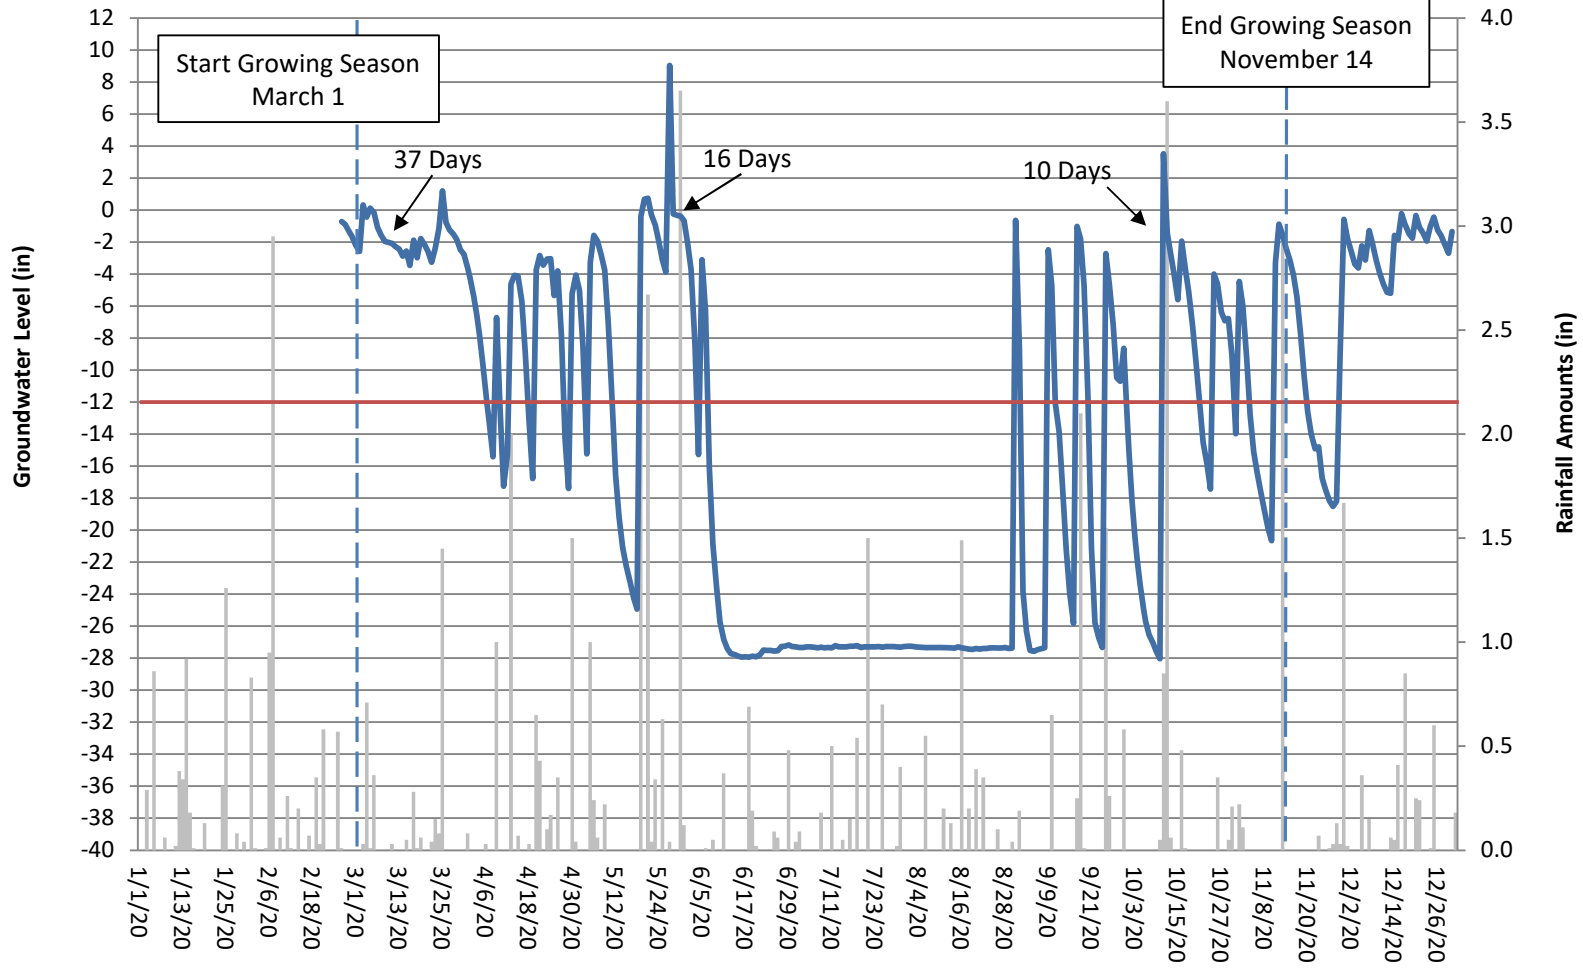

# Wits End Groundwater Gauge 1 Preconstruction (2021 Data)

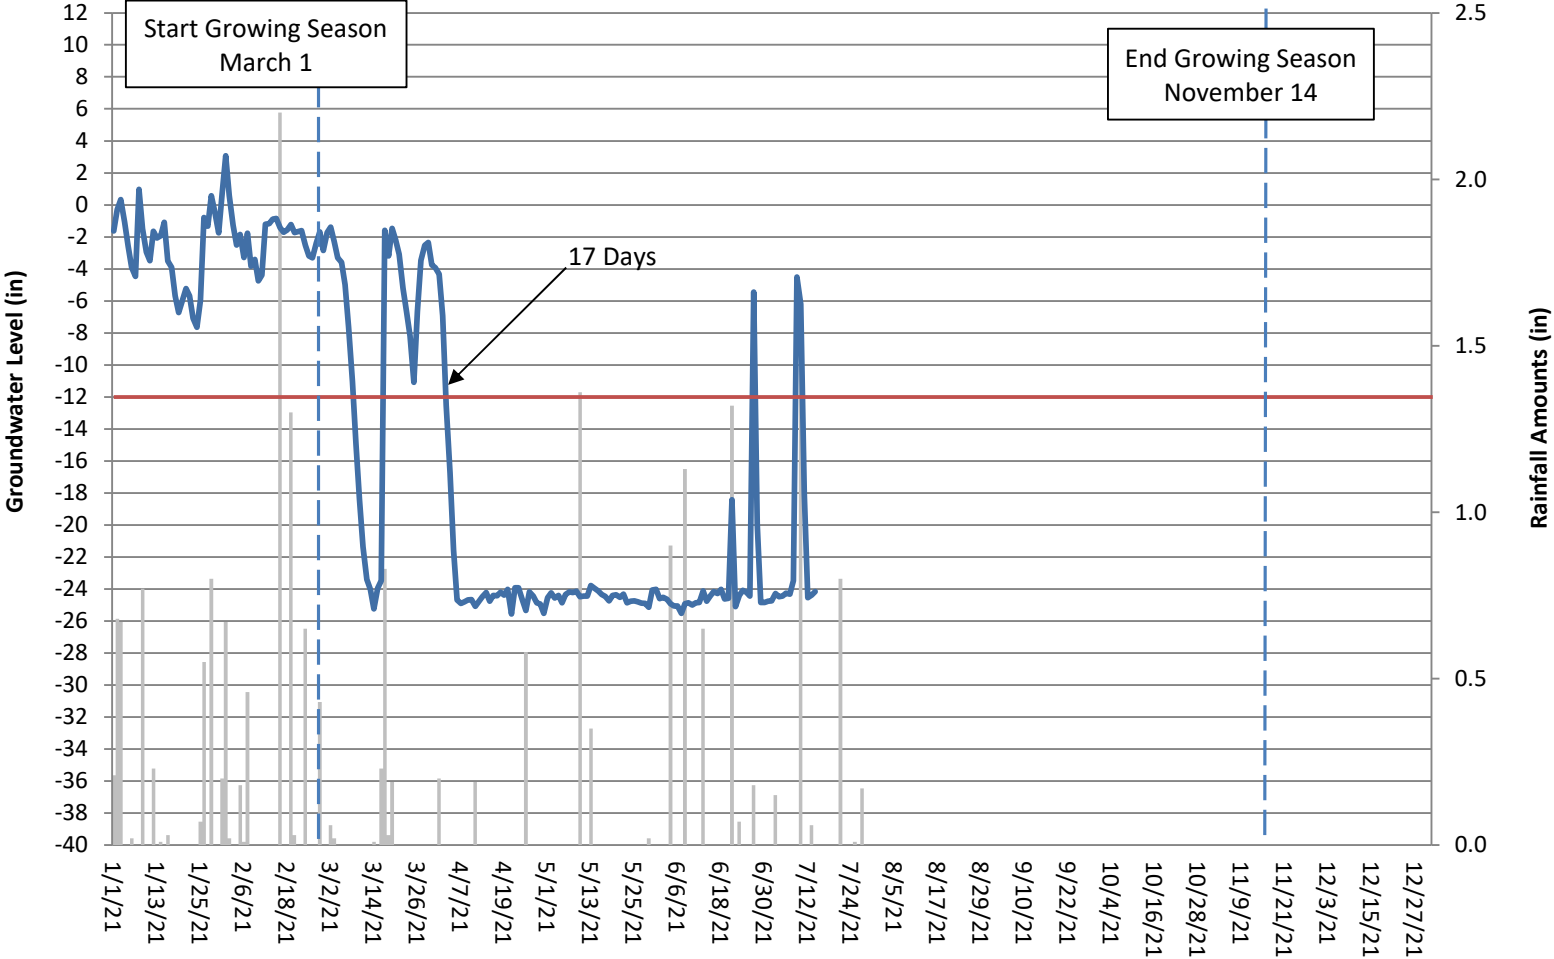


# Wits End Groundwater Gauge 2 Preconstruction (2021 Data)

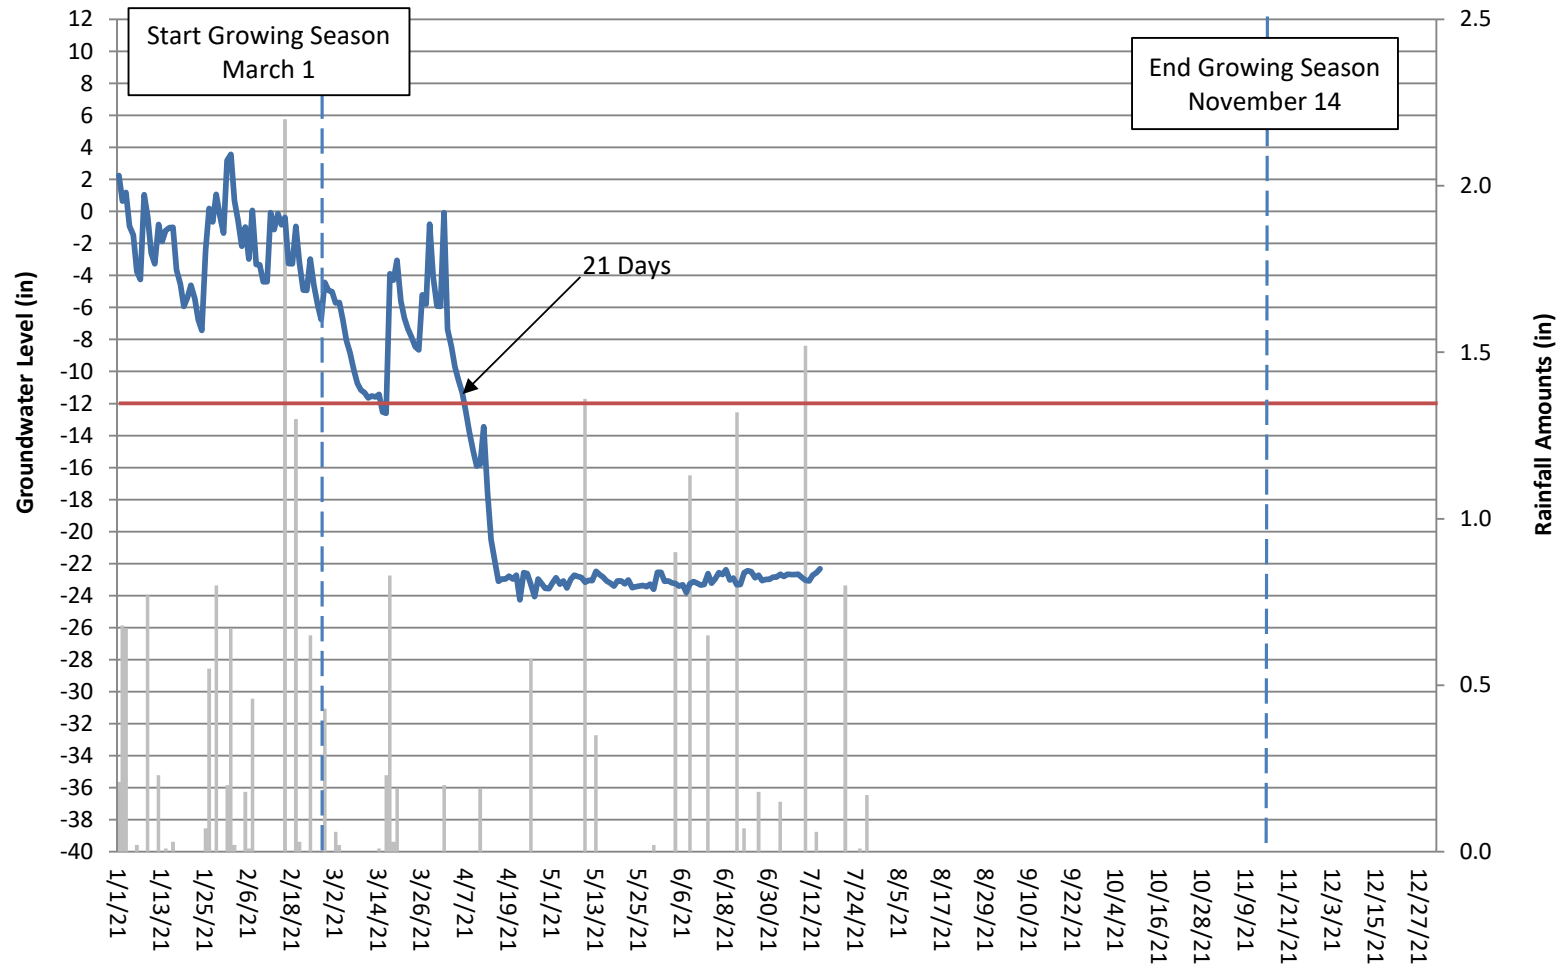





# Wits End Groundwater Gauge 3 Preconstruction (2021 Data)

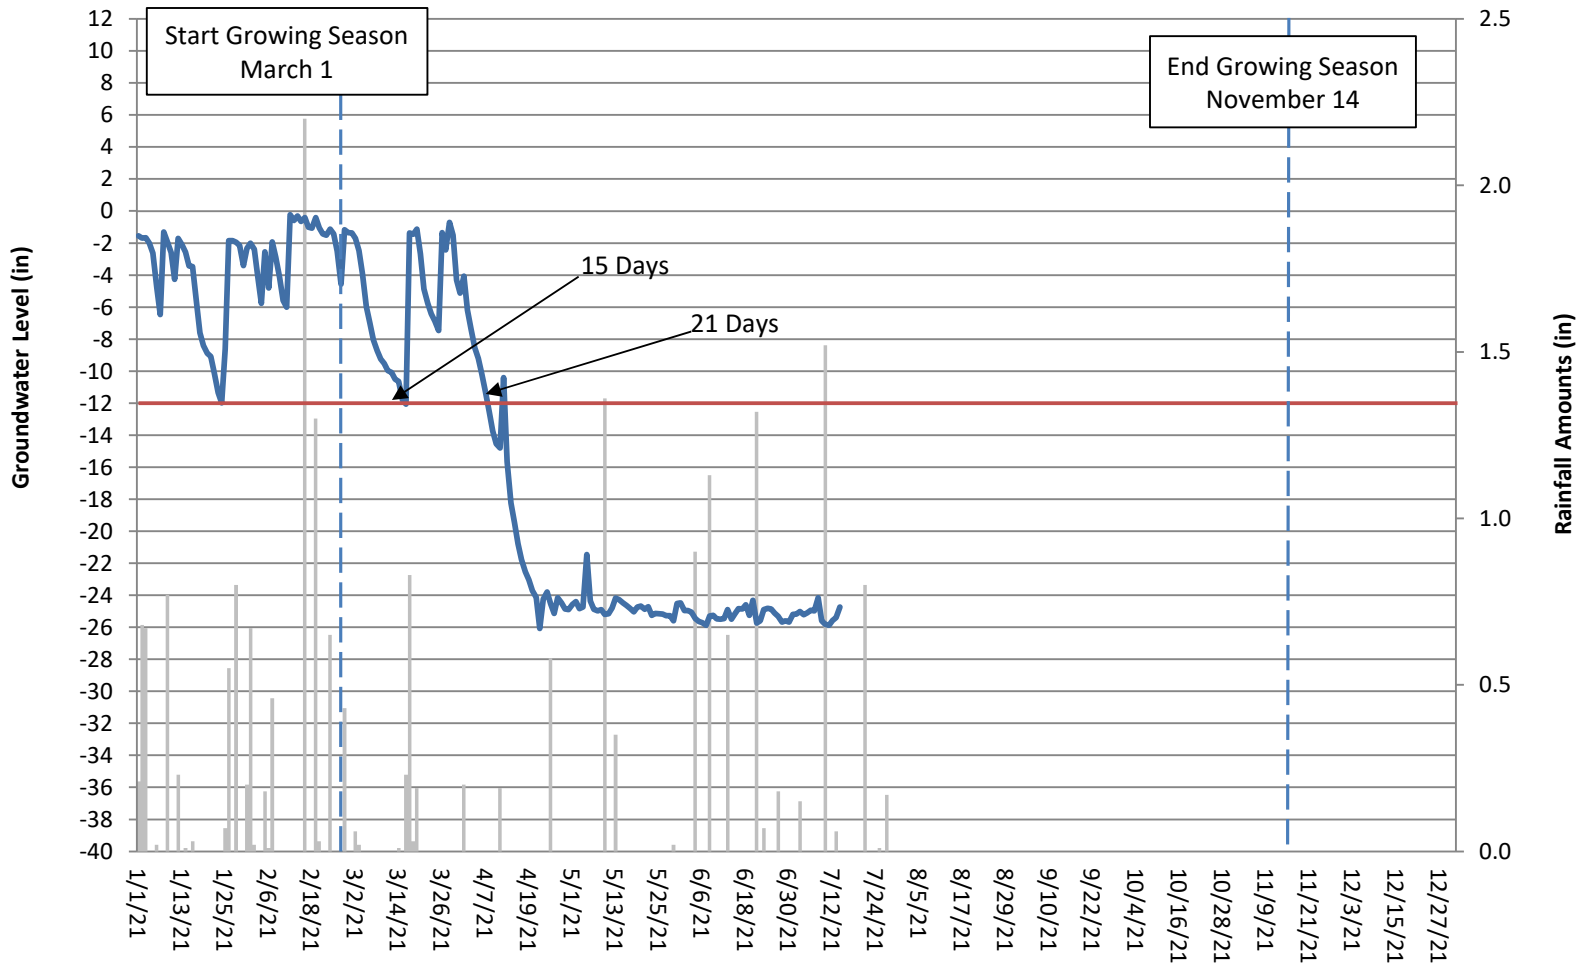

# Wits End Groundwater Gauge 4 Preconstruction (2021 Data)

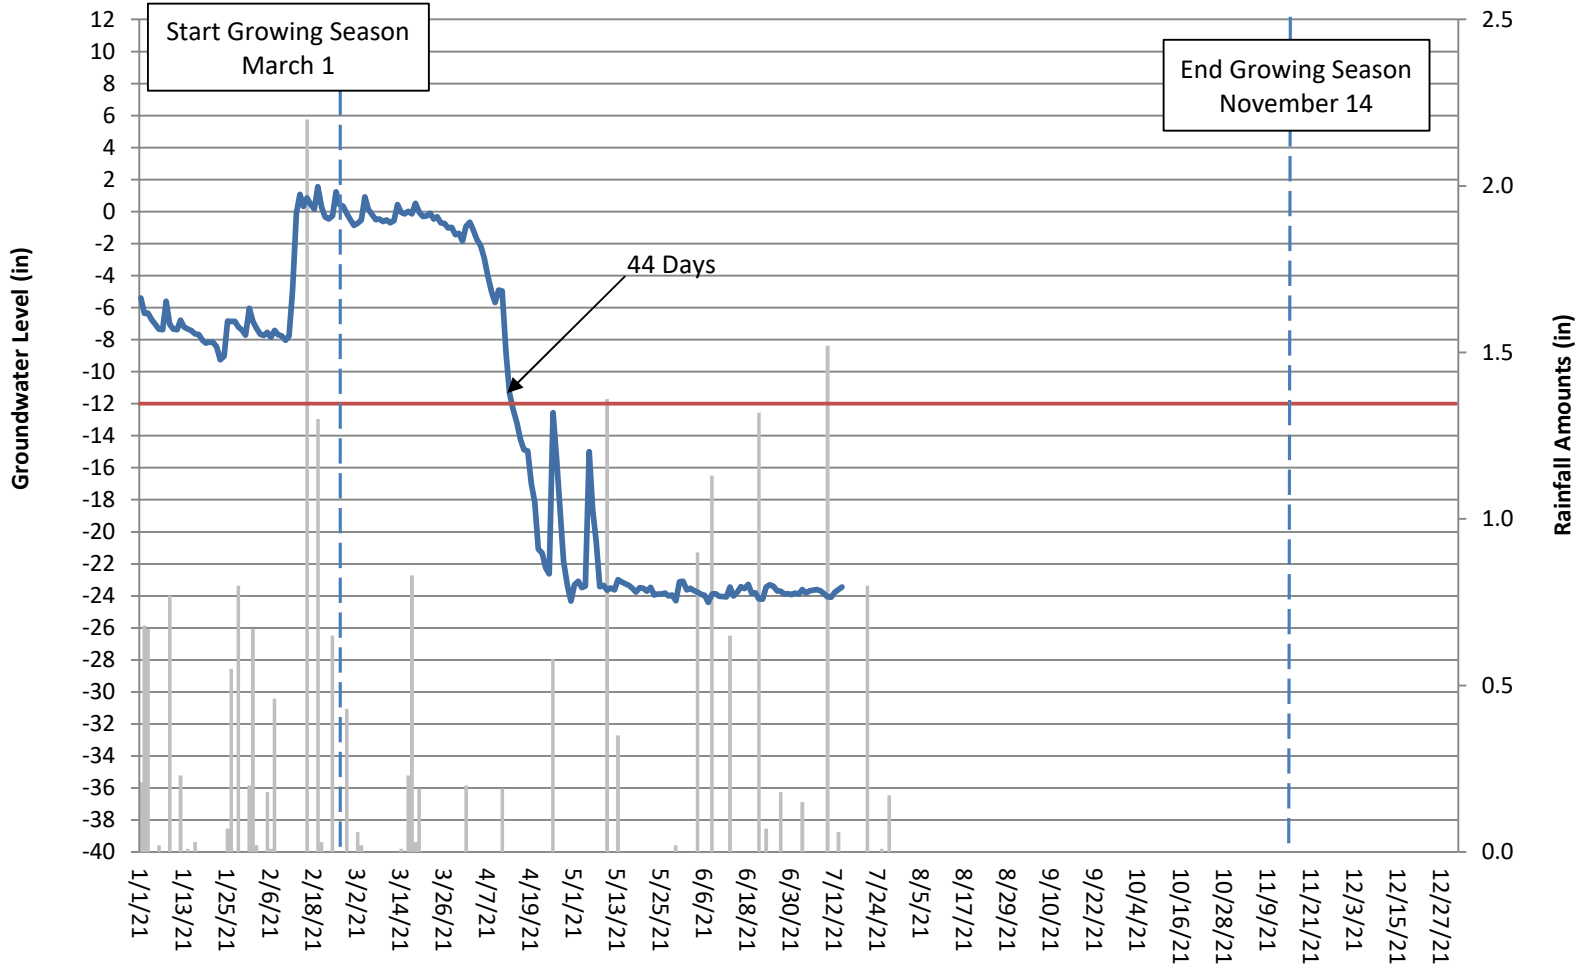

# Wits End Groundwater Gauge 5 Preconstruction (2021 Data)

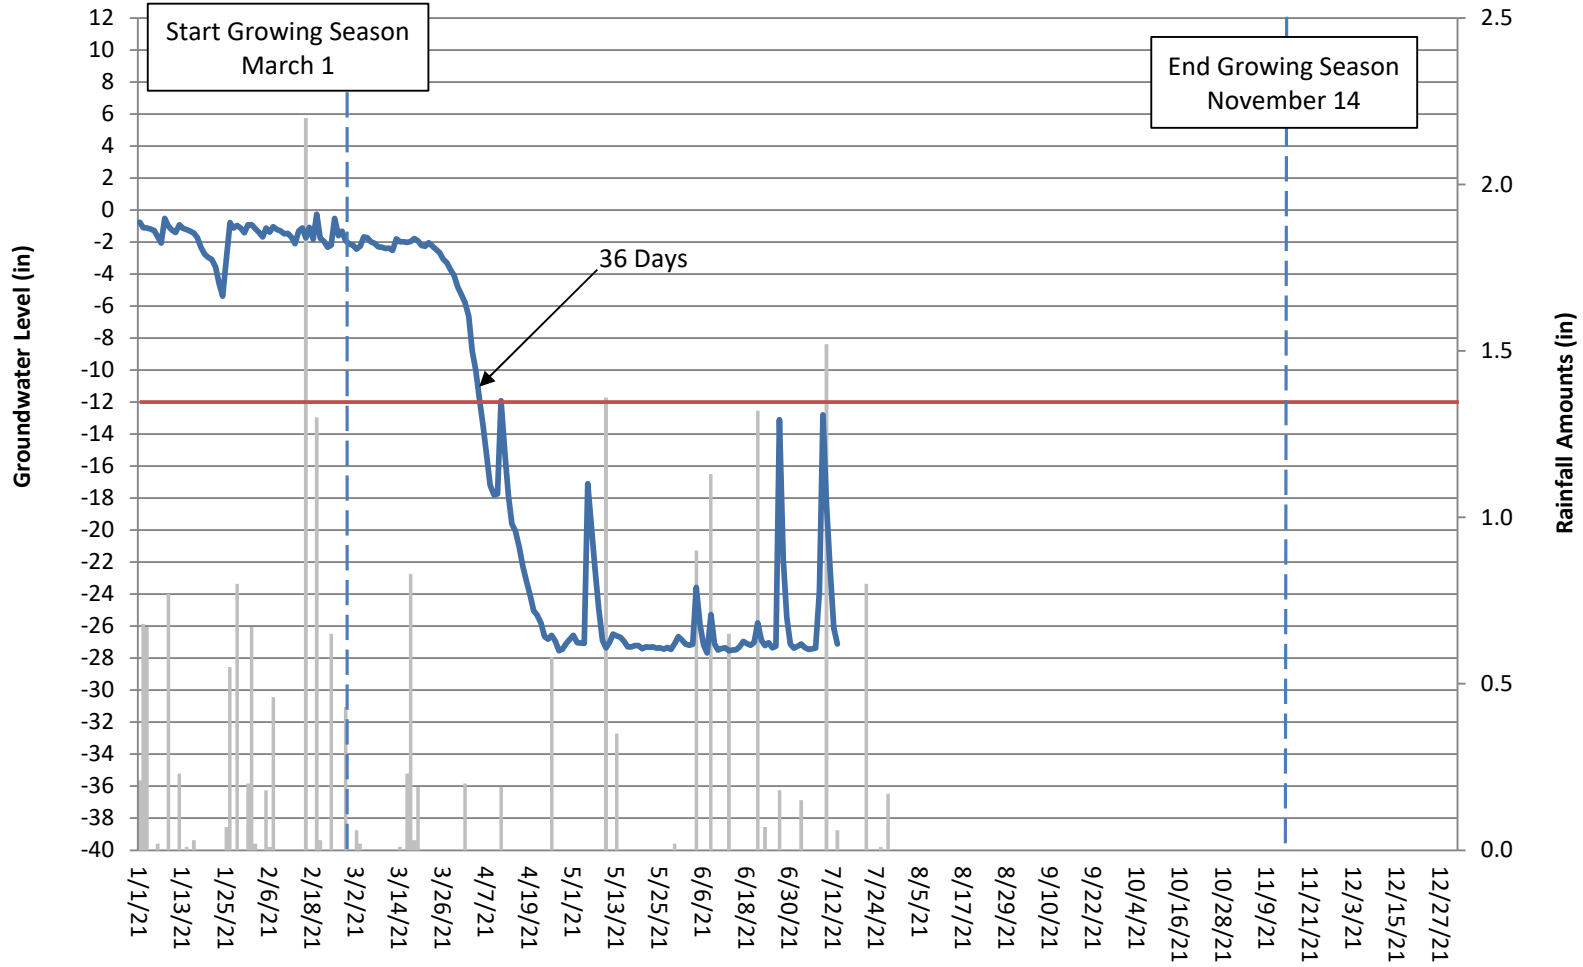





Project:

**WITS END**

Union County, NC

Title:

**PRE-CONSTRUCTION  
GROUNDWATER  
GAUGE LOCATIONS**

Drawn by: KRJ

Date: July 2022

Scale: 1:3900


Project No.: 20-011

**FIGURE**


**2**




### Wits End Stream Crest Gauge Waxhaw Branch Upstream Year 0 (2022-2023 Data)

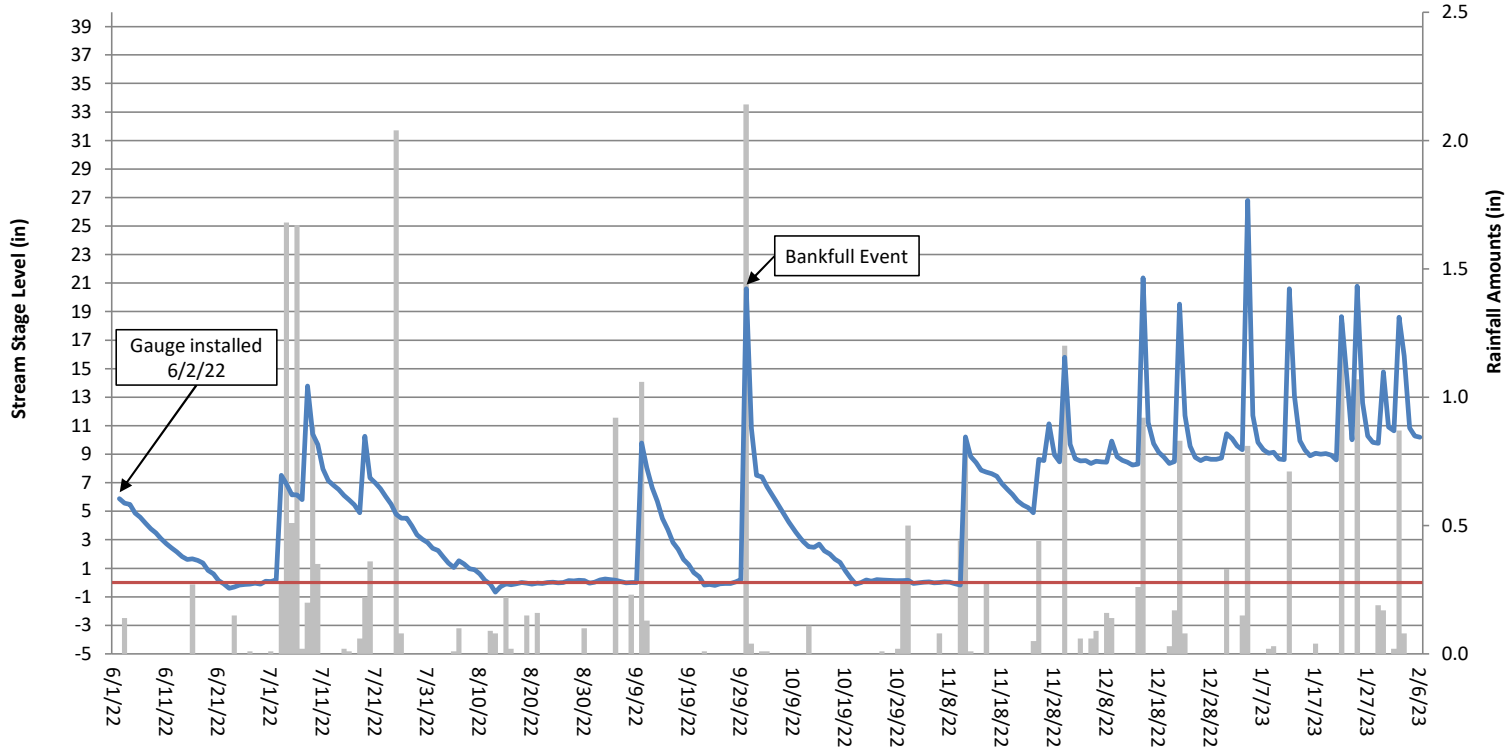


### Wits End Stream Crest Gauge Waxhaw Branch Downstream Year 0 (2022-2023 Data)

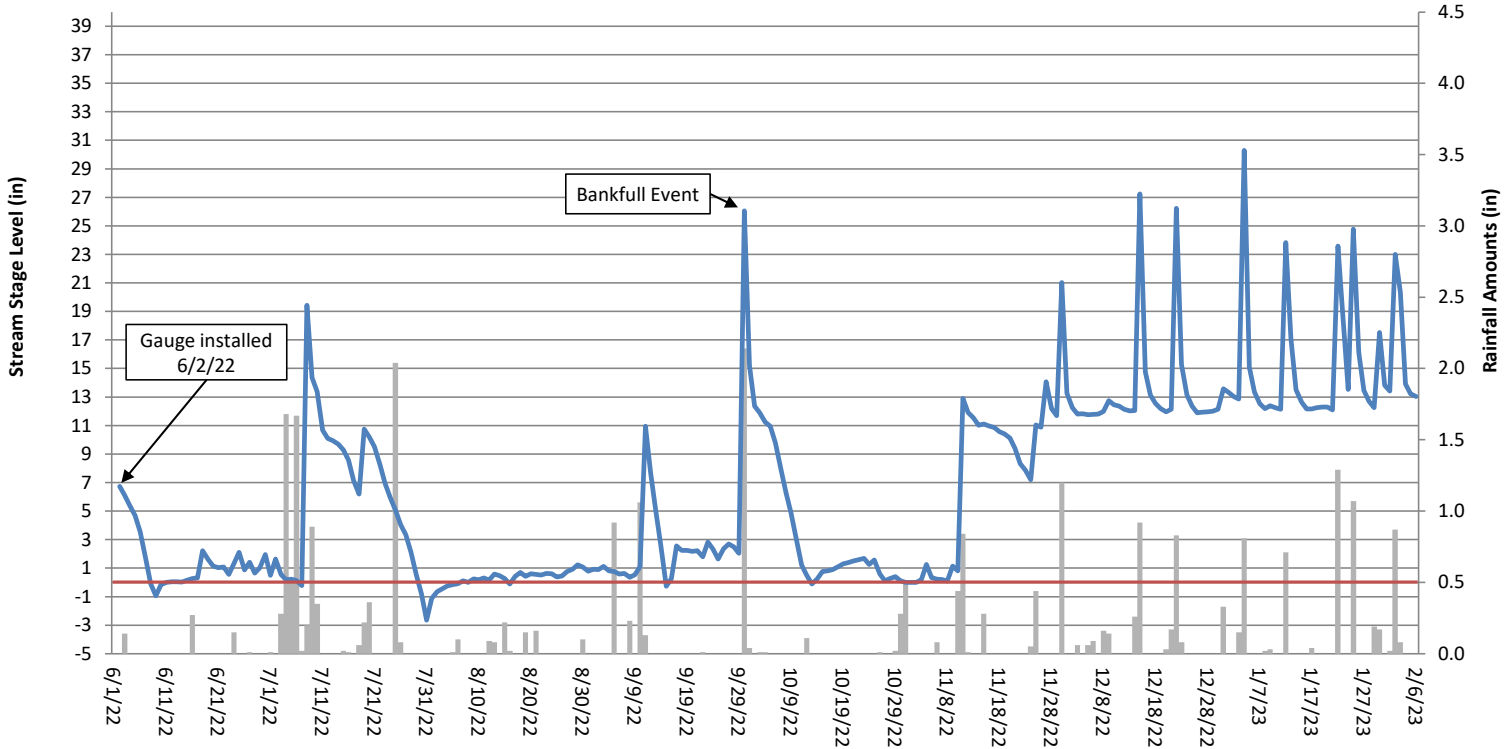

### Wits End Stream Flow Gauge UT2 Year 0 (2022-2023 Data)

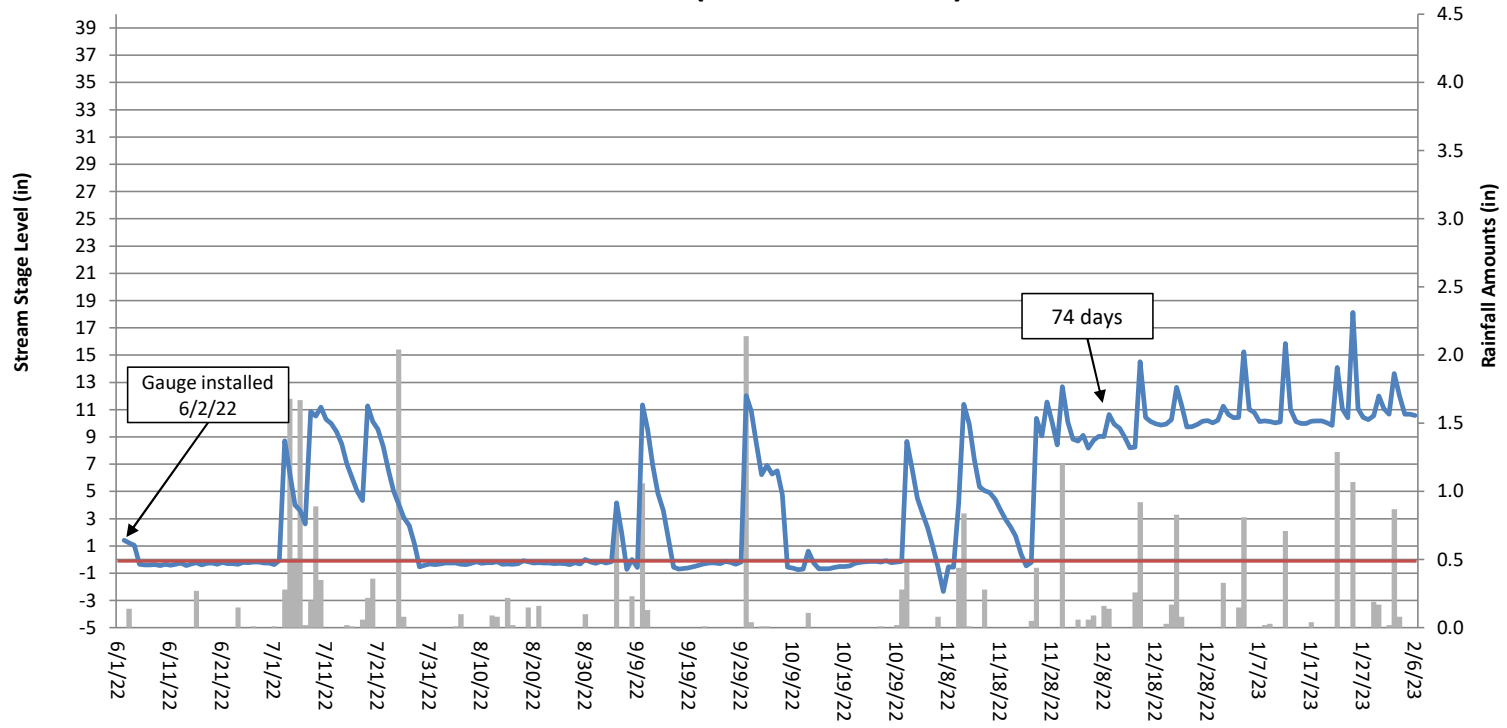


### Wits End Stream Flow Gauge UT3 Upstream Year 0 (2022-2023 Data)

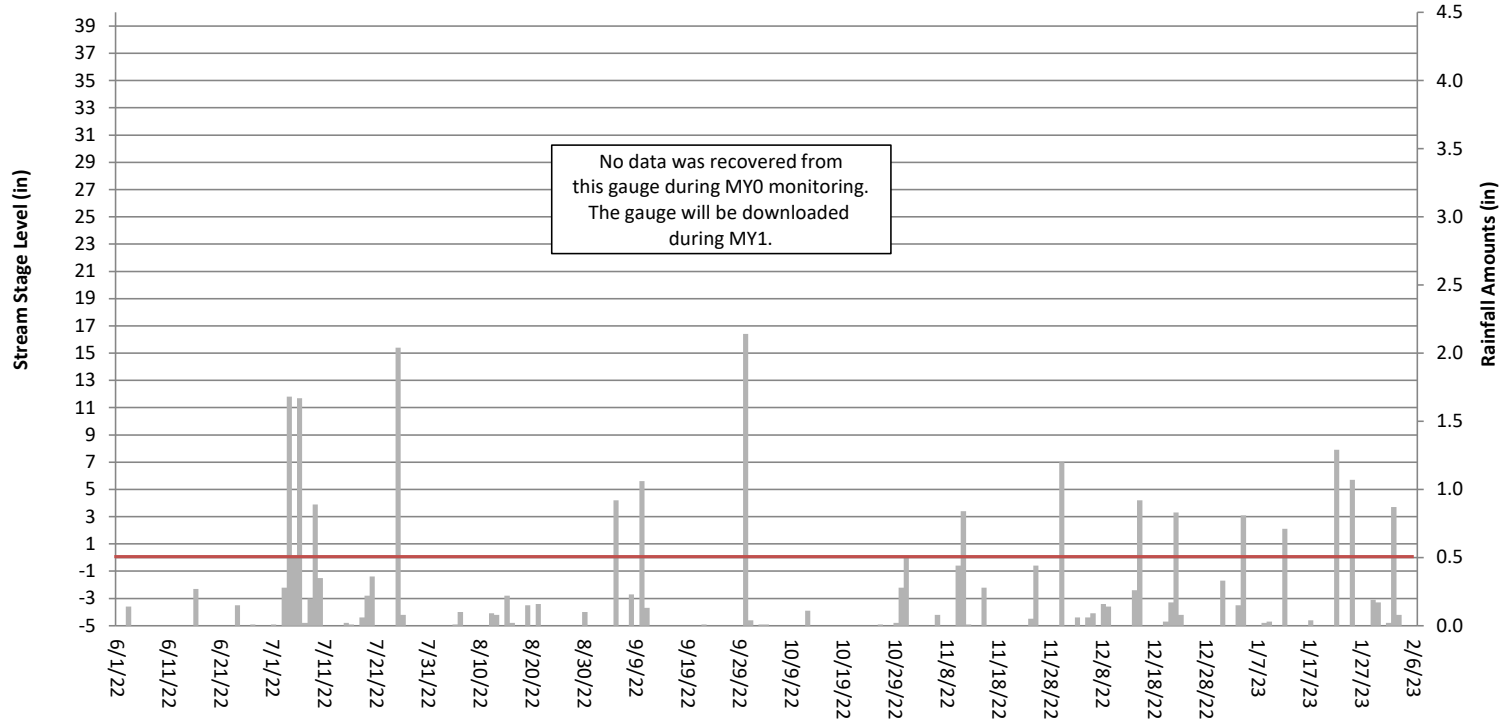





### Wits End Stream Crest Gauge UT3 Downstream Year 0 (2022-2023 Data)

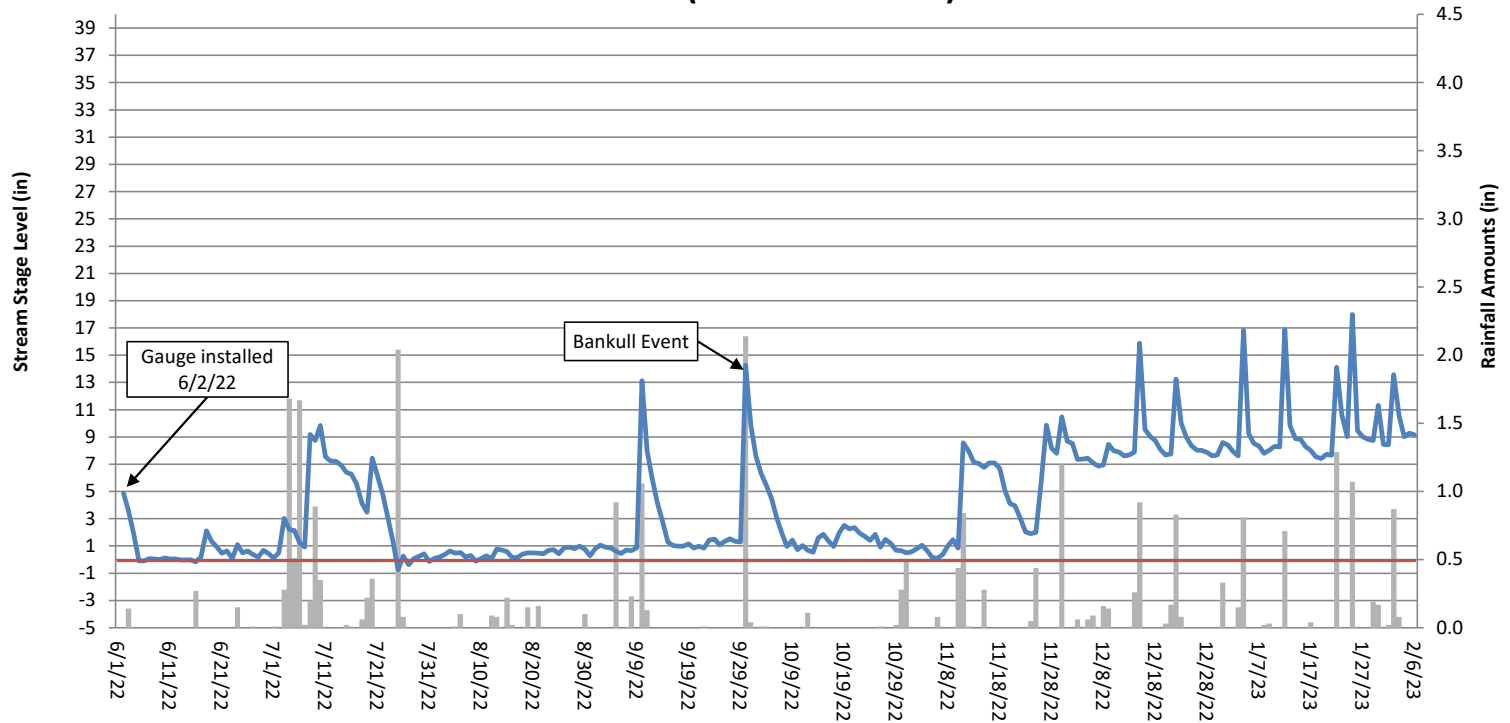


### Wits End Stream Flow Gauge UT3A Year 0 (2022-2023 Data)

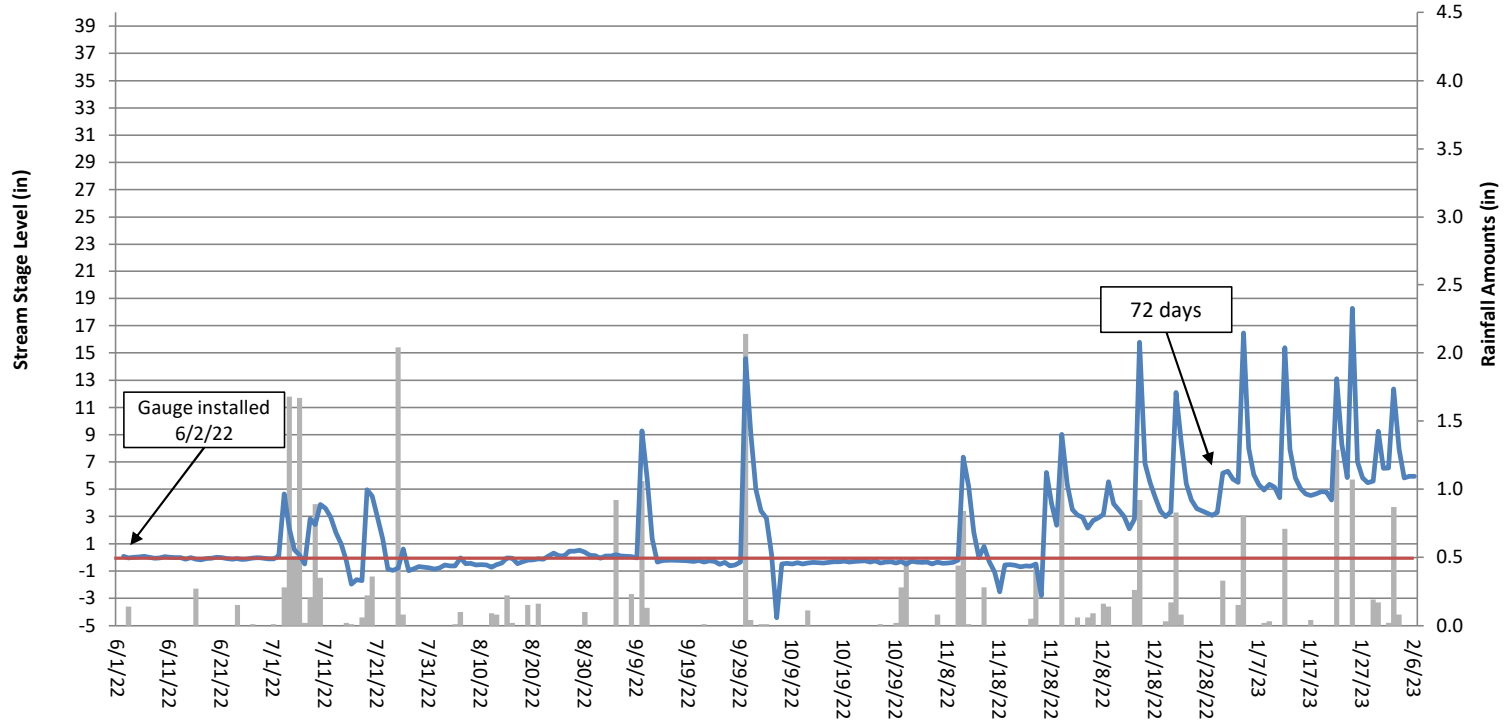

### Wits End Stream Flow Gauge UT4 Year 0 (2022-2023 Data)

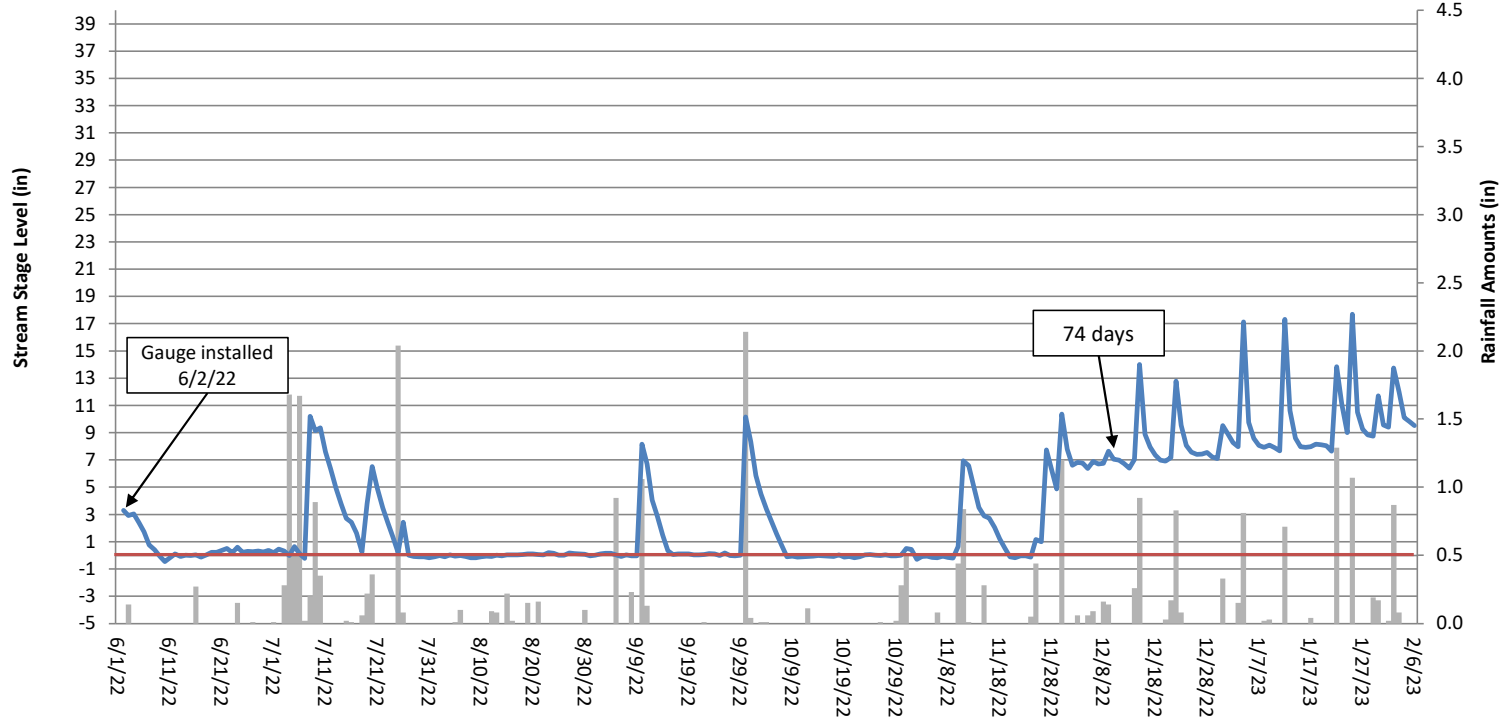

### Wits End Stream Flow Gauge UT5 Year 0 (2022-2023 Data)

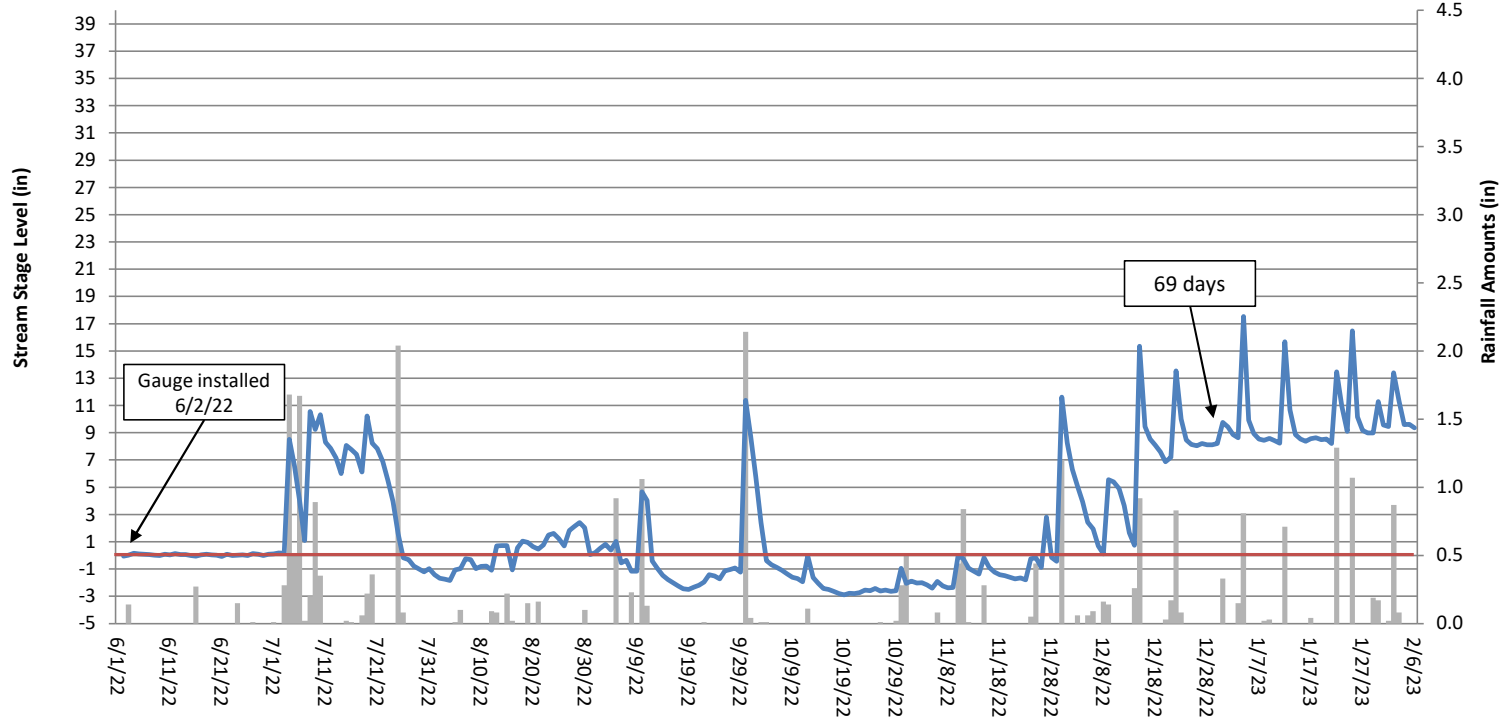



## **Appendix E: Project Timeline and Contact Info**

Table 11. Project Timeline

Table 12. Project Contacts

**Table 11. Project Timeline**

<b>Activity or Deliverable</b>	<b>Data Collection Complete</b>	<b>Task Completion or Deliverable Submission</b>
Project Instituted	NA	Aug-20
Mitigation Plan Approved	NA	28-Jul-21
Construction (Grading) Completed	NA	22-Jul-22
Planting Completed	NA	28-Jul-22
As-built Survey Completed	Jul-22	Jul-22
MY-0 Baseline Report	Jun-22	Mar-23
Stream Survey	1-Jun-22	NA
Vegetation Survey	10-Feb-23	NA
MY1+ Monitoring Reports		
Remediation Items (e.g. beaver removal, supplements, repairs etc.)		
Encroachment		

**Table 12. Project Contacts**

<b>Project Name/Number</b>	
<b>Provider</b> Mitigation Provider POC	Restoration Systems, LLC 1101 Haynes Street, Suite 211 Raleigh, NC 27604 Ray Holz 919-755-9490
<b>Designer</b> Primary project design POC	Axiom Environmental, Inc. 218 Snow Ave Raleigh, NC 27603 Grant Lewis 919-215-1693
<b>Construction Contractor</b>	Land Mechanics Designs, Inc. 126 Circle G Lane Willow Spring, NC 27592 Charles Hill 919-639-6132

## **Appendix F: Other Data**

Figures 3A-B. Stream Buffer Credit Adjustment Output

Wilmington District Stream Buffer Credit Calculator


UT 3 Redesign Summary Sheet

Recorded Release and Removal of Trails from Conservation Easement



**Legend**

- Conservation Easement Boundary
- Channel TOB
- TOB - 15 ft
- 15 - 20 ft
- 20 - 25 ft
- 25 - 30 ft
- 30 - 35 ft
- 35 - 40 ft
- 40 - 45 ft
- 45 - 50 ft
- 50 - 75 ft
- 75 - 100 ft
- 100 - 125 ft
- 125 - 150 ft
- Ineligible Buffer Area (Wetland Mitigation Beyond 50 ft from TOB)

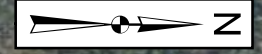

Prepared for:



Project:

**WITS END SITE**

Union County, NC

Title:

**STREAM BUFFER  
CREDIT  
ADJUSTMENT  
OUTPUT  
(ACTUAL BUFFER)**

Drawn by:

KRJ

Date:



OCT 2022

Scale:

1:4200

Project No.:

20-011

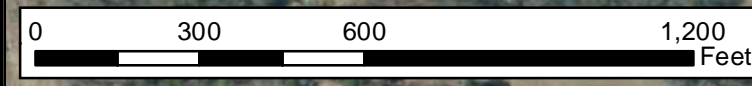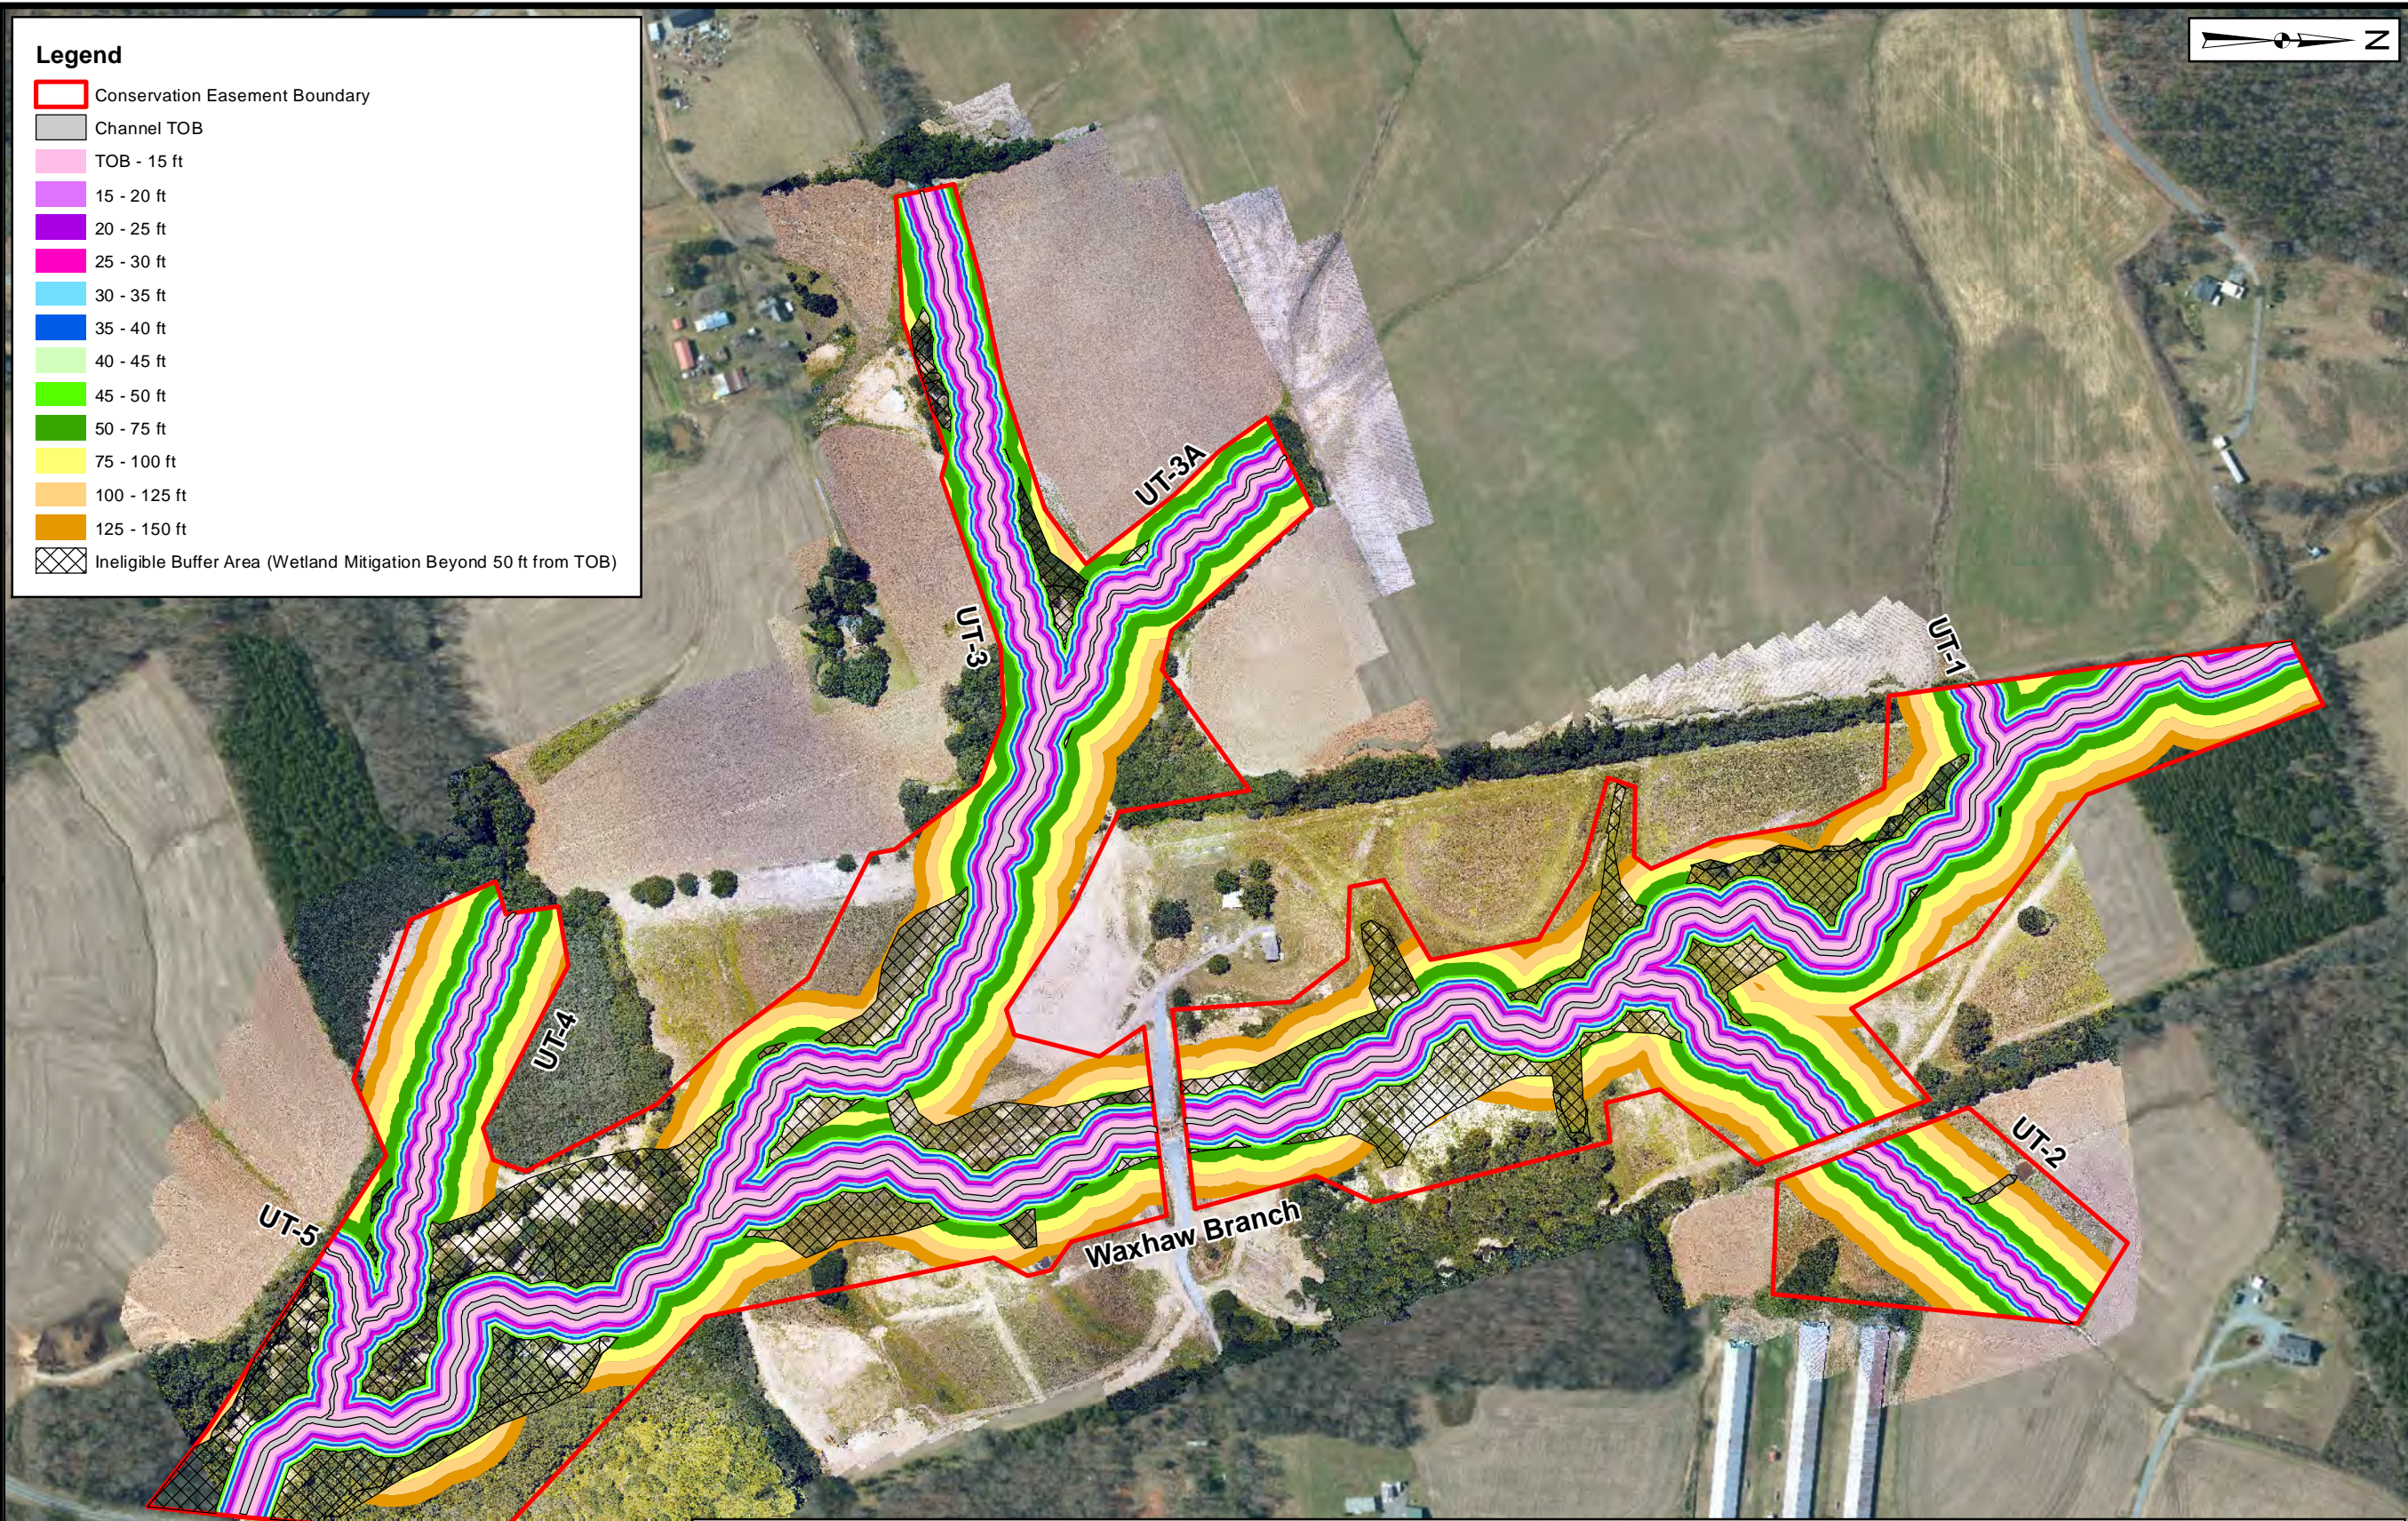


Buffer Zones	Buffer Width Zone (feet from Ordinary High Water Mark)											
	<15 feet	>15 to 20 feet	>20 to 25 feet	>25 to 30 feet	>30 to 35 feet	>35 to 40 feet	>40 to 45 feet	>45 to 50 feet	>50 to 75 feet	>75 to 100 feet	>100 to 125 feet	>125 to 150 feet
Max Possible Buffer (square feet) <sup>1</sup>	348312.75	117203.25	117752.75	118302.25	118851.75	119401.25	119950.75	120500.25	610743.75	624481.25	638218.75	651956.25
Ideal Buffer (square feet) <sup>2</sup>	847079.04	115578.42	115570.16	115208.81	114511.84	113783.00	113109.34	112567.41	550853.89	528773.22	511045.07	499872.80
Actual Buffer (square feet) <sup>3</sup>	839479.07	110624.73	106835.72	108851.98	107061.98	105577.40	104152.80	102983.17	281175.26	259621.51	243399.27	201245.87
Zone Multiplier	50%	10%	10%	10%	5%	5%	5%	5%	7%	5%	4%	4%
Buffer Credit Equivalent	5336.13	1067.23	1067.23	1067.23	533.61	533.61	533.61	533.61	747.06	533.61	426.89	426.89
Percent of Ideal Buffer	98%	97%	96%	95%	95%	95%	94%	94%	47%	49%	46%	40%
Credit Adjustment	-95.13	-37.17	-44.73	-50.18	-24.82	-29.28	-31.70	-33.84	354.47	262.99	203.31	171.86
<b>Total Baseline Credit</b>	<b>10672.27</b>											
<b>Credit Loss in Required Buffer</b>	<b>-351.95</b>											
<b>Credit Gain for Additional Buffer</b>	<b>992.64</b>											
<b>Net Change in Credit from Buffers</b>	<b>640.69</b>											
<b>Total Credit</b>	<b>11312.96</b>											

FIGURE  
**3A**



**Legend**

- Conservation Easement Boundary
- Channel TOB
- TOB - 15 ft
- 15 - 20 ft
- 20 - 25 ft
- 25 - 30 ft
- 30 - 35 ft
- 35 - 40 ft
- 40 - 45 ft
- 45 - 50 ft
- 50 - 75 ft
- 75 - 100 ft
- 100 - 125 ft
- 125 - 150 ft

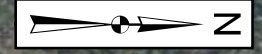

Prepared for:



Project:

**WITS END SITE**

Union County, NC

Title:

**STREAM BUFFER  
CREDIT  
ADJUSTMENT  
OUTPUT  
(IDEAL BUFFER)**

Drawn by:

KRJ

Date:



OCT 2022

Scale:

1:4200

Project No.:

20-011

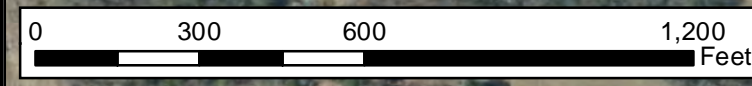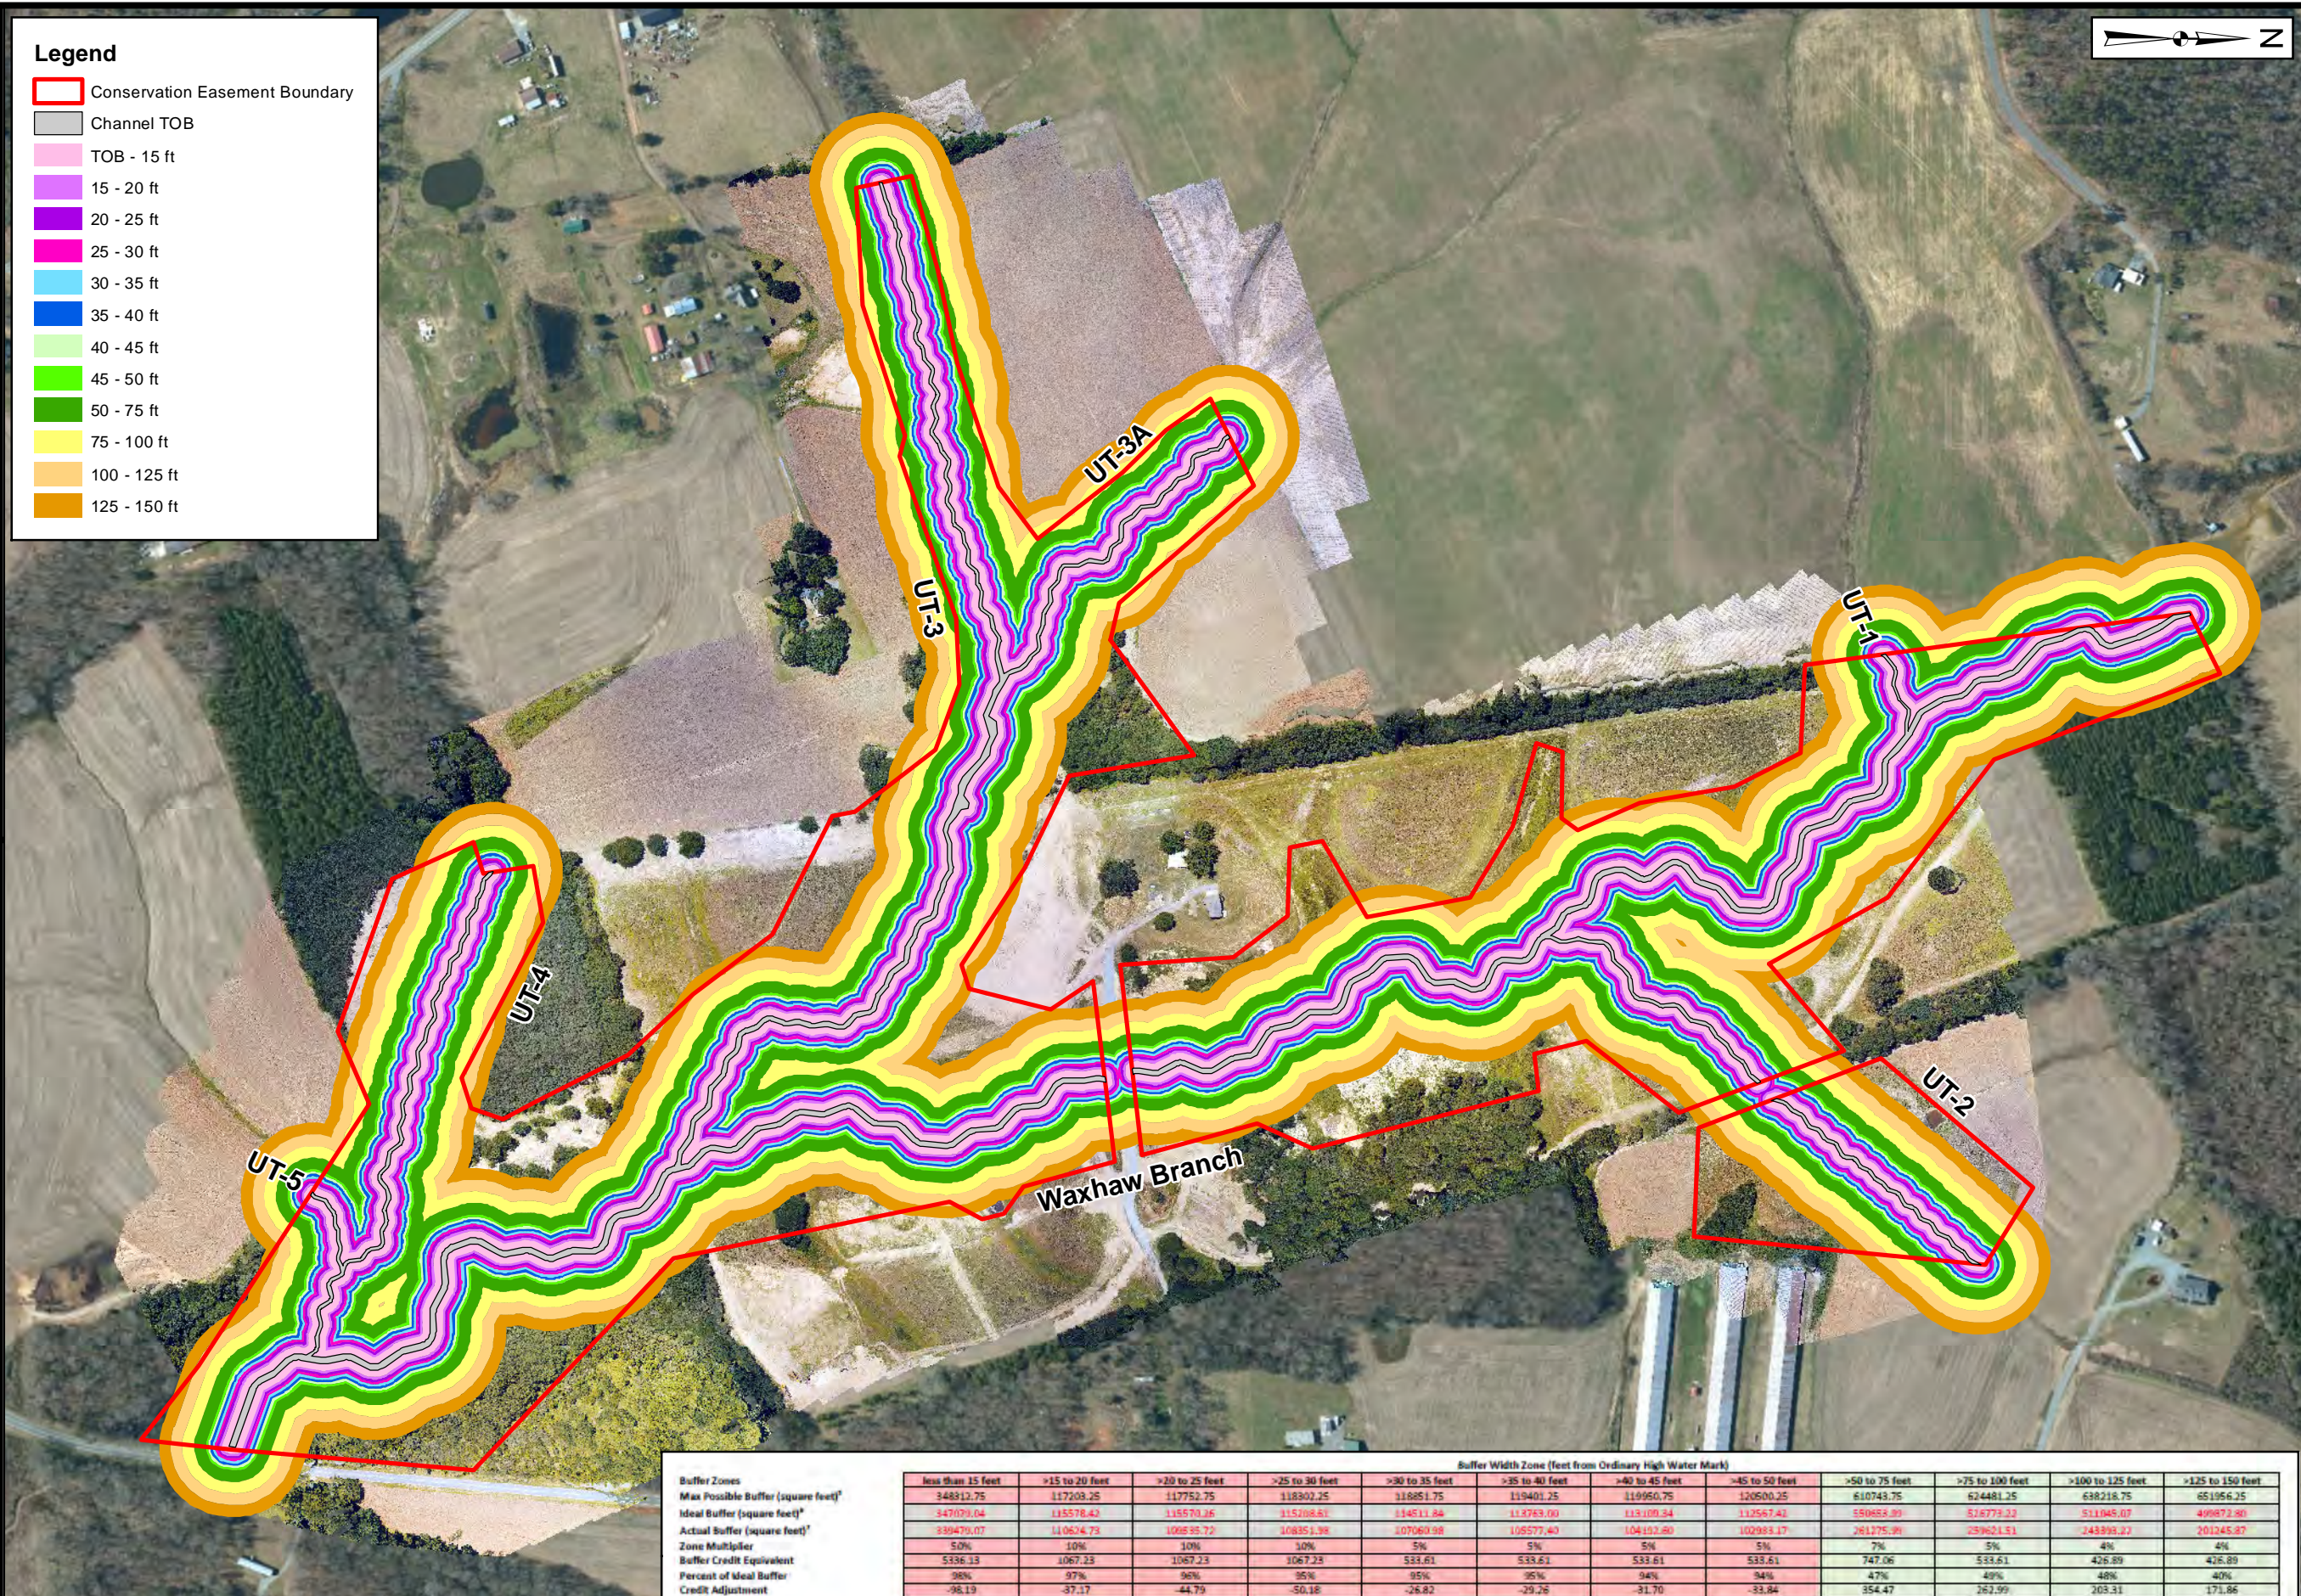

Buffer Zones	Buffer Width Zone (feet from Ordinary High Water Mark)											
	<15 feet	>15 to 20 feet	>20 to 25 feet	>25 to 30 feet	>30 to 35 feet	>35 to 40 feet	>40 to 45 feet	>45 to 50 feet	>50 to 75 feet	>75 to 100 feet	>100 to 125 feet	>125 to 150 feet
Max Possible Buffer (square feet) <sup>1</sup>	348312.75	117203.25	117752.75	118302.25	118851.75	119401.25	119950.75	120500.25	610743.75	624481.25	638218.75	651956.25
Ideal Buffer (square feet) <sup>2</sup>	847079.04	115578.42	115570.16	115208.81	114511.84	113783.00	113109.34	112567.41	550653.89	516773.22	511045.07	499872.80
Actual Buffer (square feet) <sup>3</sup>	839479.07	110624.73	106635.72	108851.98	107061.98	105577.40	104152.80	102983.17	281175.26	259621.51	243399.27	201245.87
Zone Multiplier	50%	10%	10%	10%	5%	5%	5%	5%	7%	5%	4%	4%
Buffer Credit Equivalent	5336.13	1067.23	1067.23	1067.23	533.61	533.61	533.61	533.61	747.06	533.61	426.89	426.89
Percent of Ideal Buffer	98%	97%	96%	95%	95%	95%	94%	94%	47%	49%	46%	40%
Credit Adjustment	-95.13	-37.17	-44.73	-50.18	-24.82	-29.28	-31.70	-33.84	354.47	262.99	203.31	171.86
<b>Total Baseline Credit</b>	<b>10672.27</b>											
<b>Credit Loss in Required Buffer</b>	<b>-351.95</b>											
<b>Credit Gain for Additional Buffer</b>	<b>992.64</b>											
<b>Net Change in Credit from Buffers</b>	<b>640.69</b>											
<b>Total Credit</b>	<b>11312.96</b>											

FIGURE  
**3B**



Wilmington District Stream Buffer Credit Calculator

Site Name:	Wits End
USACE Action ID:	NA
NCDWR Project Number:	NA
Sponsor:	Restoration Systems
Number of Exempt Terminal Stream Ends <sup>1</sup> :	7
County:	Union
Minimum Required Buffer Width <sup>2</sup> :	50

Mitigation Type	Mitigation Ratio Multiplier <sup>3</sup>	Creditable Stream Length <sup>4</sup>	Include in Buffer Calculations	Baseline Stream Credit	Buffered Stream Length	Credit From Buffered Streams
Restoration (1:1)	1	10323	Yes	10323.00	10323.00	10323.00
Enhancement I (1.5:1)	1.5	232	Yes	154.67	232.00	154.67
Enhancement II (2.5:1)	2.5					
Preservation (5:1)	5					
Other (7.5:1)	7.5					
Other (10:1)	10					
Custom Ratio 1	5	973	Yes	194.60	973.00	194.60
Custom Ratio 2						
Custom Ratio 3						
Custom Ratio 4						
Custom Ratio 5						
<b>Totals</b>		<b>11528.00</b>		<b>10672.27</b>	<b>11528.00</b>	<b>10672.27</b>

Buffer Zones	Buffer Width Zone (feet from Ordinary High Water Mark)											
	less than 15 feet	>15 to 20 feet	>20 to 25 feet	>25 to 30 feet	>30 to 35 feet	>35 to 40 feet	>40 to 45 feet	>45 to 50 feet	>50 to 75 feet	>75 to 100 feet	>100 to 125 feet	>125 to 150 feet
Max Possible Buffer (square feet) <sup>5</sup>	348312.75	117203.25	117752.75	118302.25	118851.75	119401.25	119950.75	120500.25	610743.75	624481.25	638218.75	651956.25
Ideal Buffer (square feet) <sup>6</sup>	347079.04	115578.42	115570.26	115208.61	114511.84	113763.00	113109.34	112567.42	550653.99	526773.22	511045.07	499872.80
Actual Buffer (square feet) <sup>7</sup>	339479.07	110624.73	109535.72	108351.98	107060.98	105577.40	104192.60	102983.17	261275.99	259621.51	243393.22	201245.87
Zone Multiplier	50%	10%	10%	10%	5%	5%	5%	5%	7%	5%	4%	4%
Buffer Credit Equivalent	5336.13	1067.23	1067.23	1067.23	533.61	533.61	533.61	533.61	747.06	533.61	426.89	426.89
Percent of Ideal Buffer	98%	97%	96%	95%	95%	95%	94%	94%	47%	49%	48%	40%
Credit Adjustment	-98.19	-37.17	-44.79	-50.18	-26.82	-29.26	-31.70	-33.84	354.47	262.99	203.31	171.86

Total Baseline Credit	Credit Loss in Required Buffer	Credit Gain for Additional Buffer	Net Change in Credit from Buffers	Total Credit
10672.27	-351.95	992.64	640.69	11312.96

<sup>1</sup>Number of terminal stream ends, including all points where streams enter or exit the project boundaries, but not including internal crossings even if they are not protected by the easement.

<sup>2</sup>Minimum standard buffer width measured from the top of bank (50 feet in piedmont and coastal plain counties or 30 feet in mountain counties)

<sup>3</sup>Use the Custom Ratio fields to enter non-standard ratios, which are equal to the number of feet in the feet-to-credit mitigation ratio (e.g., for a preservation ratio of 8 feet to 1 credit, the multiplier would be 8).

<sup>4</sup>Equal to the number of feet of stream in each Mitigation Type. If stream reaches are not creditable, they should be excluded from this measurement, even if they fall within the easement.

<sup>5</sup>This amount is the maximum buffer area possible based on the linear footage of stream length if channel were perfectly straight with full buffer width and no internal crossings. This number is not used in calculations, but is provided as a reference.

<sup>6</sup>Maximum potential size (in square feet) of each buffer zone measured around all creditable stream reaches, calculated using GIS, including areas outside of the easement. The inner zone (0-15') should be measured from the top of the OHWM or the edge of the average stream width if OHWM is not known. Non-creditable stream reaches within the easement should be removed prior to calculating this area with GIS.

<sup>7</sup>Square feet in each buffer zone, as measured by GIS, excluding non-forested areas, all other credit type (e.g., wetland, nutrient offset, buffer), easement exceptions, open water, areas failing to meet the vegetation performance standard, etc. Additional credit is given to 150 feet in buffer width, so areas within the easement that are more than 150 feet from creditable streams should not be included in this measurement. Non-creditable stream reaches within the easement should be removed prior to calculating this area with GIS.





UT3A

Sta 742.17  
Elev 586.39

Elev 586.38

Elev 586.35

Elev 586.35

Top of Drop Structure  
Elev 586.34

Bottom Drop Structure  
At Grade  
Elev 583.32

Elev 586.35

Elev 586.40

Sta 1101  
Elev 586.51

UT3





585

UT3

Tie to existing  
Elev 580.80

Elev 580.15



---



---

FILED	Jul 22, 2022
AT	11:31:00 AM
BOOK	08531
START PAGE	0085
END PAGE	0088
INSTRUMENT #	26083
EXCISE TAX	\$0.00

Prepared By: J. Patrick Bailey, Jr., Manning, Fulton & Skinner, P.A.  
P.O. Box 20389, Raleigh, NC 27619

After Recording Return to: Department of Administration, State Property Office  
1321 Mail Service Center, Raleigh, NC 27699-1321  
SPO File 90-BN and 90-BO / DMS PROJECT No. 100164

STATE OF NORTH CAROLINA  
COUNTY OF UNION

RELEASE AND REMOVAL  
OF TRAILS FROM  
CONSERVATION EASEMENT

THIS RELEASE AND REMOVAL OF TRAILS FROM CONSERVATION EASEMENT (hereinafter, "Release"), is made as of the date set forth in the notary acknowledgment below, by RESTORATION SYSTEMS, LLC, a North Carolina limited liability company ("Grantor"), and the STATE OF NORTH CAROLINA ("Grantee").

RECITALS:

- A. Grantor conveyed a conservation easement to Grantee in that certain instrument dated the 22nd day of June 2021, recorded in Book 8144, Page 757, Union County Registry (the "Conservation Easement").
- B. A portion of certain real property owned by Grantor is preserved and protected by the Conservation Easement for the purposes as set forth therein.
- C. The property that is subject to preservation and protection under the Conservation Easement consists of a total of approximately 56.839 acres and is more particularly identified and described therein as the "Conservation Easement Area" or "Easement Area."

D. A Plat of Survey prepared by Carolina Surveyors, Inc. and recorded on June 1, 2021, in Plat Cabinet P, Pages 903-904, Union County Registry, depicted two 6' trails in the Easement Area and as shown on EXHIBIT A.

E. Grantor has agreed to release all rights to the 6' trails and thereby quitclaims, releases, and abandons the 6' trails as depicted on EXHIBIT A (the "Release Areas"), attached hereto, and incorporated herein by this reference, from the rights to use, repair, or reconstruct so that Grantee may possess the Release Areas and the Conservation Easement unencumbered by the 6' trails.

F. Based on the foregoing, the North Carolina Department of Environmental Quality, Division of Mitigation Services has accepted the release of rights to these 6' trails and the execution of this instrument for the purposes set forth herein.

G. Authority to accept this Release on behalf of the North Carolina Department of Environmental Quality, Division of Mitigation Services was delegated to the North Carolina Department of Administration by resolution adopted by the Governor and Council of State at a meeting held in the City of Raleigh, North Carolina, on the 13th day of September 2011.

NOW THEREFORE, for and in receipt of Ten Dollars (\$10.00) and other good and valuable consideration, the receipt of which is hereby acknowledged, Grantor does hereby execute this Release and agrees as follows:

1. The recitals stated above are substantive and are incorporated in full by this reference.
2. All capitalized terms appearing in this Release and not otherwise defined shall have the meaning ascribed to such terms in the Conservation Easement.
3. Grantor, for itself and its heirs, successors, and assigns, does hereby irrevocably and completely remise, release, and quitclaim unto Grantee, its successors and assigns, all right, title, claim, and interests to and in the Release Areas.
4. This Release shall apply only to the 6' trails in the Release Areas and the remainder of the Conservation Easement Area shall continue to be subject to all retained rights, and said Conservation Easement shall otherwise remain in full force and effect.

TO HAVE AND TO HOLD, the Release Areas, together with all privileges and appurtenances thereunto belonging, to Grantee, its successors and assigns, free, discharged, and released from the right to use the 6' trails.

[signatures on following page]

IN TESTIMONY WHEREOF, Grantor has hereunto set its hand and seal, the day and year herein notarized.

**GRANTOR:**

**Restoration Systems, LLC,**  
a North Carolina limited liability company

By: George Howard (SEAL)

Name: George Howard (SEAL)

Title: CEO (SEAL)


**NORTH CAROLINA**

**COUNTY OF** Wake

I, John Duncan Hamby, a Notary Public in and for the County and State aforesaid, do hereby certify that George Howard personally appeared before me this day and acknowledged the execution of the foregoing instrument.

IN WITNESS WHEREOF, I have hereunto set my hand and Notary Seal this the 21<sup>st</sup> day of July, 2022.

John Duncan Hamby  
Notary Public

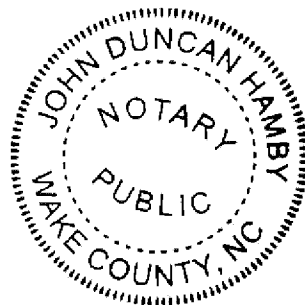

My commission expires:

11-15-26






## Appendix G: Record Drawings & As-built Survey

# NC DEPARTMENT OF ENVIRONMENTAL QUALITY DIVISION OF MITIGATION SERVICES AS-BUILT PLANS WITS END SITE

STATE	STATE PROJECT REFERENCE NO.	SHEET NO.	TOTAL SHEETS
N.C.	WITS END SITE	1	

### INDEX OF SHEETS


SHEET NUMBER	SHEET
AB-01	Title Sheet
AB-02	Symbology
AB-03	Easement
AB-03A THRU AB-03G	As-Built Vegetation Plot, Groundwater Wells
AB-03H	Bridge As-Built
AB-04A THRU AB-04ZX	As-Built Structures
AB-04ZY	As-Built Planting List

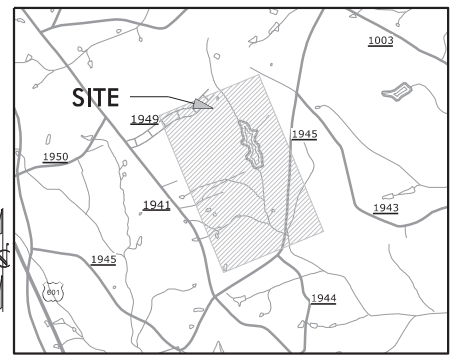

**LOCATION: UNION COUNTY, NORTH CAROLINA**

**TYPE OF WORK: STREAM RESTORATION AND ENHANCEMENT (CLEARING, GRUBBING, GRADING, EROSION CONTROL AND PLANTING)**

NOTE: WAXHAW BRANCH IS LOCATED IN A FEMA LIMITED DETAILED STUDY AREA. PROJECT TO BE CONSTRUCTED ACCORDING TO APPROVED CONSTRUCTION DOCUMENTS. ANY DEVIATIONS FROM THE PLANS WILL REQUIRE APPROVAL FROM THE ENGINEER AND FLOODPLAIN ADMINISTRATOR

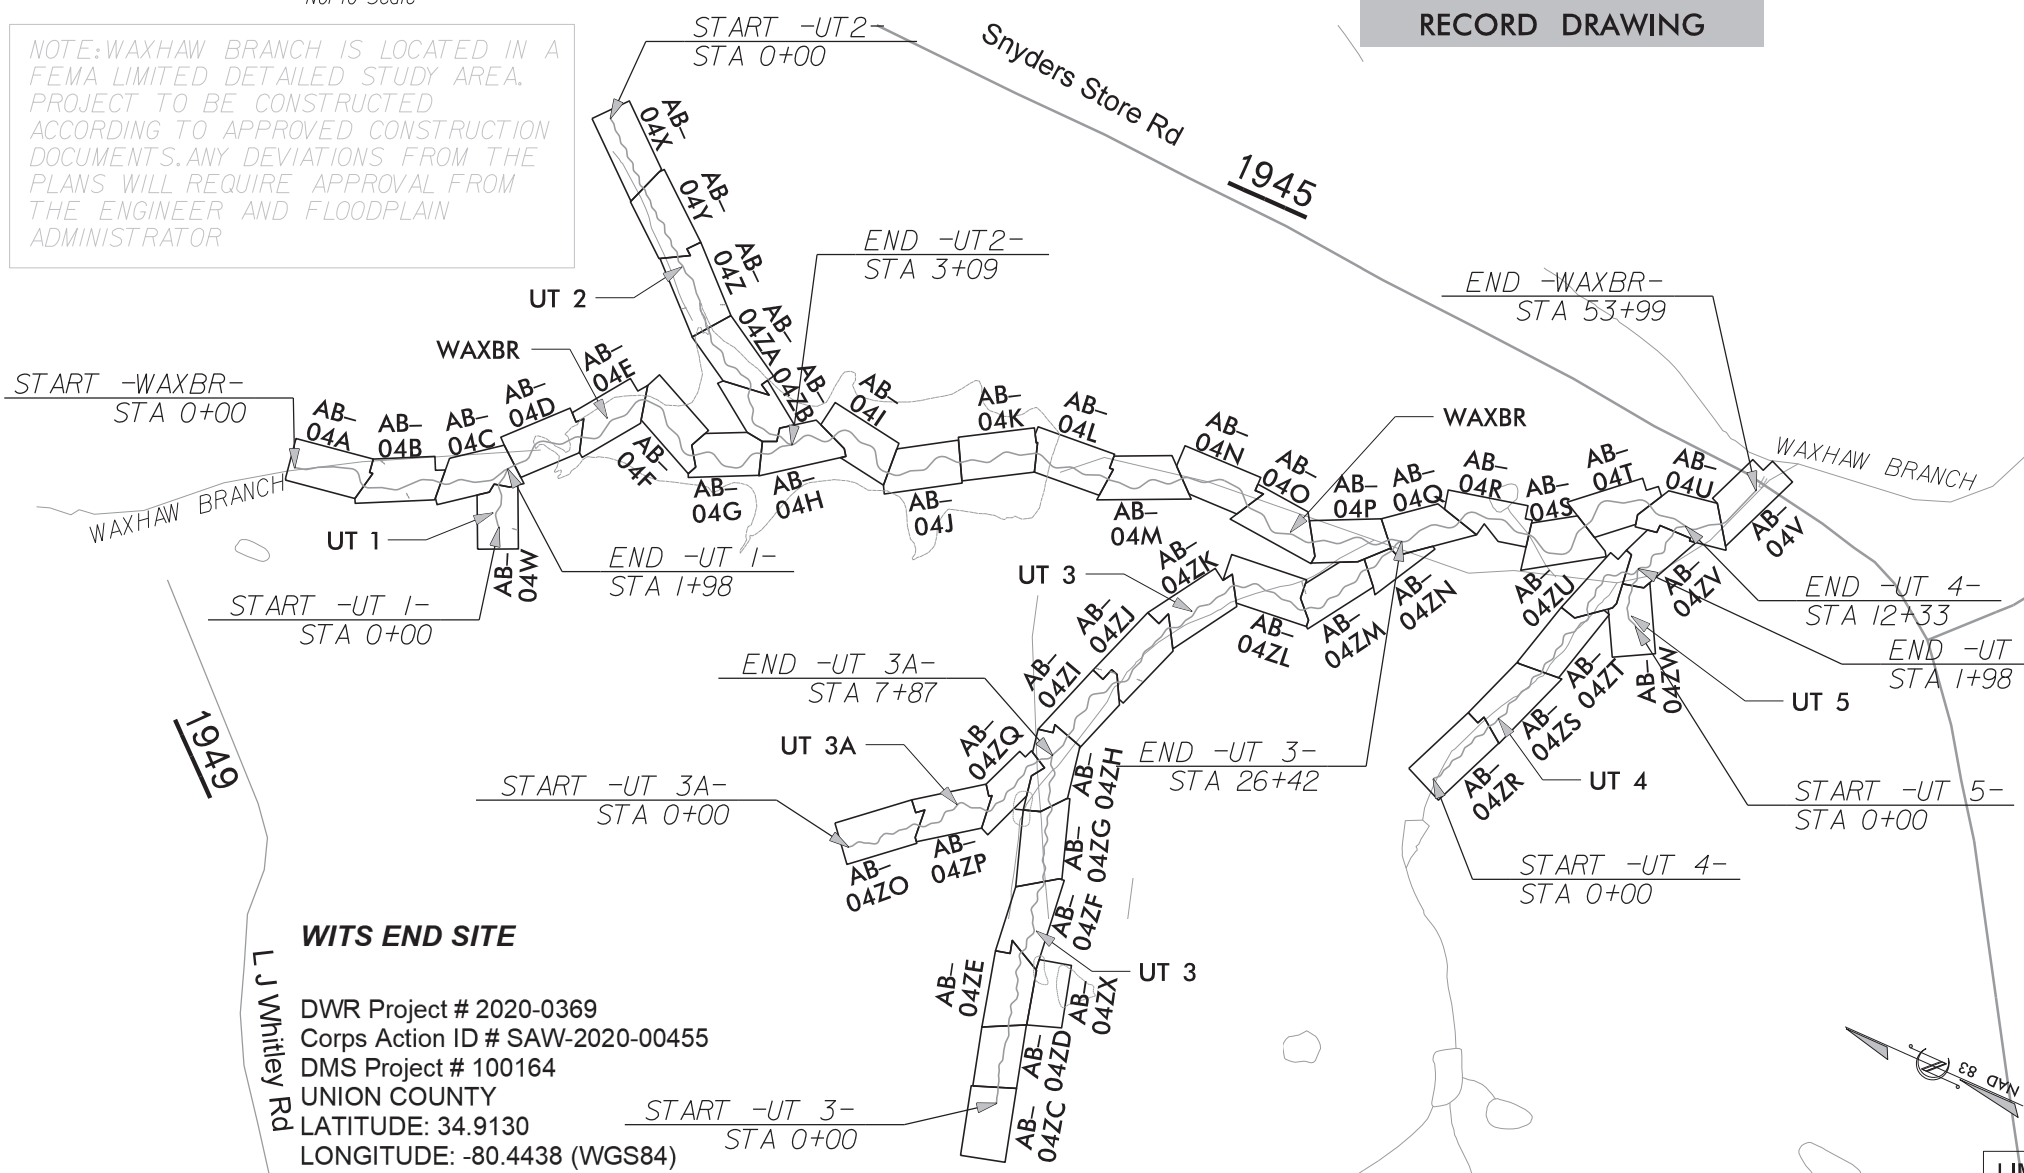


RECORD DRAWING

**SURVEYORS CERTIFICATION(S)**  
 Surveyor's disclaimer: No attempt was made to locate any cemeteries, wetlands, hazardous material sites, underground utilities or any other features above, or below ground other than those shown. However, no visible evidence of cemeteries or utilities, aboveground or otherwise, was observed by the undersigned (other than those shown).

I certify that the survey is of an existing parcel or parcels of land or one or more existing easements and does not create a new street or change an existing street.  
 I JOHN A. RUDOLPH, certify that this plat was prepared under my supervision from an actual field survey made under my supervision, of as-built conditions.


That the boundaries not surveyed are clearly indicated as such and were plotted from information as referenced hereon; That the ratio of precision as calculated was 1:7,500+ and that the global navigational satellite system (GNSS) was used to perform this survey and the following information was used:  
 Class of Survey: CLASS B (HORIZONTAL) CLASS B (VERTICAL)  
 Positional Accuracy: 0.12 feet (HORIZONTAL)  
 Type of GPS field procedure: RTK  
 Dates of survey: May and June 2022  
 Datum/Epoch: NAD 1983(2011)  
 Published/Fixed Control Use: OPUS  
 Geoid Model: 2012B CONUS  
 Combined Grid Factor: 0.99995565 GROUND TO GRID  
 Units: US SURVEY FEET

That this plat meets the requirements of the standards of practice for land surveying in North Carolina. Witness my hand and seal this 29th day of July, 2022.

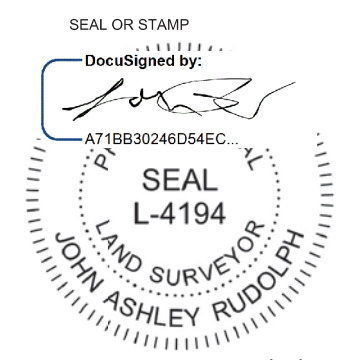

**CONTRACT: WITS END SITE**

**WITS END SITE**  
 DWR Project # 2020-0369  
 Corps Action ID # SAW-2020-00455  
 DMS Project # 100164  
 UNION COUNTY  
 LATITUDE: 34.9130  
 LONGITUDE: -80.4438 (WGS84)

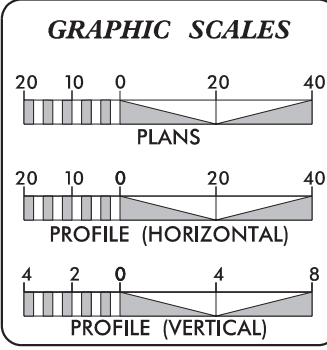

PROPOSED LENGTH OF -WAXBR- = 5403	PROPOSED LENGTH OF -UT 3A- = 780		
PROPOSED LENGTH OF -UT 1- = 189	PROPOSED LENGTH OF -UT 4- = 1223		
PROPOSED LENGTH OF -UT 2- = 1240	PROPOSED LENGTH OF -UT 5- = 192		
PROPOSED LENGTH OF -UT 3- = 2629			
<b>TOTAL STREAM LENGTHS (LF) = 11656</b>			
RESTORATION LEVEL	STREAM (linear footage)	RIPARIAN WETLAND (acreage)	NONRIPARIAN WETLAND (acreage)
RESTORATION	10,289	22.833 (Reestablishment)	0.000
ENHANCEMENT I	232	1.442 (Rehabilitation)	0.000
ENHANCEMENT II	976	0.000	0.000
PRESERVATION	0	4.916	0.000
CREATION	0	0.351	0.000
<b>TOTALS</b>	<b>11,497</b>	<b>29.602</b>	<b>0.000</b>
MITIGATION UNITS	11,525.946 SMUs	24.163 RIPARIAN WMUs	NONRIPARIAN WMUs

**Axiom Environmental, Inc.**  
 218 Snow Ave  
 Raleigh, NC 27603  
**GRANT LEWIS**  
 PROJECT DESIGNER

**Restoration Systems, LLC**  
 1101 Haynes St.  
 Suite 211  
 Raleigh, NC 27604  
**WORTH CREECH**  
 SITE CONSTRUCTION MANAGER

Prepared in the Office of:  
**SUNGATE DESIGN GROUP, P.A.**  
 905 JONES FRANKLIN ROAD  
 RALEIGH, NORTH CAROLINA 27606  
 TEL (919) 859-2243  
 ENG FIRM LICENSE NO. C-890  
**JOSHUA G. DALTON, P.E.**  
 PROJECT ENGINEER

DocuSigned by:  
**Josh Dalton**  
 1089AD8C14994C3...  
 26971  
**JOSHUA G. DALTON**  
 ENGINEER  
 10/7/2022  
 DATE:

10/6/2022 Wits\_End\_psh\_AB-01.dgn jnarvey



# CONVENTIONAL PLAN SHEET SYMBOLS

Note: Not to Scale

\*S.U.E. = Subsurface Utility Engineering

RECORD DRAWING

## BOUNDARIES AND PROPERTY:

State Line	-----
County Line	-----
Township Line	-----
City Line	-----
Reservation Line	-----
Property Line	-----
Existing Iron Pin	EP
Computed Property Corner	-----
Property Monument	EDM
Parcel/Sequence Number	(23)
Existing Fence Line	-x-x-x-
Proposed Fence Gate	□
Proposed Barbed Wire Fence	◇
Existing Wetland Boundary	-WLB-
Proposed Wetland Boundary	-WLB-
Existing Endangered Animal Boundary	-EAB-
Existing Endangered Plant Boundary	-EPB-
Existing Historic Property Boundary	-HPB-

## BUILDINGS AND OTHER CULTURE:

Gas Pump Vent or U/G Tank Cap	○
Sign	○
Well	W
Small Mine	⊗
Foundation	□
Area Outline	□
Cemetery	⊕
Building	□
School	□
Church	⊕
Dam	□

## HYDROLOGY:

Stream or Body of Water	-----
Hydro, Pool or Reservoir	□
Jurisdictional Stream	-JS-
Buffer Zone 1	-BZ 1-
Buffer Zone 2	-BZ 2-
Flow Arrow	←
Disappearing Stream	-----
Spring	○
Wetland	W
Proposed Lateral, Tail, Head Ditch	-----

## RIGHT OF WAY & PROJECT CONTROL:

Secondary Horiz and Vert Control Point	◆
Primary Horiz Control Point	○
Primary Horiz and Vert Control Point	●

Exist Permanent Easement Pin and Cap	◇
New Permanent Easement Pin and Cap	◆
Vertical Benchmark	⊕
Existing Right of Way Marker	△
Existing Right of Way Line	-----
New Right of Way Line	-----
New Right of Way Line with Pin and Cap	◇
New Right of Way Line with Concrete or Granite RW Marker	△
New Control of Access Line with Concrete CA Marker	△
Existing Control of Access	△
New Control of Access	△
Existing Easement Line	-----
New Conservation Easement	-----
New Temporary Drainage Easement	-----
New Permanent Drainage Easement	-----
New Permanent Drainage / Utility Easement	-----
New Permanent Utility Easement	-----
New Temporary Utility Easement	-----
New Aerial Utility Easement	-----

## ROADS AND RELATED FEATURES:

Existing Edge of Pavement	-----
Existing Curb	-----
Proposed Slope Stakes Cut	-C-
Proposed Slope Stakes Fill	-F-
Proposed Curb Ramp	CR
Existing Metal Guardrail	-----
Proposed Guardrail	-----
Existing Cable Guiderail	-----
Proposed Cable Guiderail	-----
Equality Symbol	⊕
Pavement Removal	⊗

## VEGETATION:

Single Tree	⊕
Single Shrub	⊕
Hedge	-----
Woods Line	-----
Orchard	⊕
Vineyard	Vineyard

## EXISTING STRUCTURES:

MAJOR:	
Bridge, Tunnel or Box Culvert	CONC
Bridge Wing Wall, Head Wall and End Wall	CONC WW
MINOR:	
Head and End Wall	CONC HW

Pipe Culvert	-----
Footbridge	-----
Drainage Box: Catch Basin, DI or JB	CB
Paved Ditch Gutter	-----
Storm Sewer Manhole	⊕
Storm Sewer	S

## UTILITIES:

POWER:	
Existing Power Pole	●
Proposed Power Pole	○
Existing Joint Use Pole	●
Proposed Joint Use Pole	○
Power Manhole	⊕
Power Line Tower	⊗
Power Transformer	⊗
U/G Power Cable Hand Hole	-----
H-Frame Pole	●
U/G Power Line LOS B (S.U.E.*)	-----
U/G Power Line LOS C (S.U.E.*)	-----
U/G Power Line LOS D (S.U.E.*)	-----

## TELEPHONE:

Existing Telephone Pole	●
-------------------------	---

## WATER:

Water Manhole	⊕
Water Meter	○
Water Valve	⊗
Water Hydrant	⊕
U/G Water Line LOS B (S.U.E.*)	-----
U/G Water Line LOS C (S.U.E.*)	-----
U/G Water Line LOS D (S.U.E.*)	-----
Above Ground Water Line	A/G Water

## GAS:

Gas Valve	◇
Gas Meter	◇
U/G Gas Line LOS B (S.U.E.*)	-----
U/G Gas Line LOS C (S.U.E.*)	-----
U/G Gas Line LOS D (S.U.E.*)	-----
Above Ground Gas Line	A/G Gas

## SANITARY SEWER:

Sanitary Sewer Manhole	⊕
Sanitary Sewer Cleanout	⊕
U/G Sanitary Sewer Line	SS
Above Ground Sanitary Sewer	A/G Sanitary Sewer
SS Forced Main Line LOS B (S.U.E.*)	-----
SS Forced Main Line LOS C (S.U.E.*)	-----

SS Forced Main Line LOS D (S.U.E.*)	-----
-------------------------------------	-------

## MISCELLANEOUS:

Utility Pole	●
Utility Pole with Base	□
Utility Located Object	○
Utility Traffic Signal Box	⊕
Utility Unknown U/G Line LOS B (S.U.E.*)	-----
U/G Tank; Water, Gas, Oil	□
Underground Storage Tank, Approx. Loc.	UST
A/G Tank; Water, Gas, Oil	□
Geoenvironmental Boring	⊕
U/G Test Hole LOS A (S.U.E.*)	⊕
Abandoned According to Utility Records	AATUR
End of Information	E.O.I.
Existing Contour Major	-----
Existing Contour Minor	-----
Contour Interval = 1 ft	

Riffle Rip Rap	⊗
----------------	---

Log Vane	-----
----------	-------

Log Cross Vane	-----
----------------	-------

Step Pool Structure	-----
---------------------	-------

Stream Plug	⊗
-------------	---

Floodplain Interceptor	-----
------------------------	-------

Proposed Fence	-----
----------------	-------

Limits of Disturbance	LOD
-----------------------	-----

## AS-BUILT:

Stream Centerline	-----
-------------------	-------

Stream Top of Bank	-----
--------------------	-------

Stream Gauge	○
--------------	---

Groundwater Gauge	#
-------------------	---

Benthic & Water Quality Station	1
---------------------------------	---

Origin Point on CVS Plots	⊕
---------------------------	---


CVS Plots	#
-----------	---

Cross Section	XS-10R
---------------	--------

Adjusted Stream Structure	-----
---------------------------	-------

Not Constructed	-----
-----------------	-------

SURVEY INFORMATION PROPERTY/  
EASEMENT PROVIDED BY:  
CAROLINA SURVEYORS, INC.  
P.O. BOX 267  
PINEVILLE, NC 28134

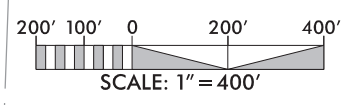

HORIZONTAL DATUM: NAD 83 (2011)  
VERTICAL DATUM: NAVD 1988

Snyders Store Rd

1945

WAXBR

WAXBR

WAXHAW BRANCH

WAXHAW BRANCH

L J Whitley Rd

1949

UT 2

UT 1

UT 3A

UT 3


UT 4

UT 5

— CE — CONSERVATION EASEMENT

RECORD DRAWING

**SUNGATE DESIGN GROUP, P.A.**  
 850 GILES FARM ROAD  
 SUITE 200  
 PINEVILLE, NC 28134  
 TEL: (719) 855-2243  
 ENG FIRM LICENSE NO. C-980

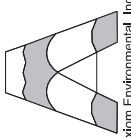Axiom Environmental, Inc.

THIS DRAWING AND ALL REPRODUCTIONS OF IT ARE THE SOLE PROPERTY OF SDG. REPRODUCTION OR OTHER USES OF THIS DRAWING WITHOUT WRITTEN CONSENT OF SDG IS NOT PERMITTED.

**WITS END**  
UNION COUNTY, NC  
**AS-BUILT EASEMENT**

PROJECT # : 1221-20024  
 DRAWING NAME: WITS END PSH AB-03  
 DATE: 2022  
 DRAWN BY: JRH  
 REVIEWED BY: JGD  
 REVISIONS:

SHEET NO.  
**AB-03**

10/6/2022  
Wits\_End\_Psh\_AB-03.dgn  
10:48:58 AM



RECORD DRAWING



DocuSigned by:  
*Josh Dalton*  
 1089AD8C14994C3...  
 PROFESSIONAL SEAL  
 26971  
 ENGINEER  
 JOSHUA G. DALTON

10/7/2022


DATE:  
DOCUMENT NOT CONSIDERED FINAL  
UNLESS ALL SIGNATURES COMPLETED

SUNGATE DESIGN GROUP, P.A.  
 850 GILES FARM ROAD  
 BAYLOR UNIVERSITY CAMPUS  
 TEL: (919) 855-2243  
 ENG FIRM LICENSE NO. C-980

Axiom Environmental, Inc.

PROJECT # :  
 1221-20024  
 DRAWING NAME:  
 WITS END PSH AB-03A  
 DATE:  
 2022  
 DRAWN BY:  
 JRH  
 REVIEWED BY:  
 JGD  
 REVISIONS:


SHEET NO.  
**AB-03A**

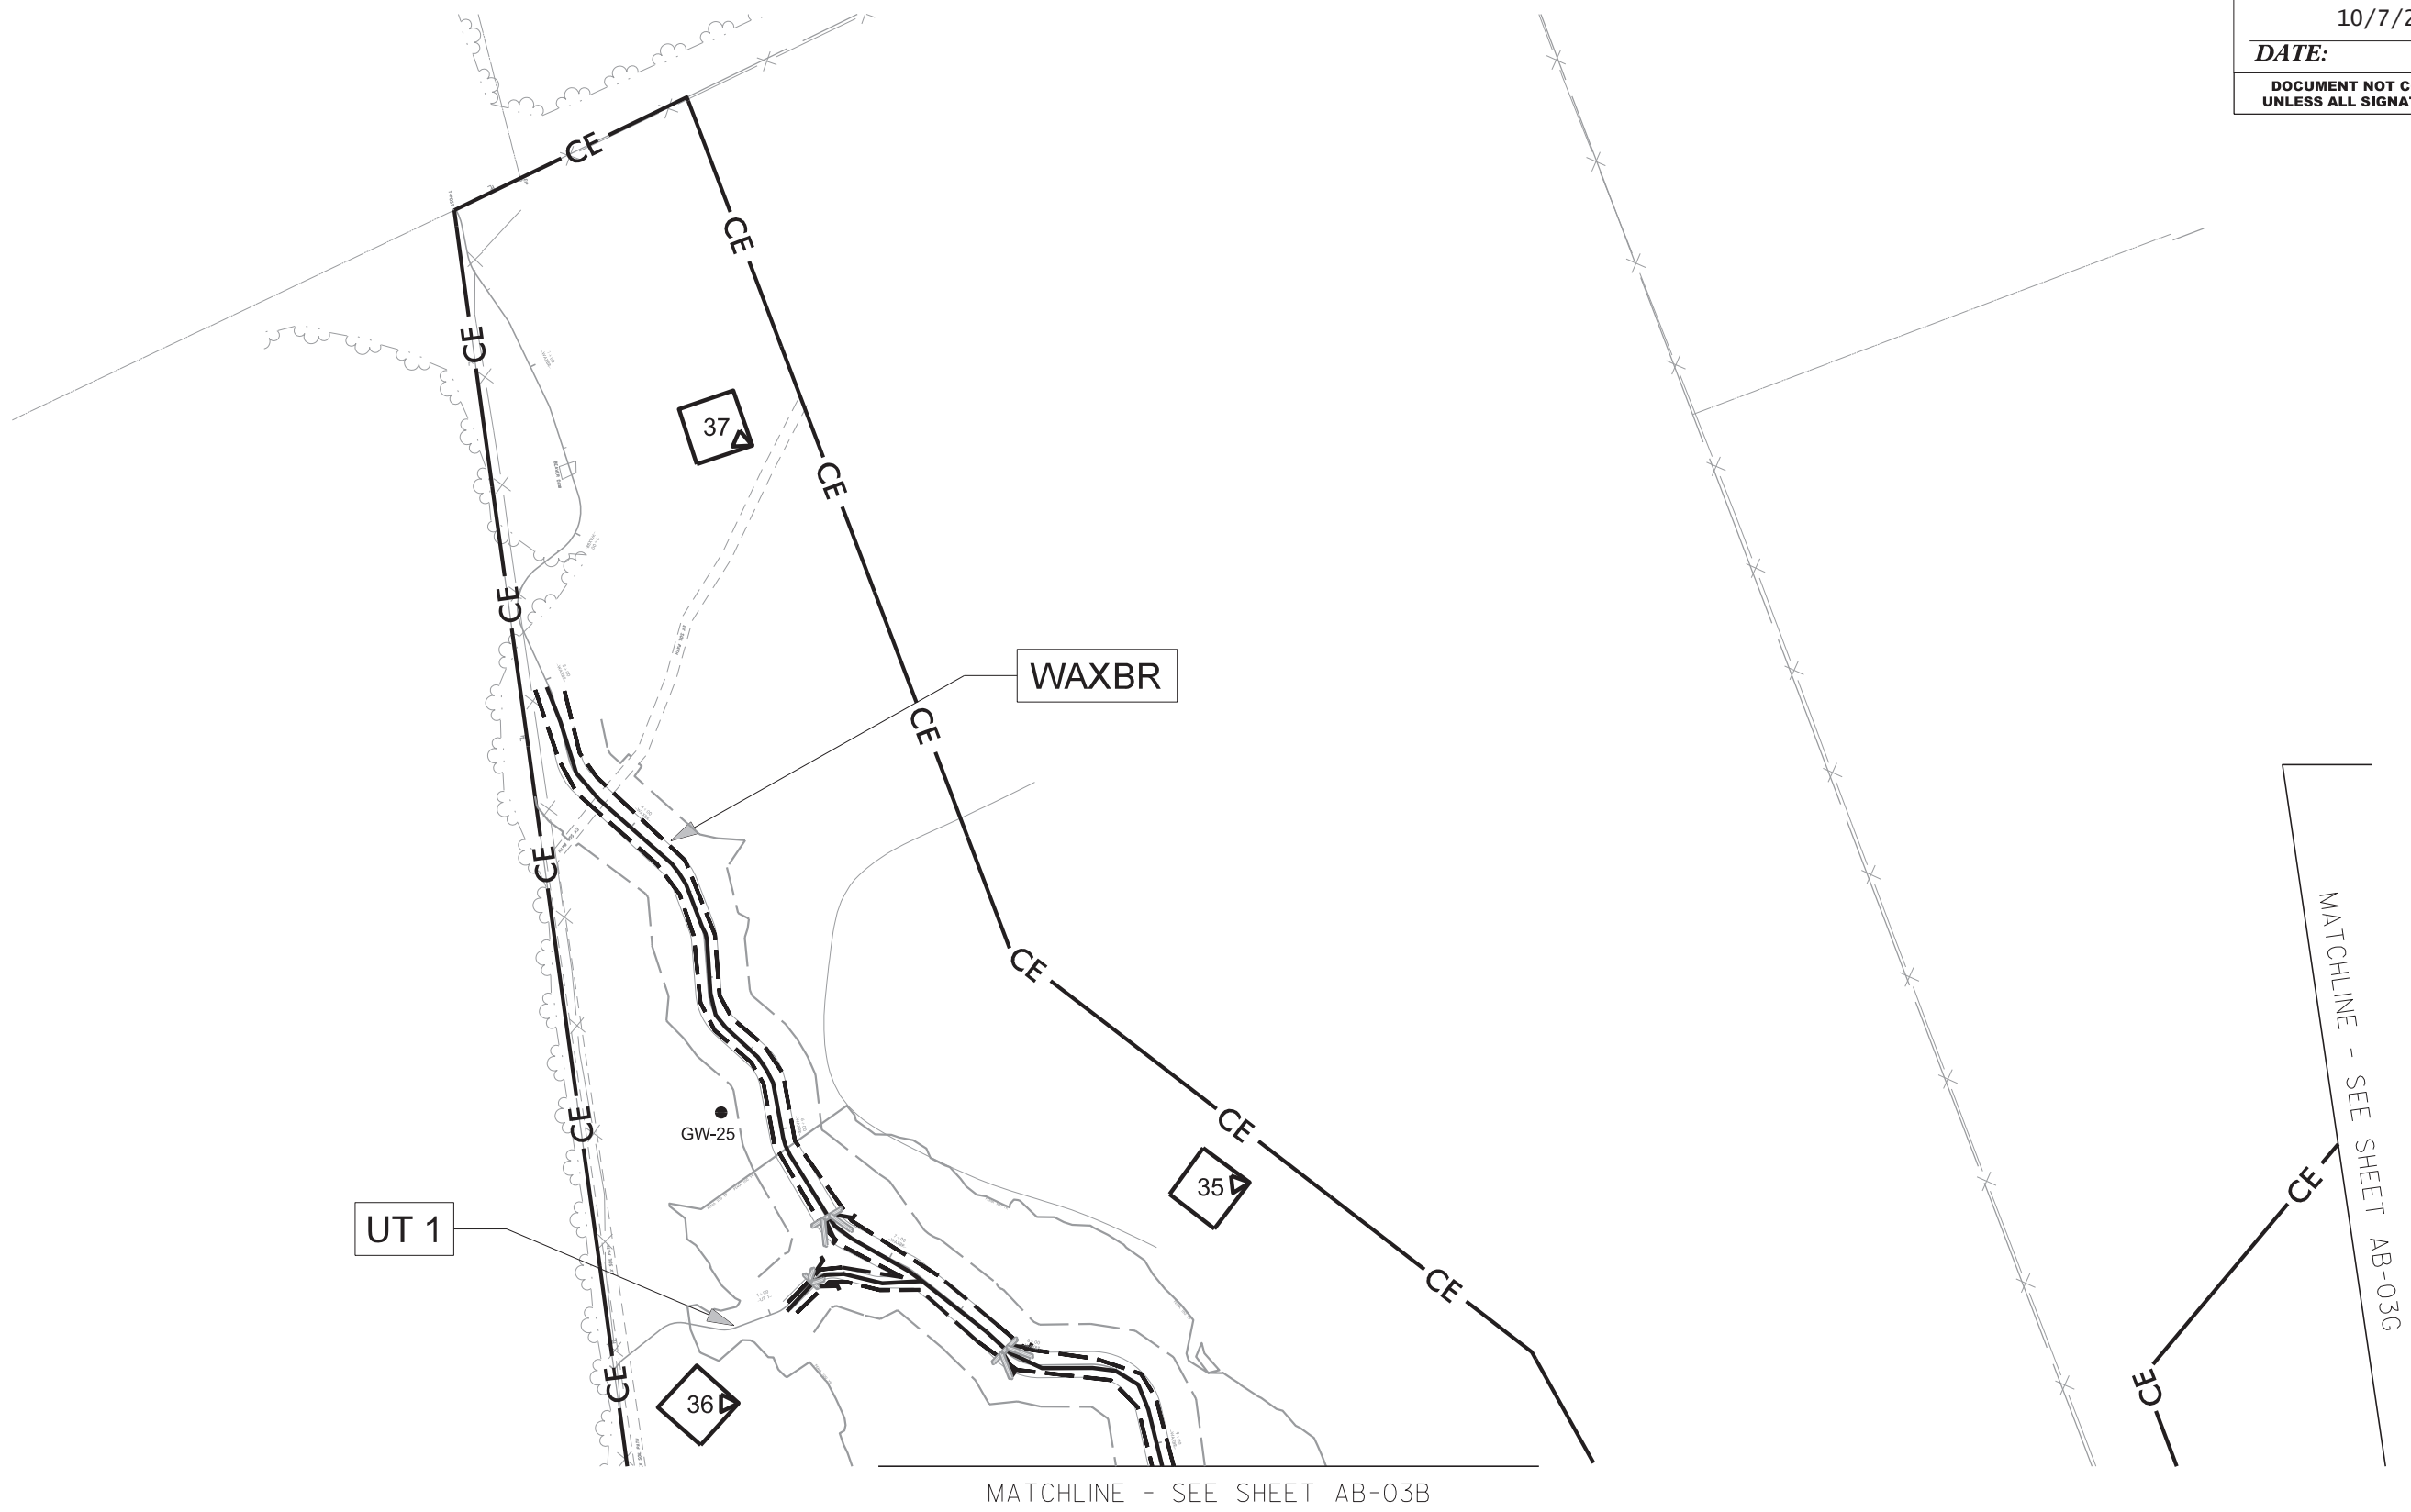


10/6/2022  
Wits\_End\_Psh\_AB-03A.dgn  
jrh

© 2022 SUNGATE DESIGN GROUP, P.A. THIS DRAWING AND ALL REPRODUCTIONS OF IT ARE THE SOLE PROPERTY OF SDG. REPRODUCTION OR OTHER USES OF THIS DRAWING WITHOUT WRITTEN CONSENT OF SDG IS NOT PERMITTED.



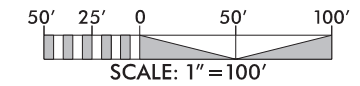


**RECORD DRAWING**

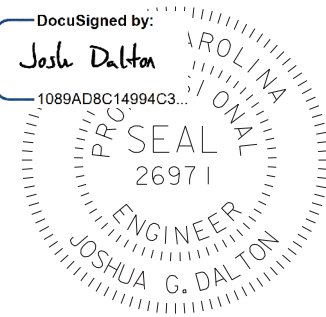

DocuSigned by:  
*Josh Dalton*  
1089AD8C14994C3...  
**DATE:**  
10/7/2022  
**DOCUMENT NOT CONSIDERED FINAL  
UNLESS ALL SIGNATURES COMPLETED**

**SUNGATE DESIGN GROUP, P.A.**  
850 GILES FARM ROAD  
RALEIGH, NC 27604  
TEL: (919) 855-2243  
ENG FIRM LICENSE NO. C-980

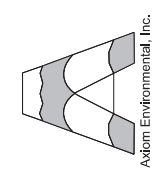

**WITS END**  
UNION COUNTY, NC  
**AS-BUILT VEGETATION PLOTS, GROUNDWATER WELLS**


PROJECT # :  
1221-20024  
DRAWING NAME:  
WITS END PSH AB03B  
DATE:  
2022  
DRAWN BY:  
JRH  
REVIEWED BY:  
JGD  
REVISIONS:

SHEET NO.  
**AB-03B**


MATCHLINE - SEE SHEET AB-03A

MATCHLINE - SEE SHEET AB-03C

MATCHLINE - SEE SHEET AB-03C

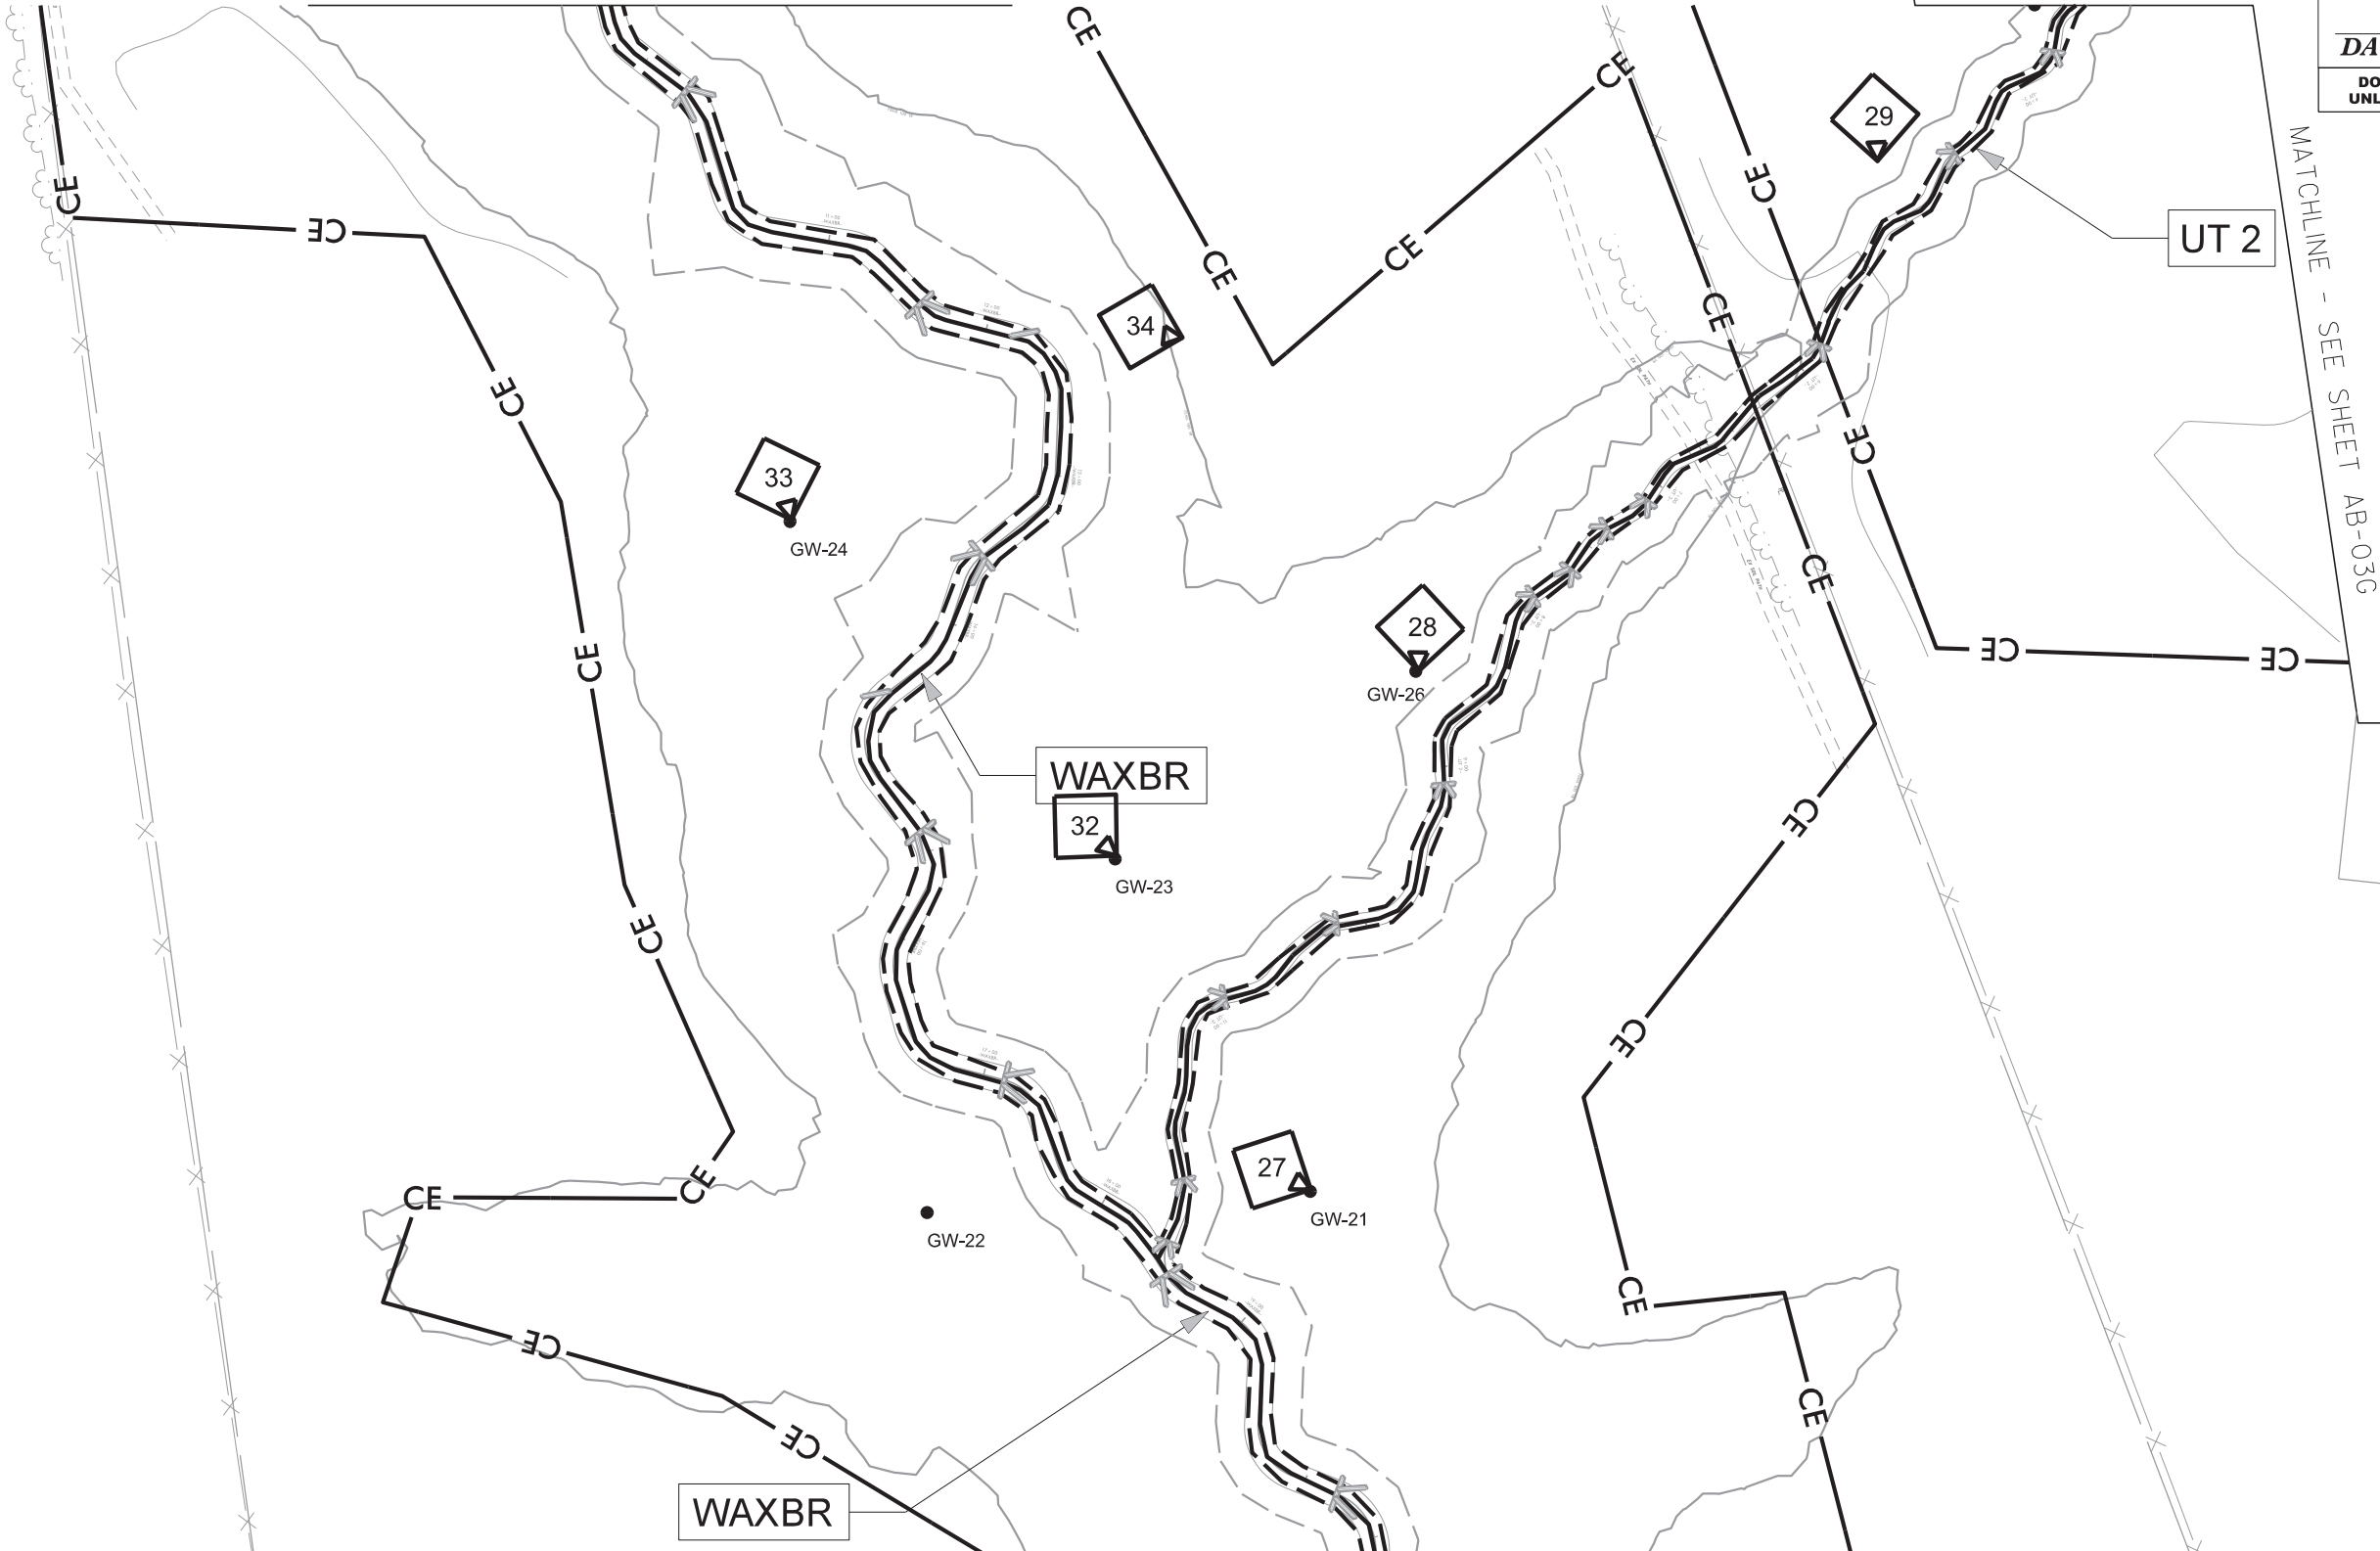

10/6/2022  
Wits\_End\_Psh\_AB-03B.dgn  
10:48:48 AM

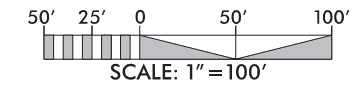


**RECORD DRAWING**



DocuSigned by:  
*Josh Dalton*  
 1089AD8C14994C3...  
 PROFESSIONAL SEAL  
 26971  
 ENGINEER  
 JOSHUA G. DALTON  
 DATE: 10/7/2022

**DOCUMENT NOT CONSIDERED FINAL  
UNLESS ALL SIGNATURES COMPLETED**


**SUNGATE DESIGN GROUP, P.A.**  
 850 GILES FARM ROAD  
 SUITE 200  
 TEL: (919) 855-2243  
 ENG FIRM LICENSE NO. C-980

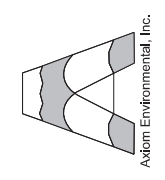

MATCHLINE - SEE SHEET AB-03B

MATCHLINE - SEE SHEET AB-03G

MATCHLINE - SEE SHEET AB-03D

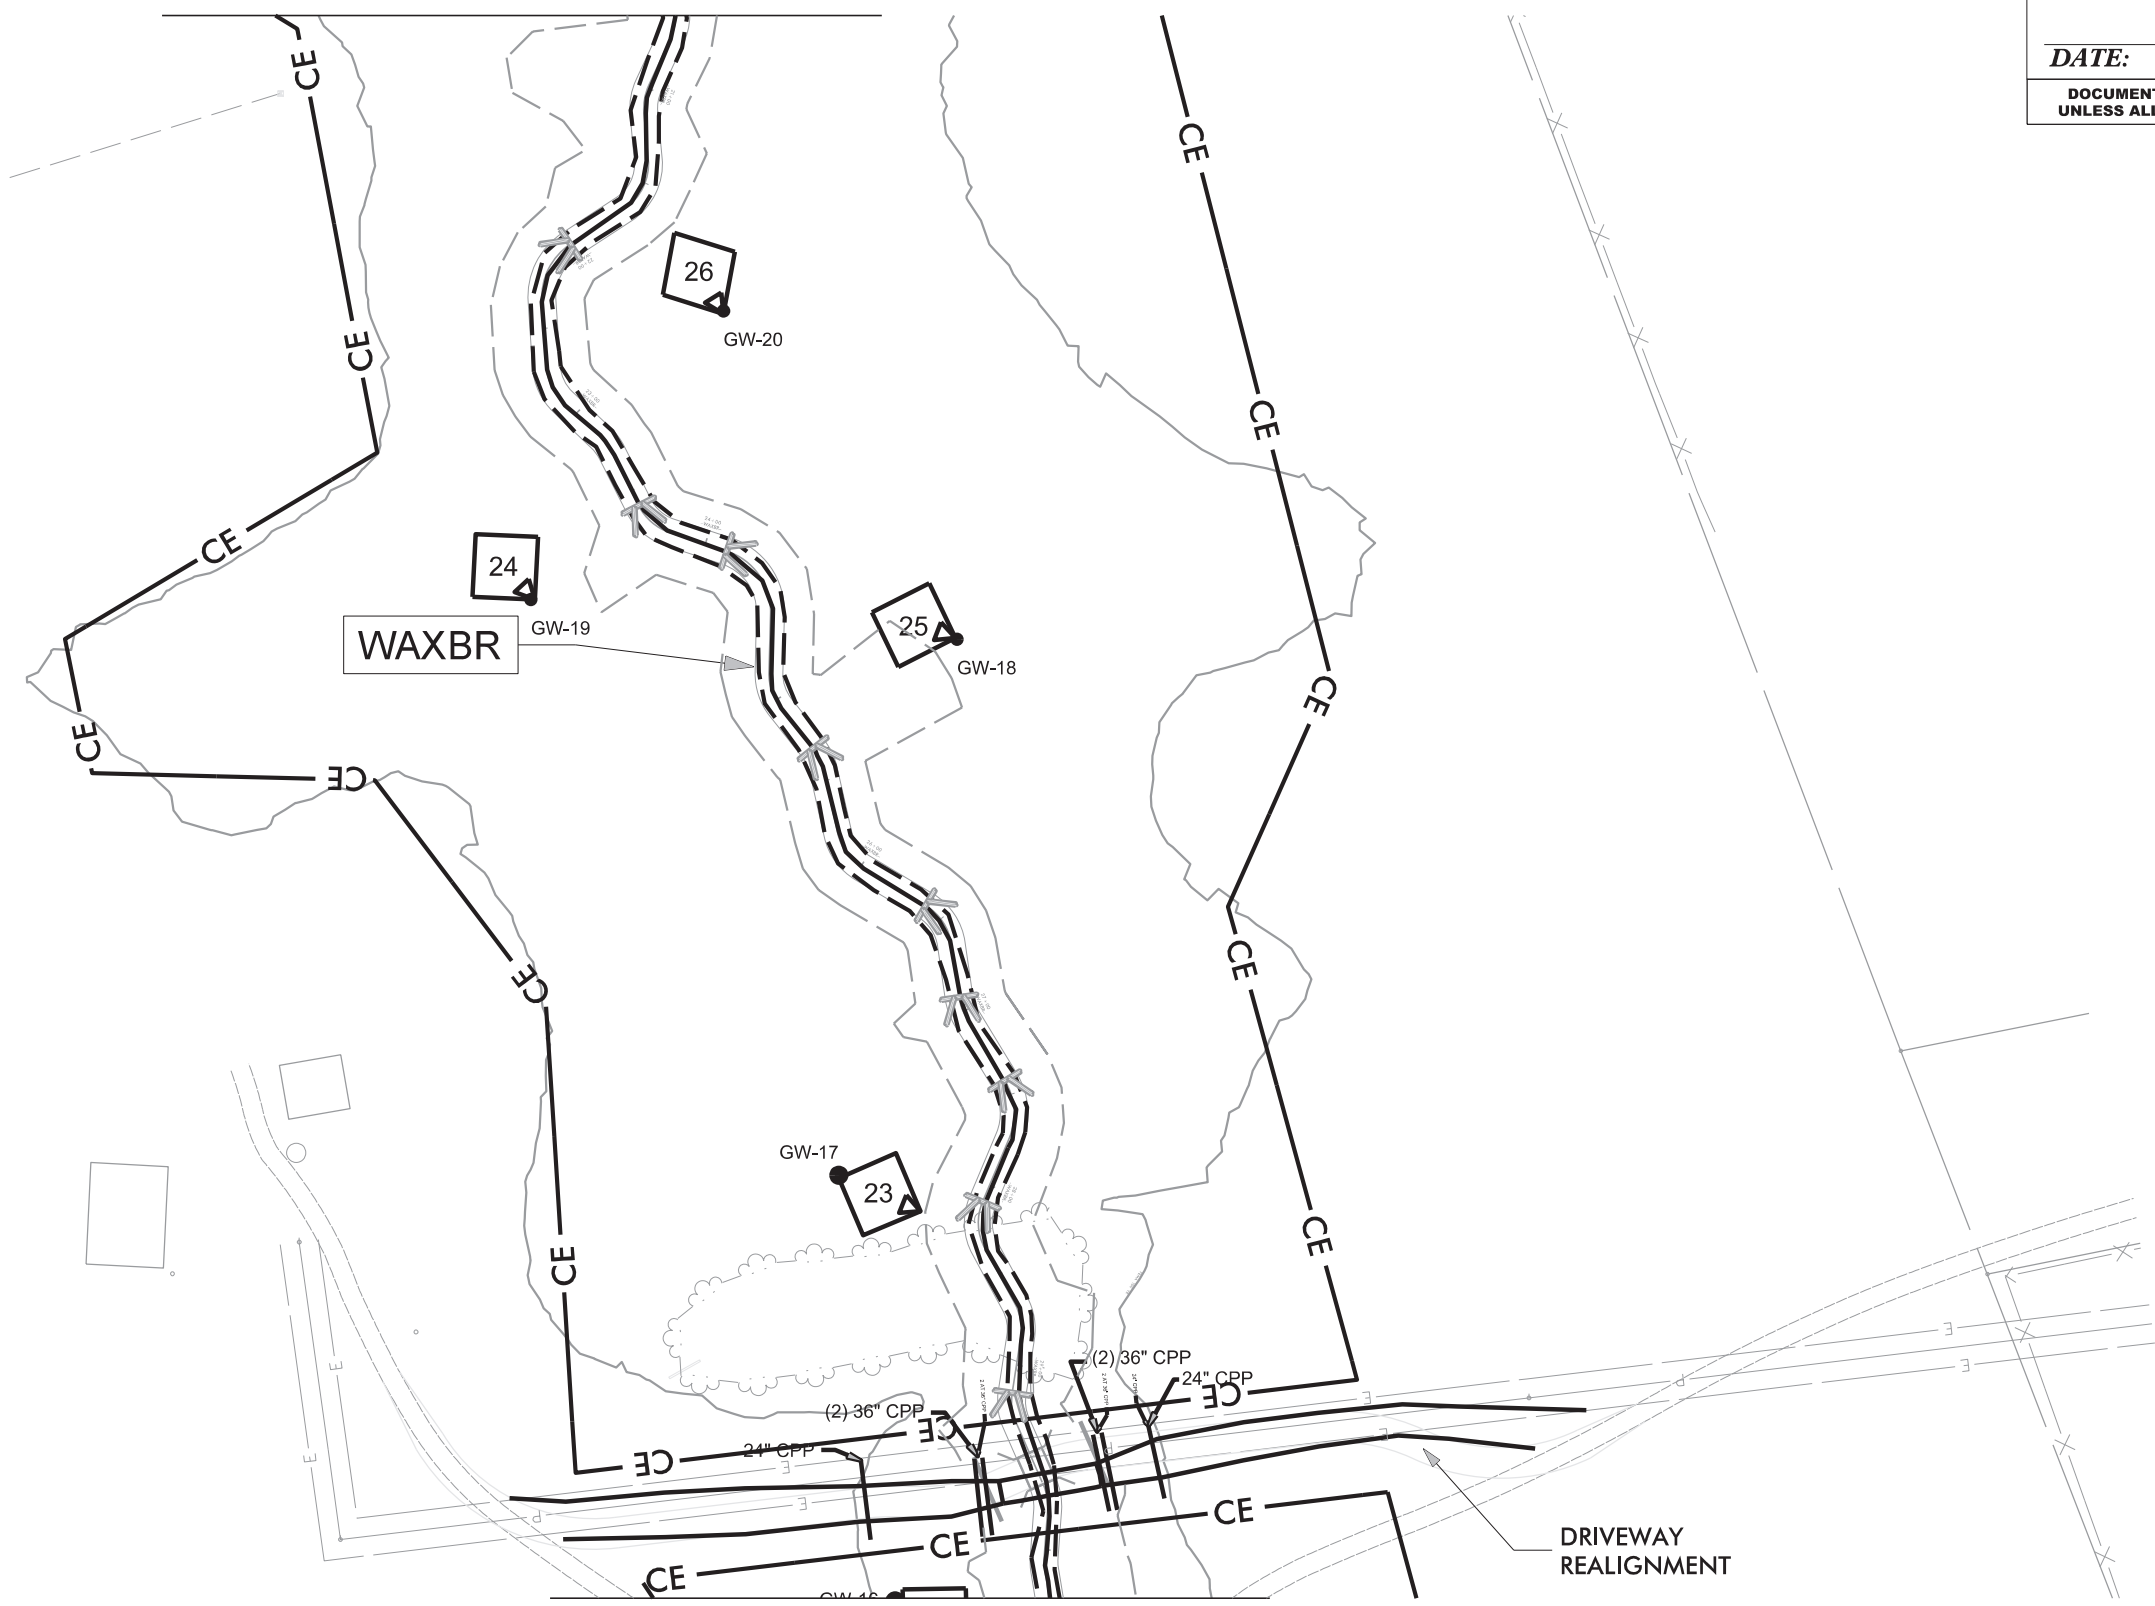

DRIVEWAY REALIGNMENT


© 2022 SUNGATE DESIGN GROUP, P.A. THIS DRAWING AND ALL REPRODUCTIONS OF IT ARE THE SOLE PROPERTY OF SDG. REPRODUCTION OR OTHER USES OF THIS DRAWING WITHOUT WRITTEN CONSENT OF SDG IS NOT PERMITTED.

**WITS END**  
 UNION COUNTY, NC  
**AS-BUILT VEGETATION PLOTS, GROUNDWATER WELLS**

PROJECT # : 1221-20024  
 DRAWING NAME: WITS END PSH AB03C  
 DATE: 2022  
 DRAWN BY: JRH  
 REVIEWED BY: JGD  
 REVISIONS:

SHEET NO. **AB-03C**

10/6/2022  
Wits\_End\_Psh\_AB-03C.dgn  
jrh

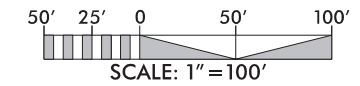

**RECORD DRAWING**





DocuSigned by:  
*Josh Dalton*  
 1089AD8C14994C3...  
 PROFESSIONAL SEAL  
 26971  
 ENGINEER  
 JOSHUA G. DALTON

DATE: 10/7/2022

**DOCUMENT NOT CONSIDERED FINAL  
 UNLESS ALL SIGNATURES COMPLETED**

**SUNGATE DESIGN GROUP, P.A.**  
 850 GILES FARM LANE ROAD  
 BALCONGE, NORTH CAROLINA 27806  
 TEL: (919) 855-2243  
 ENG FIRM LICENSE NO. C-980

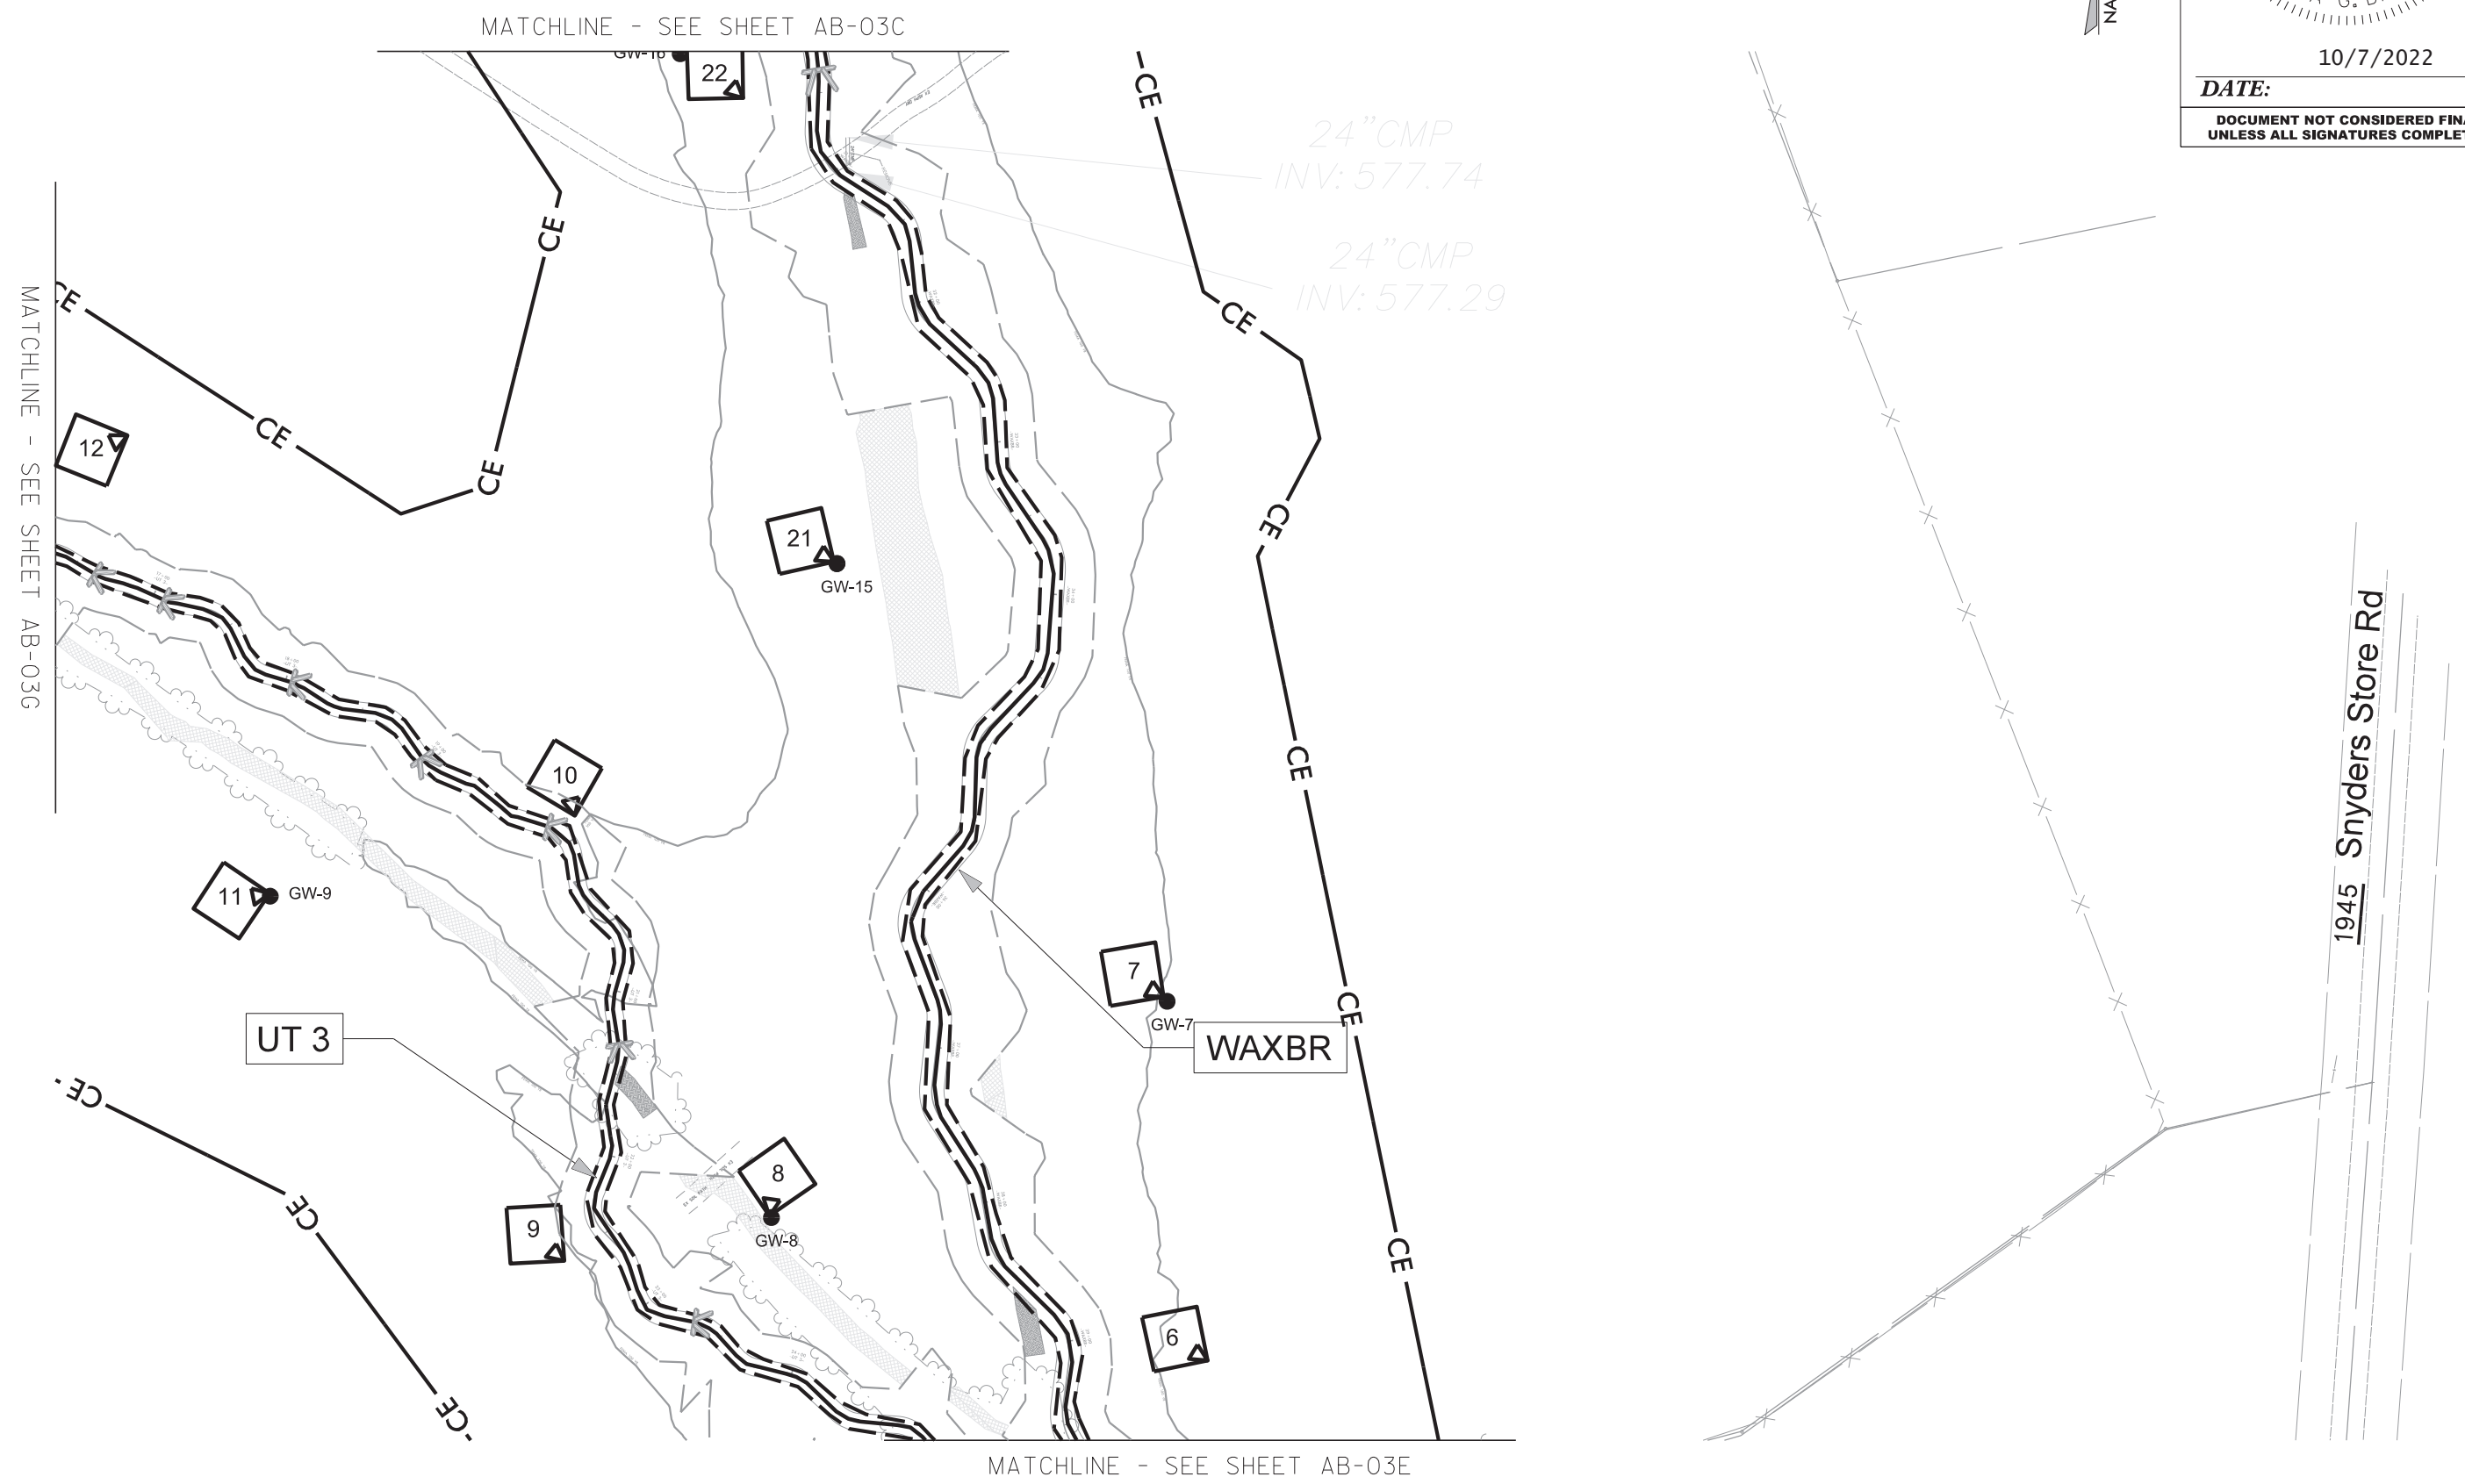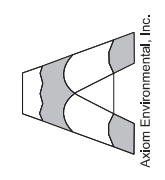

10/6/2022  
Wits\_End\_Psh\_AB-03D.dgn  
jgd

© 2022 SUNGATE DESIGN GROUP, P.A. THIS DRAWING AND ALL REPRODUCTIONS OF IT ARE THE SOLE PROPERTY OF SDG. REPRODUCTION OR OTHER USES OF THIS DRAWING WITHOUT WRITTEN CONSENT OF SDG IS NOT PERMITTED.


**WITS END**  
 UNION COUNTY, NC

**AS-BUILT VEGETATION PLOTS, GROUNDWATER WELLS**

PROJECT # : 1221-20024  
 DRAWING NAME: WITS END PSH AB03D  
 DATE: 2022  
 DRAWN BY: JRH  
 REVIEWED BY: JGD  
 REVISIONS:

SHEET NO. **AB-03D**



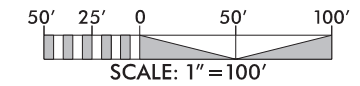

**RECORD DRAWING**



DocuSigned by:  
**Josh Dalton**  
 1089AD8C14994C3...  
 PROFESSIONAL SEAL  
 26971  
 ENGINEER  
 JOSHUA G. DALTON

DATE: 10/7/2022

**DOCUMENT NOT CONSIDERED FINAL  
UNLESS ALL SIGNATURES COMPLETED**

**SUNGATE DESIGN GROUP, P.A.**  
 850 GILES FARM ROAD  
 WAXHAM, NC 27886  
 TEL: (919) 855-2243  
 ENG. FIRM LICENSE NO. C-980

Axiom Environmental, Inc.


**WITS END**  
 UNION COUNTY, NC

**AS-BUILT VEGETATION PLOTS, GROUNDWATER WELLS**


PROJECT # :	1221-20024
DRAWING NAME:	WITS END PSH AB03E
DATE:	2022
DRAWN BY:	JRH
REVIEWED BY:	JGD
REVISIONS:	

SHEET NO. **AB-03E**


10/6/2022  
Wits\_End\_Psh\_AB-03E.dgn  
jrh

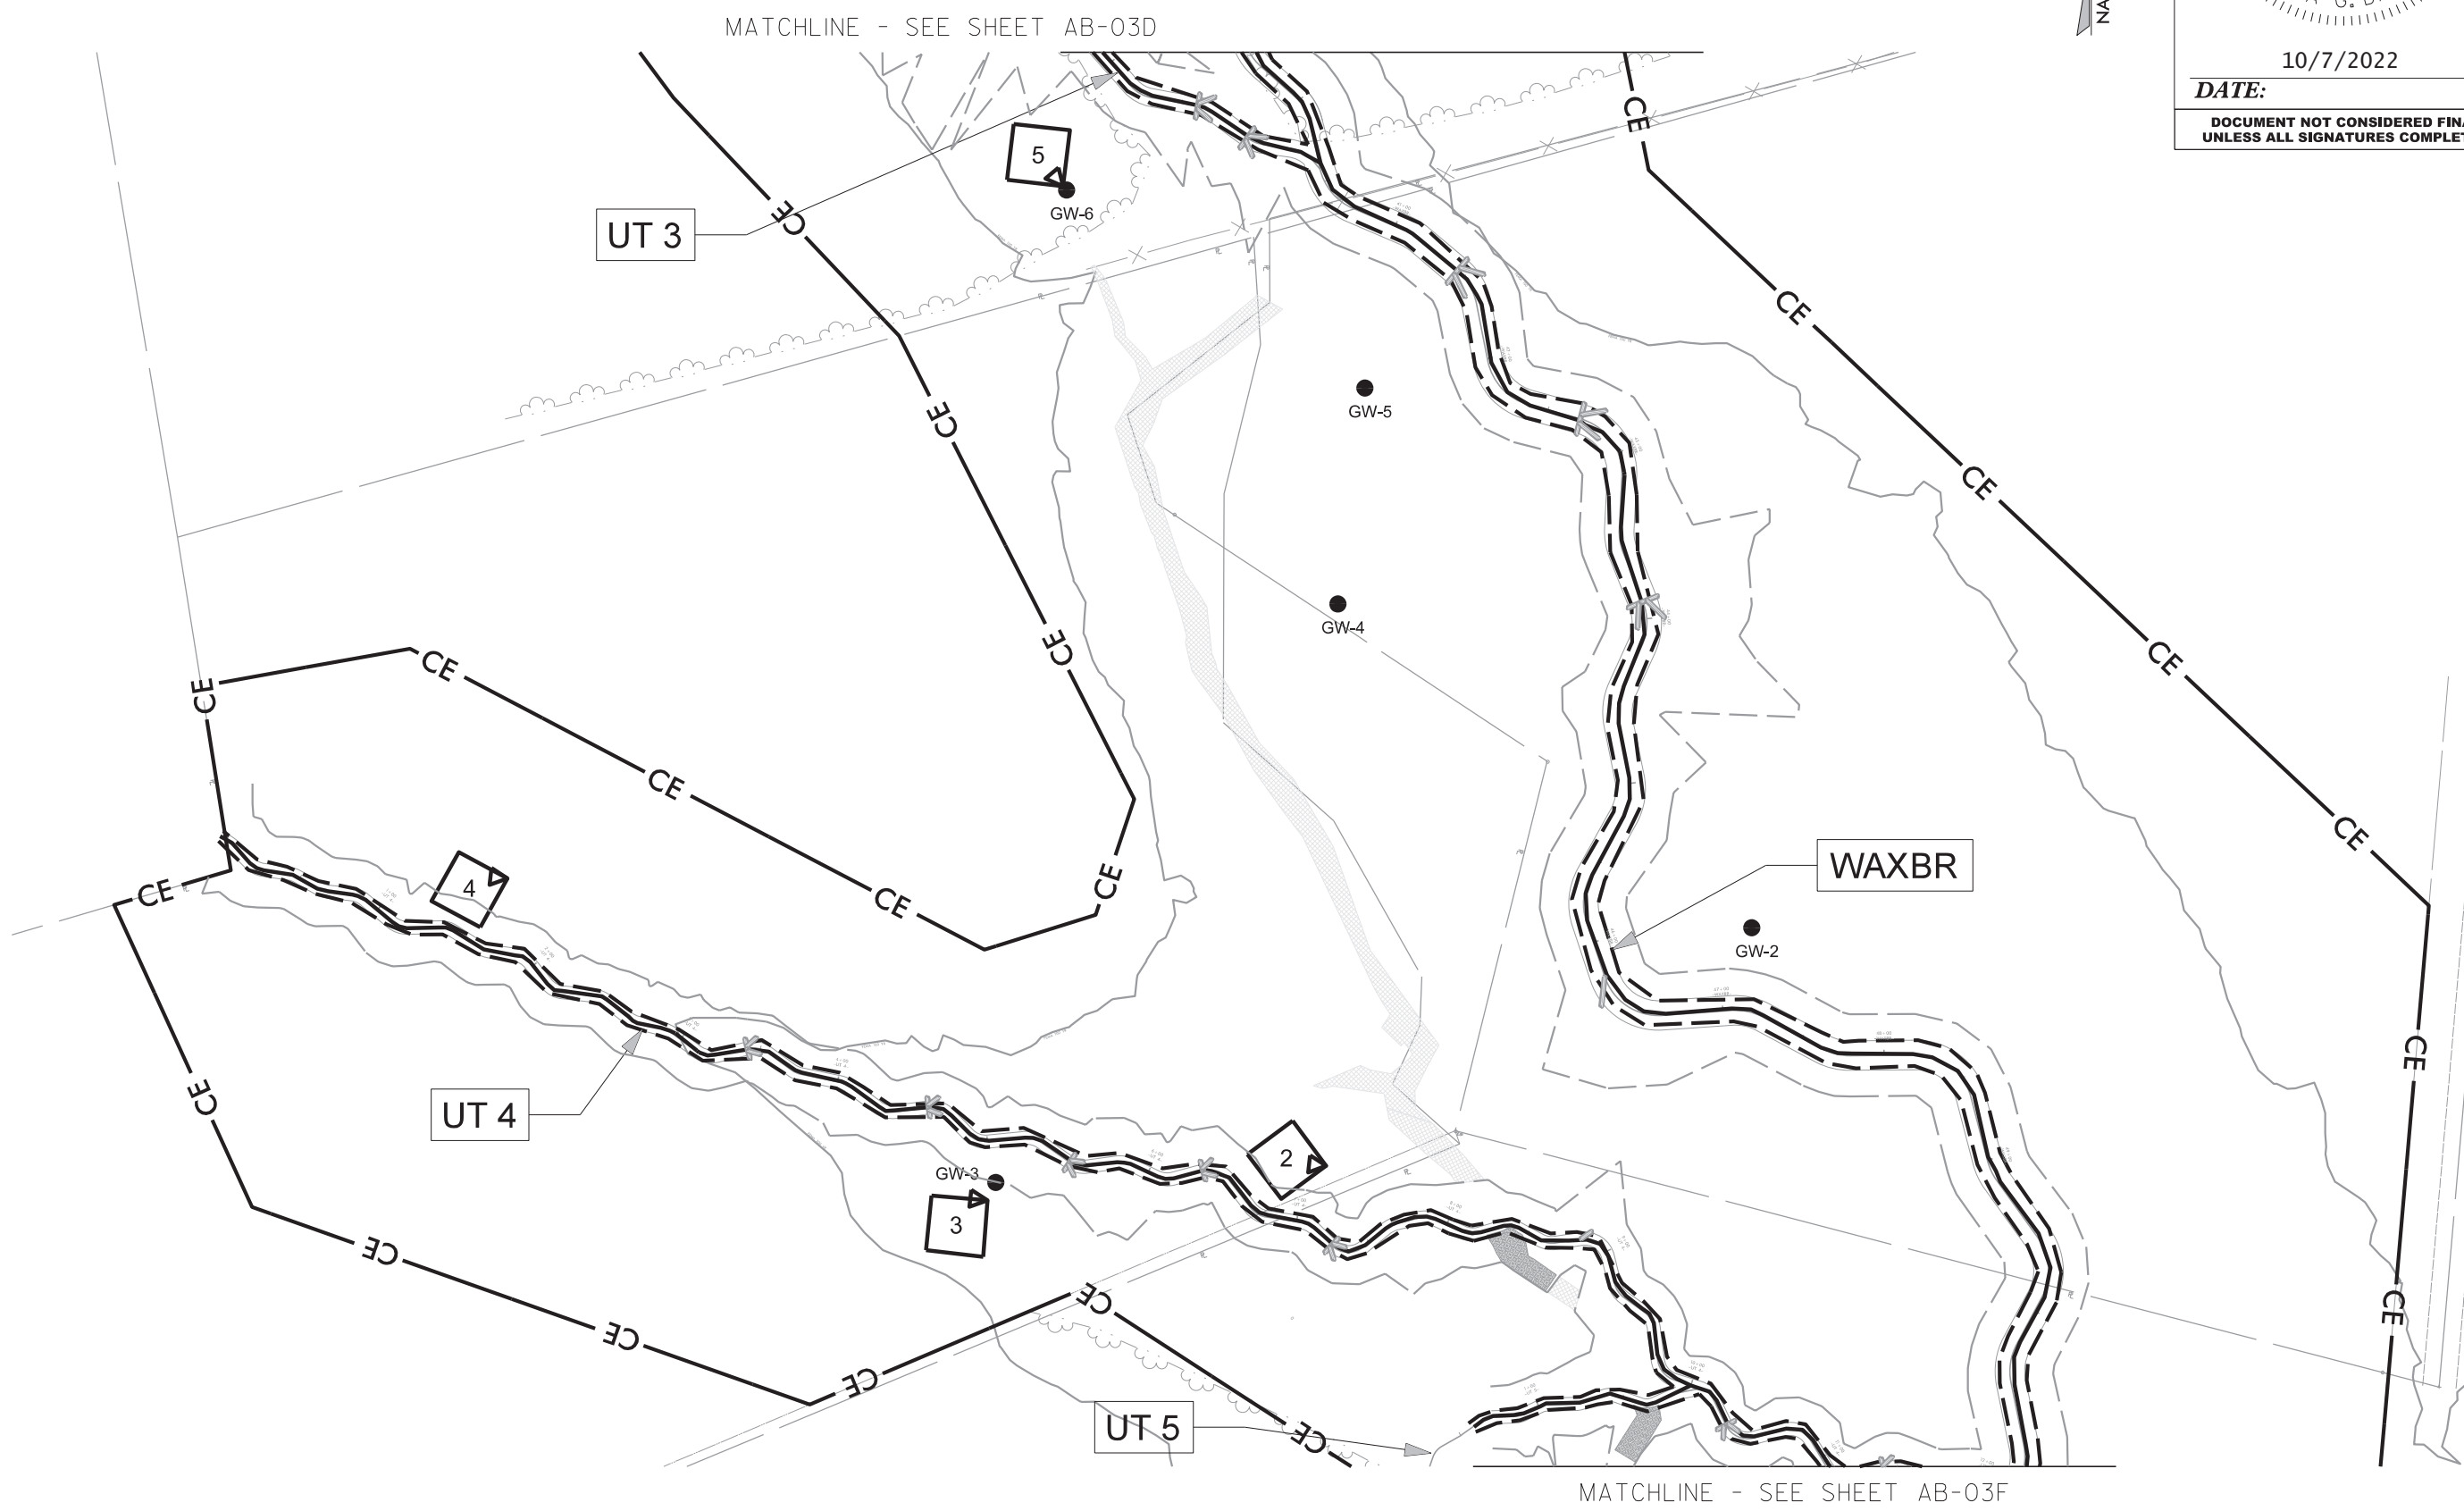

© 2022 SUNGATE DESIGN GROUP, P.A. THIS DRAWING AND ALL REPRODUCTIONS OF IT ARE THE SOLE PROPERTY OF SDG. REPRODUCTION OR OTHER USES OF THIS DRAWING WITHOUT WRITTEN CONSENT OF SDG IS NOT PERMITTED.

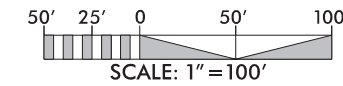


**RECORD DRAWING**

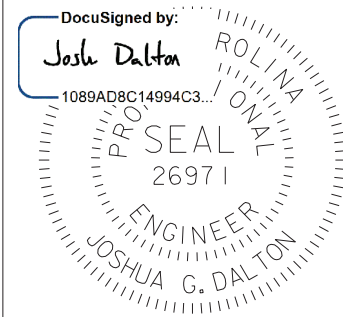

DocuSigned by:  
*Josh Dalton*  
1089AD8C14994C3...  
**DATE:** 10/7/2022  
**DOCUMENT NOT CONSIDERED FINAL  
UNLESS ALL SIGNATURES COMPLETED**



**SUNGATE DESIGN GROUP, P.A.**  
845 GILES FARM LANE ROAD  
RALEIGH, NC 27604  
TEL: (919) 855-2243  
ENG FIRM LICENSE NO. C-980

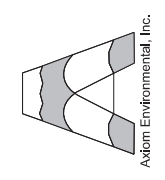


**WITS END**  
UNION COUNTY, NC  
**AS-BUILT VEGETATION PLOTS, GROUNDWATER WELLS**

PROJECT # : 1221-20024  
DRAWING NAME: WITS END PSH AB-03F  
DATE: 2022  
DRAWN BY: JRH  
REVIEWED BY: JGD  
REVISIONS:

SHEET NO.  
**AB-03F**

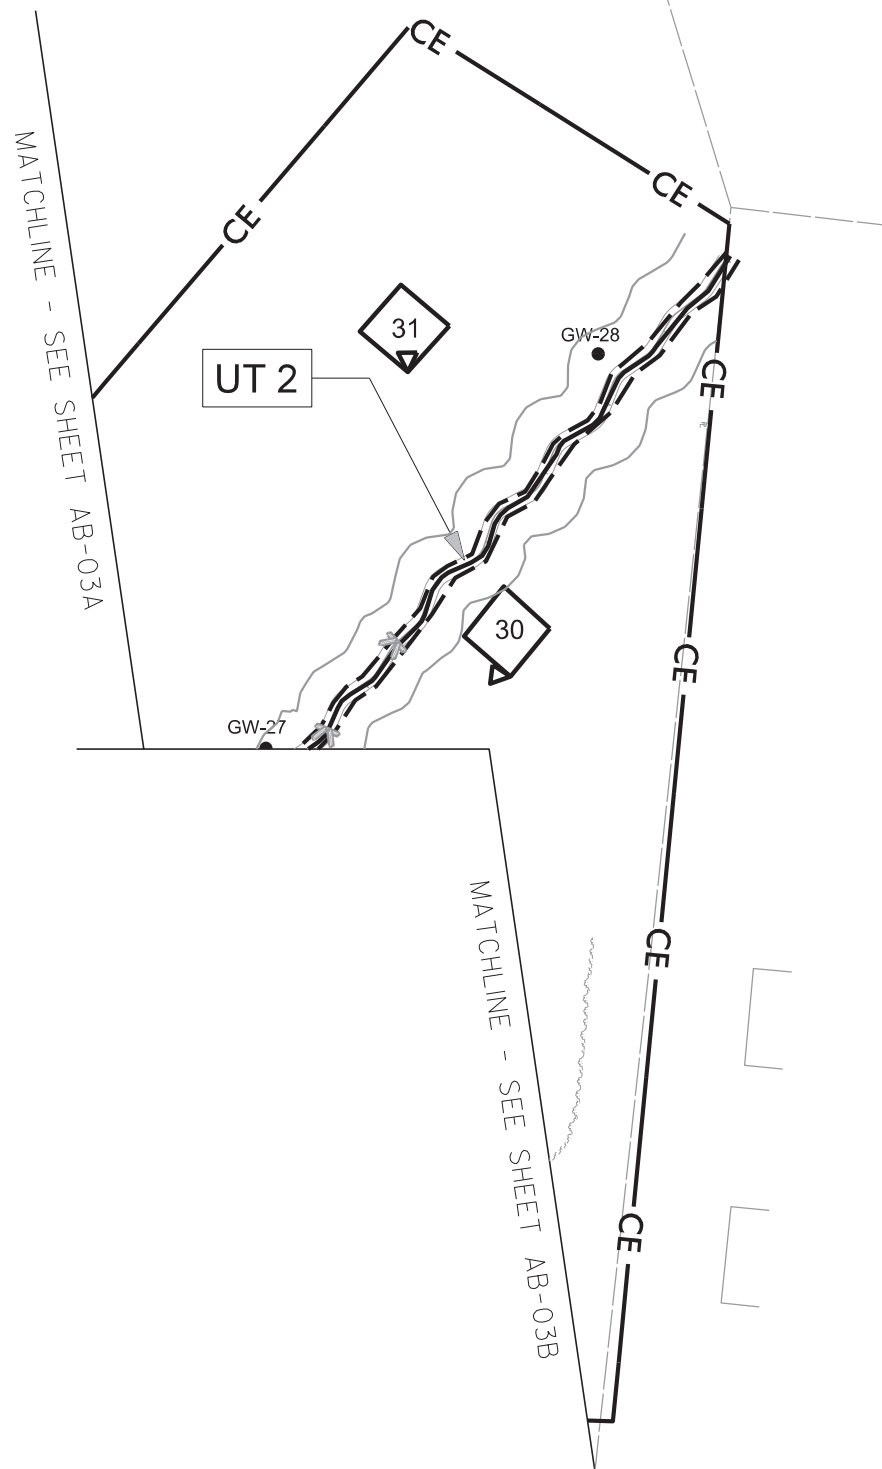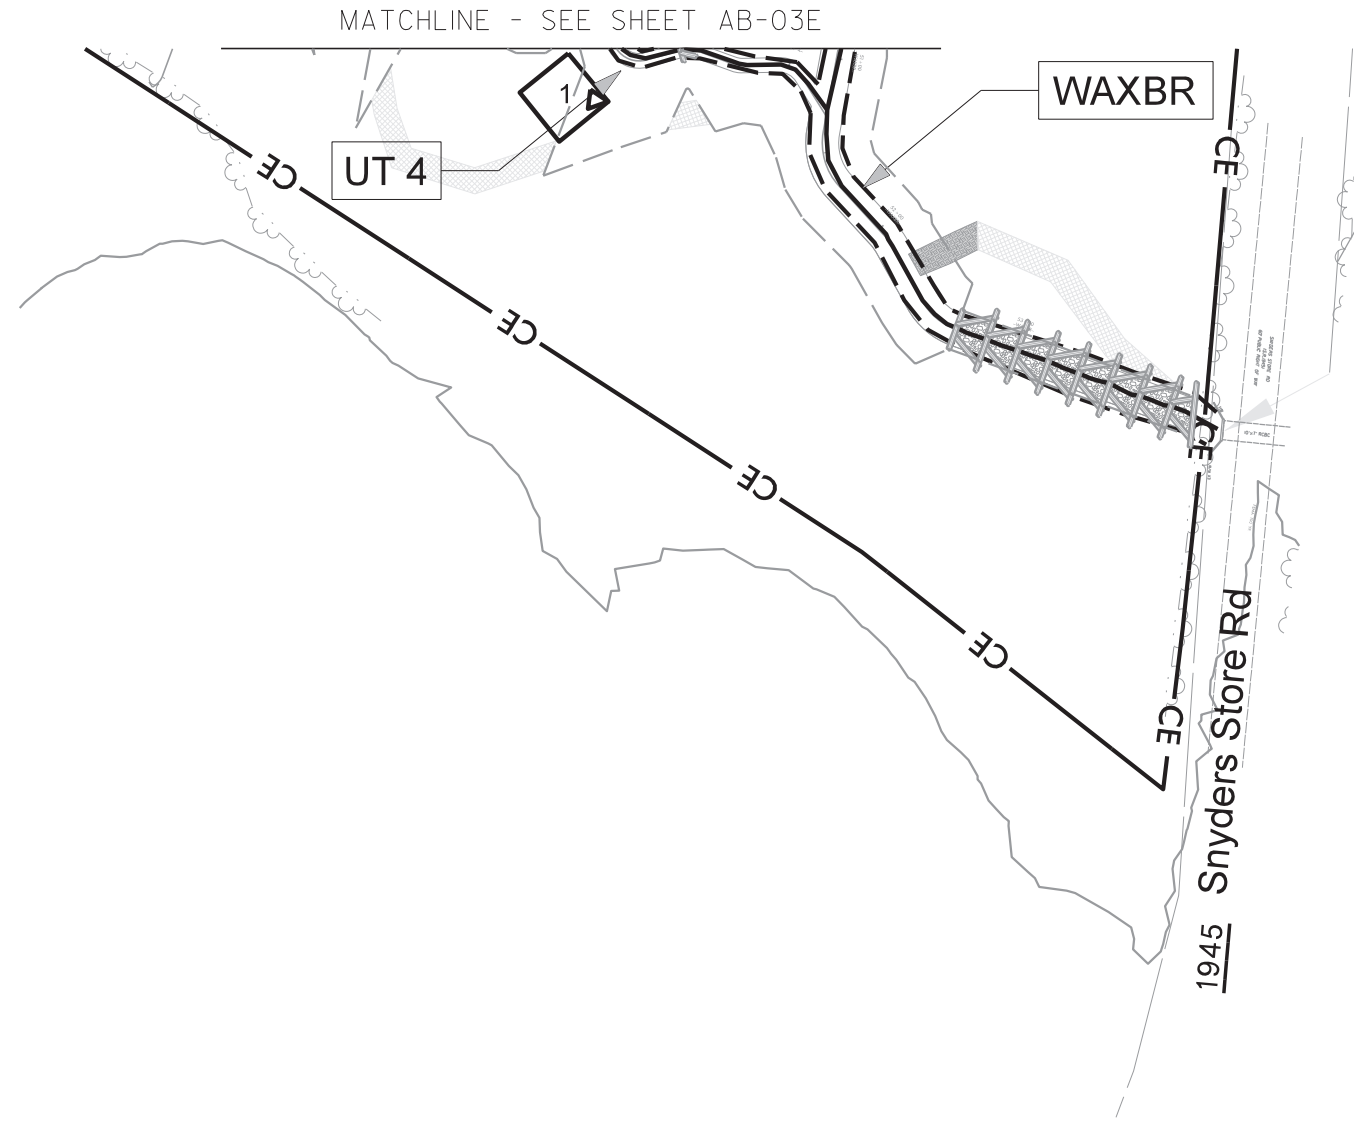

© 2022 SUNGATE DESIGN GROUP, P.A. THIS DRAWING AND ALL REPRODUCTIONS OF IT ARE THE SOLE PROPERTY OF SDG. REPRODUCTION OR OTHER USES OF THIS DRAWING WITHOUT WRITTEN CONSENT OF SDG IS NOT PERMITTED.

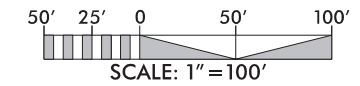

# RECORD DRAWING



DocuSigned by:  
**Josh Dalton**  
 1089AD8C14994C3...  
  
**JOSHUA G. DALTON**  
 ENGINEER  
 10/7/2022

**DATE:**  
 10/7/2022  
**DOCUMENT NOT CONSIDERED FINAL  
 UNLESS ALL SIGNATURES COMPLETED**


**SUNGATE DESIGN GROUP, P.A.**  
 850 GILES FARM ROAD  
 SUITE 200  
 FAYETTEVILLE, NC 27806  
 TEL: (919) 856-2243  
 ENG FIRM LICENSE NO. C-980

Axiom Environmental, Inc.

**WITS END**  
 UNION COUNTY, NC  
**AS-BUILT VEGETATION PLOTS, GROUNDWATER WELLS**

PROJECT # :	1221-20024
DRAWING NAME:	WITS END PSH AB-03G
DATE:	2022
DRAWN BY:	JRH
REVIEWED BY:	JGD
REVISIONS:	

SHEET NO.  
**AB-03G**

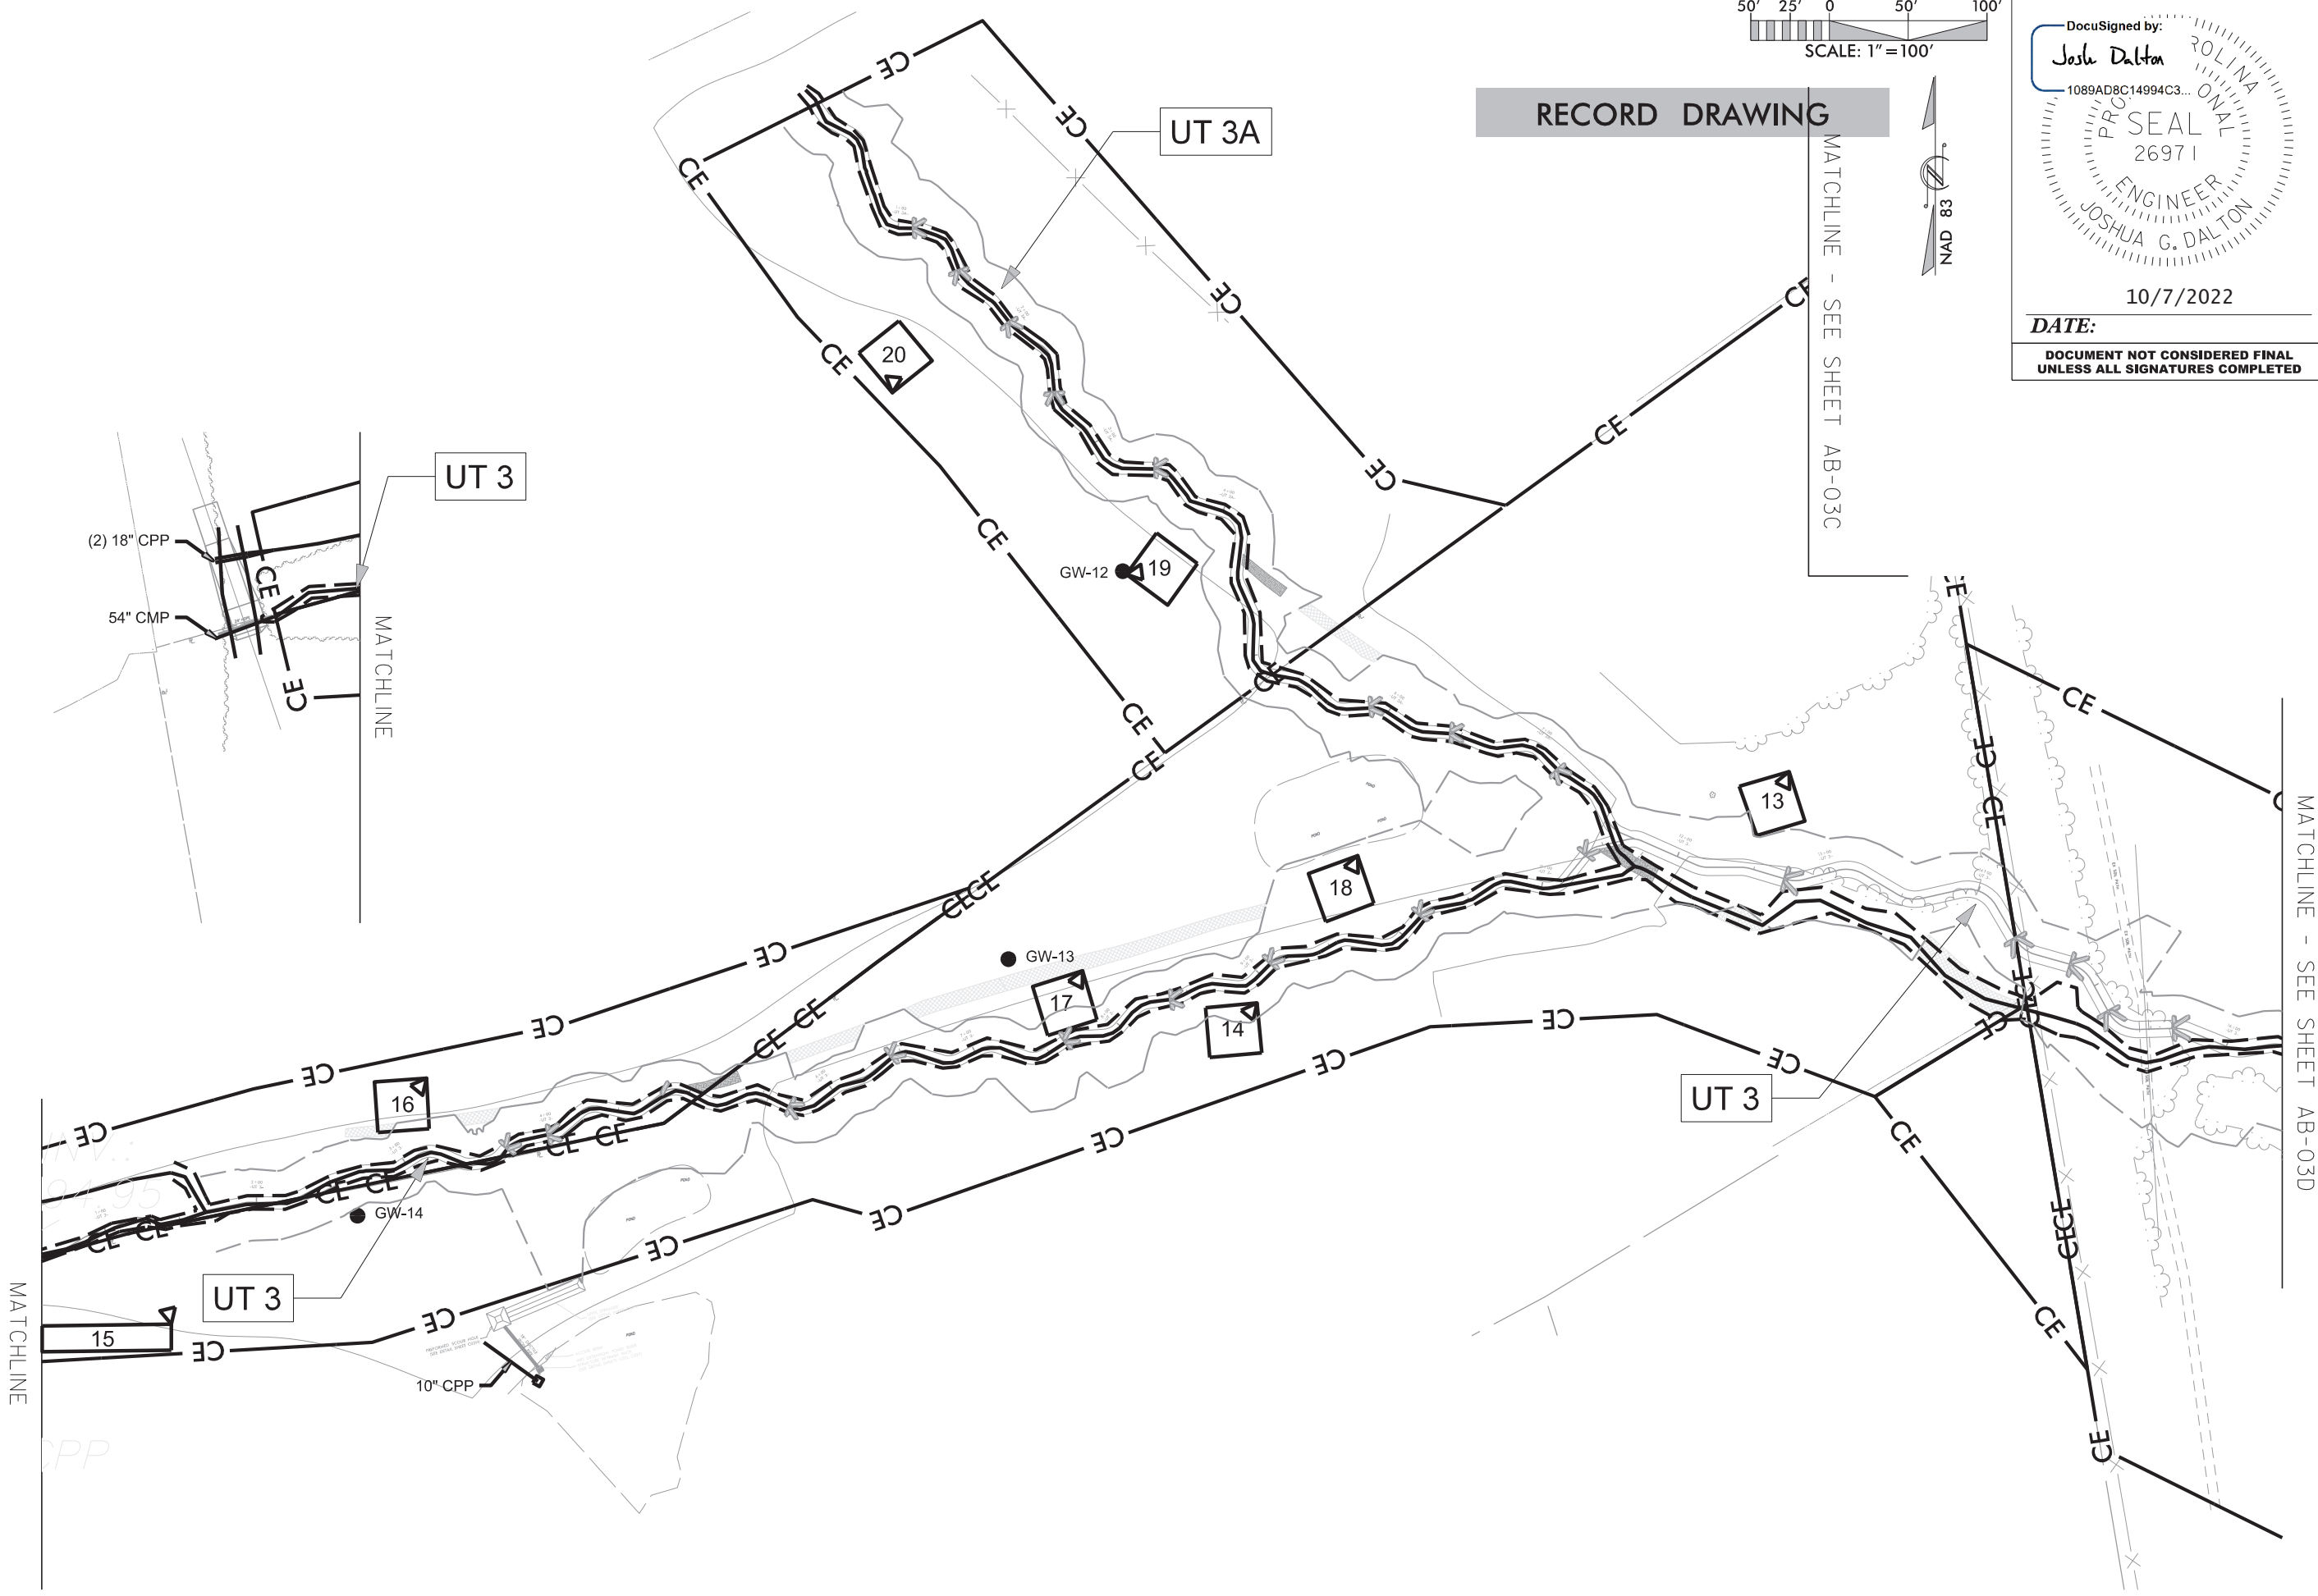


10/6/2022  
 Wits\_End\_Psh\_AB-03G.dgn  
 jrh



© 2022 SUNGATE DESIGN GROUP, P.A. THIS DRAWING AND ALL REPRODUCTIONS OF IT ARE THE SOLE PROPERTY OF SDG. REPRODUCTION OR OTHER USES OF THIS DRAWING WITHOUT WRITTEN CONSENT OF SDG IS NOT PERMITTED.




**RECORD DRAWING**

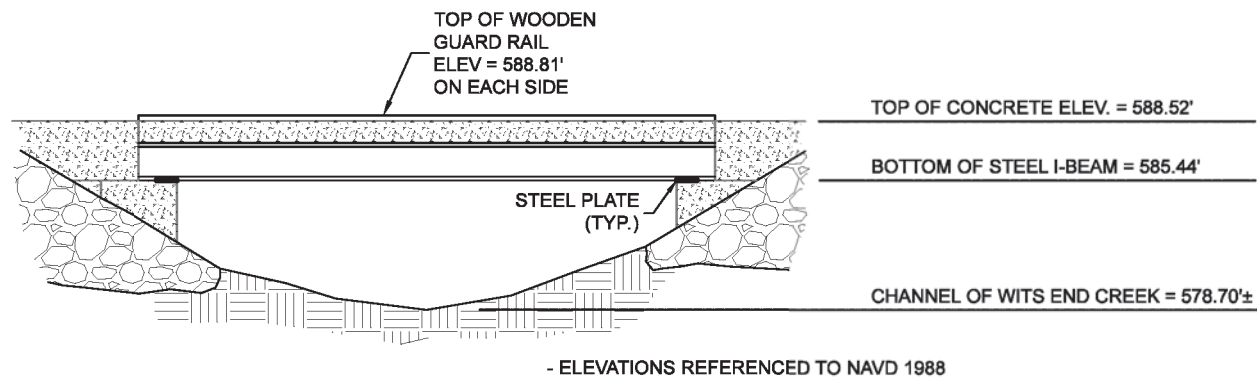

**LONGITUDINAL SECTION**

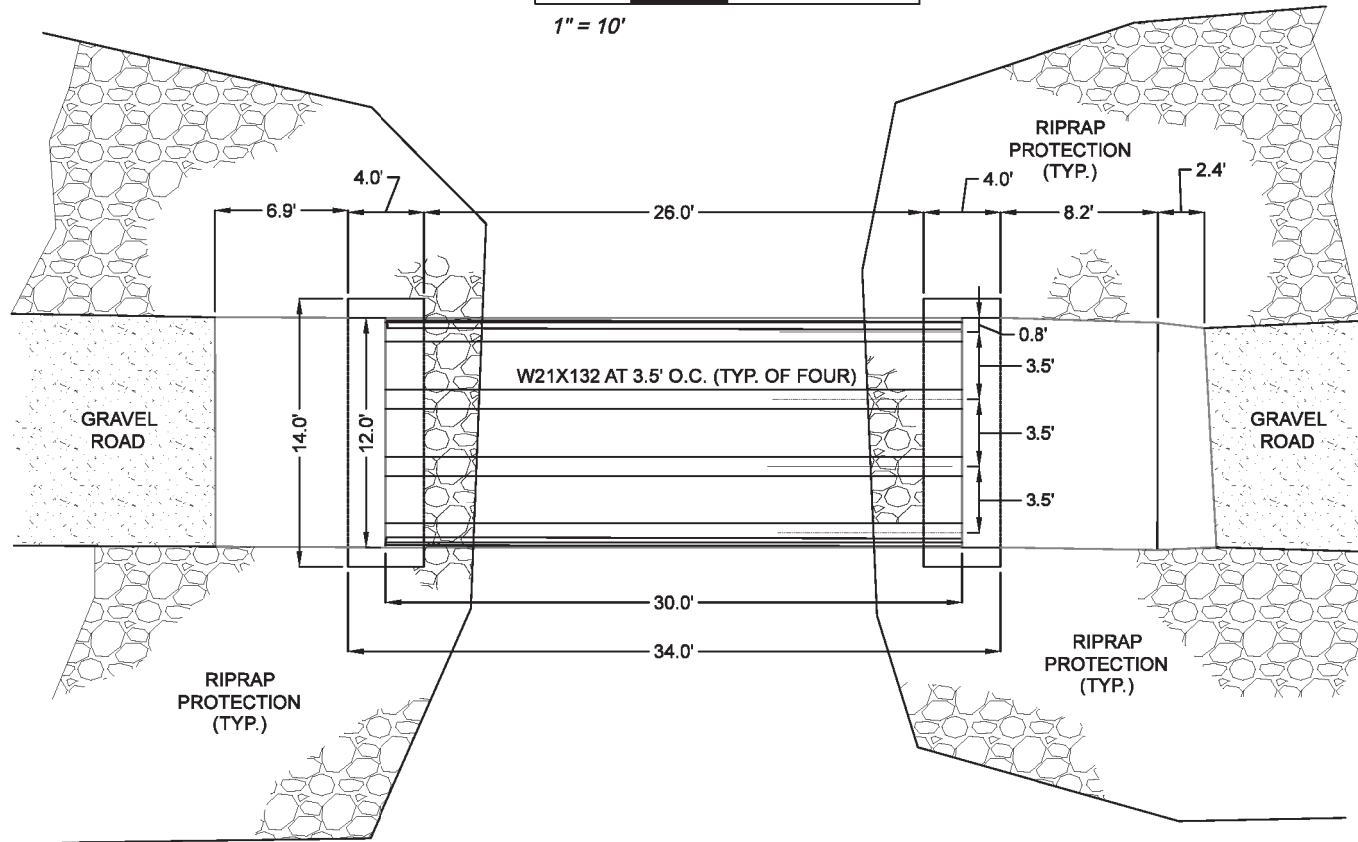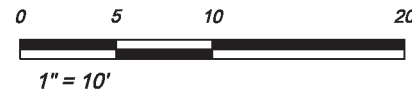

**PLAN VIEW**

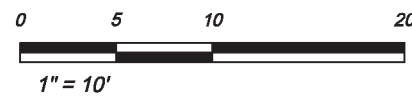


**EXISTING BRIDGE**  
SEPTEMBER 2022

**ENGINEERS CERTIFICATION(S)**

Witness my original signature, registration number and seal this 26th day of September, A.D., 2022

Seal or Stamp

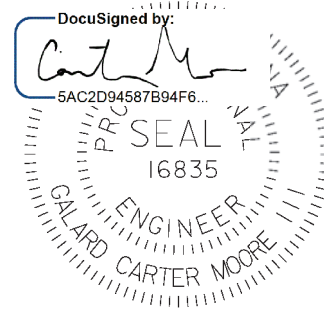


Professional Engineer

**SURVEYORS CERTIFICATION(S)**

Witness my original signature, registration number and seal this 26th day of September, A.D., 2022

Seal or Stamp

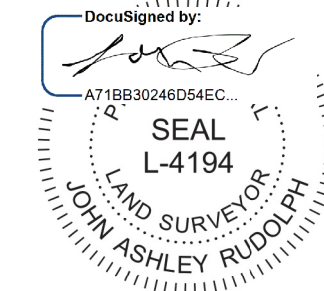

Professional Land Surveyor

774 S. Beston Road  
La Grange, NC 28551  
252.562.3097  
www.k2designgroup.com  
Firm license no.: C-2111



**RESTORATION SYSTEMS, LLC**  
1101 HAYNES STREET  
SUITE 211  
RALEIGH, NC 27604



Client

WITS END SITE  
Union County,  
North Carolina

**BRIDGE AS-BUILT**  
Plan View and  
Longitudinal view

Project

Title

DRAWN BY: FGR

DATE: 9/23/22

SURVEYED BY: J.A.R.

DWG. NO.  
RSS580AB22



SHEET  
1 OF 1








-WAXBR- AS-BUILT STRUCTURE LOCATIONS				
STR. TYPE	NORTHING	EASTING	Prop Elevation	AB Survey Elevation
CROSS VANE	428,097.82	1,566,515.51	589.76	589.36

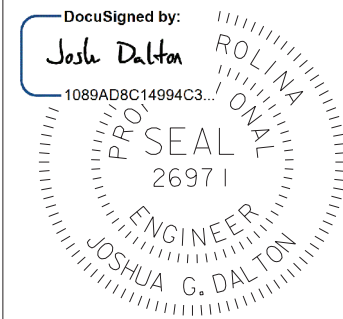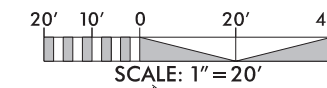

DATE: 10/7/2022

DOCUMENT NOT CONSIDERED FINAL UNLESS ALL SIGNATURES COMPLETED

**SUNGATE DESIGN GROUP, P.A.**  
 830 W. PARKWAY ROAD  
 SUITE 200  
 WILMINGTON, NC 28403  
 TEL: (919) 855-2243  
 FAX: (919) 855-2244  
 ENG. FIRM LICENSE NO. C-980

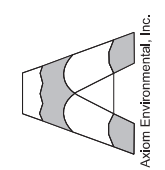



**WITS END**  
 UNION COUNTY, NC  
**AS-BUILT STRUCTURES**

PROJECT #: 1221-20024  
 DRAWING NAME: WITS END PSH AB-04C  
 DATE: 2022  
 DRAWN BY: JRH  
 REVIEWED BY: JGD  
 REVISIONS:

SHEET NO. **AB-04C**



~NOW OR FORMERLY~  
 WITS END FARM LLC  
 DB 4568/779  
 PID 04006015  
 TITLE COMMITMENT TRACT 2  
 83.434-AC  
 (NET OVERLAP)

**RECORD DRAWING**

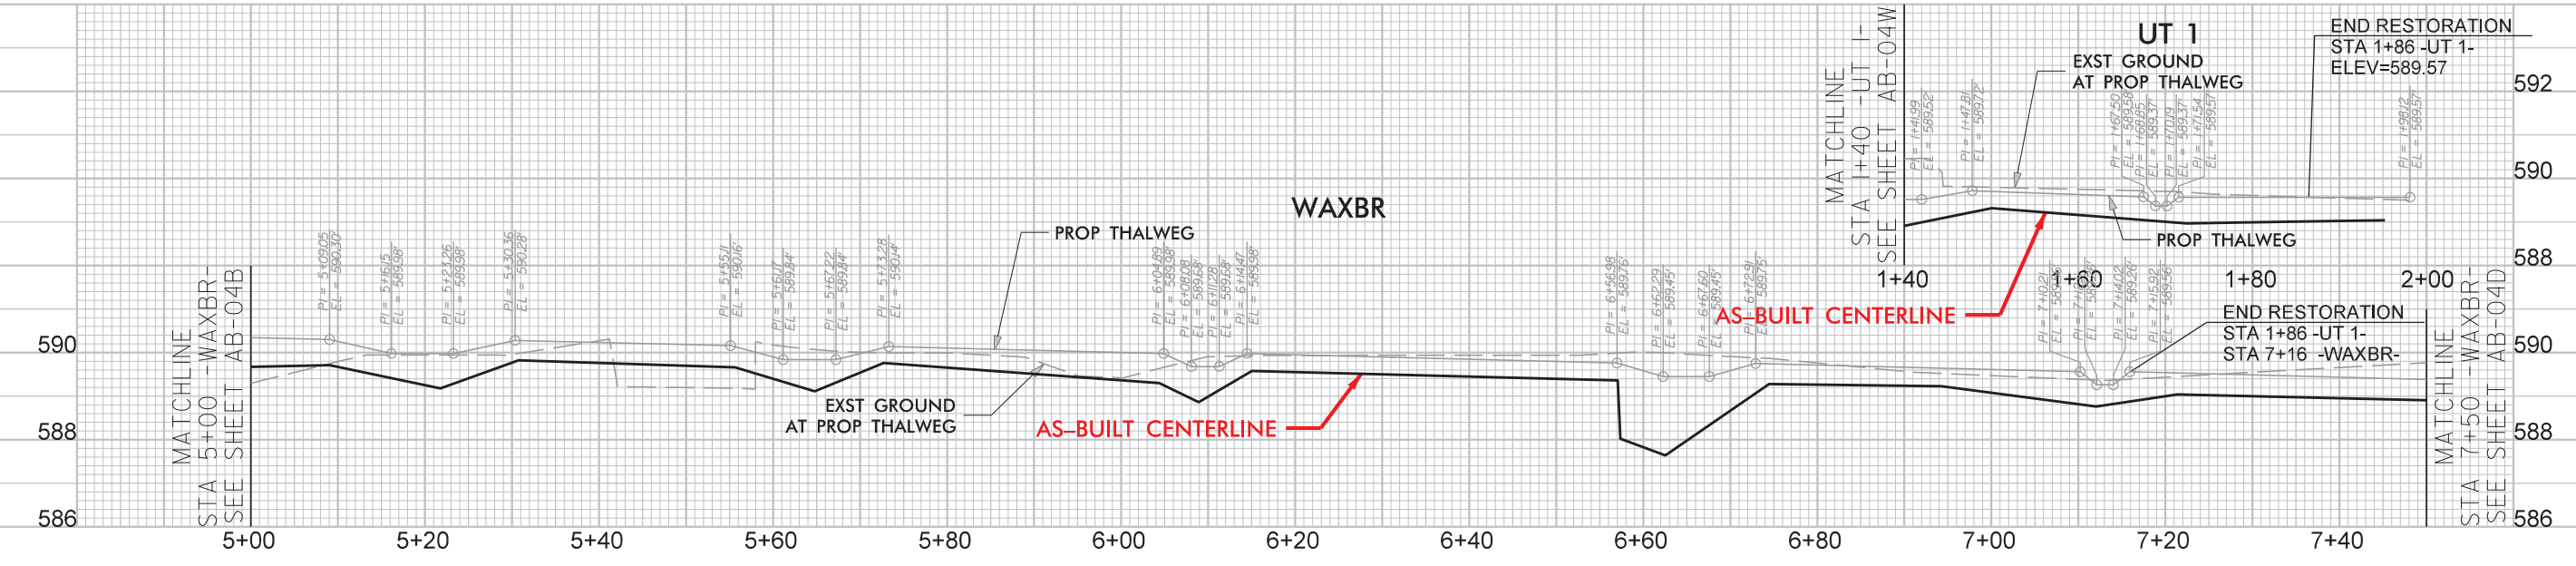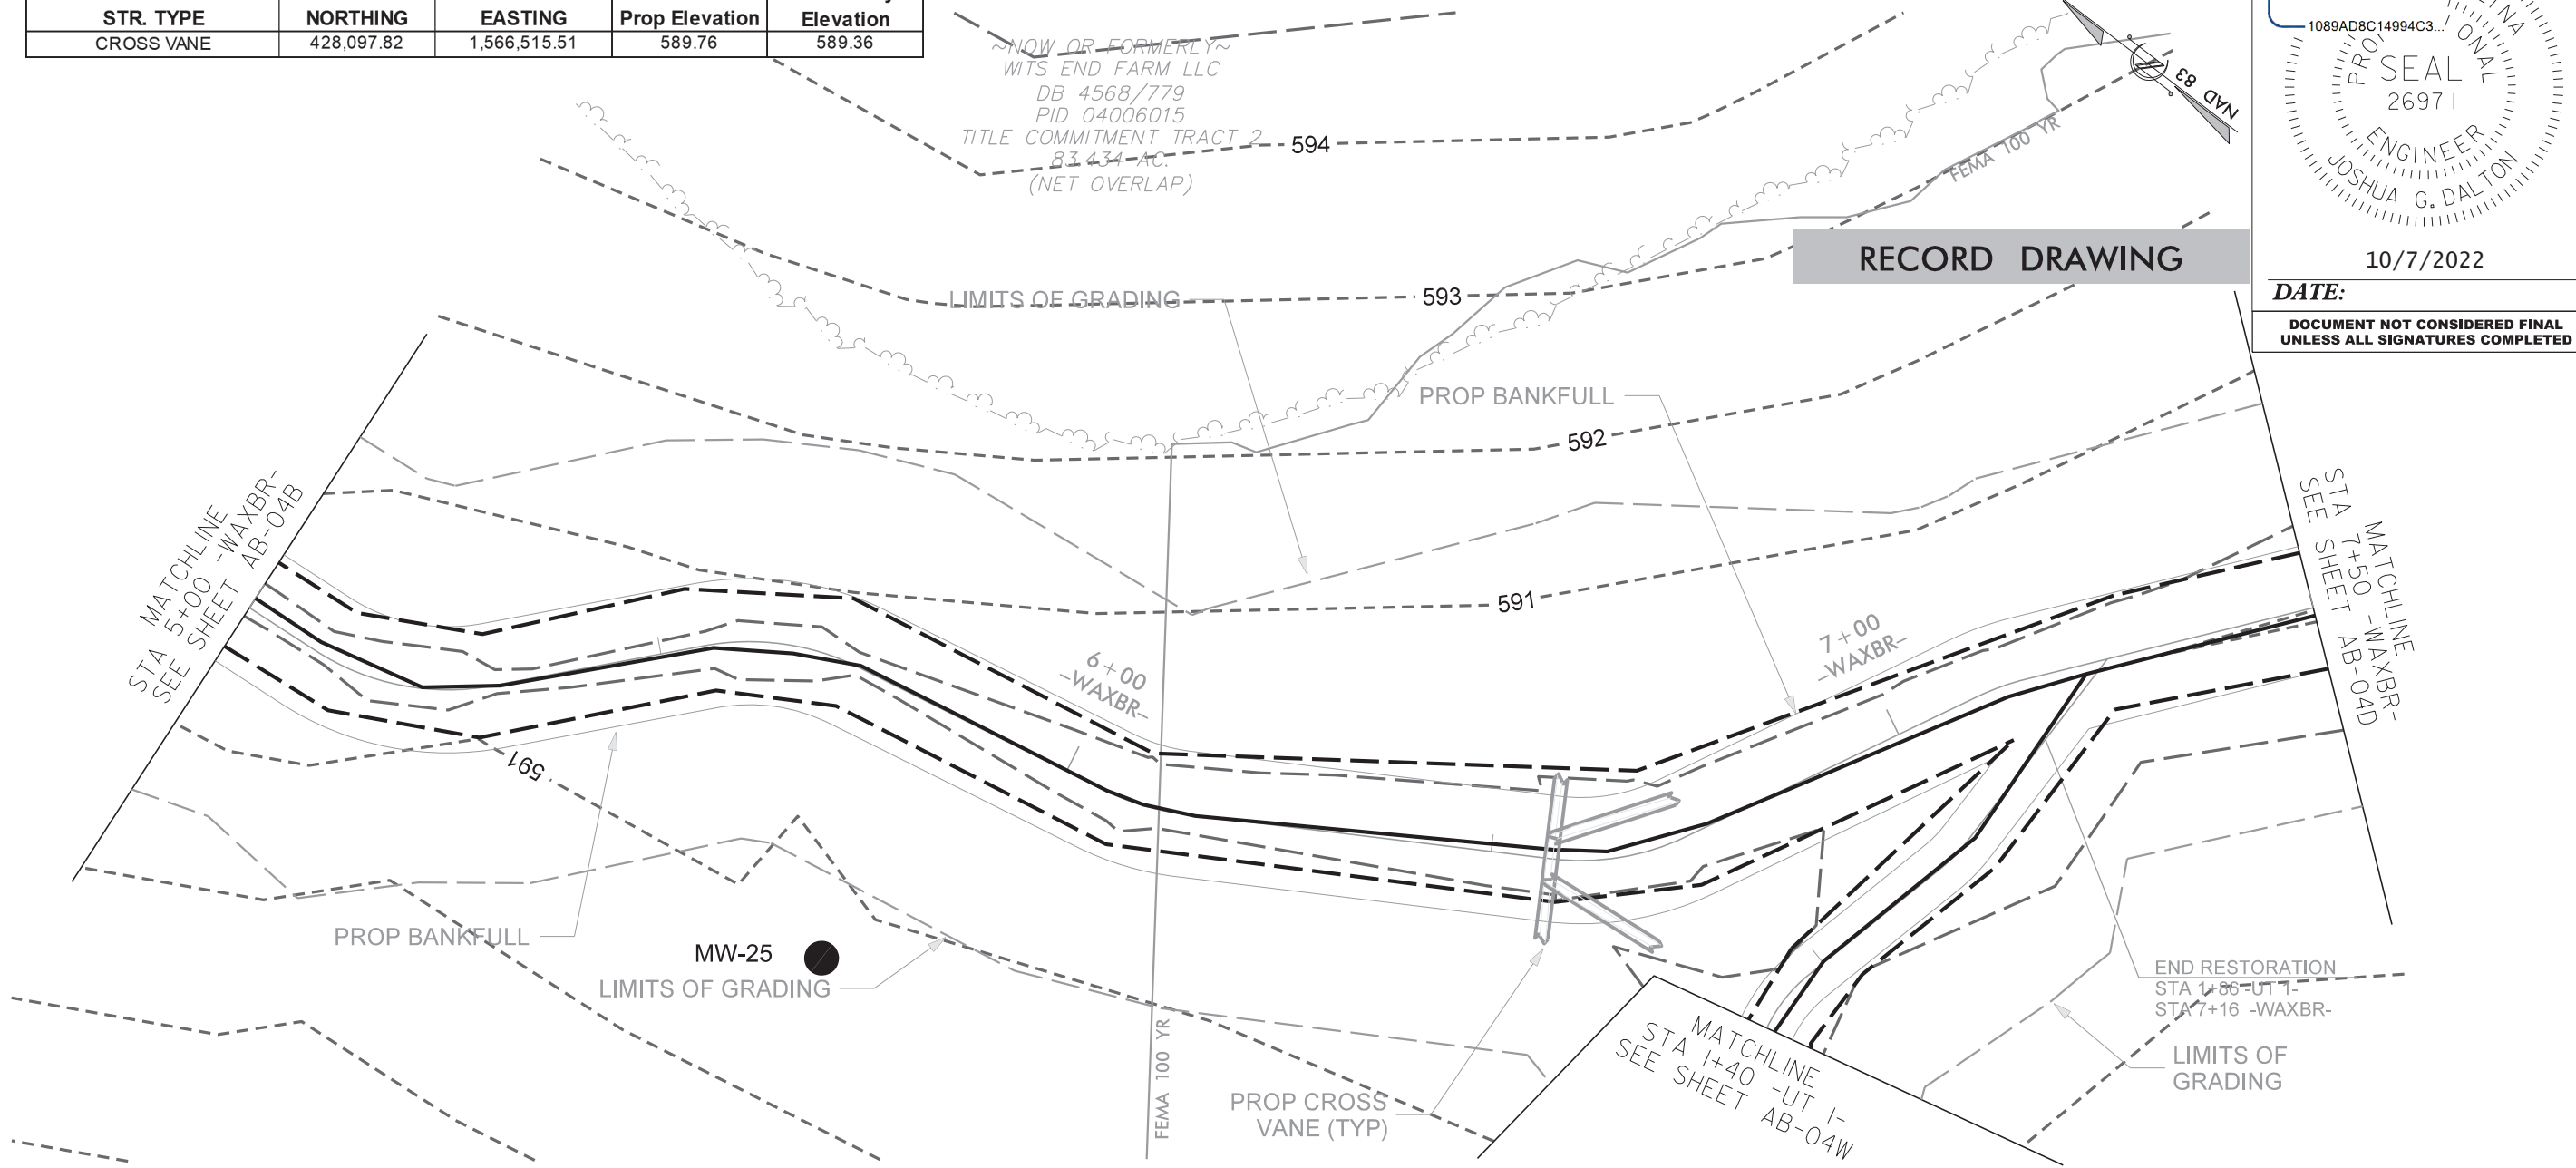


10/6/2022 Wits\_End\_Psh\_AB-04C.dgn

© 2022 SUNGATE DESIGN GROUP, P.A. THIS DRAWING AND ALL REPRODUCTIONS OF IT ARE THE SOLE PROPERTY OF SDG. REPRODUCTION OR OTHER USES OF THIS DRAWING WITHOUT WRITTEN CONSENT OF SDG IS NOT PERMITTED.

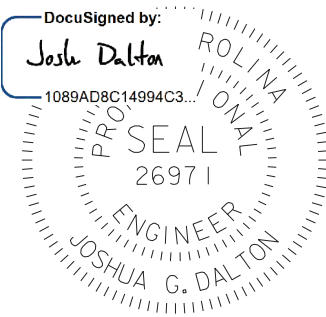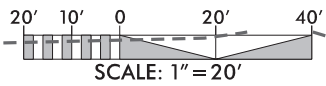

DocuSigned by:  
**Joshua Dalton**  
 1089AD8C14994C3...  
**DATE:** 10/7/2022  
**DOCUMENT NOT CONSIDERED FINAL UNLESS ALL SIGNATURES COMPLETED**



**SUNGATE DESIGN GROUP, P.A.**  
 840 GUNN ROAD  
 SUITE 200  
 FAYETTEVILLE, NC 27806  
 TEL: (919) 855-2243  
 ENG. FIRM LICENSE NO. C-980

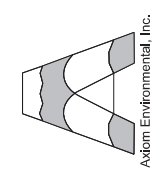

REPRODUCTION OR OTHER USES OF THIS DRAWING WITHOUT WRITTEN CONSENT OF SDG IS NOT PERMITTED.


**WITS END**  
 UNION COUNTY, NC  
**AS-BUILT STRUCTURES**

PROJECT #: 1221-20024  
 DRAWING NAME: WITS END PSH AB-04D  
 DATE: 2022  
 DRAWN BY: JRH  
 REVIEWED BY: JGD  
 REVISIONS:  
 SHEET NO. **AB-04D**

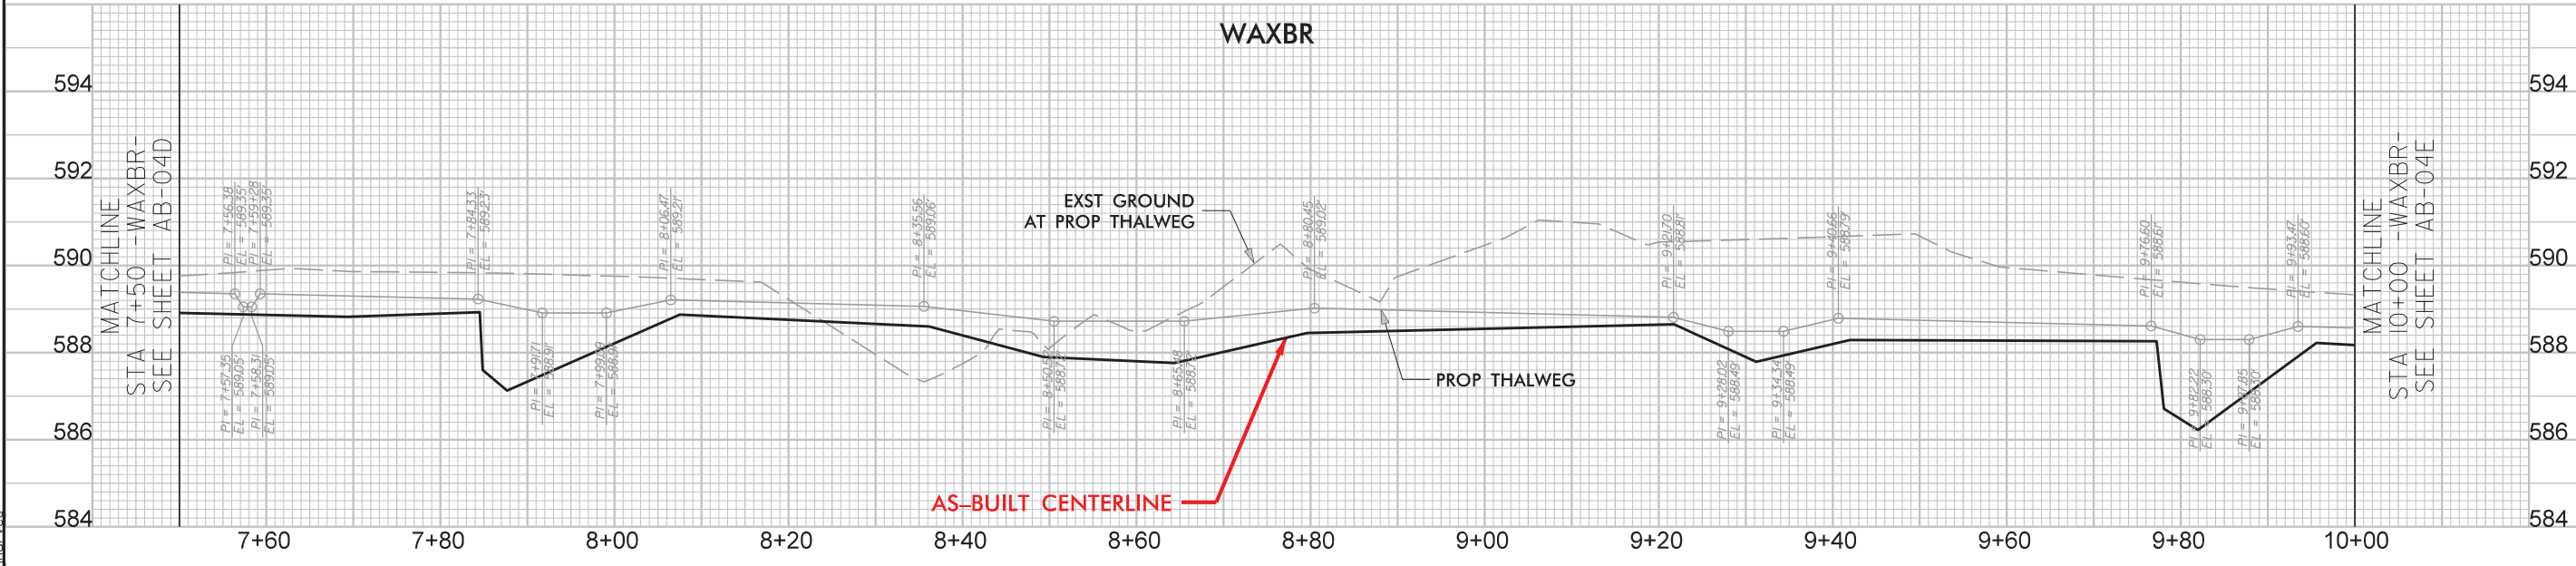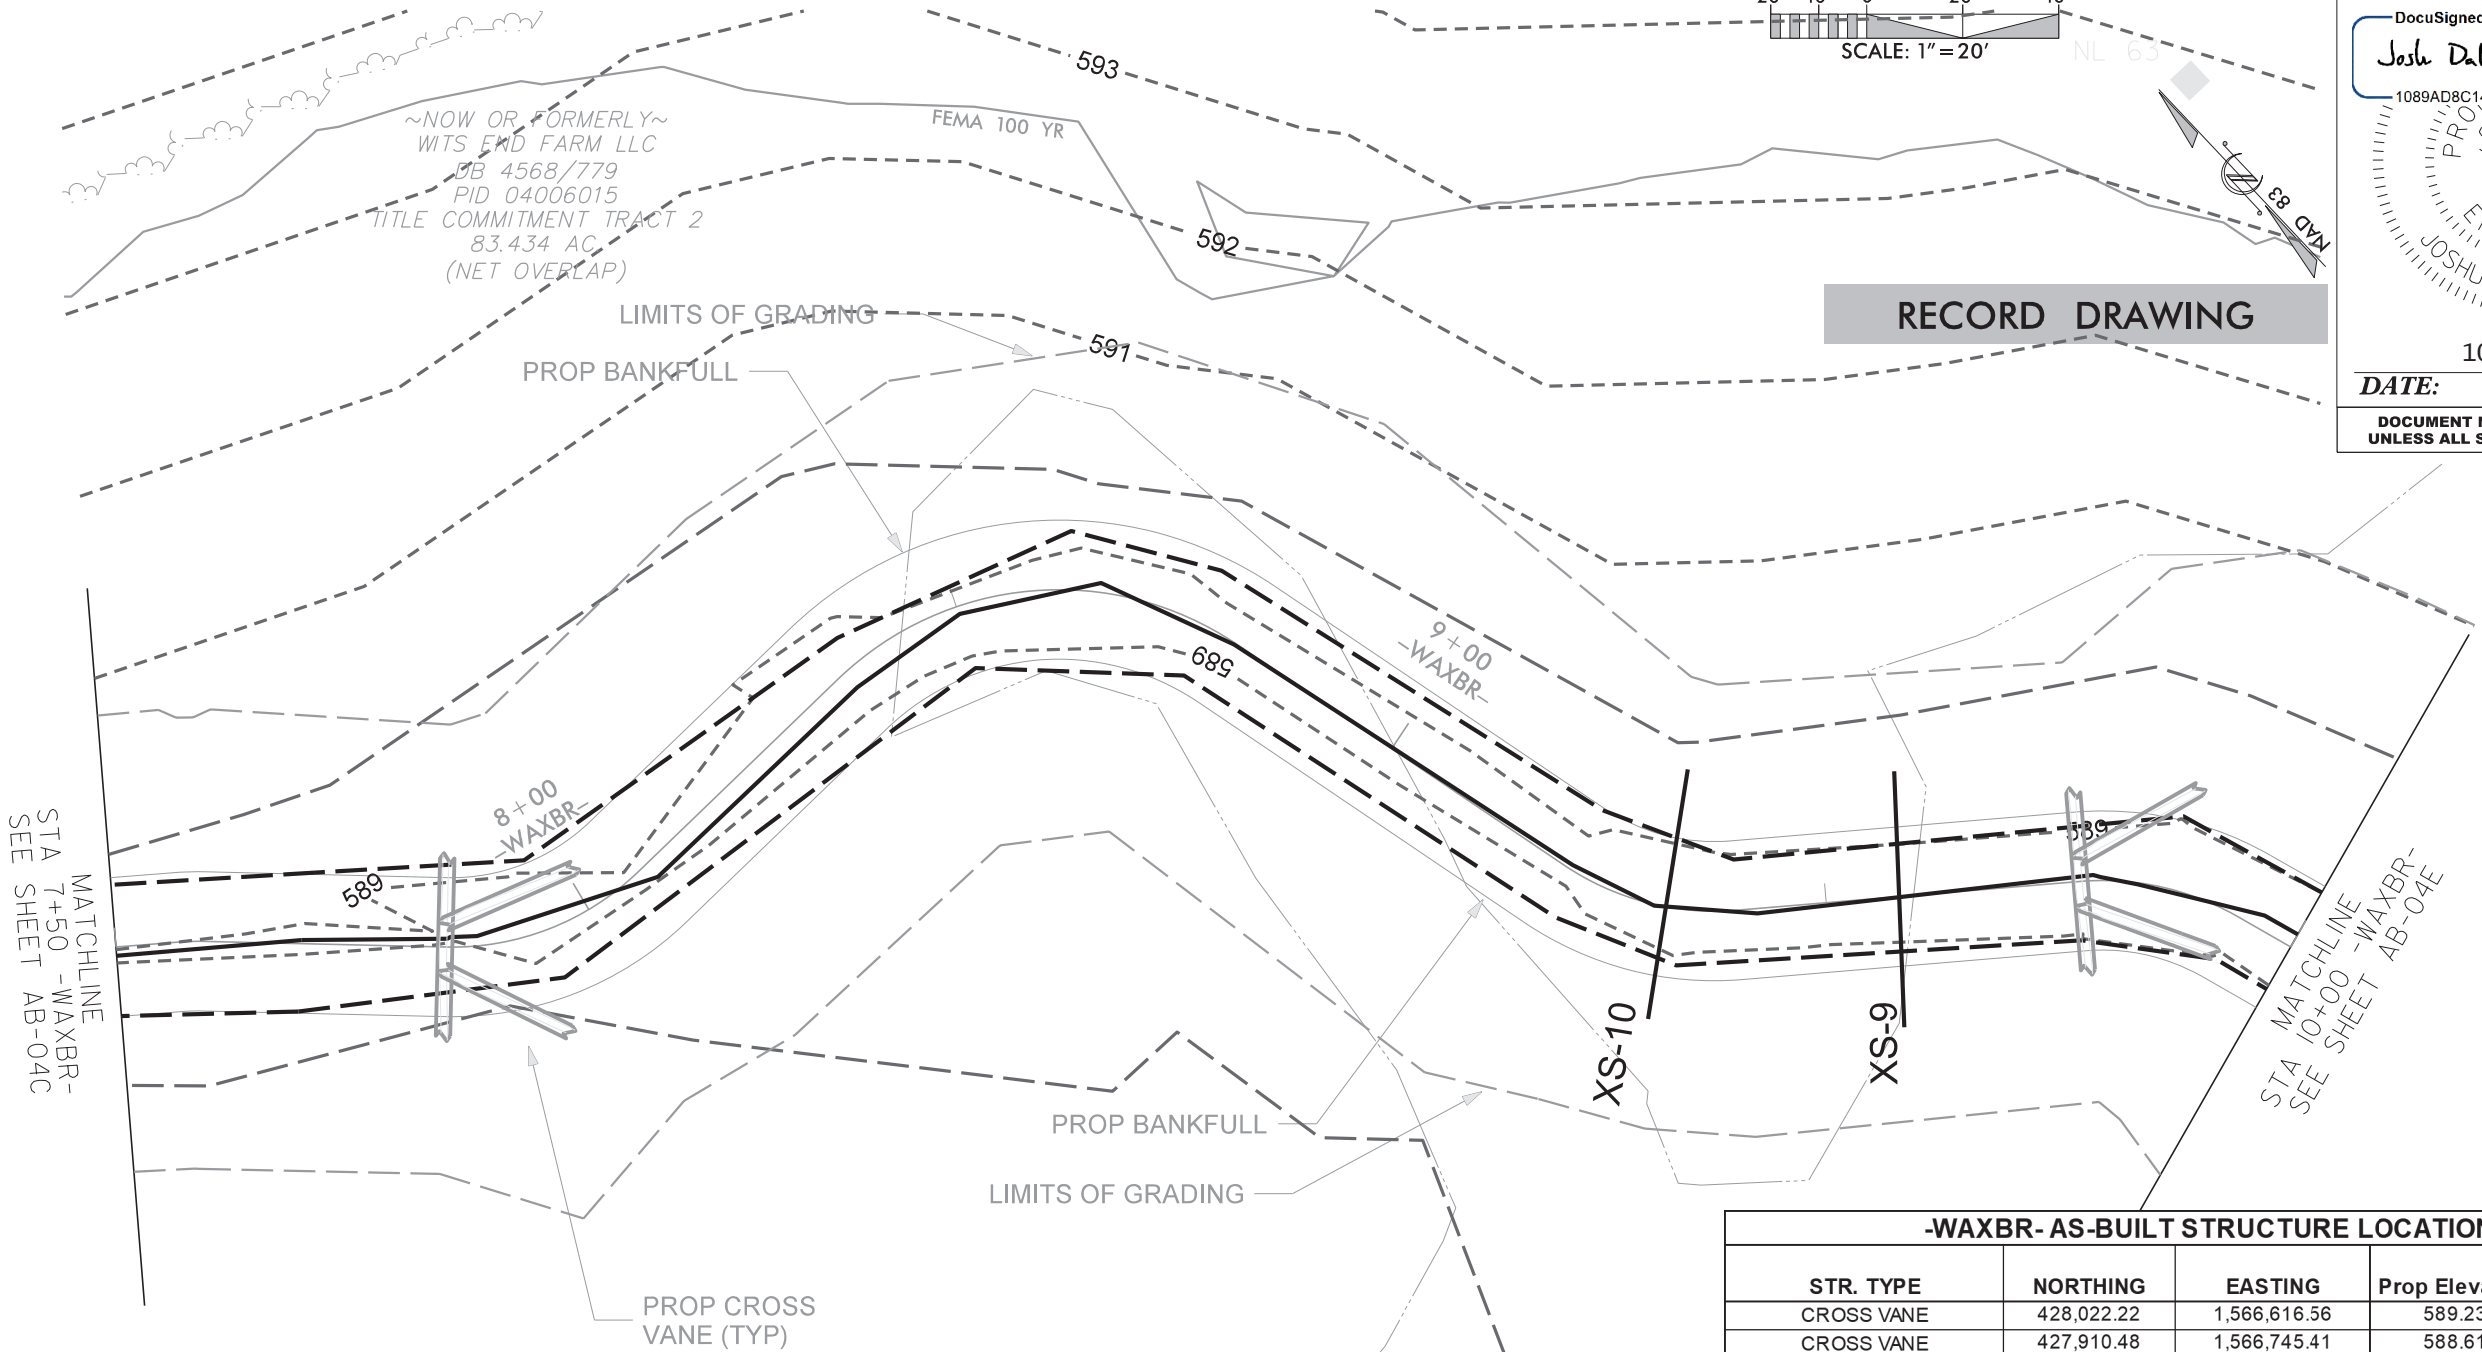

10/6/2022  
 Wits\_End\_Psh\_AB-04D.dgn


**RECORD DRAWING**

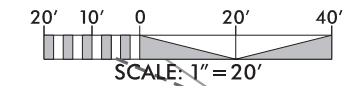

DocuSigned by:  
**Josh Dalton**  
 1089AD8C14994C3...  
 PROFESSIONAL ENGINEER  
 26971  
**JOSHUA G. DALTON**  
 DATE: 10/7/2022  
**DOCUMENT NOT CONSIDERED FINAL  
 UNLESS ALL SIGNATURES COMPLETED**


**SUNGATE DESIGN GROUP, P.A.**  
 830 W. GREENWOOD ROAD  
 SUITE 2000  
 CHARLOTTE, NC 27866  
 TEL: (919) 855-2243  
 ENG. FIRM LICENSE NO. C-980

**Axam Environmental, Inc.**

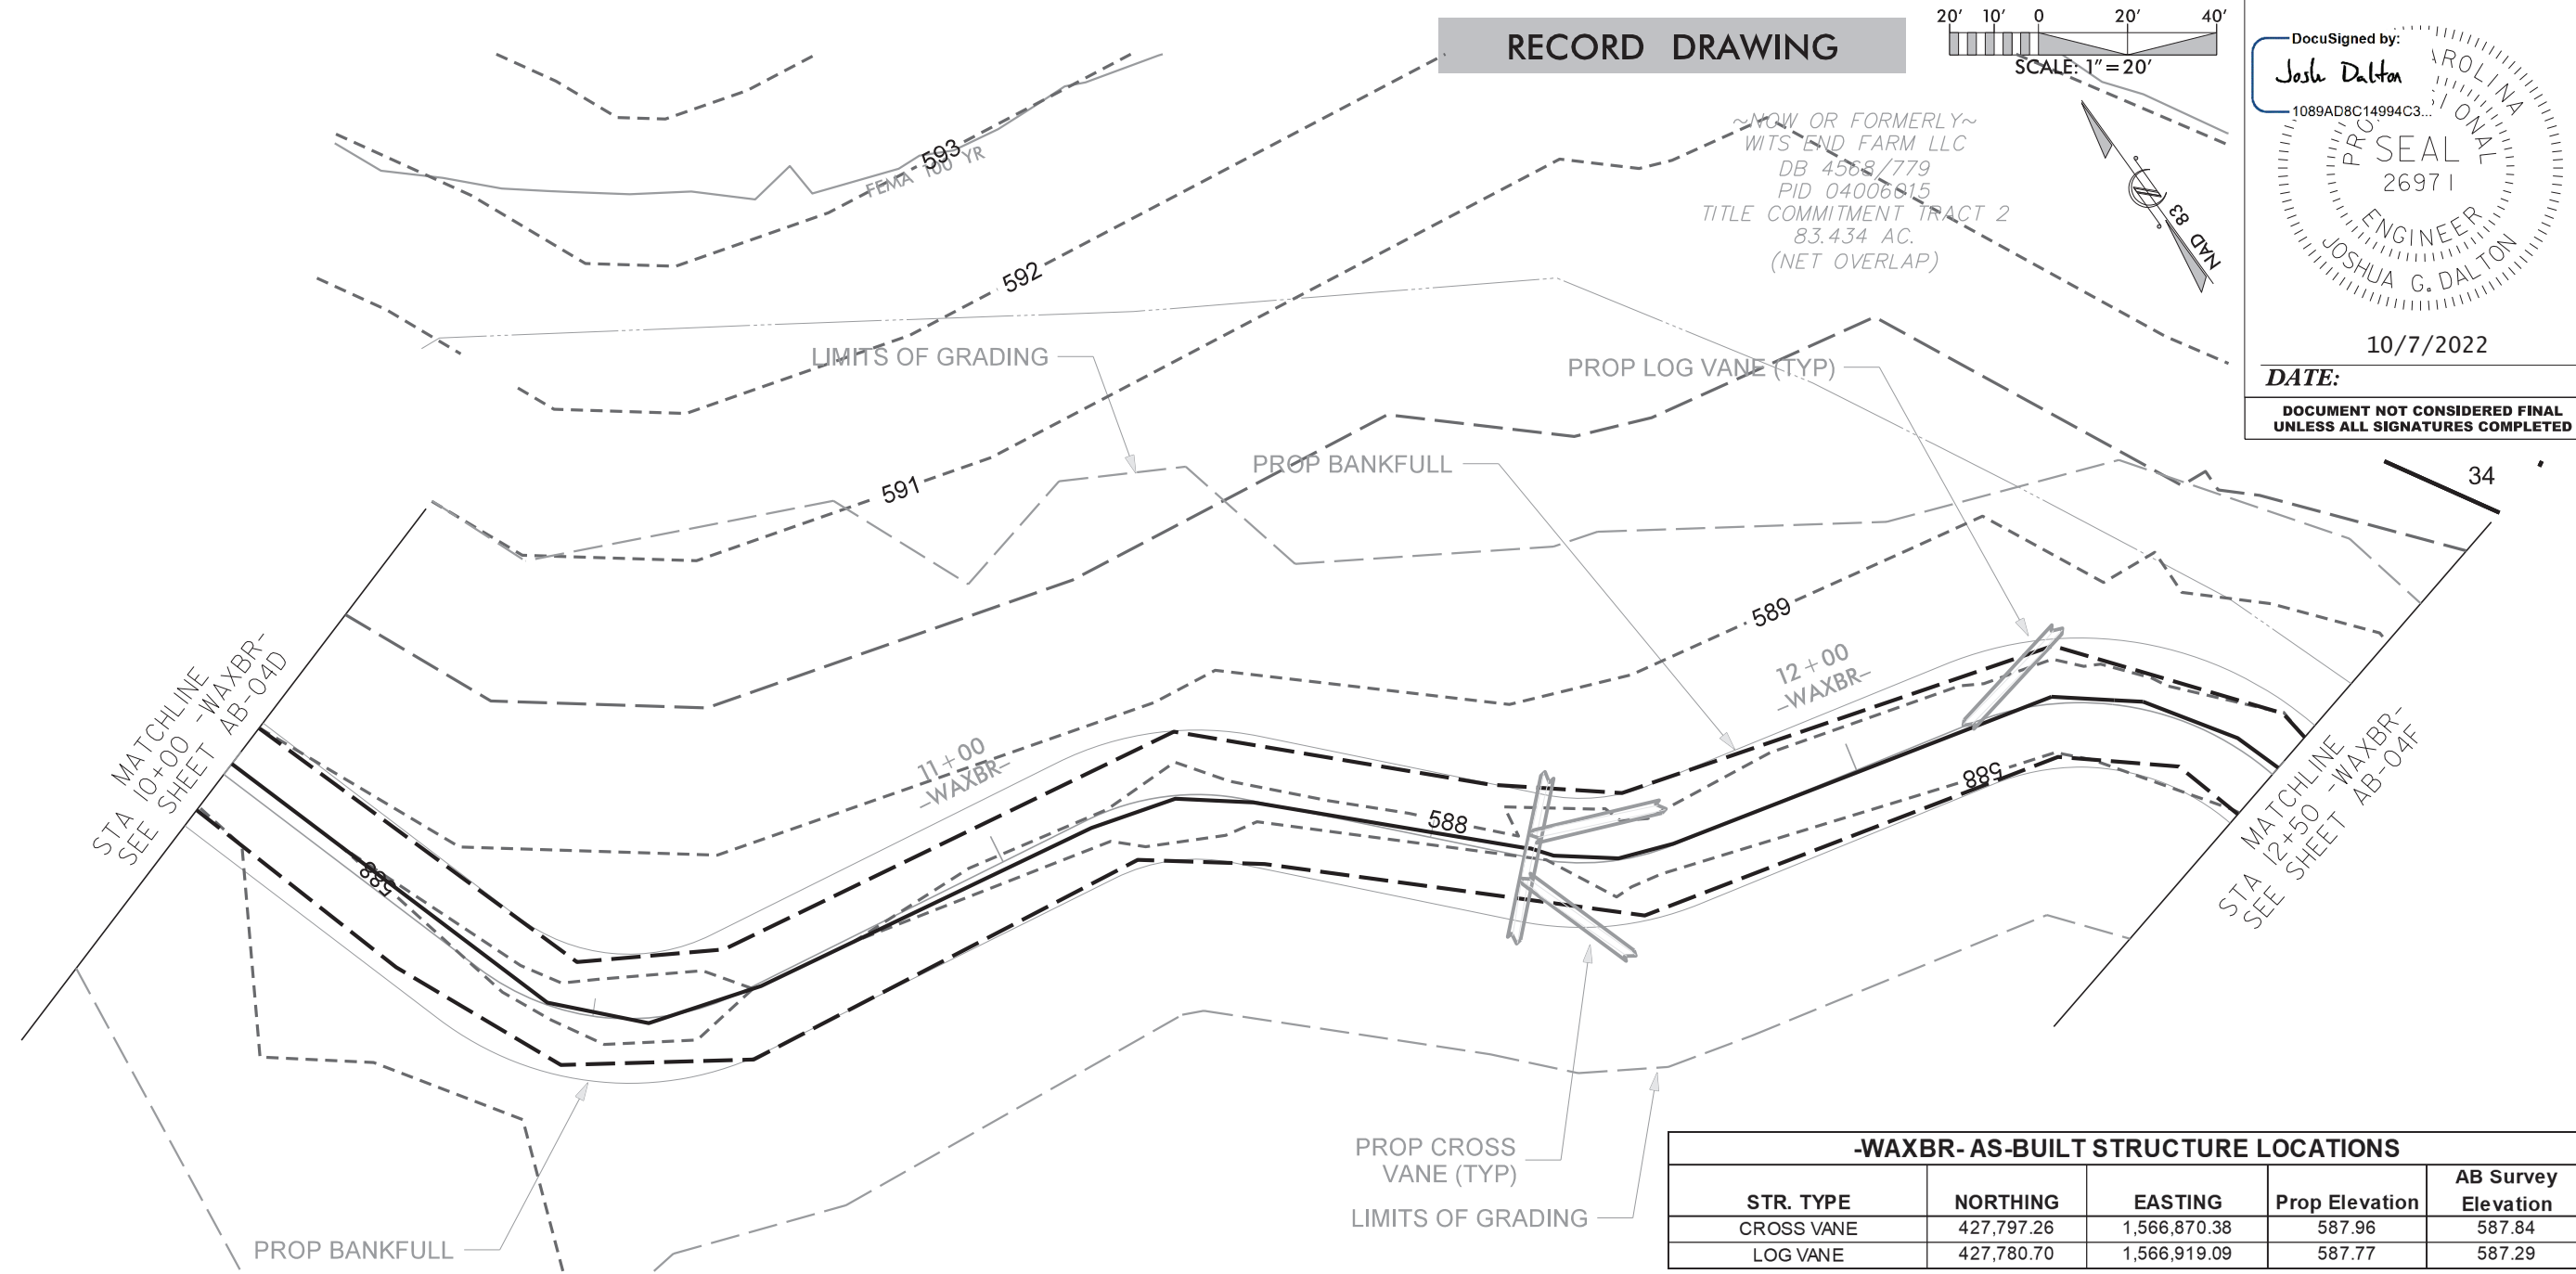

**-WAXBR- AS-BUILT STRUCTURE LOCATIONS**

STR. TYPE	NORTHING	EASTING	Prop Elevation	AB Survey Elevation
CROSS VANE	427,797.26	1,566,870.38	587.96	587.84
LOG VANE	427,780.70	1,566,919.09	587.77	587.29

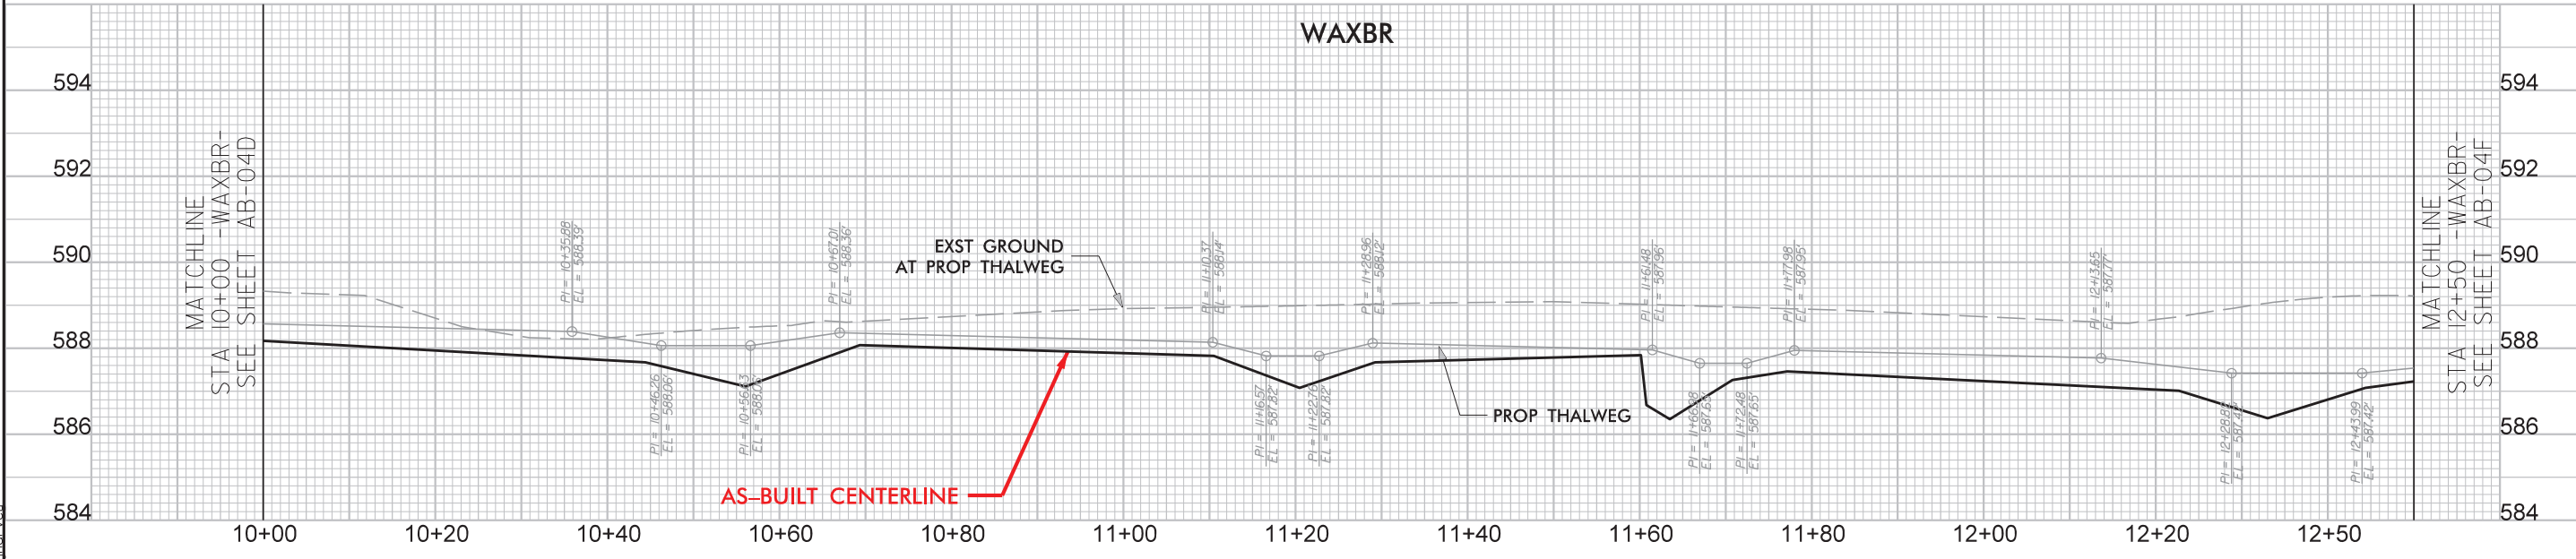



© 2021 SUNGATE DESIGN GROUP, P.A. THIS DRAWING AND ALL REPRODUCTIONS OF IT ARE THE SOLE PROPERTY OF SDG. REPRODUCTION OR OTHER USES OF THIS DRAWING WITHOUT WRITTEN CONSENT OF SDG IS NOT PERMITTED.

**WITS END**  
 UNION COUNTY, NC  
**AS-BUILT STRUCTURES**

PROJECT #: 1221-20024  
 DRAWING NAME: WITS END PSH AB-04E  
 DATE: 2022  
 DRAWN BY: JRH  
 REVIEWED BY: JGD  
 REVISIONS:  
 SHEET NO. **AB-04E**

10/6/2022  
 Wits\_End\_Psh\_AB-04E.dgn





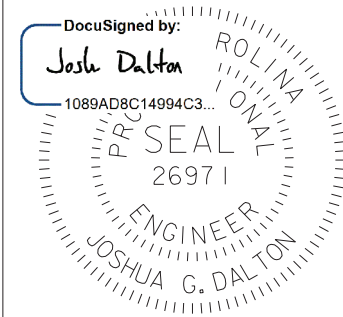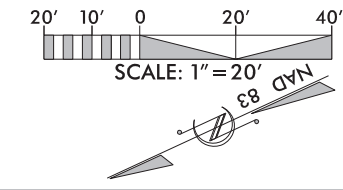

DATE: 10/7/2022

DOCUMENT NOT CONSIDERED FINAL  
UNLESS ALL SIGNATURES COMPLETED

**SUNGATE DESIGN GROUP, P.A.**  
900 GARDEN ROAD  
SUITE 200  
FARMINGTON, NC 27834  
TEL: (919) 856-2243  
ENG. FIRM LICENSE NO. C-980

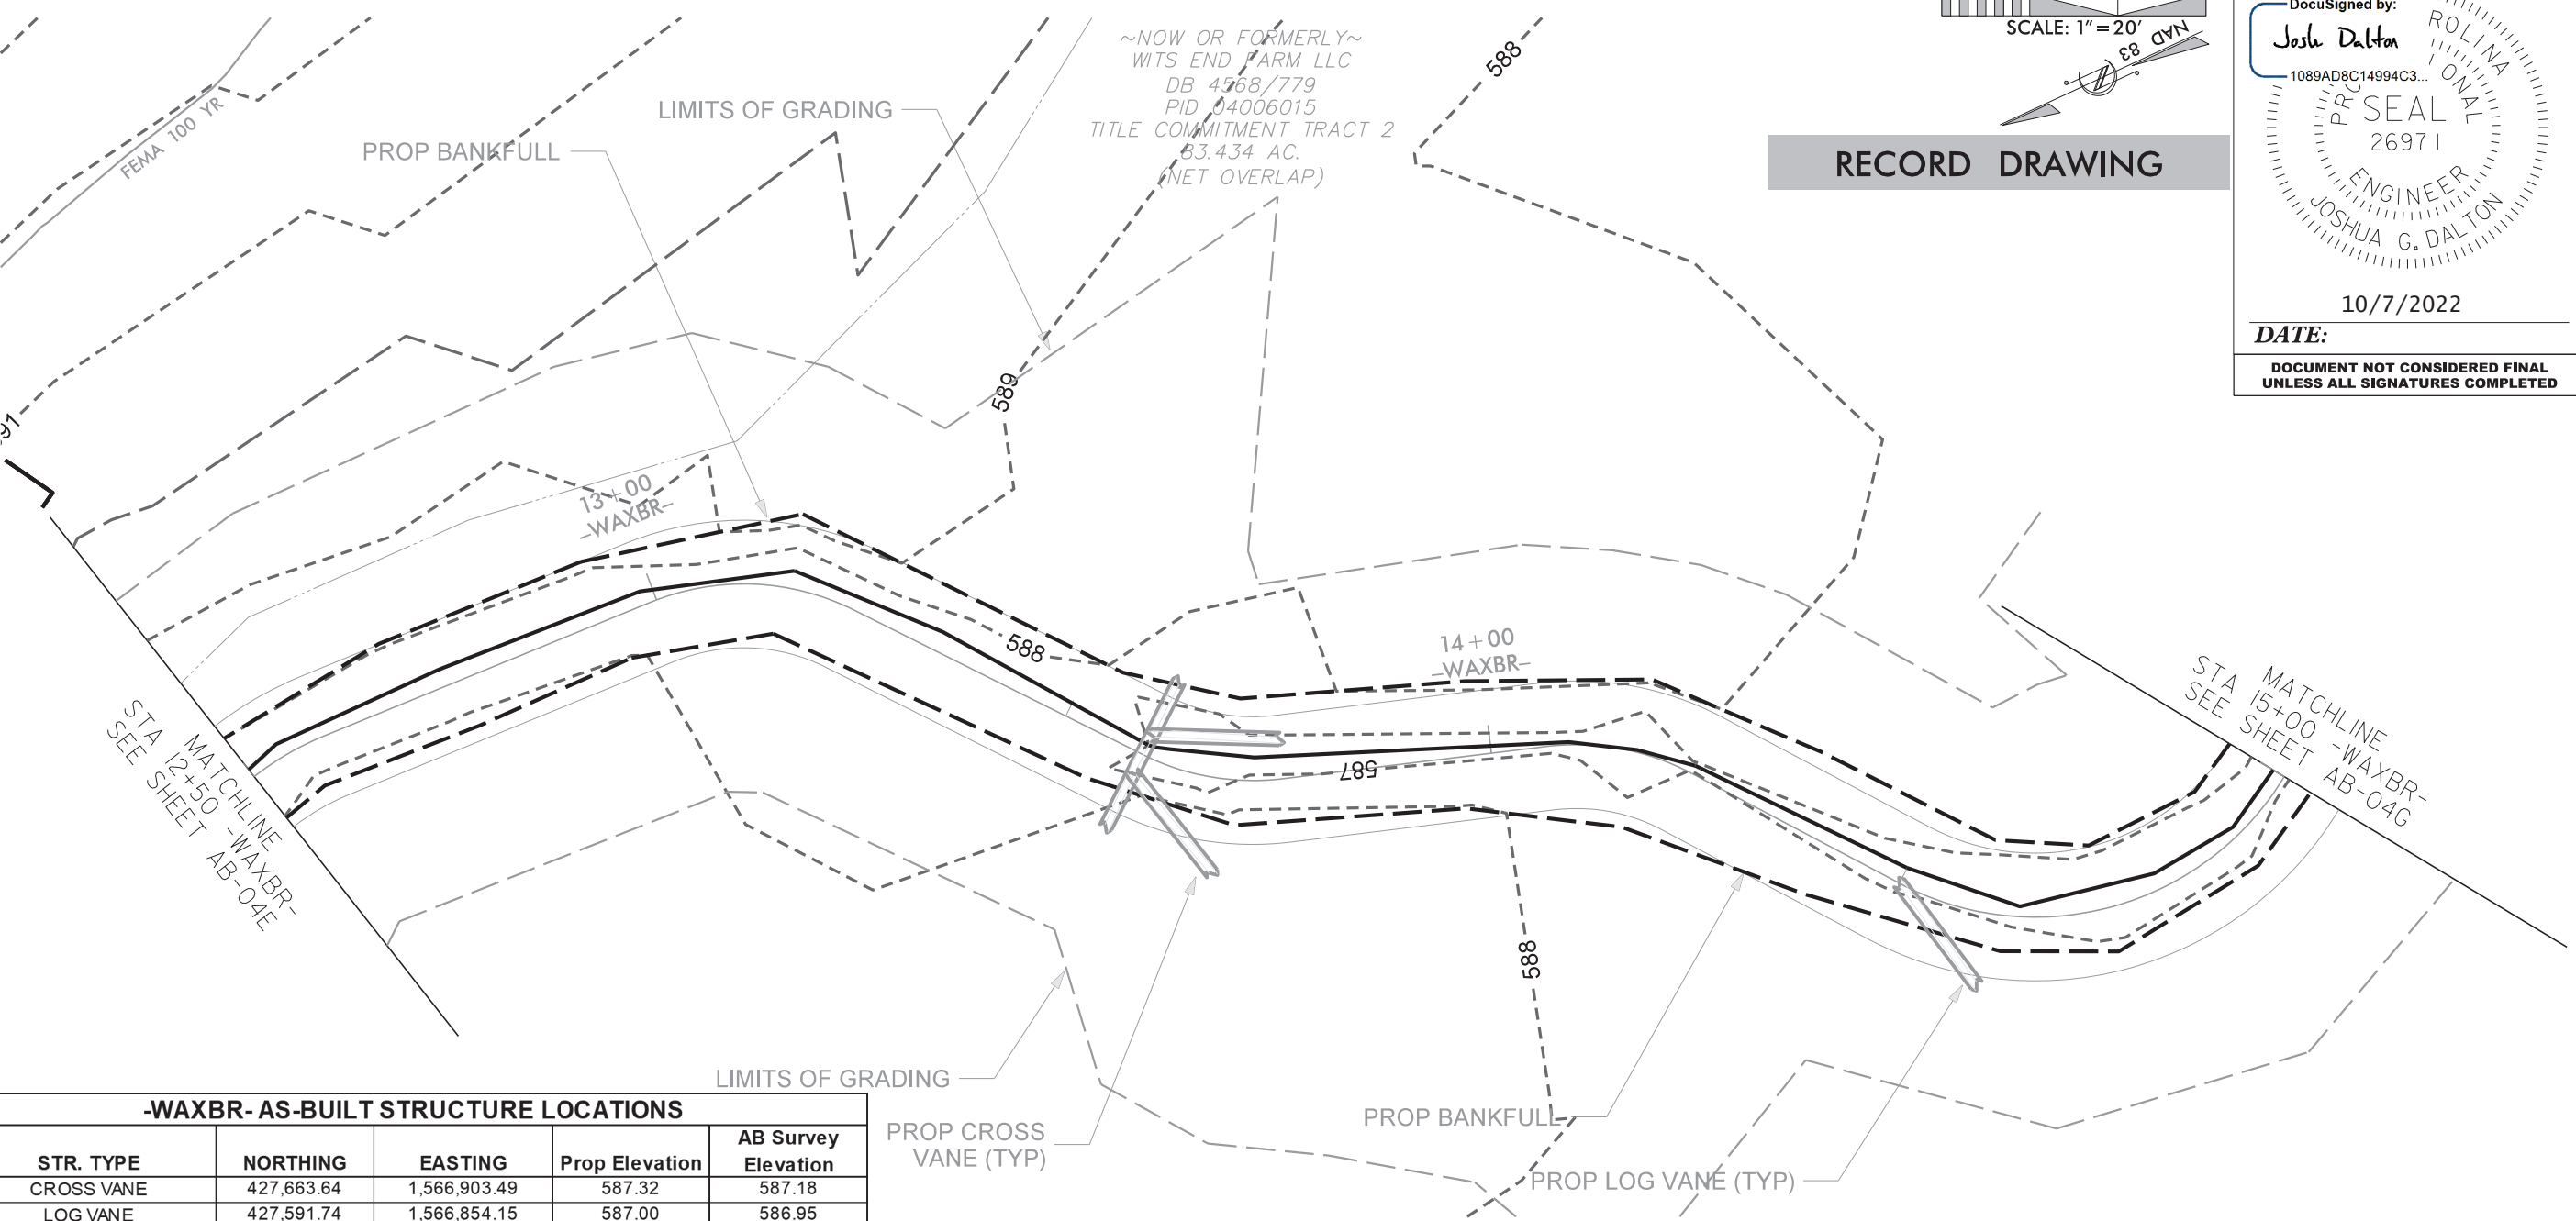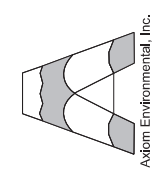


~NOW OR FORMERLY~  
WITS END FARM LLC  
DB 4568/779  
PID 04006015  
TITLE COMMITMENT TRACT 2  
83.434 AC.  
(NET OVERLAP)

**RECORD DRAWING**

**-WAXBR- AS-BUILT STRUCTURE LOCATIONS**

STR. TYPE	NORTHING	EASTING	Prop Elevation	AB Survey Elevation
CROSS VANE	427,663.64	1,566,903.49	587.32	587.18
LOG VANE	427,591.74	1,566,854.15	587.00	586.95

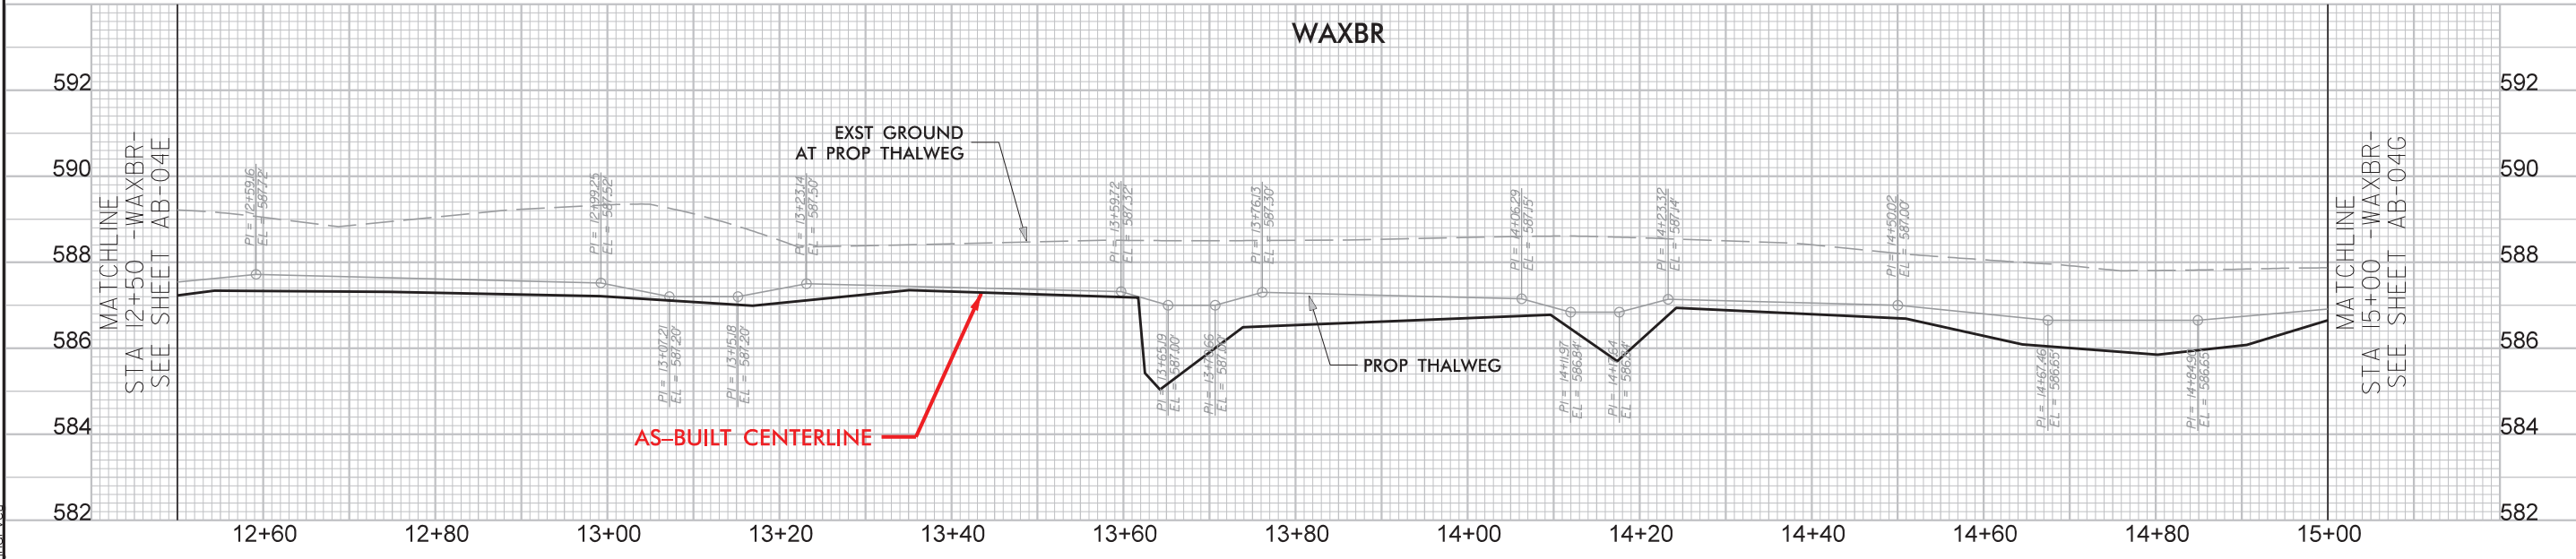

10/6/2022  
Wits\_End\_Psh\_AB-04F.dgn

© 2022 SUNGATE DESIGN GROUP, P.A. THIS DRAWING AND ALL REPRODUCTIONS OF IT ARE THE SOLE PROPERTY OF SDG. REPRODUCTION OR OTHER USES OF THIS DRAWING WITHOUT WRITTEN CONSENT OF SDG IS NOT PERMITTED.

**WITS END**  
UNION COUNTY, NC


**AS-BUILT STRUCTURES**

PROJECT # : 1221-20024  
DRAWING NAME: WITS END PSH AB-04F  
DATE: 2022  
DRAWN BY: JRH  
REVIEWED BY: JGD  
REVISIONS:


SHEET NO.  
**AB-04F**

-WAXBR- AS-BUILT STRUCTURE LOCATIONS				
STR. TYPE	NORTHING	EASTING	Prop Elevation	AB Survey Elevation
CROSS VANE	427,516.35	1,566,870.82	586.77	586.47
CROSS VANE	427,384.53	1,566,915.61	586.26	586.51

~NOW OR FORMERLY~  
 WITS END FARM LLC  
 DB 4568/779  
 PID 04006015  
 TITLE COMMITMENT TRACT 2  
 83.434 AC.  
 (NET OVERLAP)

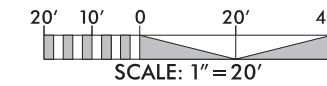




**RECORD DRAWING**

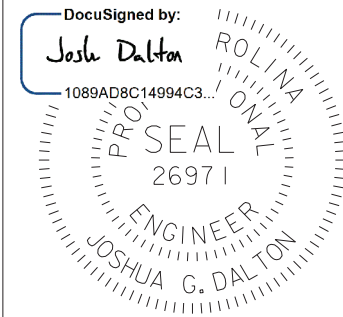

DATE: 10/7/2022

DOCUMENT NOT CONSIDERED FINAL  
 UNLESS ALL SIGNATURES COMPLETED

**SUNGATE DESIGN GROUP, P.A.**  
 8908 S. FRANKLIN ROAD  
 SUITE 200  
 CHARLOTTE, NC 27866  
 TEL: (919) 855-2243  
 ENG FIRM LICENSE NO. C-980

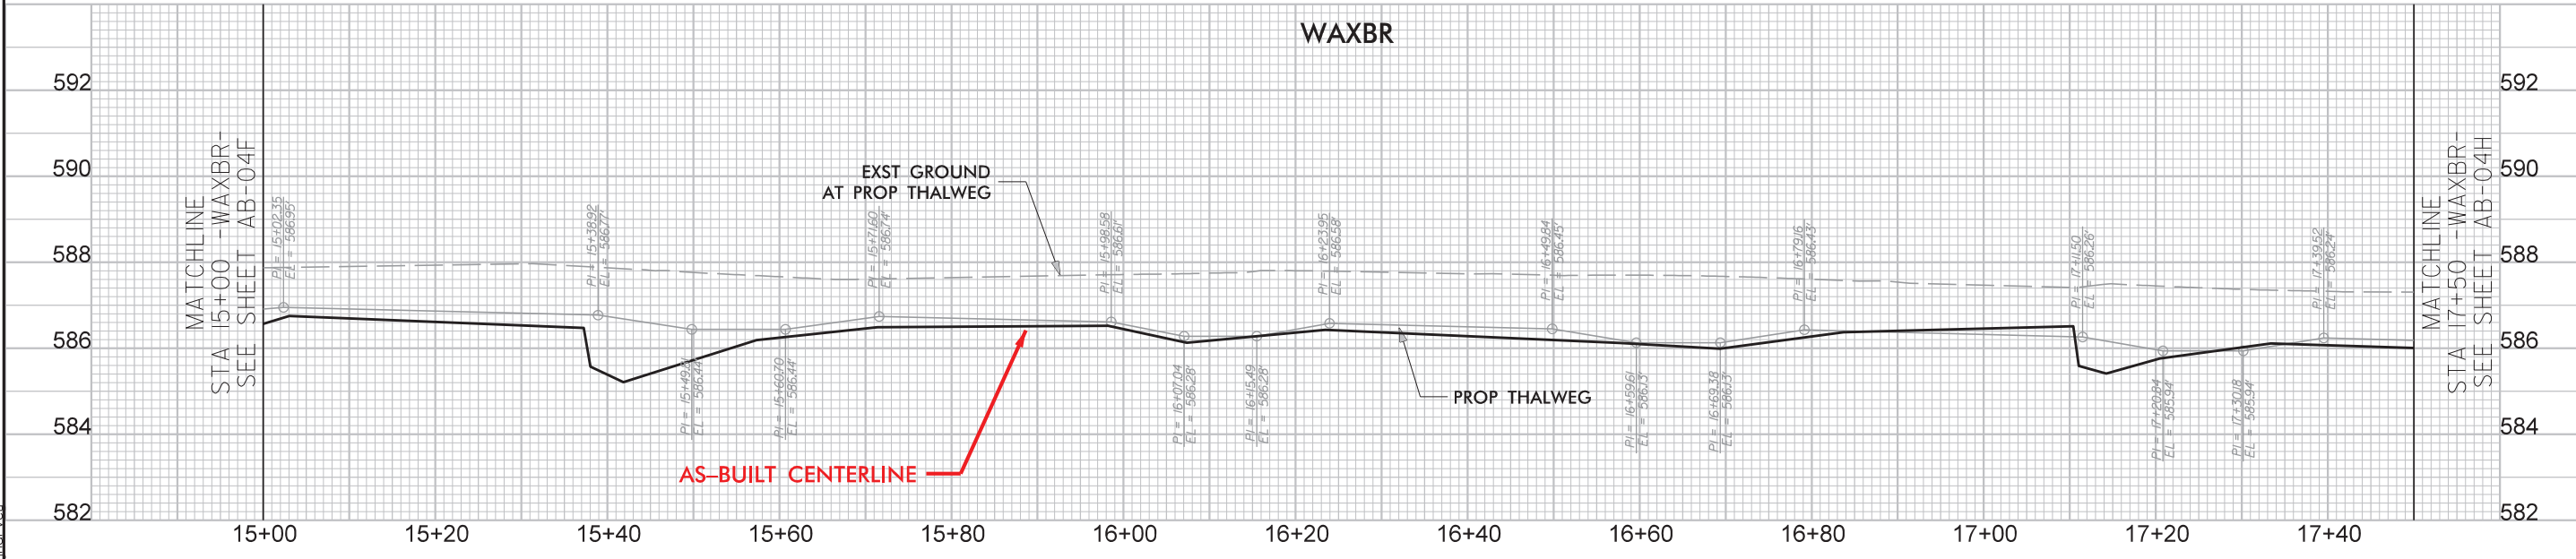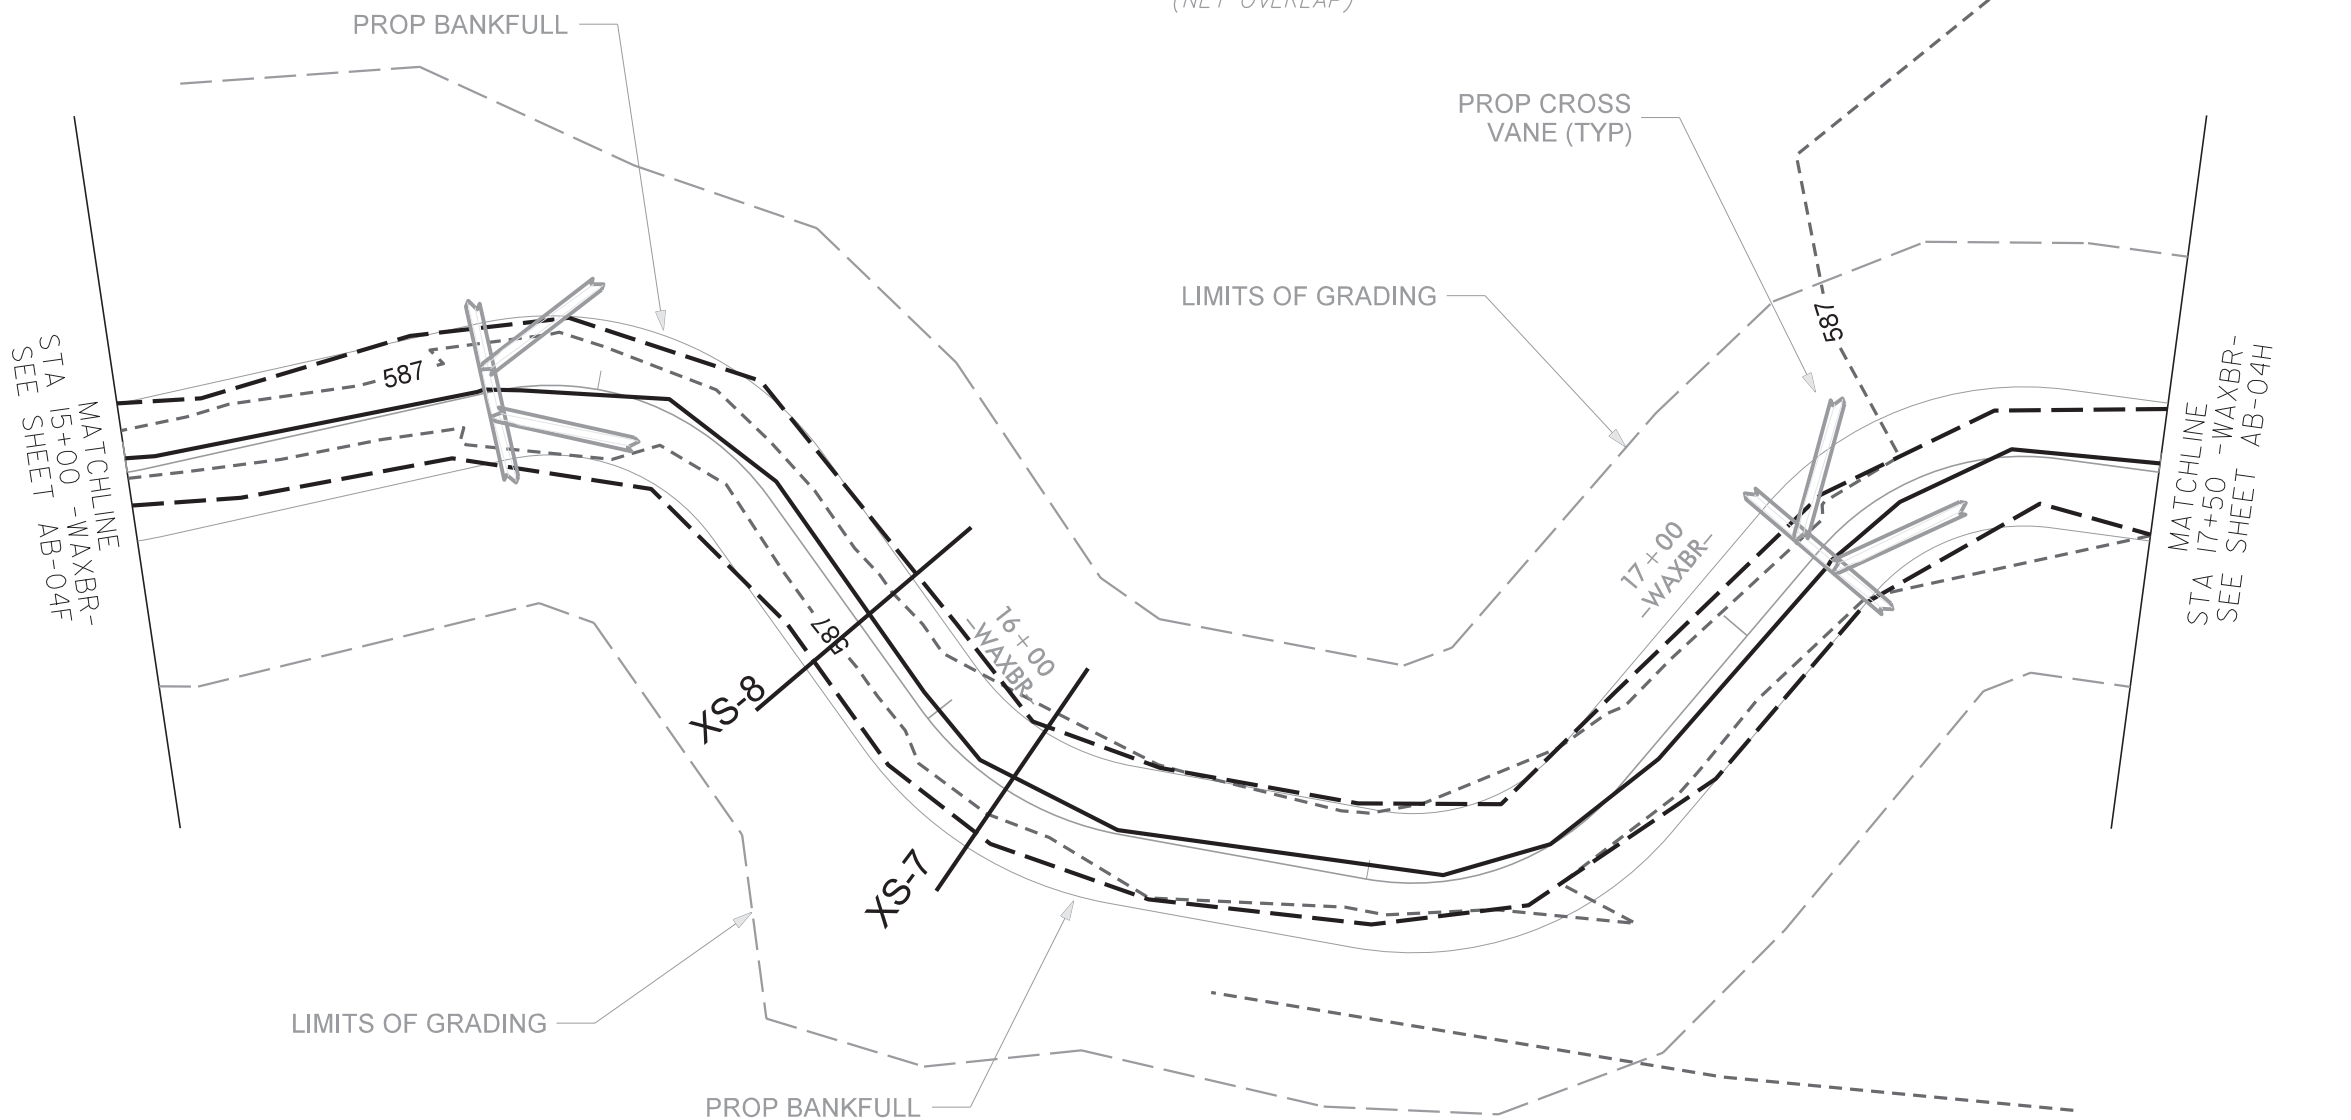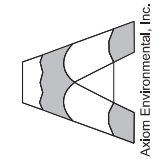

10/6/2022  
 Wits\_End\_Psh\_AB-04G.dgn



© 2022 SUNGATE DESIGN GROUP, P.A. THIS DRAWING AND ALL REPRODUCTIONS OF IT ARE THE SOLE PROPERTY OF SDG. REPRODUCTION OR OTHER USES OF THIS DRAWING WITHOUT WRITTEN CONSENT OF SDG IS NOT PERMITTED.

**WITS END**  
 UNION COUNTY, NC  
**AS-BUILT STRUCTURES**

PROJECT # : 1221-20024  
 DRAWING NAME: WITS END PSH AB-04G  
 DATE: 2022  
 DRAWN BY: JRH  
 REVIEWED BY: JGD  
 REVISIONS:  
 SHEET NO. **AB-04G**

**-UT 2- AS-BUILT STRUCTURE LOCATIONS**

STR. TYPE	NORTHING	EASTING	Prop Elevation	AB Survey Elevation
CROSS VANE	427,208.00	1,567,002.19	586.06	

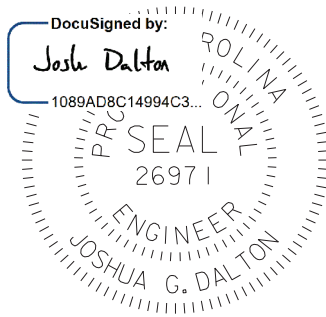
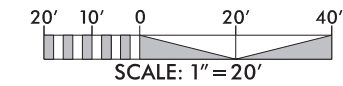


DATE: 10/7/2022

DOCUMENT NOT CONSIDERED FINAL UNLESS ALL SIGNATURES COMPLETED


**RECORD DRAWING**

**SUNGATE DESIGN GROUP, P.A.**  
 8308 W. WINDY HILL ROAD  
 SUITE 200  
 WAXHAM, NC 27086  
 TEL: (919) 855-2243  
 ENG. FIRM LICENSE NO. C-980

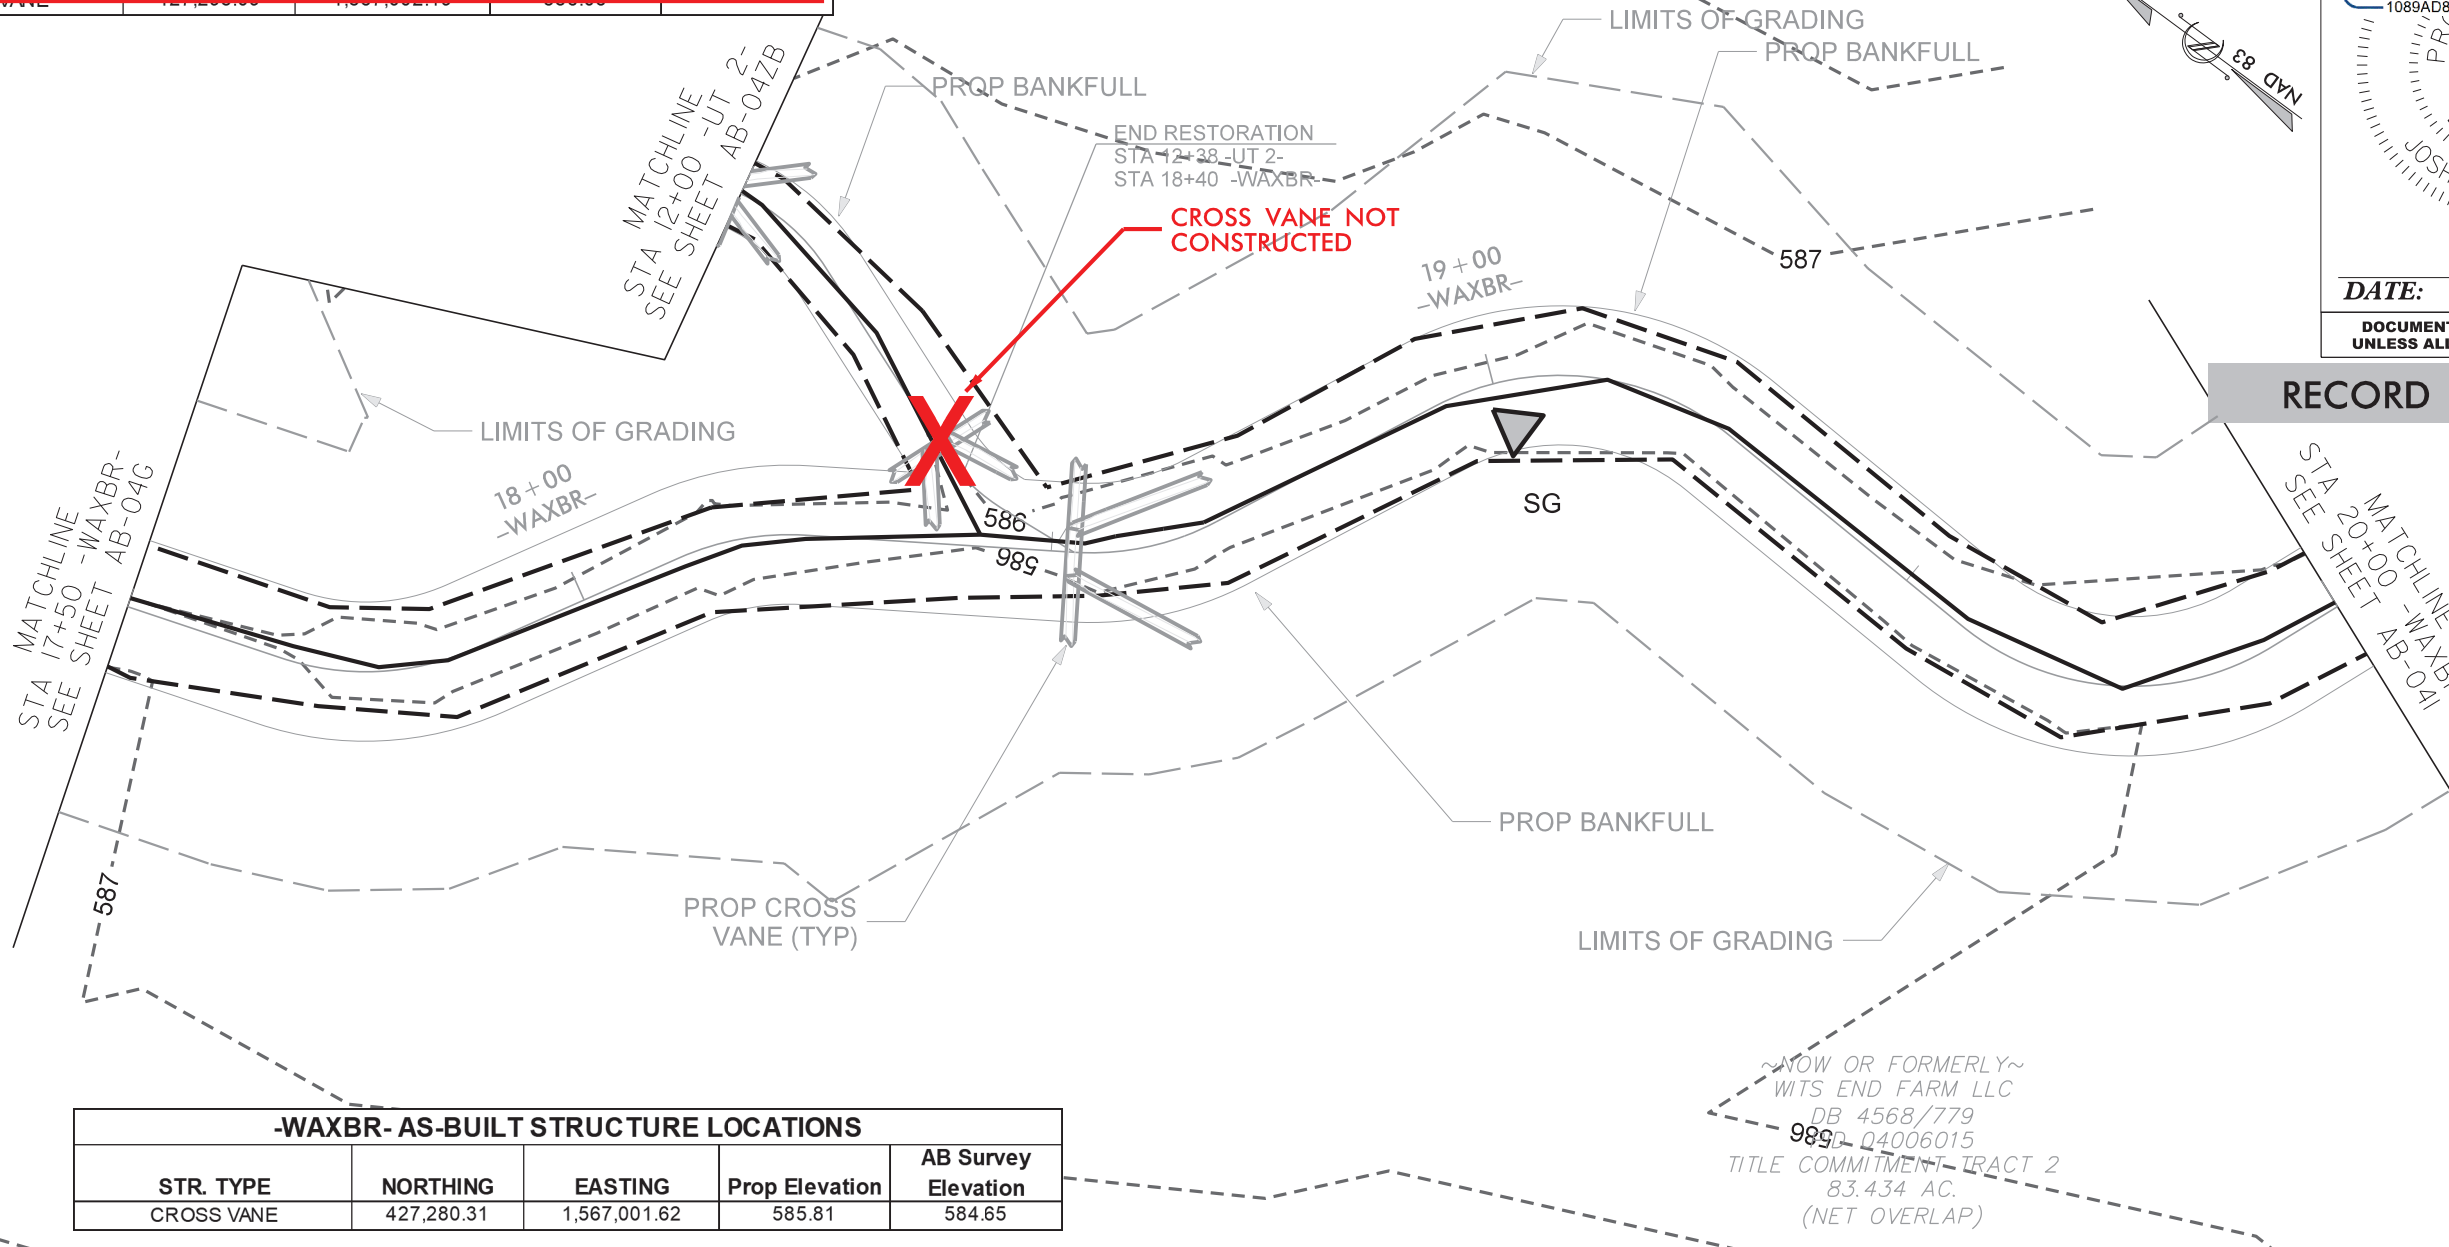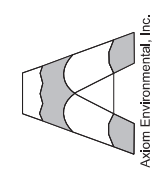

**-WAXBR- AS-BUILT STRUCTURE LOCATIONS**

STR. TYPE	NORTHING	EASTING	Prop Elevation	AB Survey Elevation
CROSS VANE	427,280.31	1,567,001.62	585.81	584.65

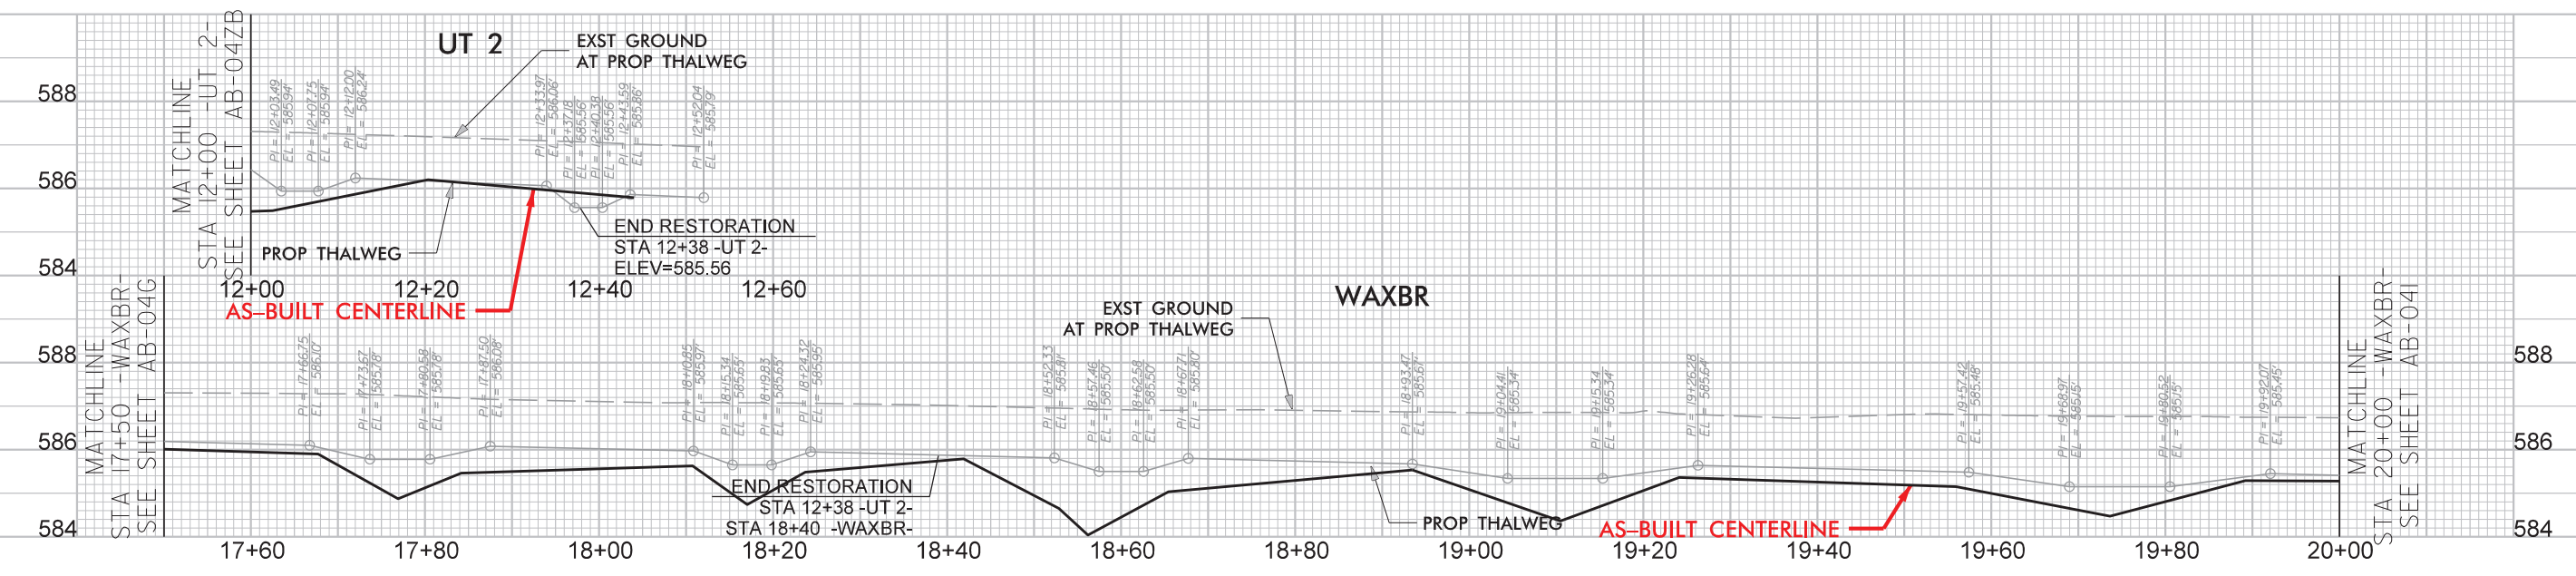

10/6/2022 Wits\_End\_Psh\_AB-04I.dgn


© 2021 SUNGATE DESIGN GROUP, P.A. THIS DRAWING AND ALL REPRODUCTIONS OF IT ARE THE SOLE PROPERTY OF SDG. REPRODUCTION OR OTHER USES OF THIS DRAWING WITHOUT WRITTEN CONSENT OF SDG IS NOT PERMITTED.

PROJECT # : 1221-20024  
 DRAWING NAME: WITS END PSH AB-04H  
 DATE: 2022  
 DRAWN BY: JRH  
 REVIEWED BY: JGD  
 REVISIONS:

SHEET NO. **AB-04H**


**WITS END**  
 UNION COUNTY, NC  
**AS-BUILT STRUCTURES**



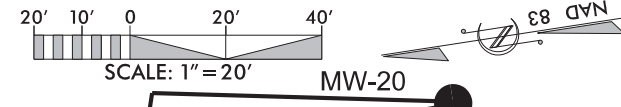


DocuSigned by:  
**Josh Dalton**  
 1089AD8C14994C3...  
 PROJECT SEAL  
 26971  
 ENGINEER  
**JOSHUA G. DALTON**  
 DATE: 10/7/2022  
 DOCUMENT NOT CONSIDERED FINAL  
 UNLESS ALL SIGNATURES COMPLETED

**SUNGATE DESIGN GROUP, P.A.**  
 950 GARDNER ROAD  
 SUITE 200  
 WILSON, NC 27606  
 TEL: (919) 855-2243  
 ENG. FIRM LICENSE NO. C-980

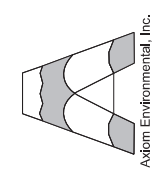


**RECORD DRAWING**

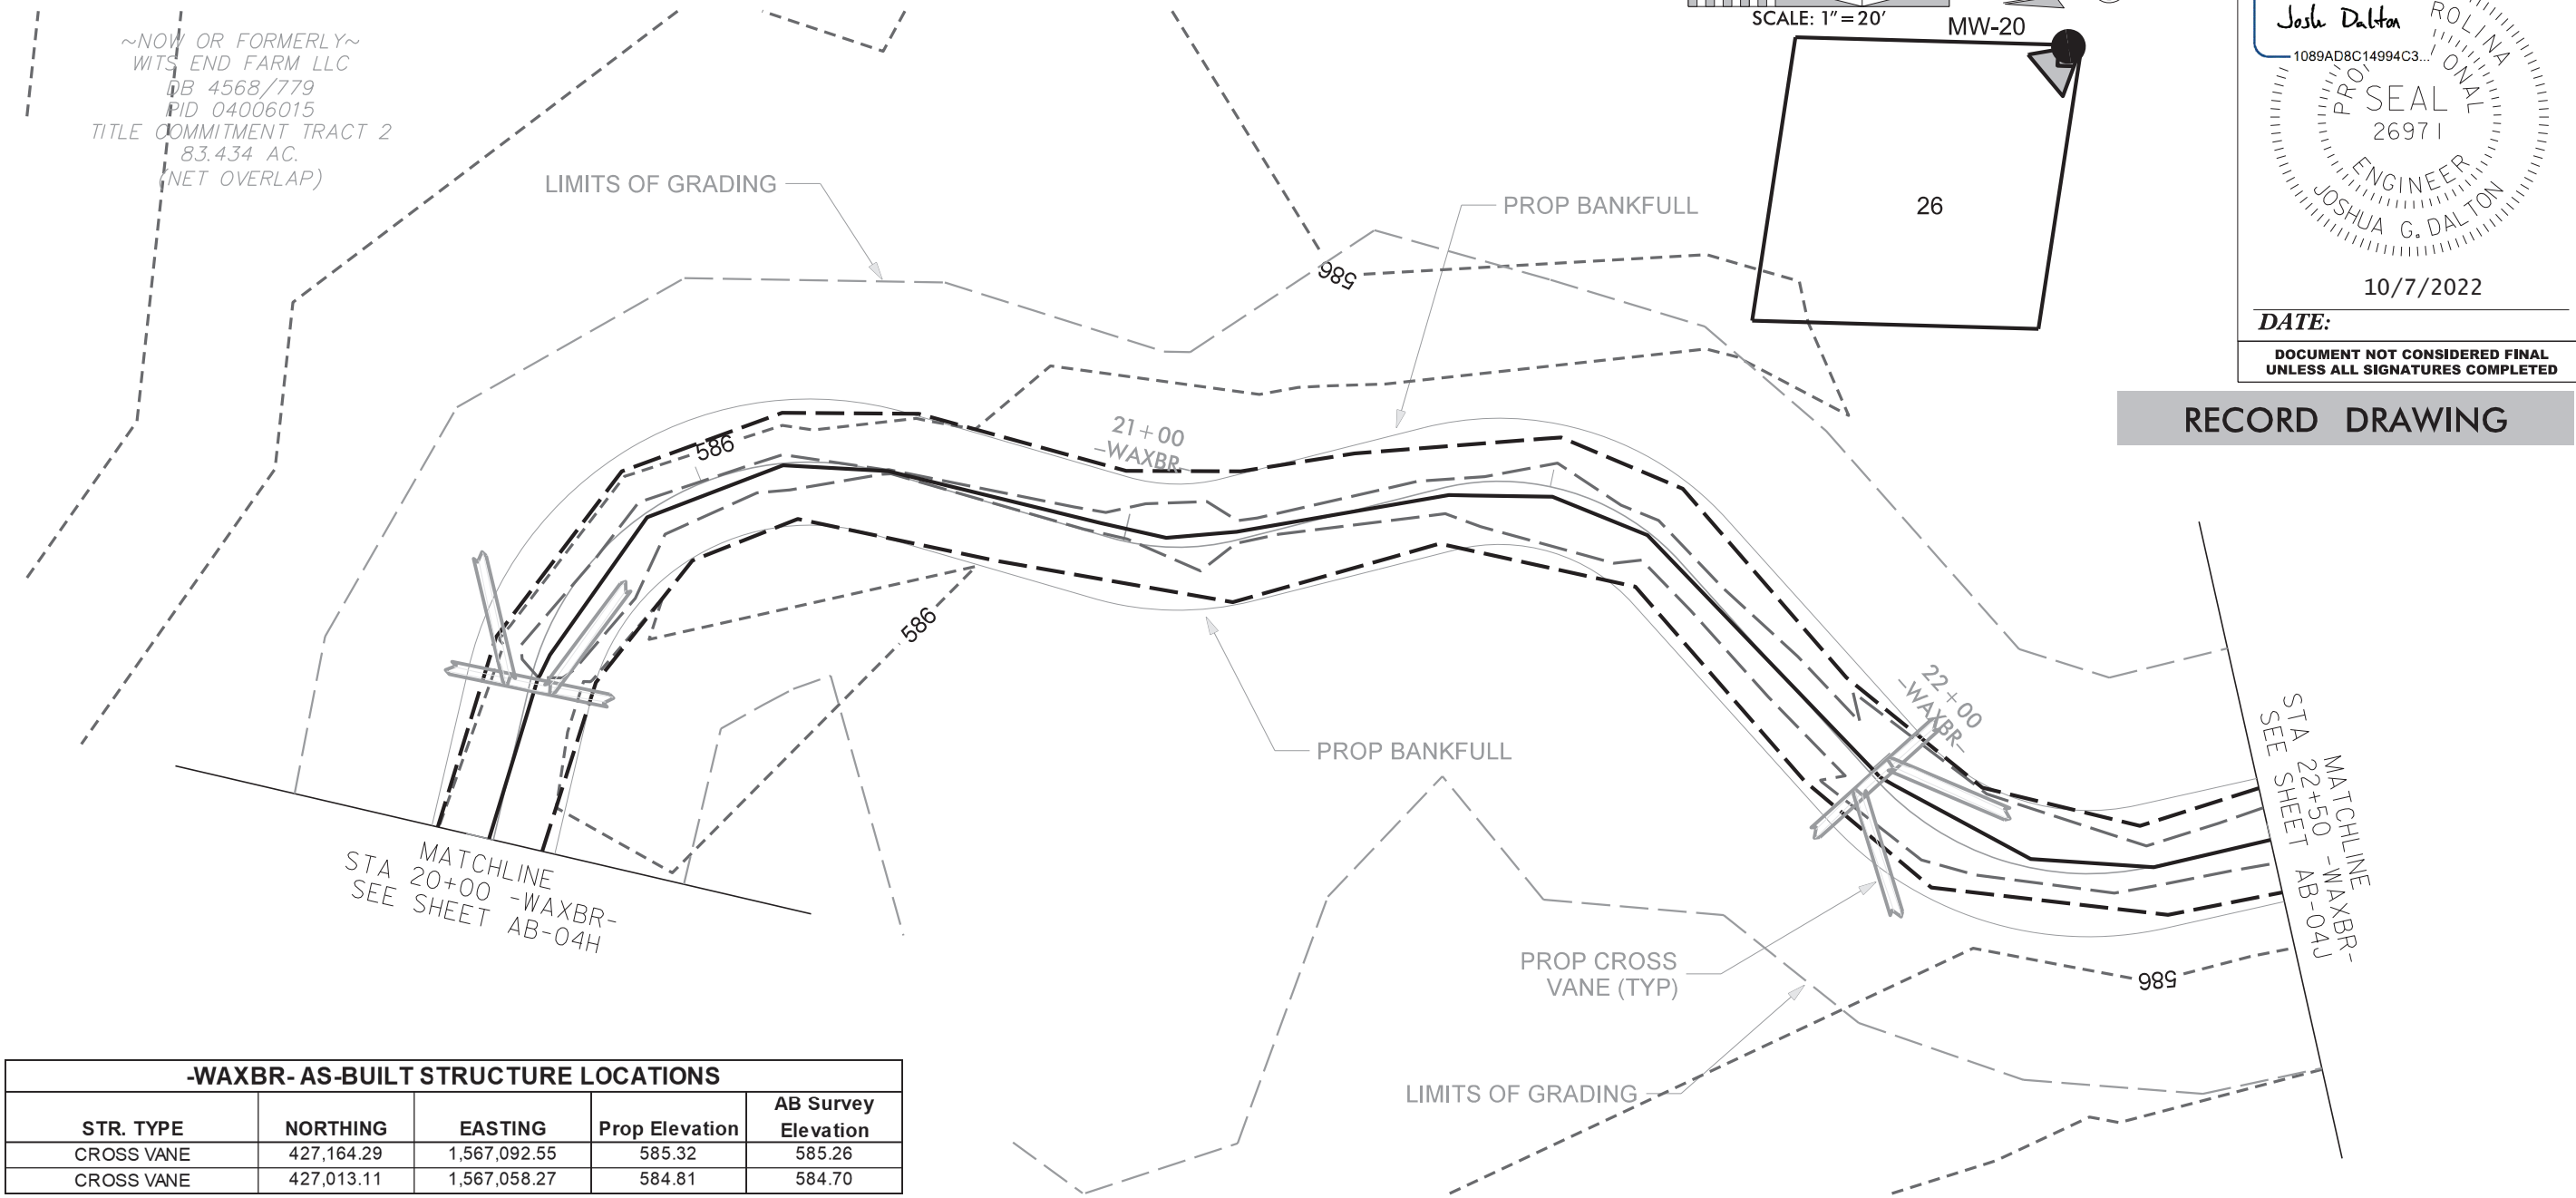

**-WAXBR- AS-BUILT STRUCTURE LOCATIONS**

STR. TYPE	NORTHING	EASTING	Prop Elevation	AB Survey Elevation
CROSS VANE	427,164.29	1,567,092.55	585.32	585.26
CROSS VANE	427,013.11	1,567,058.27	584.81	584.70

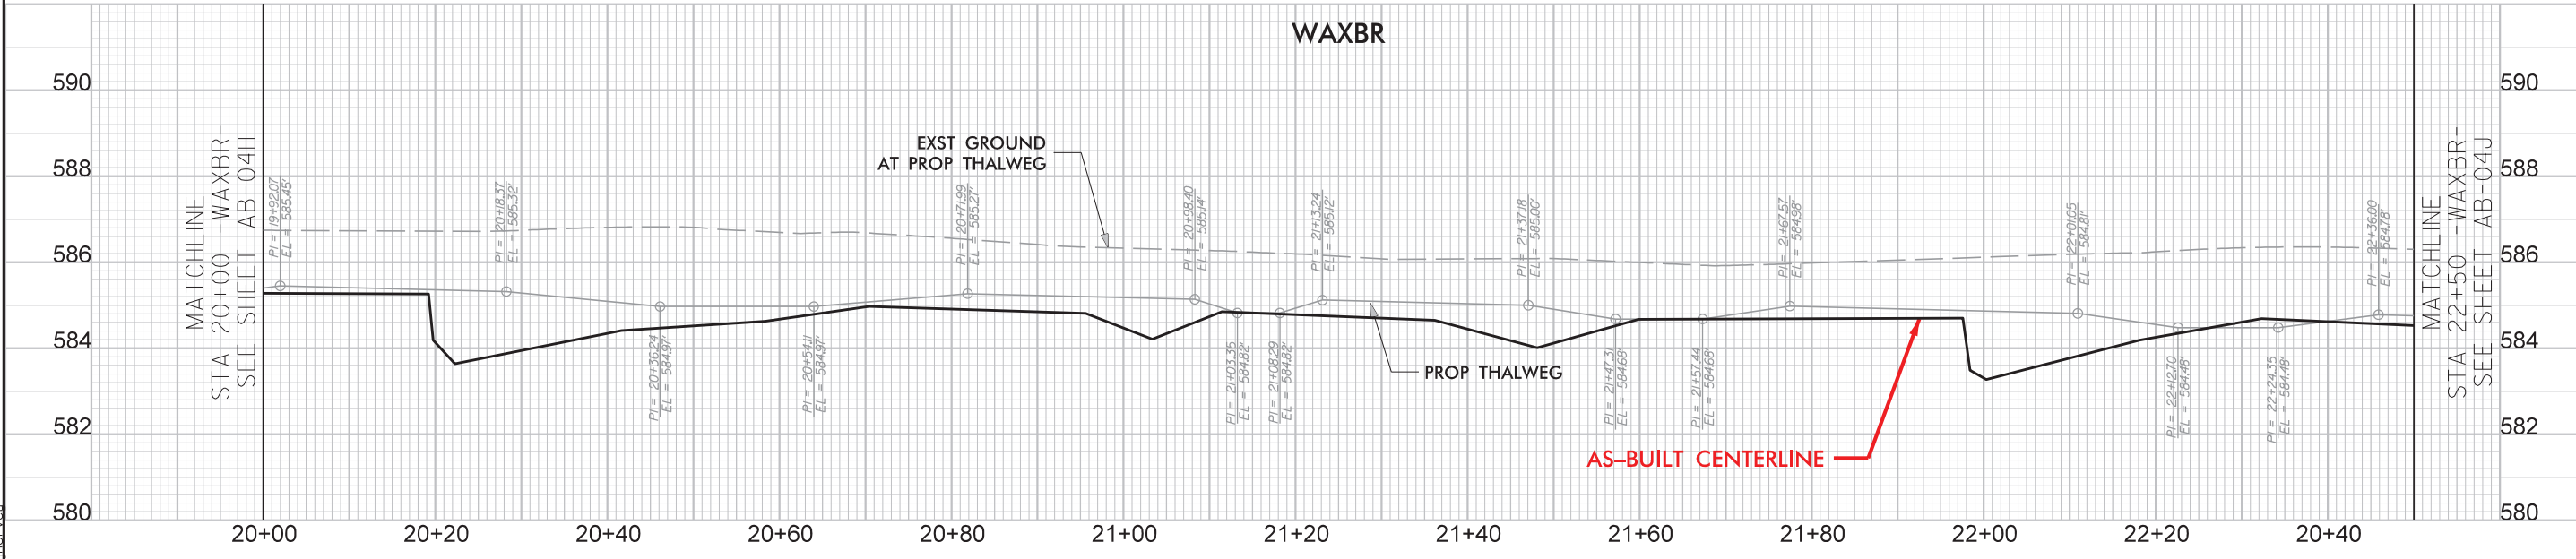

© 2022 SUNGATE DESIGN GROUP, P.A. THIS DRAWING AND ALL REPRODUCTIONS OF IT ARE THE SOLE PROPERTY OF SDG. REPRODUCTION OR OTHER USES OF THIS DRAWING WITHOUT WRITTEN CONSENT OF SDG IS NOT PERMITTED.

**WITS END**  
 UNION COUNTY, NC

**AS-BUILT STRUCTURE**



PROJECT # : 1221-20024  
 DRAWING NAME: WITS END PSH AB-04I  
 DATE: 2022  
 DRAWN BY: JRH  
 REVIEWED BY: JGD  
 REVISIONS:

SHEET NO. **AB-04I**

10/6/2022  
 Wits\_End\_Psh\_AB-04I.dgn




~NOW OR FORMERLY~  
 WITS END FARM LLC  
 DB 4568/779  
 PID 04006015  
 TITLE COMMITMENT TRACT 2  
 83.434 AC.  
 (NET OVERLAP)

-WAXBR- AS-BUILT STRUCTURE LOCATIONS				
STR. TYPE	NORTHING	EASTING	Prop Elevation	AB Survey Elevation
CROSS VANE	426,876.87	1,567,093.83	584.23	584.32
CROSS VANE	426,853.19	1,567,139.76	583.99	583.91

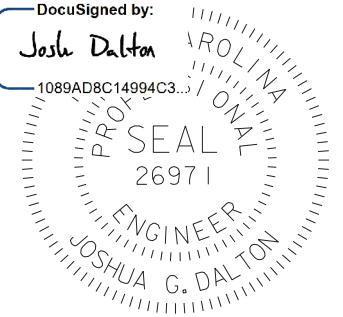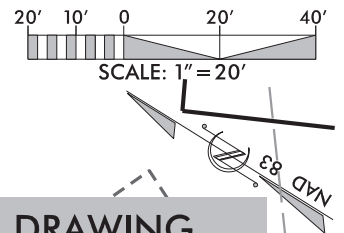

DocuSigned by:  
 Josh Dalton  
 1089AD8C14994C3...  
**DATE:** 10/7/2022  
**DOCUMENT NOT CONSIDERED FINAL UNLESS ALL SIGNATURES COMPLETED**

**SUNGATE DESIGN GROUP, P.A.**  
 890 W. GREENWOOD ROAD  
 SUITE 200 CARY, NC 27513  
 TEL: (919) 855-2243  
 ENG. FIRM LICENSE NO. C-980

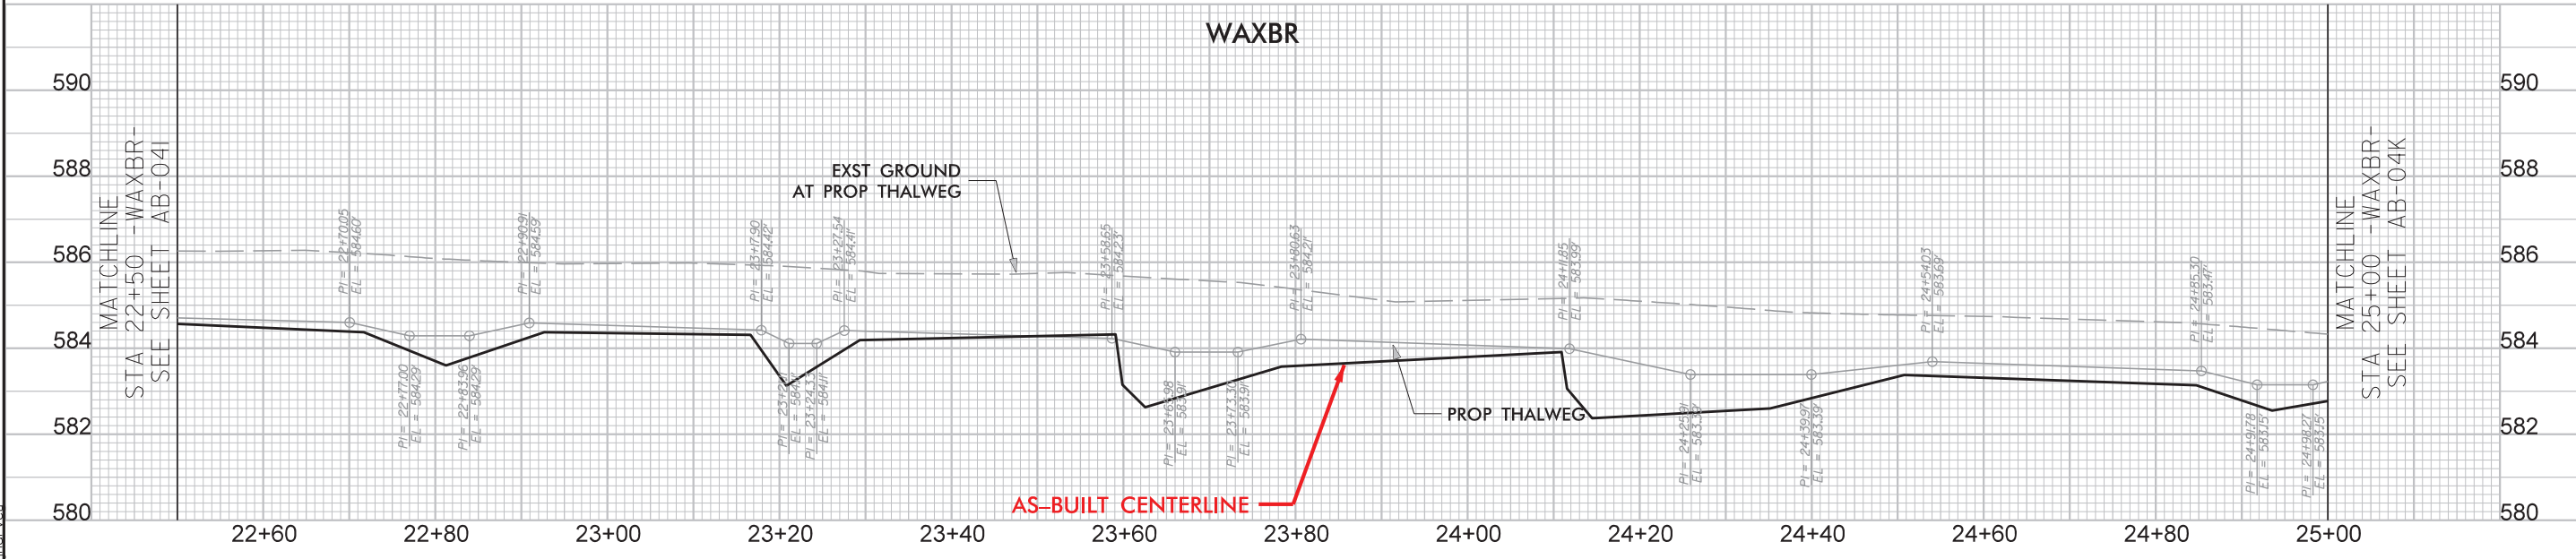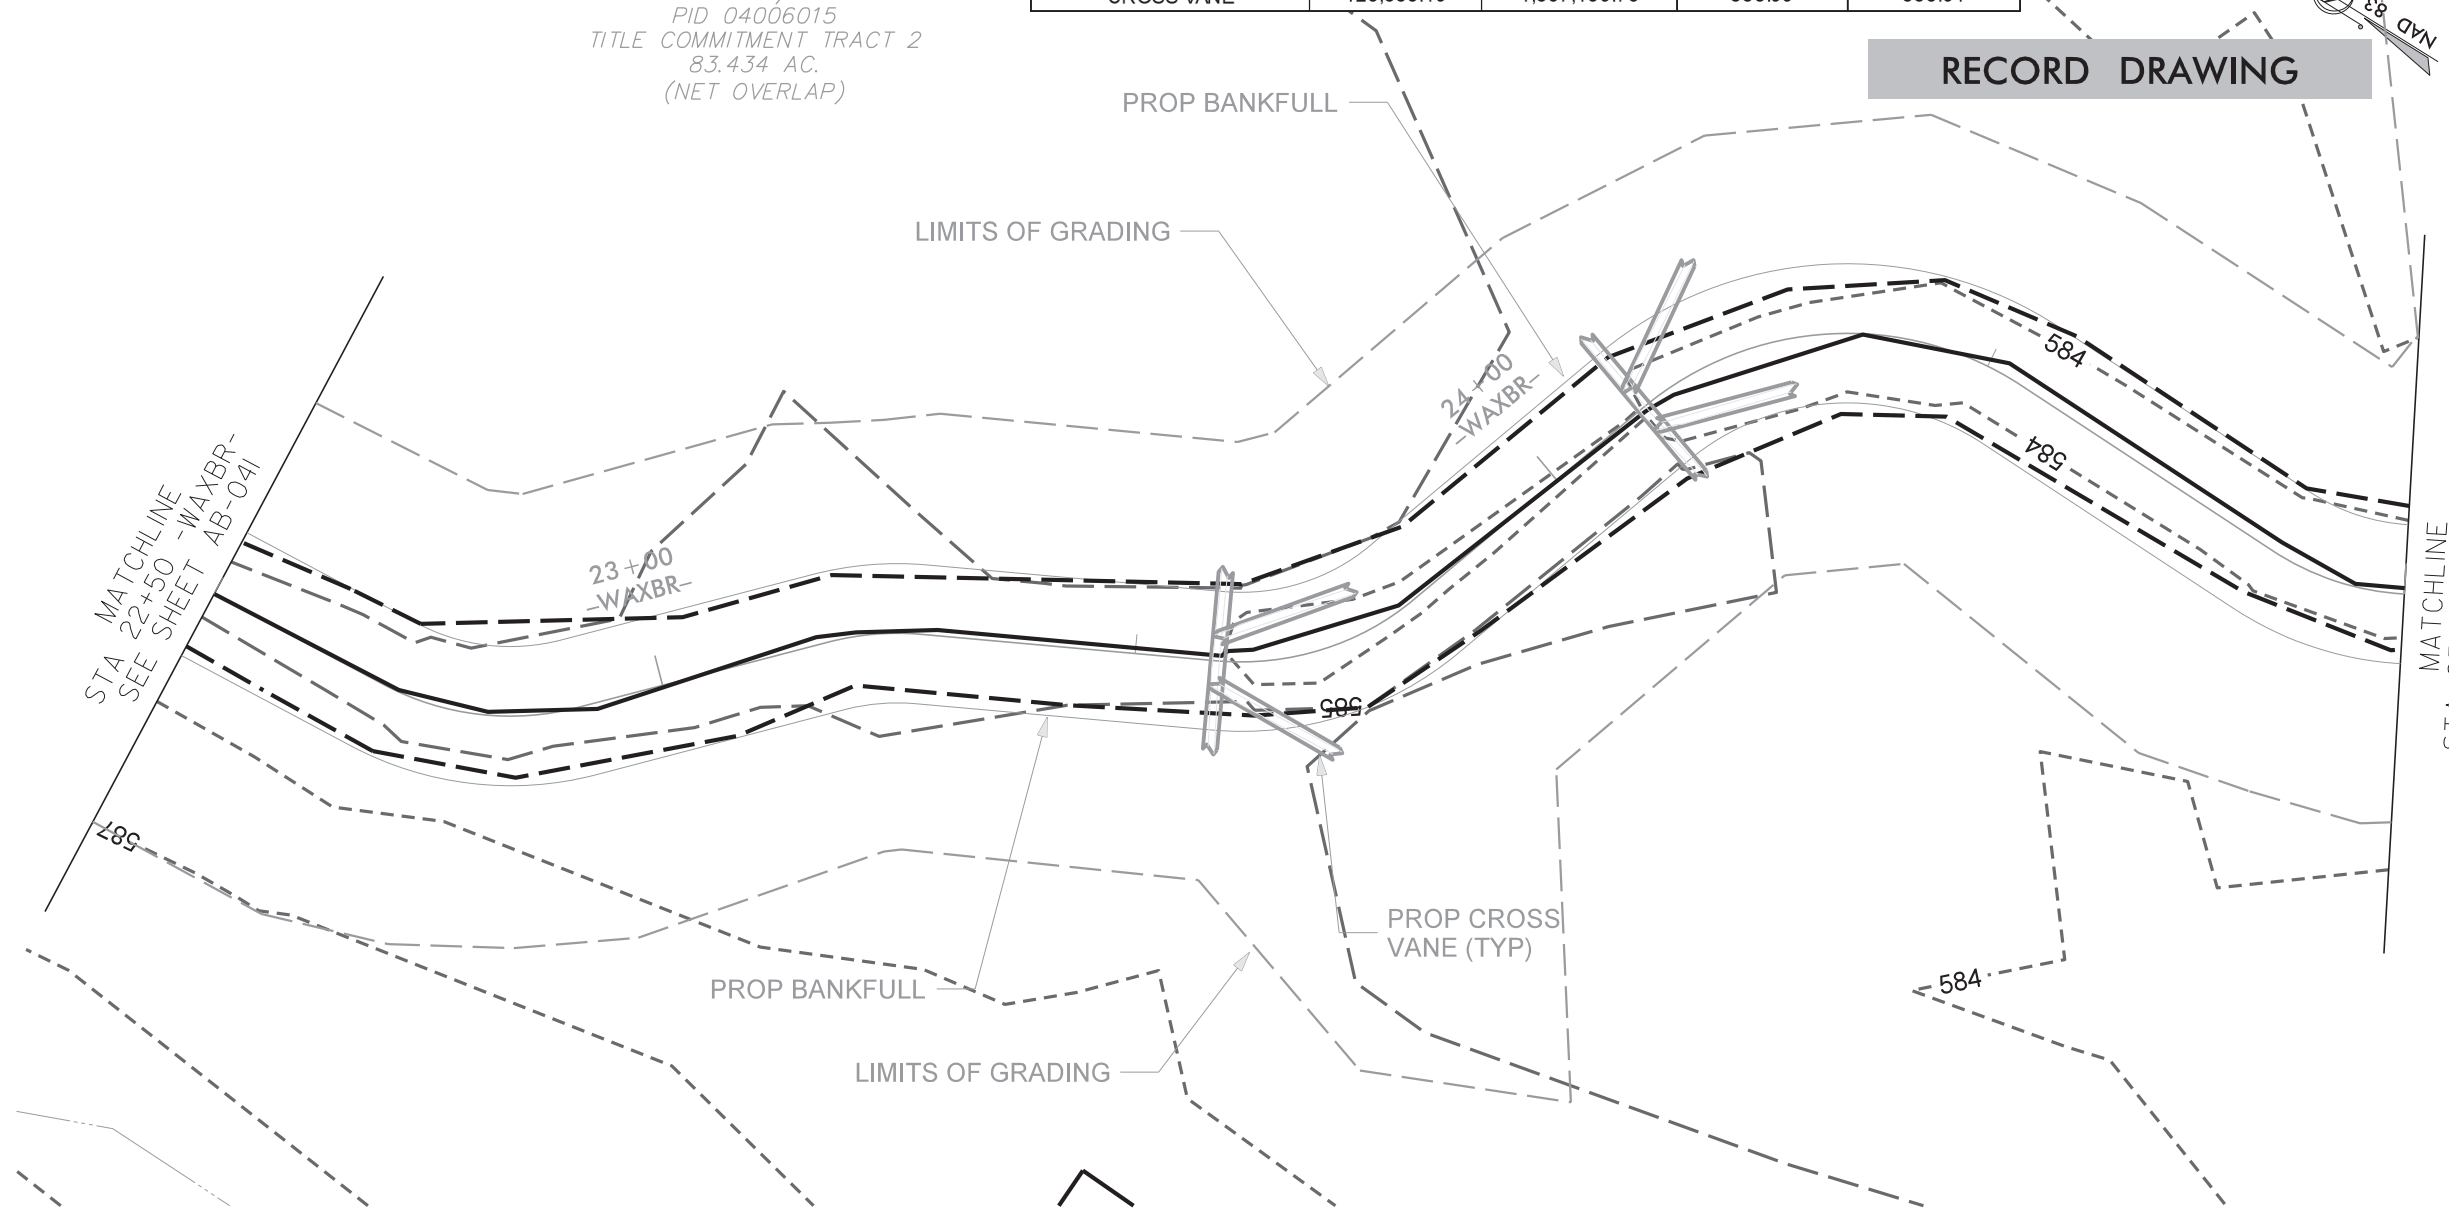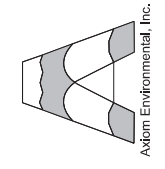


10/6/2022  
 Wits\_End\_Psh\_AB-04.dgn


© 2022 SUNGATE DESIGN GROUP, P.A. THIS DRAWING AND ALL REPRODUCTIONS OF IT ARE THE SOLE PROPERTY OF SDG. REPRODUCTION OR OTHER USES OF THIS DRAWING WITHOUT WRITTEN CONSENT OF SDG IS NOT PERMITTED.

**PROJECT # :** 1221-20024  
**DRAWING NAME:** WITS END PSH AB-04J  
**DATE:** 2022  
**DRAWN BY:** JRH  
**REVIEWED BY:** JGD  
**REVISIONS:**

**SHEET NO.**  
**AB-04J**

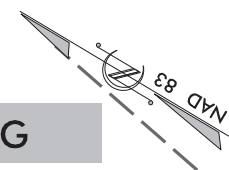


**RECORD DRAWING**

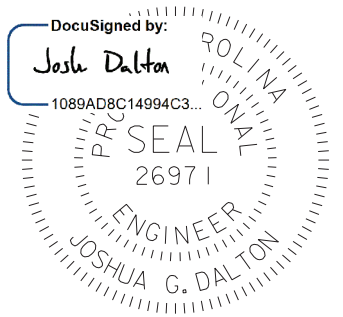

DATE: 10/7/2022

DOCUMENT NOT CONSIDERED FINAL  
UNLESS ALL SIGNATURES COMPLETED

**SUNGATE DESIGN GROUP, P.A.**  
894 GILES CRAWFORD ROAD  
RAVENHILL, NORTH CAROLINA 27866  
TEL: (919) 855-2243  
ENG. FIRM LICENSE NO. C-980

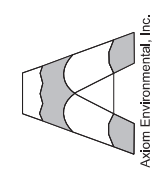



**WITS END**  
UNION COUNTY, NC  
**AS-BUILT STRUCTURES**

PROJECT #: 1221-20024  
DRAWING NAME: WITS END PSH AB-04K  
DATE: 2022  
DRAWN BY: JRH  
REVIEWED BY: JGD  
REVISIONS:

SHEET NO. **AB-04K**

~NOW OR FORMERLY~  
WITS END FARM LLC  
DB 4568/779  
PID 04006015  
TITLE COMMITMENT TRACT 2  
83.434 AC.  
(NET OVERLAP)

-WAXBR- AS-BUILT STRUCTURE LOCATIONS				
STR. TYPE	NORTHING	EASTING	Prop Elevation	AB Survey Elevation
CROSS VANE	426,750.37	1,567,184.71	583.23	583.17
CROSS VANE	426,668.53	1,567,243.34	582.34	582.29
CROSS VANE	426,620.77	1,567,260.71	581.81	581.71
CROSS VANE	426,577.27	1,567,284.60	581.49	581.32

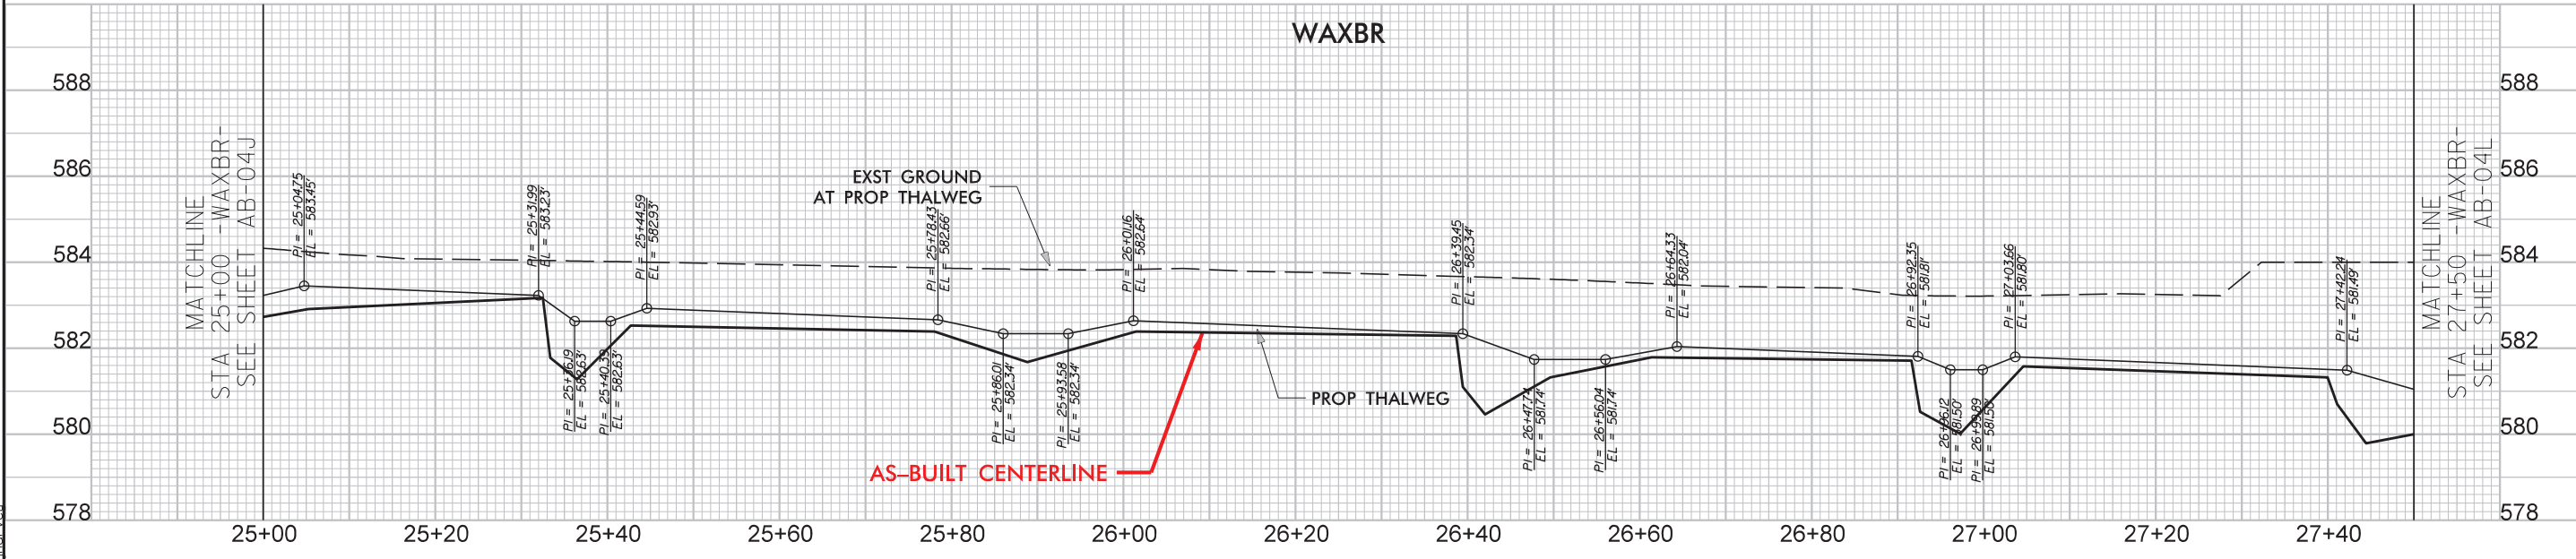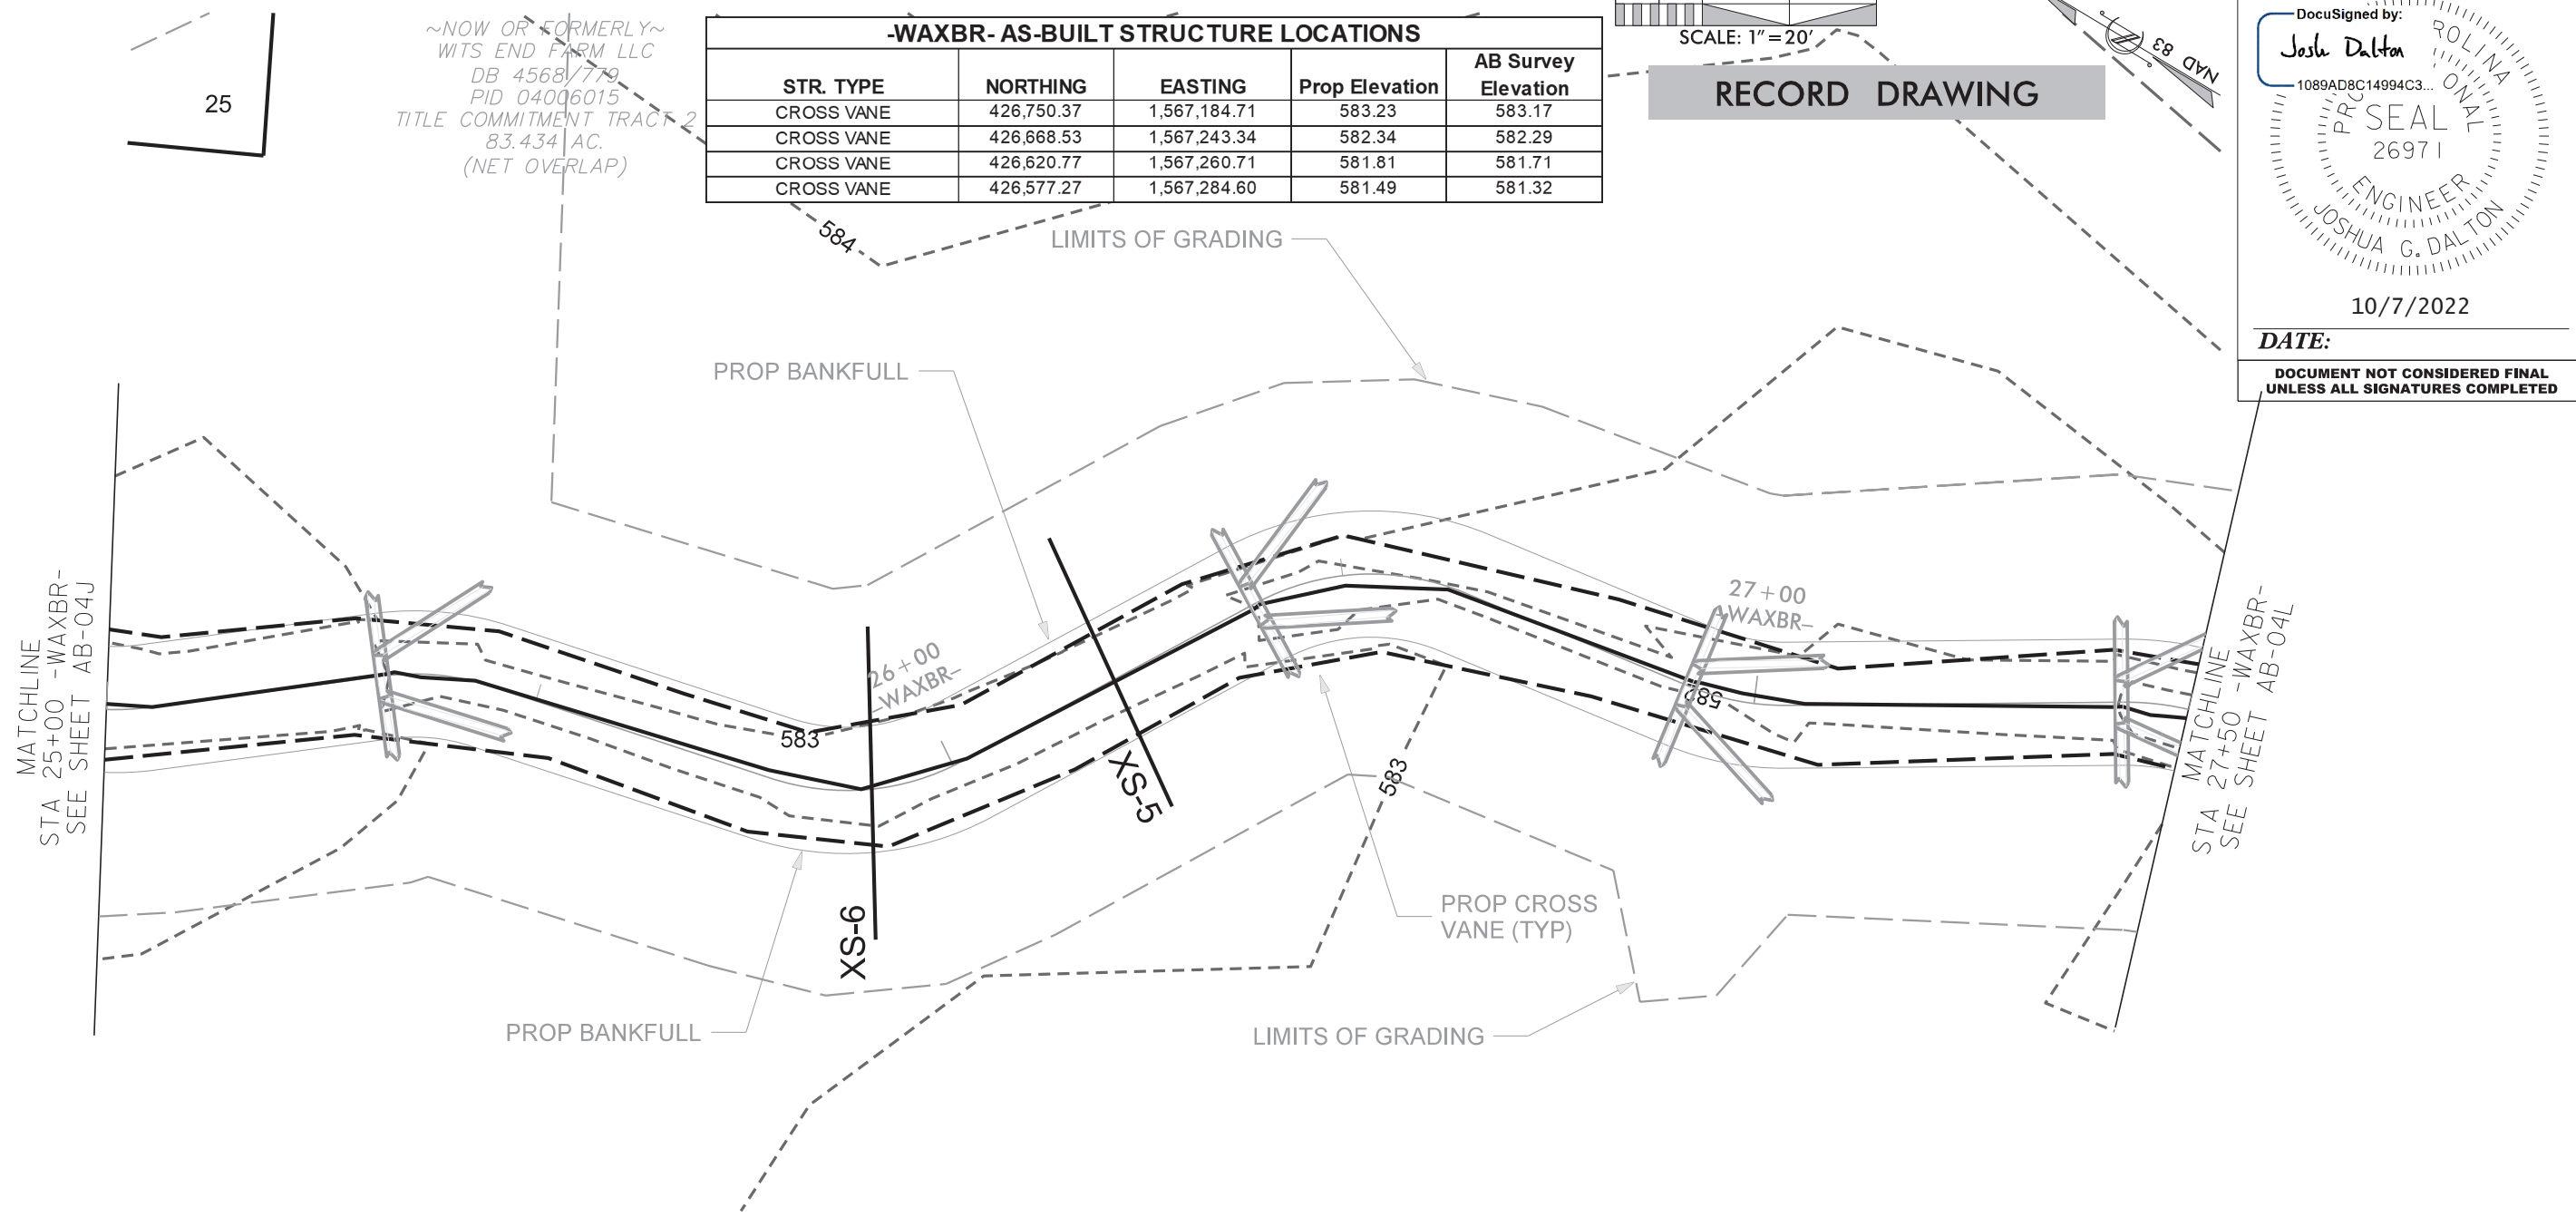


10/6/2022  
Wits\_End\_Psh\_AB-04K.dgn

© 2022 SUNGATE DESIGN GROUP, P.A. THIS DRAWING AND ALL REPRODUCTIONS OF IT ARE THE SOLE PROPERTY OF SDG. REPRODUCTION OR OTHER USES OF THIS DRAWING WITHOUT WRITTEN CONSENT OF SDG IS NOT PERMITTED.



-WAXBR- AS-BUILT STRUCTURE LOCATIONS				
STR. TYPE	NORTHING	EASTING	Prop Elevation	AB Survey Elevation
CROSS VANE	426,514.23	1,567,272.98	580.91	580.73
CROSS VANE	426,414.64	1,567,288.41	580.09	579.87

# RECORD DRAWING

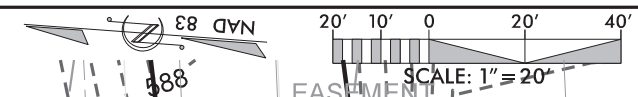



DocuSigned by:  
**Josh Dalton**  
 1089AD8C14994C3...  
 PROFESSIONAL ENGINEER  
 JOSHUA G. DALTON  
 26971

DATE: 10/7/2022

DOCUMENT NOT CONSIDERED FINAL UNLESS ALL SIGNATURES COMPLETED

**SUNGATE DESIGN GROUP, P.A.**  
 890 W. GREENWOOD ROAD  
 SUITE 1000  
 WAXHAM, NC 27086  
 TEL: (919) 855-2243  
 ENG. FIRM LICENSE NO. C-980

**Askom Environmental, Inc.**

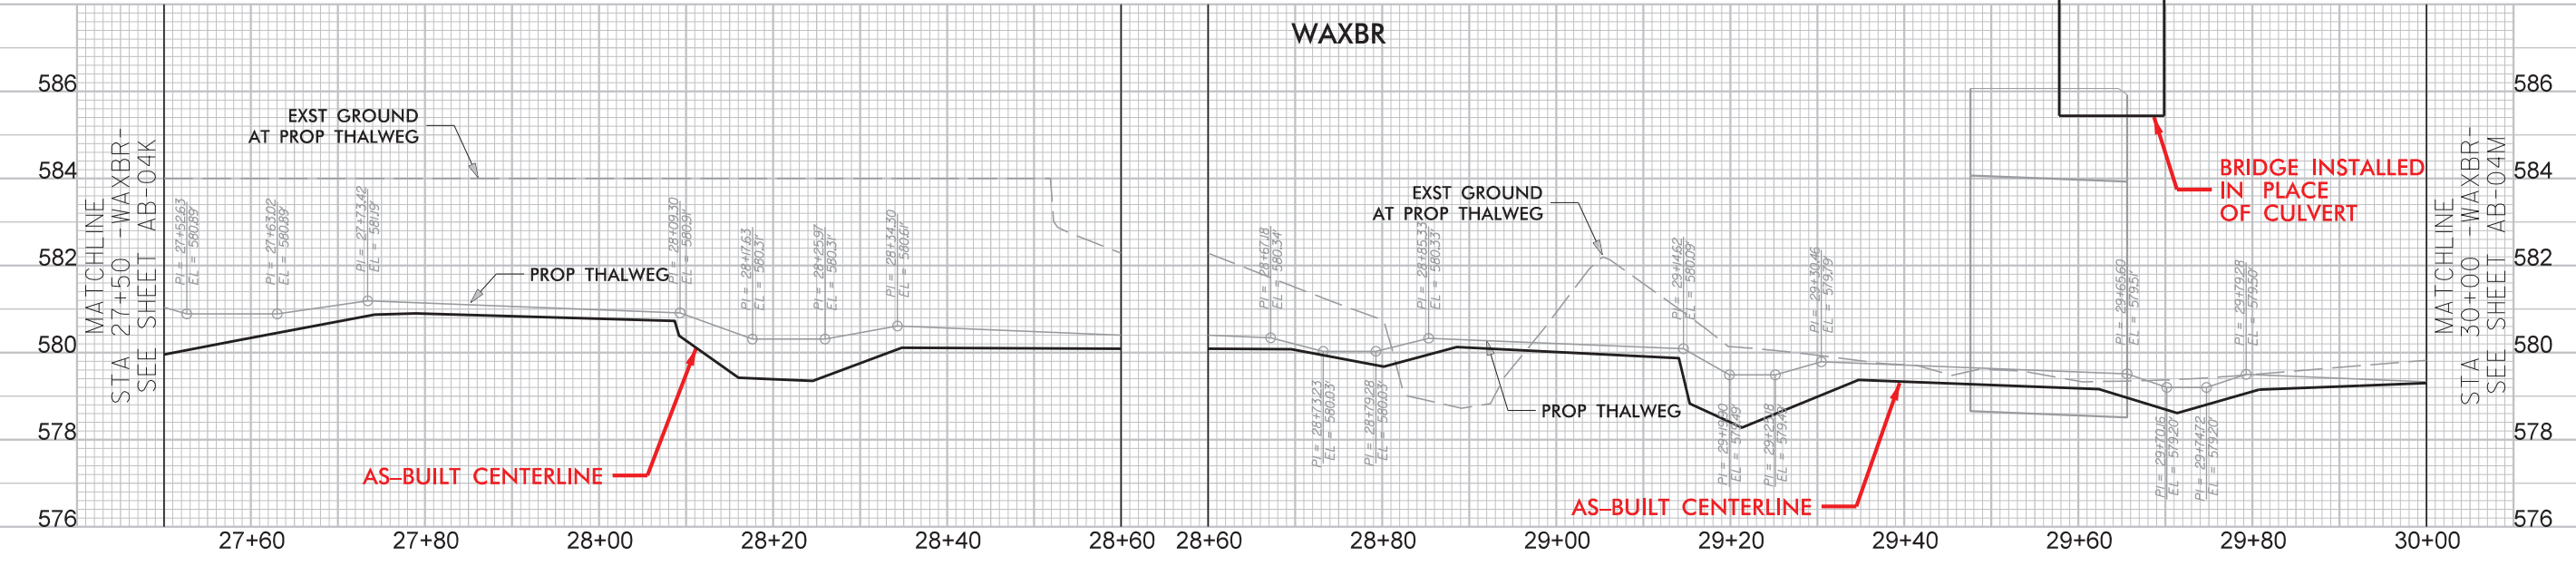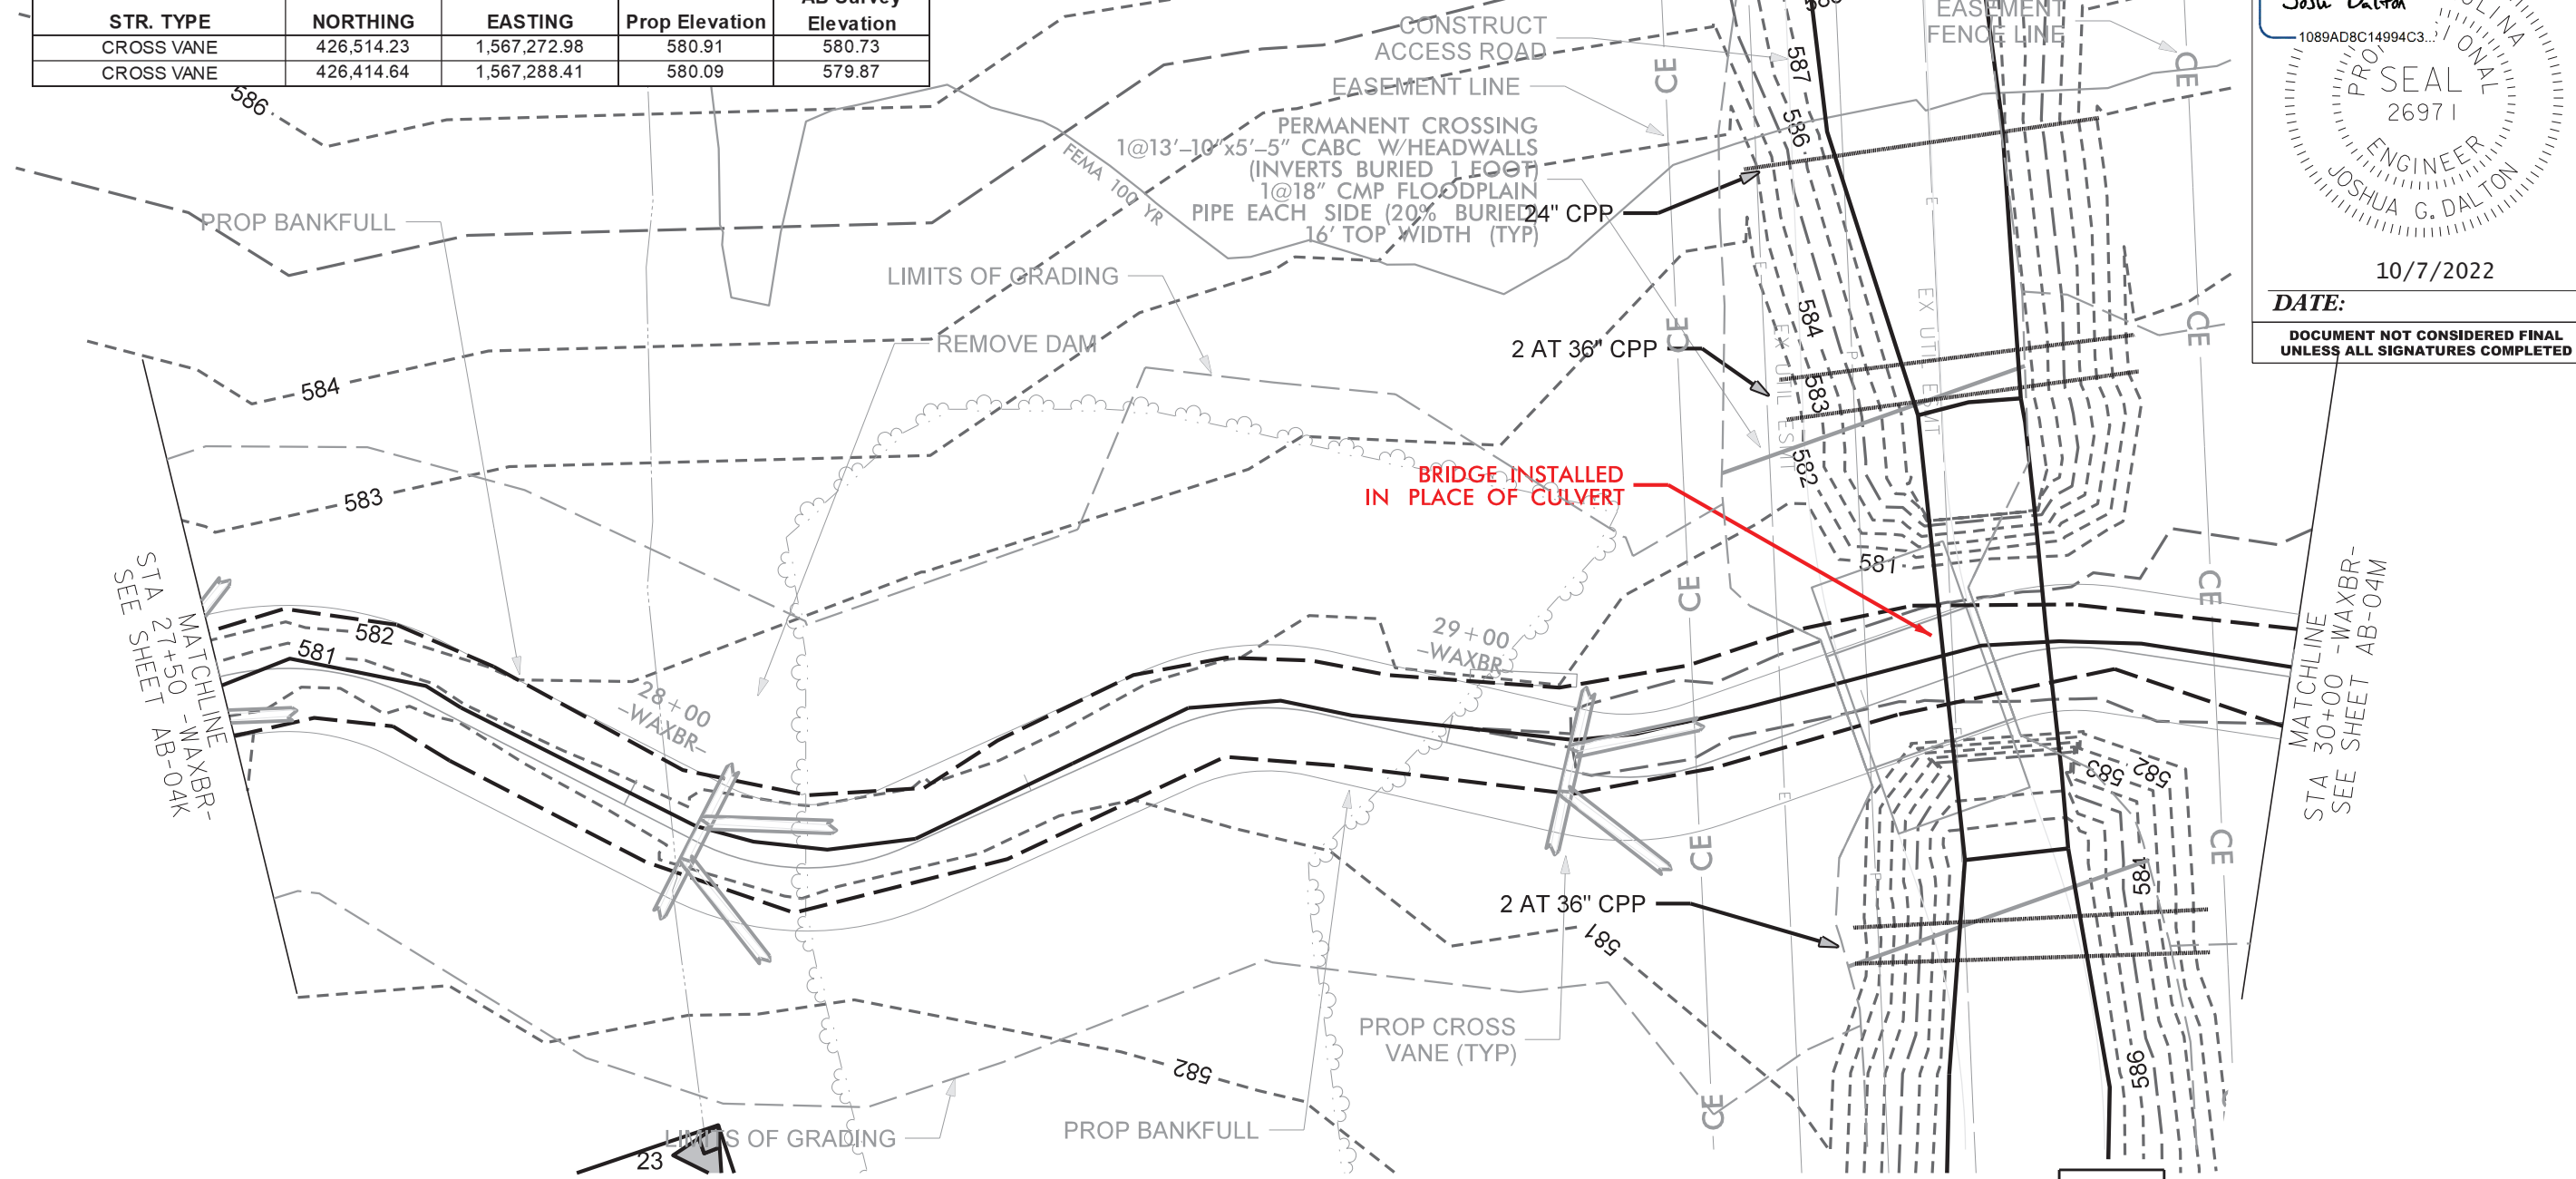



© 2022 SUNGATE DESIGN GROUP, P.A. THIS DRAWING AND ALL REPRODUCTIONS OF IT ARE THE SOLE PROPERTY OF SDG. REPRODUCTION OR OTHER USES OF THIS DRAWING WITHOUT WRITTEN CONSENT OF SDG IS NOT PERMITTED.

**WITS END**  
 UNION COUNTY, NC  
**AS-BUILT STRUCTURES**

PROJECT #: 1221-20024  
 DRAWING NAME: WITS END PSH AB-04L  
 DATE: 2022  
 DRAWN BY: JRH  
 REVIEWED BY: JGD  
 REVISIONS:

SHEET NO.  
**AB-04L**


10/6/2022  
 Wits\_End\_Psh\_AB-04L.dgn

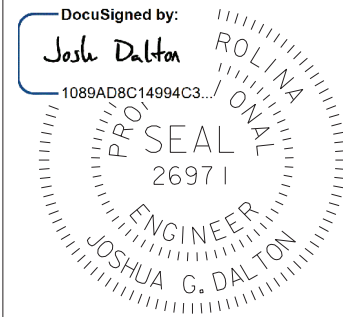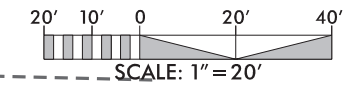



DATE: 10/7/2022

DOCUMENT NOT CONSIDERED FINAL  
UNLESS ALL SIGNATURES COMPLETED

**SUNGATE DESIGN GROUP, P.A.**  
580 GARDNER ROAD  
CARY, NC 27513  
TEL: (919) 855-2243  
ENG. FIRM LICENSE NO. C-980

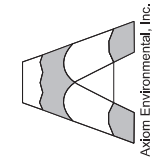

-WAXBR- AS-BUILT STRUCTURE LOCATIONS				
STR. TYPE	NORTHING	EASTING	Prop Elevation	AB Survey Elevation
CROSS VANE	426,296.67	1,567,309.58	579.08	579.07

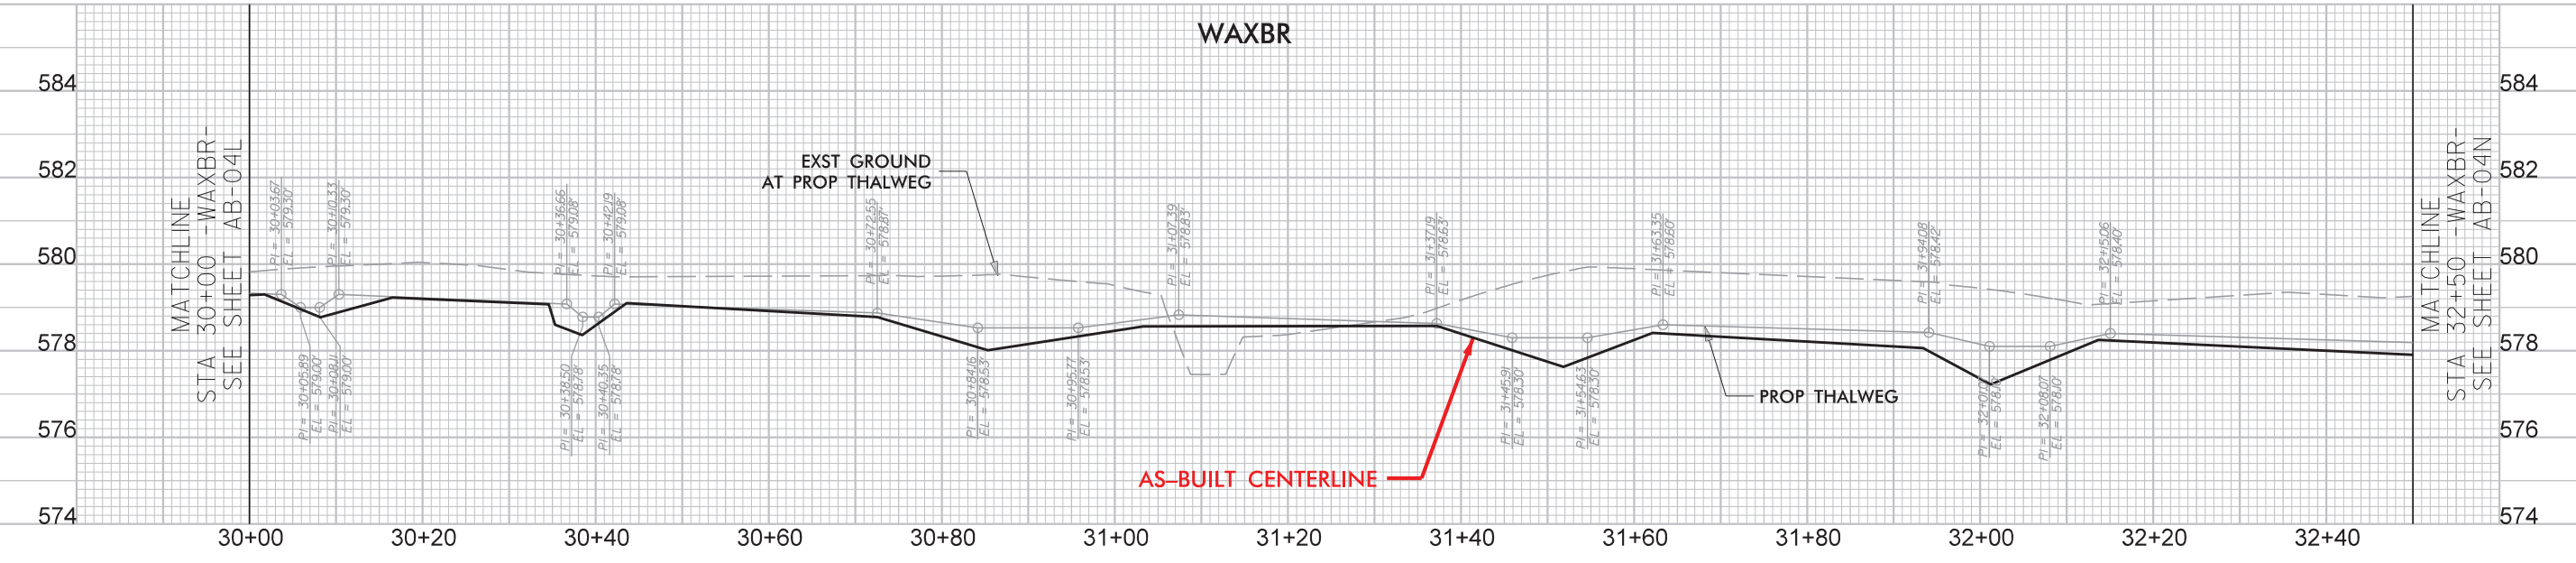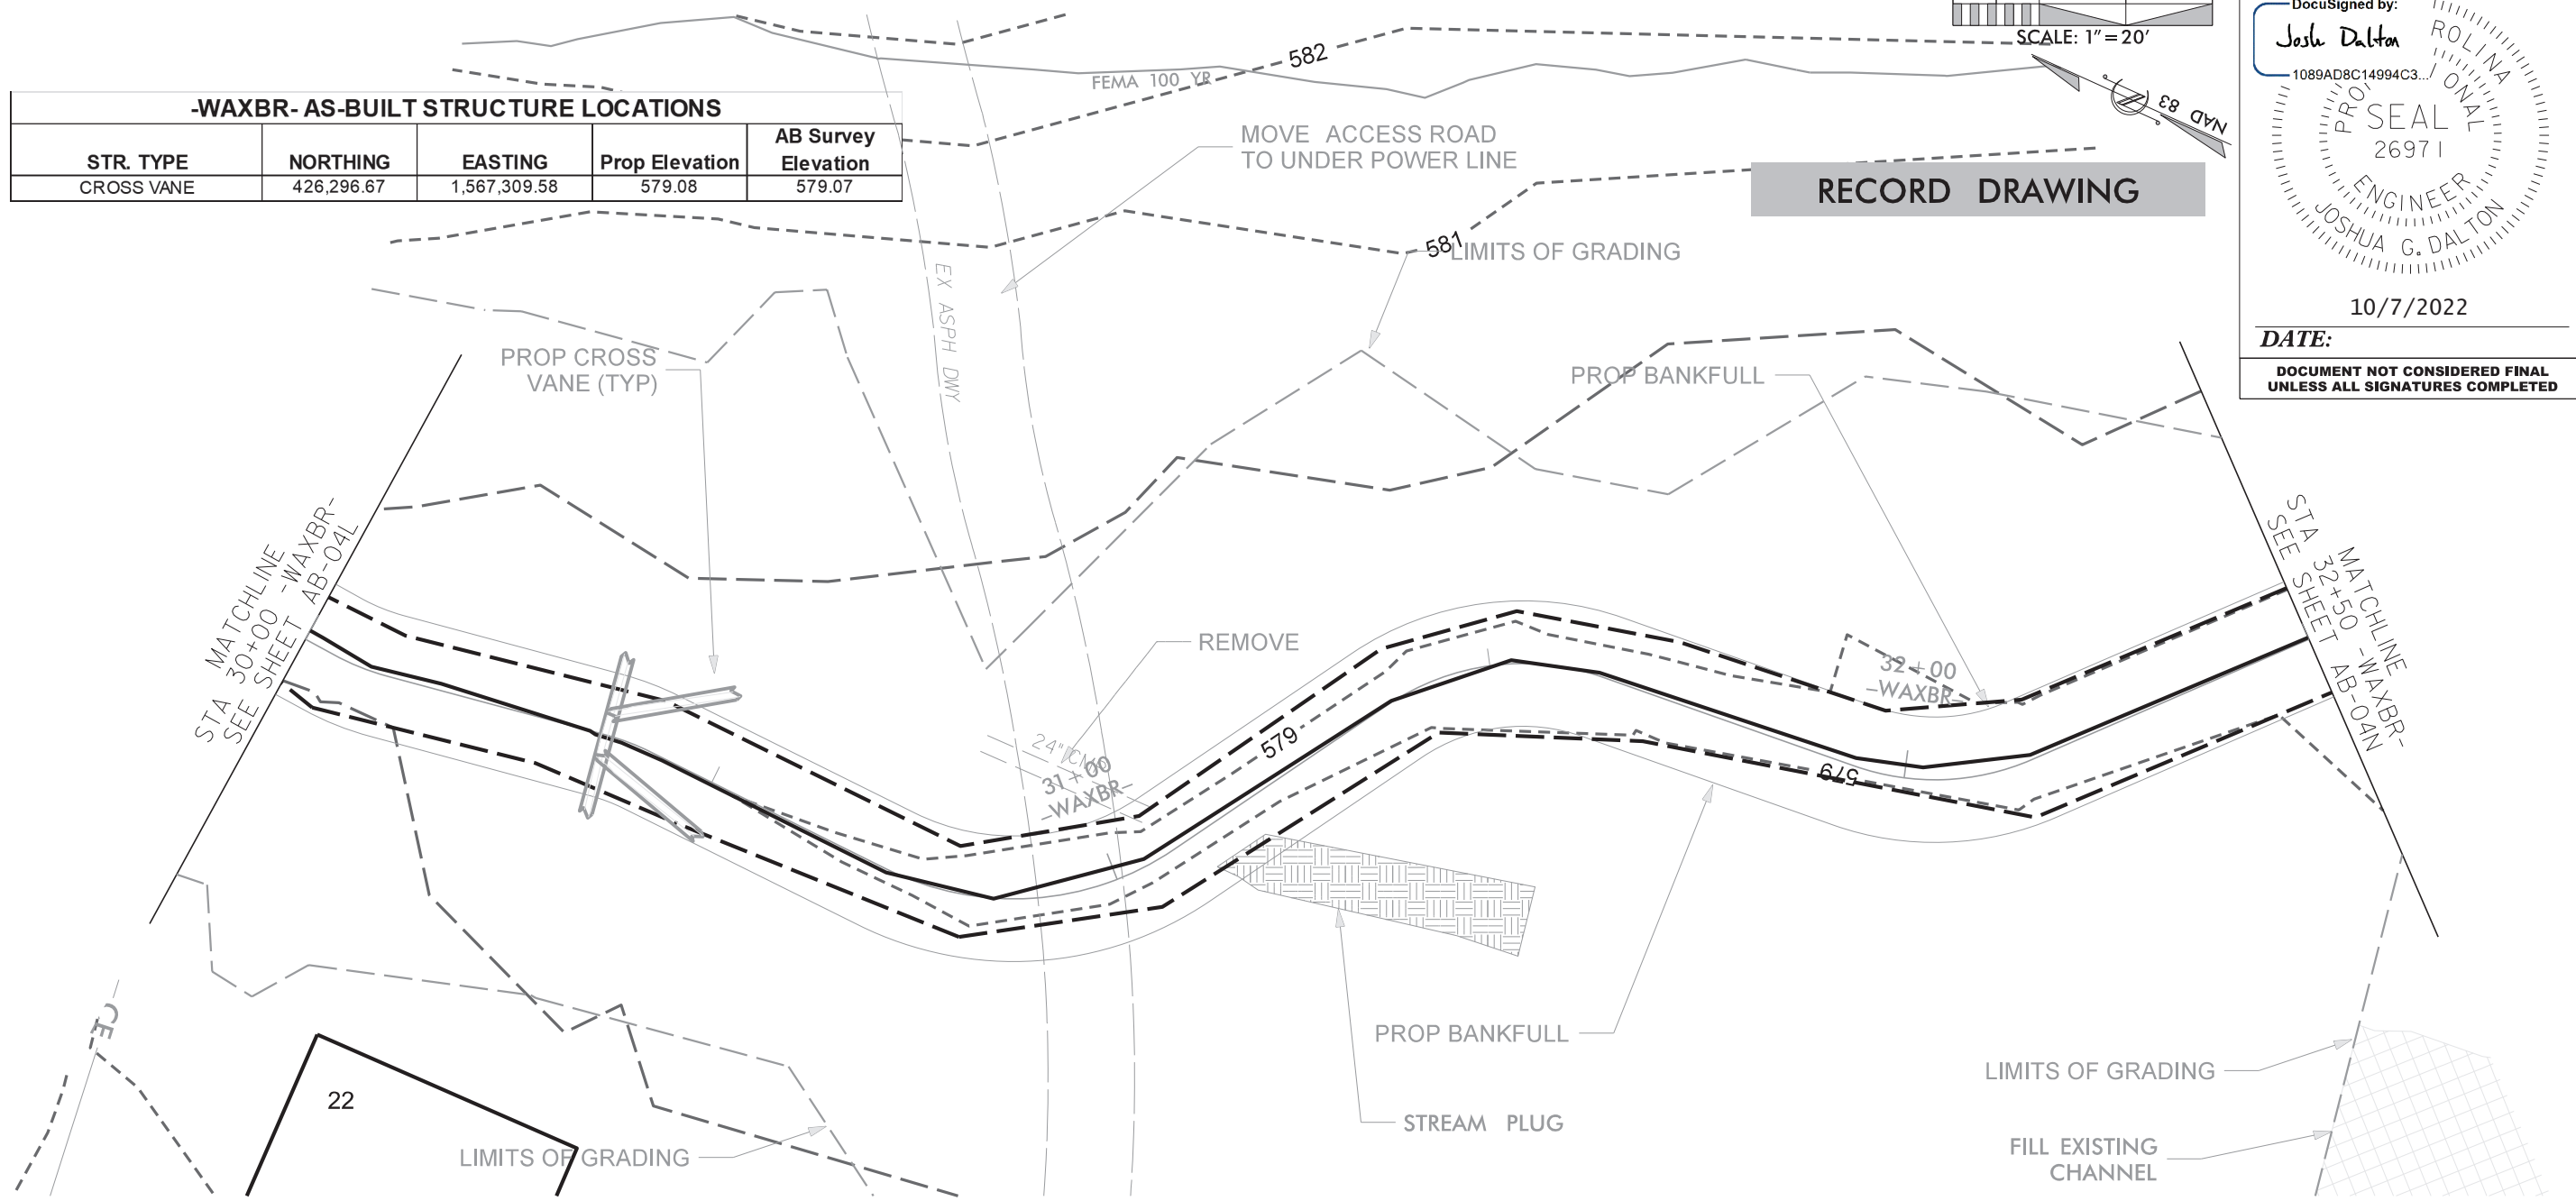



© 2022 SUNGATE DESIGN GROUP, P.A. THIS DRAWING AND ALL REPRODUCTIONS OF IT ARE THE SOLE PROPERTY OF SDG. REPRODUCTION OR OTHER USES OF THIS DRAWING WITHOUT WRITTEN CONSENT OF SDG IS NOT PERMITTED.

**WITS END**  
UNION COUNTY, NC  
**AS-BUILT STRUCTURES**

PROJECT # : 1221-20024  
DRAWING NAME: WITS END PSH AB-04M  
DATE: 2022  
DRAWN BY: JRH  
REVIEWED BY: JGD  
REVISIONS:


SHEET NO. **AB-04M**

10/6/2022  
Wits\_End\_Psh\_AB-04M.dgn

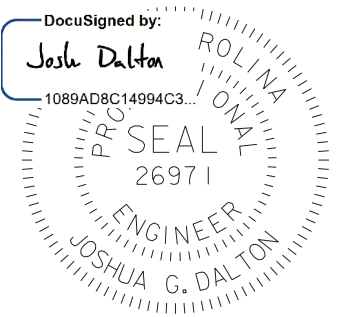
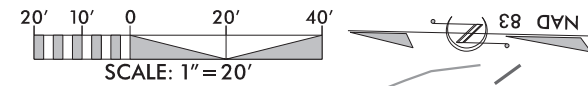


DocuSigned by:  
**Joshua Dalton**  
 1089AD8C14994C3...  
**DATE:** 10/7/2022  
**DOCUMENT NOT CONSIDERED FINAL  
 UNLESS ALL SIGNATURES COMPLETED**

**SUNGATE DESIGN GROUP, P.A.**  
 890 GUNNERS ROAD  
 SUITE 200  
 WAXAHACH, NC 27886  
 TEL: (919) 855-2243  
 ENG. FIRM LICENSE NO. C-890

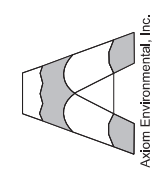

**RECORD DRAWING**

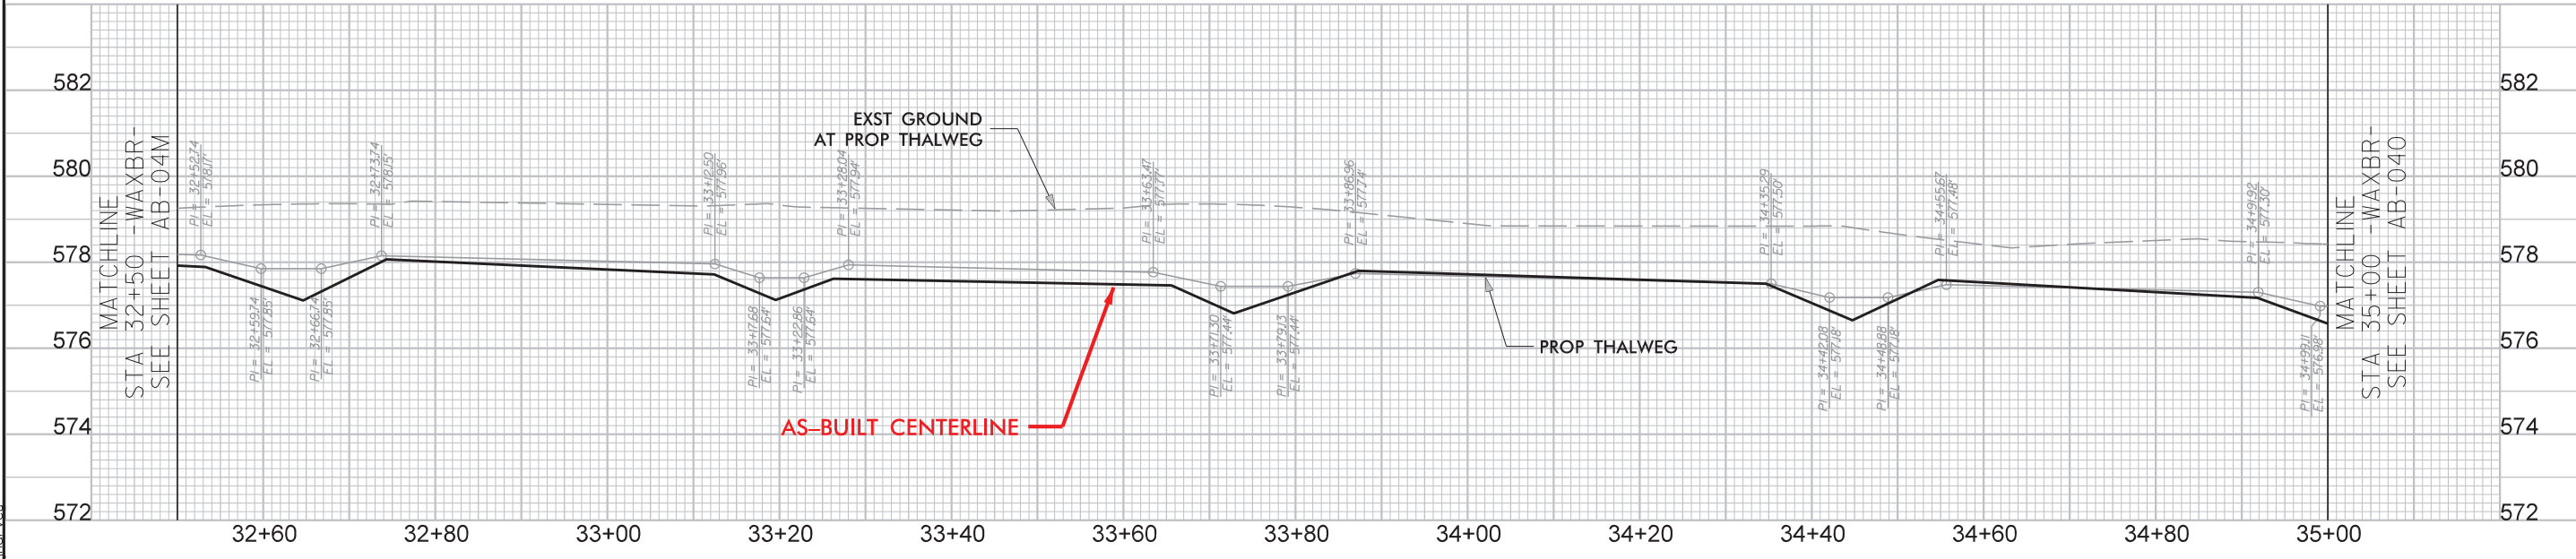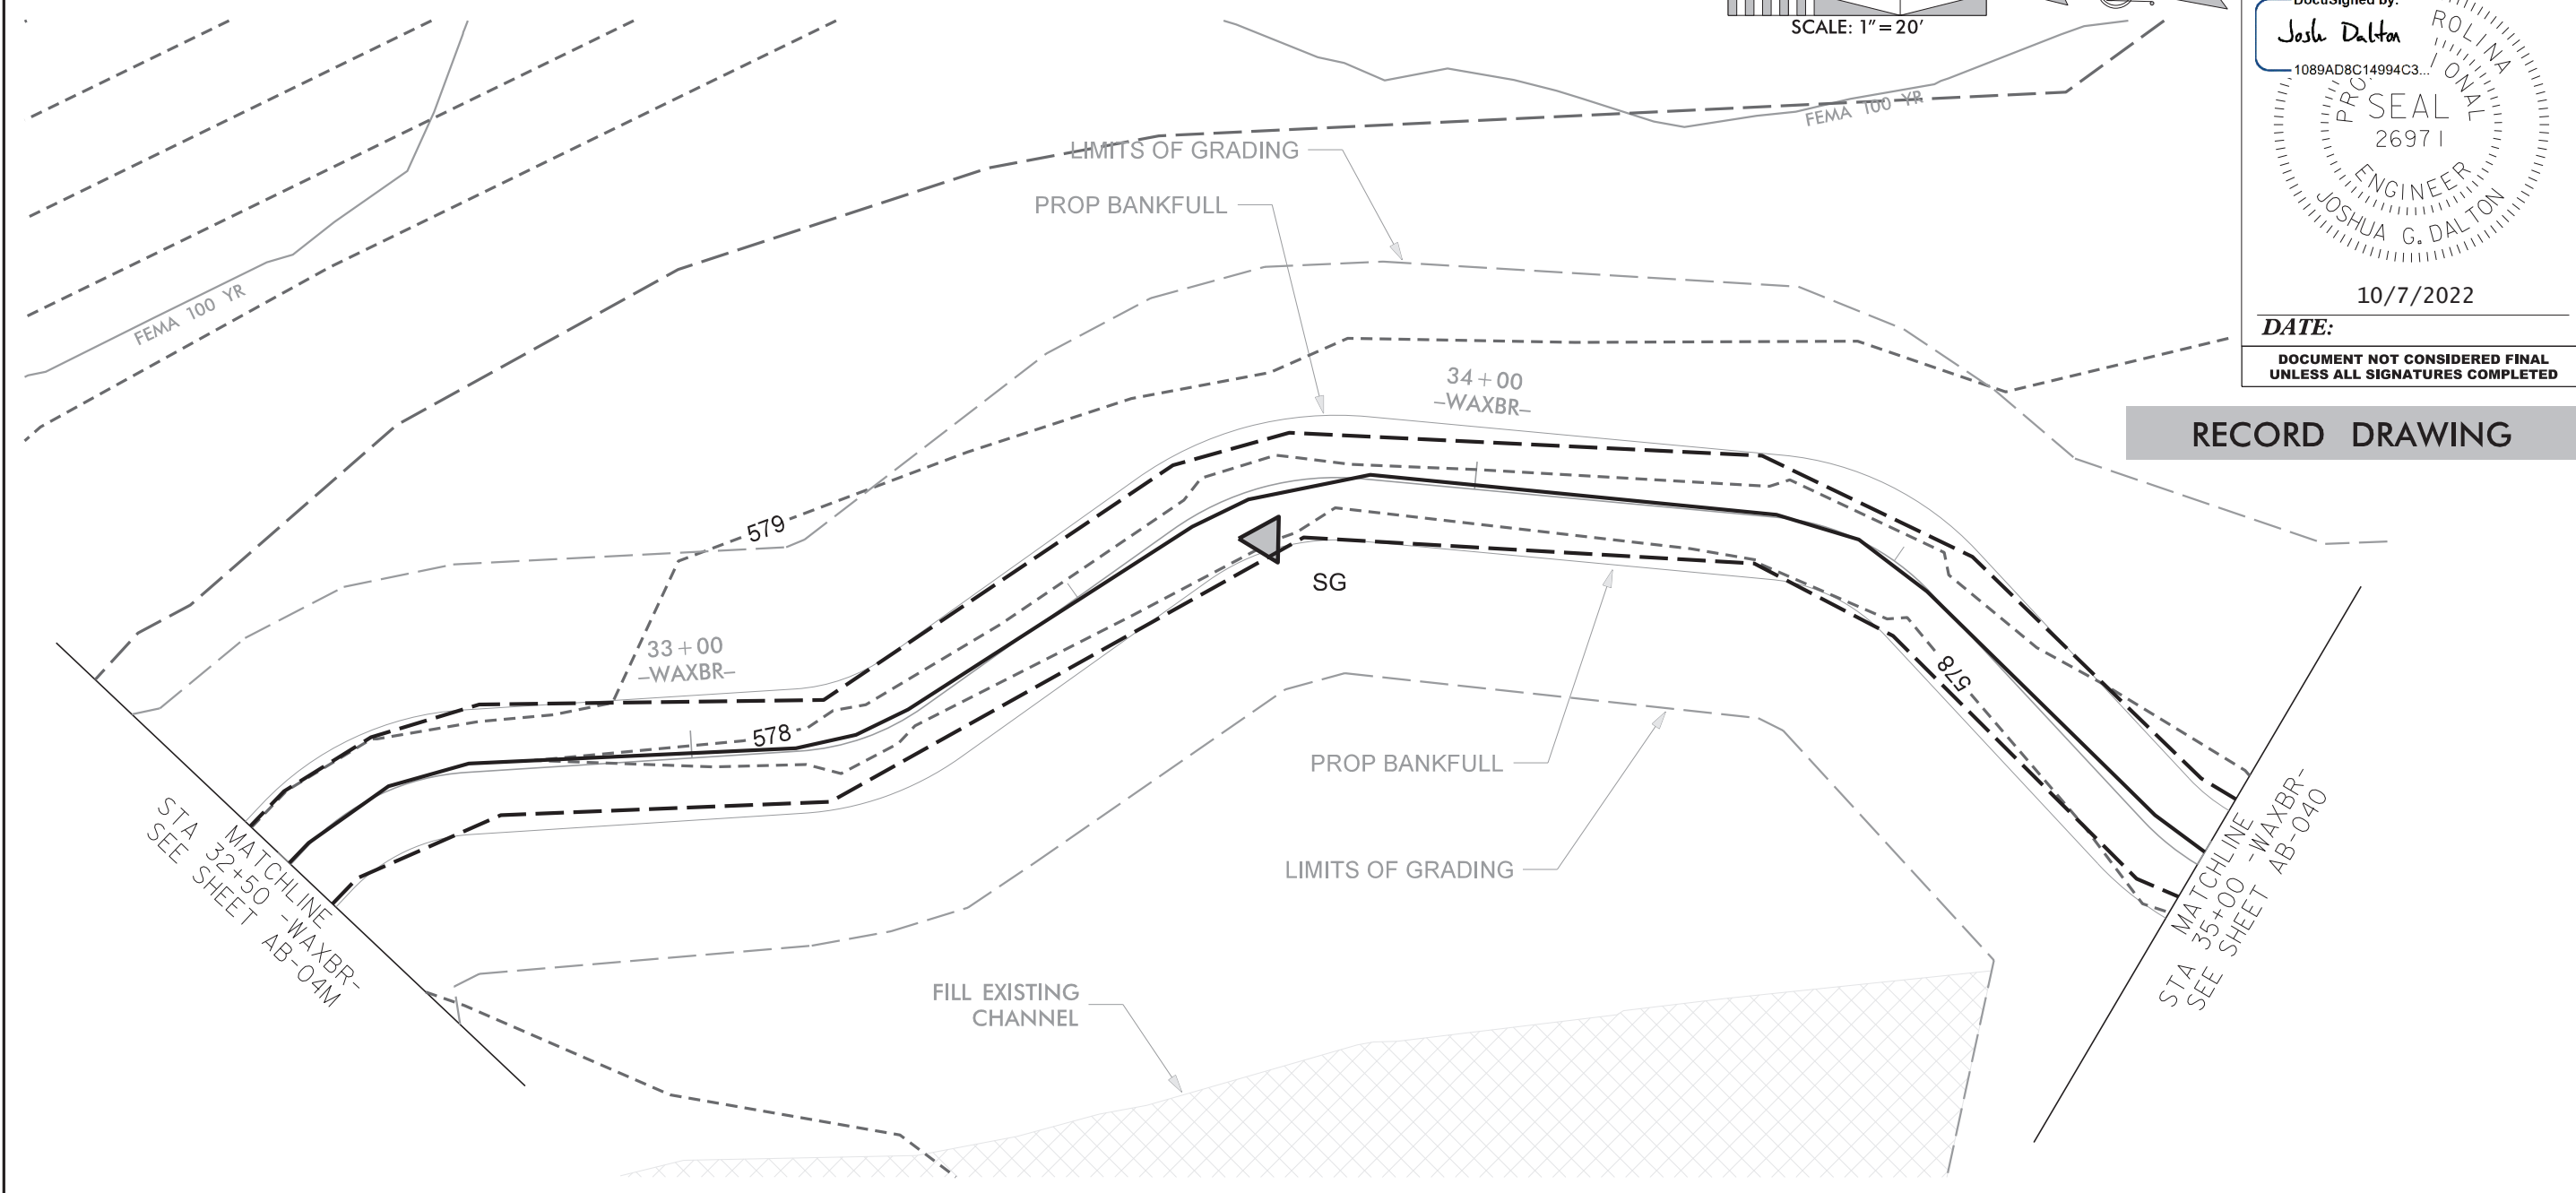

© 2022 SUNGATE DESIGN GROUP, P.A. THIS DRAWING AND ALL REPRODUCTIONS OF IT ARE THE SOLE PROPERTY OF SDG. REPRODUCTION OR OTHER USES OF THIS DRAWING WITHOUT WRITTEN CONSENT OF SDG IS NOT PERMITTED.



PROJECT #: 1221-20024  
 DRAWING NAME: WITS END PSH AB-04N  
 DATE: 2022  
 DRAWN BY: JRH  
 REVIEWED BY: JGD  
 REVISIONS:

SHEET NO.  
**AB-04N**

**WITS END**  
 UNION COUNTY, NC  
**AS-BUILT STRUCTURES**


10/6/2022  
 Wits\_End\_Psh\_AB-04N.dgn



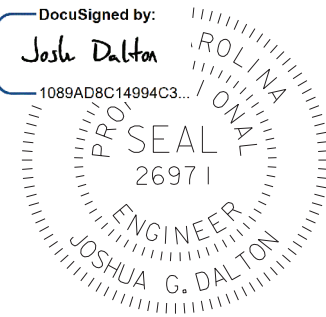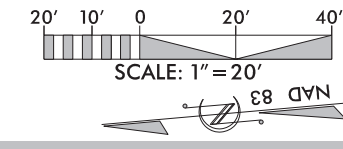

DocuSigned by:  
 Joshua Dalton  
 1089AD8C14994C3...  
**DATE:** 10/7/2022  
**DOCUMENT NOT CONSIDERED FINAL UNLESS ALL SIGNATURES COMPLETED**

**SUNGATE DESIGN GROUP, P.A.**  
 890 GUNNERS ROAD  
 SUITE 200  
 WILSON, NC 27606  
 TEL: (919) 855-2243  
 FAX: (919) 855-2243  
 ENG. FIRM LICENSE NO. C-980

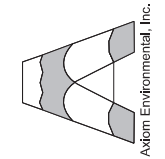



© 2022 SUNGATE DESIGN GROUP, P.A. THIS DRAWING AND ALL REPRODUCTIONS OF IT ARE THE SOLE PROPERTY OF SDG. REPRODUCTION OR OTHER USES OF THIS DRAWING WITHOUT WRITTEN CONSENT OF SDG IS NOT PERMITTED.

**WITS END**  
 UNION COUNTY, NC  
**AS-BUILT STRUCTURES**

PROJECT # : 1221-20024  
 DRAWING NAME: WITS END PSH AB-040  
 DATE: 2022  
 DRAWN BY: JRH  
 REVIEWED BY: JGD  
 REVISIONS:



SHEET NO.  
**AB-040**

**RECORD DRAWING**

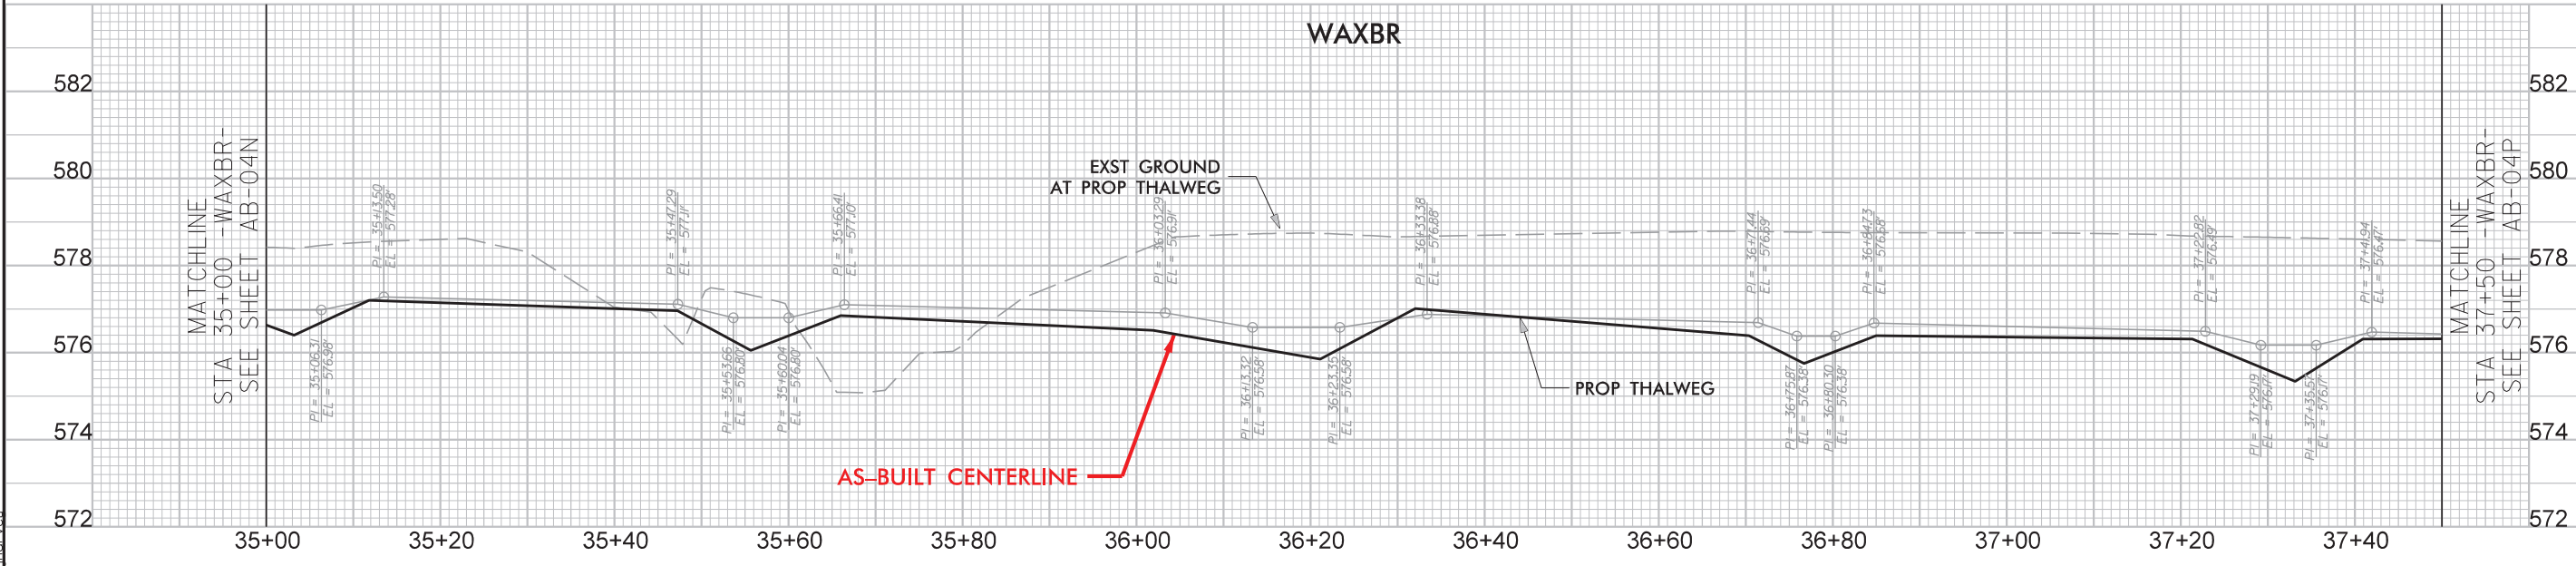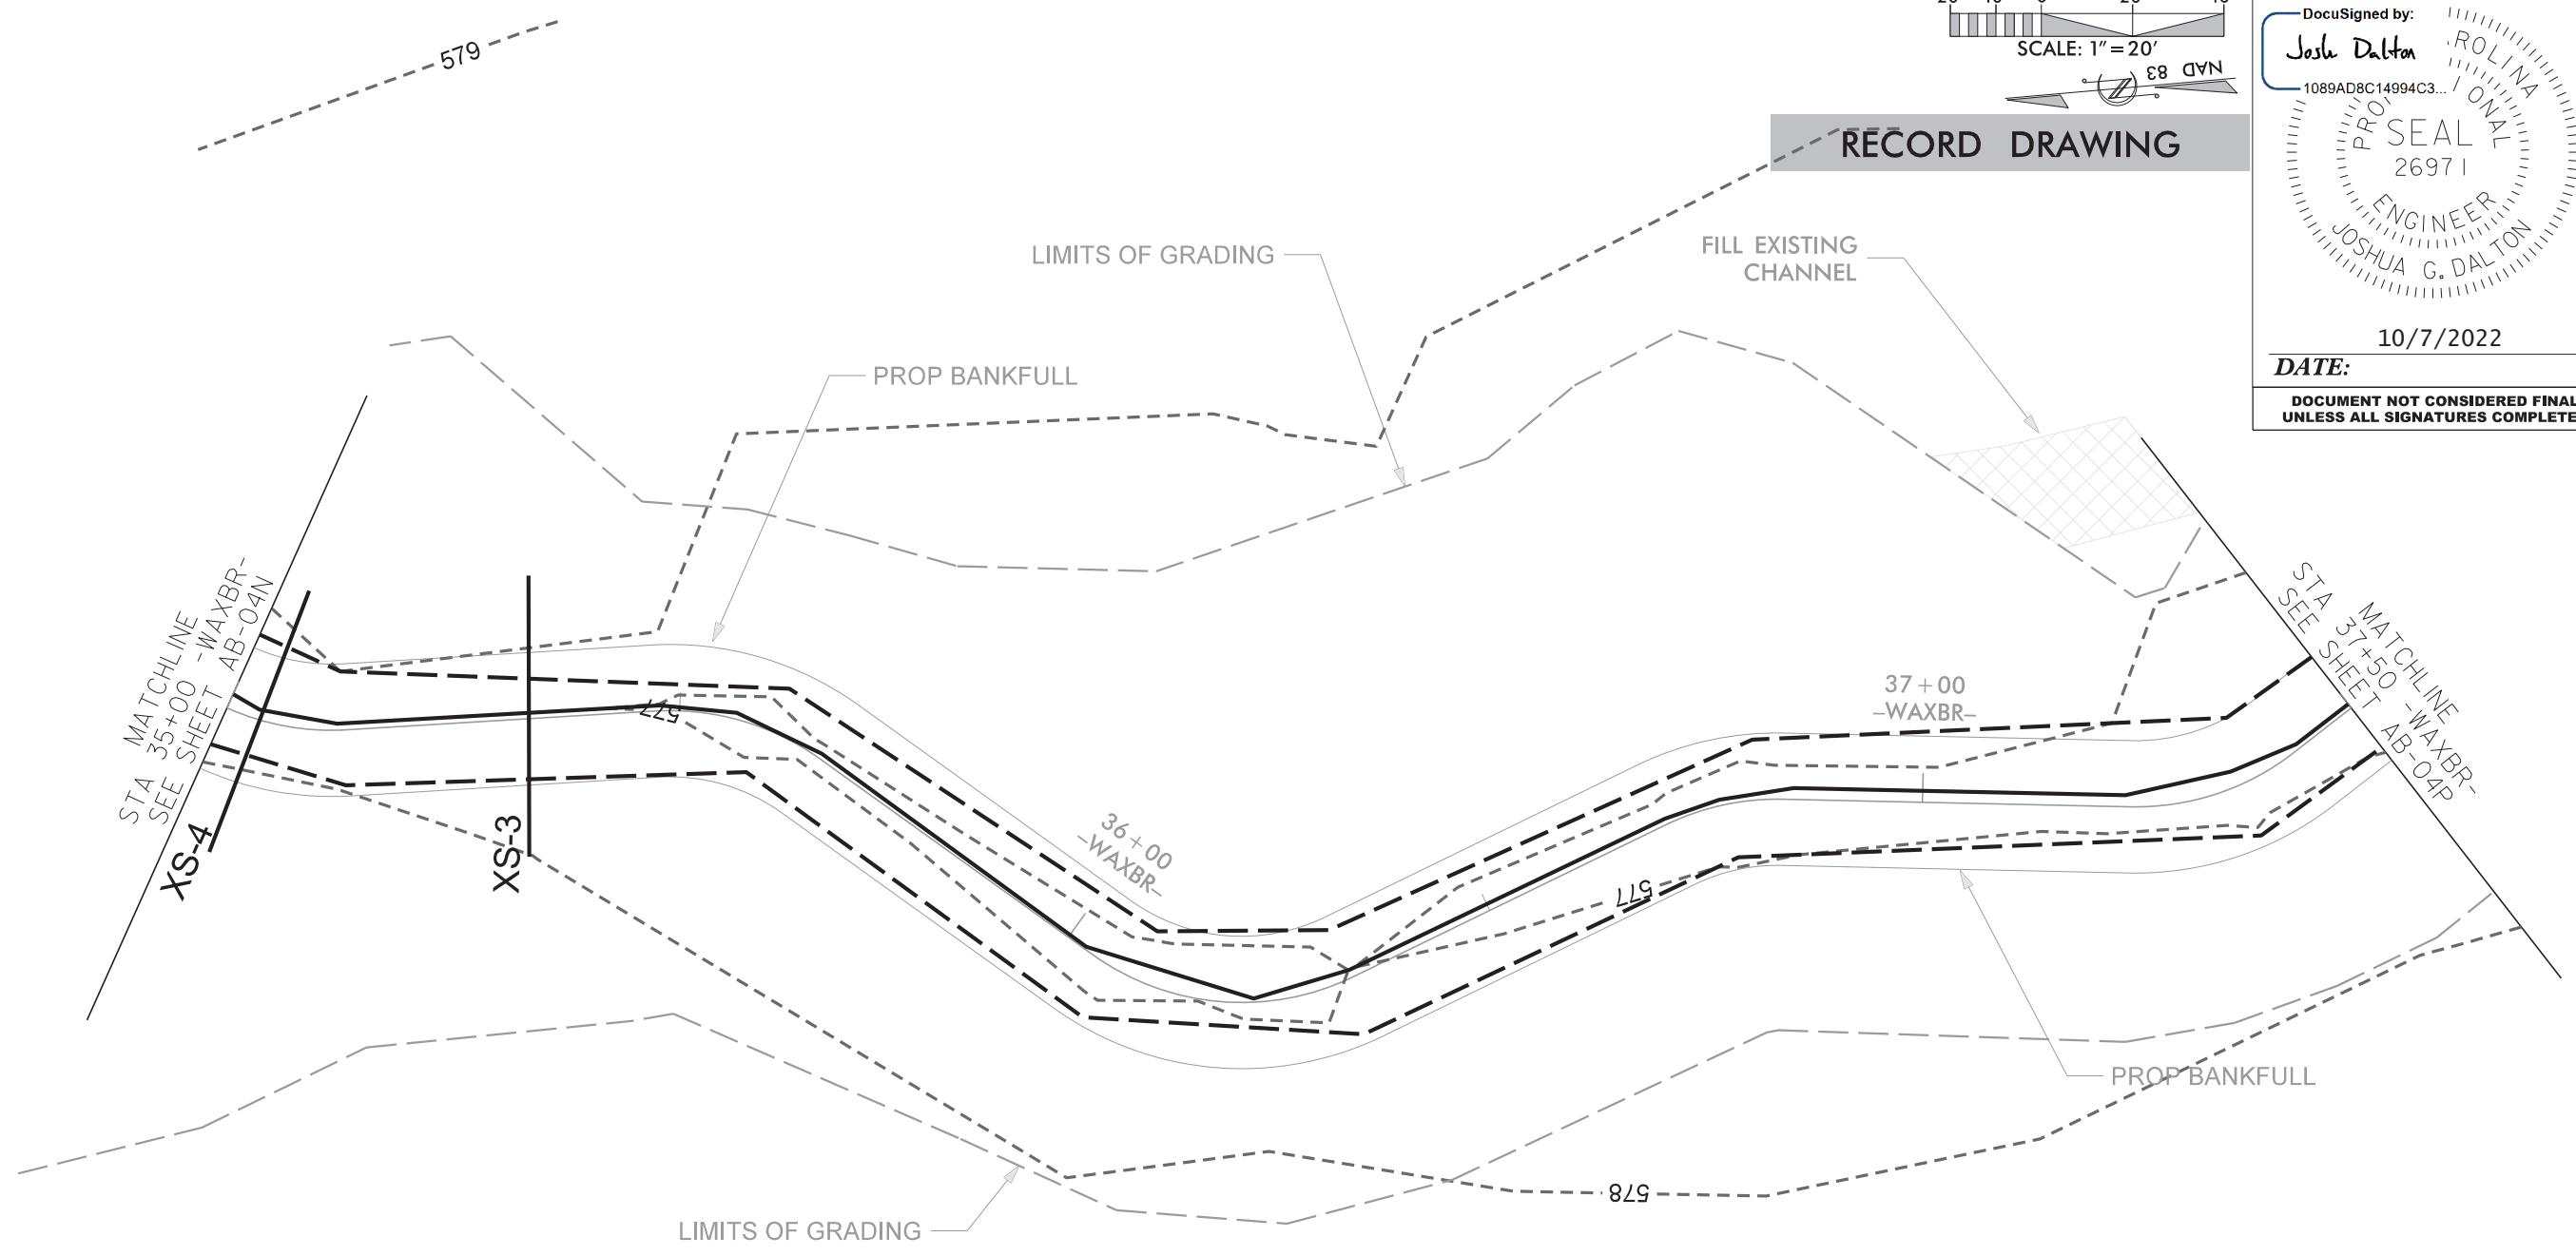




10/6/2022  
 Wits\_End\_Psh\_AB-040.dgn

**RECORD DRAWING**

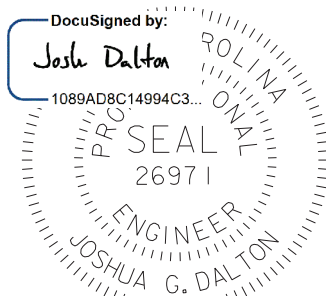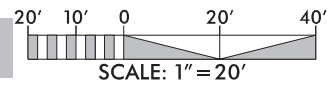

DocuSigned by:  
**Josh Dalton**  
 1089AD8C14994C3...  
**DATE:** 10/7/2022  
**DOCUMENT NOT CONSIDERED FINAL  
 UNLESS ALL SIGNATURES COMPLETED**

**SUNGATE DESIGN GROUP, P.A.**  
 890 GAYNES BRANFORD ROAD  
 WILSON, NORTH CAROLINA 27606  
 TEL: (919) 855-2243  
 ENG. FIRM LICENSE NO. C-980

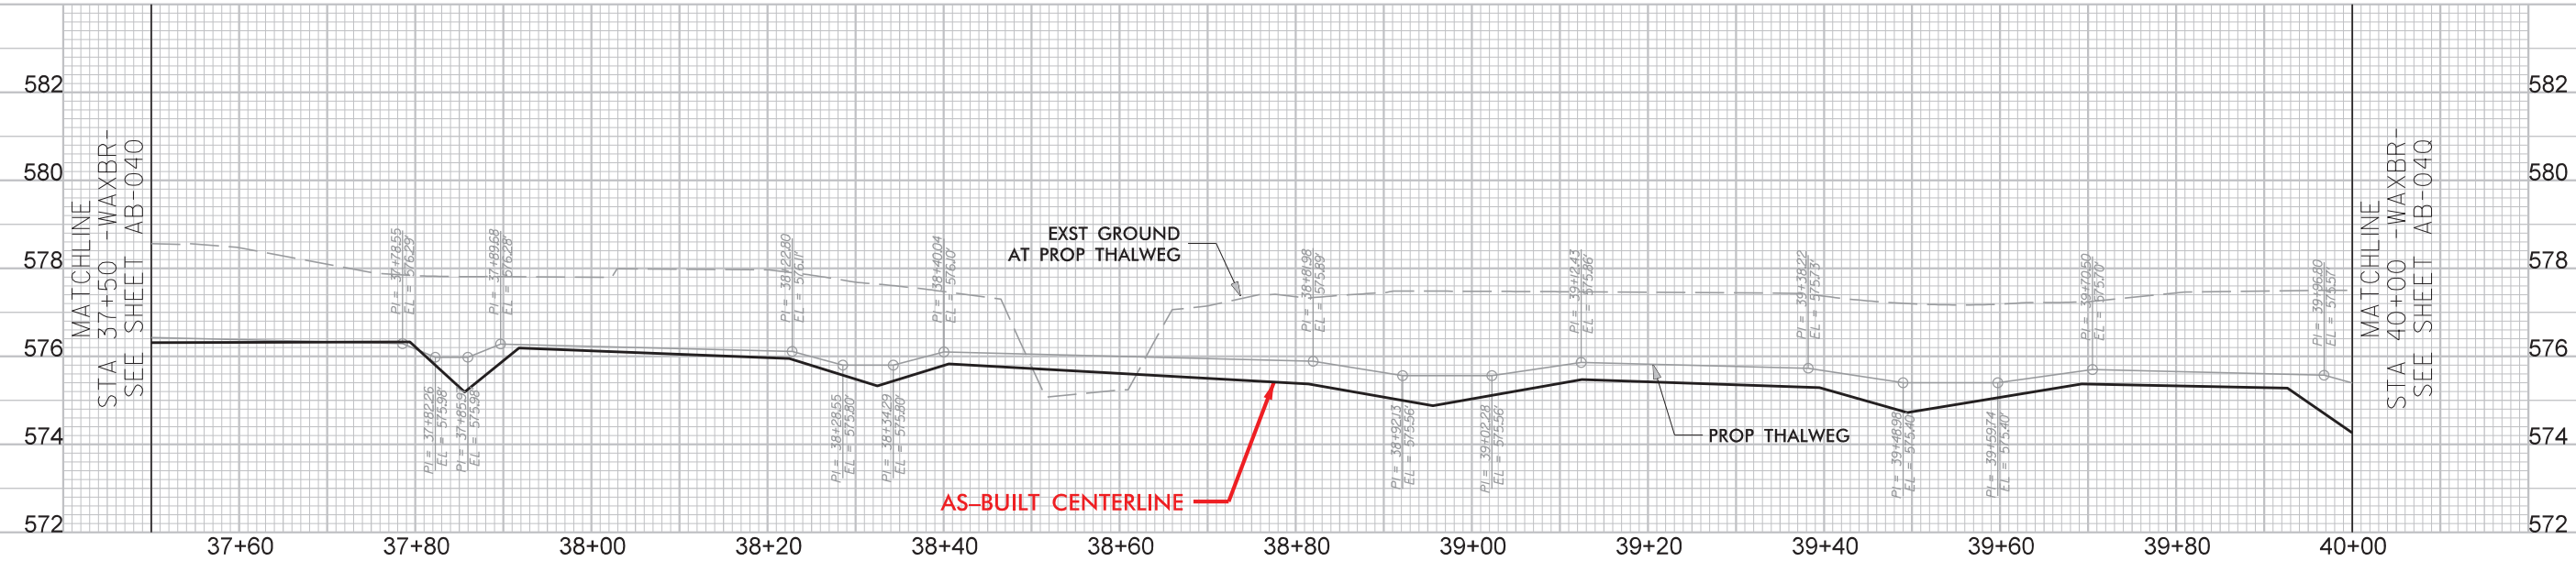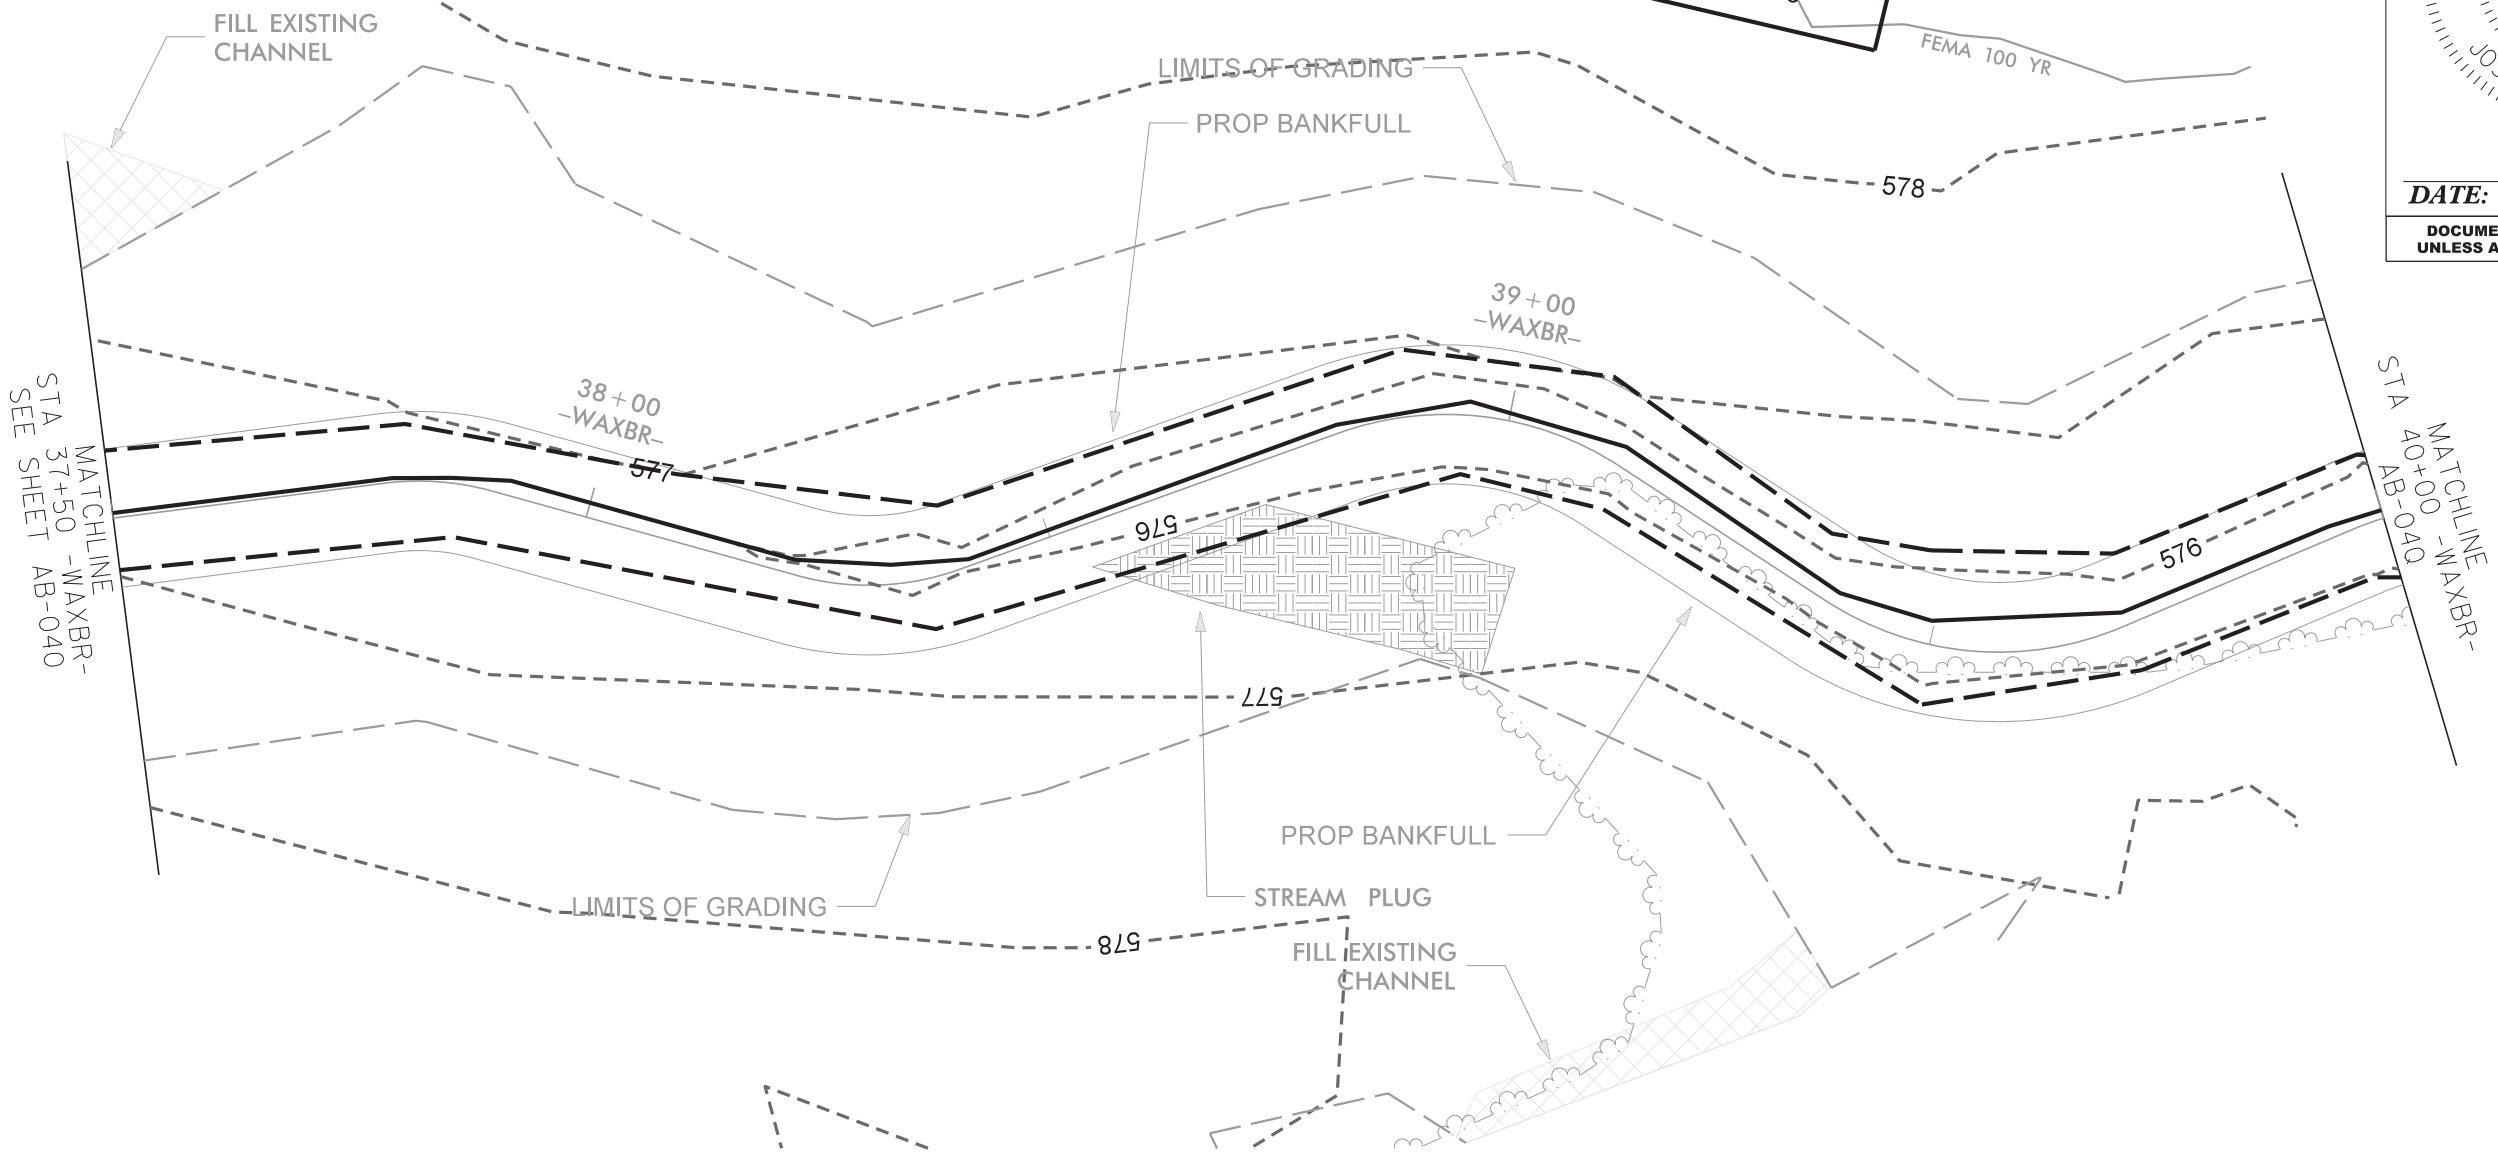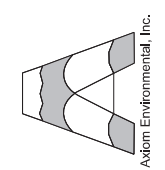

10/6/2022  
 Wits\_Endr\_psh\_AB-04P.dgn



© 2022 SUNGATE DESIGN GROUP, P.A. THIS DRAWING AND ALL REPRODUCTIONS OF IT ARE THE SOLE PROPERTY OF SDG. REPRODUCTION OR OTHER USES OF THIS DRAWING WITHOUT WRITTEN CONSENT OF SDG IS NOT PERMITTED.

PROJECT # : 1221-20024  
 DRAWING NAME: WITS END PSH AB-04P  
 DATE: 2022  
 DRAWN BY: JRH  
 REVIEWED BY: JGD  
 REVISIONS:

SHEET NO.  
**AB-04P**


**WITS END**  
 UNION COUNTY, NC  
**AS-BUILT STRUCTURES**

-WAXBR- AS-BUILT STRUCTURE LOCATIONS				
STR. TYPE	NORTHING	EASTING	Prop Elevation	AB Survey Elevation
CROSS VANE	425,269.54	1,567,651.67	574.17	573.85
CROSS VANE	425,162.87	1,567,688.08	573.43	573.00

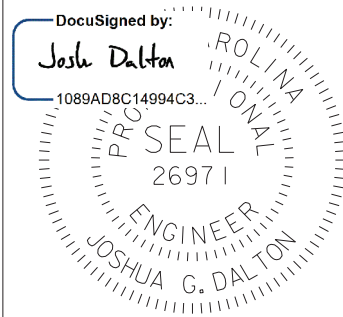
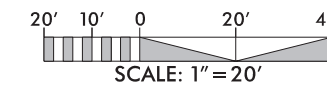


DocuSigned by:  
 Joshua Dalton  
 1089AD8C14994C3...  
 DATE: 10/7/2022  
 DOCUMENT NOT CONSIDERED FINAL  
 UNLESS ALL SIGNATURES COMPLETED

**SUNGATE DESIGN GROUP, P.A.**  
 800 W. HARRIS ROAD  
 SUITE 200  
 WAXHAM, NC 27086  
 TEL: (919) 856-2243  
 ENG. FIRM LICENSE NO. C-890

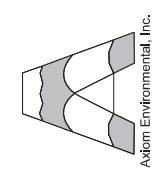

**RECORD DRAWING**

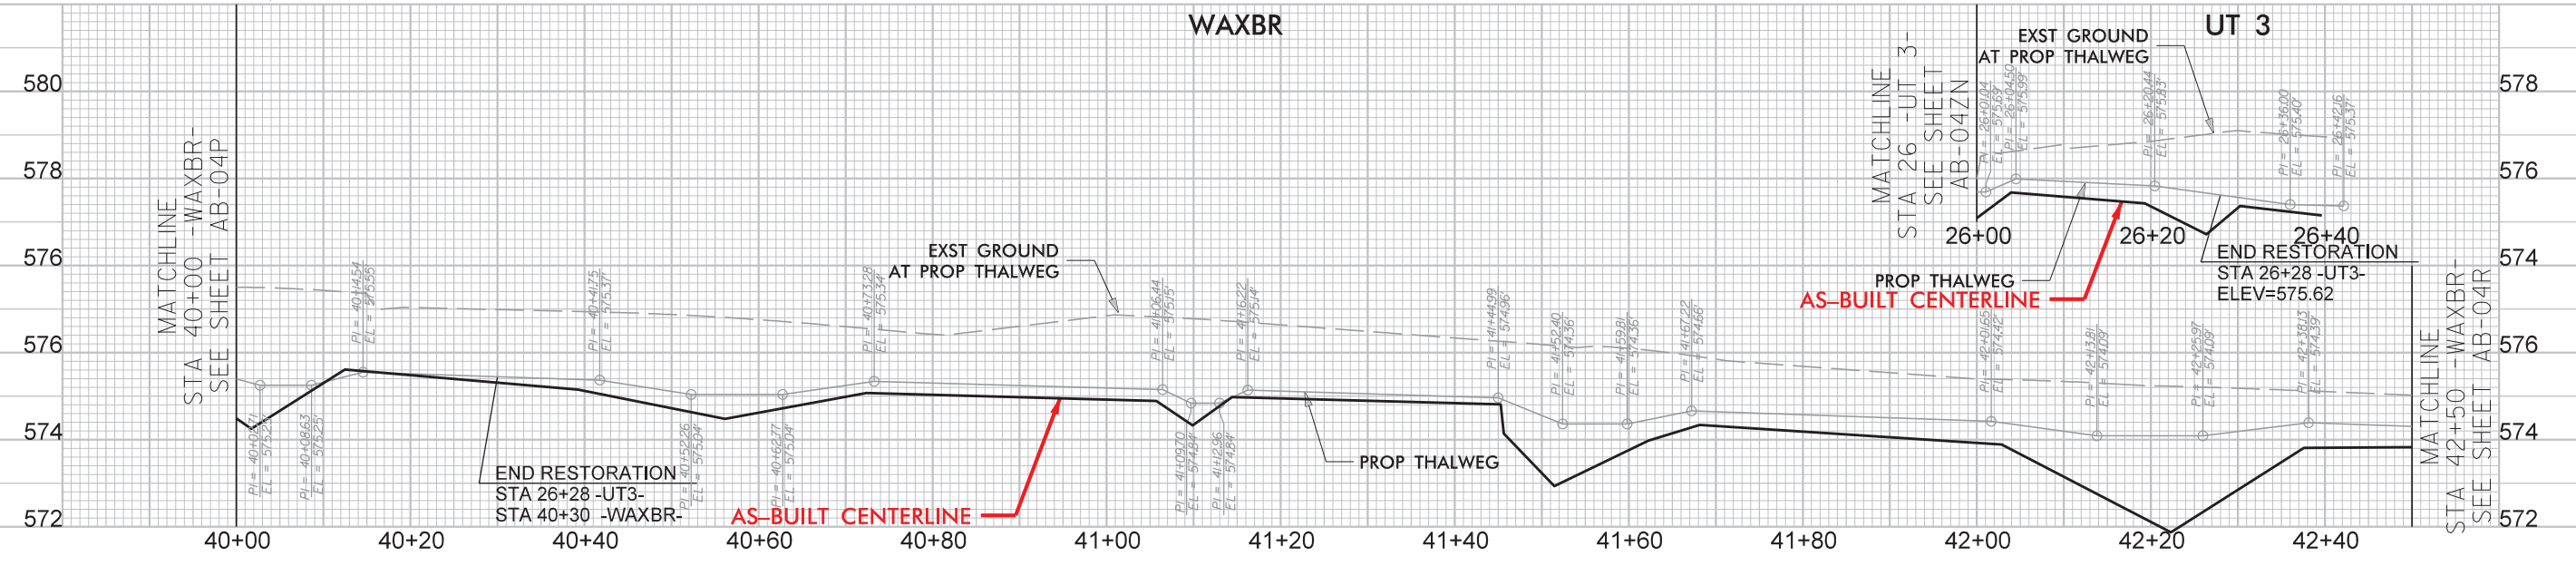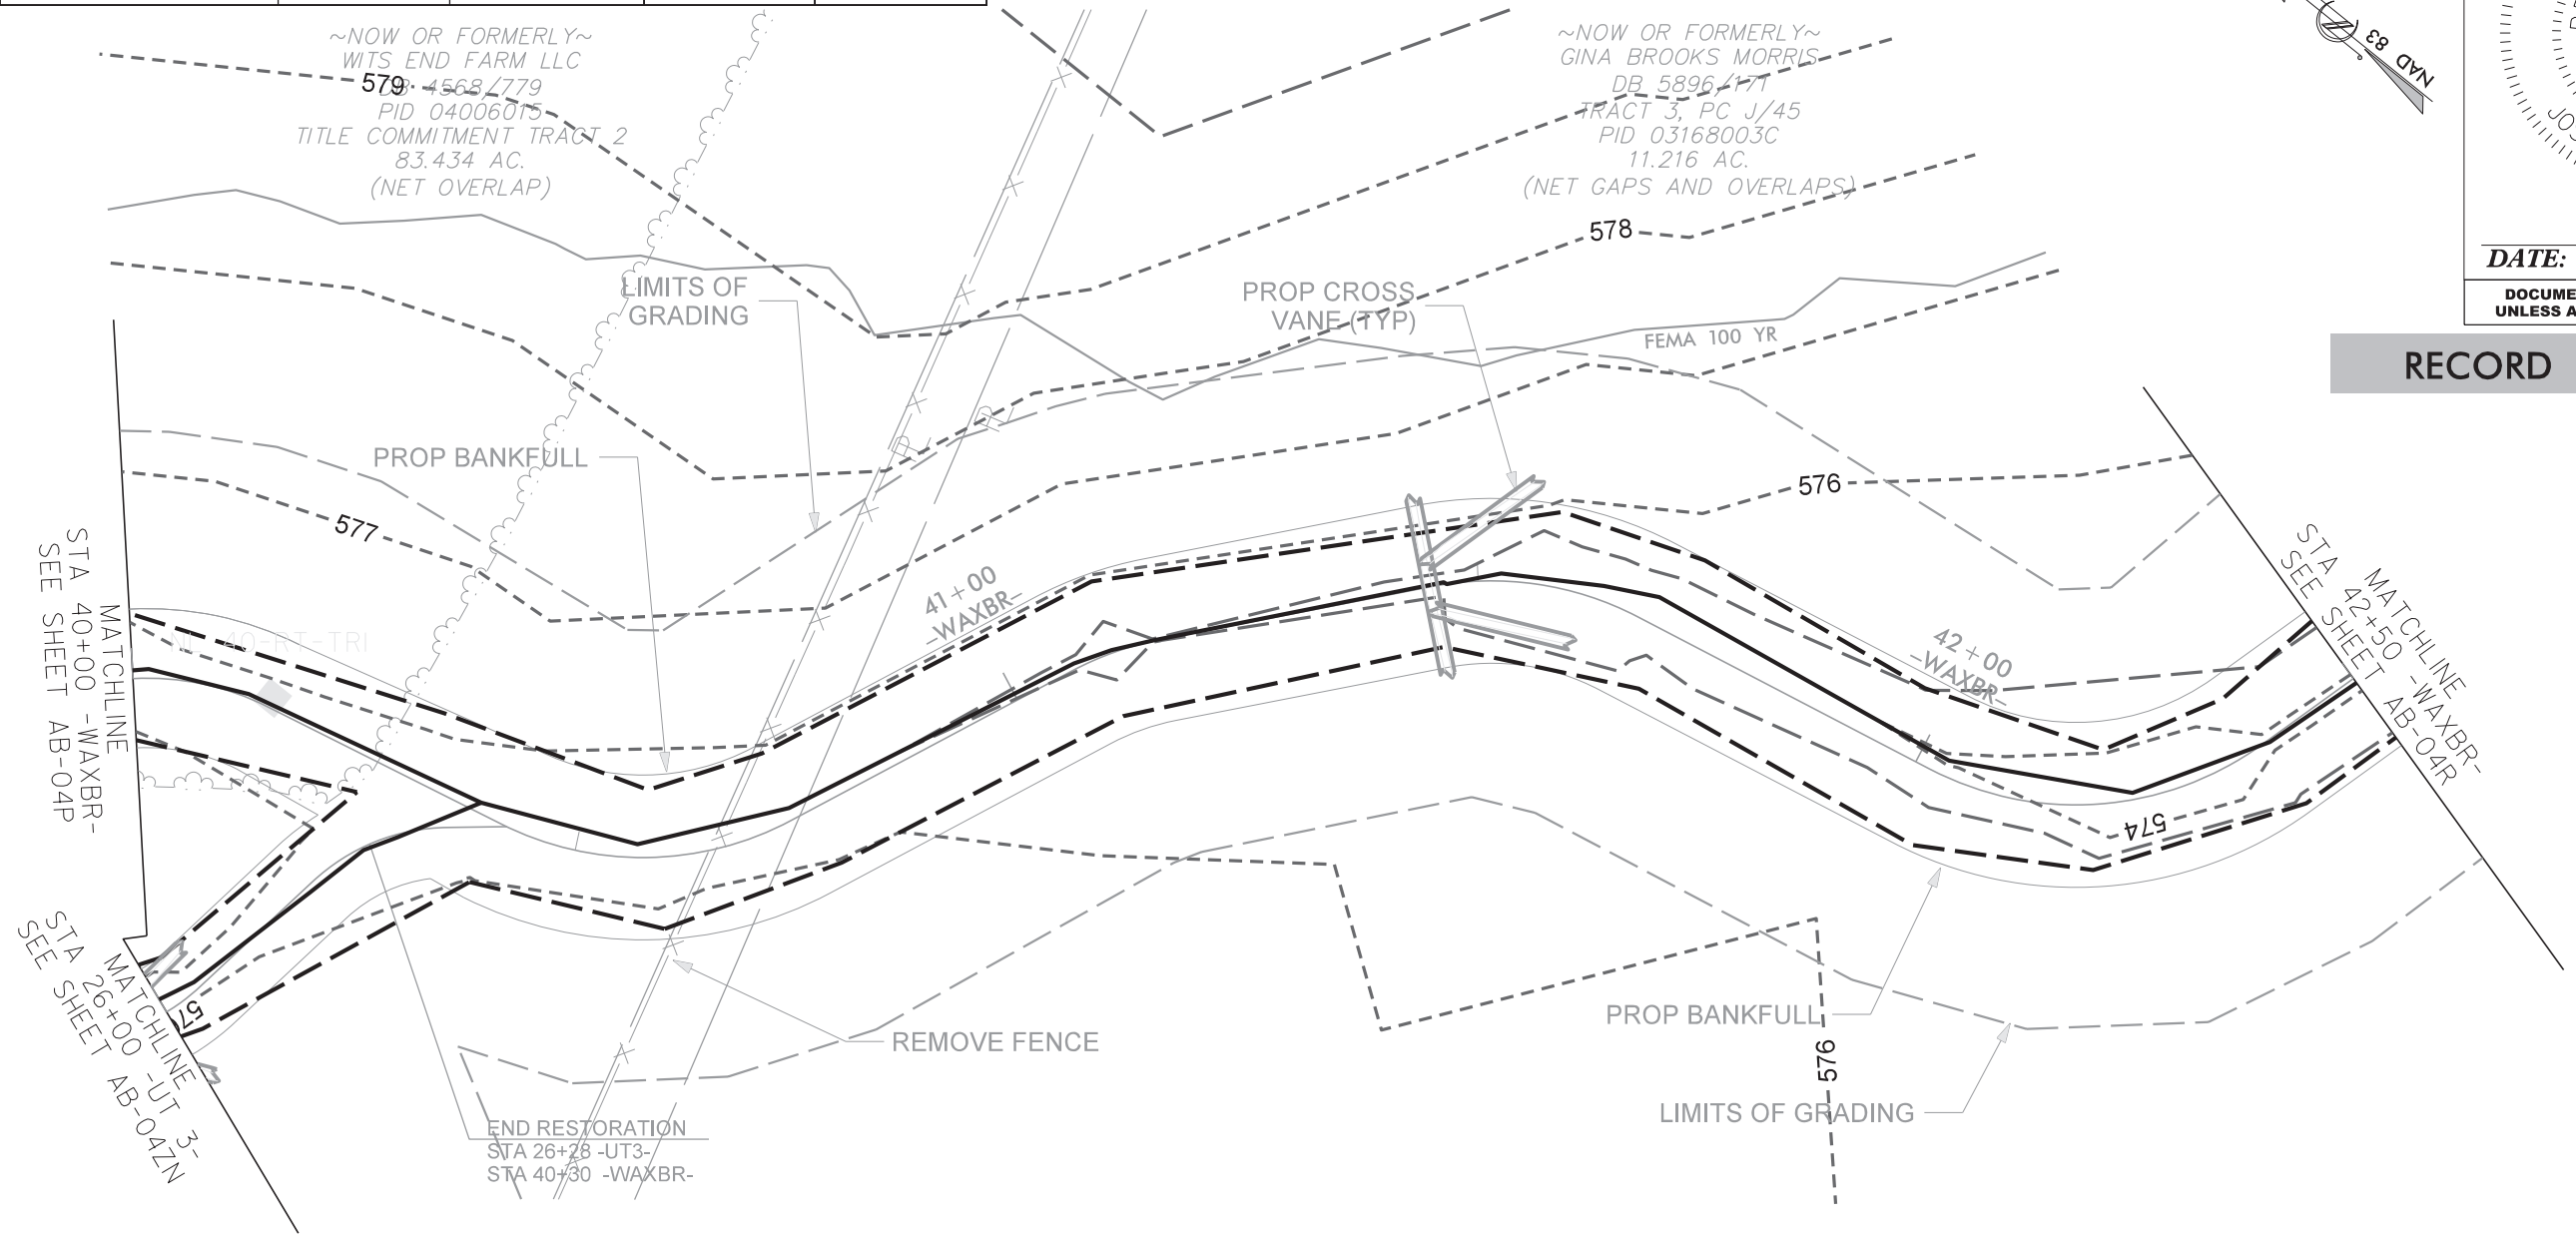

© 2022 SUNGATE DESIGN GROUP, P.A. THIS DRAWING AND ALL REPRODUCTIONS OF IT ARE THE SOLE PROPERTY OF SDG. REPRODUCTION OR OTHER USES OF THIS DRAWING WITHOUT WRITTEN CONSENT OF SDG IS NOT PERMITTED.


**WITS END**  
 UNION COUNTY, NC  
**AS-BUILT STRUCTURES**

PROJECT #: 1221-20024  
 DRAWING NAME: WITS END PSH AB-040  
 DATE: 2022  
 DRAWN BY: JRH  
 REVIEWED BY: JGD  
 REVISIONS:  
 SHEET NO. **AB-04Q**

10/6/2022  
 Wits\_End\_Psh\_AB-040.dgn



# RECORD DRAWING

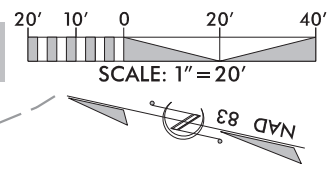


DocuSigned by:  
**Josh Dalton**  
 1089AD8C14994C3...  
 PROFESSIONAL SEAL  
 26971  
 ENGINEER  
 JOSHUA G. DALTON

DATE: 10/7/2022

**DOCUMENT NOT CONSIDERED FINAL  
 UNLESS ALL SIGNATURES COMPLETED**

**SUNGATE DESIGN GROUP, P.A.**  
 840 GILES FARM ROAD  
 SUITE 200  
 FAYETTEVILLE, NC 27806  
 TEL: (919) 855-2243  
 ENG. FIRM LICENSE NO. C-980

**Aslam Environmental, Inc.**

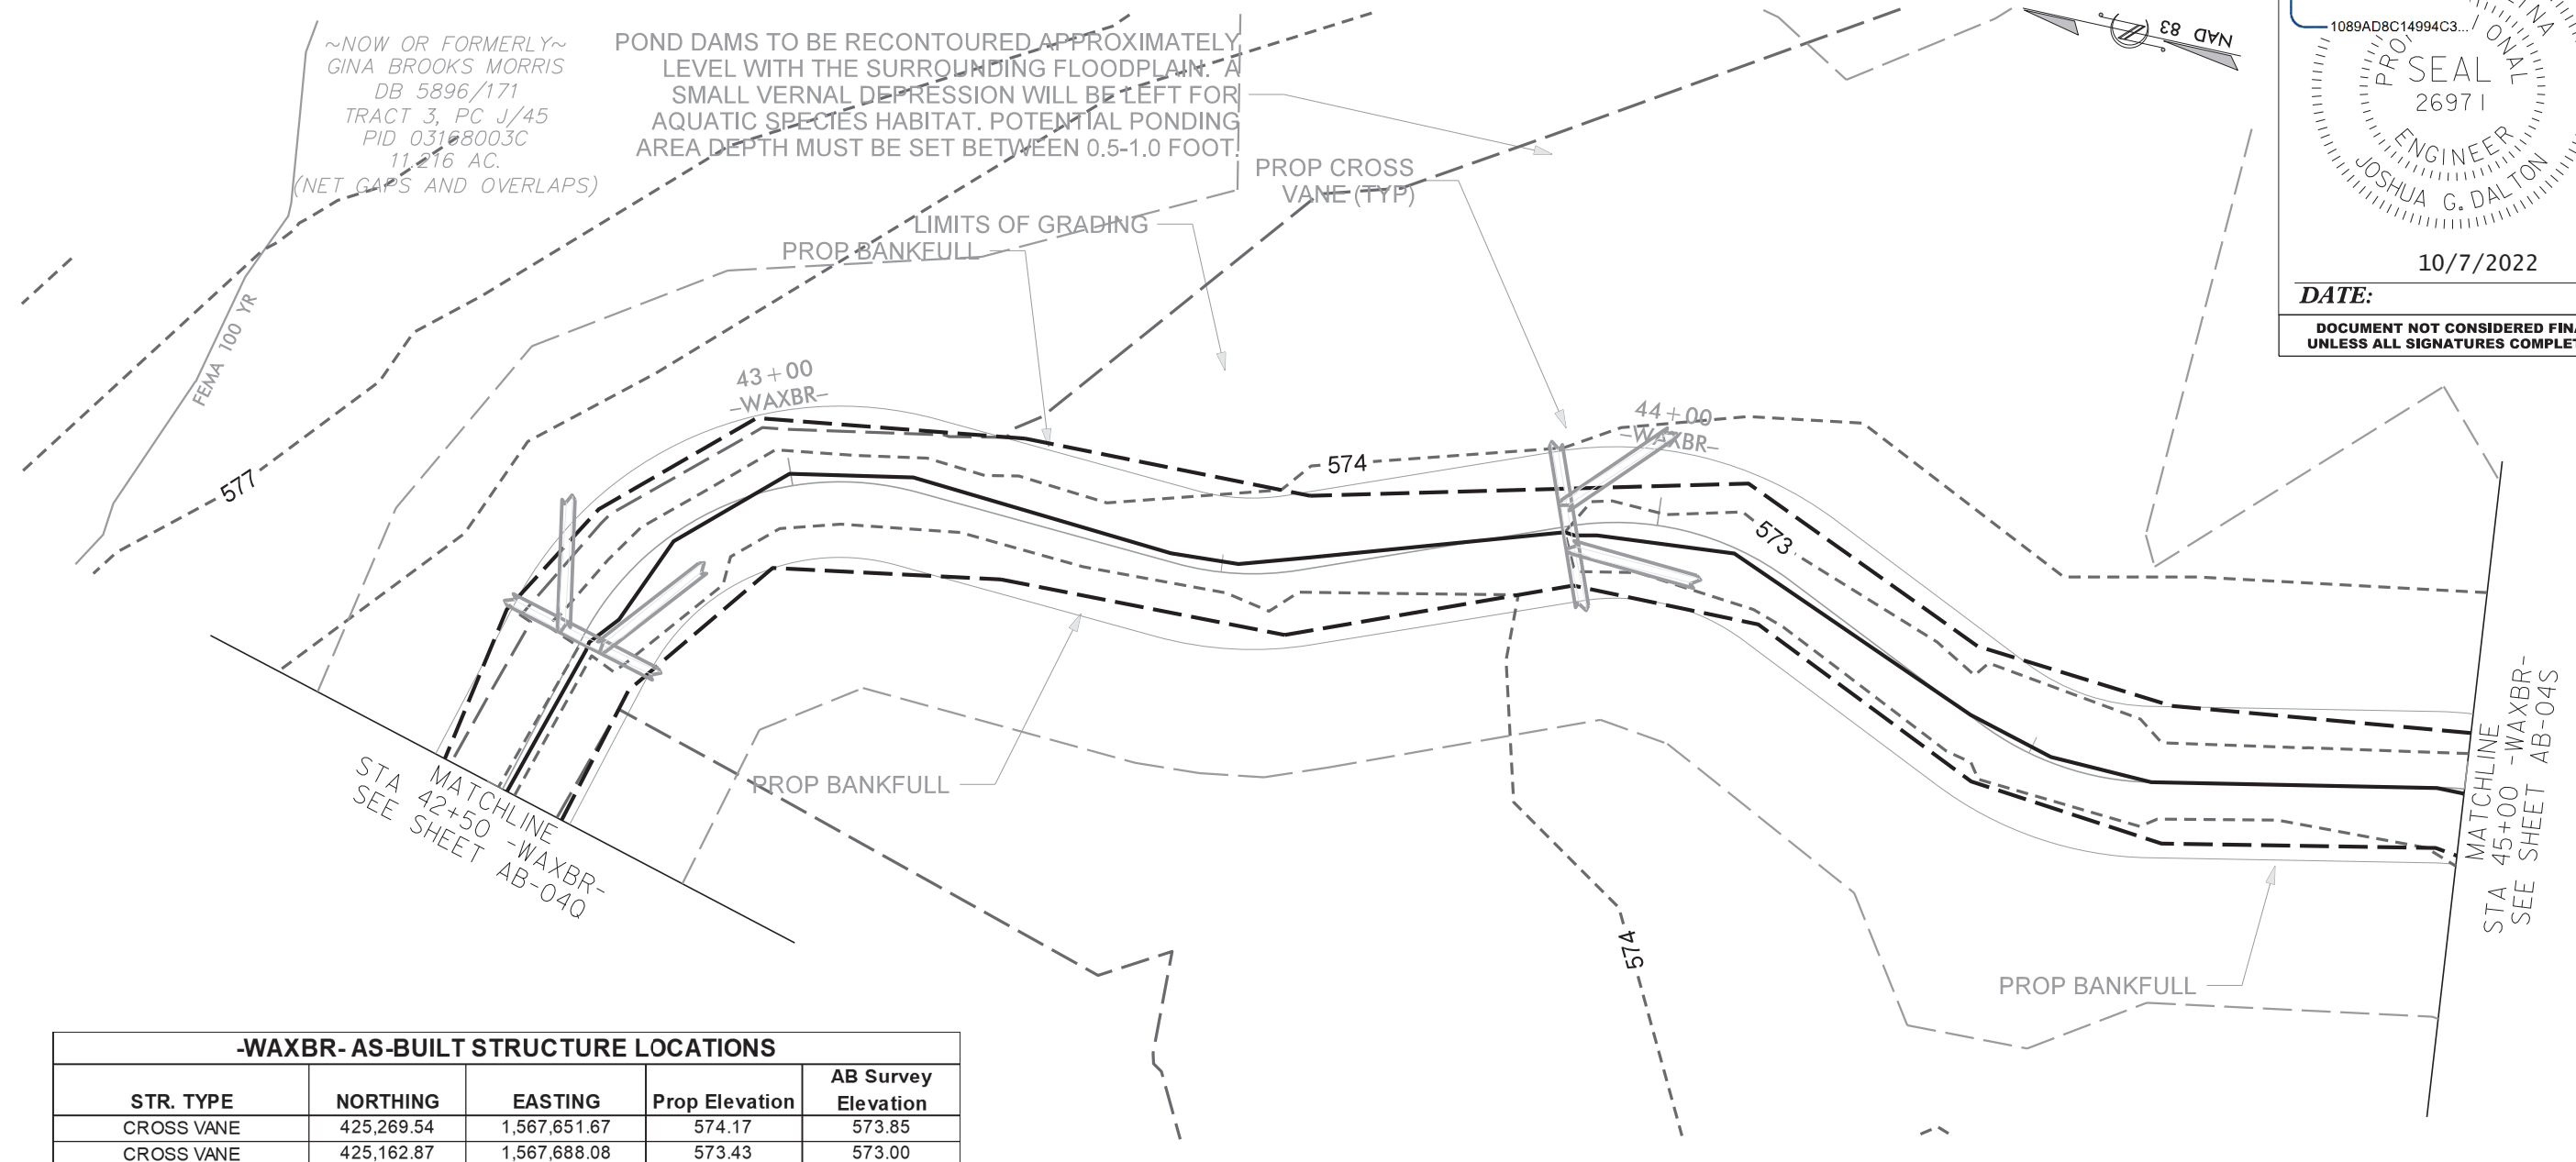


~NOW OR FORMERLY~  
 GINA BROOKS MORRIS  
 DB 5896/171  
 TRACT 3, PC J/45  
 PID 03188003C  
 11.216 AC.  
 (NET GAPS AND OVERLAPS)

POND DAMS TO BE RECONTOURED APPROXIMATELY  
 LEVEL WITH THE SURROUNDING FLOODPLAIN. A  
 SMALL VERNAL DEPRESSION WILL BE LEFT FOR  
 AQUATIC SPECIES HABITAT. POTENTIAL PONDING  
 AREA DEPTH MUST BE SET BETWEEN 0.5-1.0 FOOT!

**-WAXBR- AS-BUILT STRUCTURE LOCATIONS**

STR. TYPE	NORTHING	EASTING	Prop Elevation	AB Survey Elevation
CROSS VANE	425,269.54	1,567,651.67	574.17	573.85
CROSS VANE	425,162.87	1,567,688.08	573.43	573.00

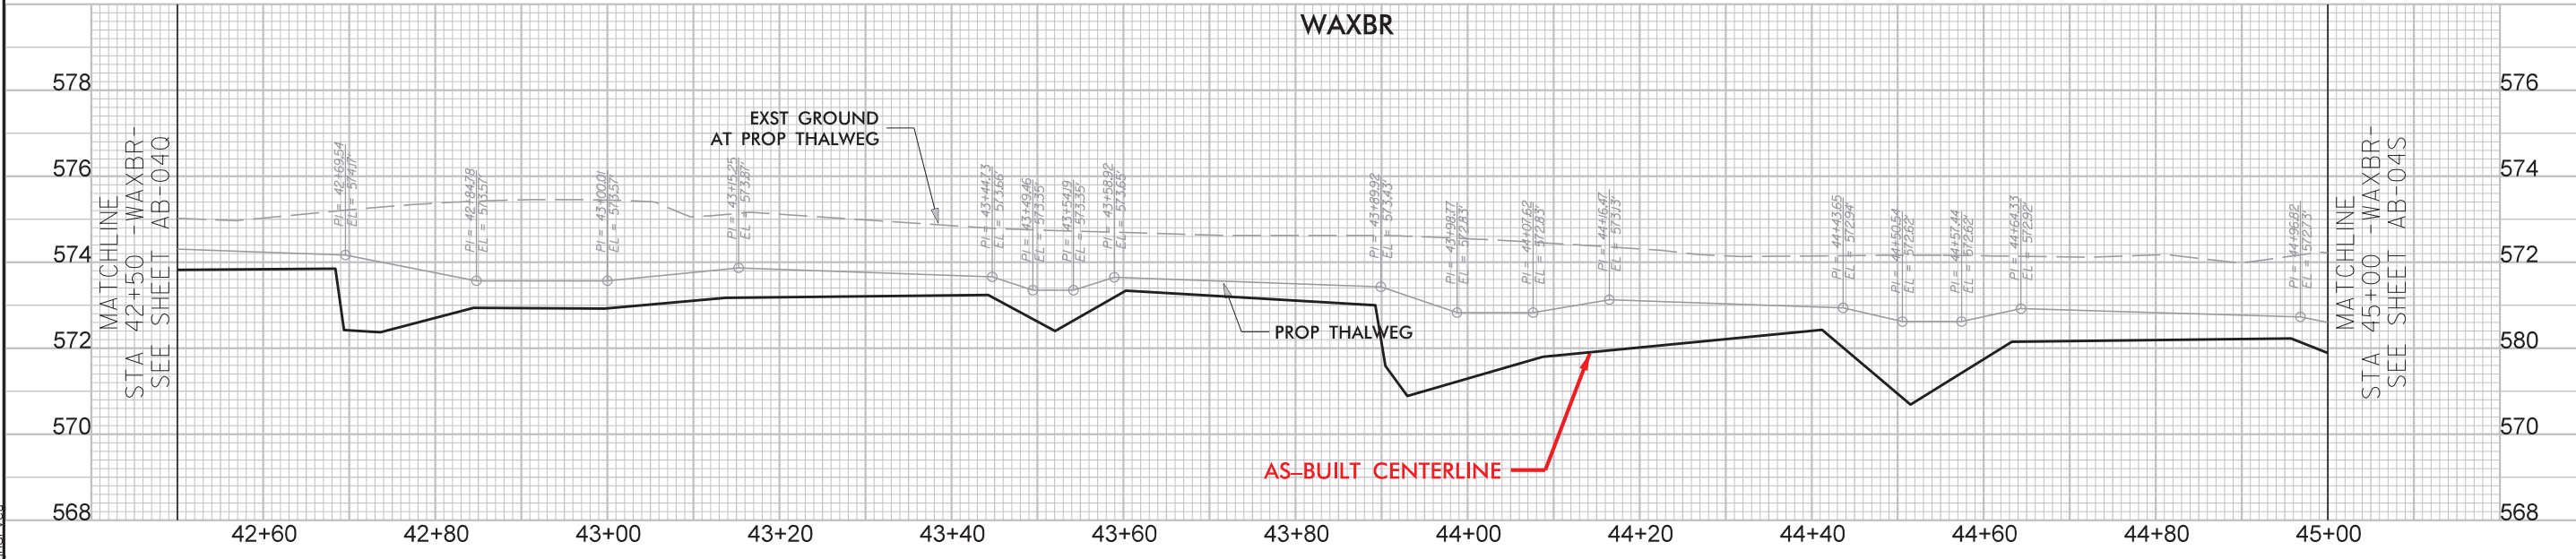

10/6/2022  
 Wits\_End\_Psh\_AB-04R.dgn



© 2022 SUNGATE DESIGN GROUP, P.A. THIS DRAWING AND ALL REPRODUCTIONS OF IT ARE THE SOLE PROPERTY OF SDG. REPRODUCTION OR OTHER USES OF THIS DRAWING WITHOUT WRITTEN CONSENT OF SDG IS NOT PERMITTED.

**WITS END**  
 UNION COUNTY, NC

**AS-BUILT STRUCTURES**


PROJECT # : 1221-20024  
 DRAWING NAME: WITS END PSH AB-04R  
 DATE: 2022  
 DRAWN BY: JRH  
 REVIEWED BY: JGD  
 REVISIONS:

SHEET NO.  
**AB-04R**

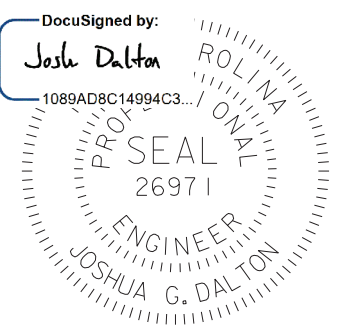
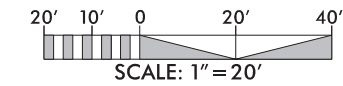


DocuSigned by:  
**Josh Dalton**  
 1089AD8C14994C3...  
**DATE:** 10/7/2022  
**DOCUMENT NOT CONSIDERED FINAL UNLESS ALL SIGNATURES COMPLETED**

**SUNGATE DESIGN GROUP, P.A.**  
 890 GUNNERS ROAD  
 SUITE 100  
 WILSON, NC 27606  
 TEL: (919) 855-2243  
 FAX: (919) 855-2243  
 ENG. FIRM LICENSE NO. C-980

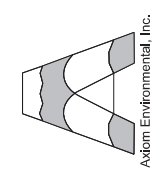

**RECORD DRAWING**

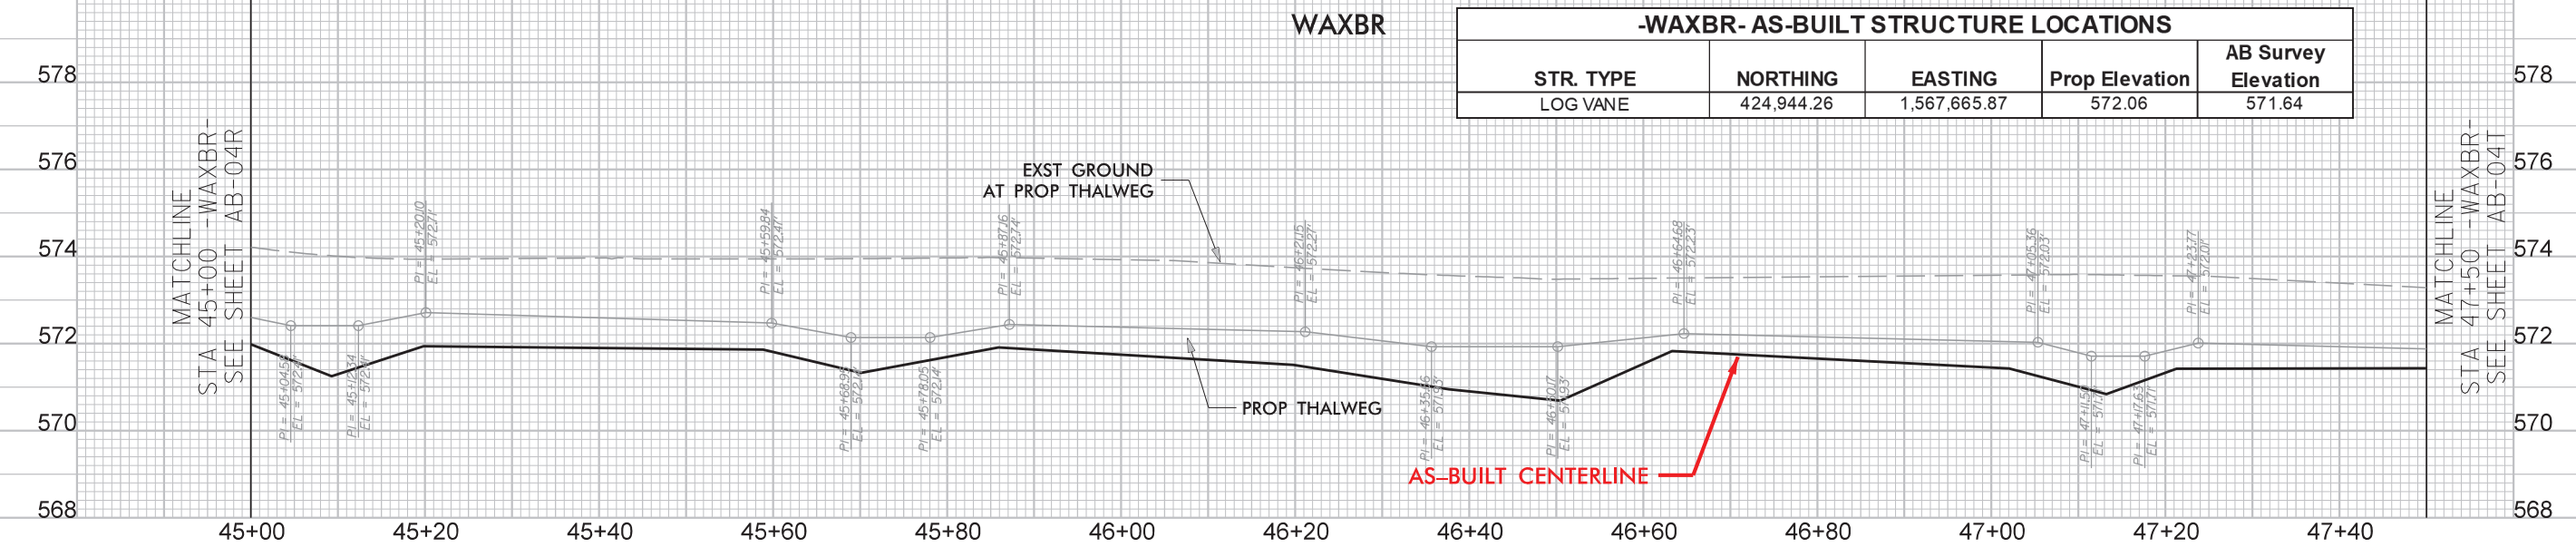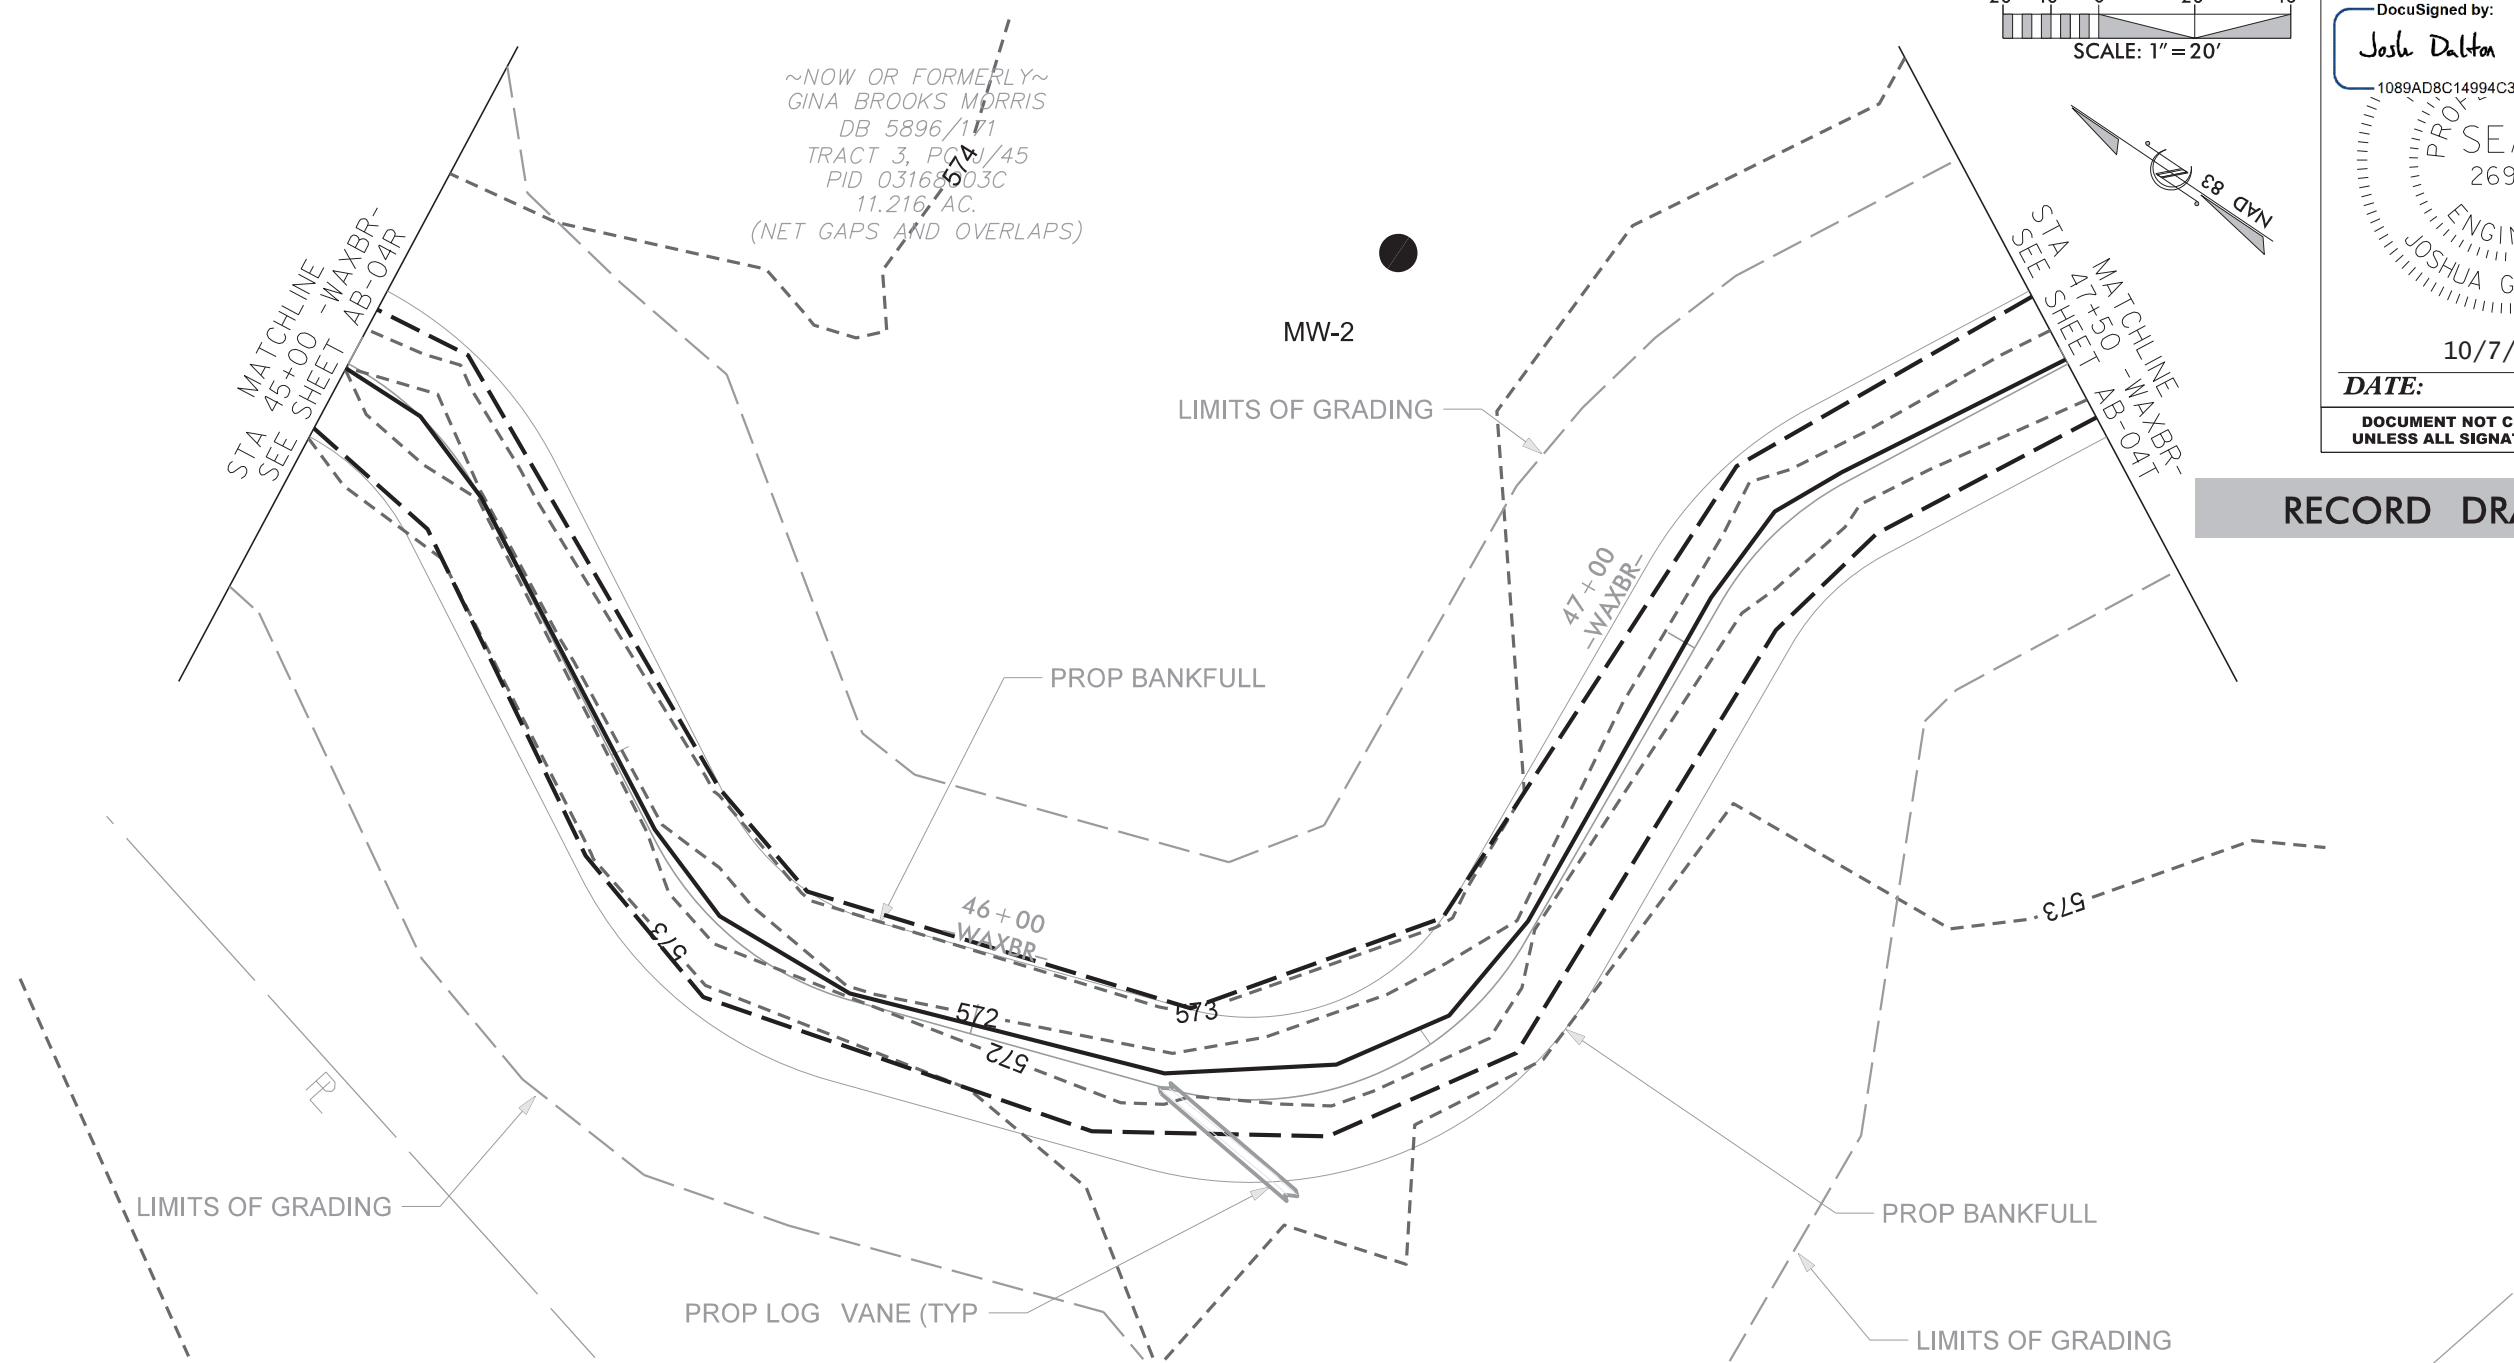

10/6/2022  
 Wits\_Endr\_psh\_AB-04S.dgn  
 jgd


© 2022 SUNGATE DESIGN GROUP, P.A. THIS DRAWING AND ALL REPRODUCTIONS OF IT ARE THE SOLE PROPERTY OF SDG. REPRODUCTION OR OTHER USES OF THIS DRAWING WITHOUT WRITTEN CONSENT OF SDG IS NOT PERMITTED.

**WITS END**  
 UNION COUNTY, NC  
**AS-BUILT STRUCTURES**

PROJECT #: 1221-20024  
 DRAWING NAME: WITS END PSH AB-04S  
 DATE: 2022  
 DRAWN BY: JRH  
 REVIEWED BY: JGD  
 REVISIONS:

SHEET NO.  
**AB-04S**

# RECORD DRAWING

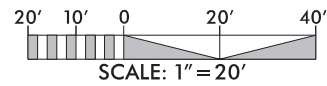



DocuSigned by:  
*Josh Dalton*  
 1089AD8C14994C3...  
 PROFESSIONAL SEAL  
 26971  
 ENGINEER  
 JOSHUA G. DALTON

DATE: 10/7/2022

DOCUMENT NOT CONSIDERED FINAL  
UNLESS ALL SIGNATURES COMPLETED

SUNGATE DESIGN GROUP, P.A.  
 8908 W. HANCOCK ROAD  
 SUITE 200  
 CHARLOTTE, NC 28217  
 TEL: (919) 855-2243  
 ENG. FIRM LICENSE NO. C-980

Axiom Environmental, Inc.

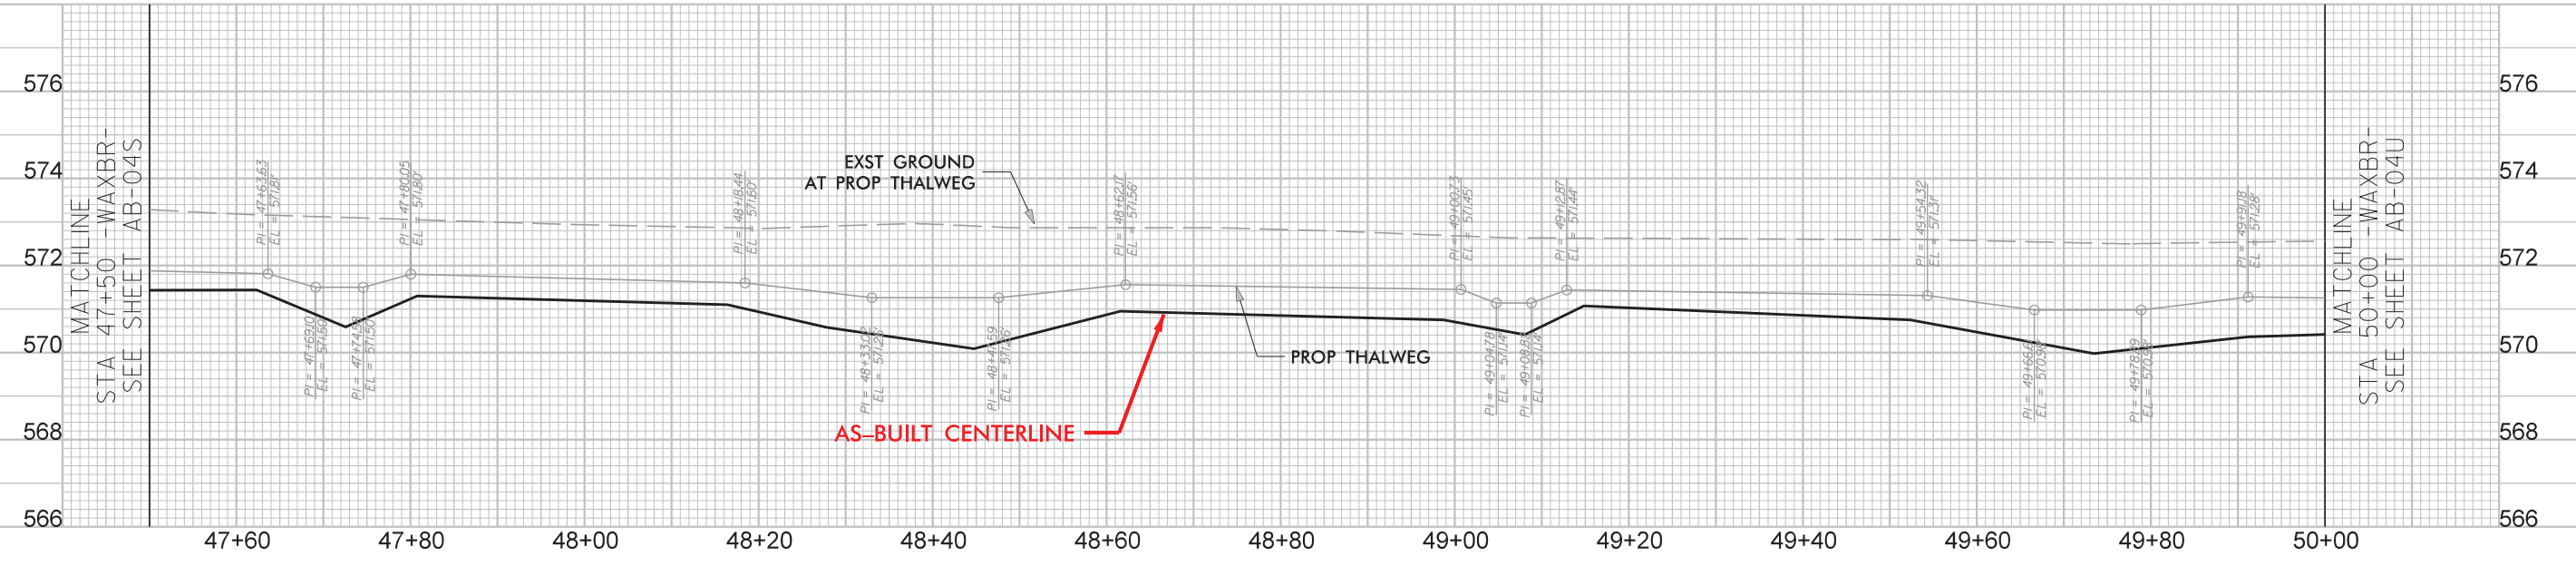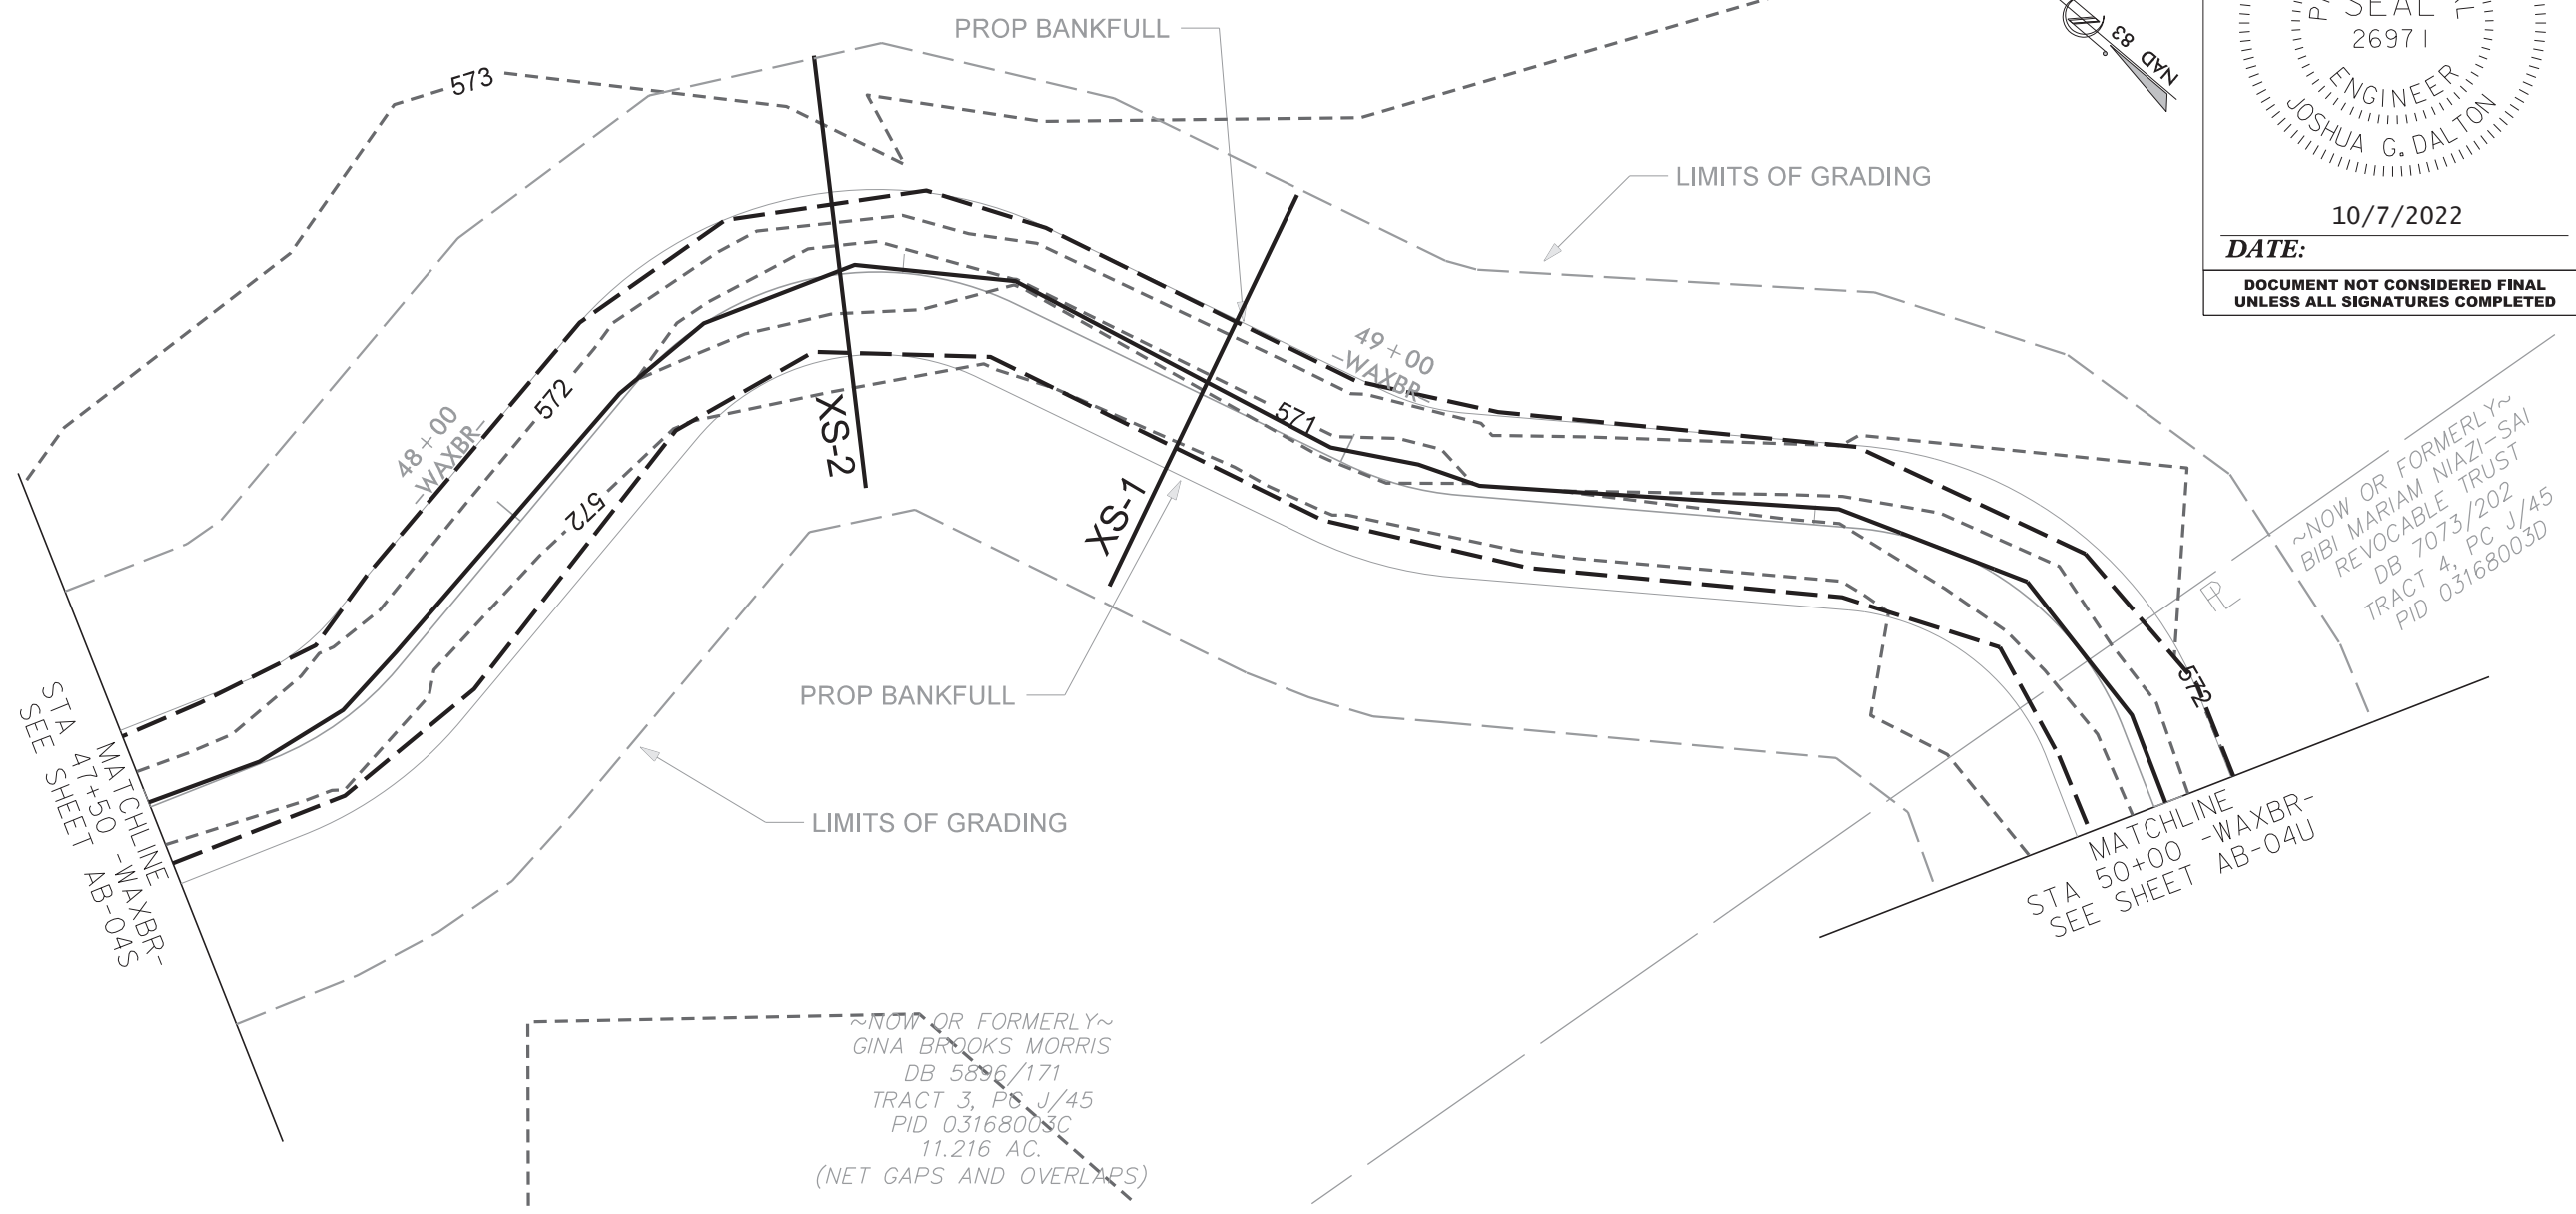

10/6/2022  
Wits\_Endr\_psh\_AB-04T.dgn

© 2022 SUNGATE DESIGN GROUP, P.A. THIS DRAWING AND ALL REPRODUCTIONS OF IT ARE THE SOLE PROPERTY OF SDG. REPRODUCTION OR OTHER USES OF THIS DRAWING WITHOUT WRITTEN CONSENT OF SDG IS NOT PERMITTED.



WITS END  
 UNION COUNTY, NC  
 AS-BUILT STRUCTURES

PROJECT # : 1221-20024  
 DRAWING NAME: WITS END PSH AB-04T  
 DATE: 2022  
 DRAWN BY: JRH  
 REVIEWED BY: JGD  
 REVISIONS:

SHEET NO.  
**AB-04T**





# RECORD DRAWING

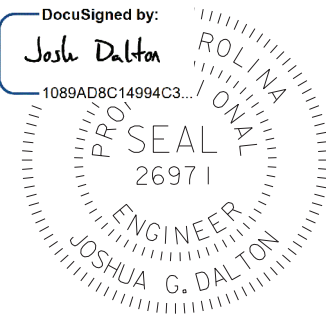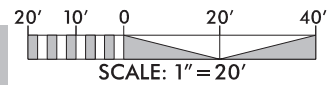

DATE: 10/7/2022


DOCUMENT NOT CONSIDERED FINAL  
UNLESS ALL SIGNATURES COMPLETED

~NOW OR FORMERLY~  
BIBI MARIAM NIAZI-SAI REVOCABLE TRUST  
DB 7073/202  
TRACT 4, PC J/45  
PID 03168003D

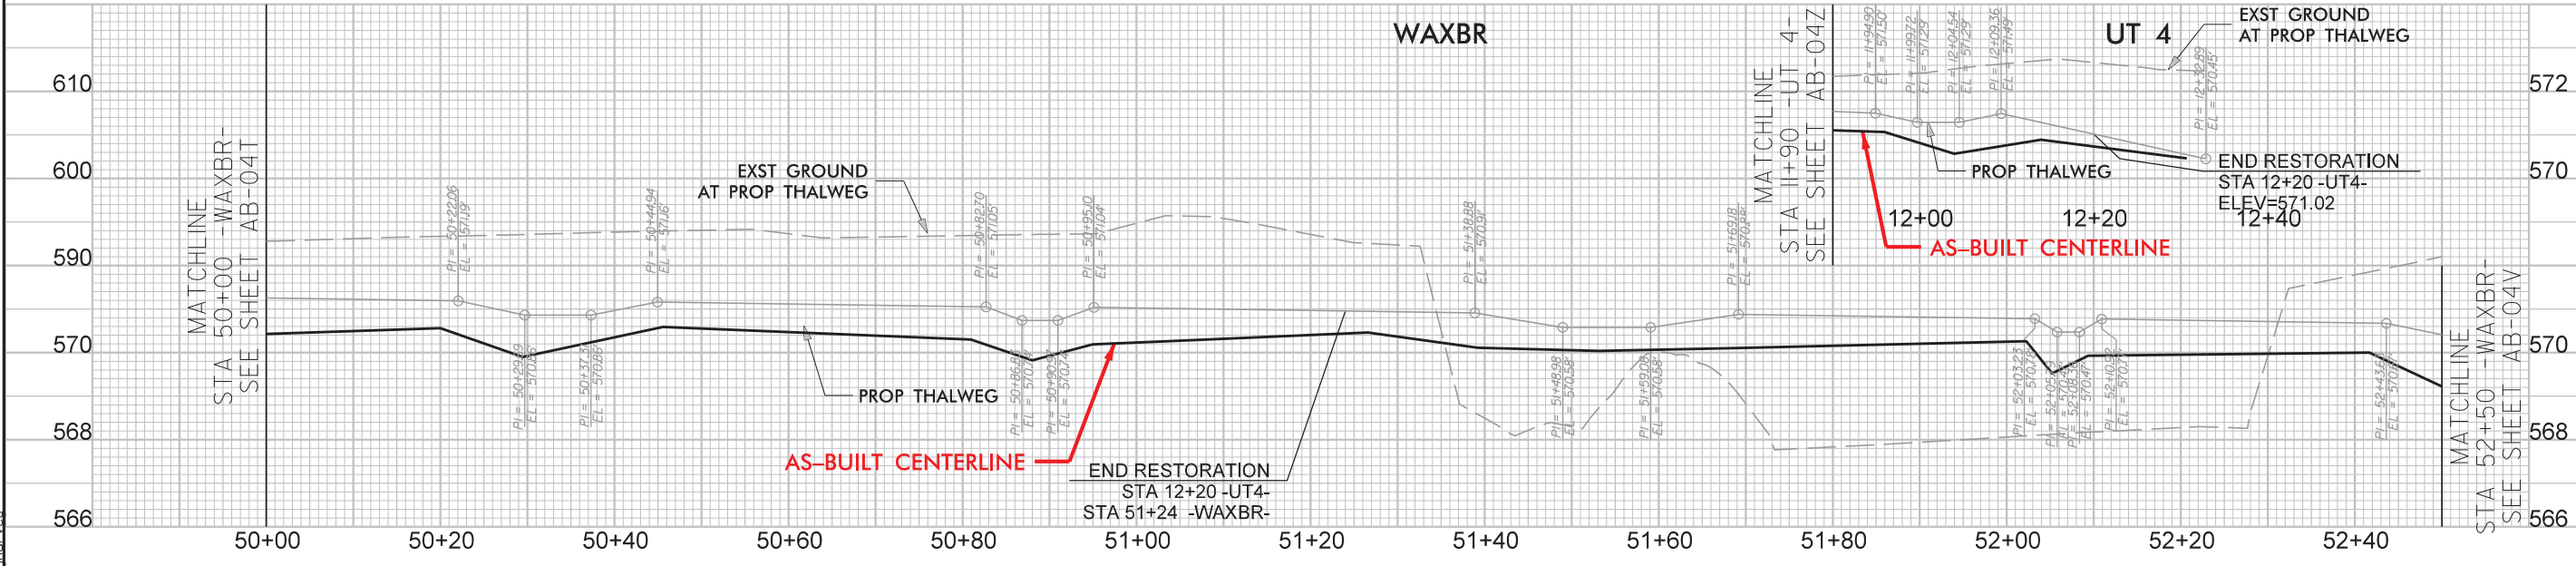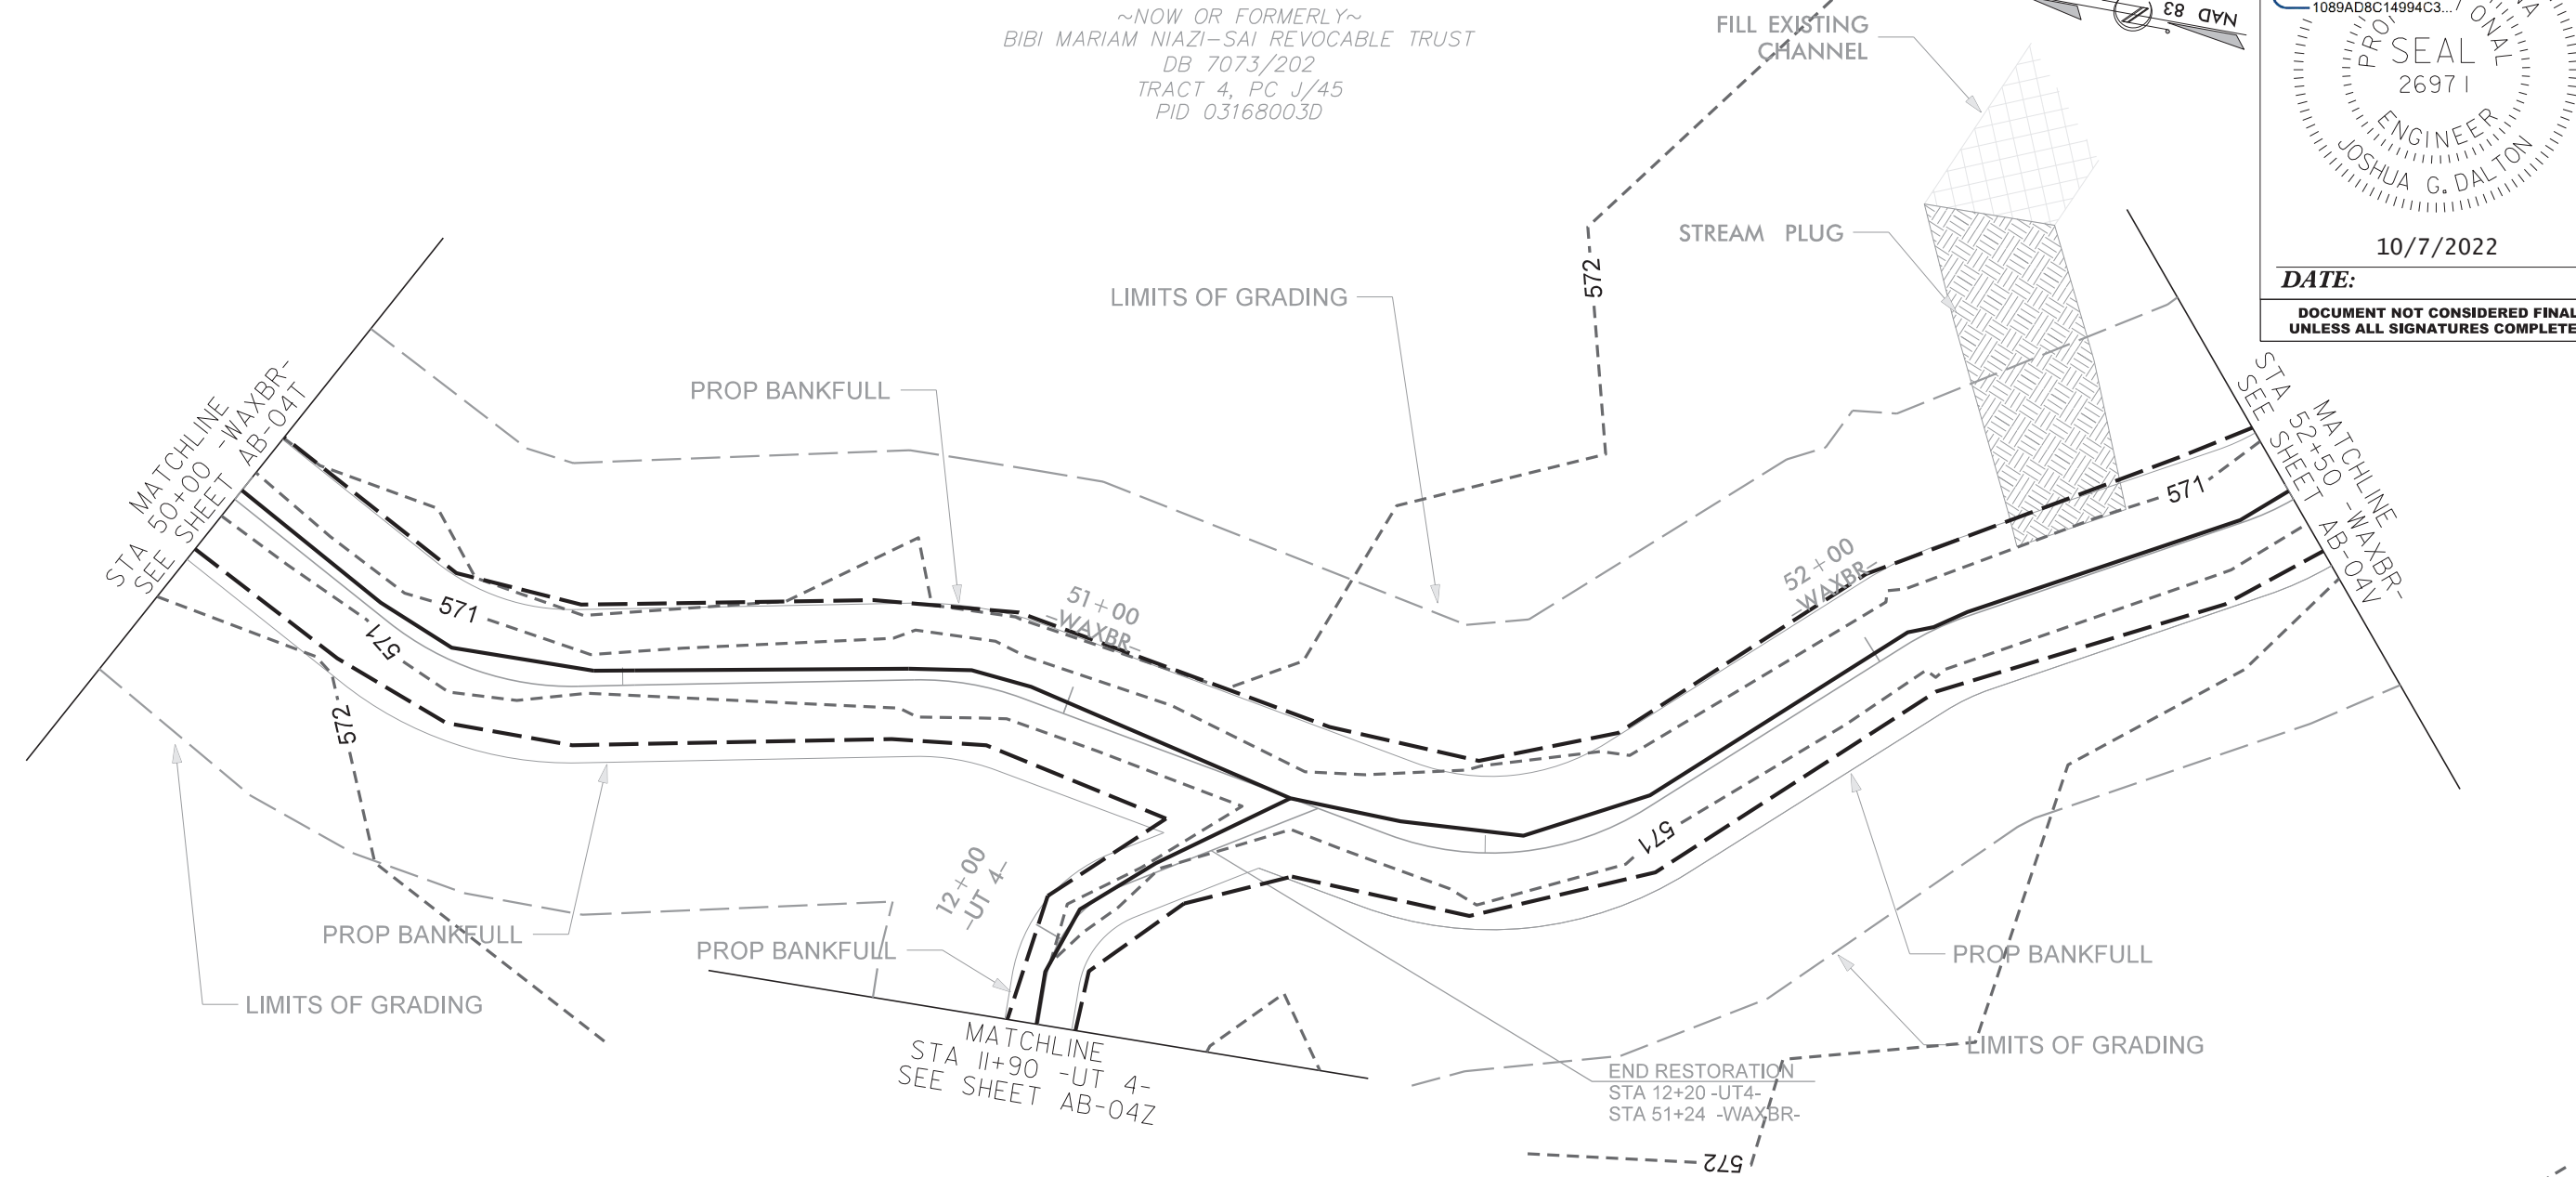

10/6/2022  
Wits\_Endr\_psh\_AB-04U.dgn

SUNGATE DESIGN GROUP, P.A.  
5808 S. FRANKLIN ROAD  
SUITE 200  
CARY, NC 27513  
TEL: (919) 855-2243  
ENG. FIRM LICENSE NO. C-980

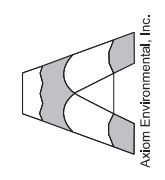

PROJECT # :  
1221-20024  
DRAWING NAME:  
WITS END PSH AB-04U  
DATE:  
2022  
DRAWN BY:  
JRH  
REVIEWED BY:  
JGD  
REVISIONS:


WITS END  
UNION COUNTY, NC

AS-BUILT STRUCTURES

SHEET NO.  
**AB-04U**

© 2022 SUNGATE DESIGN GROUP, P.A. THIS DRAWING AND ALL REPRODUCTIONS OF IT ARE THE SOLE PROPERTY OF SDG. REPRODUCTION OR OTHER USES OF THIS DRAWING WITHOUT WRITTEN CONSENT OF SDG IS NOT PERMITTED.

**RECORD DRAWING**

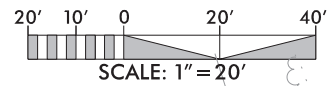


DocuSigned by:  
**Josh Dalton**  
 1089AD8C14994C3...  
 PROFESSIONAL ENGINEER  
 26971  
**JOSHUA G. DALTON**  
 DATE: 10/7/2022


**SUNGATE DESIGN GROUP, P.A.**  
 890 GILES FARM LANE ROAD  
 SUITE 2000 CARY, NC 27513  
 TEL: (919) 855-2243  
 ENG FIRM LICENSE NO. C-980

**-WAXBR- AS-BUILT STRUCTURE LOCATIONS**


STR. TYPE	NORTHING	EASTING	Prop Elevation	AB Survey Elevation
DROP STRUCTURE	424,512.41	1,567,971.80	570.65	570.31
DROP STRUCTURE	424,467.50	1,568,095.49	567.68	567.53

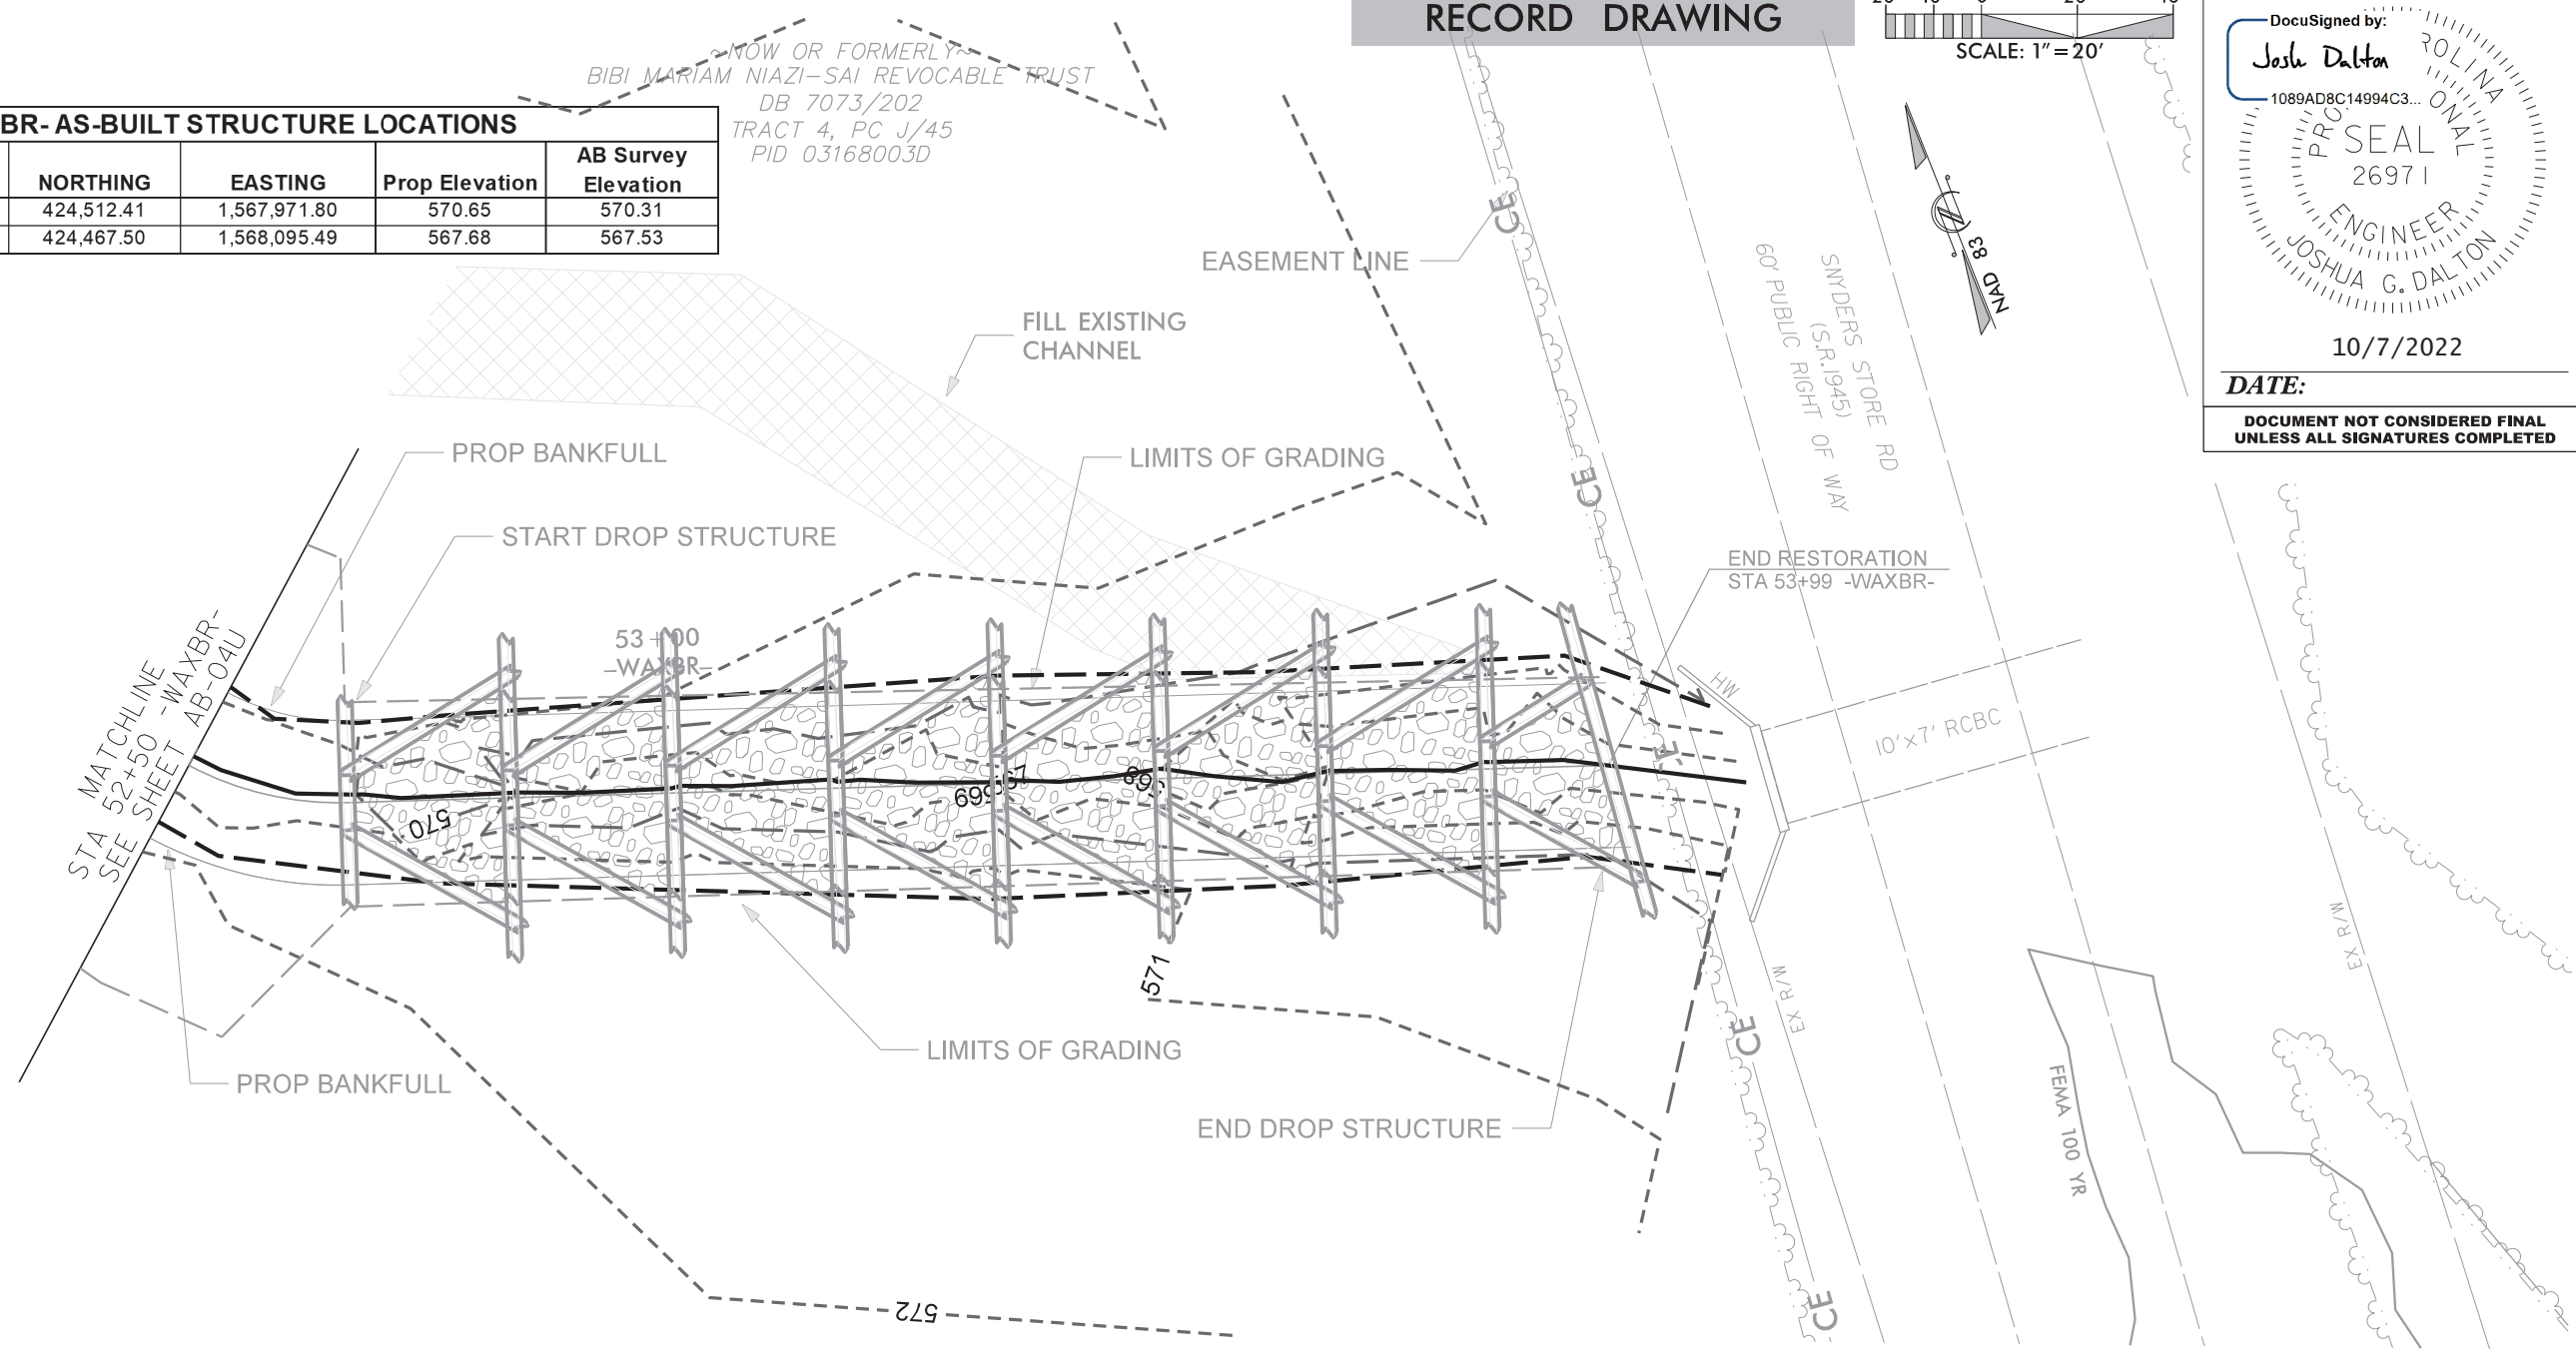

**DOCUMENT NOT CONSIDERED FINAL UNLESS ALL SIGNATURES COMPLETED**

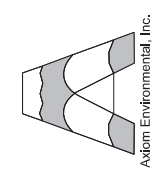

**WITS END**  
 UNION COUNTY, NC  
**AS-BUILT STRUCTURES**

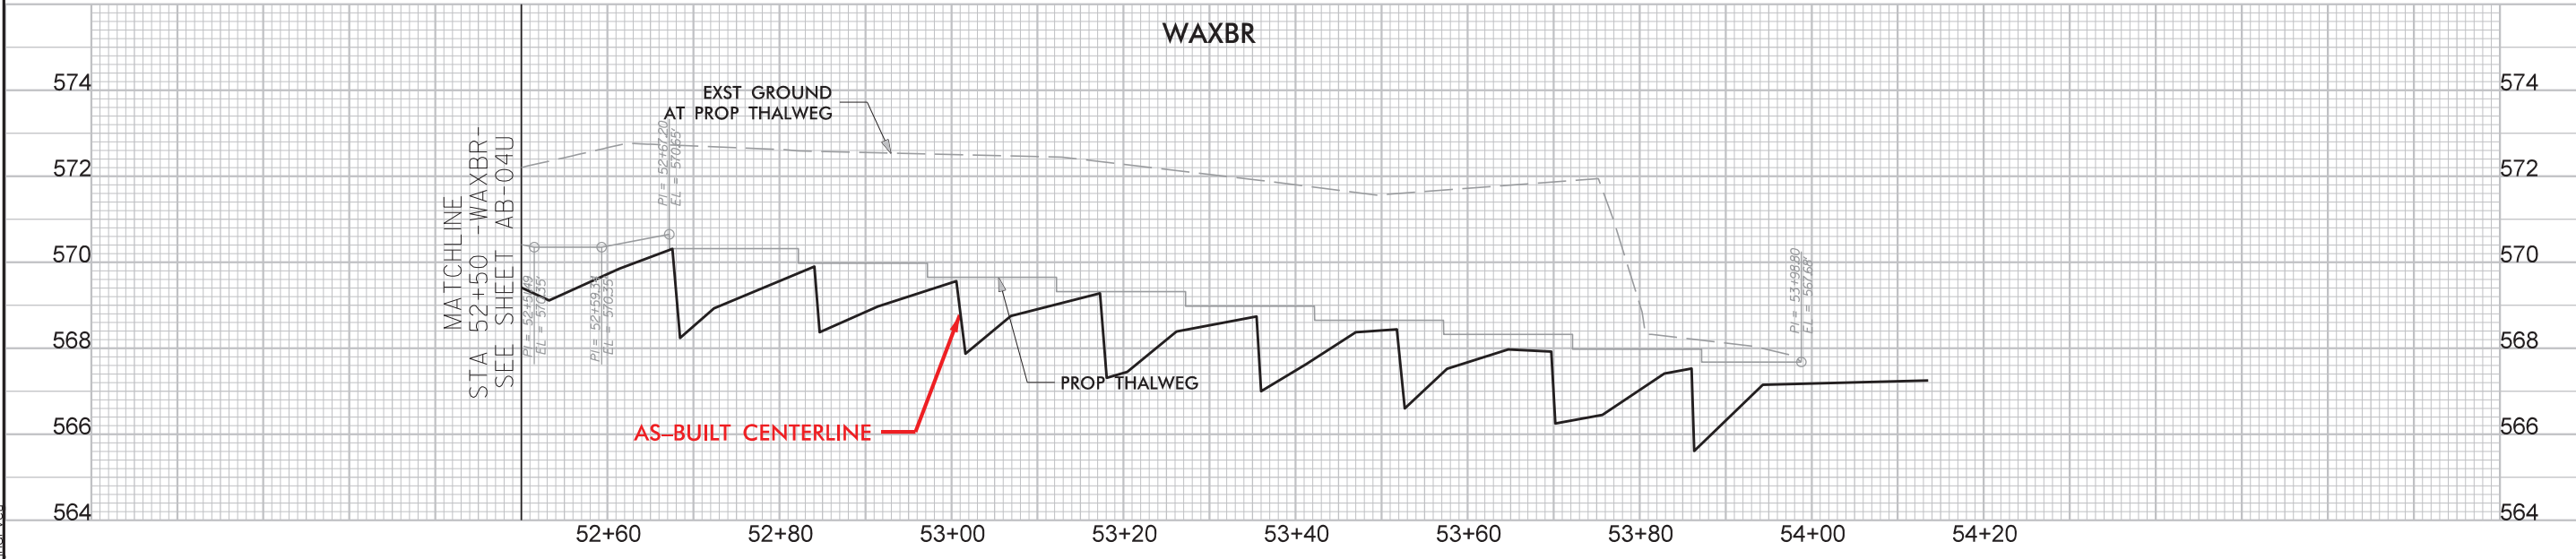

PROJECT #: 1221-20024  
 DRAWING NAME: WITS END PSH AB-04V  
 DATE: 2022  
 DRAWN BY: JRH  
 REVIEWED BY: JGD  
 REVISIONS:

SHEET NO.  
**AB-04V**


10/6/2022 Wits\_End\_Psh\_AB-04V.dgn

© 2022 SUNGATE DESIGN GROUP, P.A. THIS DRAWING AND ALL REPRODUCTIONS OF IT ARE THE SOLE PROPERTY OF SDG. REPRODUCTION OR OTHER USES OF THIS DRAWING WITHOUT WRITTEN CONSENT OF SDG IS NOT PERMITTED.






# RECORD DRAWING

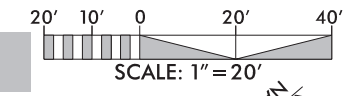


DocuSigned by:  
**Josh Dalton**  
 1089AD8C14994C3...  
 PROFESSIONAL SEAL  
 ENGINEER  
 JOSHUA G. DALTON  
 26971  
 DATE: 10/7/2022

**SUNGATE DESIGN GROUP, P.A.**  
 8908 W. FRANKLIN ROAD  
 SUITE 200  
 WILSON, NC 27604  
 TEL: (919) 855-2243  
 FAX: (919) 855-2243  
 ENG. FIRM LICENSE NO. C-980

~NOW OR FORMERLY~  
 ROGER L JAMES  
 CYNTHIA L JAMES  
 BK 4460 PG 790  
 PID 03168004A

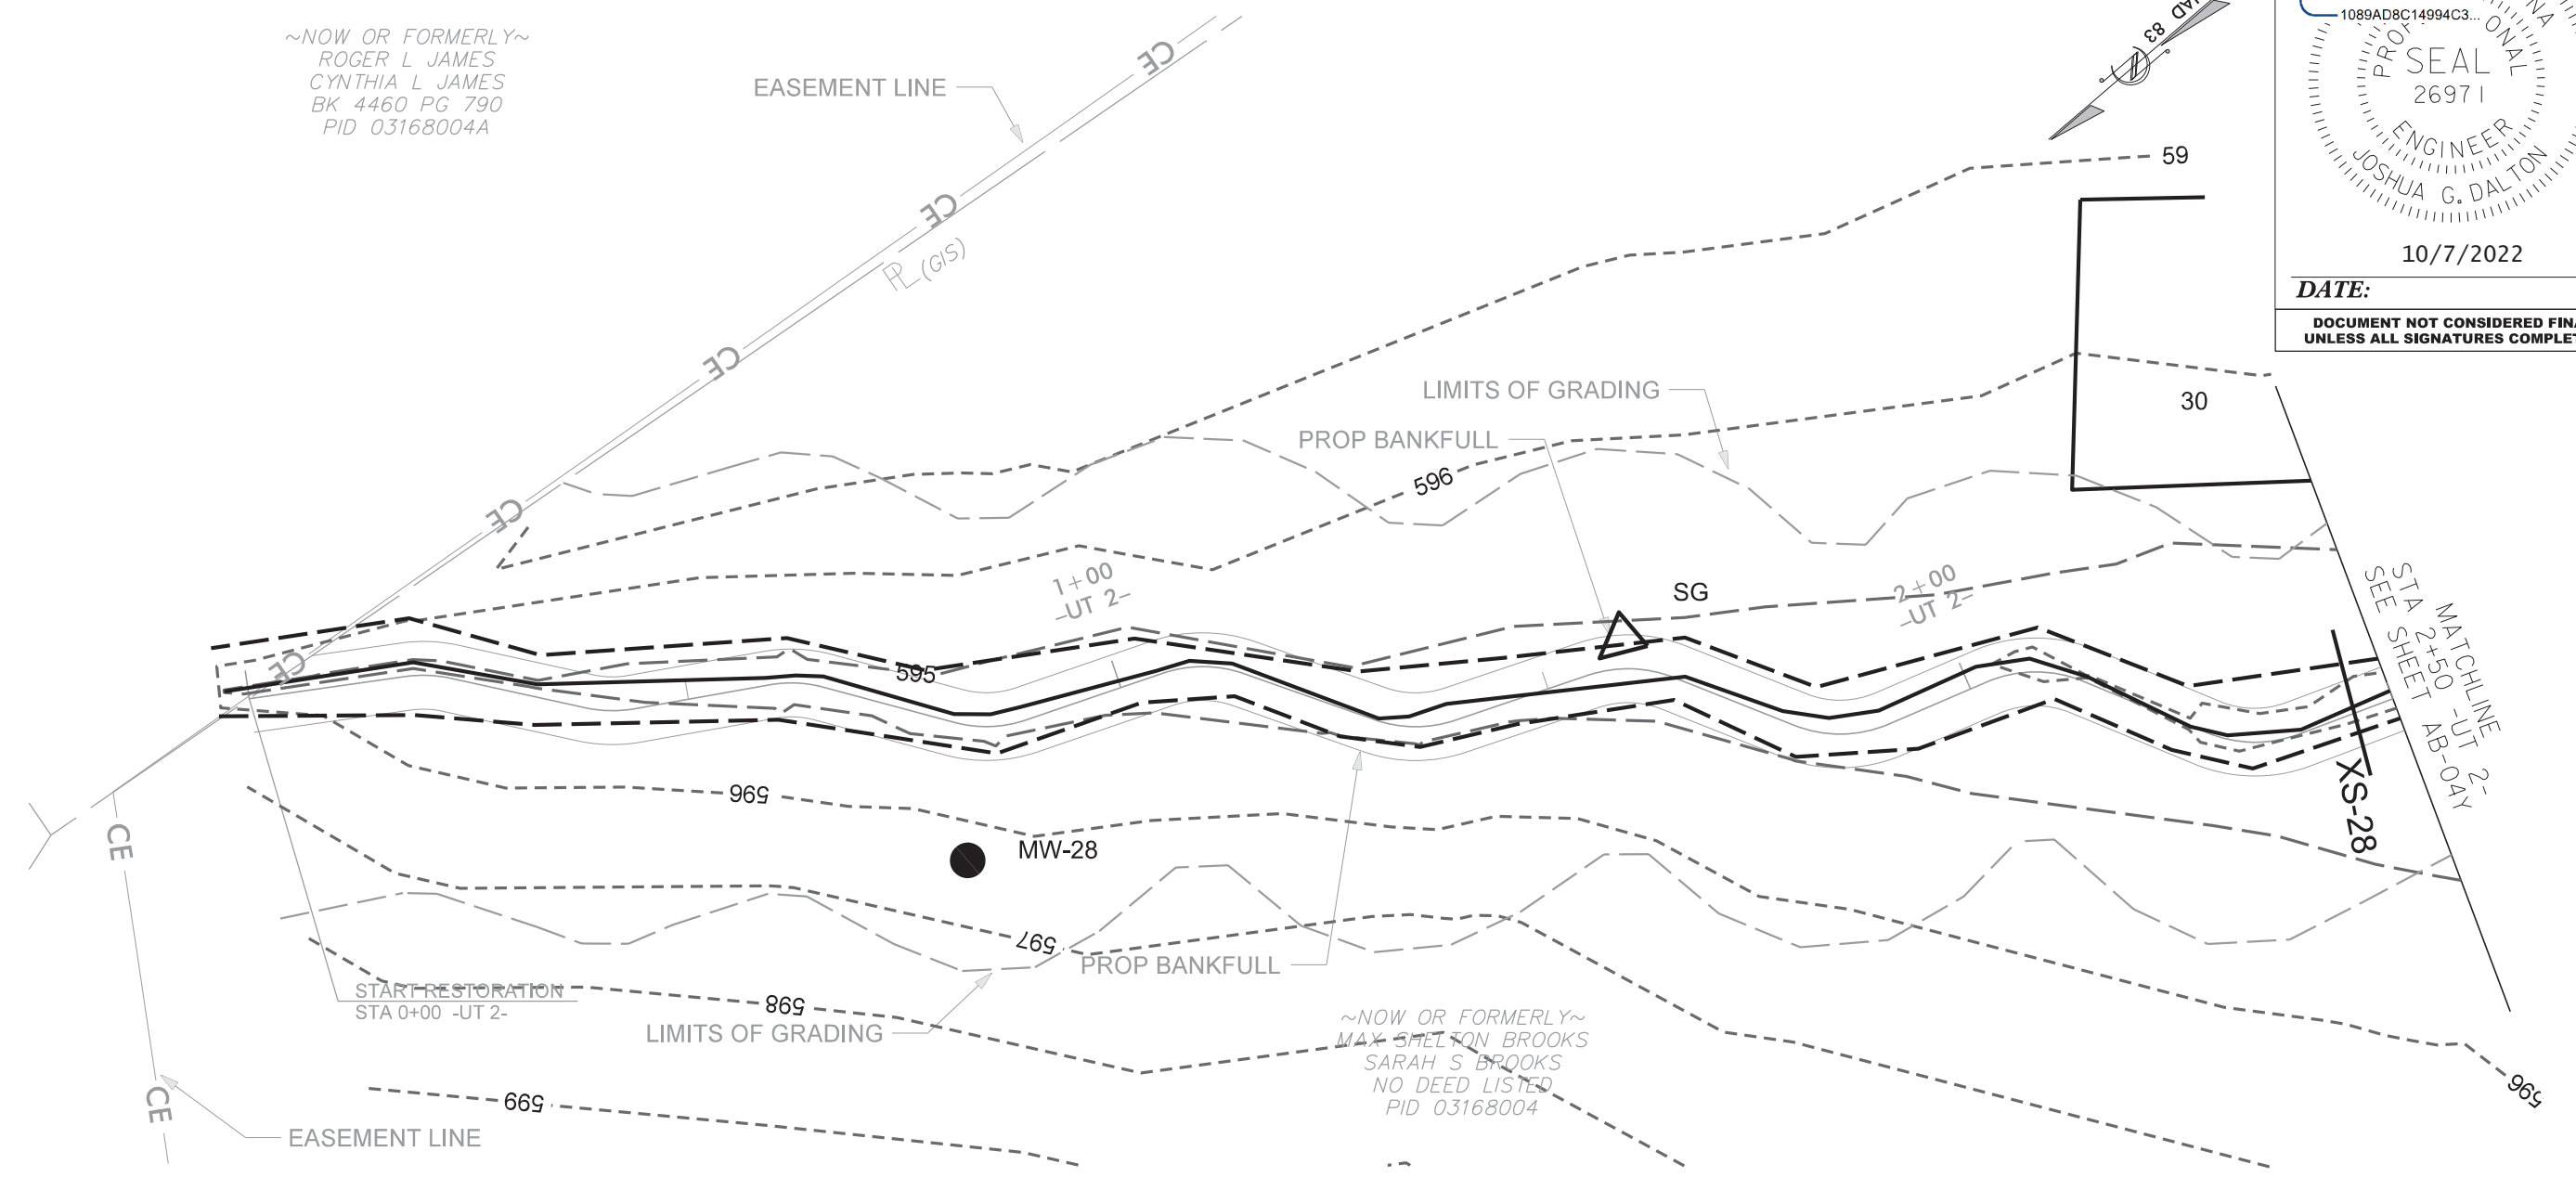

## UT 2

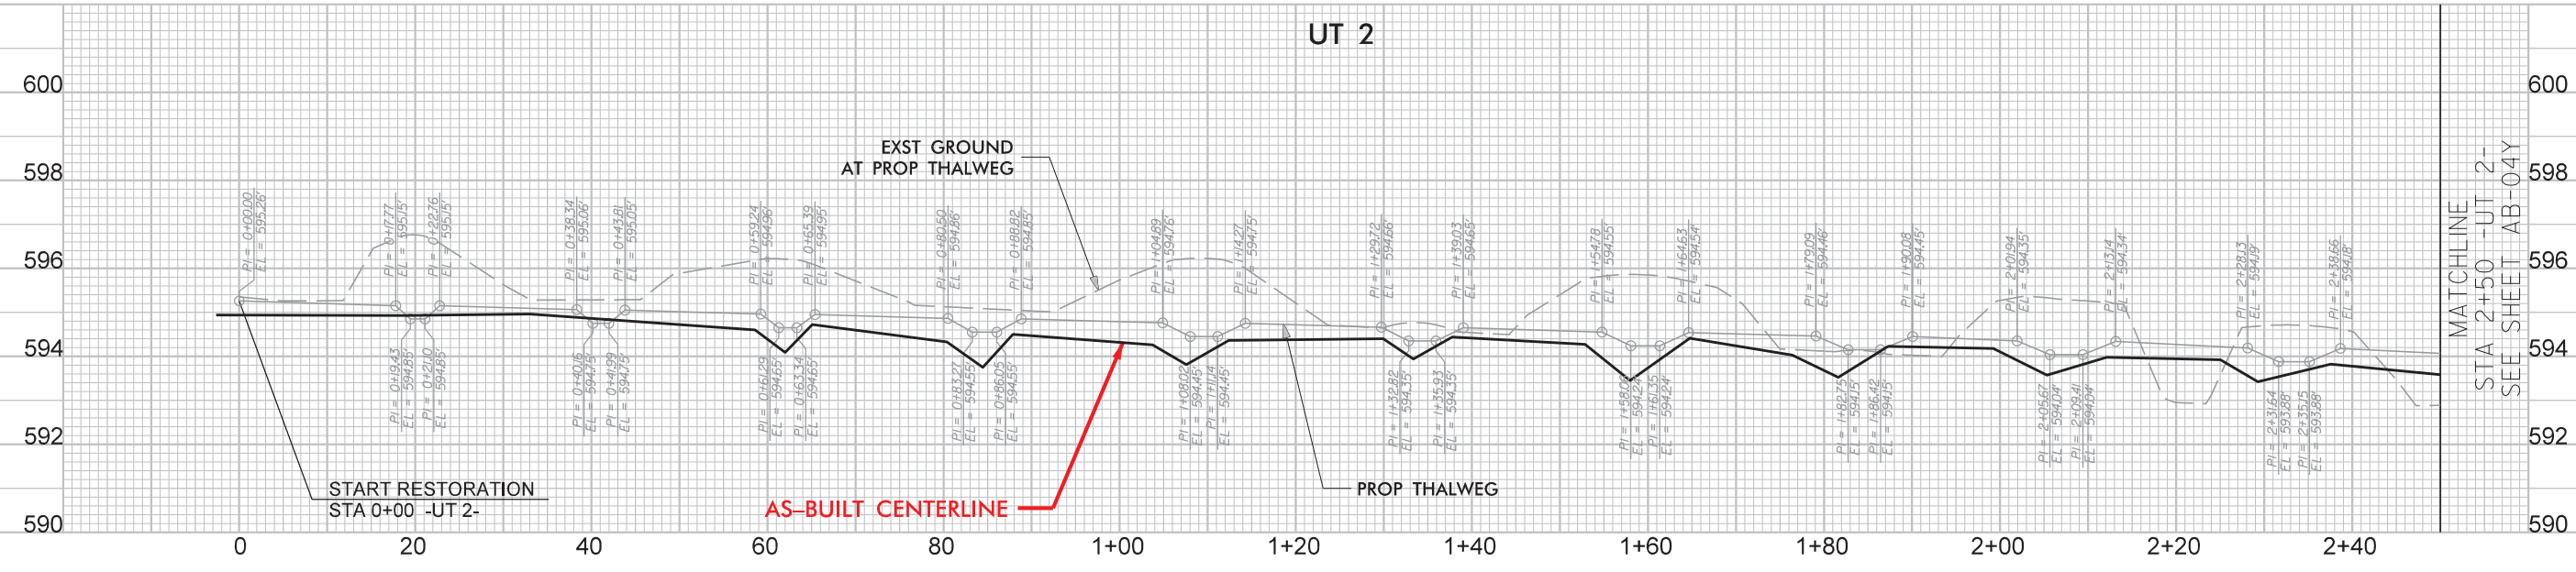

10/6/2022  
 Wits\_End\_Psh\_AB-04X.dgn


© 2022 SUNGATE DESIGN GROUP, P.A. THIS DRAWING AND ALL REPRODUCTIONS OF IT ARE THE SOLE PROPERTY OF SDG. REPRODUCTION OR OTHER USES OF THIS DRAWING WITHOUT WRITTEN CONSENT OF SDG IS NOT PERMITTED.

**WITS END**  
 UNION COUNTY, NC  
**AS-BUILT STRUCTURES**

PROJECT # :	1221-20024
DRAWING NAME:	WITS END PSH AB-04X
DATE:	2022
DRAWN BY:	JRH
REVIEWED BY:	JGD
REVISIONS:	
SHEET NO.	<b>AB-04X</b>

-UT 2- AS-BUILT STRUCTURE LOCATIONS				
STR. TYPE	NORTHING	EASTING	Prop Elevation	AB Survey Elevation
CROSS VANE	428,012.30	1,567,531.94	593.90	593.51
CROSS VANE	427,966.59	1,567,495.93	593.28	593.05
CROSS VANE	427,931.94	1,567,473.65	592.82	592.48
CROSS VANE	427,877.96	1,567,420.76	592.14	591.76

**RECORD DRAWING**

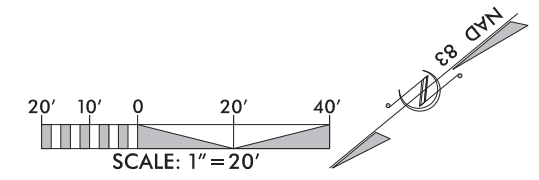



DocuSigned by:  
**Josh Dalton**  
 1089AD8C14994C3...  
 PROFESSIONAL SEAL  
 26971  
 ENGINEER  
 JOSHUA G. DALTON

DATE: 10/7/2022

DOCUMENT NOT CONSIDERED FINAL  
 UNLESS ALL SIGNATURES COMPLETED

**SUNGATE DESIGN GROUP, P.A.**  
 890 GILES FARM ROAD  
 SUITE 200  
 FARMINGTON, NC 27834  
 TEL: (919) 855-2243  
 FAX: (919) 855-2244  
 ENG. FIRM LICENSE NO. C-890

**Aslam Environmental, Inc.**

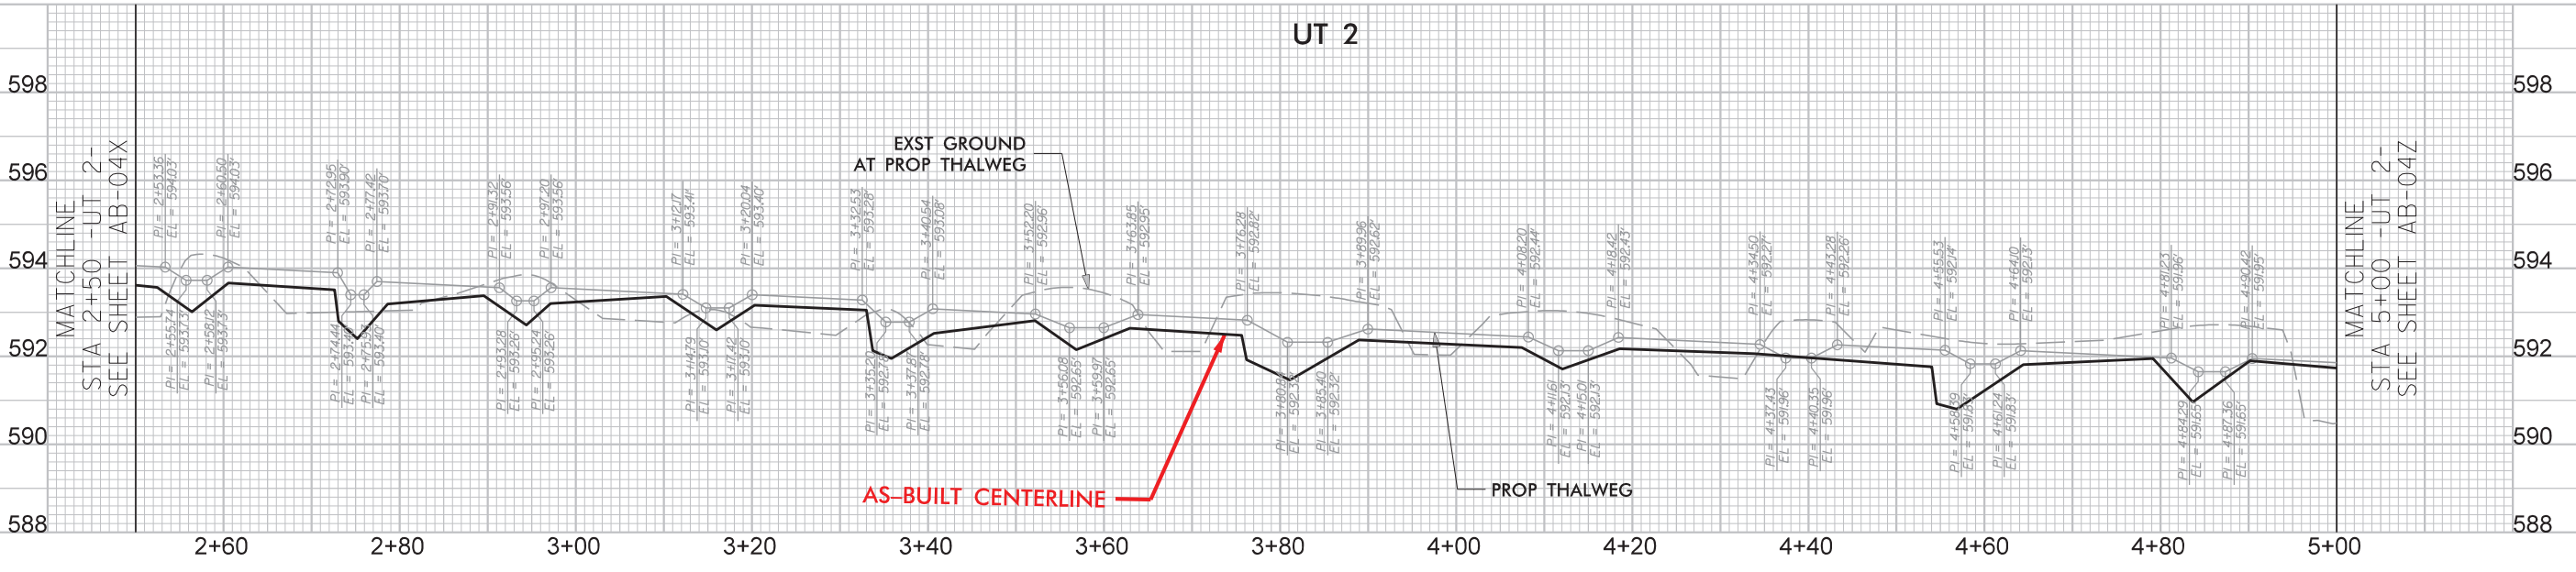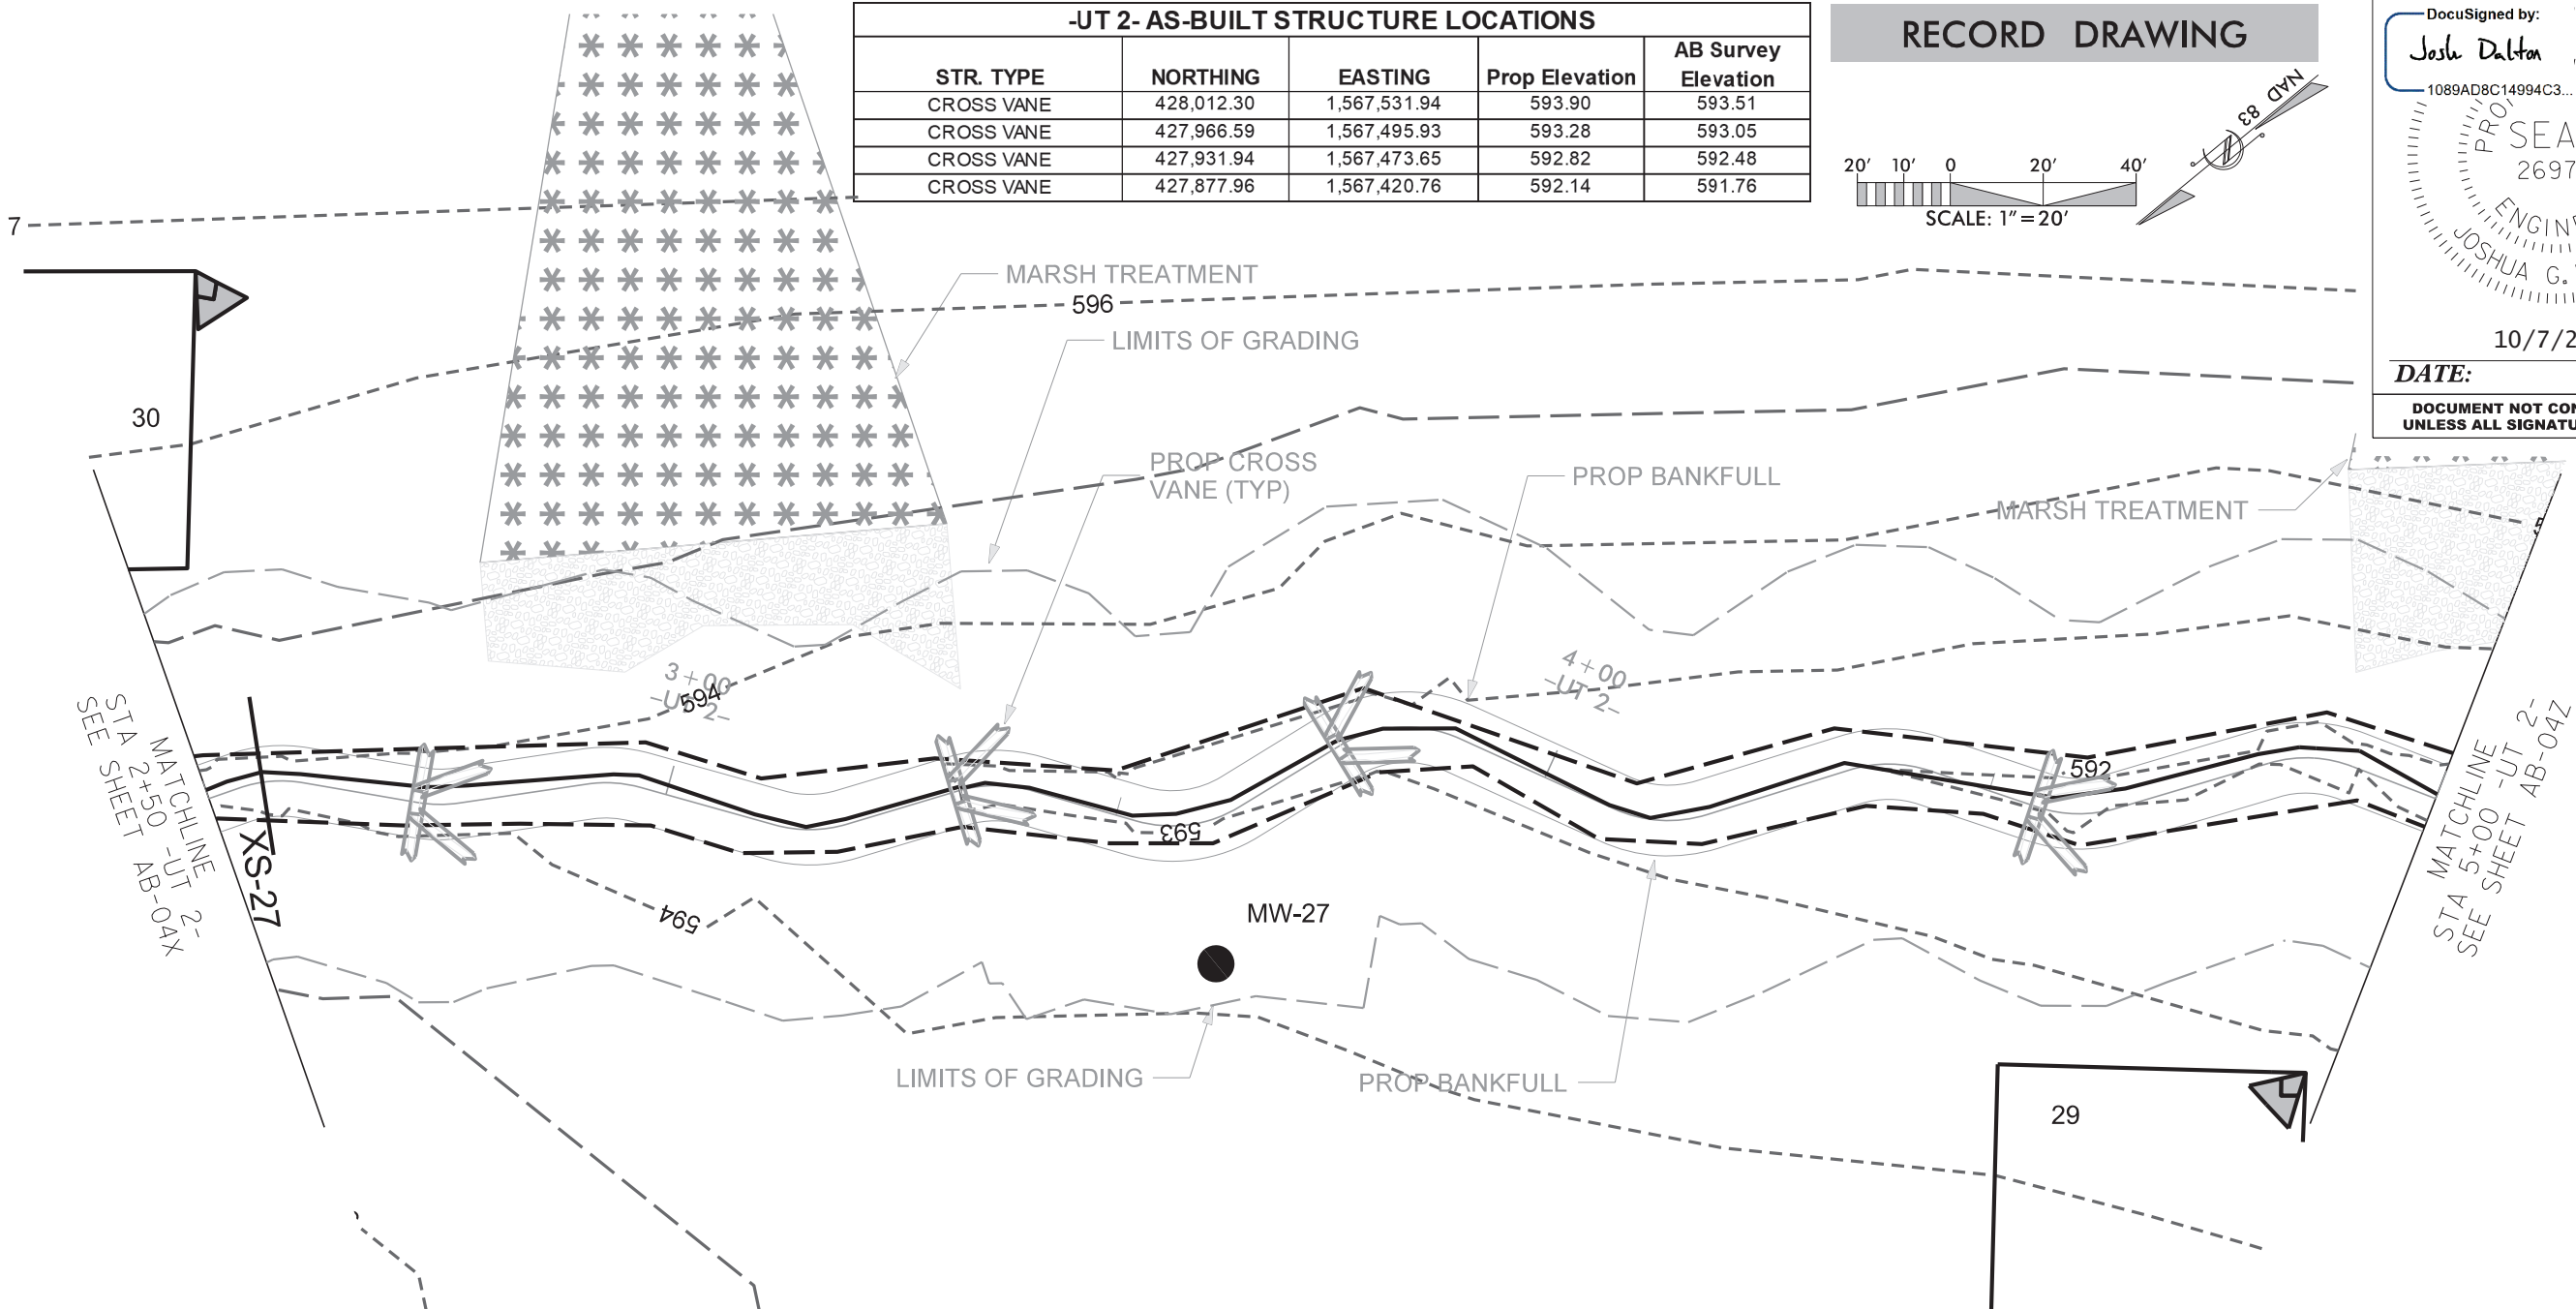

© 2022 SUNGATE DESIGN GROUP, P.A. THIS DRAWING AND ALL REPRODUCTIONS OF IT ARE THE SOLE PROPERTY OF SDG. REPRODUCTION OR OTHER USES OF THIS DRAWING WITHOUT WRITTEN CONSENT OF SDG IS NOT PERMITTED.

**WITS END**  
 UNION COUNTY, NC  
**AS-BUILT STRUCTURES**


PROJECT #: 1221-20024  
 DRAWING NAME: WITS END PSH AB-04Y  
 DATE: 2022  
 DRAWN BY: JRH  
 REVIEWED BY: JGD  
 REVISIONS:

SHEET NO.  
**AB-04Y**

10/6/2022  
 Wits\_End\_Psh\_AB-04Y.dgn



**RECORD DRAWING**

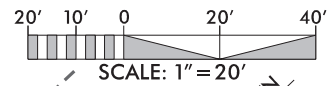


DocuSigned by:  
**Josh Dalton**  
 1089AD8C14994C3...  
 PROFESSIONAL ENGINEER  
 26971  
 JOSHUA G. DALTON  
 DATE: 10/7/2022

**SUNGATE DESIGN GROUP, P.A.**  
 834 GILES FARM ROAD  
 WITS END, NC 27886  
 TEL: (919) 855-2243  
 ENG. LIC. NO. C-980

**DOCUMENT NOT CONSIDERED FINAL UNLESS ALL SIGNATURES COMPLETED**

**WITS END ENVIRONMENTAL, INC.**

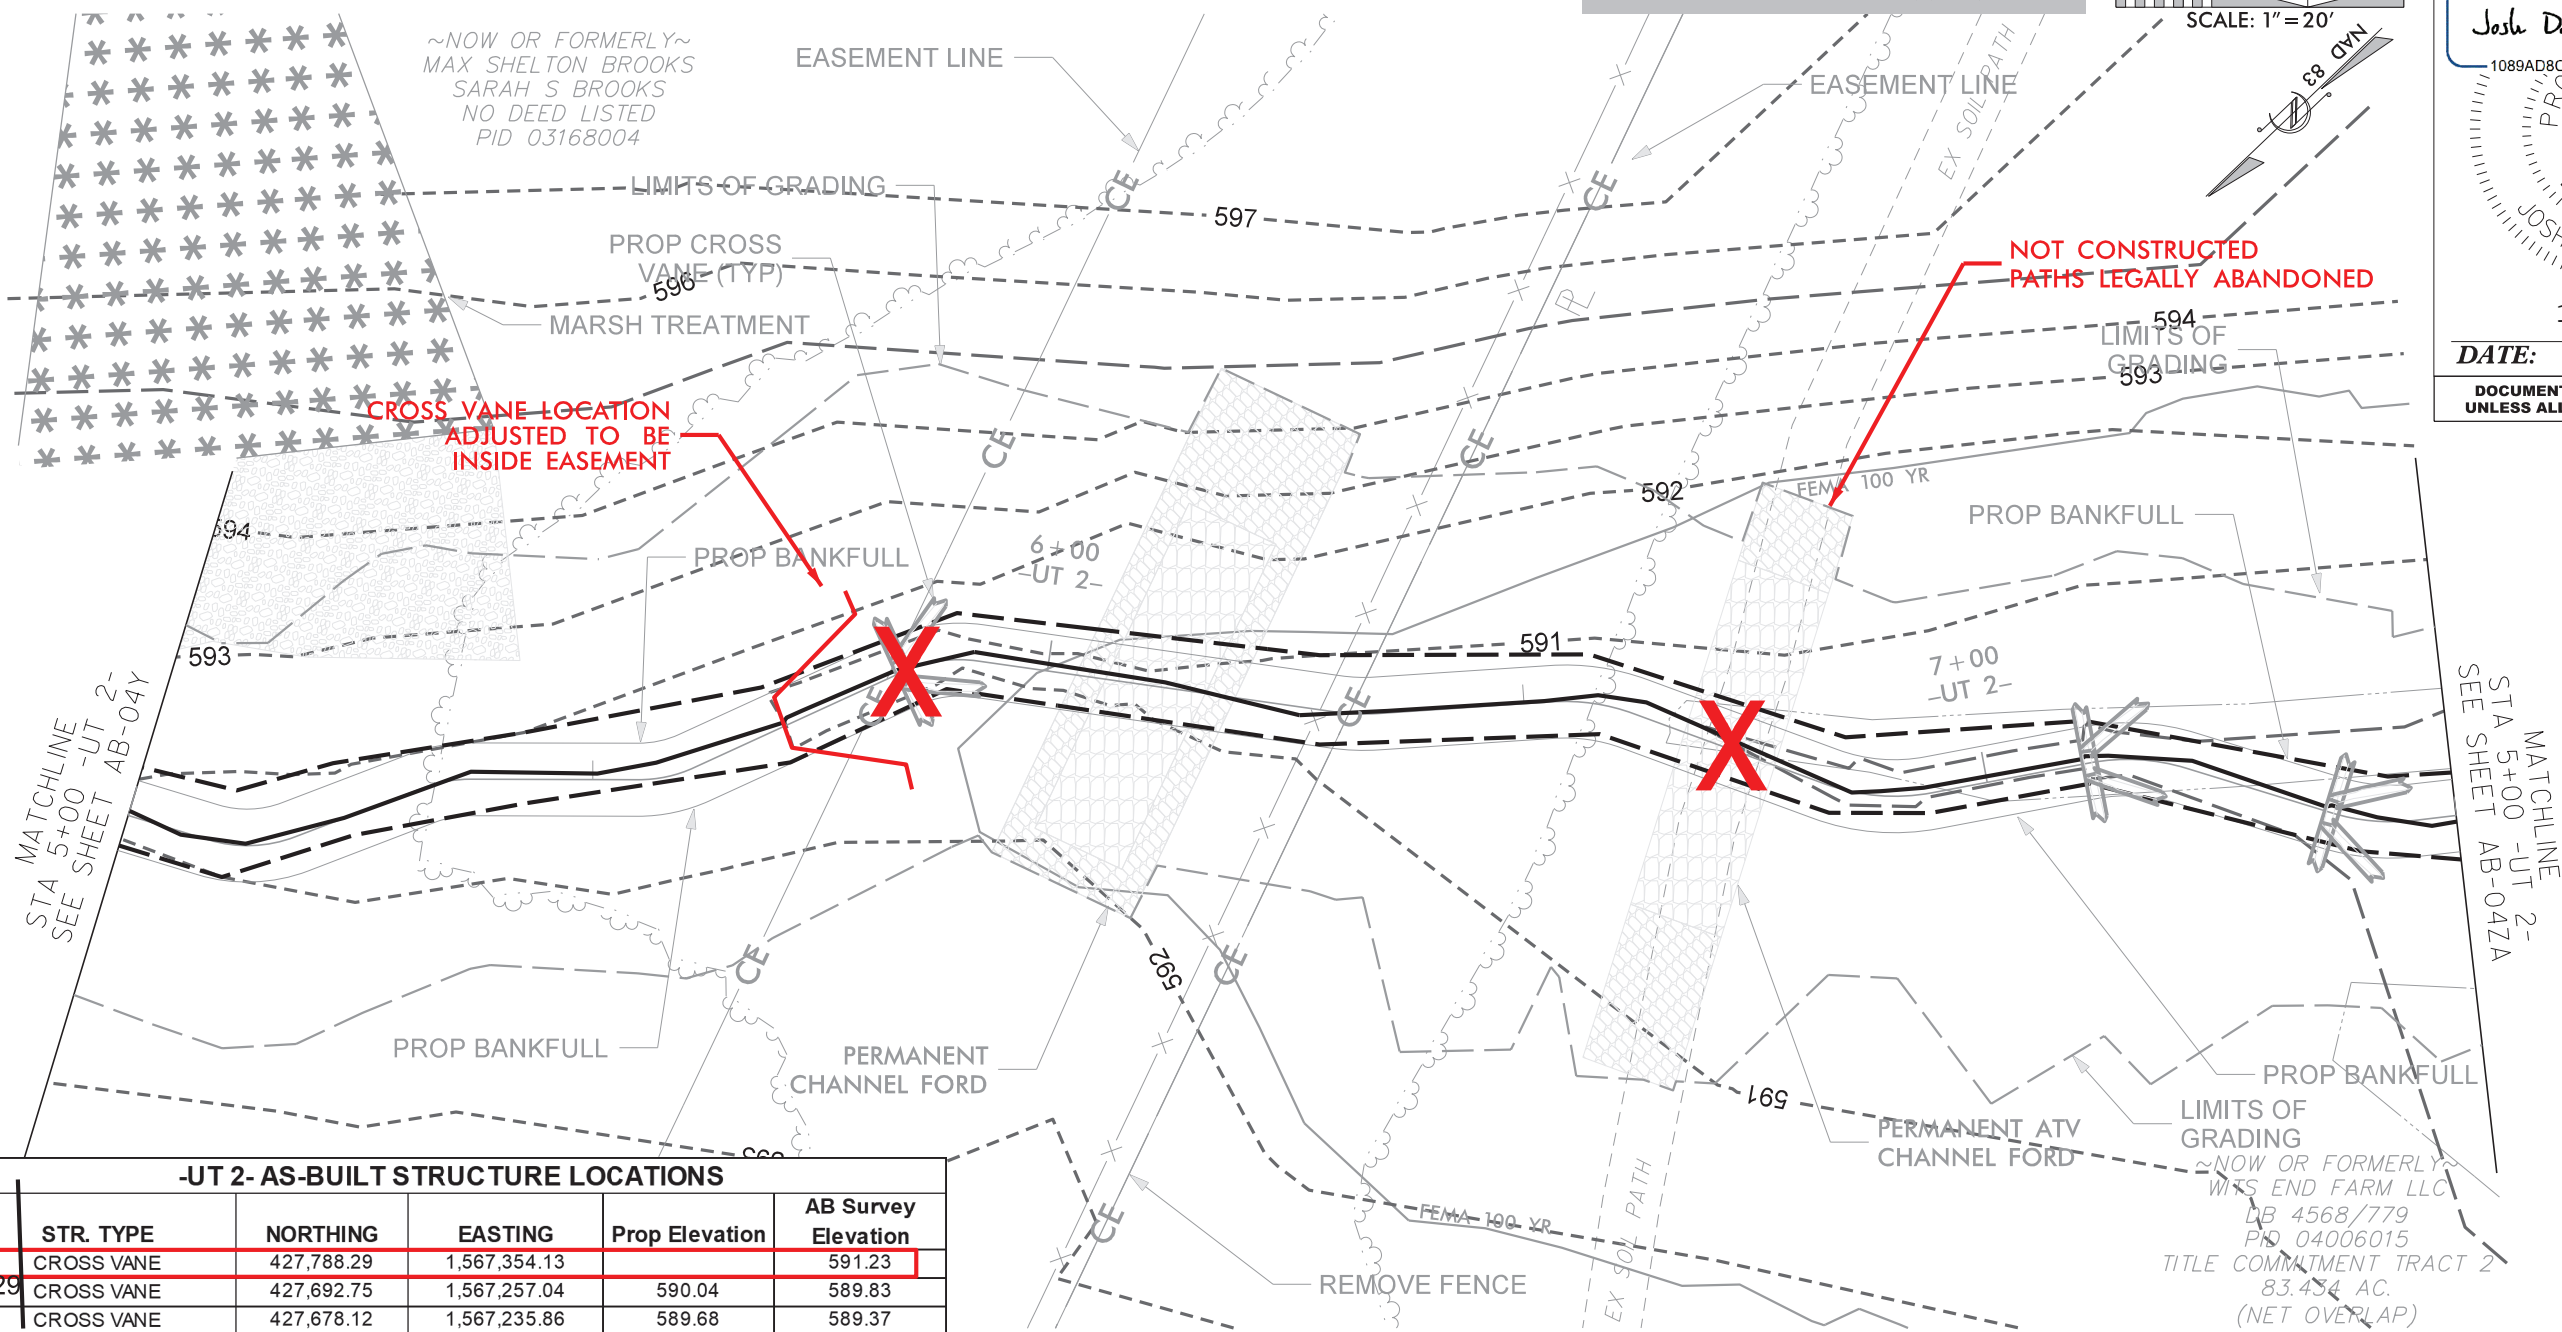


**-UT 2- AS-BUILT STRUCTURE LOCATIONS**

STR. TYPE	NORTHING	EASTING	Prop Elevation	AB Survey Elevation
CROSS VANE	427,788.29	1,567,354.13		591.23
29 CROSS VANE	427,692.75	1,567,257.04	590.04	589.83
CROSS VANE	427,678.12	1,567,235.86	589.68	589.37

~NOW OR FORMERLY~  
 WITS END FARM LLC  
 LB 4568/779  
 PO 04006015  
 TITLE COMMITMENT TRACT 2  
 83.434 AC.  
 (NET OVERLAP)

**UT 2**

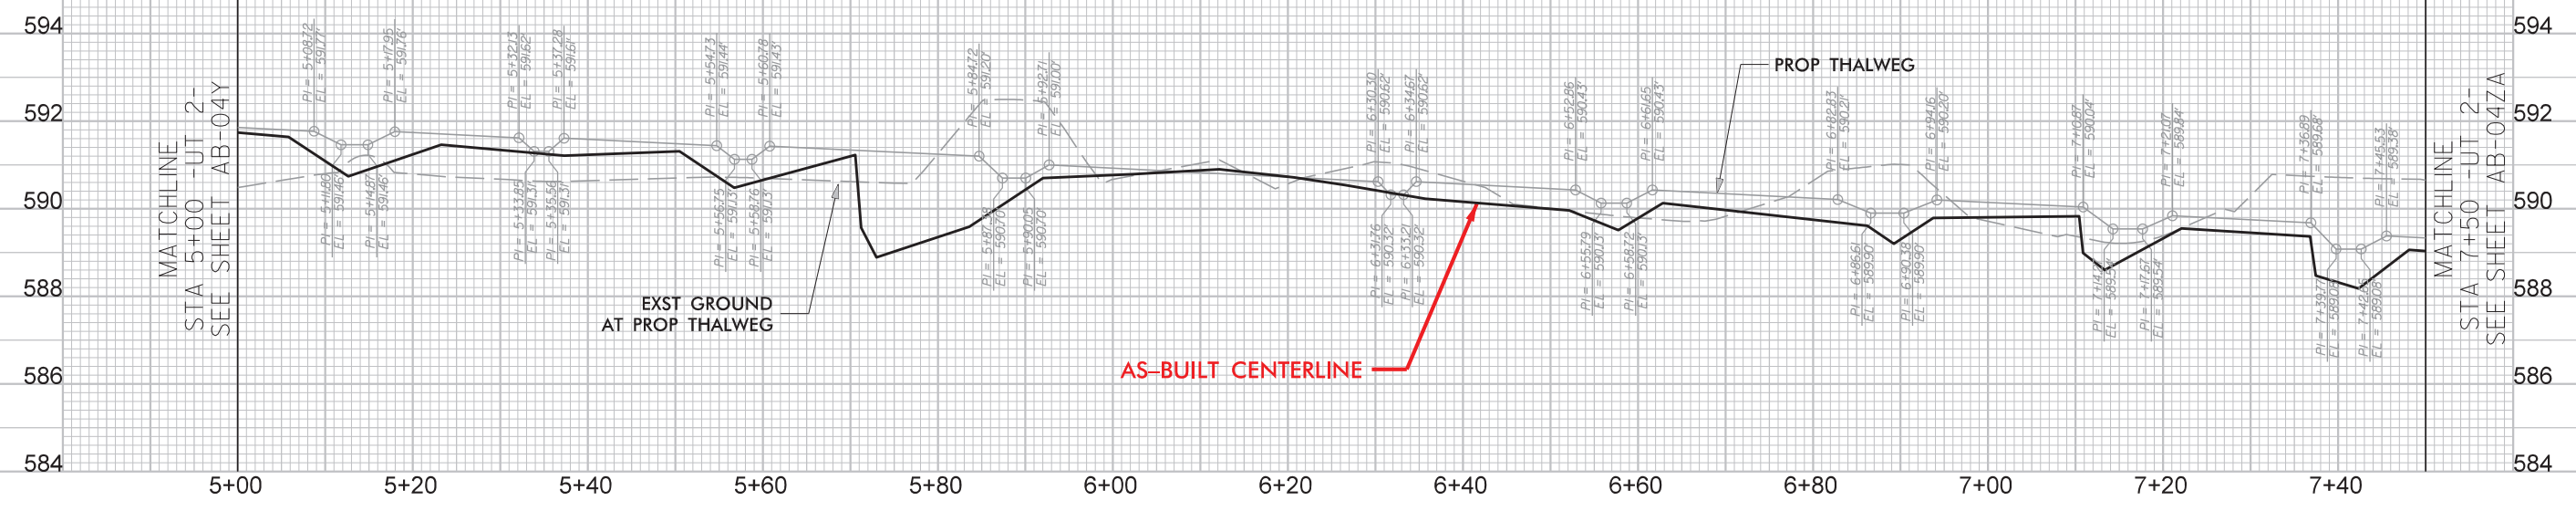

© 2022 SUNGATE DESIGN GROUP, P.A. THIS DRAWING AND ALL REPRODUCTIONS OF IT ARE THE SOLE PROPERTY OF SDG. REPRODUCTION OR OTHER USES OF THIS DRAWING WITHOUT WRITTEN CONSENT OF SDG IS NOT PERMITTED.


PROJECT #: 1221-20024  
 DRAWING NAME: WITS END PSH AB-04Z  
 DATE: 2022  
 DRAWN BY: JRH  
 REVIEWED BY: JGD  
 REVISIONS:

SHEET NO.  
**AB-04Z**

10/6/2022  
 Wits\_End\_Psh\_AB-04Z.dgn



~NOW OR FORMERLY~  
 WITS END FARM LLC  
 DB 4568/779  
 PID 04006015  
 TITLE COMMITMENT TRACT 2  
 83.434 AC.  
 (NET OVERLAP)

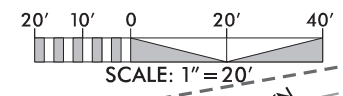


DocuSigned by:  
 Joshua Dalton  
 1089AD8C14994C3...  
 PROFESSIONAL SEAL  
 26971  
 ENGINEER  
 JOSHUA G. DALTON  
 DATE: 10/7/2022

SUNGATE DESIGN GROUP, P.A.  
 830 GILES FARM ROAD  
 SUITE 200  
 CARY, NC 27513  
 TEL: (919) 855-2243  
 ENG. FIRM LICENSE NO. C-980


DOCUMENT NOT CONSIDERED FINAL  
 UNLESS ALL SIGNATURES COMPLETED

**RECORD DRAWING**

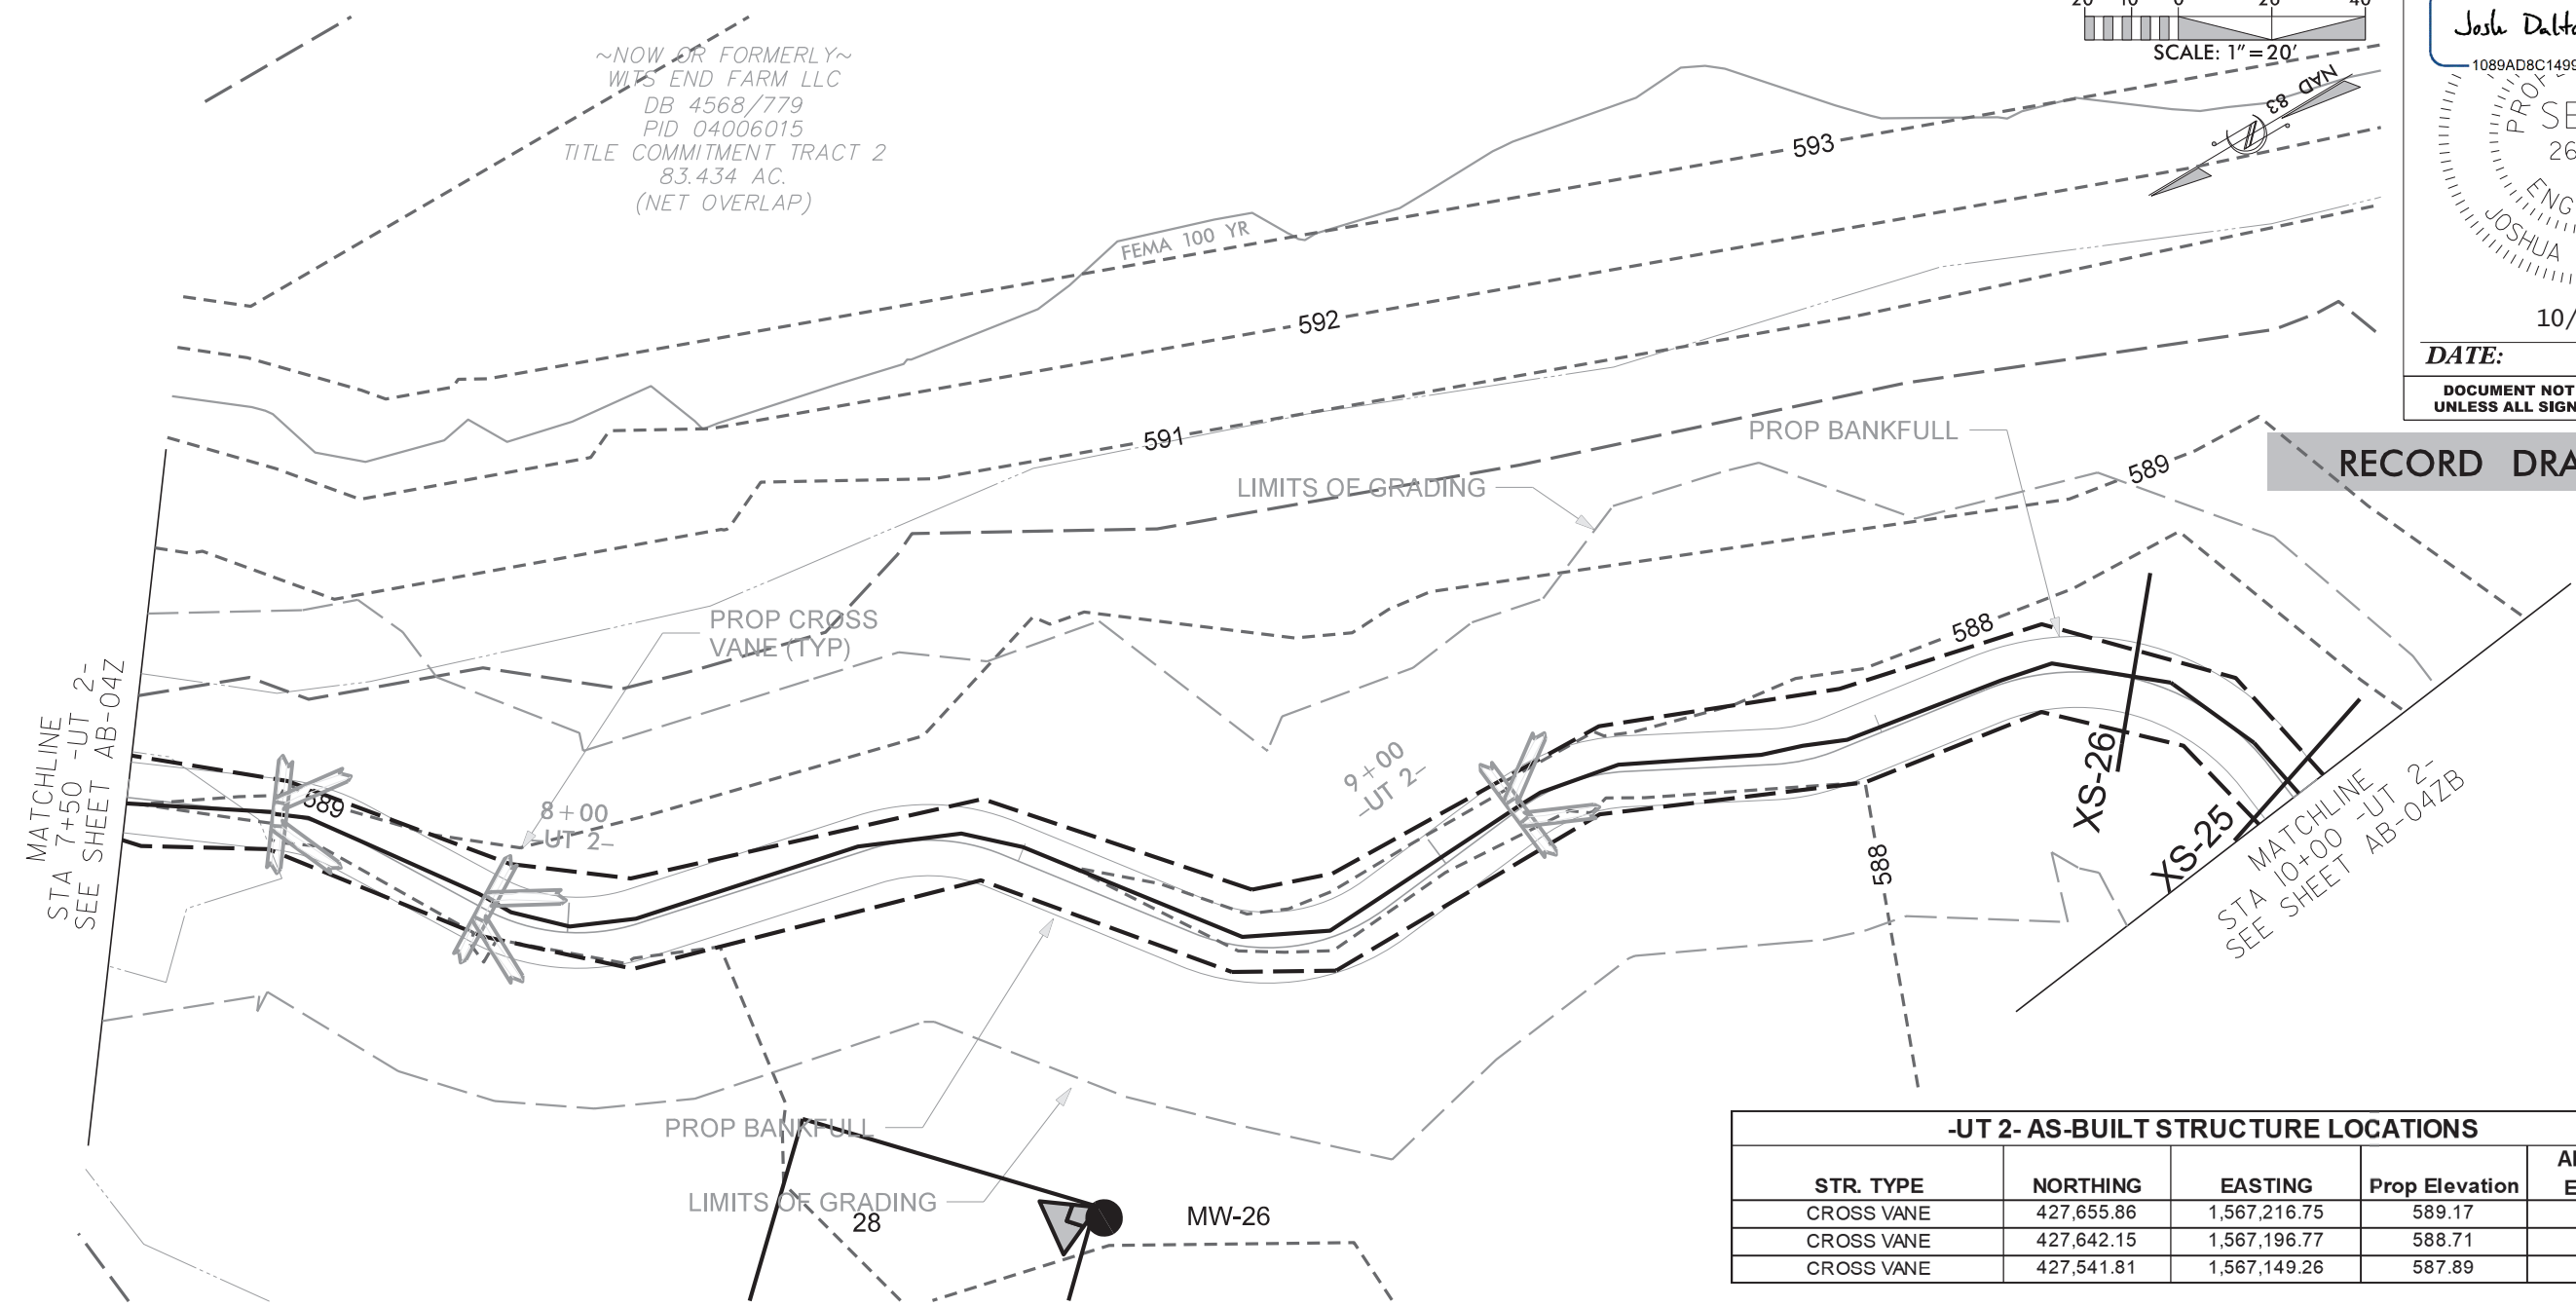

**-UT 2- AS-BUILT STRUCTURE LOCATIONS**

STR. TYPE	NORTHING	EASTING	Prop Elevation	AB Survey Elevation
CROSS VANE	427,655.86	1,567,216.75	589.17	588.79
CROSS VANE	427,642.15	1,567,196.77	588.71	588.36
CROSS VANE	427,541.81	1,567,149.26	587.89	587.65

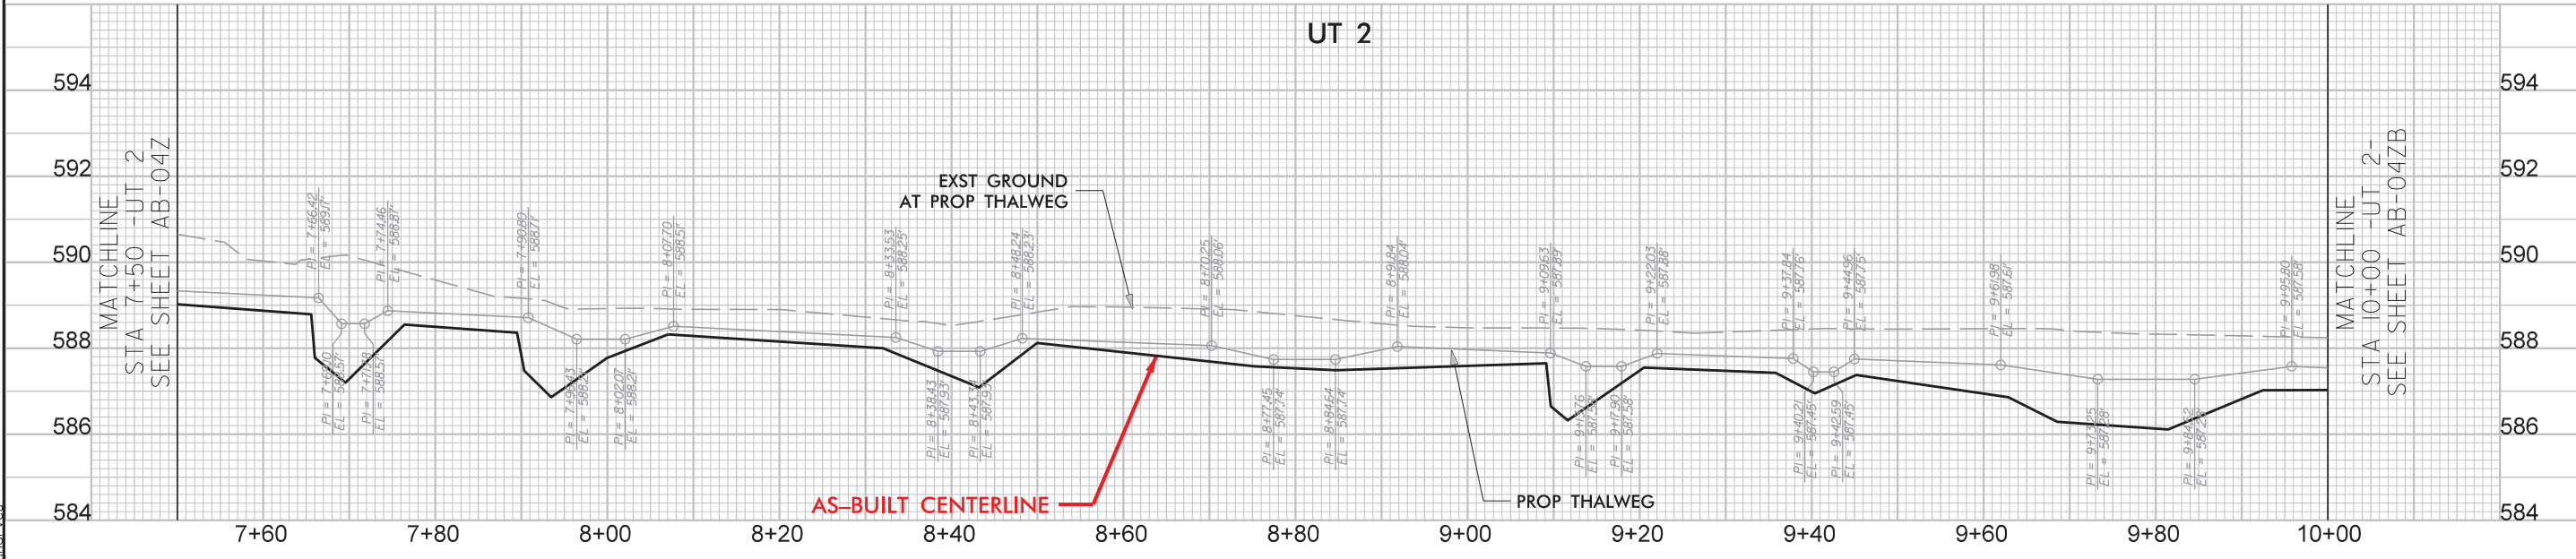


© 2022 SUNGATE DESIGN GROUP, P.A. THIS DRAWING AND ALL REPRODUCTIONS OF IT ARE THE SOLE PROPERTY OF SDG. REPRODUCTION OR OTHER USES OF THIS DRAWING WITHOUT WRITTEN CONSENT OF SDG IS NOT PERMITTED.

**WITS END**  
 UNION COUNTY, NC  
**AS-BUILT STRUCTURES**

PROJECT # : 1221-20024  
 DRAWING NAME: WITS END PSH AB-04ZA  
 DATE: 2021  
 DRAWN BY: JRH  
 REVIEWED BY: JGD  
 REVISIONS:  
 SHEET NO. **AB-04ZA**

10/6/2022  
 Wits\_End\_Psh\_AB-04ZA.dgn

**RECORD DRAWING**

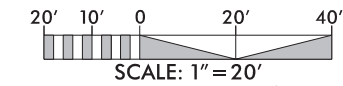

DocuSigned by:  
**Josh Dalton**  
 1089AD8C14994C3...  
  
**JOSHUA G. DALTON**  
 ENGINEER  
 26971  
 10/7/2022

**DATE:**  
 DOCUMENT NOT CONSIDERED FINAL  
 UNLESS ALL SIGNATURES COMPLETED



**SUNGATE DESIGN GROUP, P.A.**  
 890 GUNNERS FARM ROAD  
 SUITE 200 CARY, NORTH CAROLINA 27506  
 TEL: (919) 855-2243  
 ENG. FIRM LICENSE NO. C-980

Axiom Environmental, Inc.

**-UT 2- AS-BUILT STRUCTURE LOCATIONS**

STR. TYPE	NORTHING	EASTING	Prop Elevation	AB Survey Elevation
CROSS VANE	427,468.01	1,567,092.08	587.42	587.05
CROSS VANE	427,428.83	1,567,032.36	587.05	586.83
CROSS VANE	427,331.14	1,567,010.81	586.54	586.52

~NOW OR FORMERLY~  
 WITS END FARM LLC  
 DB 45687779  
 PID 04006015  
 TITLE COMMITMENT TRACT 2  
 83.434 AC.  
 (NET OVERLAP)

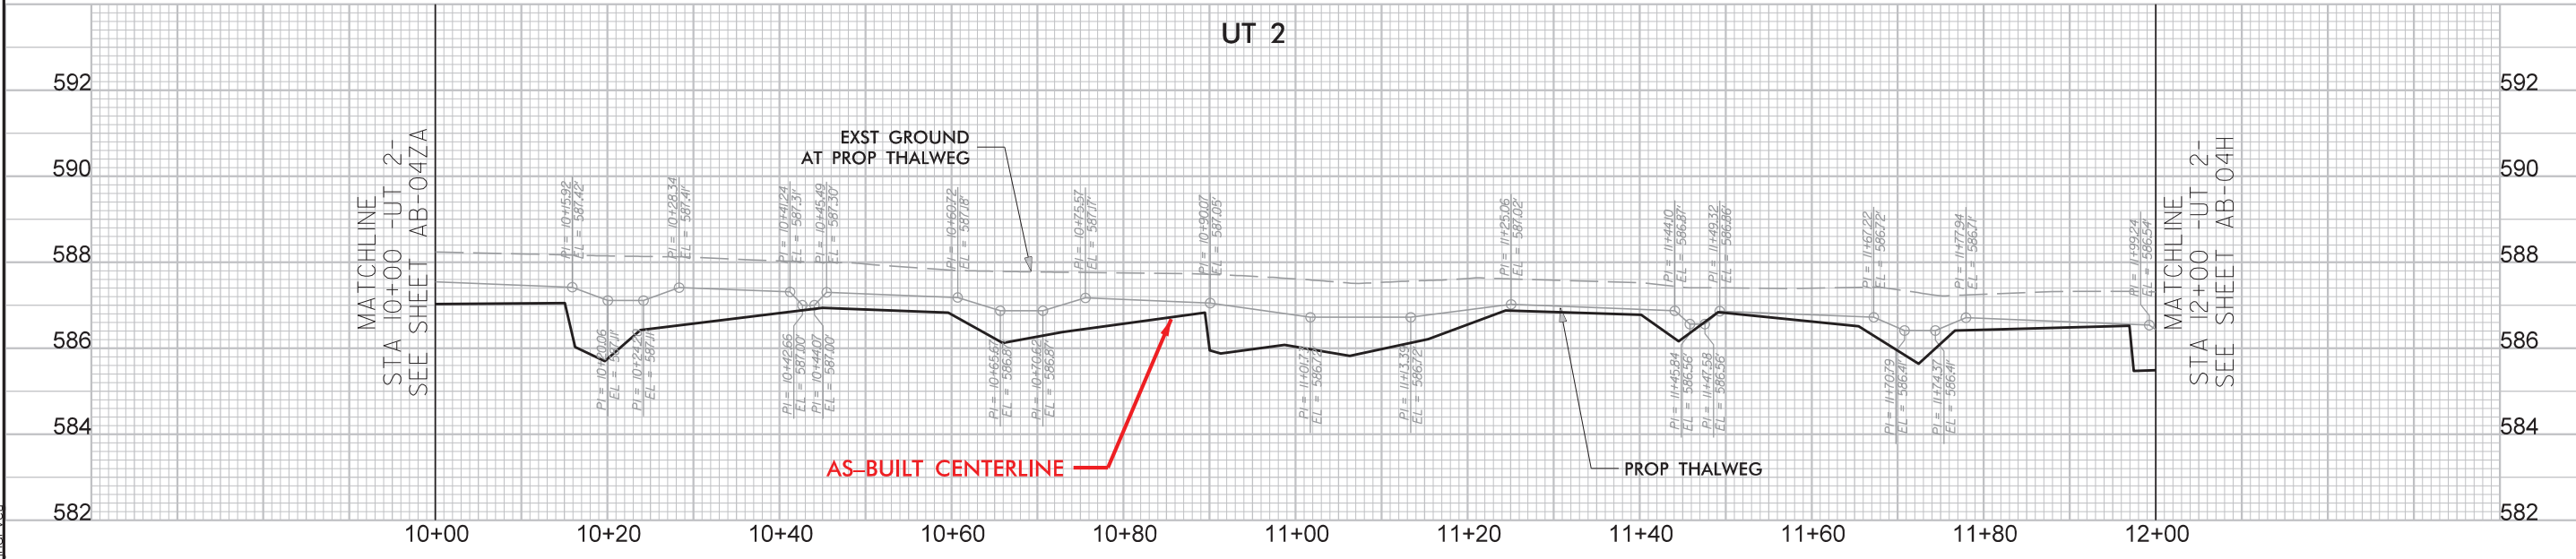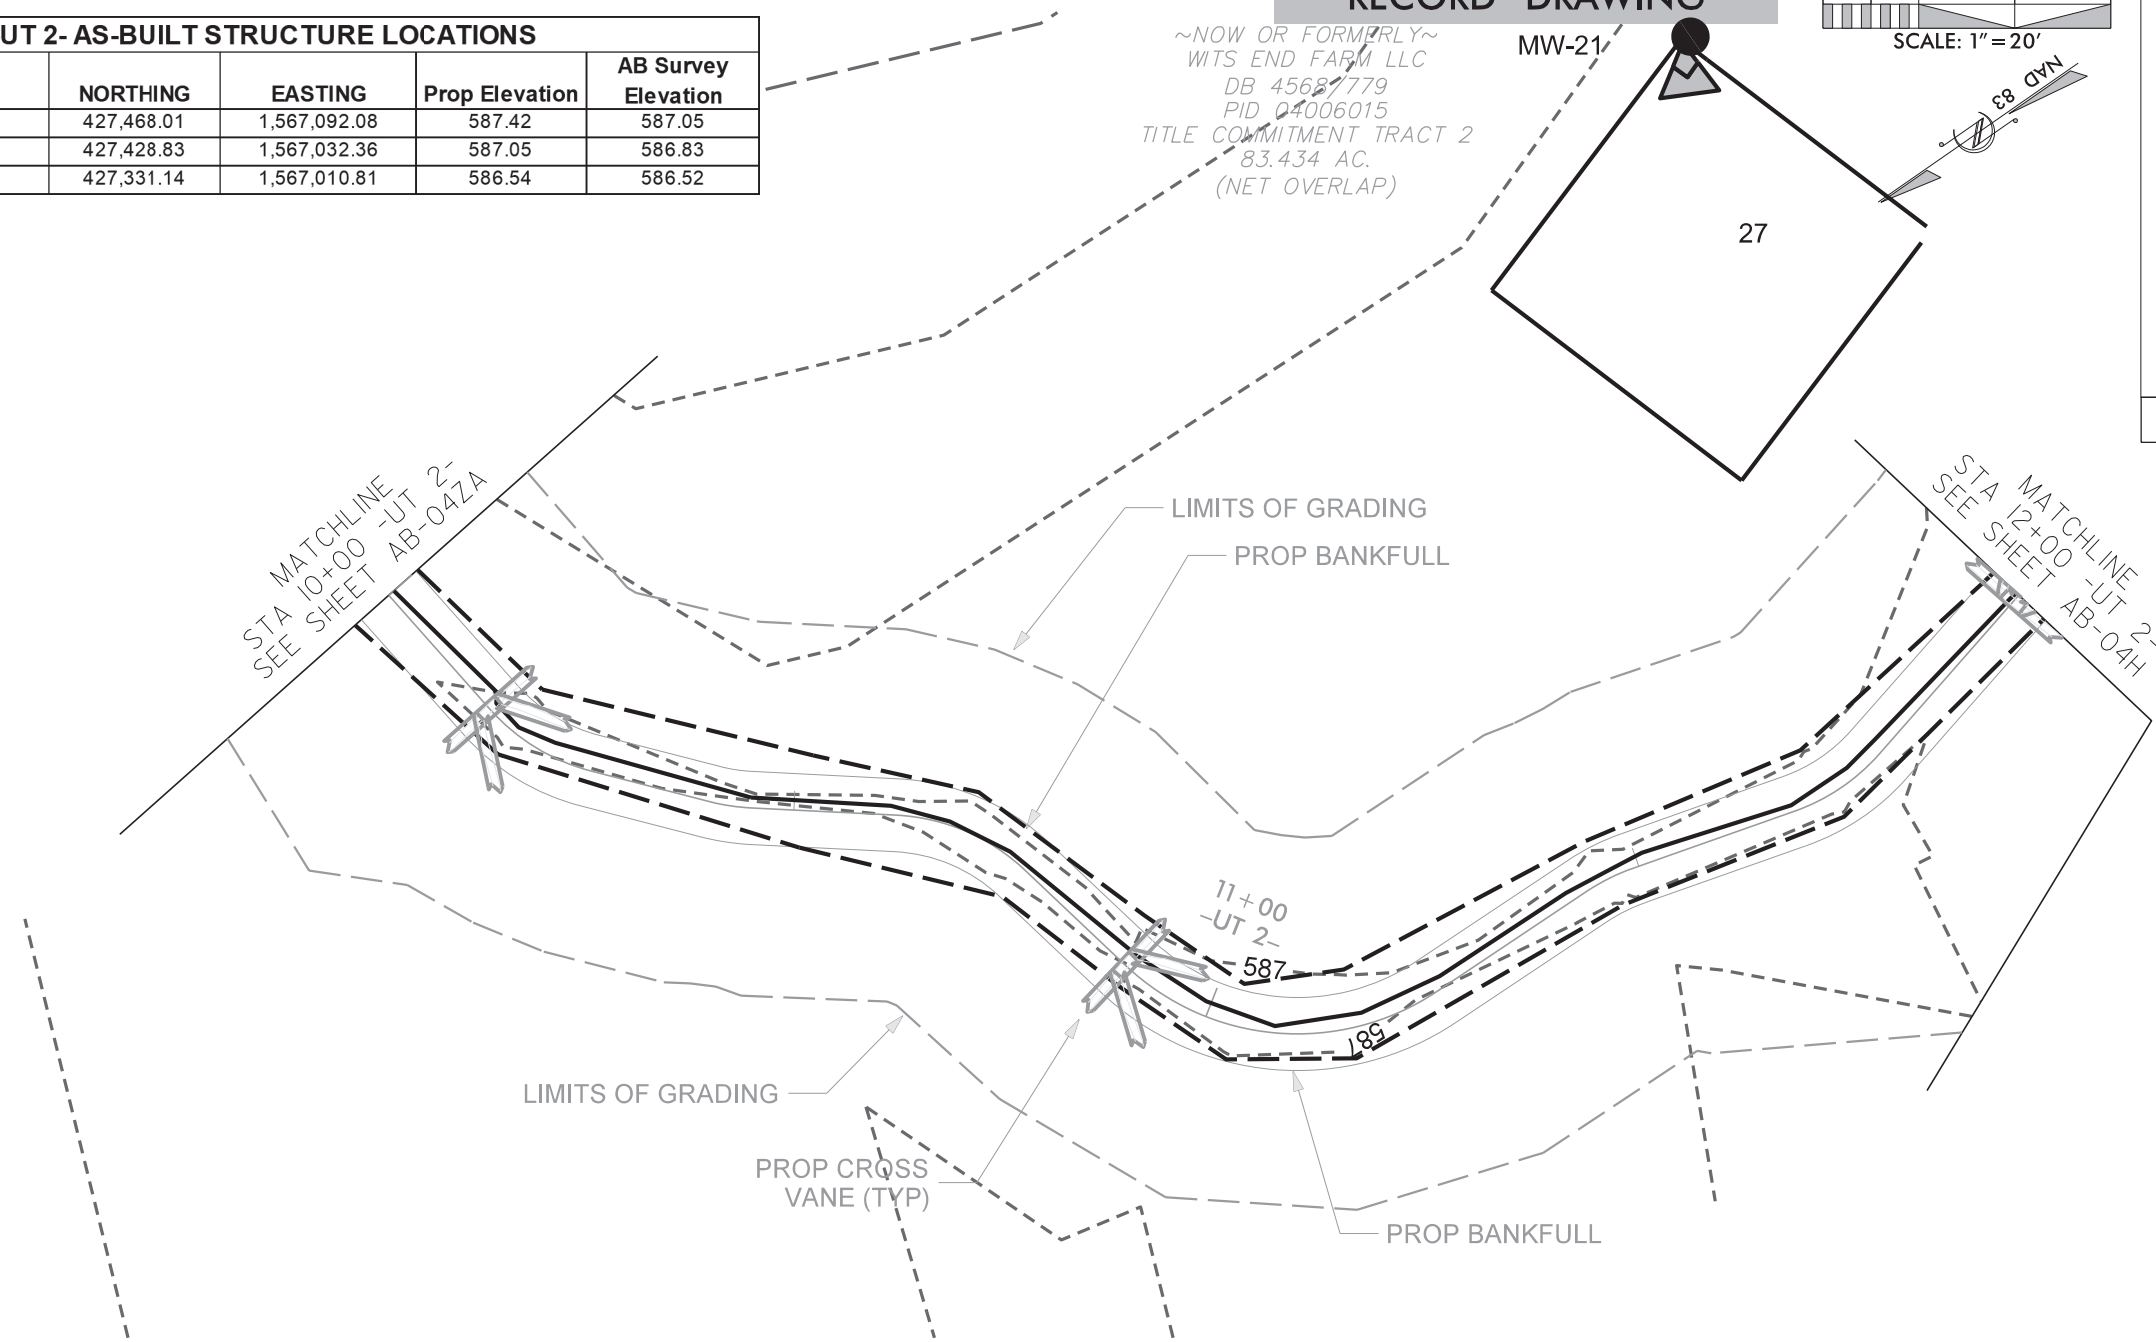



10/6/2022  
 Wits\_End\_Psh\_AB-04ZB.dgn

© 2022 SUNGATE DESIGN GROUP, P.A. THIS DRAWING AND ALL REPRODUCTIONS OF IT ARE THE SOLE PROPERTY OF SDG. REPRODUCTION OR OTHER USES OF THIS DRAWING WITHOUT WRITTEN CONSENT OF SDG IS NOT PERMITTED.

**PROJECT # :** 1221-20024  
**DRAWING NAME:** WITS END PSH AB-04ZB  
**DATE:** 2022  
**DRAWN BY:** JRH  
**REVIEWED BY:** JGD  
**REVISIONS:**

**SHEET NO.**  
**AB-04ZB**

**WITS END**  
 UNION COUNTY, NC  
**AS-BUILT STRUCTURES**

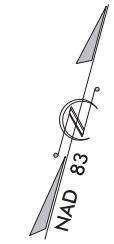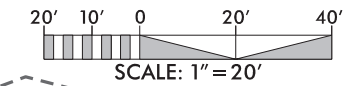


DocuSigned by:  
**Josh Dalton**  
 1089AD8C14994C3...  
 PROFESSIONAL ENGINEER  
 JOSHUA G. DALTON  
 26971  
 DATE: 10/7/2022

**DOCUMENT NOT CONSIDERED FINAL  
 UNLESS ALL SIGNATURES COMPLETED**

**RECORD DRAWING**

**SUNGATE DESIGN GROUP, P.A.**  
 850 GILES FARM ROAD  
 SUITE 200  
 WILSON, NC 27606  
 TEL: (919) 855-2243  
 ENG FIRM LICENSE NO. C-980

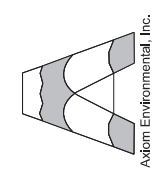


~NOW OR FORMERLY~  
 COX LAND INVESTMENTS  
 LIMITED PATERNERSHIP  
 DEED BK 5905, PAGE 073  
 PID 04006018


~NOW OR FORMERLY~  
 RANDY H GUION  
 NO DEED LISTED  
 PID 04006018

~NOW OR FORMERLY~  
 TIMOTHY JAMES WALDEN, ET AL  
 DEED BK 5667, PAGE 790  
 PID 04006018

~NOW OR FORMERLY~  
 JESSIE B GUION  
 NO DEED LISTED  
 PID 04006018

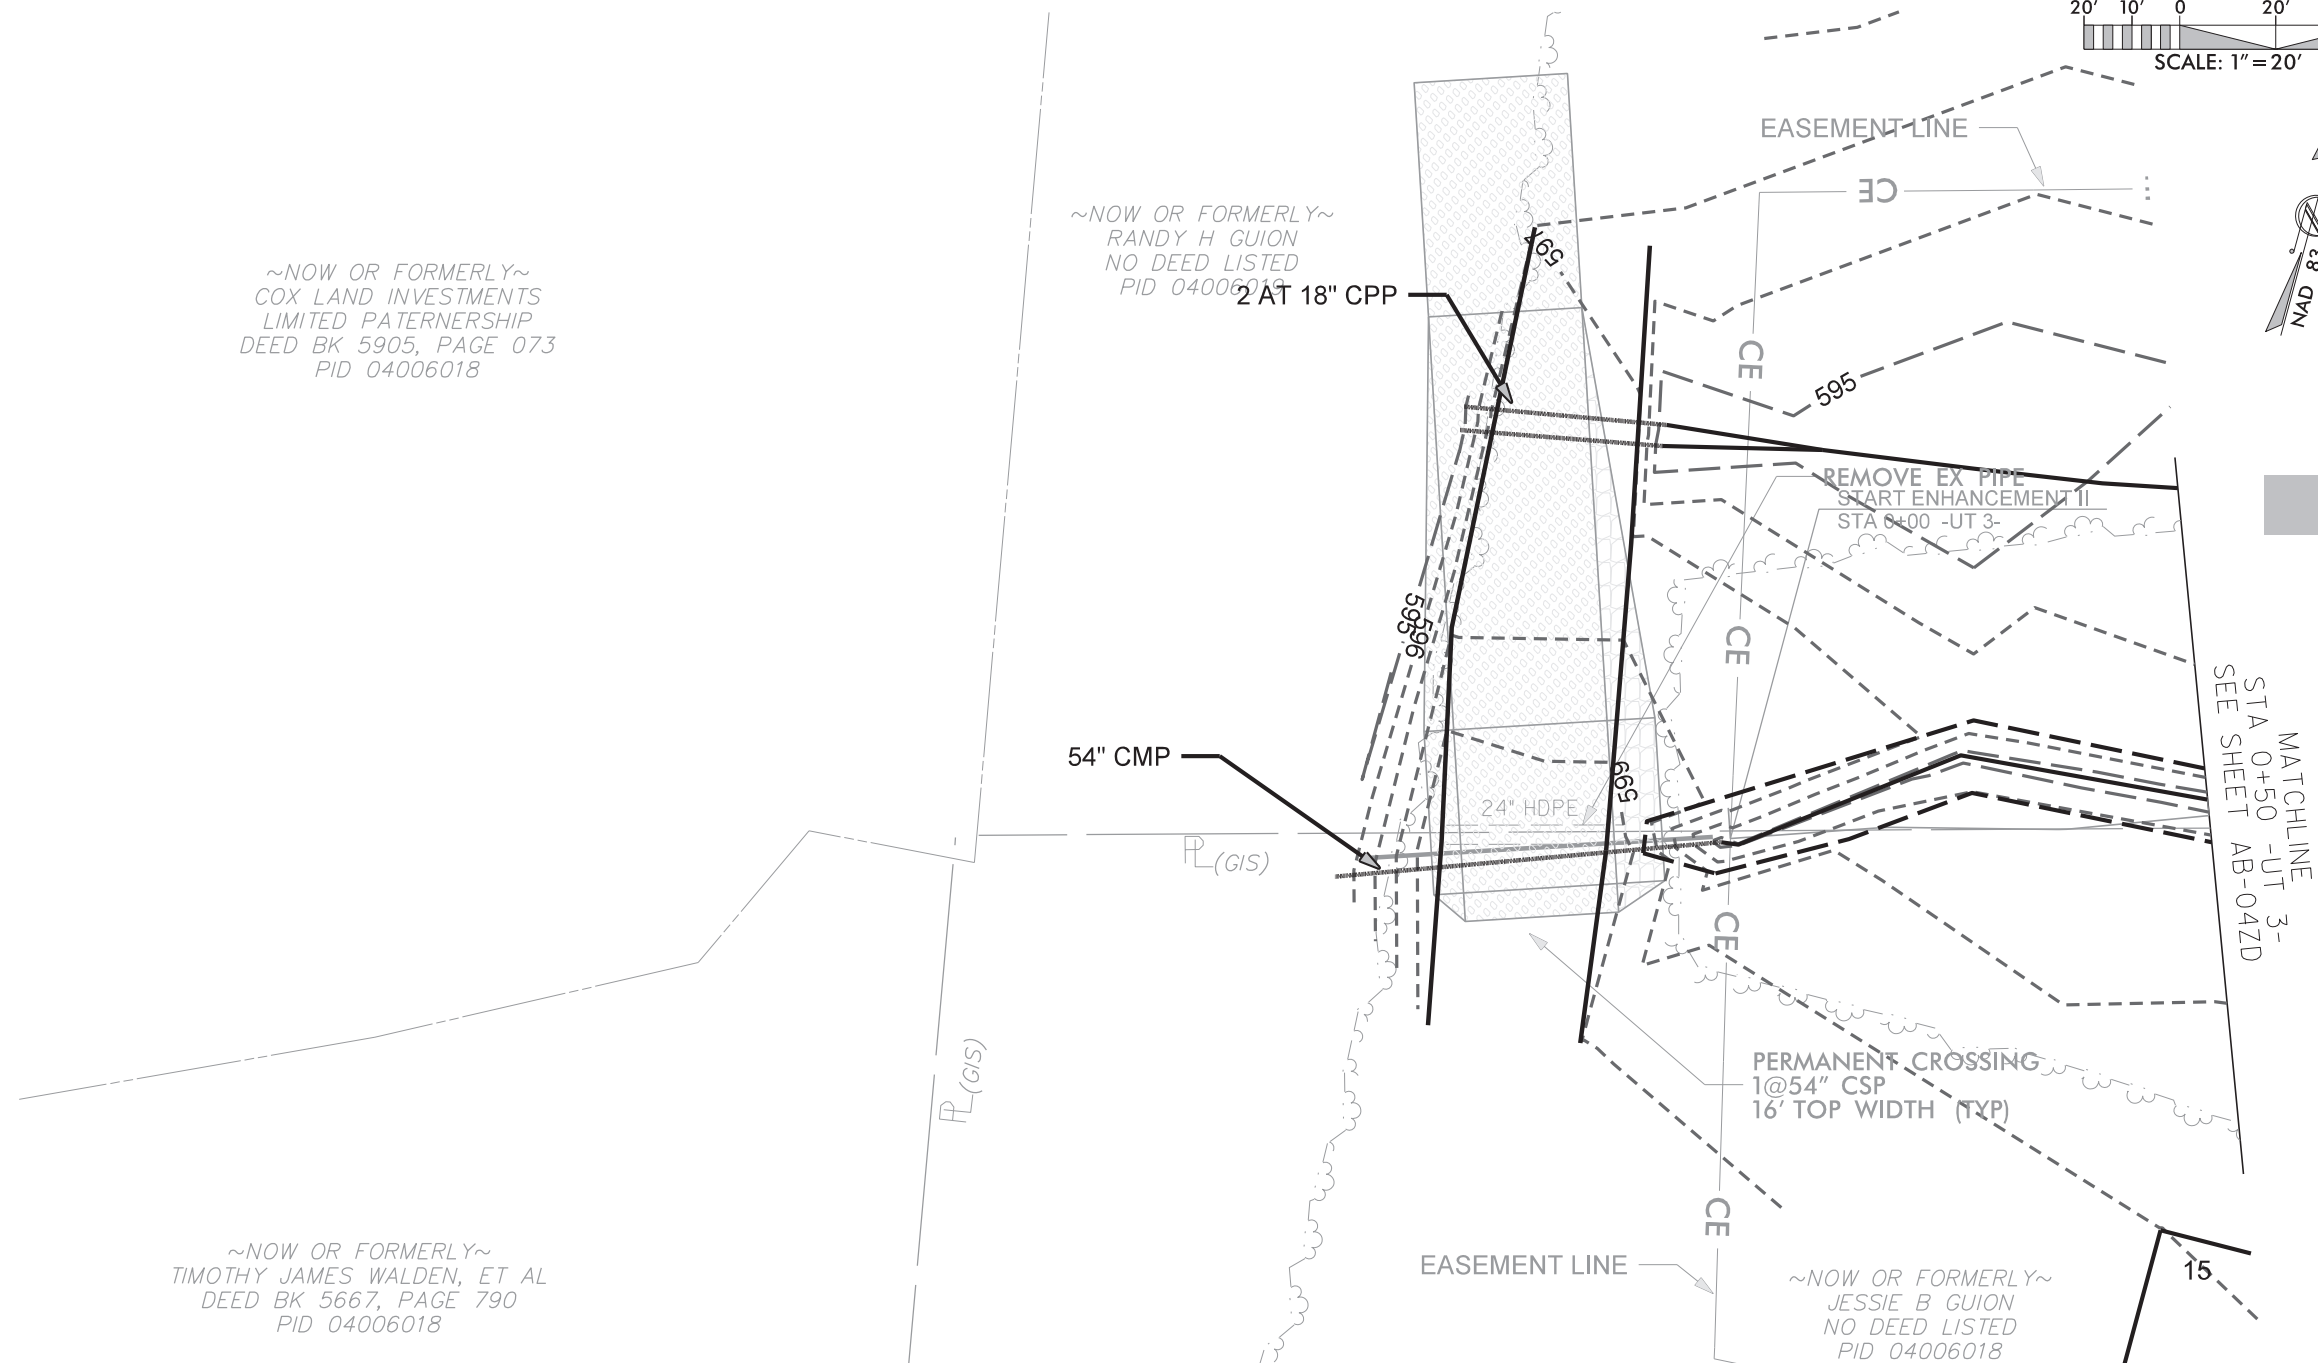

Permanent Pipe Crossings					
Centerline Station	Pipe Size	Pipe Length (feet)	Pipe Invert In (feet)	Pipe Invert Out (feet)	Bury Depth (feet)
-0+10 -UT3	1 @ 54" CSP	37	594.2	593.9	1.0

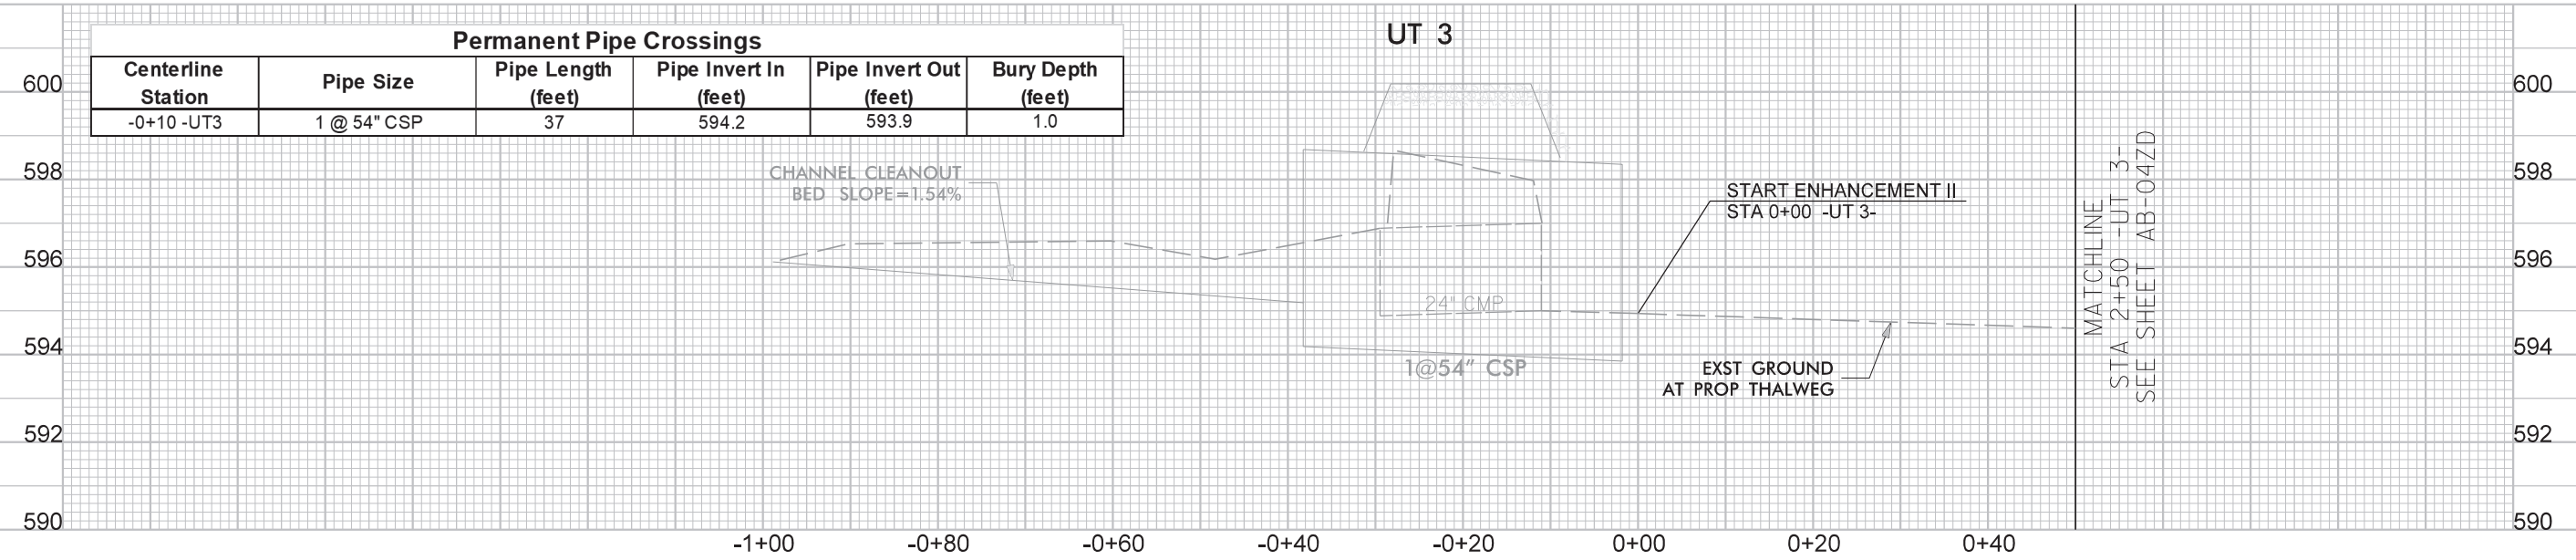

© 2022 SUNGATE DESIGN GROUP, P.A. THIS DRAWING AND ALL REPRODUCTIONS OF IT ARE THE SOLE PROPERTY OF SDG. REPRODUCTION OR OTHER USES OF THIS DRAWING WITHOUT WRITTEN CONSENT OF SDG IS NOT PERMITTED.



**WITS END**  
 UNION COUNTY, NC  
**AS-BUILT STRUCTURES**

PROJECT # : 1221-20024  
 DRAWING NAME: WITS END PSH AB-04ZC  
 DATE: 2022  
 DRAWN BY: JRH  
 REVIEWED BY: JGD  
 REVISIONS:

SHEET NO.  
**AB-04ZC**

10/6/2022  
 Wits\_End\_Psh\_AB-04ZC.dgn  
 jrd



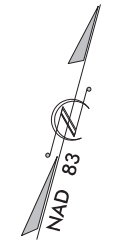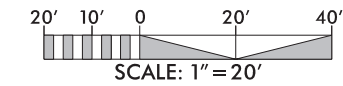


DocuSigned by:  
**Josh Dalton**  
 1089AD8C14994C3...  
 PROFESSIONAL ENGINEER  
 26971  
 JOSHUA G. DALTON

DATE: 10/7/2022

DOCUMENT NOT CONSIDERED FINAL  
 UNLESS ALL SIGNATURES COMPLETED

**SUNGATE DESIGN GROUP, P.A.**  
 8908 S. FRANKLIN ROAD  
 SUITE 200  
 CHARLOTTE, NC 27866  
 TEL: (919) 855-2243  
 ENG FIRM LICENSE NO. C-980

**Aslam Environmental, Inc.**

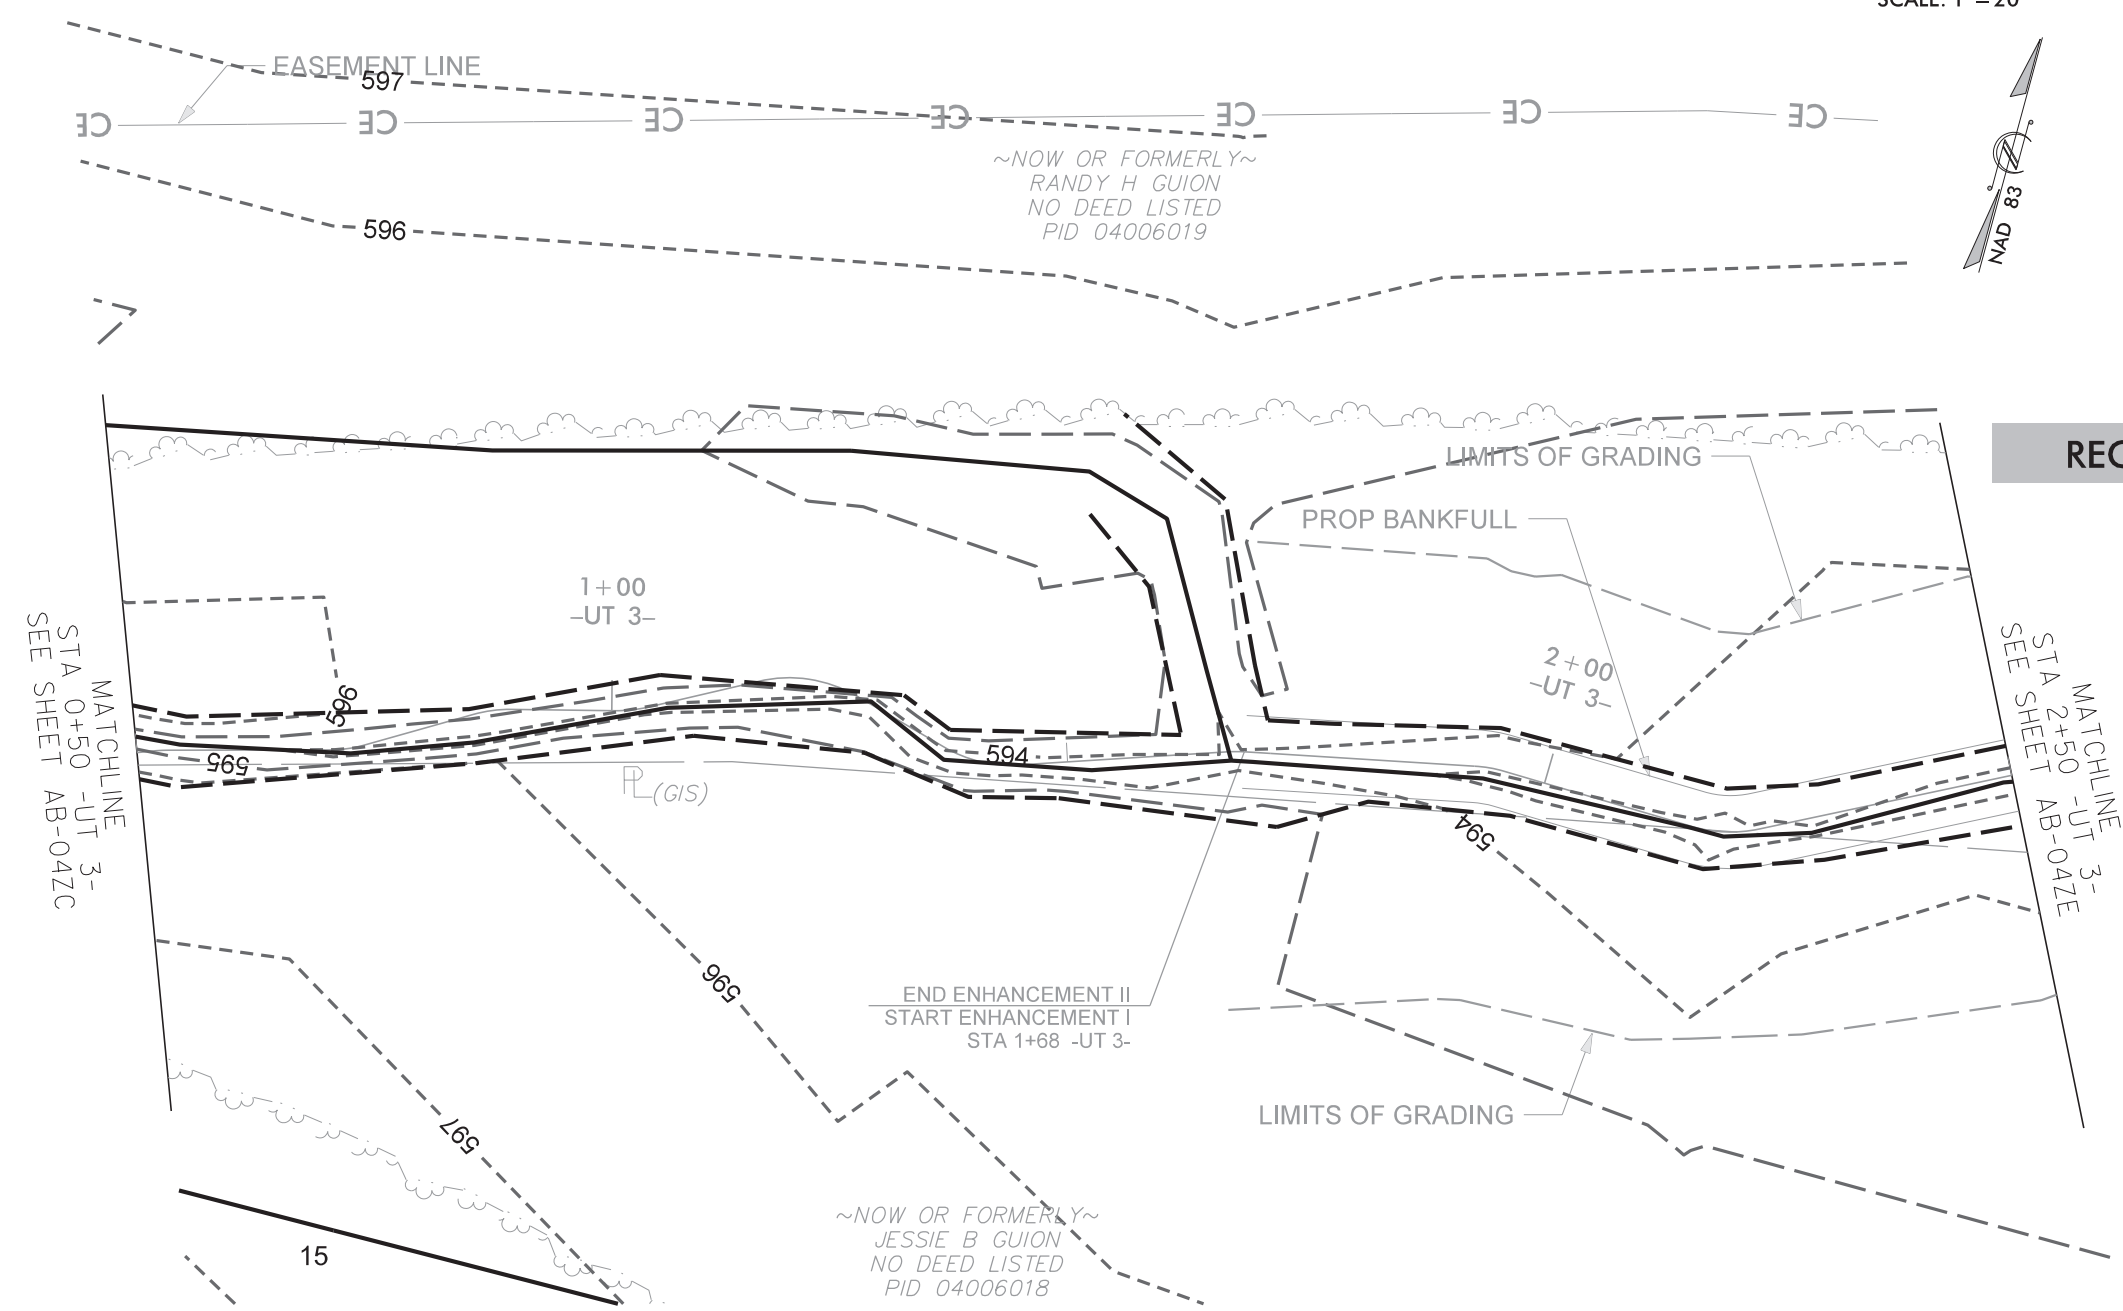


**RECORD DRAWING**

MATCHLINE  
STA 0+50 -UT 3-  
SEE SHEET AB-04ZC

MATCHLINE  
STA 2+50 -UT 3-  
SEE SHEET AB-04ZE

UT 3

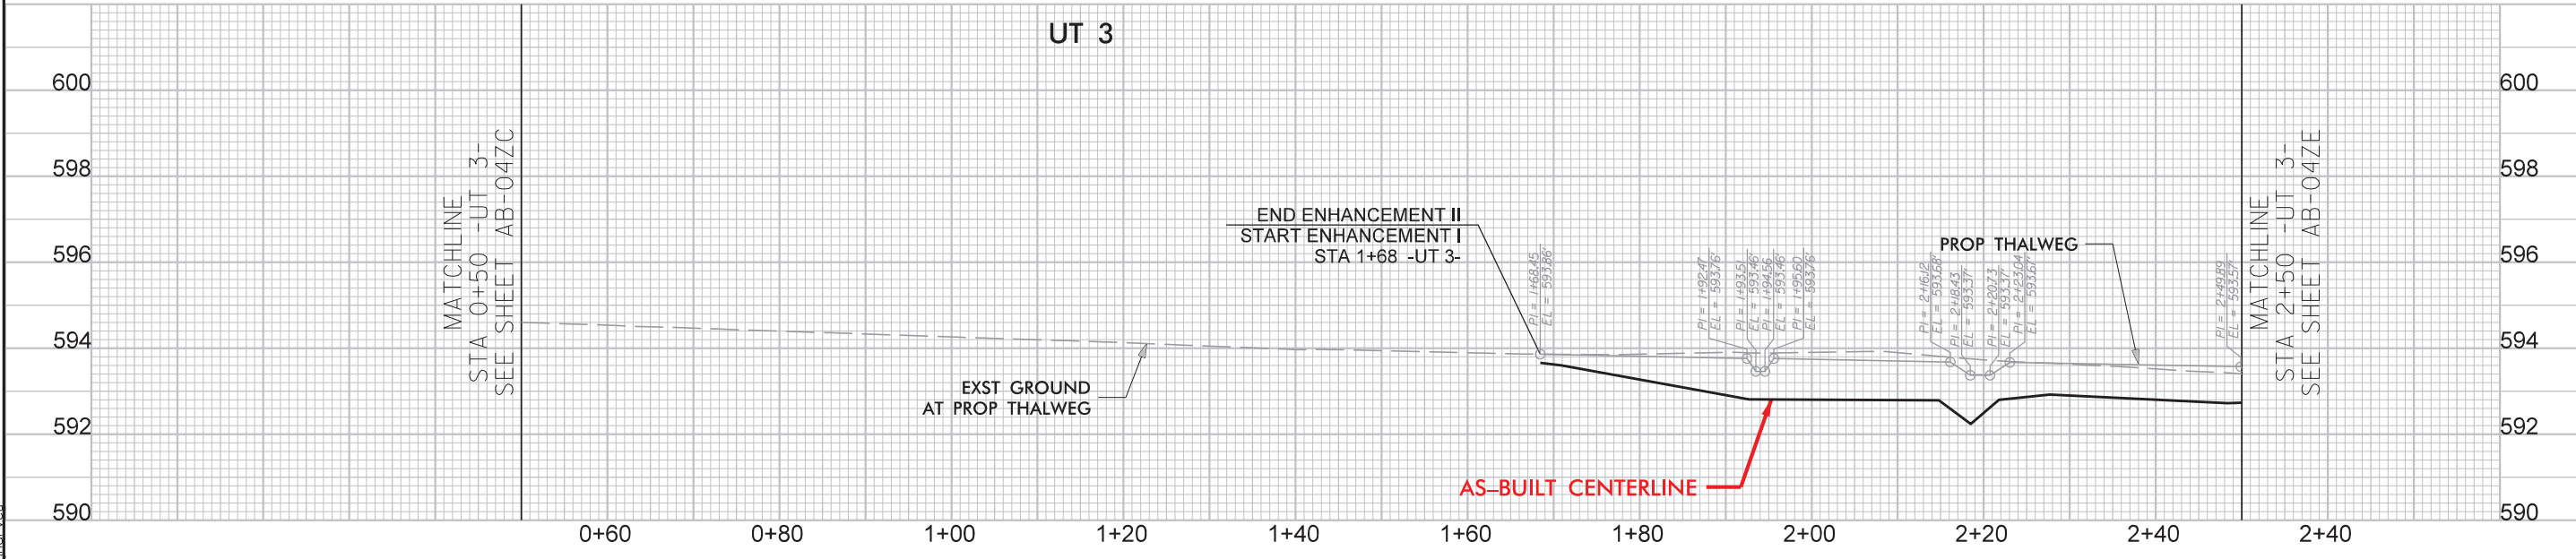

MATCHLINE  
STA 0+50 -UT 3-  
SEE SHEET AB-04ZC

MATCHLINE  
STA 2+50 -UT 3-  
SEE SHEET AB-04ZE



THIS DRAWING AND ALL REPRODUCTIONS OF IT ARE THE SOLE PROPERTY OF SDG. REPRODUCTION OR OTHER USES OF THIS DRAWING WITHOUT WRITTEN CONSENT OF SDG IS NOT PERMITTED.

PROJECT # :	1221-20024
DRAWING NAME:	WITS END PSH AB-04ZD
DATE:	2022
DRAWN BY:	JRH
REVIEWED BY:	JGD
REVISIONS:	

SHEET NO.  
**AB-04ZD**


10/6/2022  
Wits\_End\_Psh\_AB-04ZD.dgn

**RECORD DRAWING**

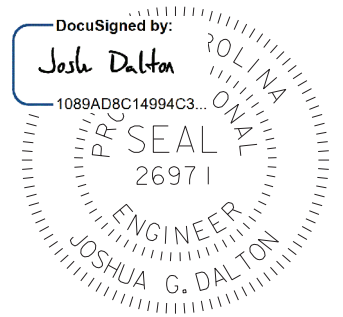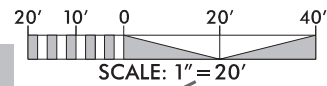

DocuSigned by:  
 Josh Dalton  
 1089AD8C14994C3...  
**DATE:** 10/7/2022  
**DOCUMENT NOT CONSIDERED FINAL UNLESS ALL SIGNATURES COMPLETED**

**SUNGATE DESIGN GROUP, P.A.**  
 890 GILES FARM ROAD  
 SUITE 200  
 WILSON, NC 27604  
 TEL: (919) 856-2243  
 ENG. FIRM LICENSE NO. C-980

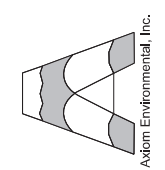


**WITS END**  
 UNION COUNTY, NC  
**AS-BUILT STRUCTURES**

PROJECT #: 1221-20024  
 DRAWING NAME: WITS END PSH AB-04ZE  
 DATE: 2022  
 DRAWN BY: JRH  
 REVIEWED BY: JGD  
 REVISIONS:

SHEET NO. **AB-04ZE**

~NOW OR FORMERLY~  
 RANDY H GUION  
 NO DEED LISTED  
 PID 04006019


~NOW OR FORMERLY~  
 JESSIE B GUION  
 NO DEED LISTED  
 PID 04006018

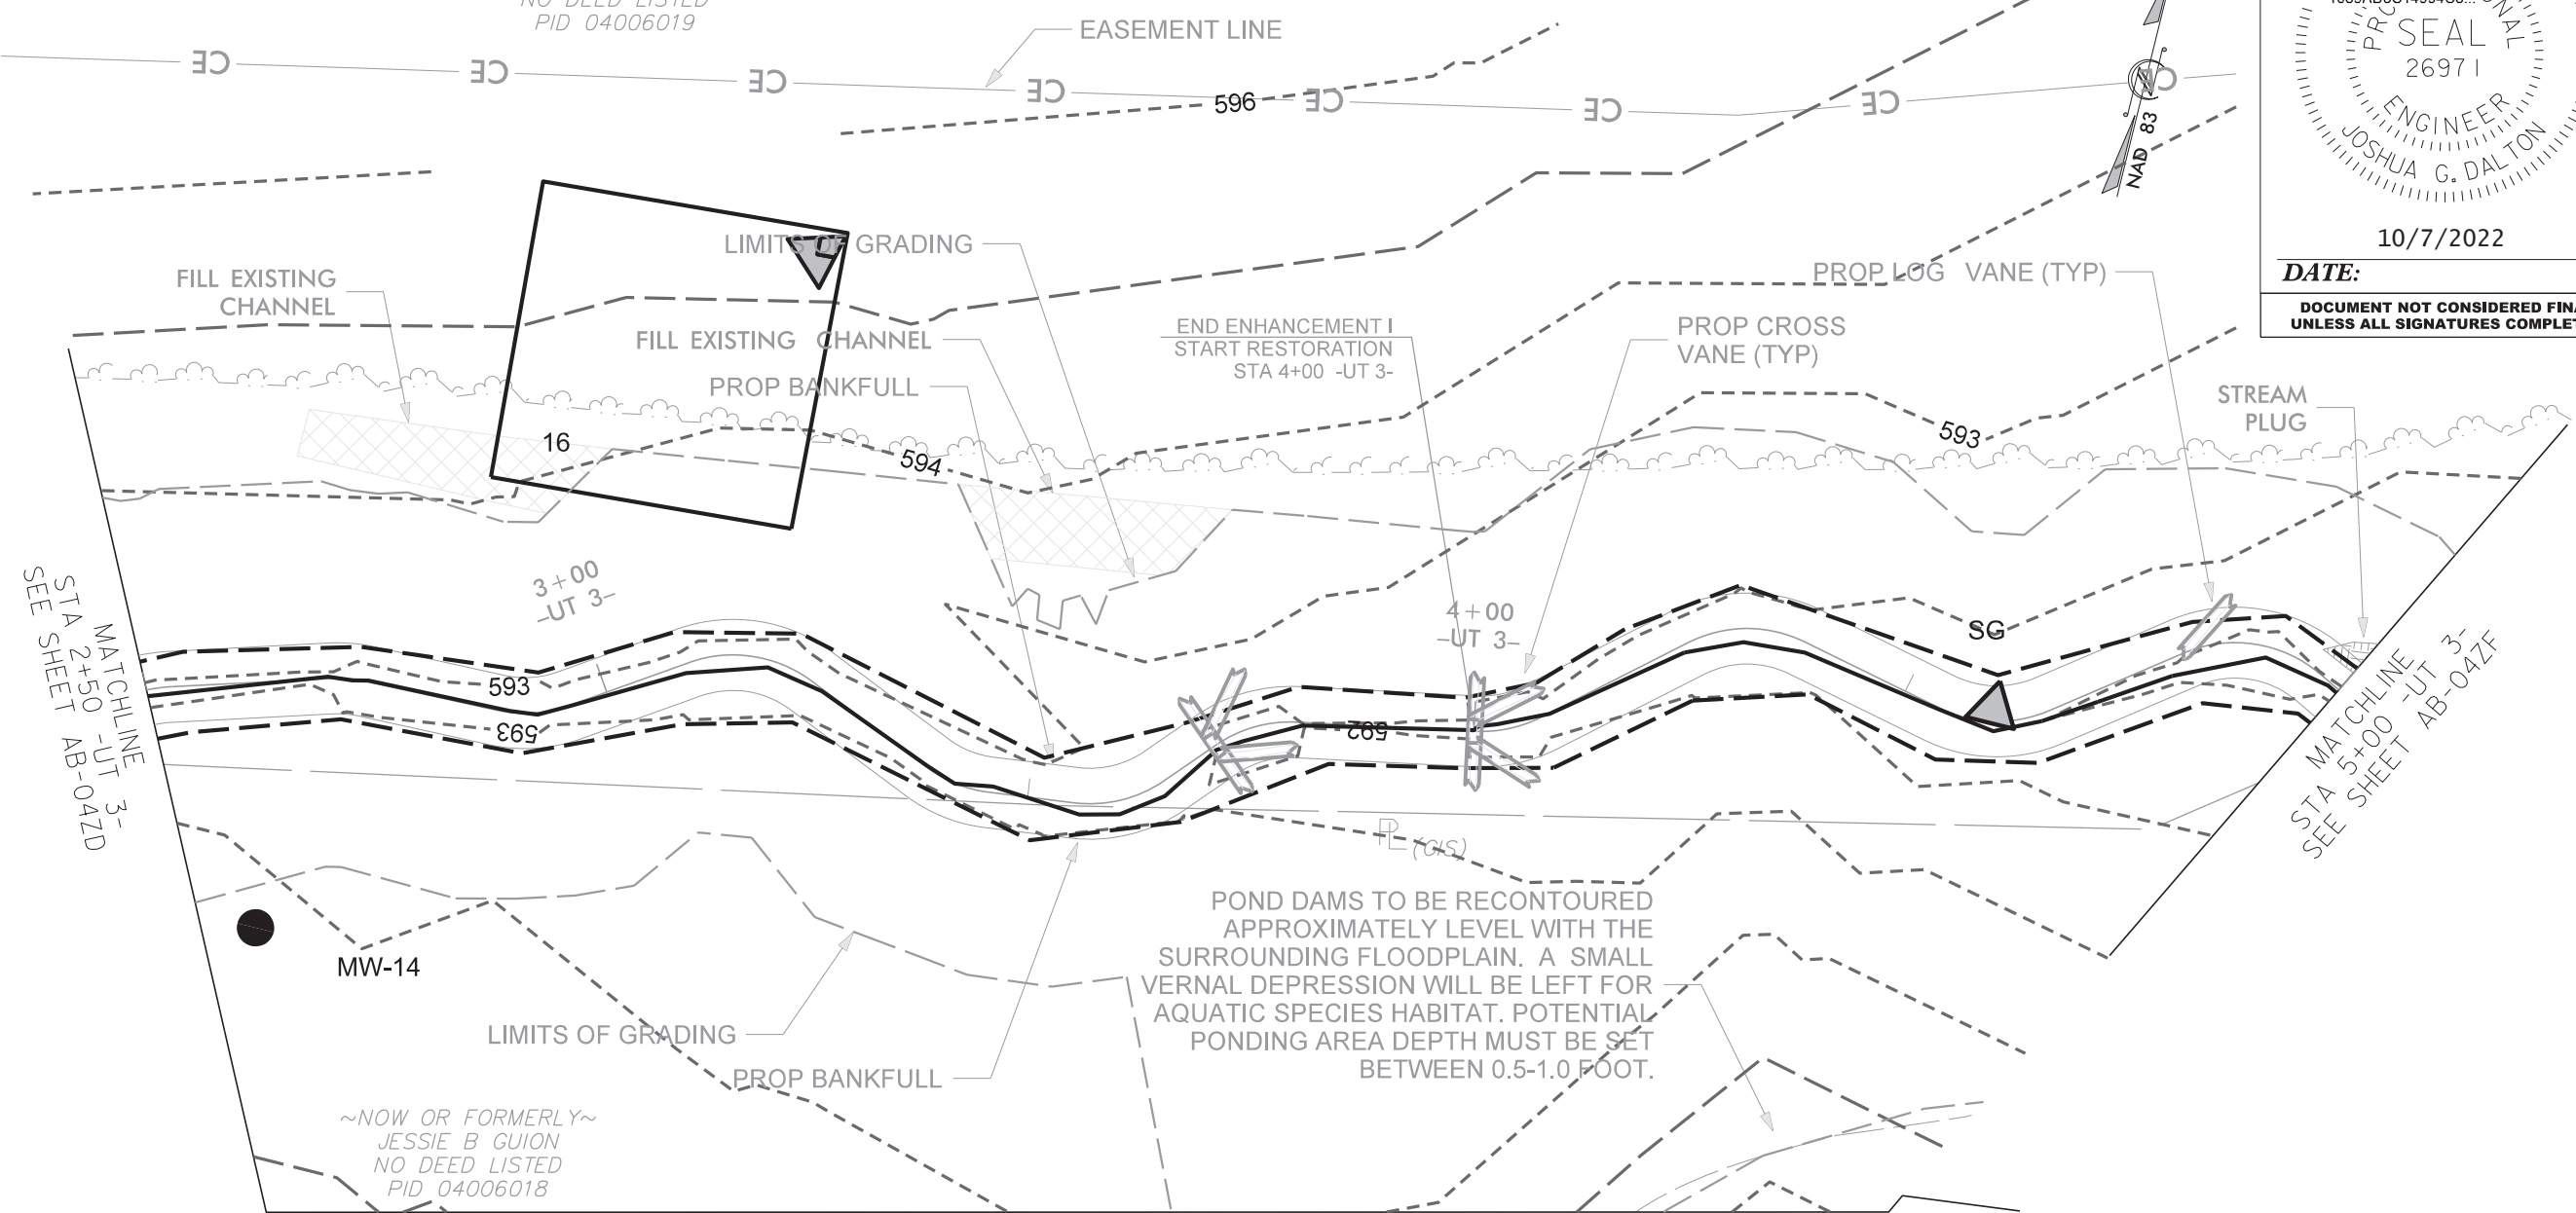

MATCHLINE SEE SHEET AB-04ZX  
**UT 3**


**-UT 3- AS-BUILT STRUCTURE LOCATIONS**

STR. TYPE	NORTHING	EASTING	Prop Elevation	AB Survey Elevation
CROSS VANE	425,945.11	1,565,730.02	593.01	592.20
CROSS VANE	425,953.16	1,565,756.56	592.52	591.87
LOG VANE	425,979.39	1,565,828.23	591.70	590.94

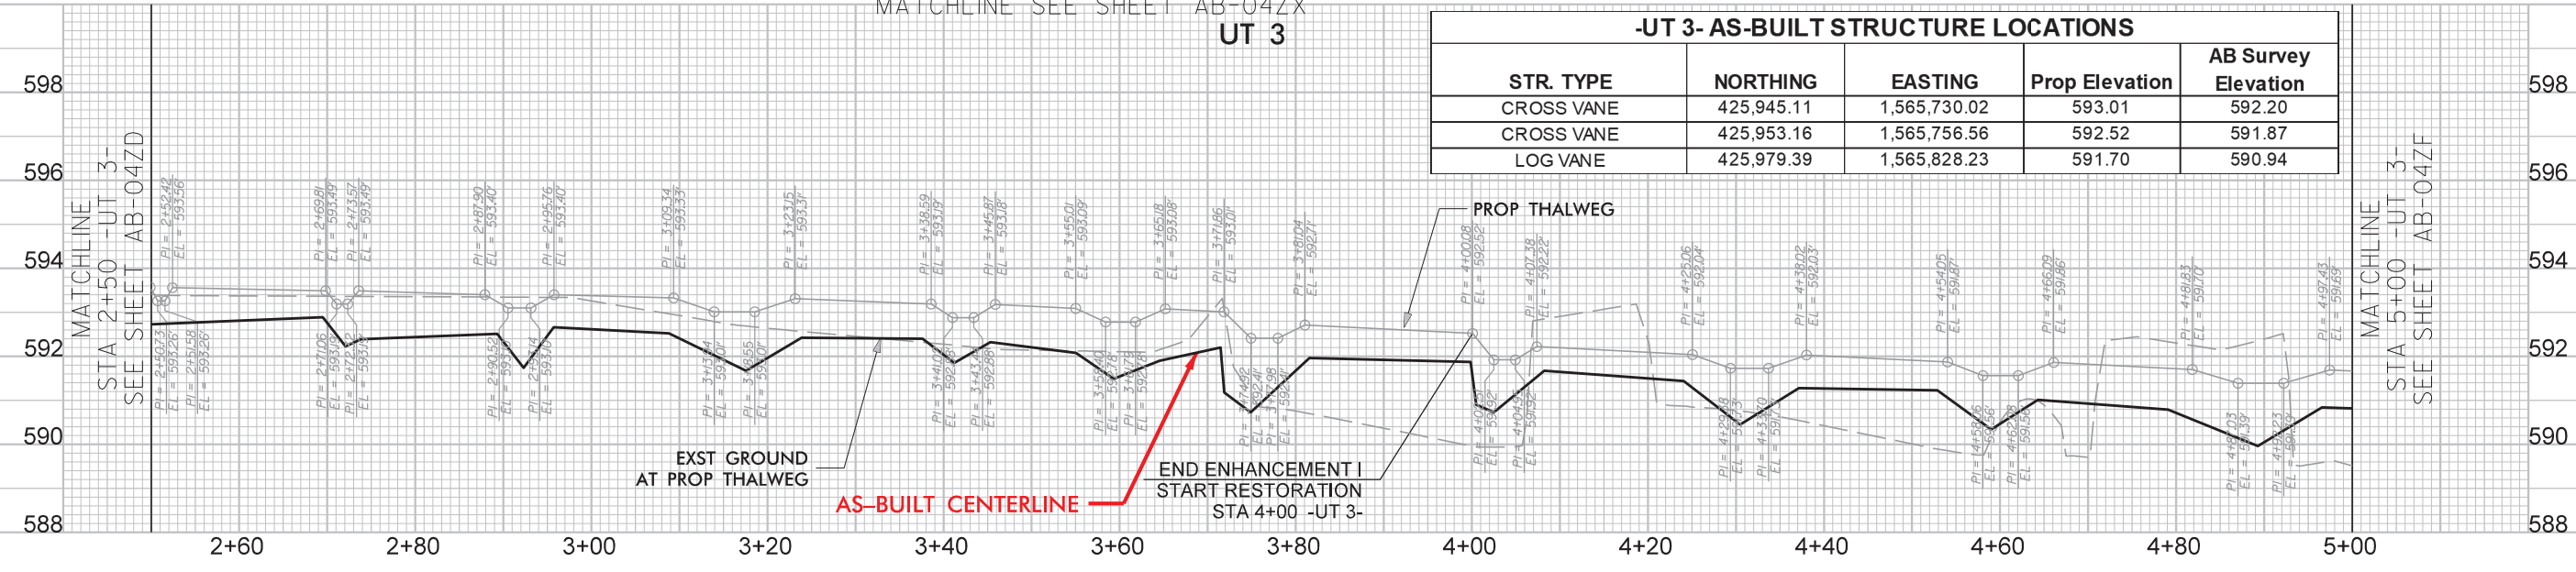

10/6/2022  
 Wits\_End\_Psh\_AB-04ZE.dgn

© 2022 SUNGATE DESIGN GROUP, P.A. THIS DRAWING AND ALL REPRODUCTIONS OF IT ARE THE SOLE PROPERTY OF SDG. REPRODUCTION OR OTHER USES OF THIS DRAWING WITHOUT WRITTEN CONSENT OF SDG IS NOT PERMITTED.

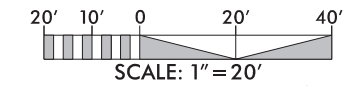

**RECORD DRAWING**



DocuSigned by:  
**Josh Dalton**  
 1089AD8C14994C3...  
 PROFESSIONAL SEAL  
 26971  
 ENGINEER  
 JOSHUA G. DALTON  
 DATE: 10/7/2022

**SUNGATE DESIGN GROUP, P.A.**  
 934 GILES FARM ROAD  
 SUITE 200, CARY, NC 27513  
 TEL: (919) 855-2243  
 ENG FIRM LICENSE NO. C-980

**DATE:**  
 10/7/2022  
**DOCUMENT NOT CONSIDERED FINAL  
 UNLESS ALL SIGNATURES COMPLETED**


**-UT 3- AS-BUILT STRUCTURE LOCATIONS**

STR. TYPE	NORTHING	EASTING	Prop Elevation	AB Survey Elevation
CROSS VANE	425,970.81	1,565,909.67	591.18	590.37
CROSS VANE	426,003.21	1,565,974.05	590.38	589.75

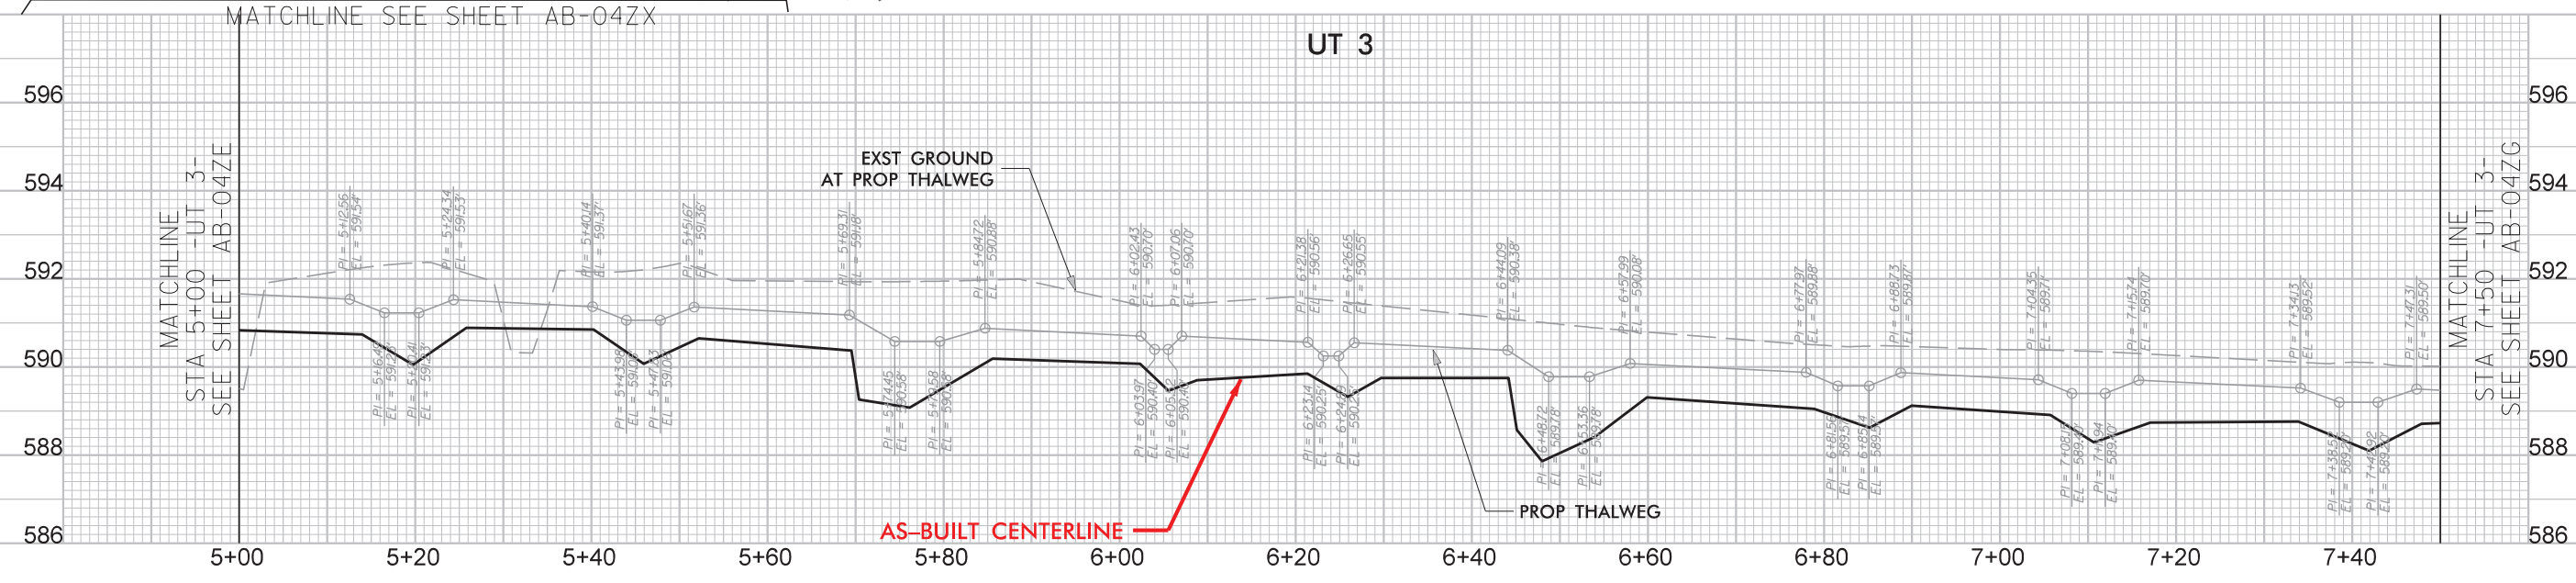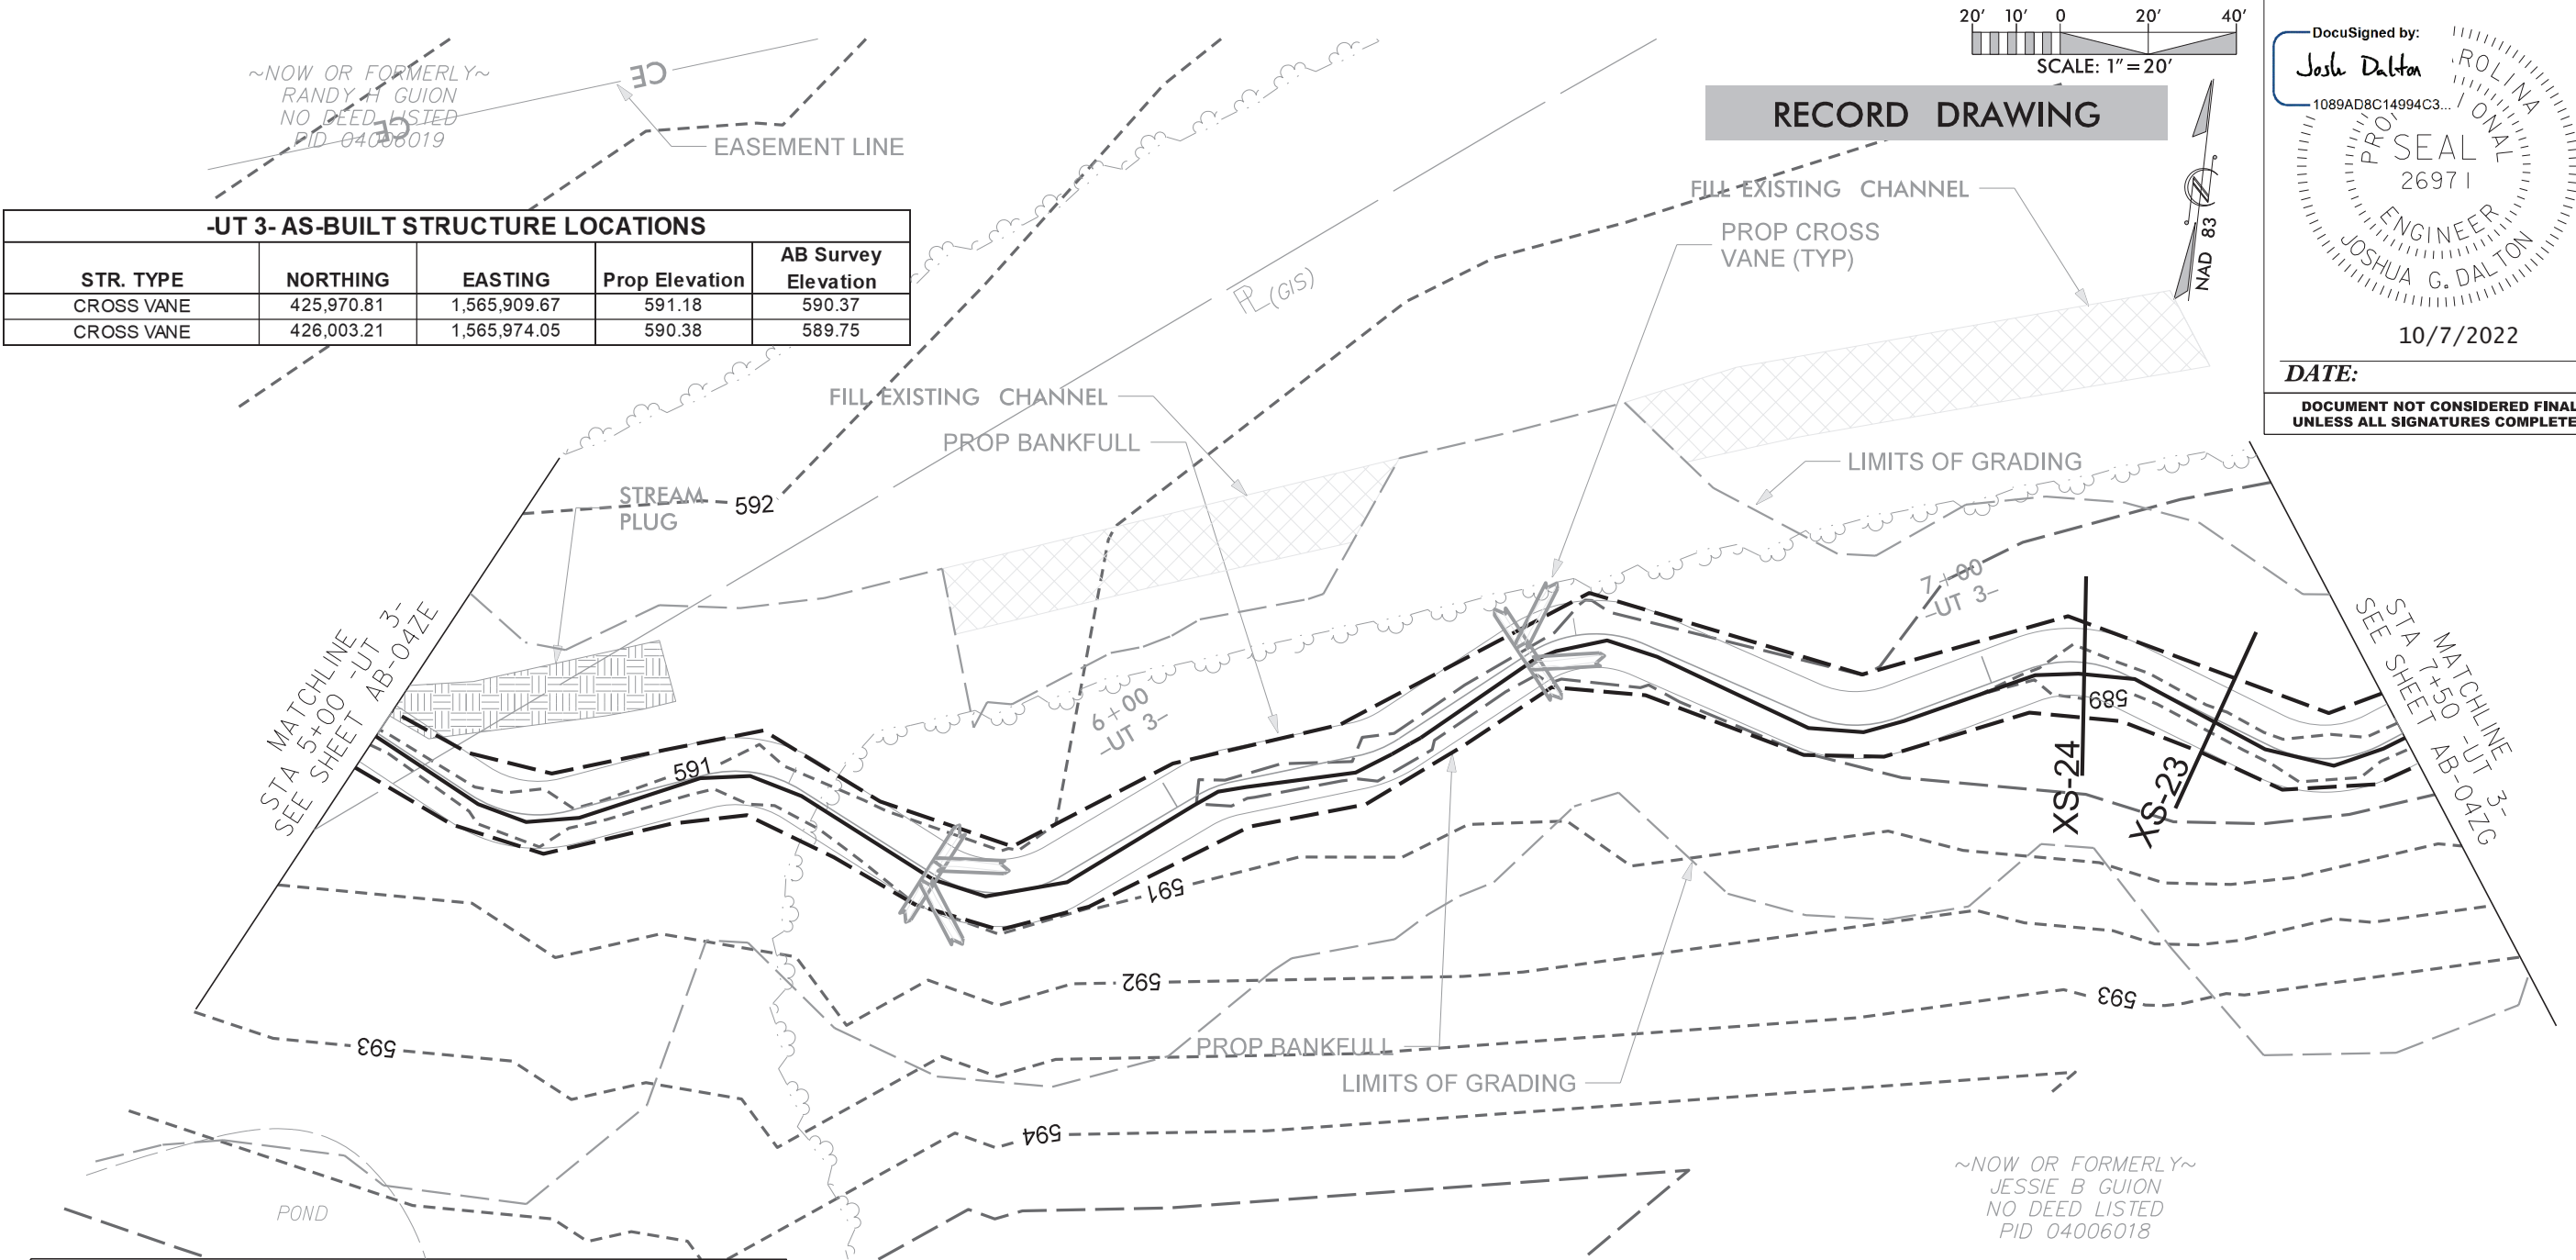

10/6/2022  
 Wits\_Endr\_psh\_AB-04ZF.dgn

© 2022 SUNGATE DESIGN GROUP, P.A. THIS DRAWING AND ALL REPRODUCTIONS OF IT ARE THE SOLE PROPERTY OF SDG. REPRODUCTION OR OTHER USES OF THIS DRAWING WITHOUT WRITTEN CONSENT OF SDG IS NOT PERMITTED.


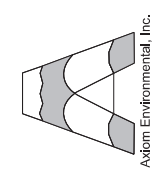


**WITS END**  
 UNION COUNTY, NC  
**AS-BUILT STRUCTURES**

PROJECT # : 1221-20024  
 DRAWING NAME: WITS END PSH AB-04ZF  
 DATE: 2022  
 DRAWN BY: JRH  
 REVIEWED BY: JGD  
 REVISIONS:

SHEET NO.  
**AB-04ZF**




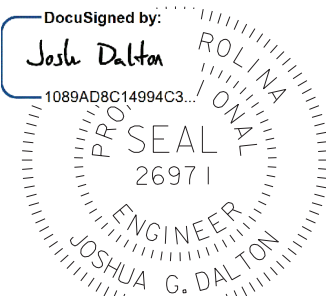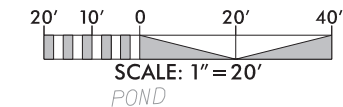

DATE: 10/7/2022


DOCUMENT NOT CONSIDERED FINAL  
UNLESS ALL SIGNATURES COMPLETED

**SUNGATE DESIGN GROUP, P.A.**  
934 GILES CRAWFORD ROAD  
CARY, NC 27513  
TEL: (919) 855-2243  
ENG FIRM LICENSE NO. C-890

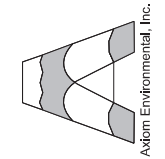


POND DAMS TO BE RECONTOURED APPROXIMATELY LEVEL WITH THE SURROUNDING FLOODPLAIN. A SMALL VERNAL DEPRESSION WILL BE LEFT FOR AQUATIC SPECIES HABITAT. POTENTIAL PONDING AREA DEPTH MUST BE SET BETWEEN 0.5-1.0 FOOT.

**RECORD DRAWING**

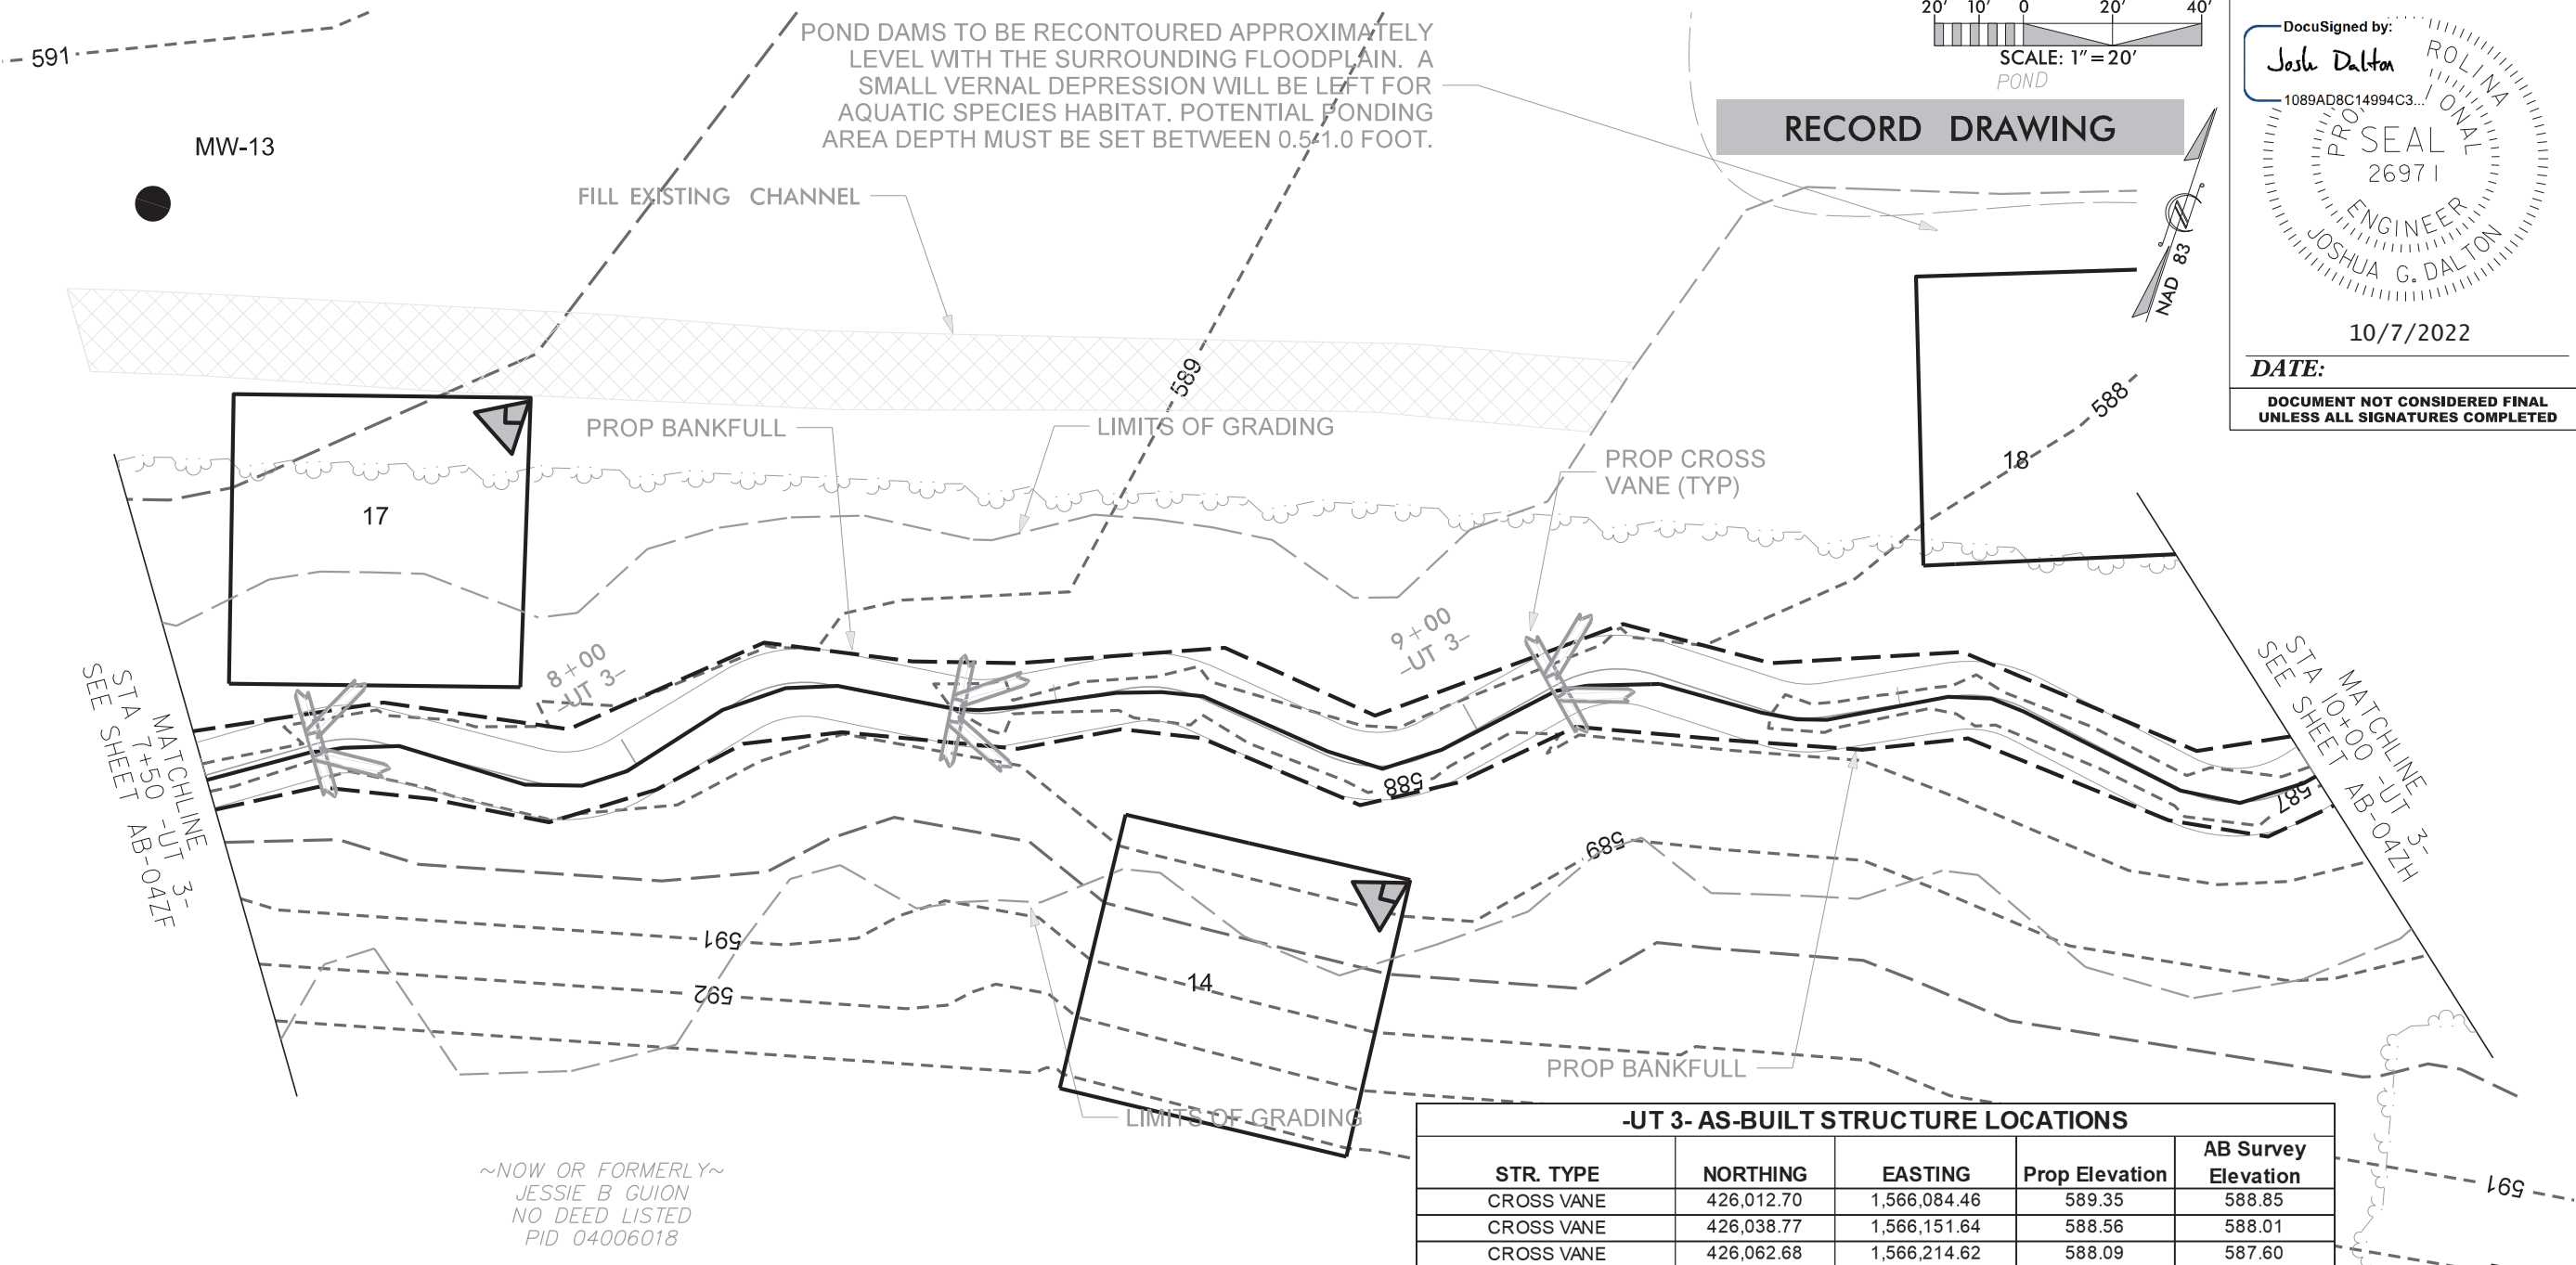

~NOW OR FORMERLY~  
JESSIE B GUION  
NO DEED LISTED  
PID 04006018

-UT 3- AS-BUILT STRUCTURE LOCATIONS				
STR. TYPE	NORTHING	EASTING	Prop Elevation	AB Survey Elevation
CROSS VANE	426,012.70	1,566,084.46	589.35	588.85
CROSS VANE	426,038.77	1,566,151.64	588.56	588.01
CROSS VANE	426,062.68	1,566,214.62	588.09	587.60

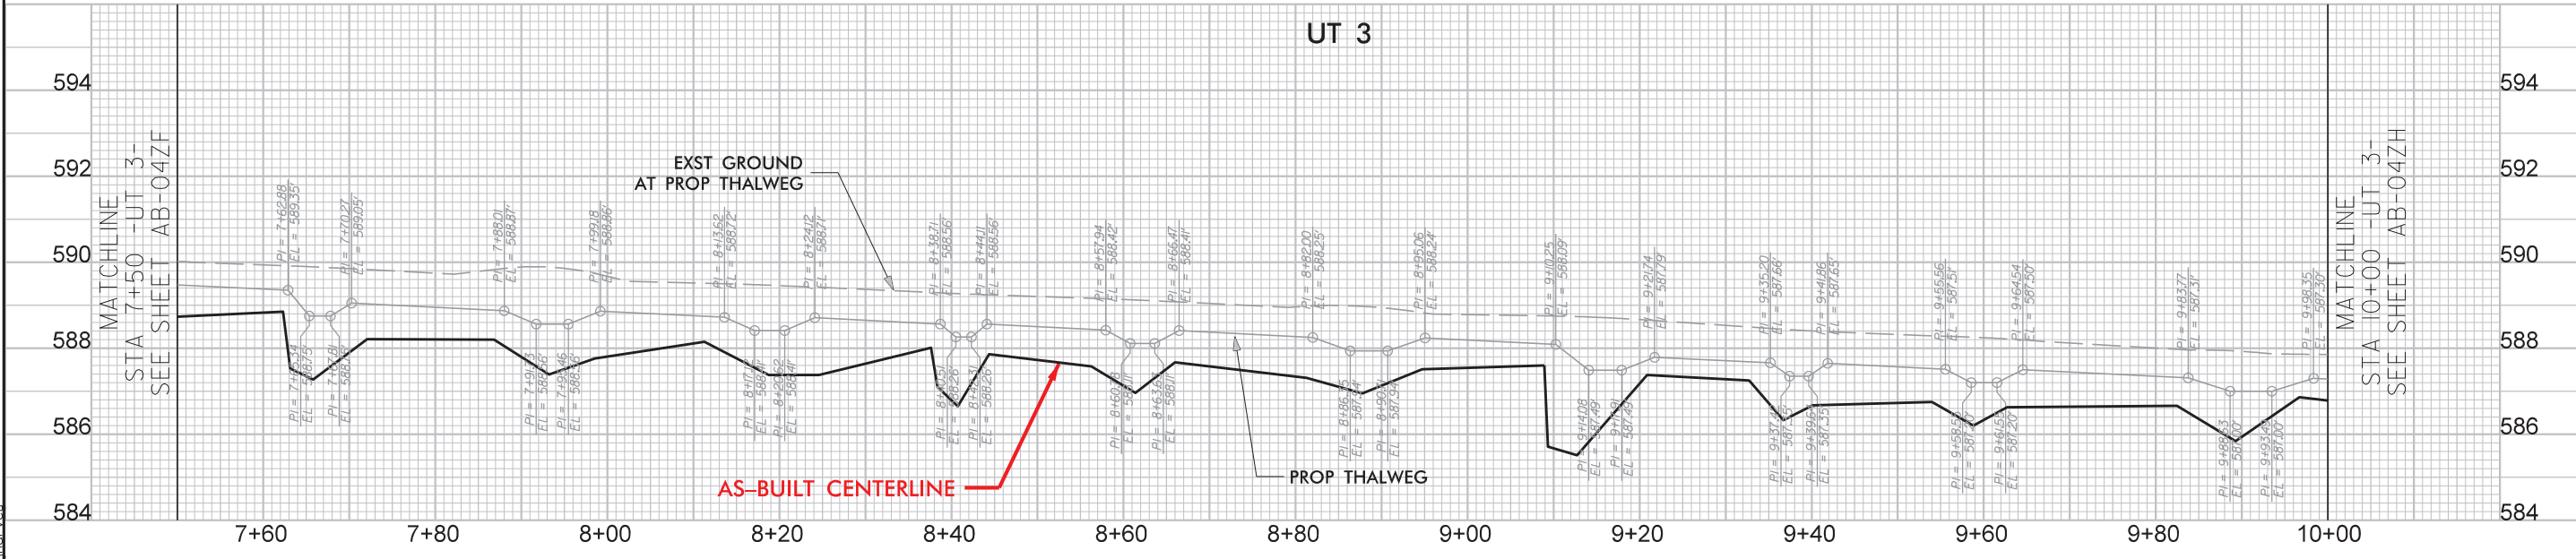


10/6/2022  
Wits\_Endr\_psh\_AB-04ZG.dgn

© 2022 SUNGATE DESIGN GROUP, P.A. THIS DRAWING AND ALL REPRODUCTIONS OF IT ARE THE SOLE PROPERTY OF SDG. REPRODUCTION OR OTHER USES OF THIS DRAWING WITHOUT WRITTEN CONSENT OF SDG IS NOT PERMITTED.


**WITS END**  
UNION COUNTY, NC  
**AS-BUILT STRUCTURES**

PROJECT # : 1221-20024  
DRAWING NAME: WITS END PSH AB-04ZG  
DATE: 2022  
DRAWN BY: JRH  
REVIEWED BY: JGD  
REVISIONS:

SHEET NO.  
**AB-04ZG**

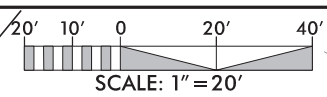


**RECORD DRAWING**

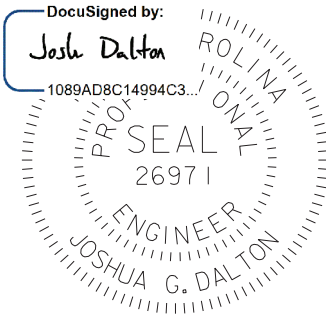


DATE: 10/7/2022

DOCUMENT NOT CONSIDERED FINAL UNLESS ALL SIGNATURES COMPLETED


**SUNGATE DESIGN GROUP, P.A.**  
 930 GILES FARM ROAD  
 SUITE 1000  
 WILSON, NC 27606  
 TEL: (919) 855-2243  
 ENG. FIRM LICENSE NO. C-980

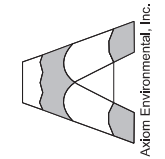

STR. TYPE	NORTHING	EASTING	Prop Elevation	AB Survey Elevation
CROSS VANE	426,093.05	1,566,309.59	587.11	586.42
<del>CROSS VANE</del>	<del>426,131.33</del>	<del>1,566,414.76</del>	<del>586.29</del>	
DROP STRUCTURE	426,122.52	1,566,448.99		585.08
DROP STRUCTURE	426,110.27	1,566,470.21		583.38

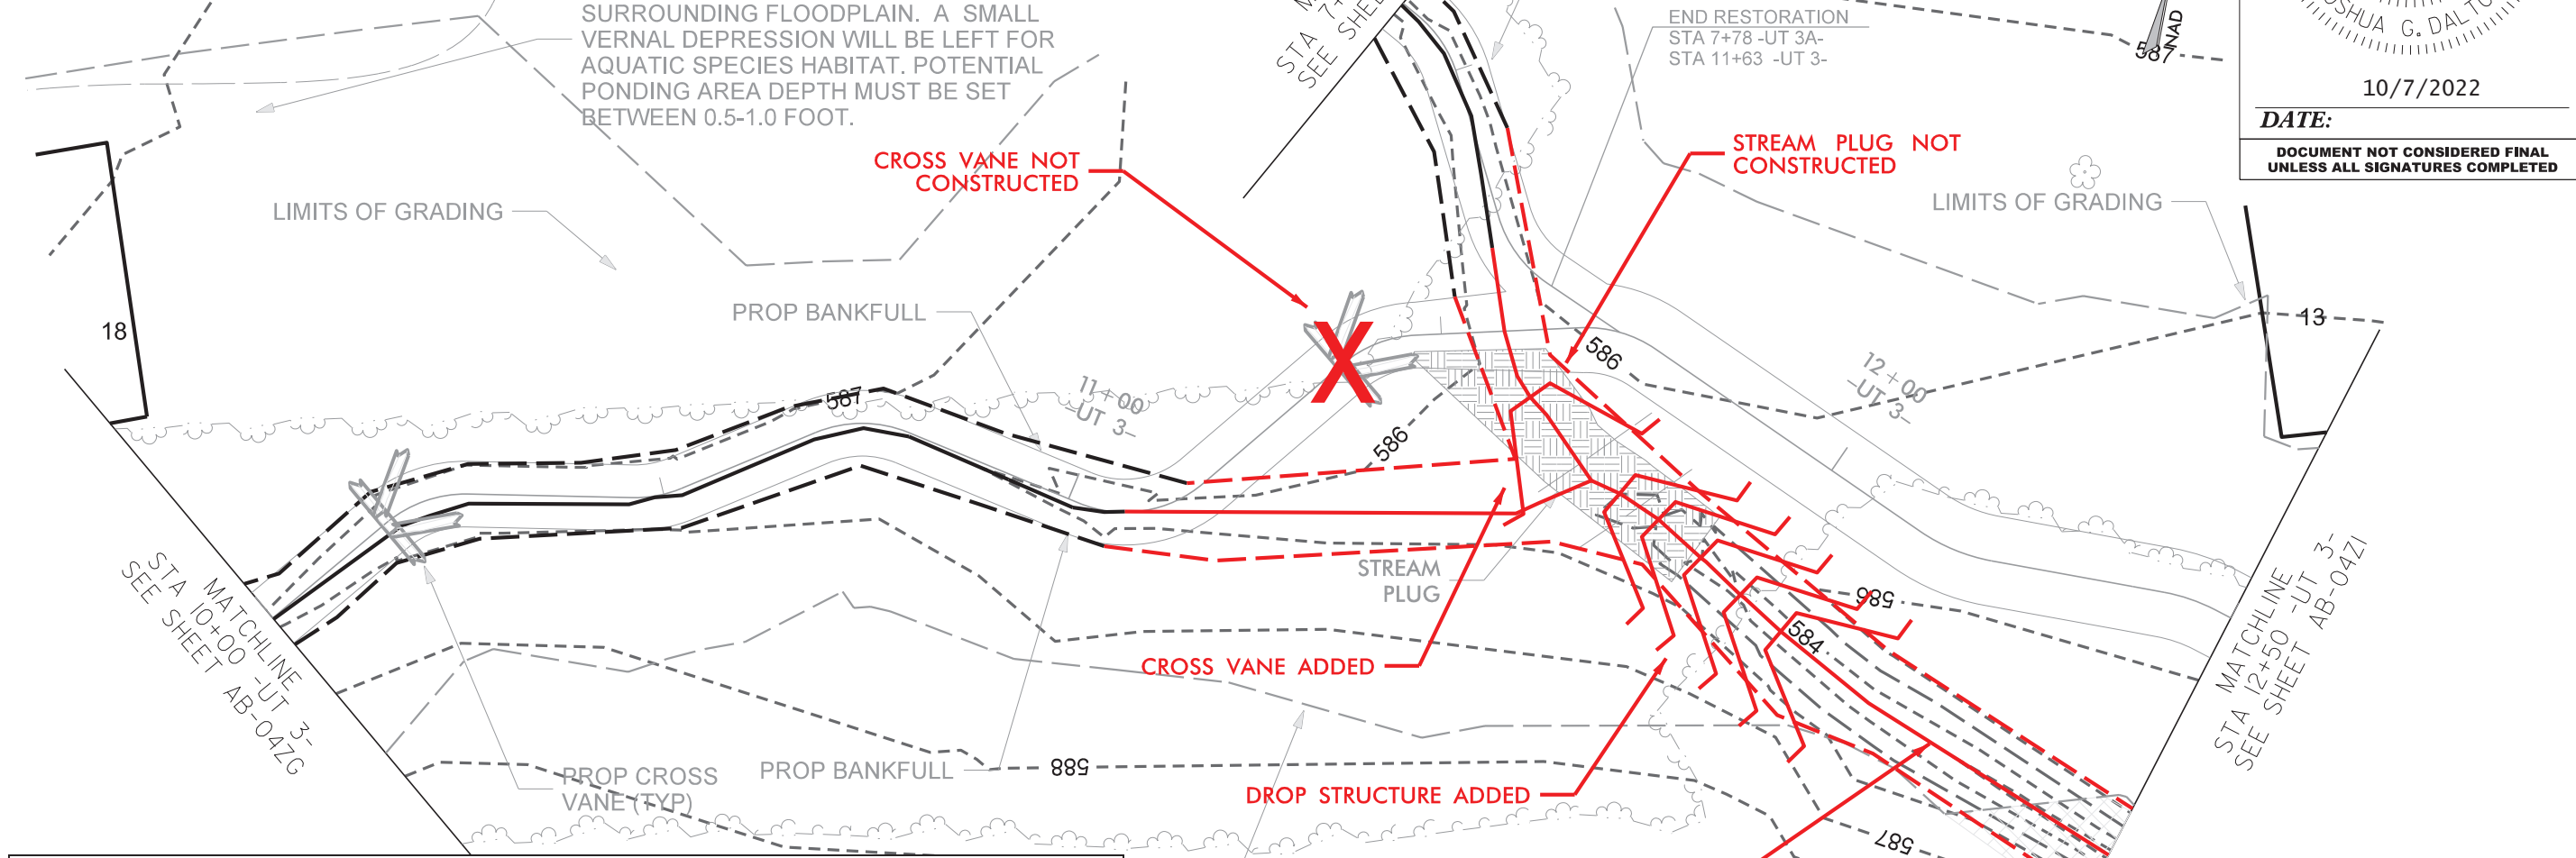

STR. TYPE	NORTHING	EASTING	Prop Elevation	AB Survey Elevation
CROSS VANE	426,131.57	1,566,436.77		585.50

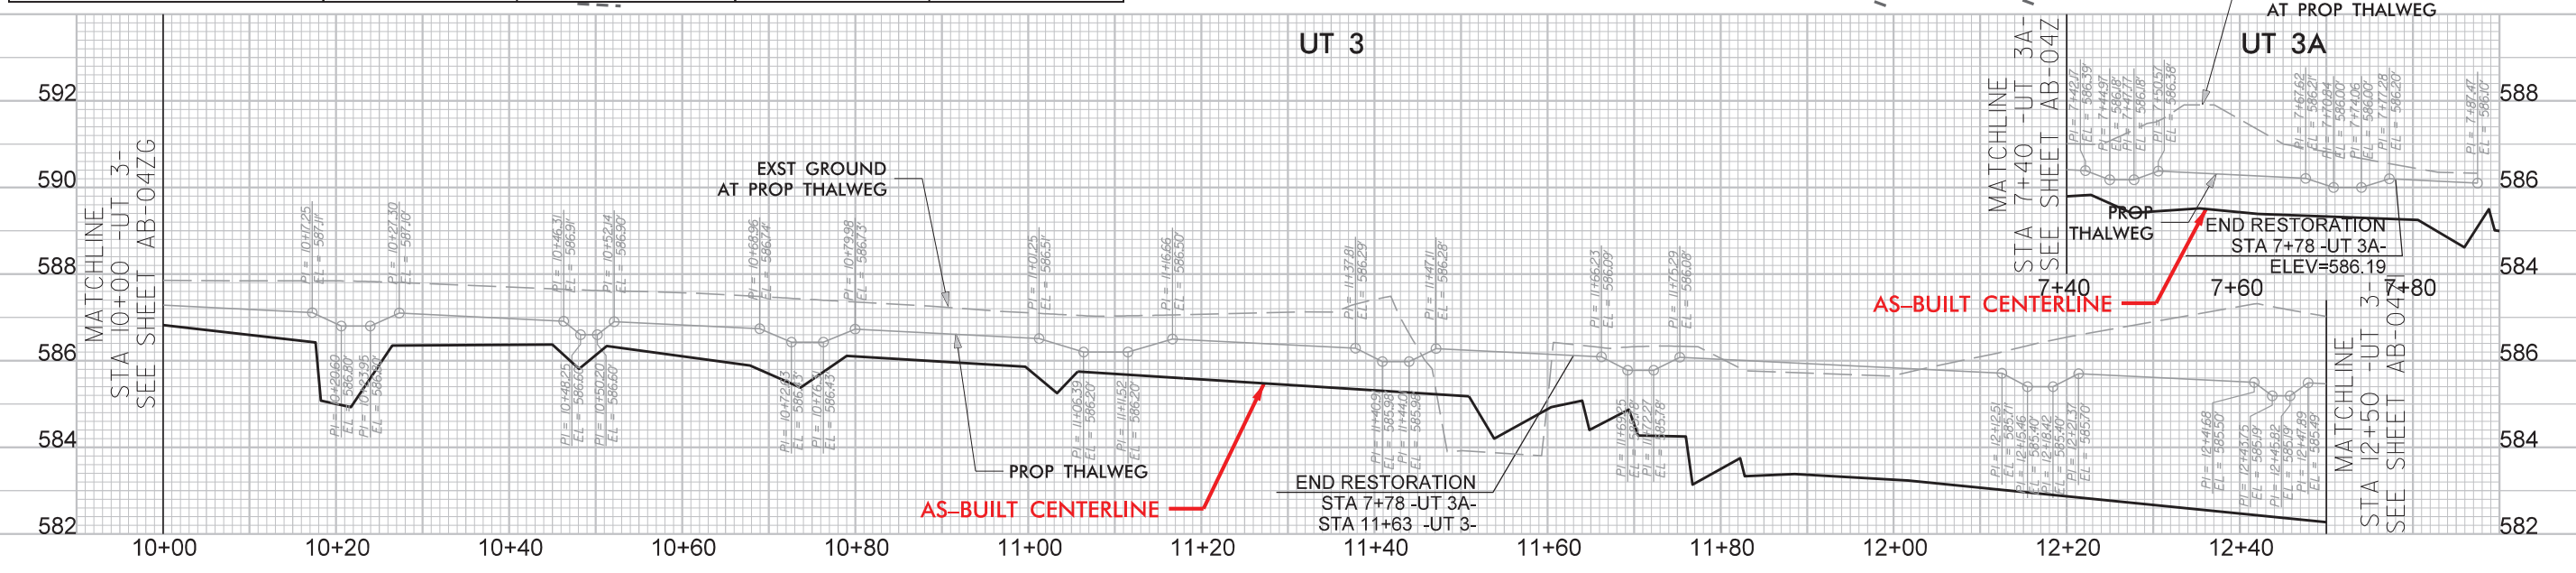

10/6/2022  
 M:\s\Eng\esh\_ab-04ZH.dgn  
 jgd

© 2021 SUNGATE DESIGN GROUP, P.A. THIS DRAWING AND ALL REPRODUCTIONS OF IT ARE THE SOLE PROPERTY OF SDG. REPRODUCTION OR OTHER USES OF THIS DRAWING WITHOUT WRITTEN CONSENT OF SDG IS NOT PERMITTED.

**WITS END**  
 UNION COUNTY, NC  
**AS-BUILT STRUCTURES**


PROJECT #: 1221-20024  
 DRAWING NAME: WITS END PSH AB-04ZH  
 DATE: 2022  
 DRAWN BY: JRH  
 REVIEWED BY: JGD  
 REVISIONS:

SHEET NO.  
**AB-04ZH**



-UT 3- AS-BUILT STRUCTURE LOCATIONS				
STR. TYPE	NORTHING	EASTING	Prop Elevation	AB Survey Elevation
<del>CROSS VANE</del>	<del>426,115.27</del>	<del>1,566,544.40</del>	<del>585.26</del>	
<del>CROSS VANE</del>	<del>426,077.24</del>	<del>1,566,687.26</del>	<del>584.22</del>	
<del>CROSS VANE</del>	<del>426,061.06</del>	<del>1,566,722.74</del>	<del>583.78</del>	

# RECORD DRAWING

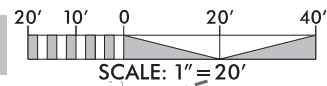

DocuSigned by:  
**Josh Dalton**  
 1089AD8C14994C3...  
 PROFESSIONAL SEAL  
 26971  
 ENGINEER  
 JOSHUA G. DALTON

DATE: 10/7/2022

DOCUMENT NOT CONSIDERED FINAL  
 UNLESS ALL SIGNATURES COMPLETED



**SUNGATE DESIGN GROUP, P.A.**  
 890 GUNNERS FARM ROAD  
 WILMINGTON, NC 28403  
 TEL: (919) 855-2243  
 ENG FIRM LICENSE NO. C-980

**WITS END**  
 UNION COUNTY, NC

**AS-BUILT STRUCTURES**

PROJECT #: 1221-20024  
 DRAWING NAME: WITS END PSH AB-04ZI  
 DATE: 2022  
 DRAWN BY: JRH  
 REVIEWED BY: JGD  
 REVISIONS:

SHEET NO.  
**AB-04ZI**

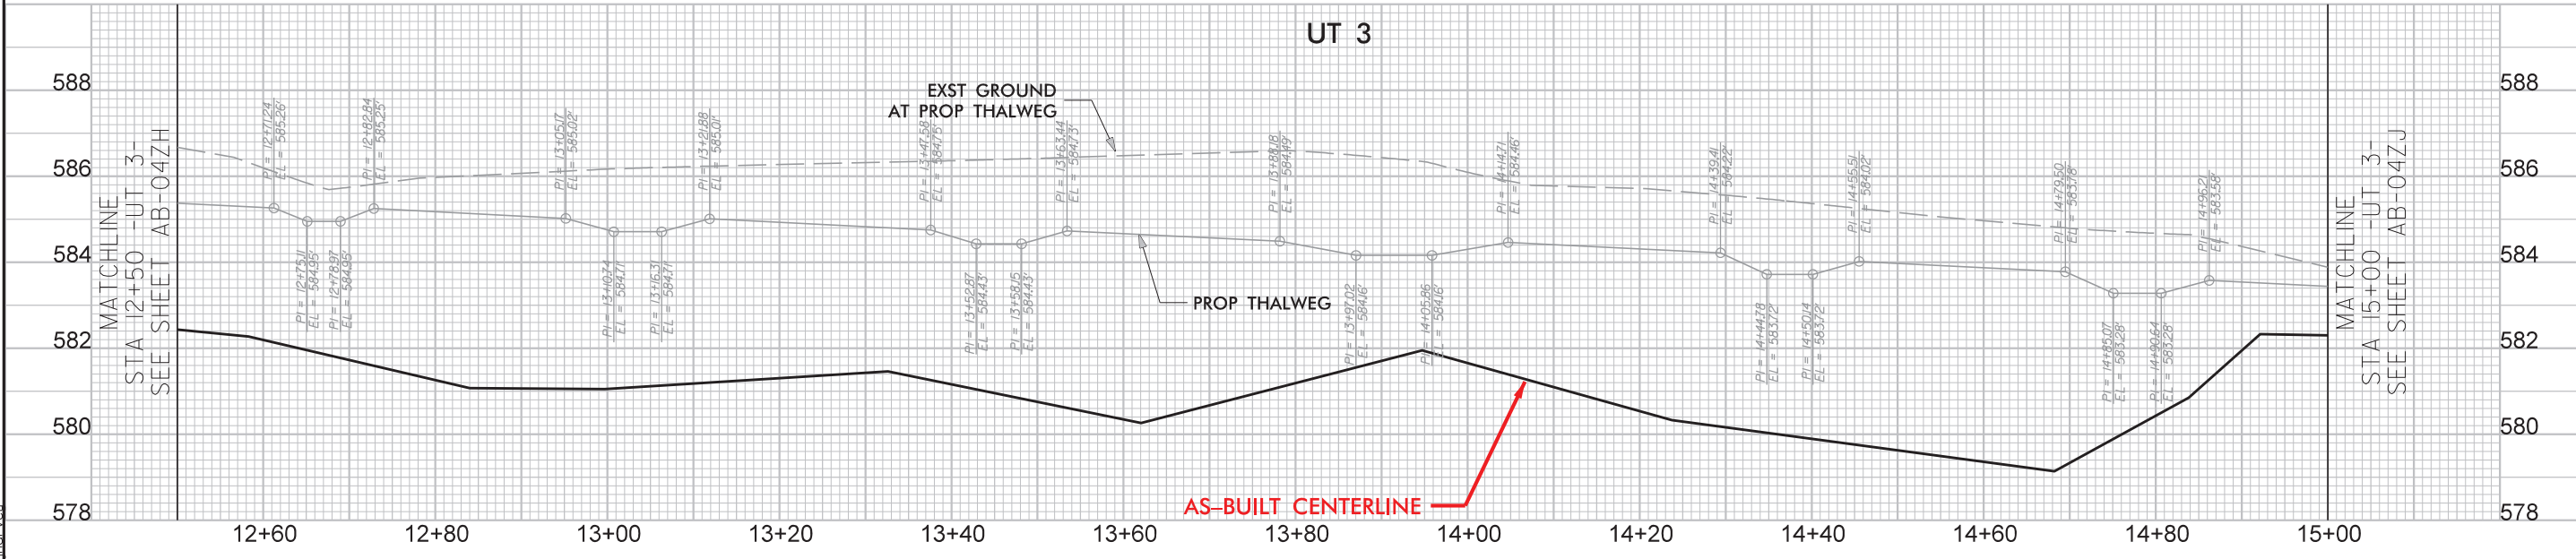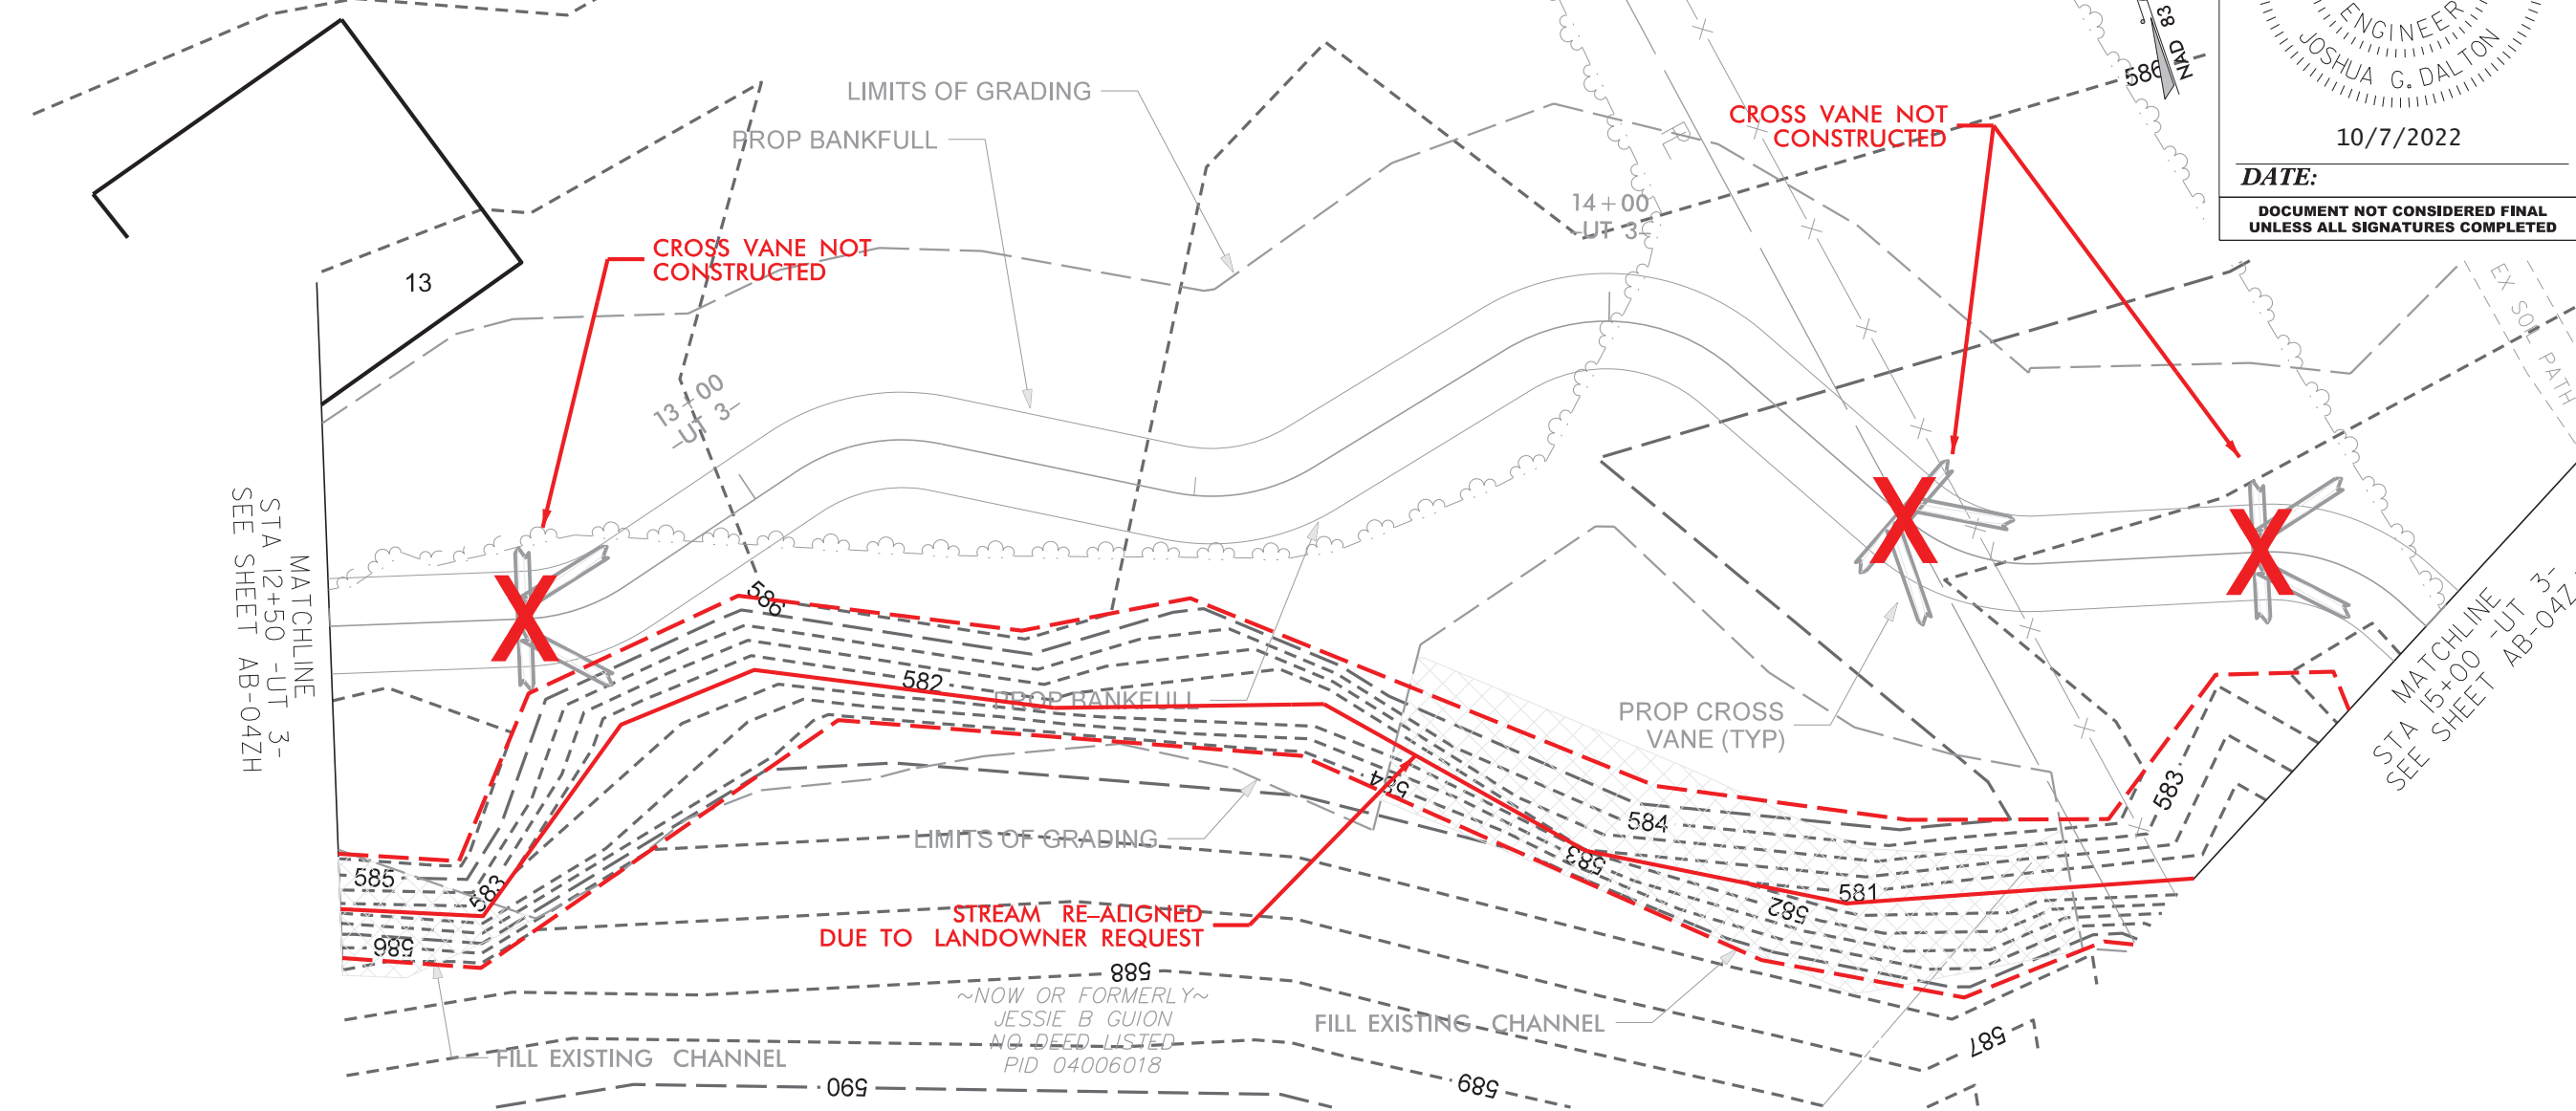

10/6/2022  
 Wits\_End\_Psh\_AB-04ZI.dgn

© 2022 SUNGATE DESIGN GROUP, P.A. THIS DRAWING AND ALL REPRODUCTIONS OF IT ARE THE SOLE PROPERTY OF SDG. REPRODUCTION OR OTHER USES OF THIS DRAWING WITHOUT WRITTEN CONSENT OF SDG IS NOT PERMITTED.



-UT 3- AS-BUILT STRUCTURE LOCATIONS				
STR. TYPE	NORTHING	EASTING	Prop Elevation	AB Survey Elevation
<del>CROSS VANE</del>	<del>426,030.78</del>	<del>1,566,746.30</del>	<del>583.35</del>	
<del>CROSS VANE</del>	<del>426,020.55</del>	<del>1,566,788.18</del>	<del>582.92</del>	
CROSS VANE	426,005.70	15,566,794.08	582.26	
CROSS VANE	425,997.17	1,566,880.05	582.07	581.68
CROSS VANE	425,981.65	1,566,921.25	581.53	581.19

~NOW OR FORMERLY~  
JESSIE B GUION  
NO DEED LISTED  
PID 04000018

**RECORD DRAWING**

SCALE: 1" = 20'

DATE: 10/7/2022



DOCUMENT NOT CONSIDERED FINAL  
UNLESS ALL SIGNATURES COMPLETED

DocuSigned by:  
**Josh Dalton**  
1089AD8C14994C3...

PROFESSIONAL SEAL  
26971  
ENGINEER  
JOSHUA G. DALTON

**SUNGATE DESIGN GROUP, P.A.**  
5808 W. HANCOCK ROAD  
SUITE 200  
CHARLOTTE, NC 27866  
TEL: (919) 856-2243  
ENG. FIRM LICENSE NO. C-890

Axiam Environmental, Inc.

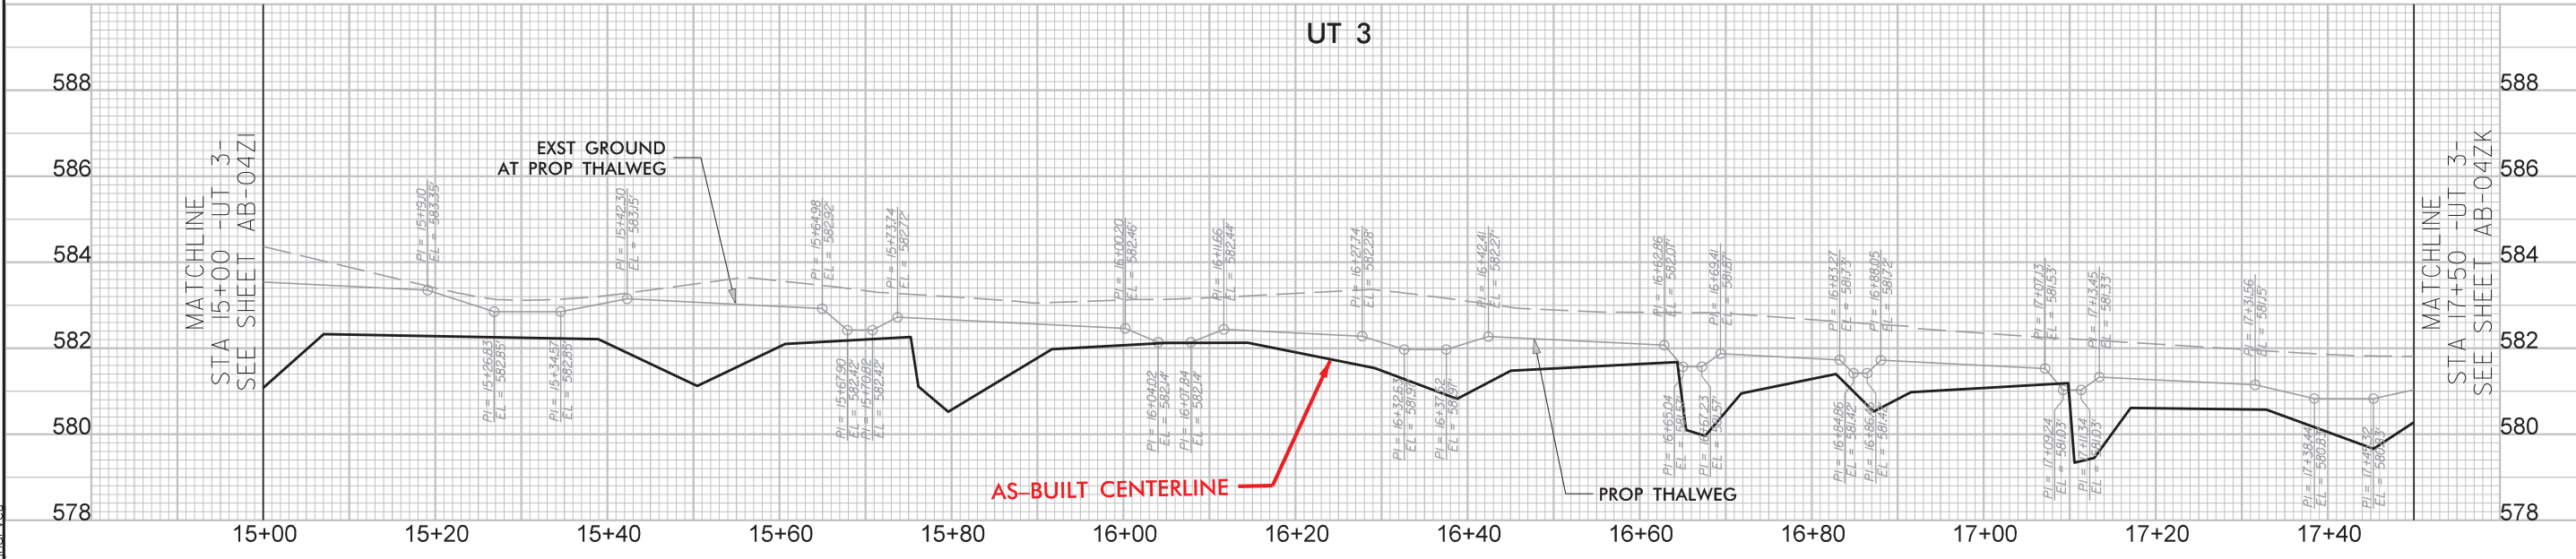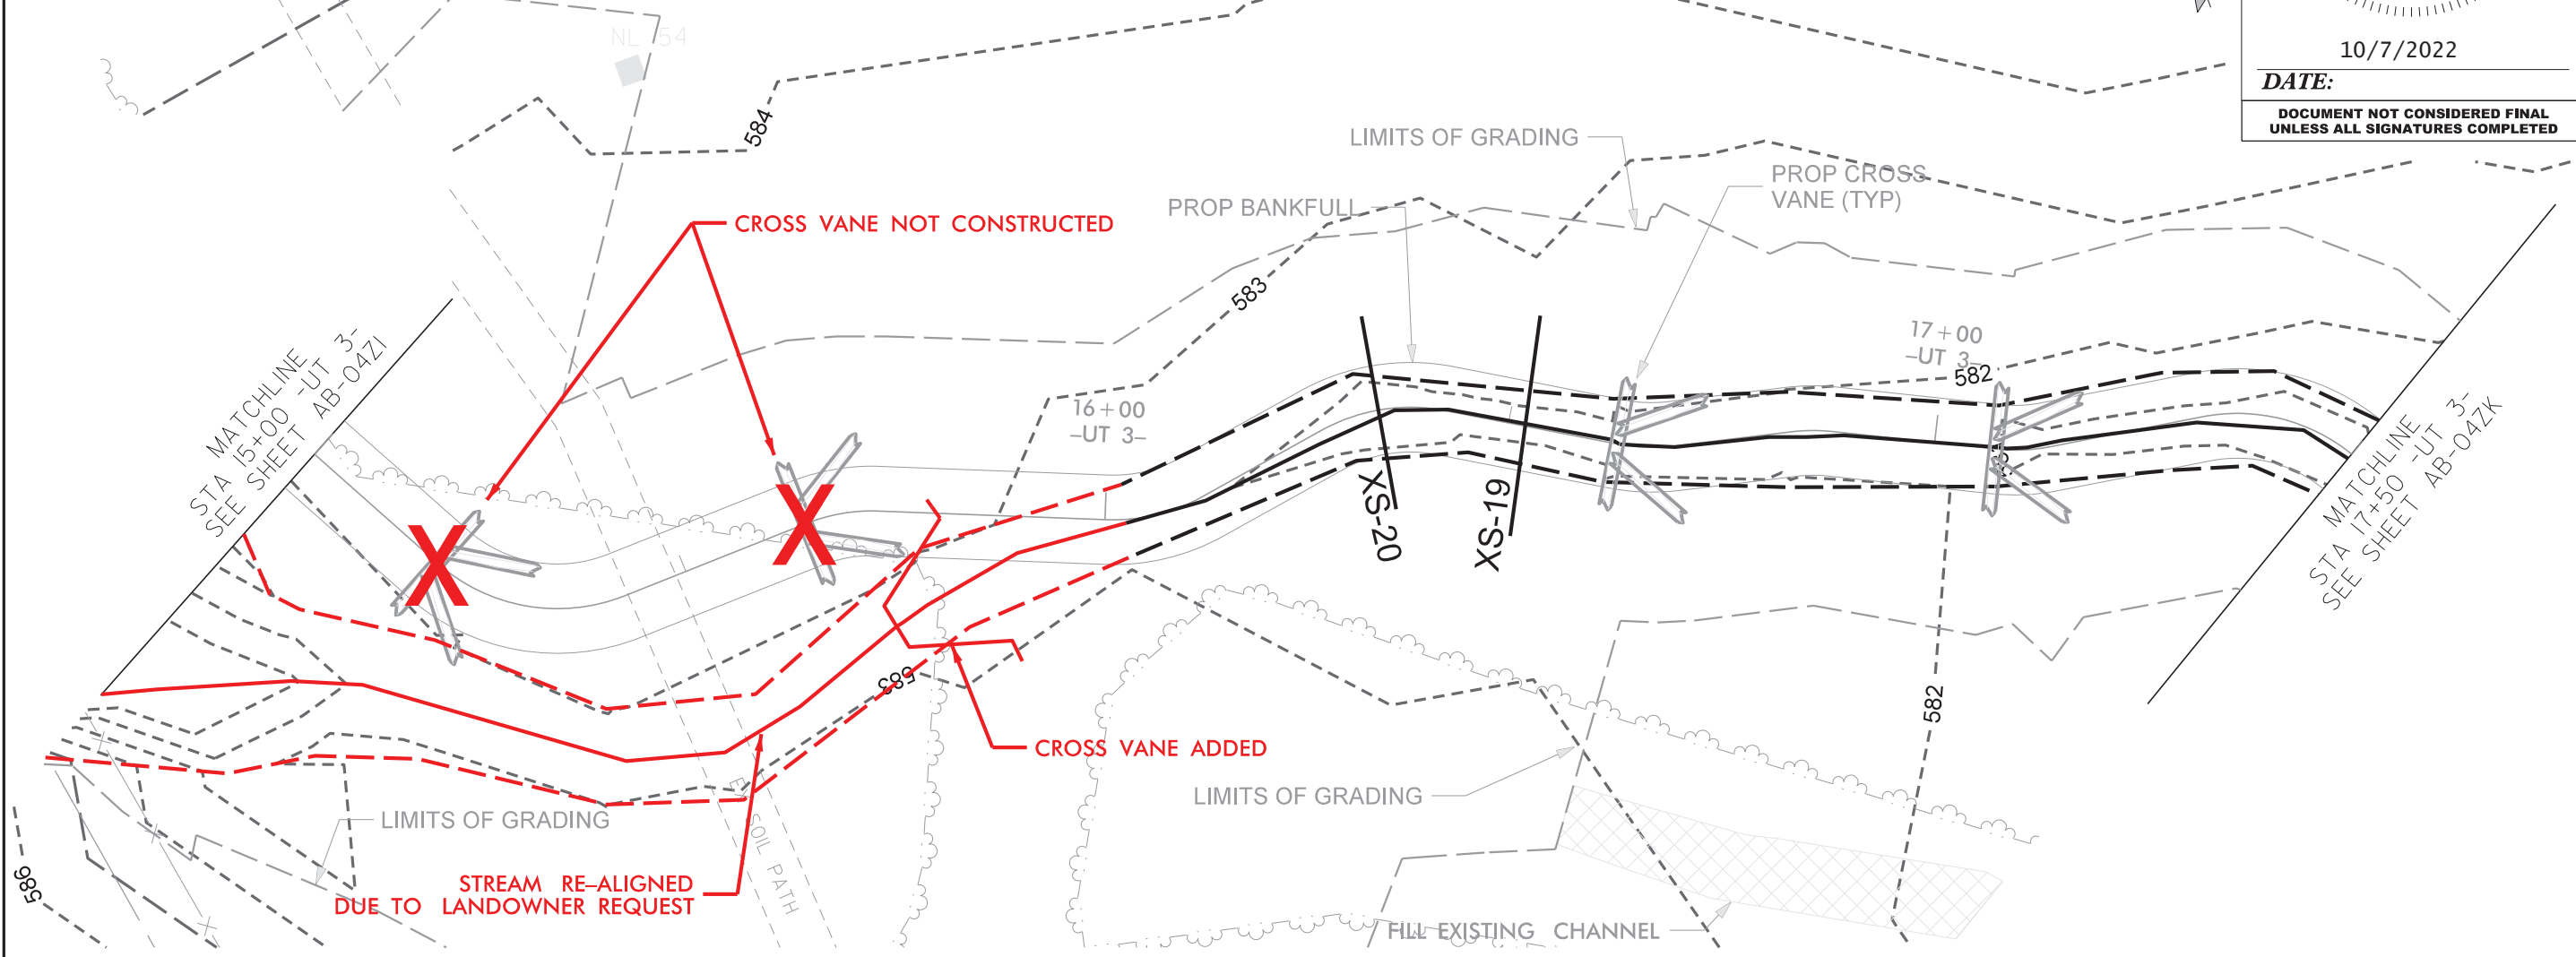

© 2022 SUNGATE DESIGN GROUP, P.A. THIS DRAWING AND ALL REPRODUCTIONS OF IT ARE THE SOLE PROPERTY OF SDG. REPRODUCTION OR OTHER USES OF THIS DRAWING WITHOUT WRITTEN CONSENT OF SDG IS NOT PERMITTED.

**WITS END**  
UNION COUNTY, NC

**AS-BUILT STRUCTURES**


PROJECT #: 1221-20024  
DRAWING NAME: WITS END PSH AB-04ZJ  
DATE: 2022  
DRAWN BY: JRH  
REVIEWED BY: JGD  
REVISIONS:

SHEET NO.  
**AB-04ZJ**


10/6/2022  
Wits\_End\_Psh\_AB-04ZJ.dgn

**-UT 3- AS-BUILT STRUCTURE LOCATIONS**

STR. TYPE	NORTHING	EASTING	Prop Elevation	AB Survey Elevation
CROSS VANE	425,933.04	1,566,997.26	580.77	580.43
CROSS VANE	425,887.75	1,567,074.26	580.15	579.61
CROSS VANE	425,847.30	1,567,149.06	579.54	579.11

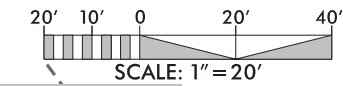


**RECORD DRAWING**

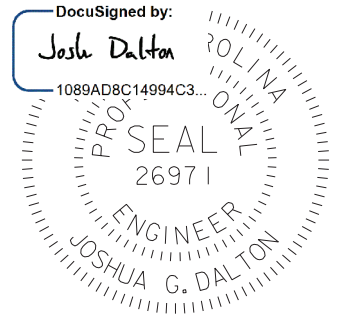



DATE: 10/7/2022

DOCUMENT NOT CONSIDERED FINAL  
UNLESS ALL SIGNATURES COMPLETED

**SUNGATE DESIGN GROUP, P.A.**  
934 GILES FARM ROAD  
SUNGATE, NC 27886  
TEL: (919) 855-2243  
ENG. FIRM LICENSE NO. C-980

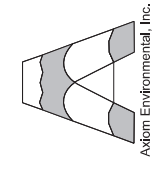

~NOW OR FORMERLY~  
JESSIE B GUION  
NO DEED LISTED  
PID 04006018

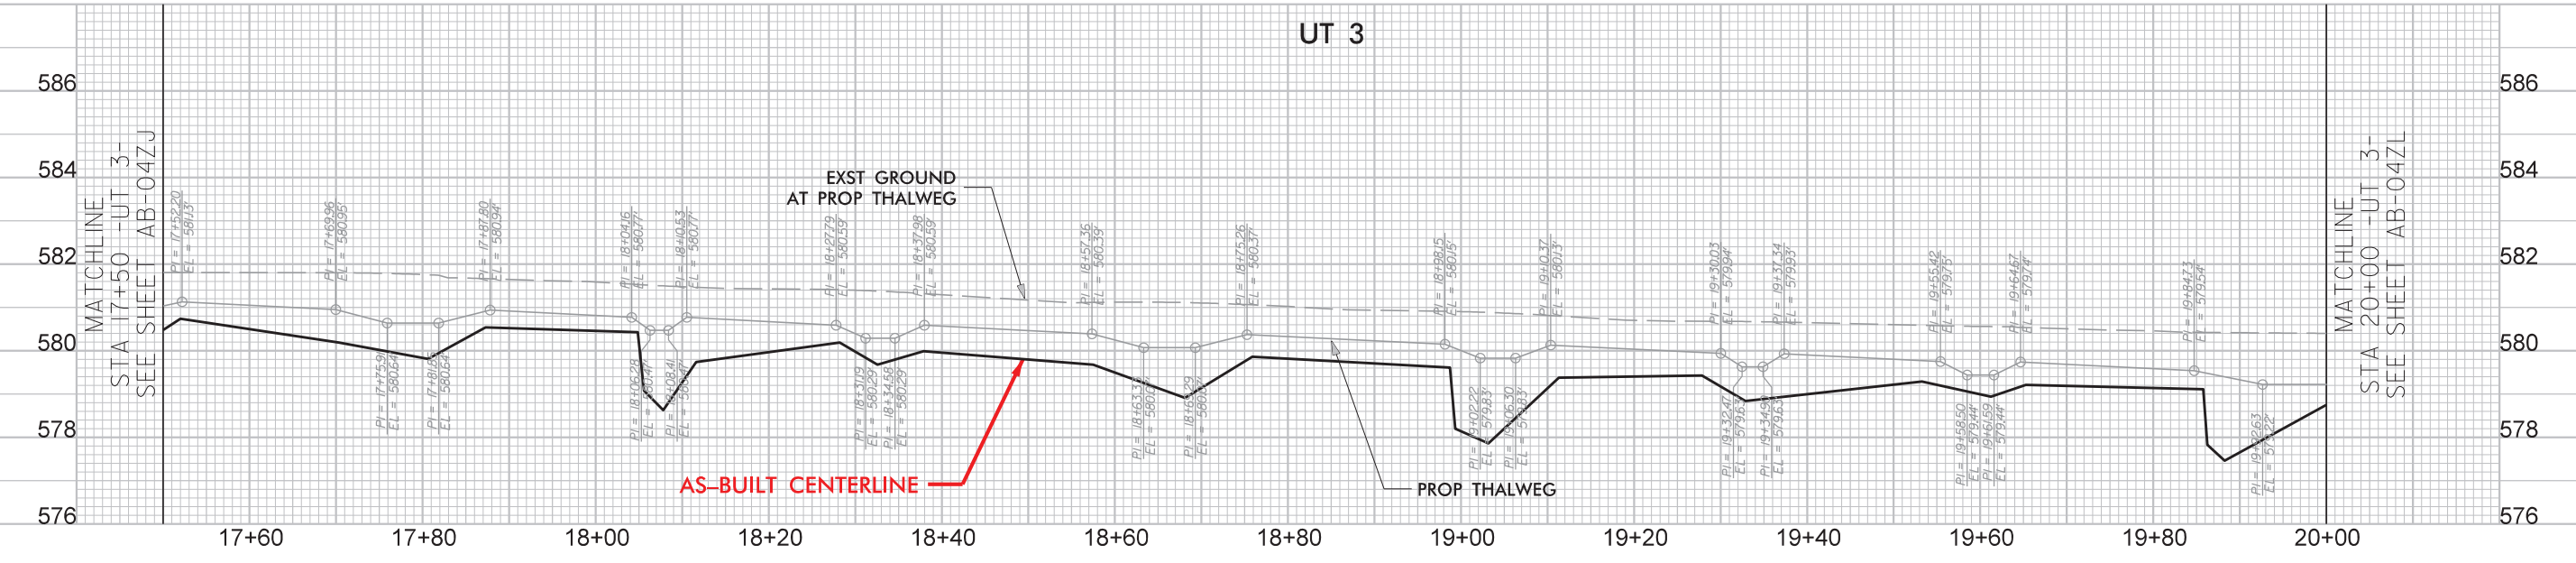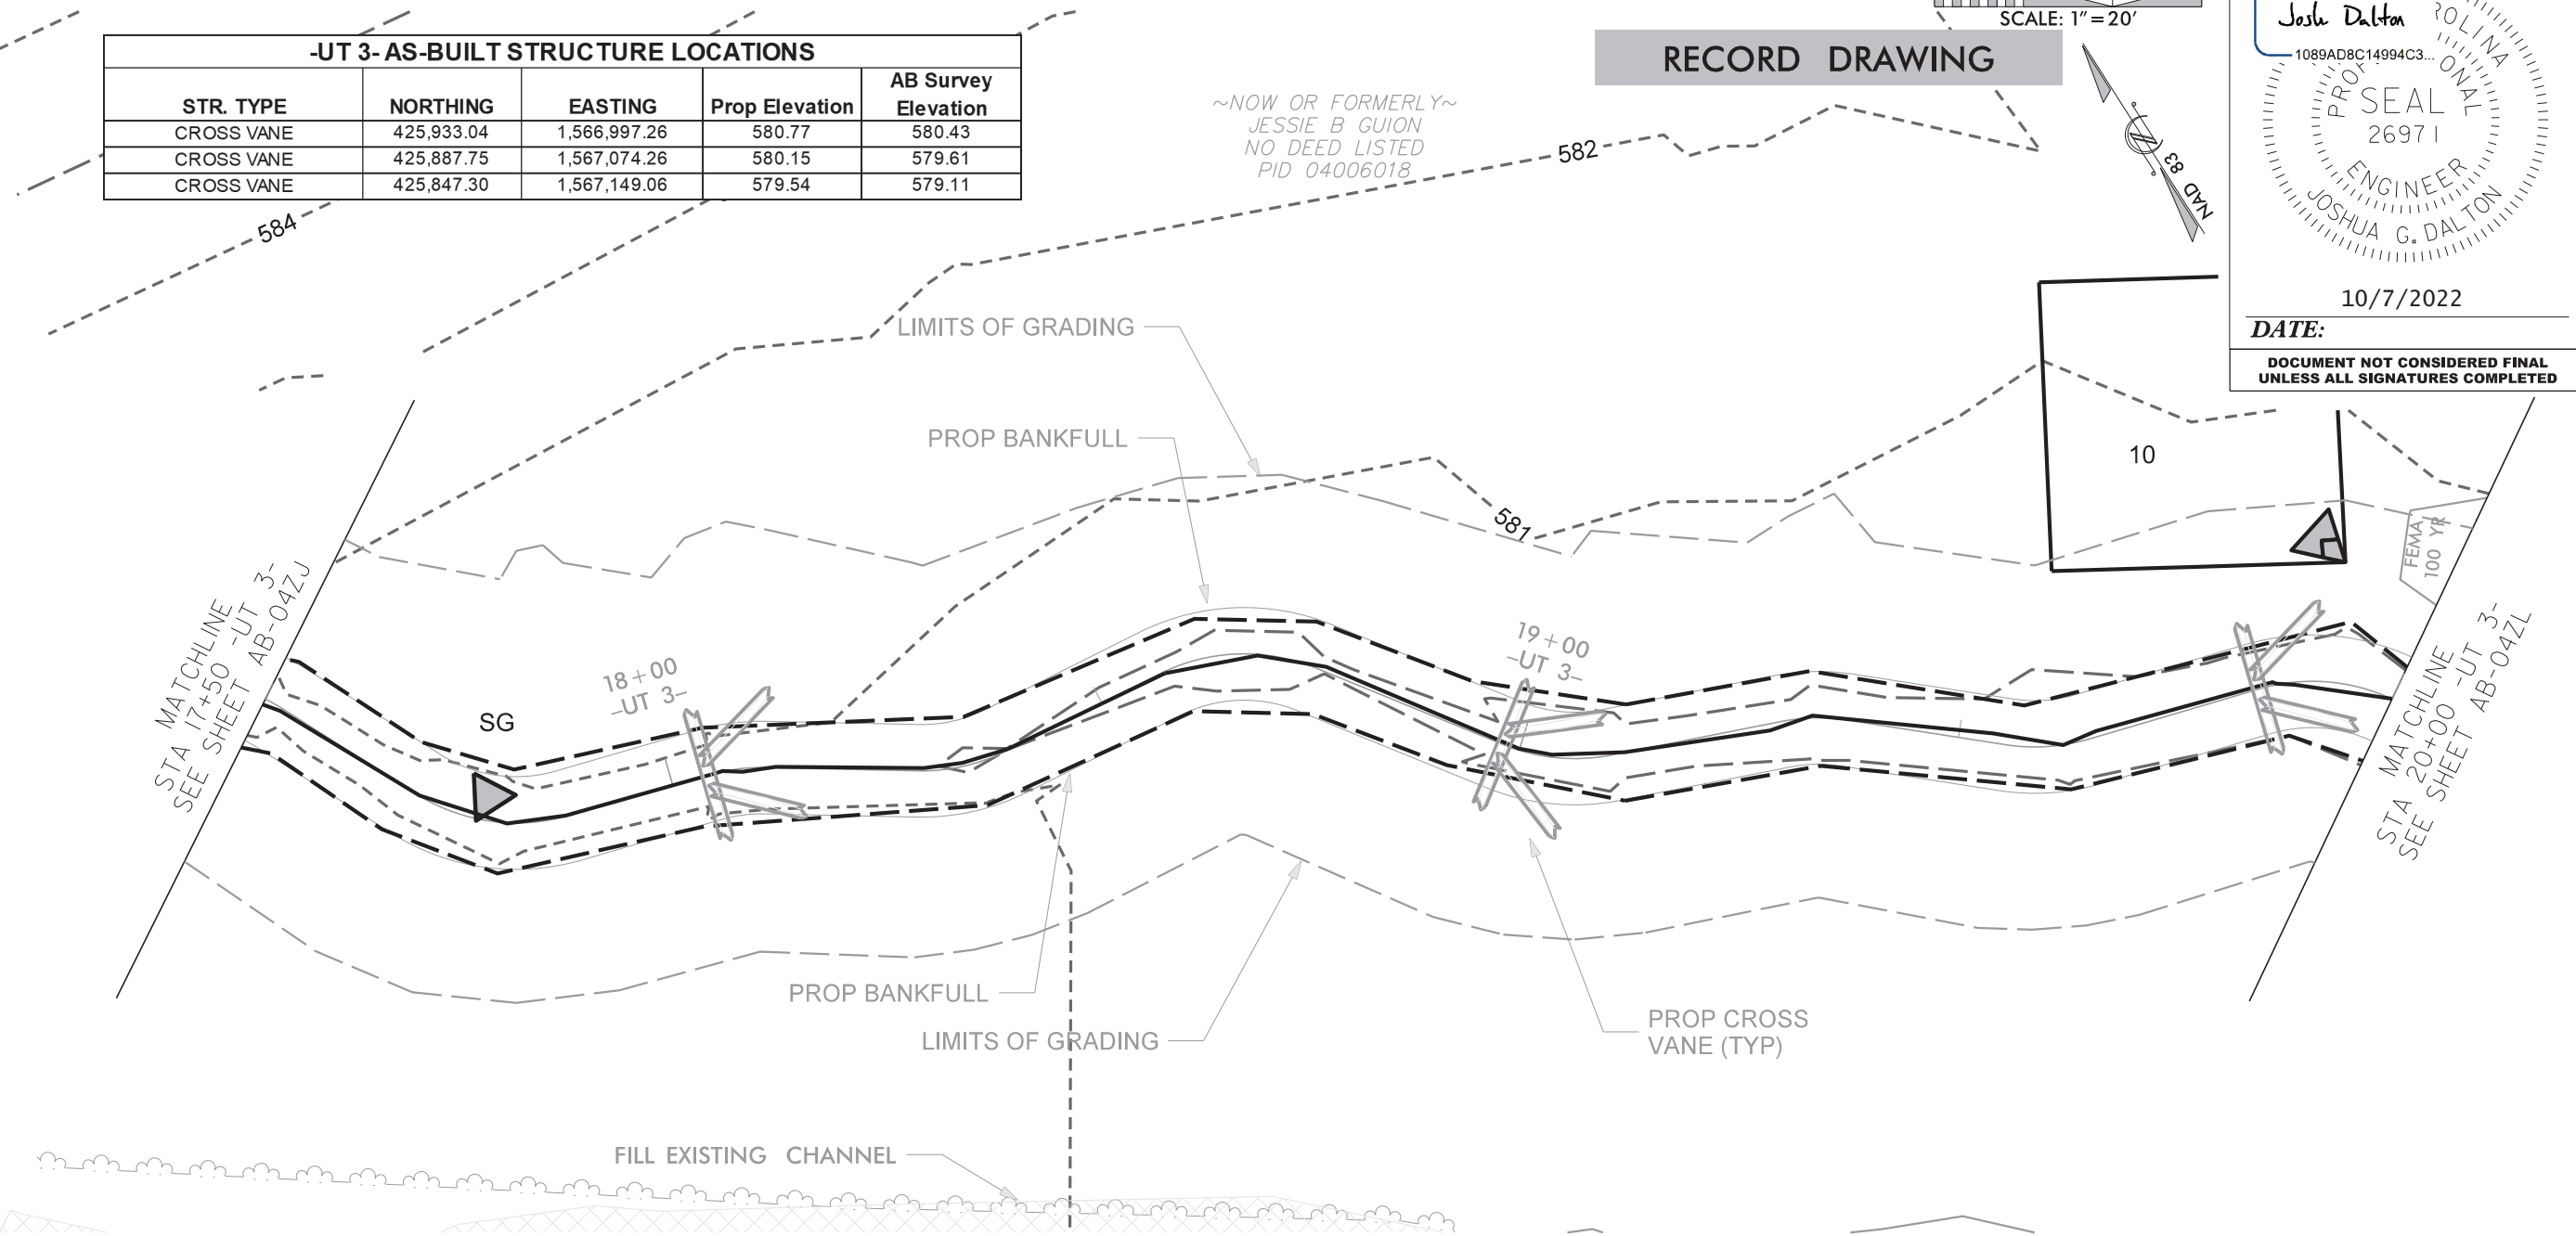

10/6/2022  
Wits\_End\_psh\_AB-04ZK.dgn

© 2022 SUNGATE DESIGN GROUP, P.A. THIS DRAWING AND ALL REPRODUCTIONS OF IT ARE THE SOLE PROPERTY OF SDG. REPRODUCTION OR OTHER USES OF THIS DRAWING WITHOUT WRITTEN CONSENT OF SDG IS NOT PERMITTED.

**WITS END**  
UNION COUNTY, NC  
**AS-BUILT STRUCTURES**

PROJECT #: 1221-20024  
DRAWING NAME: WITS END PSH AB-04ZK  
DATE: 2022  
DRAWN BY: JRH  
REVIEWED BY: JGD  
REVISIONS:

SHEET NO.  
**AB-04ZK**

-UT 3- AS-BUILT STRUCTURE LOCATIONS				
STR. TYPE	NORTHING	EASTING	Prop Elevation	AB Survey Elevation
CROSS VANE	425,718.00	1,567,191.31	578.94	578.79

~NOW OR FORMERLY~  
JESSIE B GUION  
NO DEED LISTED  
PID 04006018

# RECORD DRAWING





DocuSigned by:  
*Josh Dalton*  
1089AD8C14994C3...  
PROFESSIONAL ENGINEER  
JOSHUA G. DALTON  
26971  
10/7/2022

**DATE:**  
DOCUMENT NOT CONSIDERED FINAL  
UNLESS ALL SIGNATURES COMPLETED

**SUNGATE DESIGN GROUP, P.A.**  
934 GILES FARM ROAD  
SUNGATE, NORTH CAROLINA 27866  
TEL: (919) 856-2243  
ENG FIRM LICENSE NO. C-980

**Askom Environmental, Inc.**

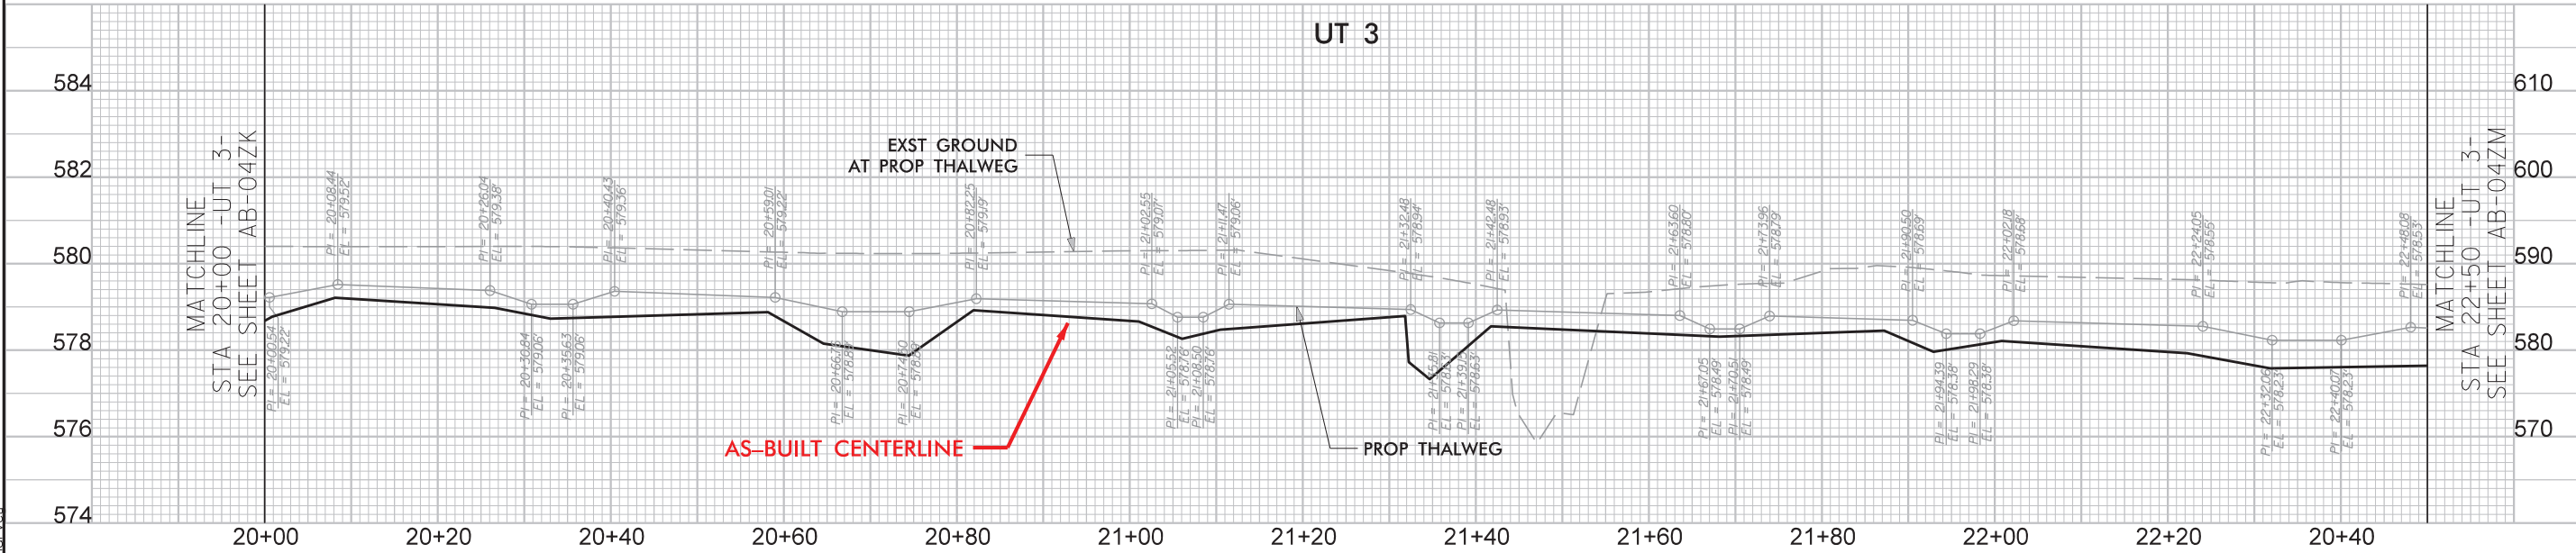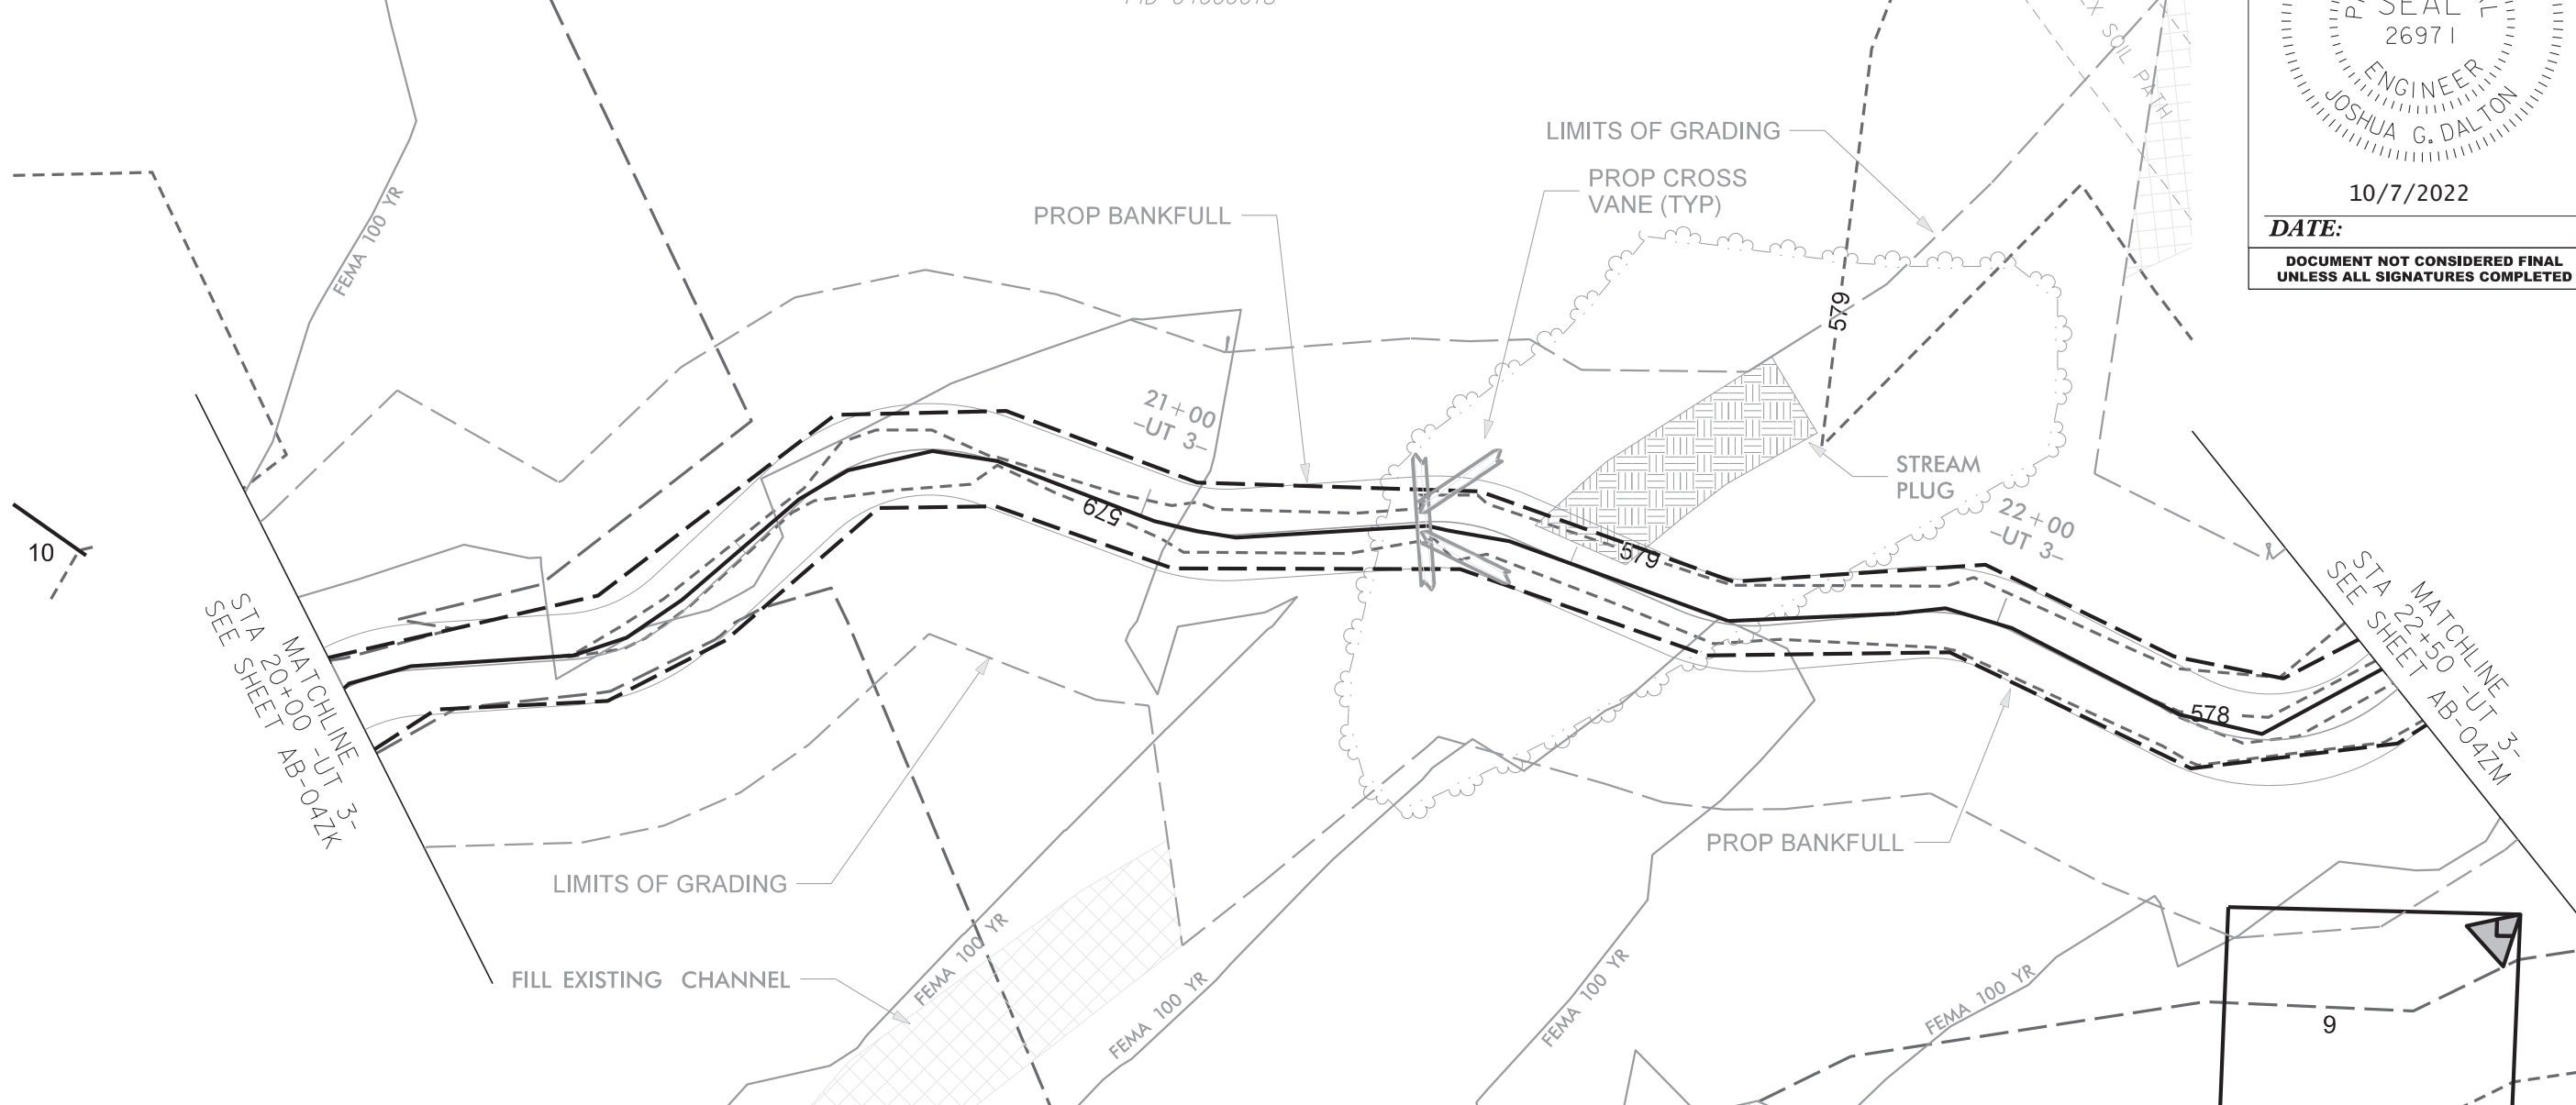

© 2022 SUNGATE DESIGN GROUP, P.A. THIS DRAWING AND ALL REPRODUCTIONS OF IT ARE THE SOLE PROPERTY OF SDG. REPRODUCTION OR OTHER USES OF THIS DRAWING WITHOUT WRITTEN CONSENT OF SDG IS NOT PERMITTED.

**WITS END**  
UNION COUNTY, NC

**AS-BUILT STRUCTURES**



PROJECT # : 1221-20024  
DRAWING NAME: WITS END PSH AB-04ZL  
DATE: 2022  
DRAWN BY: JRH  
REVIEWED BY: JGD  
REVISIONS:

SHEET NO.  
**AB-04ZL**

10/6/2022  
Wits\_End\_Psh\_AB-04ZL.dgn




-UT 3- AS-BUILT STRUCTURE LOCATIONS				
STR. TYPE	NORTHING	EASTING	Prop Elevation	AB Survey Elevation
CROSS VANE	425,553.32	1,567,236.03	578.10	577.98

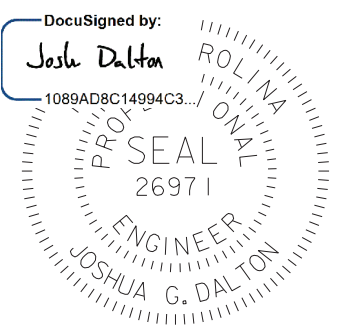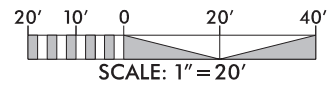



DATE: 10/7/2022

DOCUMENT NOT CONSIDERED FINAL UNLESS ALL SIGNATURES COMPLETED

**SUNGATE DESIGN GROUP, P.A.**  
 5800 W. WINDY HILL ROAD  
 SUITE 2000 CHARLOTTE, NC 27866  
 TEL: (919) 855-2243  
 ENG. FIRM LICENSE NO. C-980

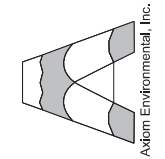

**RECORD DRAWING**

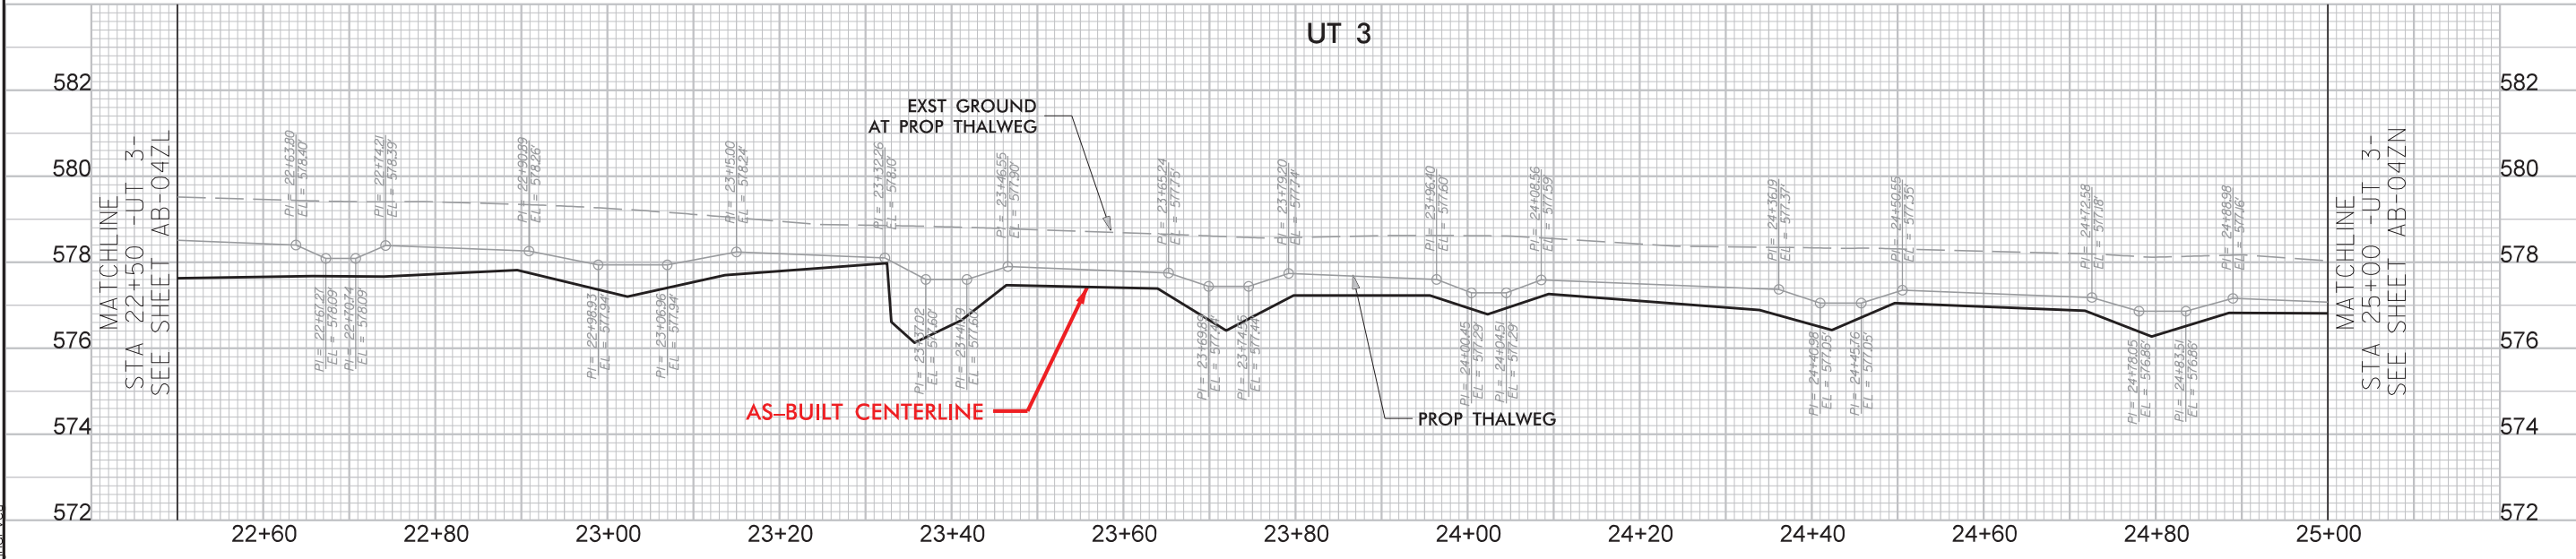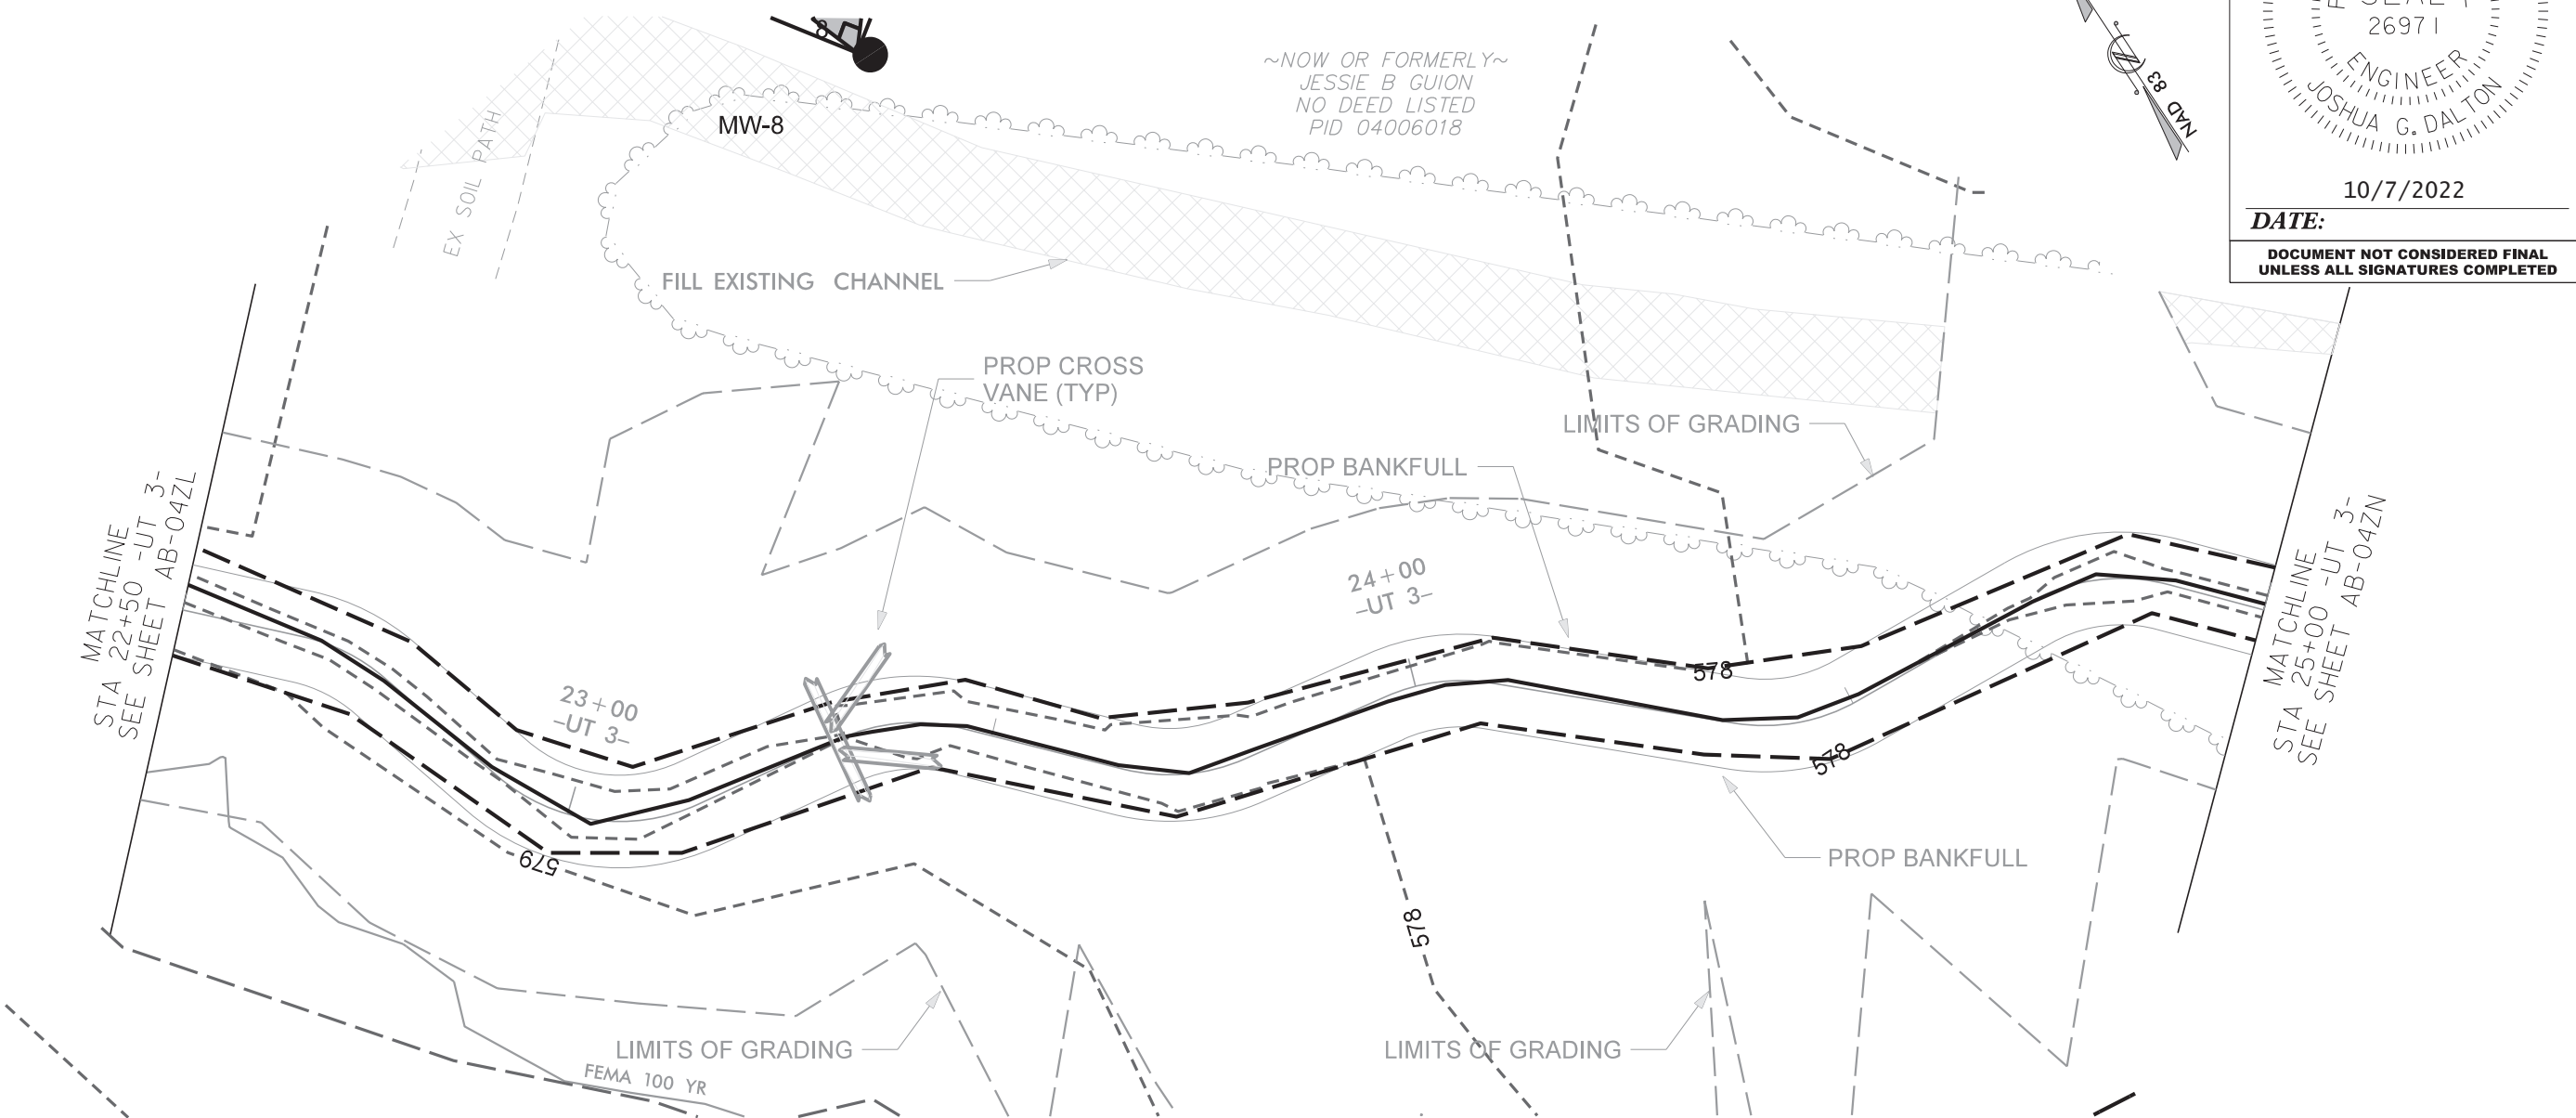

10/6/2022  
 Wits\_End\_psh\_AB-04ZM.dgn



© 2022 SUNGATE DESIGN GROUP, P.A. THIS DRAWING AND ALL REPRODUCTIONS OF IT ARE THE SOLE PROPERTY OF SDG. REPRODUCTION OR OTHER USES OF THIS DRAWING WITHOUT WRITTEN CONSENT OF SDG IS NOT PERMITTED.

**WITS END**  
 UNION COUNTY, NC  
**AS-BUILT STRUCTURES**

PROJECT #: 1221-20024  
 DRAWING NAME: WITS END PSH AB-04ZM  
 DATE: 2023  
 DRAWN BY: JRH  
 REVIEWED BY: JGD  
 REVISIONS:

SHEET NO.  
**AB-04ZM**


-UT 3- AS-BUILT STRUCTURE LOCATIONS				
STR. TYPE	NORTHING	EASTING	Prop Elevation	AB Survey Elevation
CROSS VANE	425,451.95	1,567,428.59	576.64	576.39
CROSS VANE	425,433.38	1,567,457.40	576.19	576.01

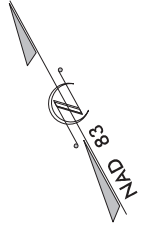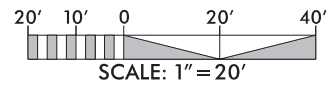

DocuSigned by:  
**Josh Dalton**  
 1089AD8C14994C3...  
 PROFESSIONAL ENGINEER  
 JOSHUA G. DALTON  
 26971  
 10/7/2022


**DATE:**  
 DOCUMENT NOT CONSIDERED FINAL  
 UNLESS ALL SIGNATURES COMPLETED

**RECORD DRAWING**

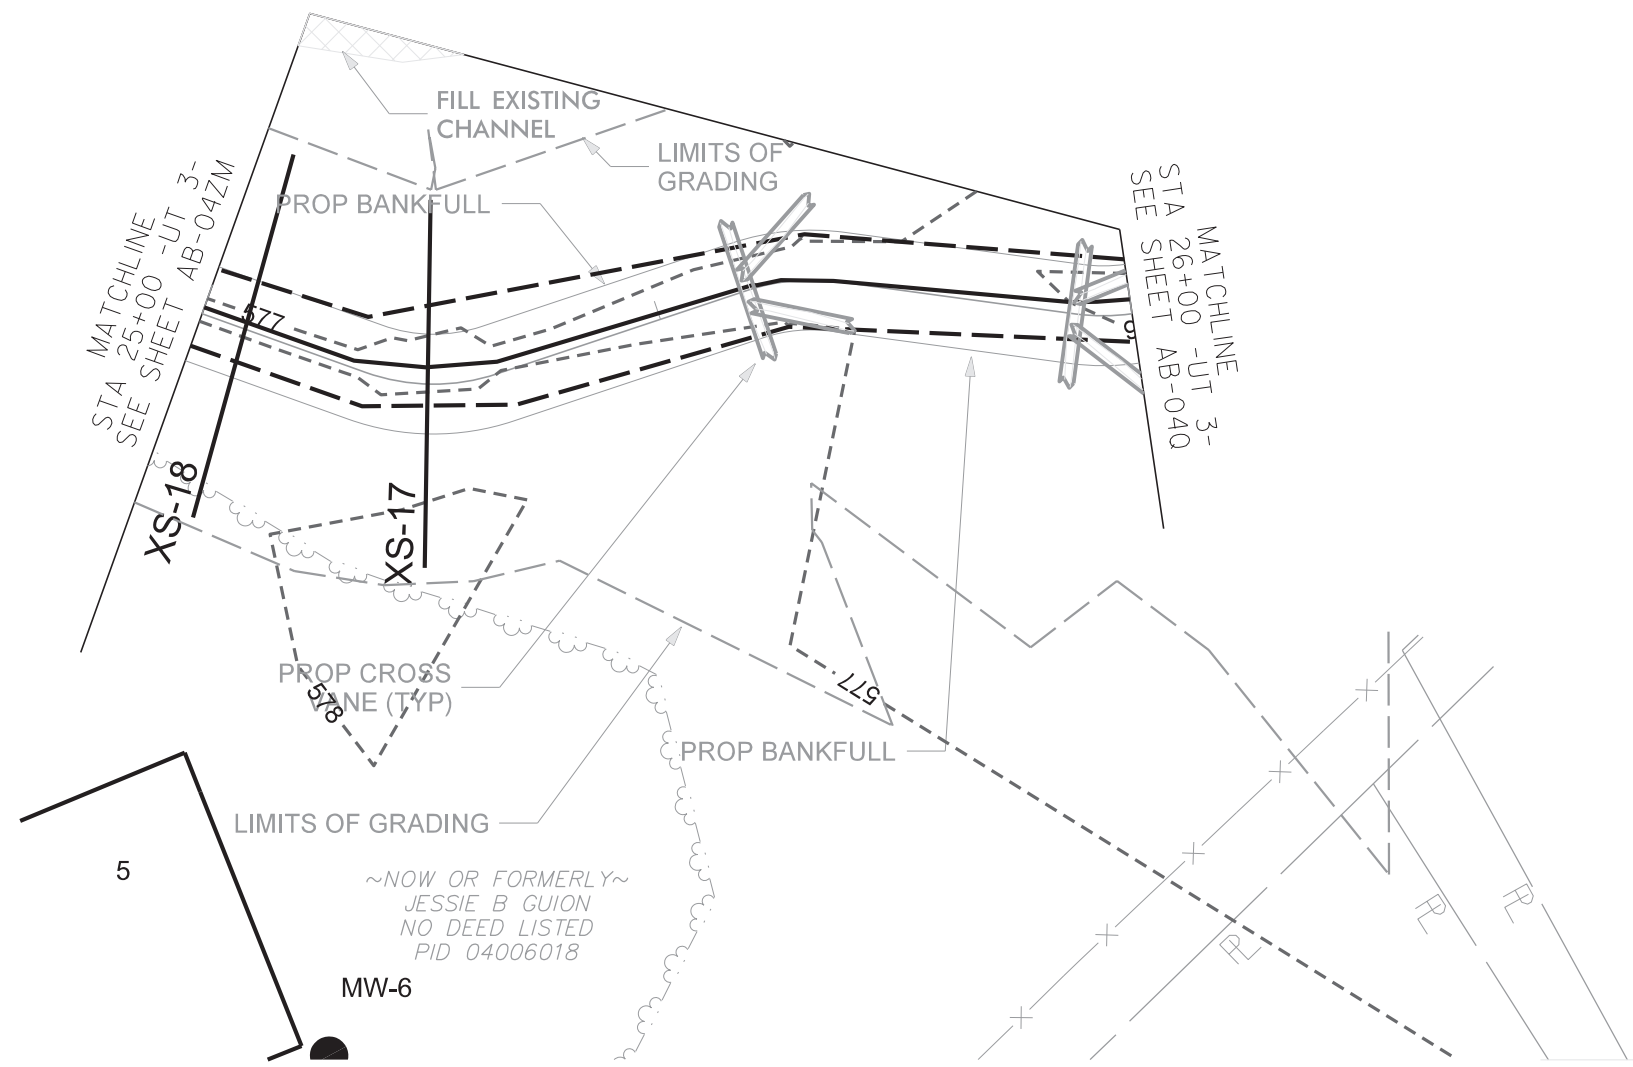


~NOW OR FORMERLY~  
 JESSIE B GUION  
 NO DEED LISTED  
 PID 04006018

~NOW OR FORMERLY~  
 GINA BROOKS MORRIS  
 DB 5896/171  
 TRACT 3, PC J/45  
 PID 03168003C  
 11.216 AC.  
 (NET GAPS AND OVERLAPS)

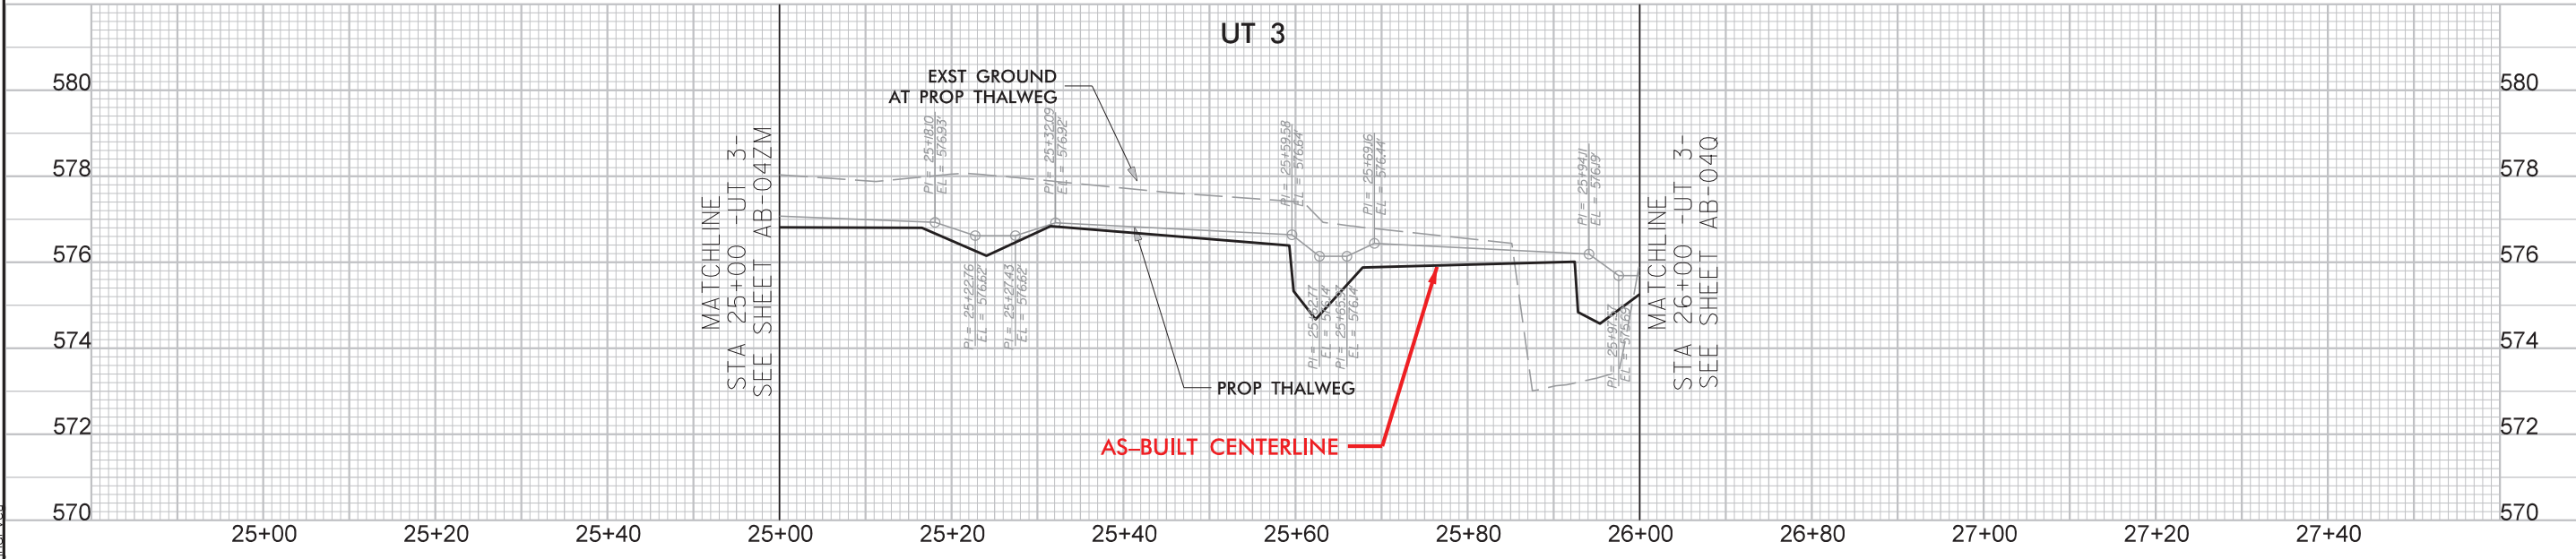

**SUNGATE DESIGN GROUP, P.A.**  
 834 GILES FARM ROAD  
 SUITE 100  
 CHARLOTTE, NC 27866  
 TEL: (919) 855-2243  
 ENG FIRM LICENSE NO. C-890

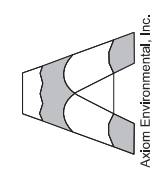

WITS END  
 UNION COUNTY, NC

AS-BUILT STRUCTURES


PROJECT # :  
 1221-20024  
 DRAWING NAME:  
 WITS END PSH AB-04ZN  
 DATE:  
 2022  
 DRAWN BY:  
 JRH  
 REVIEWED BY:  
 JGD  
 REVISIONS:

SHEET NO.  
**AB-04ZN**

10/6/2022  
 Wits\_End\_Psh\_AB-04ZN.dgn

© 2022 SUNGATE DESIGN GROUP, P.A. THIS DRAWING AND ALL REPRODUCTIONS OF IT ARE THE SOLE PROPERTY OF SDG. REPRODUCTION OR OTHER USES OF THIS DRAWING WITHOUT WRITTEN CONSENT OF SDG IS NOT PERMITTED.

# RECORD DRAWING

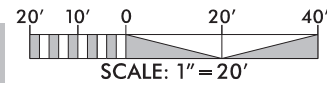


DocuSigned by:  
**Josh Dalton**  
 1089AD8C14994C3...  
 PROFESSIONAL SEAL  
 26971  
 ENGINEER  
 JOSHUA G. DALTON

DATE: 10/7/2022

**DOCUMENT NOT CONSIDERED FINAL UNLESS ALL SIGNATURES COMPLETED**


**SUNGATE DESIGN GROUP, P.A.**  
 950 GOLF COURSE ROAD  
 SUITE 200  
 WILMINGTON, NC 27866  
 TEL: (919) 855-2243  
 FAX: (919) 855-2244  
 ENG. FIRM LICENSE NO. C-980

~NOW OR FORMERLY~  
 RANDY H GUION  
 NO DEED LISTED  
 PID 04006019

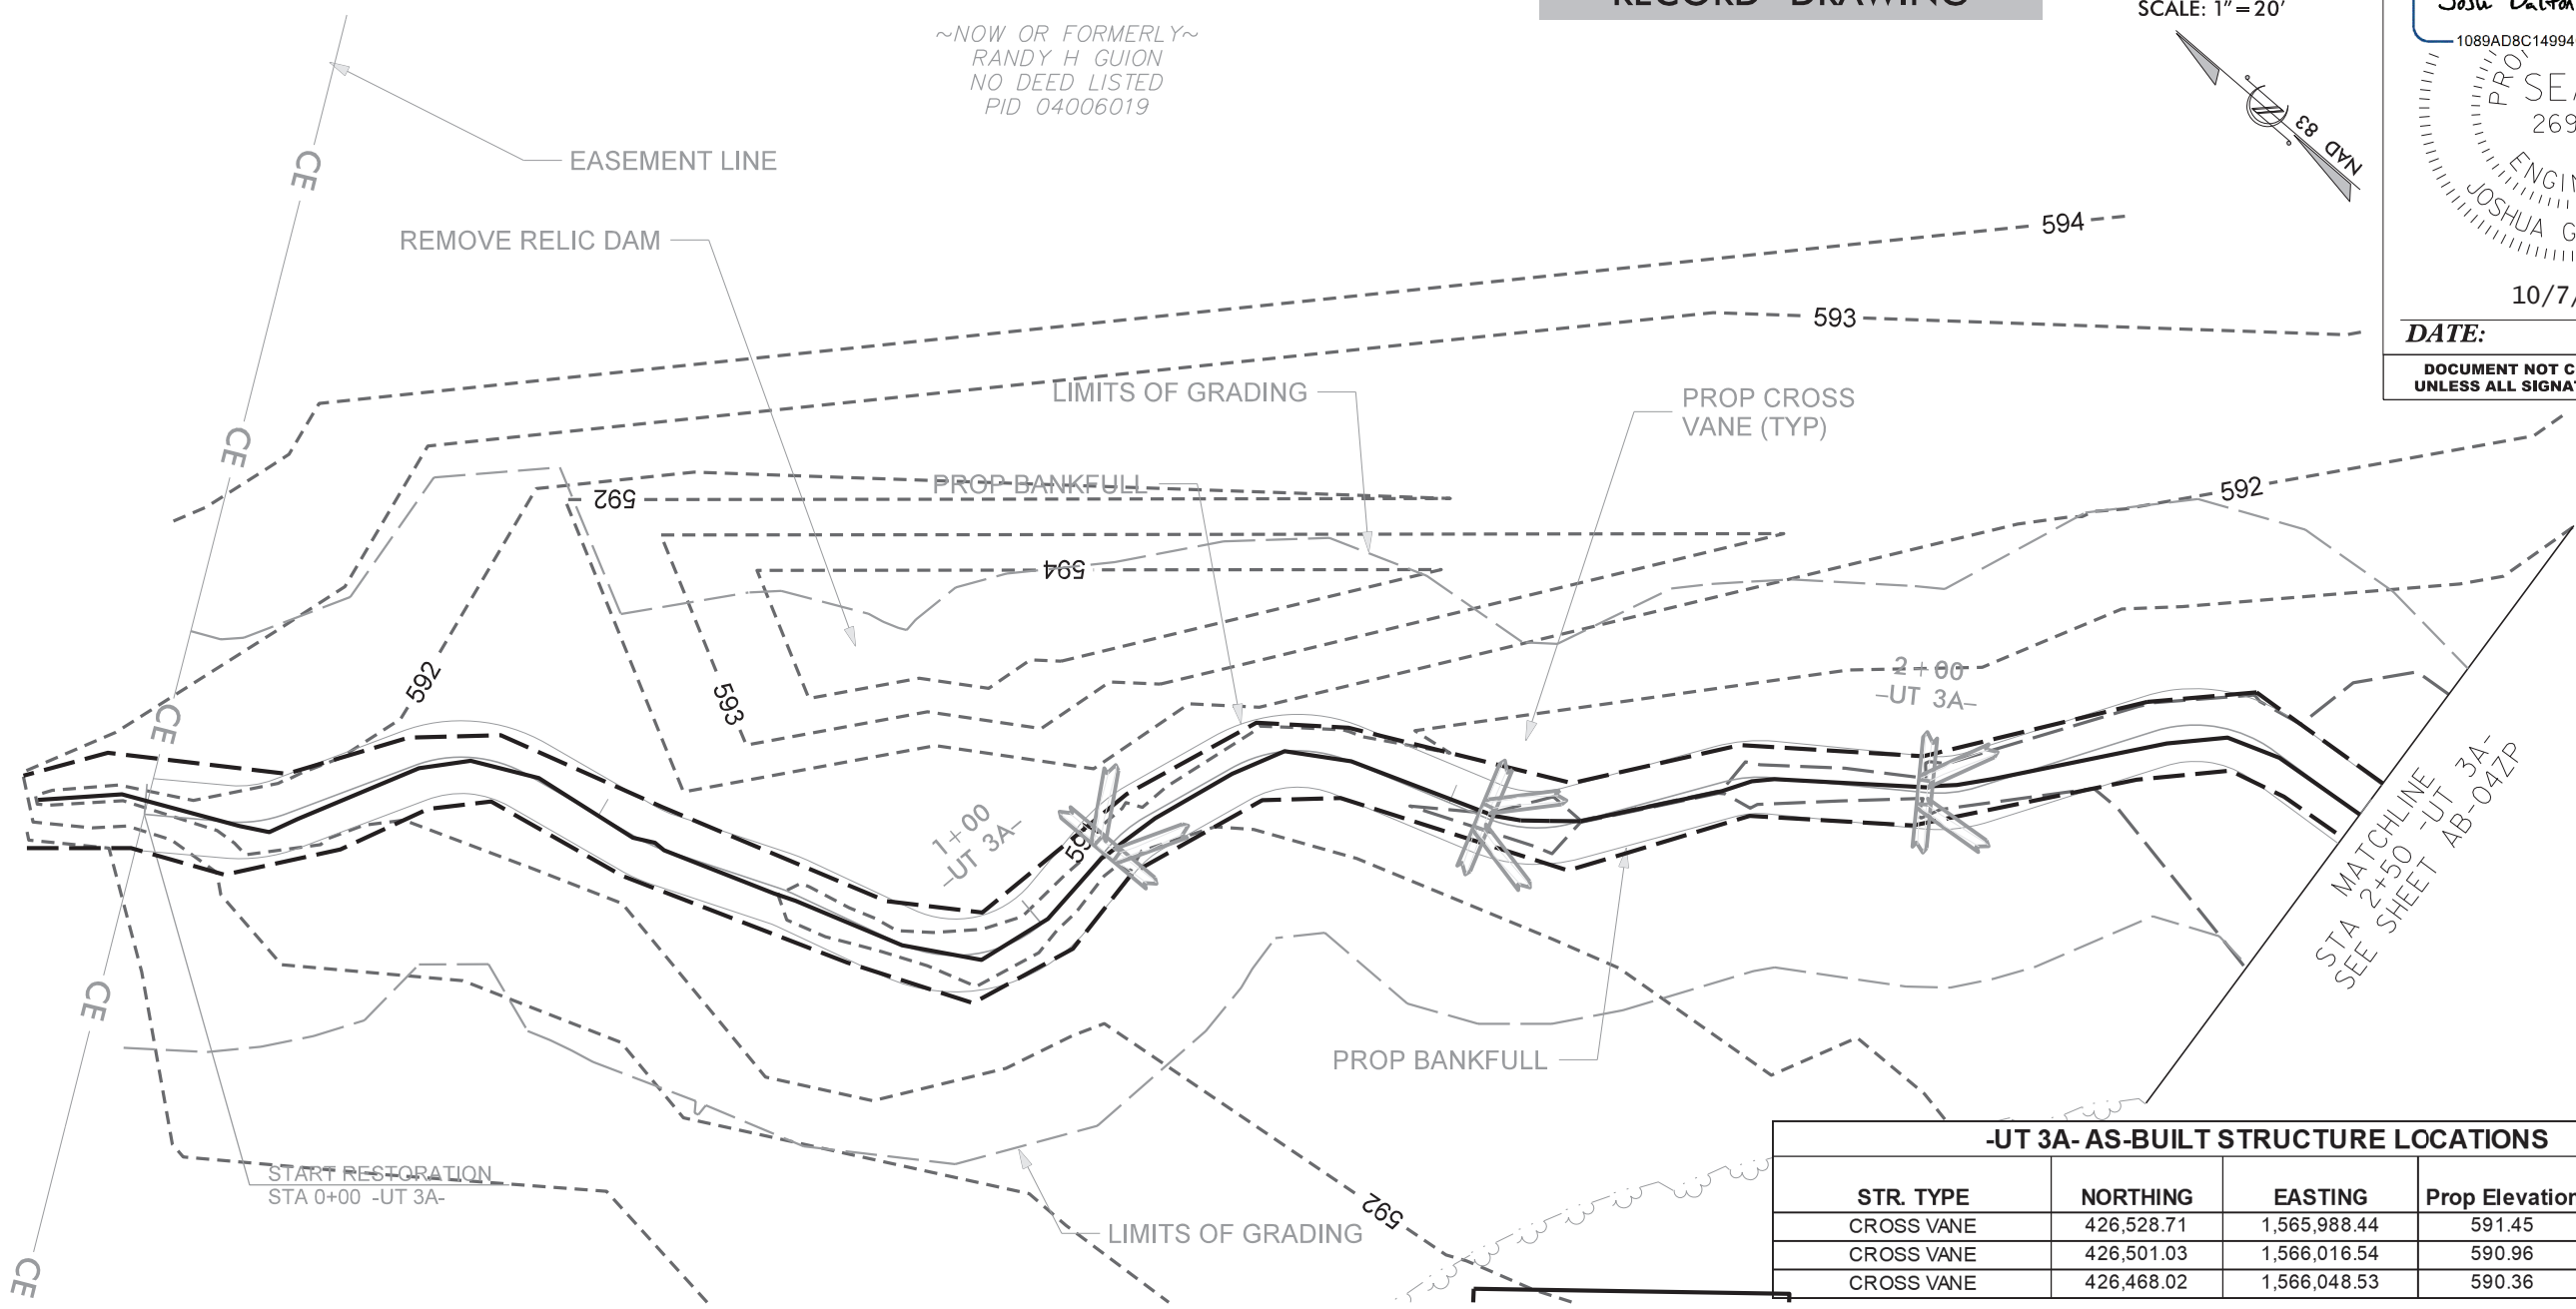

**-UT 3A- AS-BUILT STRUCTURE LOCATIONS**

STR. TYPE	NORTHING	EASTING	Prop Elevation	AB Survey Elevation
CROSS VANE	426,528.71	1,565,988.44	591.45	590.79
CROSS VANE	426,501.03	1,566,016.54	590.96	590.15
CROSS VANE	426,468.02	1,566,048.53	590.36	589.83

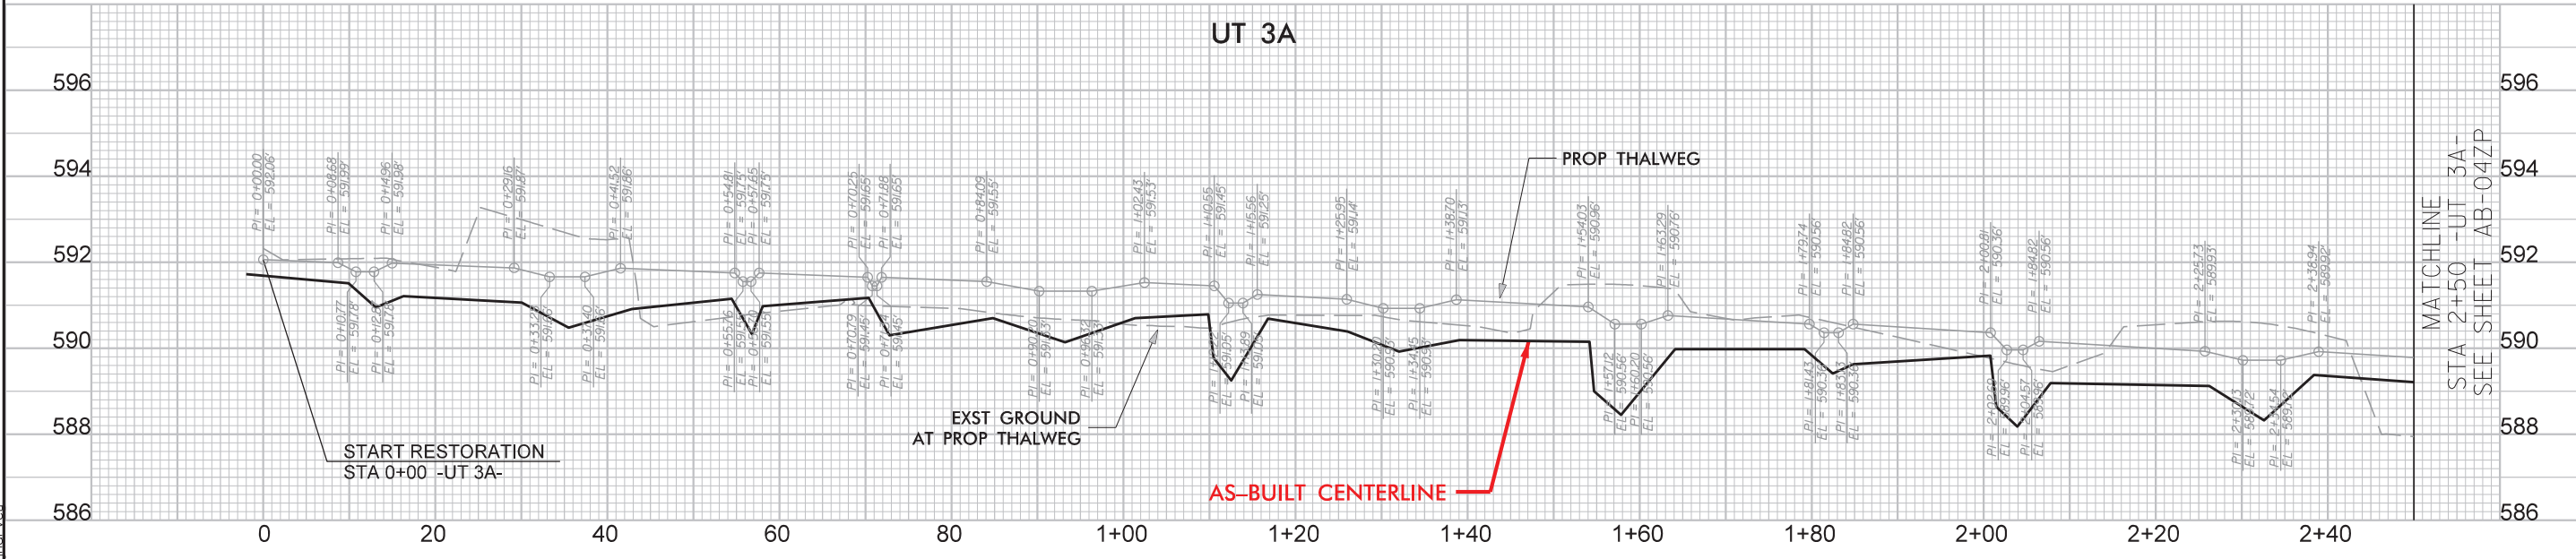

WITS END  
 UNION COUNTY, NC

ASKAM Environmental, Inc.



PROJECT # : 1221-20024  
 DRAWING NAME: WITS END PSH AB-04ZO  
 DATE: 2022  
 DRAWN BY: JRH  
 REVIEWED BY: JGD  
 REVISIONS:

SHEET NO.  
**AB-04ZO**

10/6/2022  
 Wits\_End\_Psh\_AB-04ZO.dgn

© 2022 SUNGATE DESIGN GROUP, P.A. THIS DRAWING AND ALL REPRODUCTIONS OF IT ARE THE SOLE PROPERTY OF SDG. REPRODUCTION OR OTHER USES OF THIS DRAWING WITHOUT WRITTEN CONSENT OF SDG IS NOT PERMITTED.




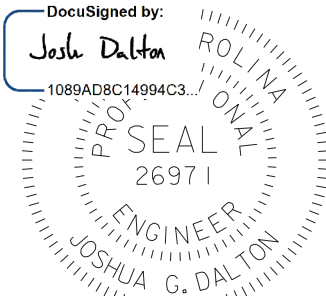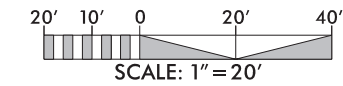

DATE: 10/7/2022


DOCUMENT NOT CONSIDERED FINAL  
UNLESS ALL SIGNATURES COMPLETED

**SUNGATE DESIGN GROUP, P.A.**  
934 GILES FARM ROAD  
RAVENHILL, NC 27868  
TEL: (919) 855-2243  
ENG. FIRM LICENSE NO. C-980

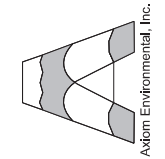


**RECORD DRAWING**

FILL EXISTING CHANNEL

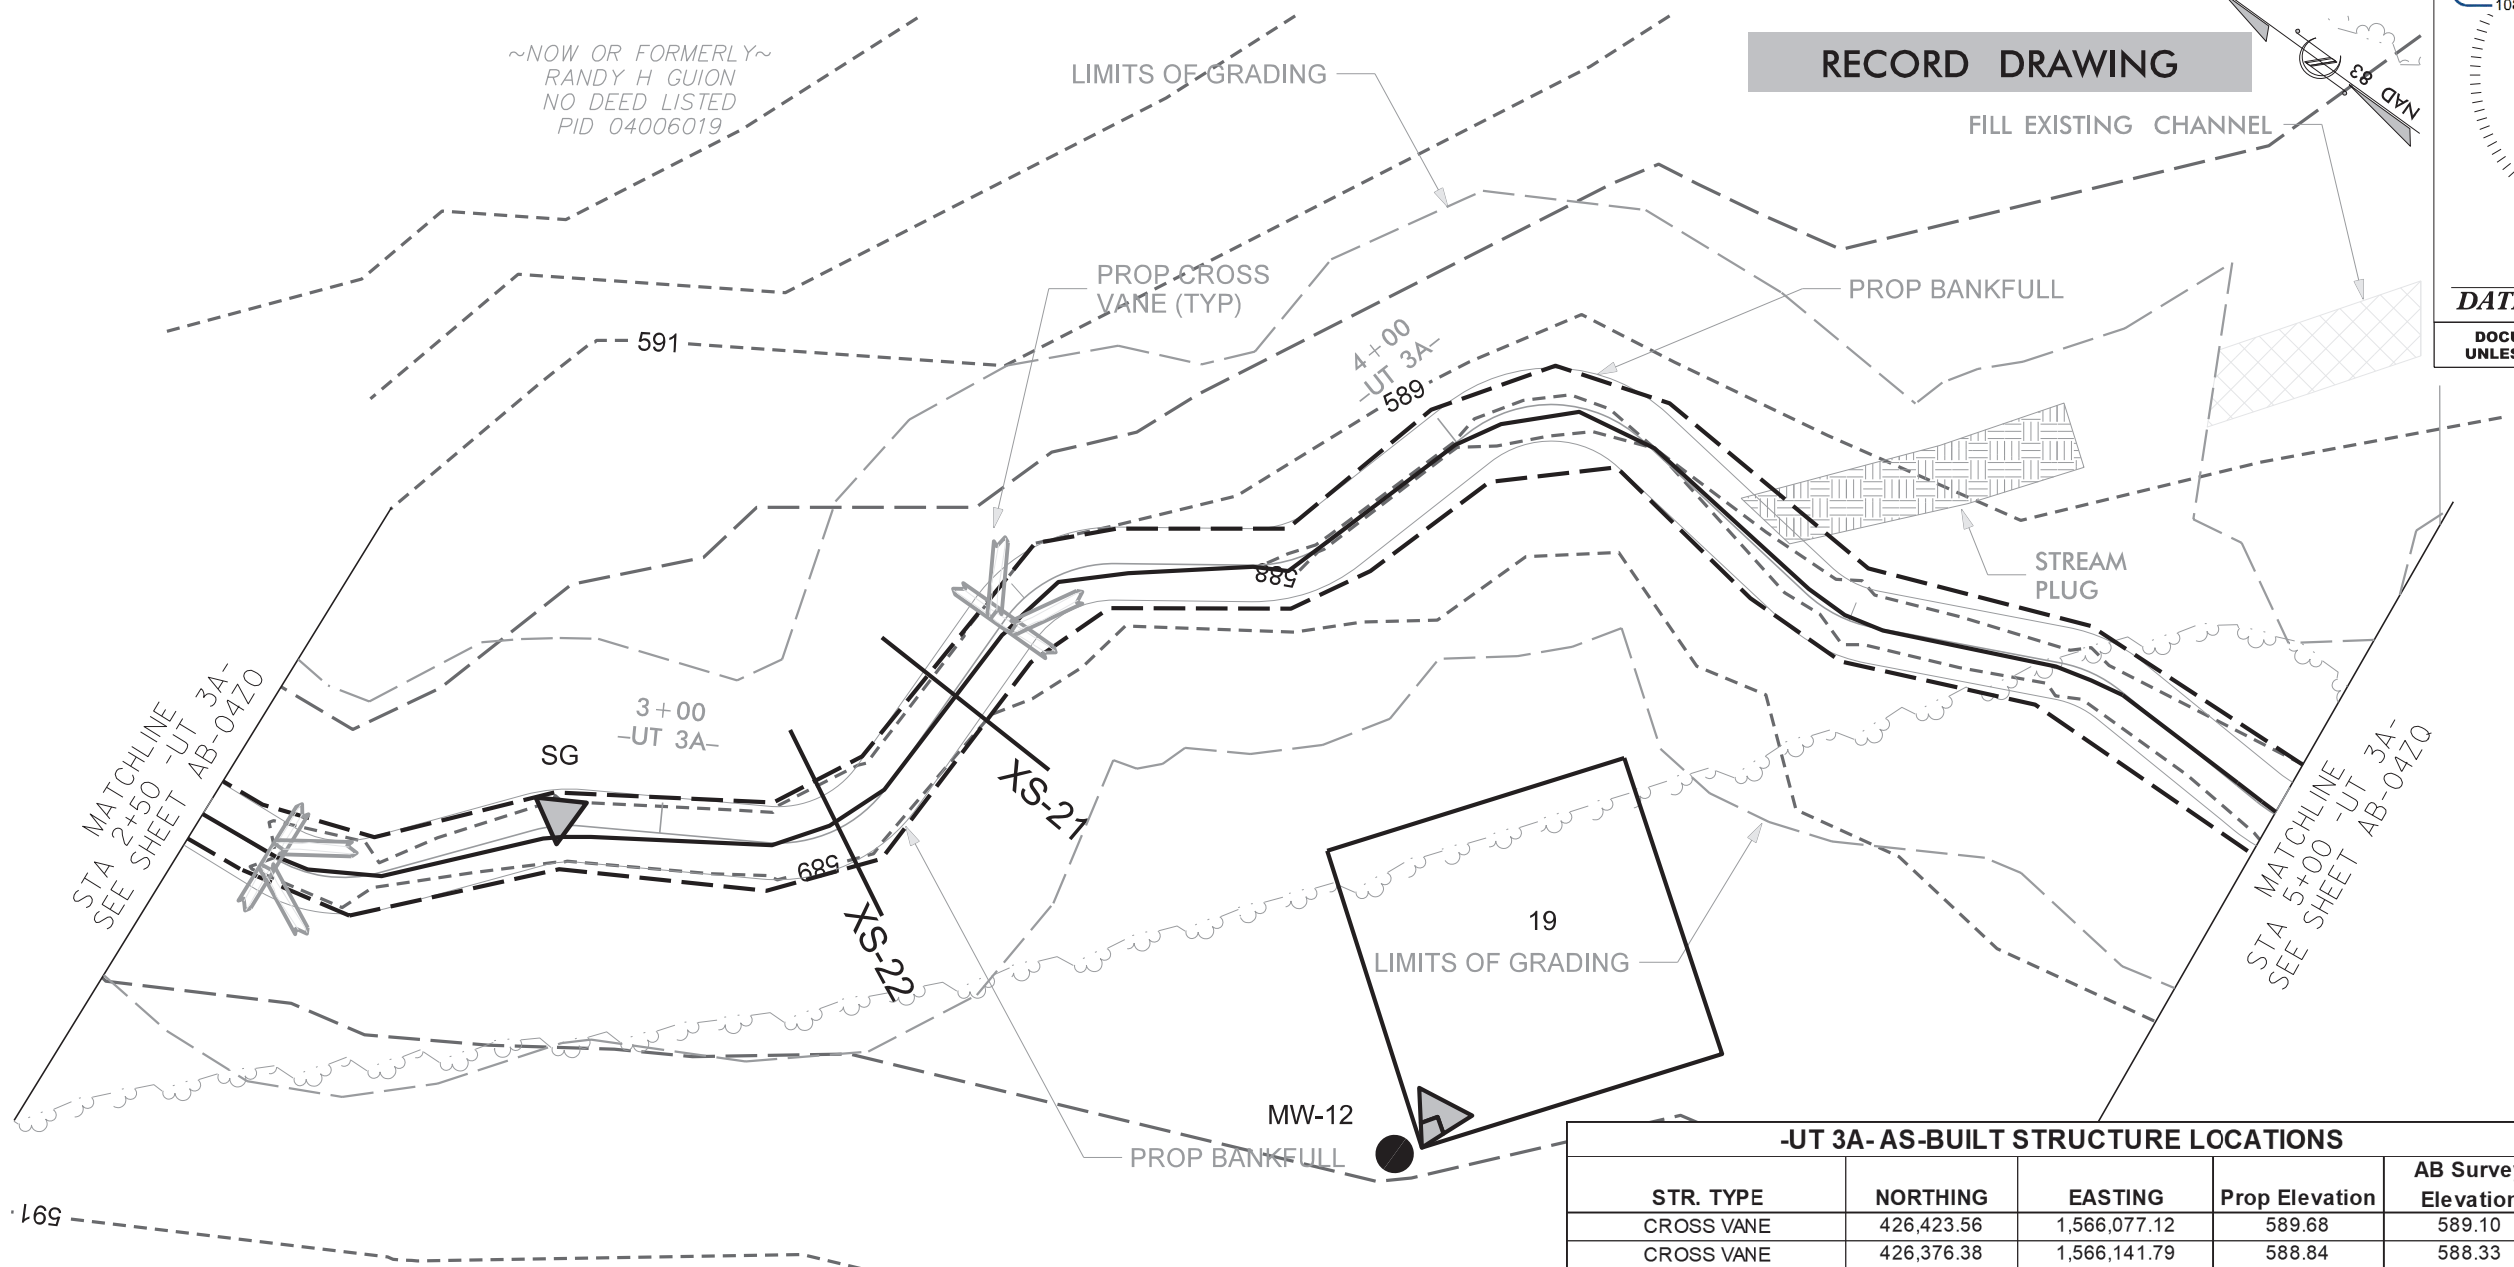

**-UT 3A- AS-BUILT STRUCTURE LOCATIONS**

STR. TYPE	NORTHING	EASTING	Prop Elevation	AB Survey Elevation
CROSS VANE	426,423.56	1,566,077.12	589.68	589.10
CROSS VANE	426,376.38	1,566,141.79	588.84	588.33

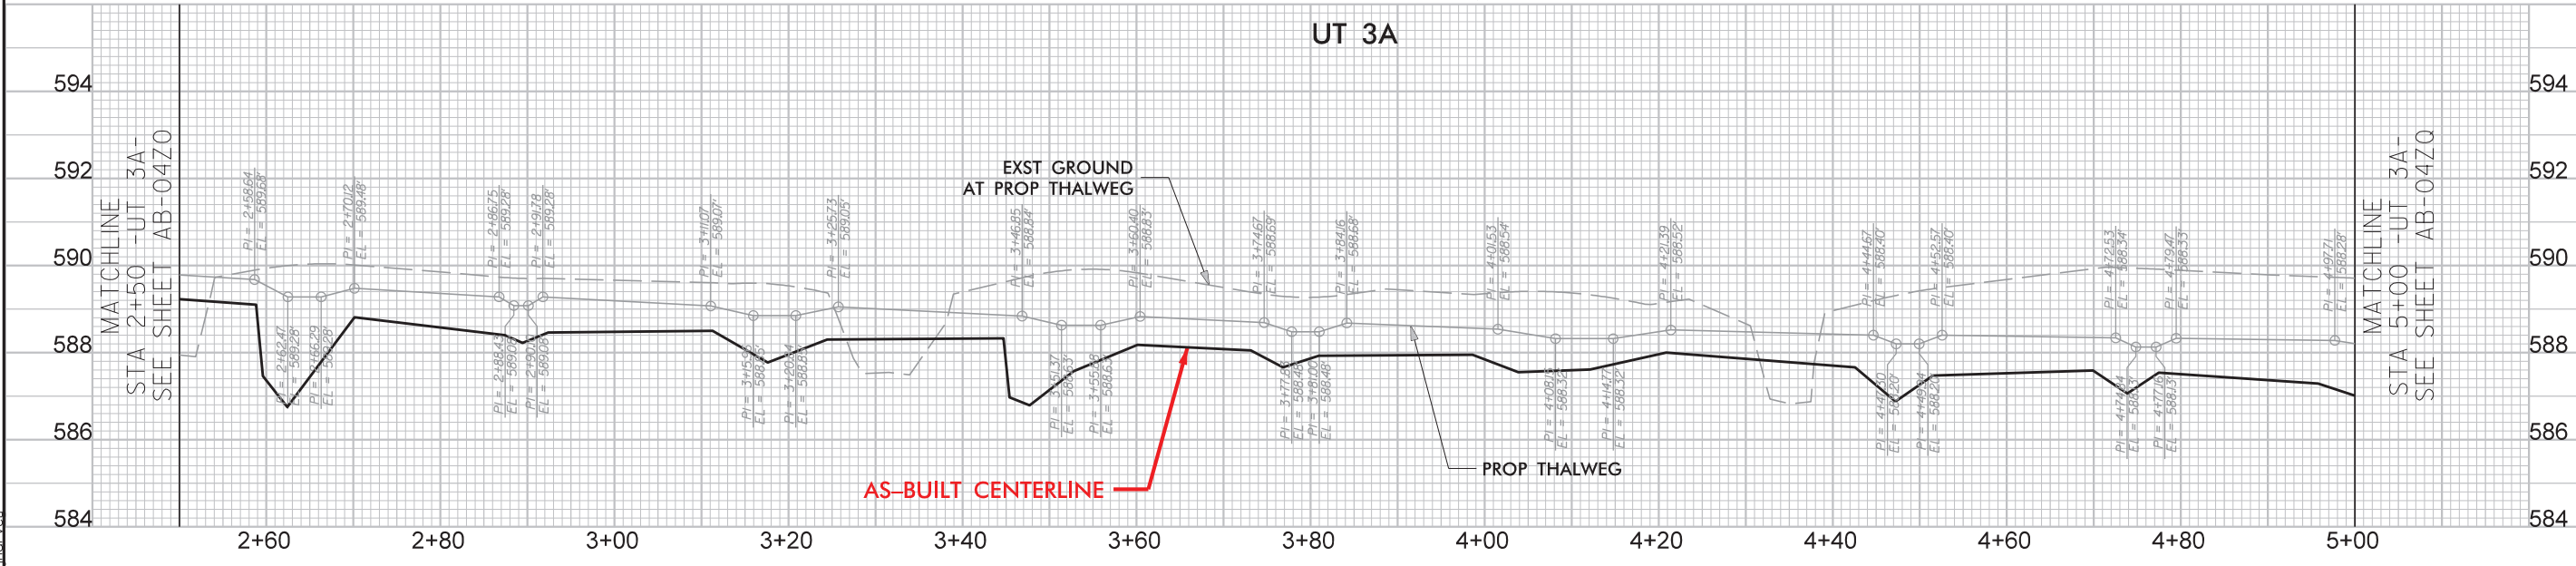


© 2022 SUNGATE DESIGN GROUP, P.A. THIS DRAWING AND ALL REPRODUCTIONS OF IT ARE THE SOLE PROPERTY OF SDG. REPRODUCTION OR OTHER USES OF THIS DRAWING WITHOUT WRITTEN CONSENT OF SDG IS NOT PERMITTED.

**WITS END**  
UNION COUNTY, NC  
**AS-BUILT STRUCTURES**


PROJECT # : 1221-20024  
DRAWING NAME: WITS END PSH AB-04ZP  
DATE: 2022  
DRAWN BY: JRH  
REVIEWED BY: JGD  
REVISIONS:

SHEET NO.  
**AB-04ZP**

-UT 3A- AS-BUILT STRUCTURE LOCATIONS				
STR. TYPE	NORTHING	EASTING	Prop Elevation	AB Survey Elevation
CROSS VANE	426,224.68	1,566,278.15	587.98	
CROSS VANE	426,208.24	1,566,329.44	587.38	
CROSS VANE	426,184.00	1,566,396.66	586.57	

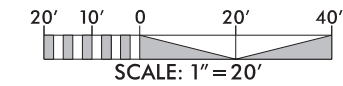




**RECORD DRAWING**

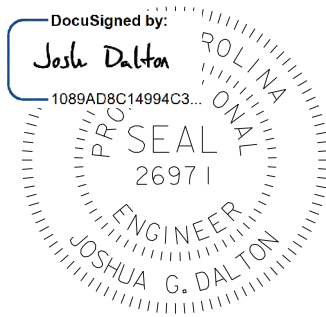

DocuSigned by:  
 Josh Dalton  
 1089AD8C14994C3...  
 DATE: 10/7/2022

**DOCUMENT NOT CONSIDERED FINAL UNLESS ALL SIGNATURES COMPLETED**

**SUNGATE DESIGN GROUP, P.A.**  
 894 GILES FARM ROAD  
 SUITE 200, CARY, NORTH CAROLINA, 27506  
 TEL: (919) 855-2243  
 ENG. FIRM LICENSE NO. C-980

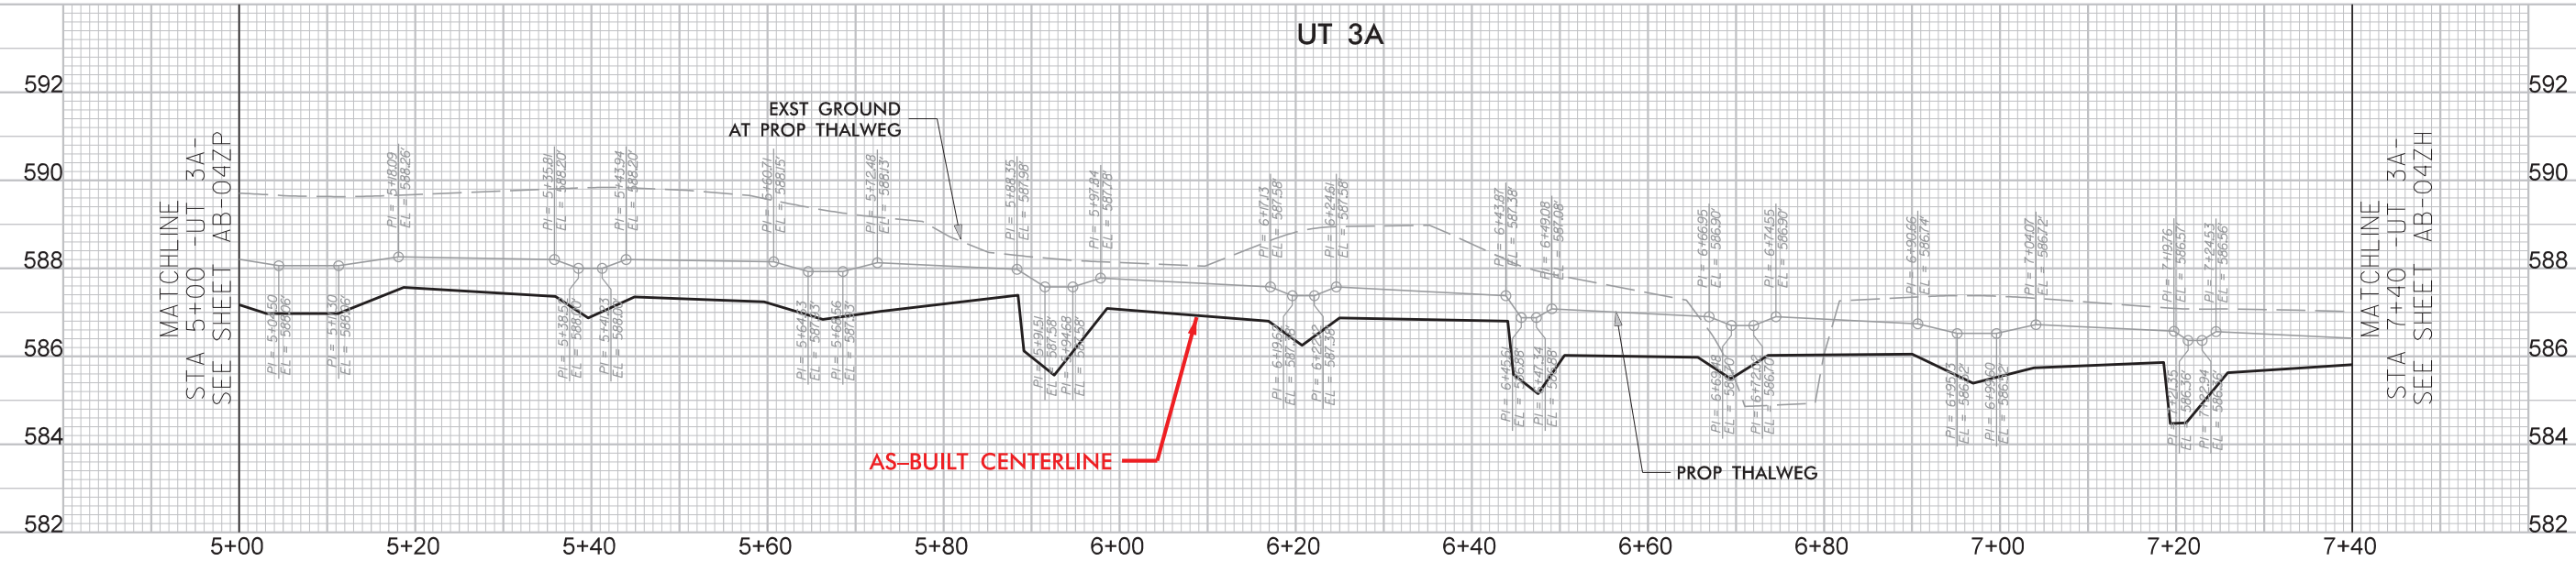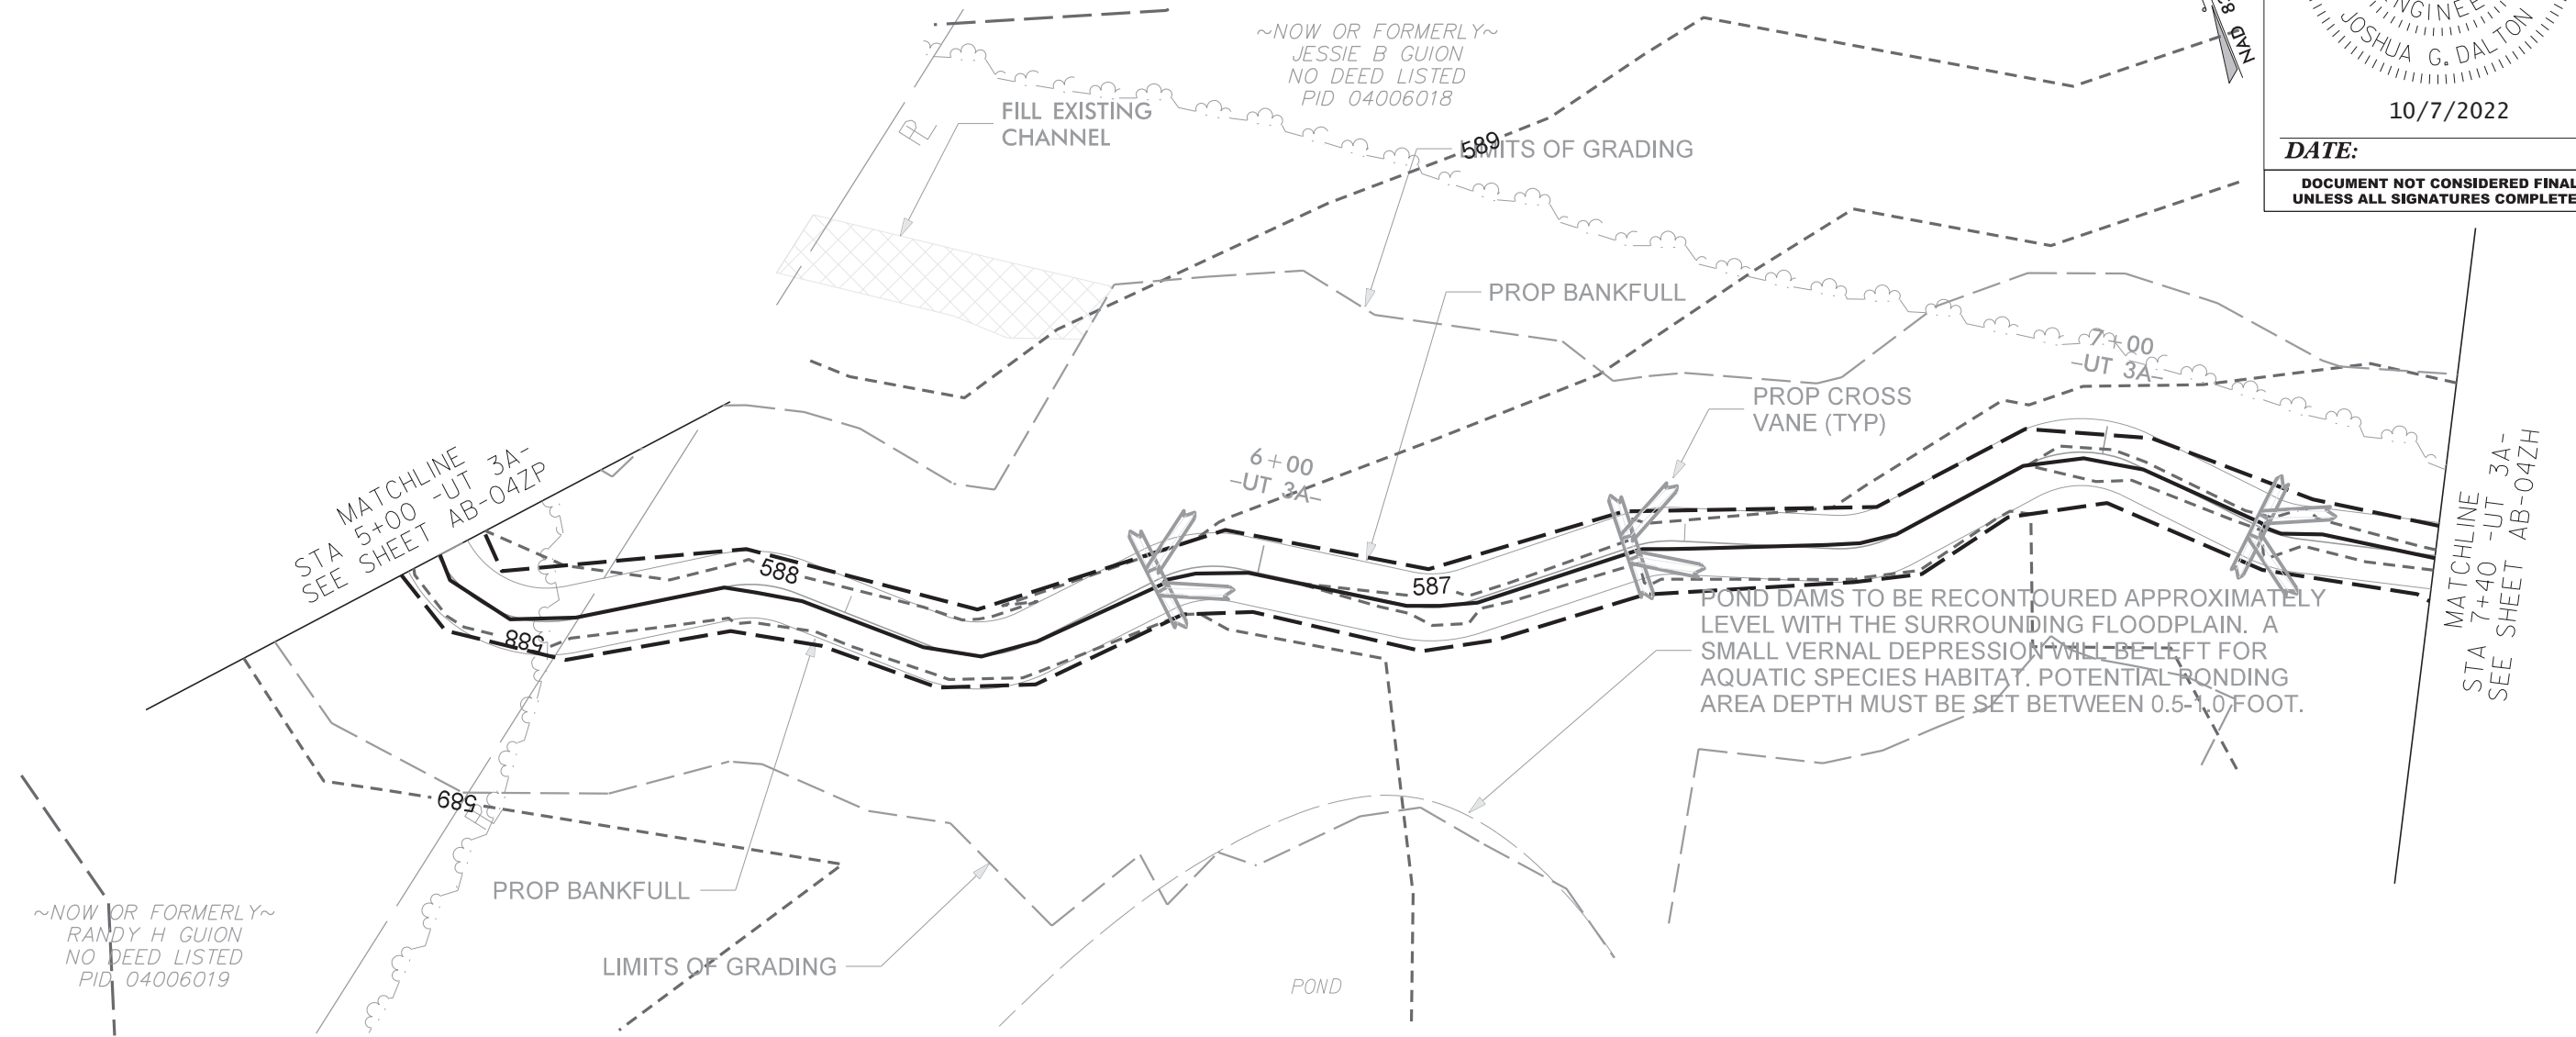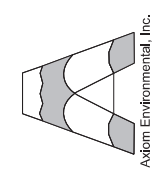


10/6/2022  
 Wits\_End\_Psh\_AB-04ZQ.dgn

© 2022 SUNGATE DESIGN GROUP, P.A. THIS DRAWING AND ALL REPRODUCTIONS OF IT ARE THE SOLE PROPERTY OF SDG. REPRODUCTION OR OTHER USES OF THIS DRAWING WITHOUT WRITTEN CONSENT OF SDG IS NOT PERMITTED.

**WITS END**  
 UNION COUNTY, NC  
**AS-BUILT STRUCTURES**

PROJECT # : 1221-20024  
 DRAWING NAME: WITS END PSH AB-04ZQ  
 DATE: 2022  
 DRAWN BY: JRH  
 REVIEWED BY: JGD  
 REVISIONS:

SHEET NO.  
**AB-04ZQ**

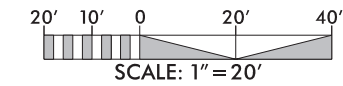



**RECORD DRAWING**

DocuSigned by:  
**Josh Dalton**  
 1089ADBC14994C3...  
 PROFESSIONAL SEAL  
 26971  
 ENGINEER  
 JOSHUA G. DALTON  
 DATE: 10/7/2022

**DOCUMENT NOT CONSIDERED FINAL  
UNLESS ALL SIGNATURES COMPLETED**

**SUNGATE DESIGN GROUP, P.A.**  
 5908 GUNN ROAD  
 SUITE 200  
 CHARLOTTE, NC 28217  
 TEL: (919) 855-2243  
 ENG FIRM LICENSE NO. C-980

**Askom Environmental, Inc.**

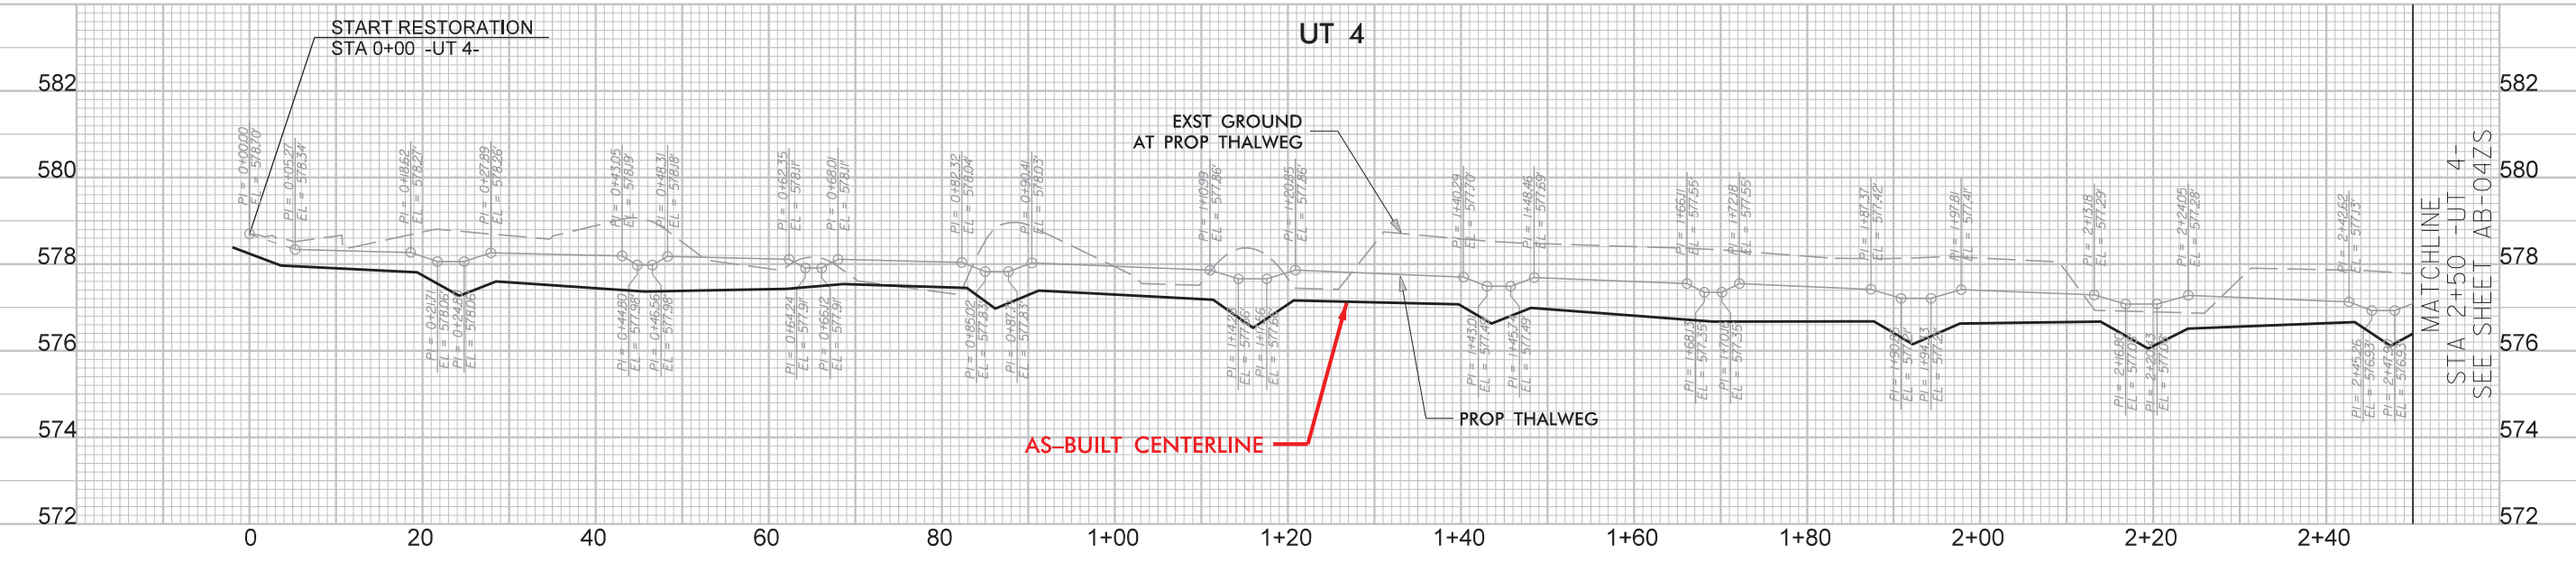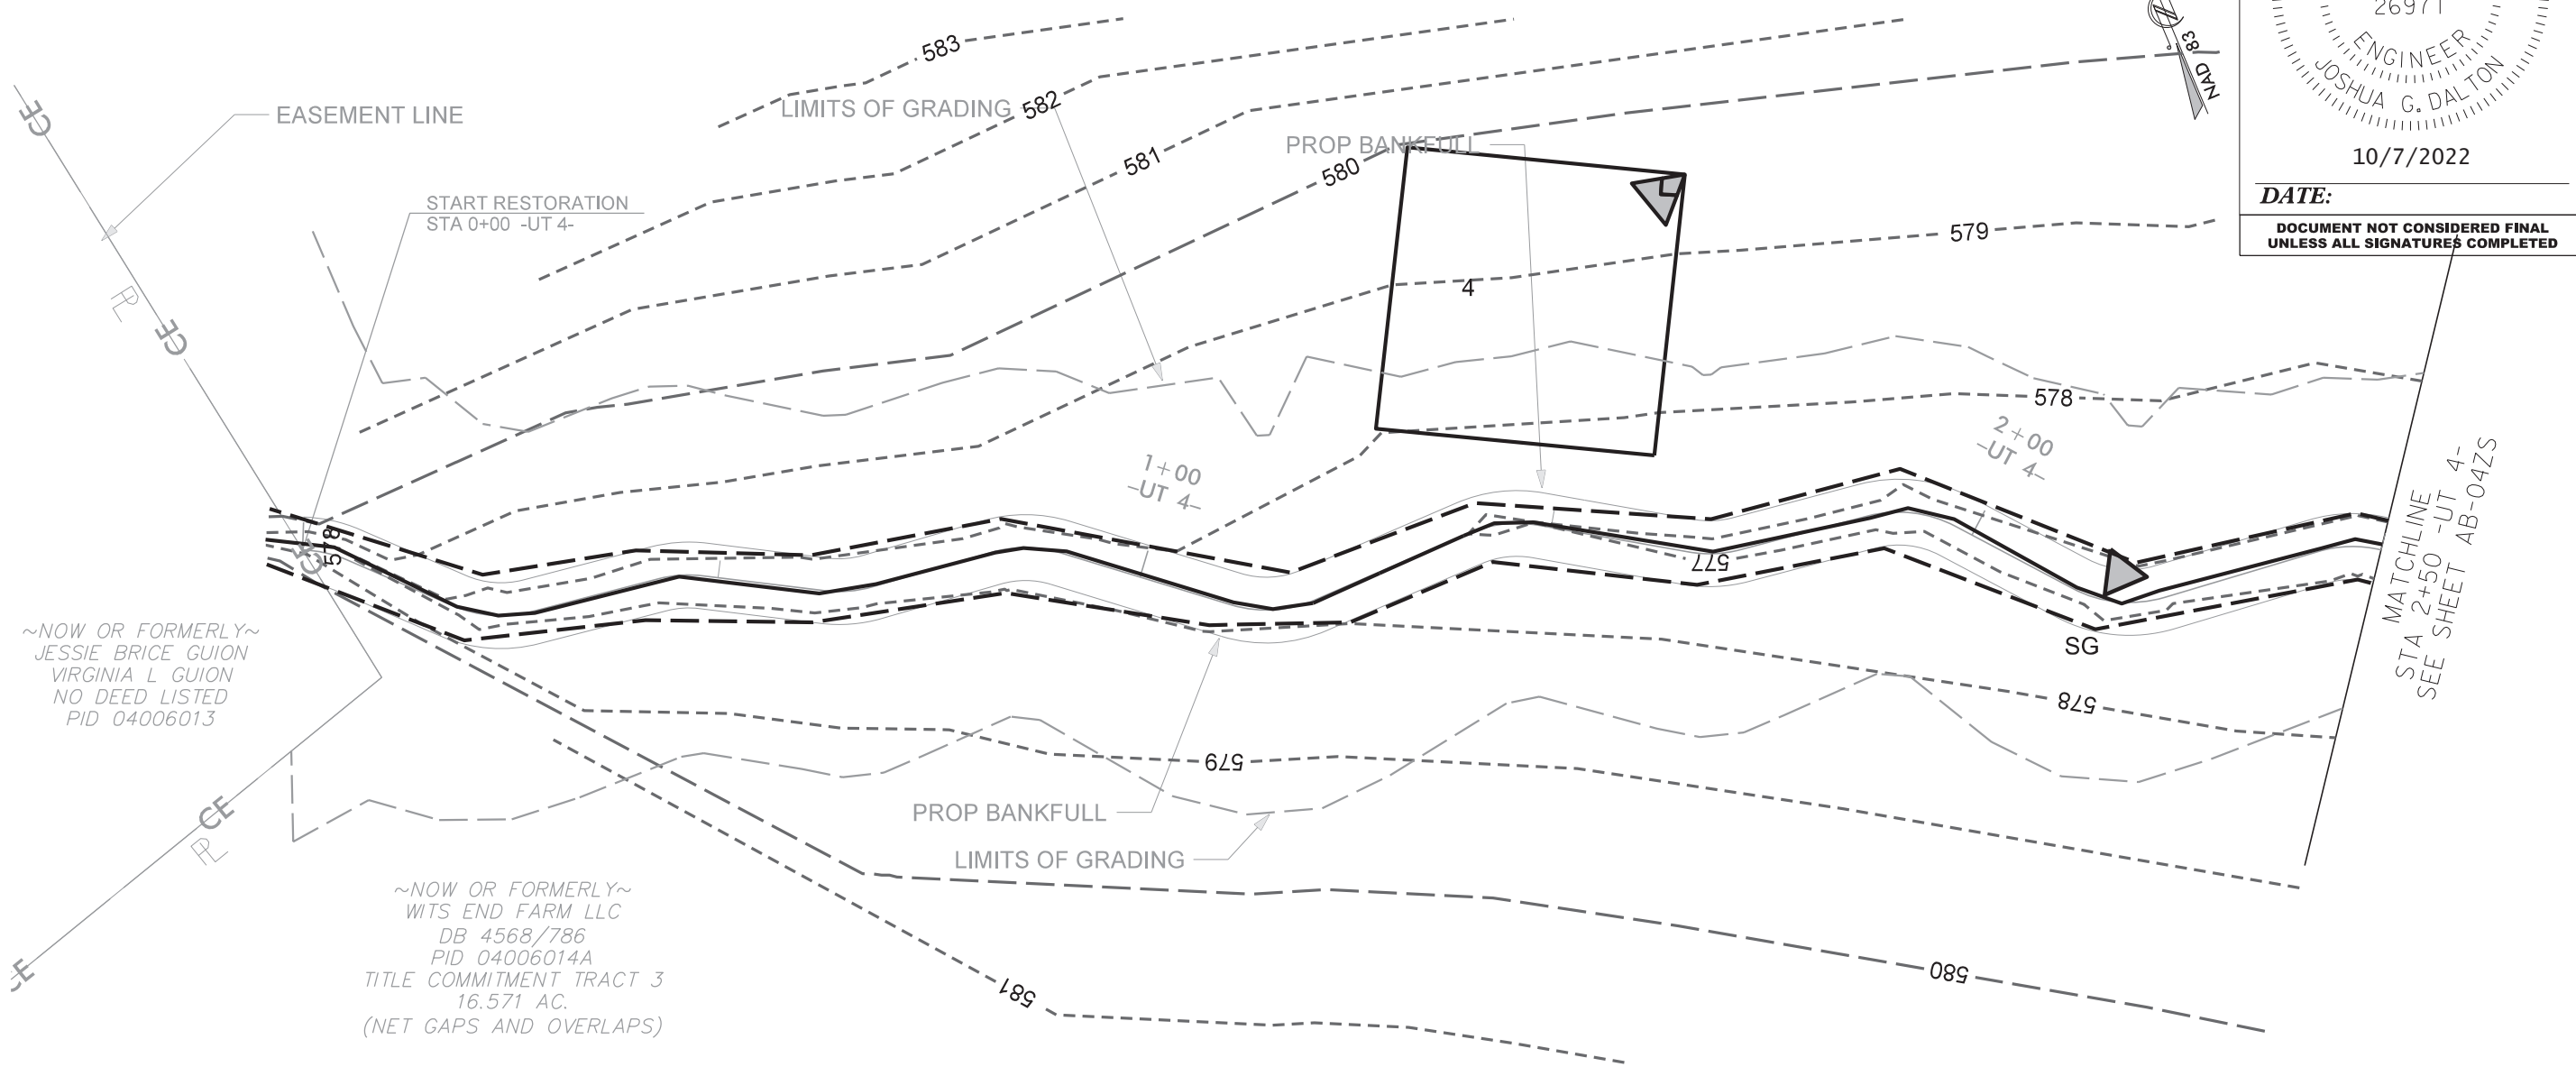

10/6/2022  
Wits\_End\_Psh\_AB-04ZR.dgn

© 2022 SUNGATE DESIGN GROUP, P.A. THIS DRAWING AND ALL REPRODUCTIONS OF IT ARE THE SOLE PROPERTY OF SDG. REPRODUCTION OR OTHER USES OF THIS DRAWING WITHOUT WRITTEN CONSENT OF SDG IS NOT PERMITTED.


**WITS END**  
 UNION COUNTY, NC  
**AB-BUILT STRUCTURES**

PROJECT # :	1221-20024
DRAWING NAME:	WITS END PSH AB-04ZR
DATE:	2022
DRAWN BY:	JRH
REVIEWED BY:	JGD
REVISIONS:	
SHEET NO.	<b>AB-04ZR</b>



~NOW OR FORMERLY~  
 WITS END FARM LLC  
 DB 4568/786  
 PID 04006014A  
 TITLE COMMITMENT TRACT 3  
 16.571 AC.  
 (NET GAPS AND OVERLAPS)

-UT 4- AS-BUILT STRUCTURE LOCATIONS				
STR. TYPE	NORTHING	EASTING	Prop Elevation	AB Survey Elevation
CROSS VANE	424,902.42	1,567,165.98	576.56	576.33
CROSS VANE	424,868.14	1,567,271.60	575.65	575.31

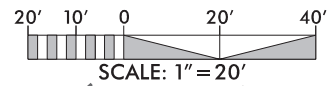

SCALE: 1" = 20'



**RECORD DRAWING**

DocuSigned by:  
 Joshua Dalton  
 1089AD8C14994C3...  
 PROFESSIONAL SEAL  
 26971  
 ENGINEER  
 JOSHUA G. DALTON  
 DATE: 10/7/2022

**DATE:**  
 DOCUMENT NOT CONSIDERED FINAL  
 UNLESS ALL SIGNATURES COMPLETED

**SUNGATE DESIGN GROUP, P.A.**  
 8908 S. FRANKLIN ROAD  
 SUITE 200  
 CHARLOTTE, NC 28217  
 TEL: (919) 855-2243  
 ENG. FIRM LICENSE NO. C-980

**Axiam Environmental, Inc.**

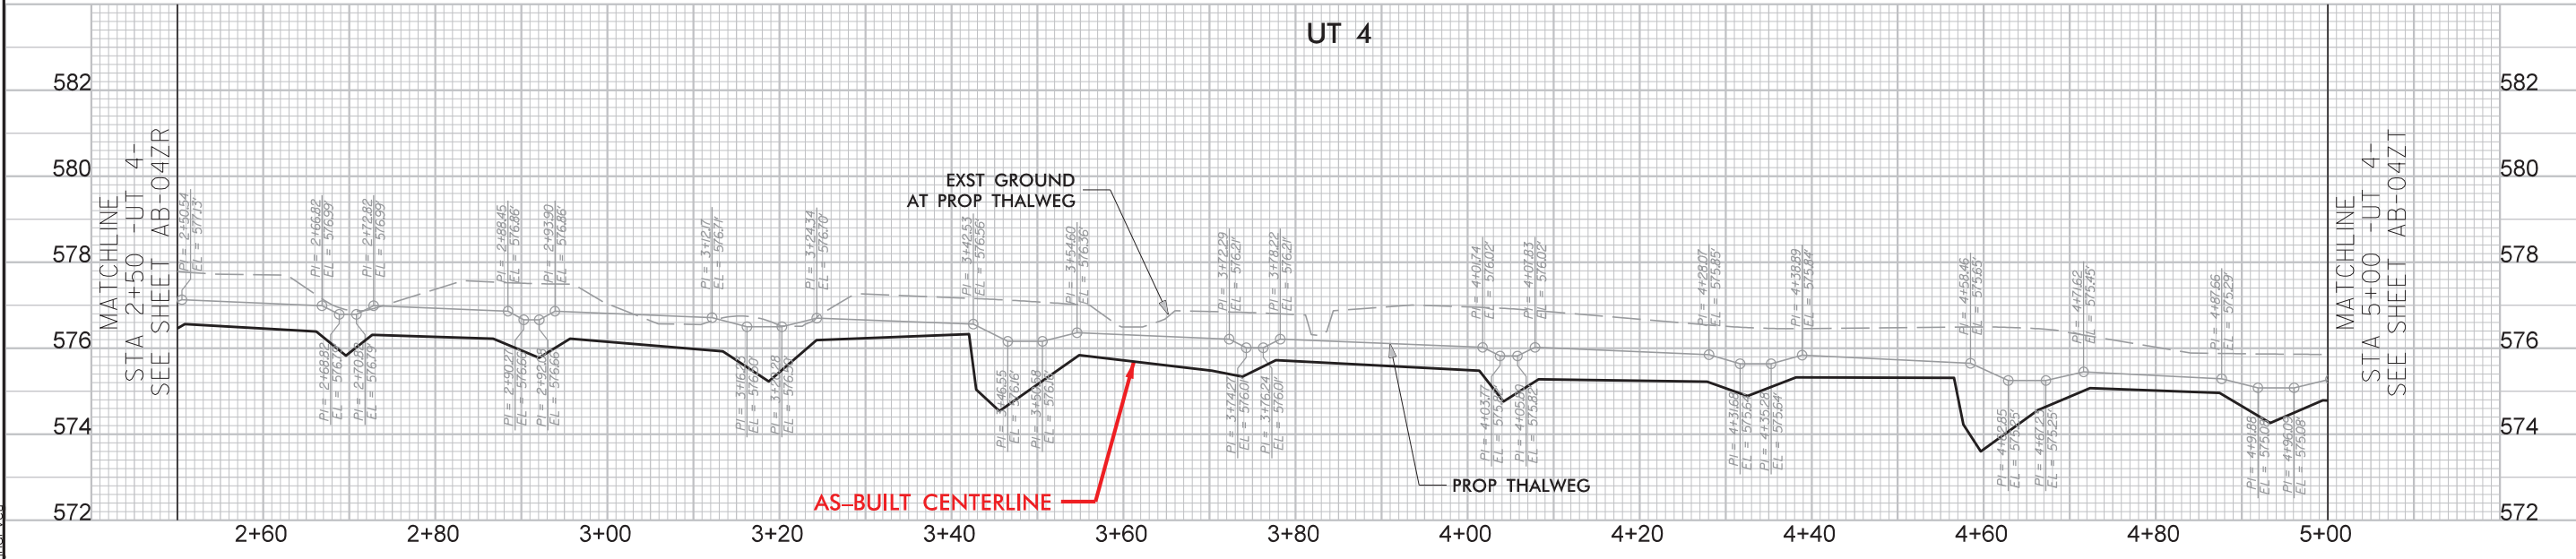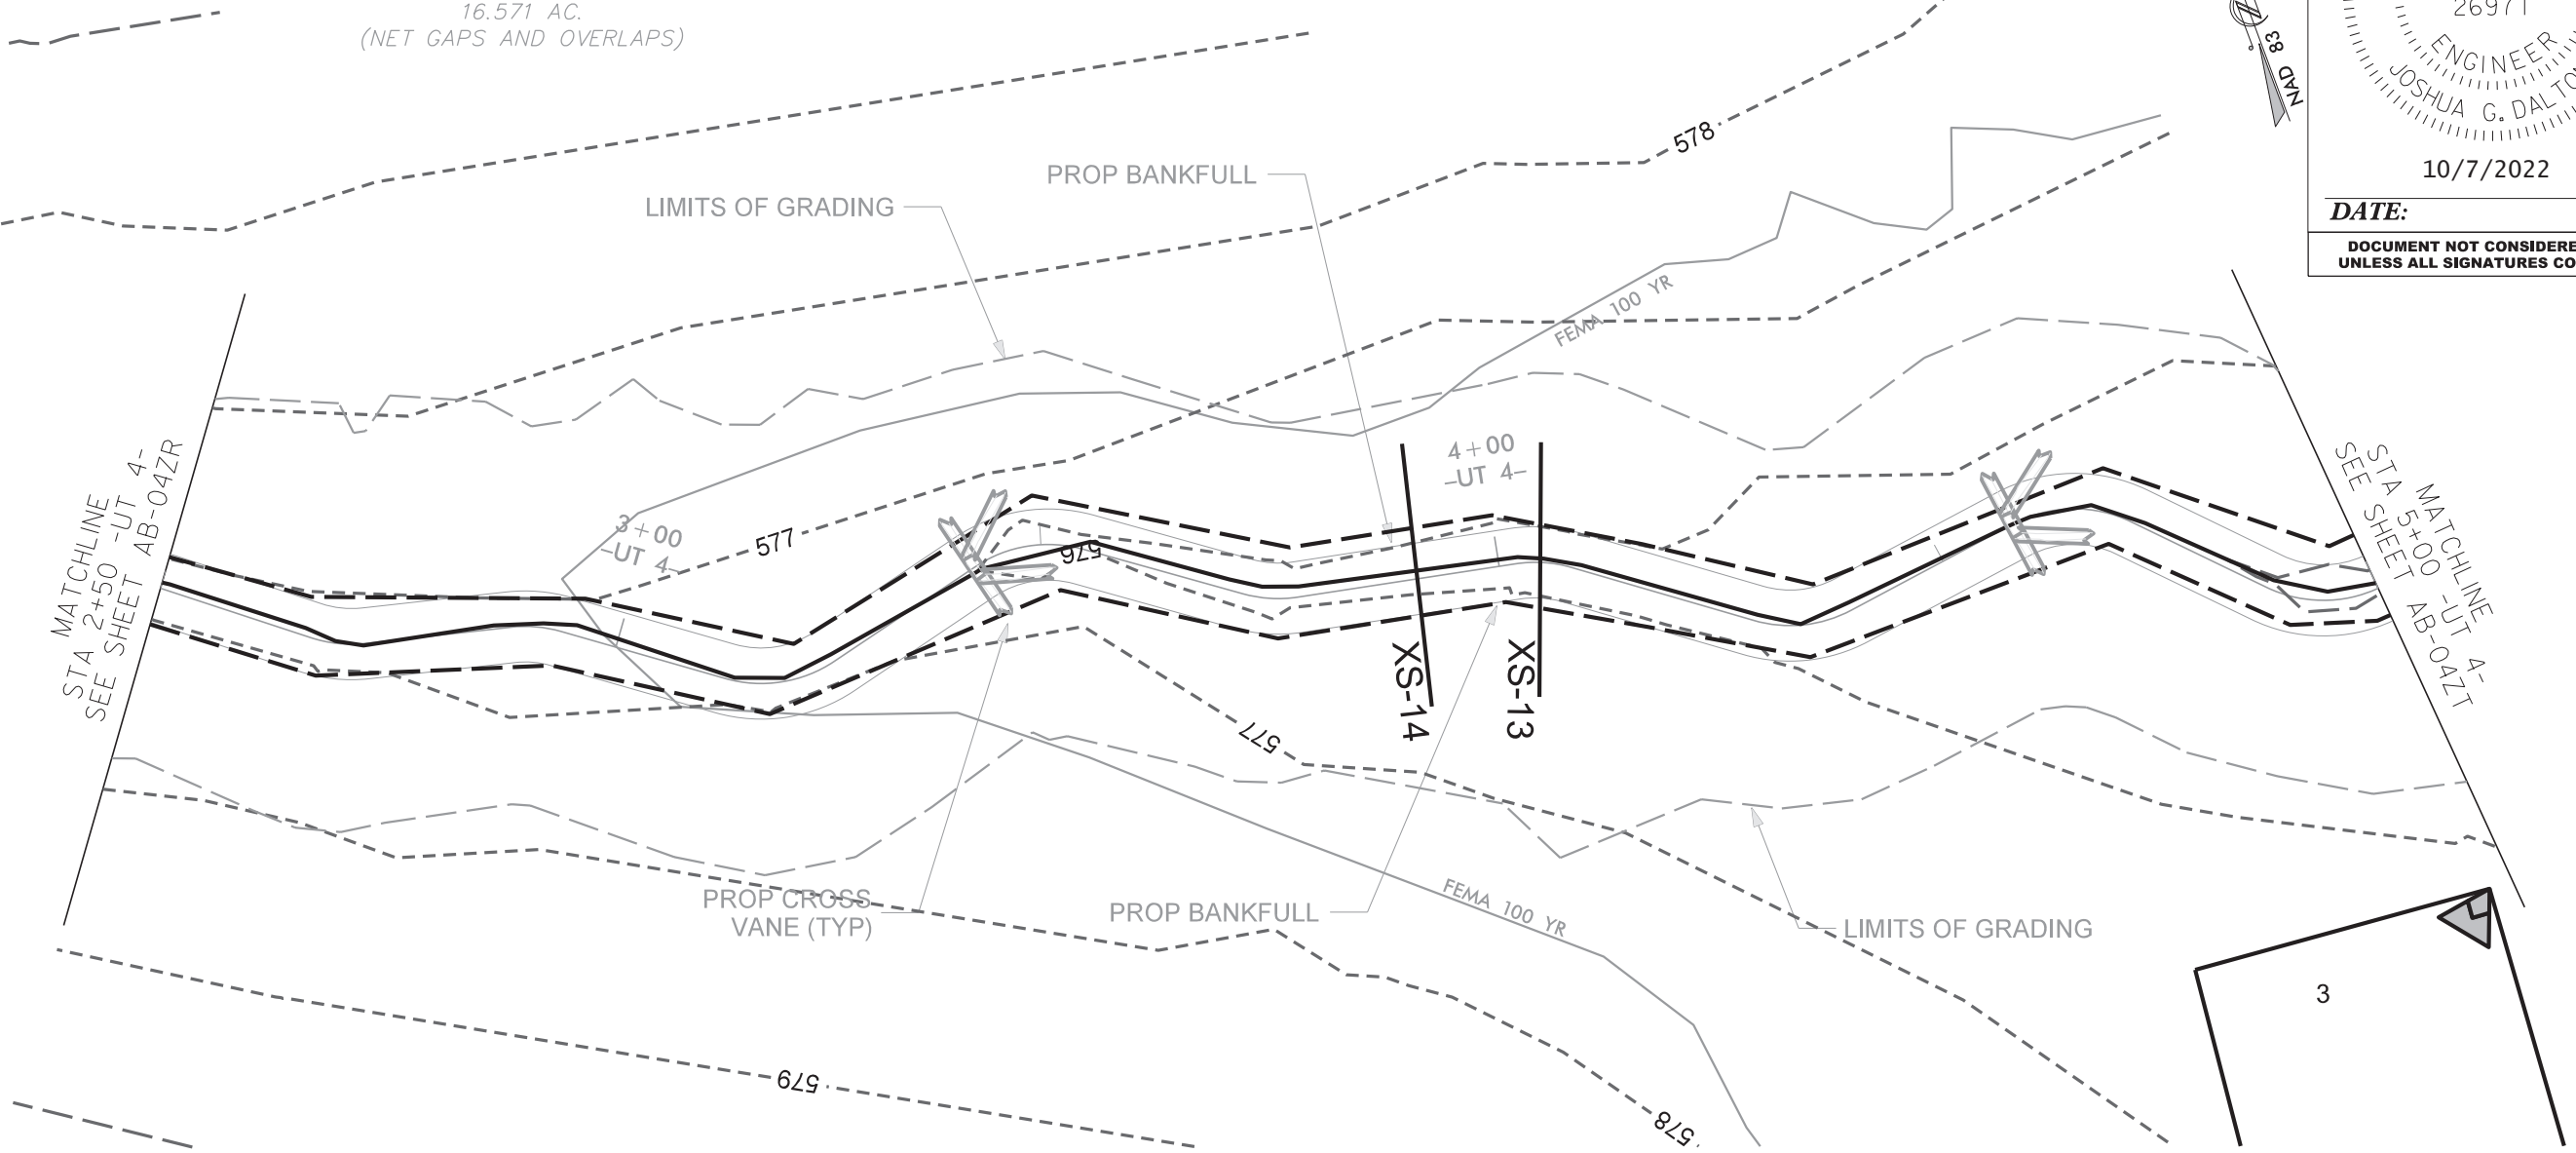

10/6/2022  
 Wits\_End\_Psh\_AB-04ZS.dgn



© 2022 SUNGATE DESIGN GROUP, P.A. THIS DRAWING AND ALL REPRODUCTIONS OF IT ARE THE SOLE PROPERTY OF SDG. REPRODUCTION OR OTHER USES OF THIS DRAWING WITHOUT WRITTEN CONSENT OF SDG IS NOT PERMITTED.

**WITS END**  
 UNION COUNTY, NC  
**AS-BUILT STRUCTURES**

PROJECT # :	1221-20024
DRAWING NAME:	WITS END PSH AB-04ZS
DATE:	2022
DRAWN BY:	JRH
REVIEWED BY:	JGD
REVISIONS:	
SHEET NO.	<b>AB-04ZS</b>

-UT 4- AS-BUILT STRUCTURE LOCATIONS				
STR. TYPE	NORTHING	EASTING	Prop Elevation	AB Survey Elevation
CROSS VANE	424,835.97	1,567,353.84	574.84	574.53
CROSS VANE	424,831.26	1,567,431.61	574.29	573.96
CROSS VANE	424,787.58	1,567,506.58	573.70	573.22


# RECORD DRAWING

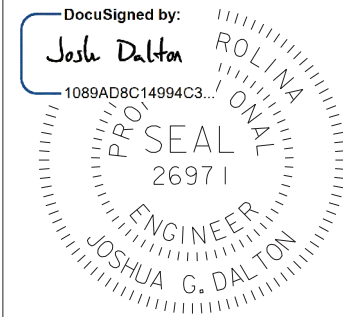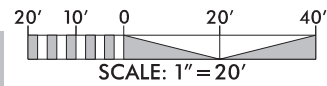

DATE: 10/7/2022



**DOCUMENT NOT CONSIDERED FINAL  
UNLESS ALL SIGNATURES COMPLETED**

**SUNGATE DESIGN GROUP, P.A.**  
930 GILES CRAWFORD ROAD  
SUNGATE, NORTH CAROLINA 27866  
TEL: (919) 855-2243  
ENG. FIRM LICENSE NO. C-980

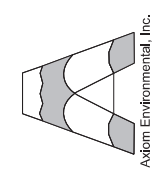

~NOW OR FORMERLY~  
WITS END FARM, LLC  
DB 4568/786  
PID 04006014A  
TITLE COMMITMENT TRACT 3  
16.571 AC.  
(NET GAPS AND OVERLAPS)

~NOW OR FORMERLY~  
BIBI MARIAM NIAZI-SAI REVOCABLE TRUST  
DB 7073/202  
TRACT 4, PC J/45  
PID 03168003D

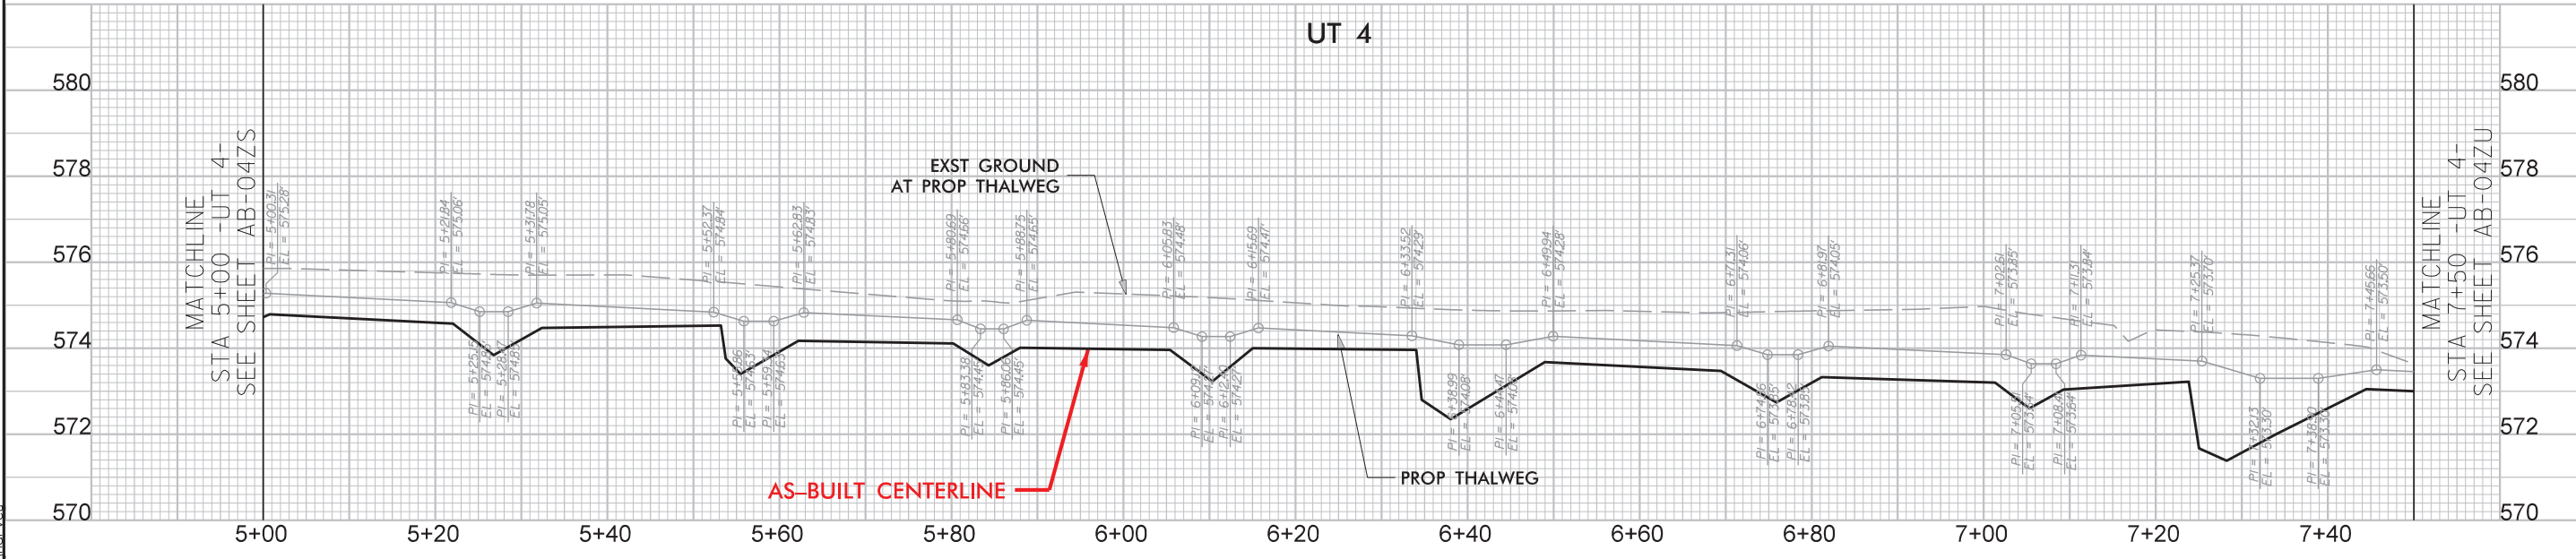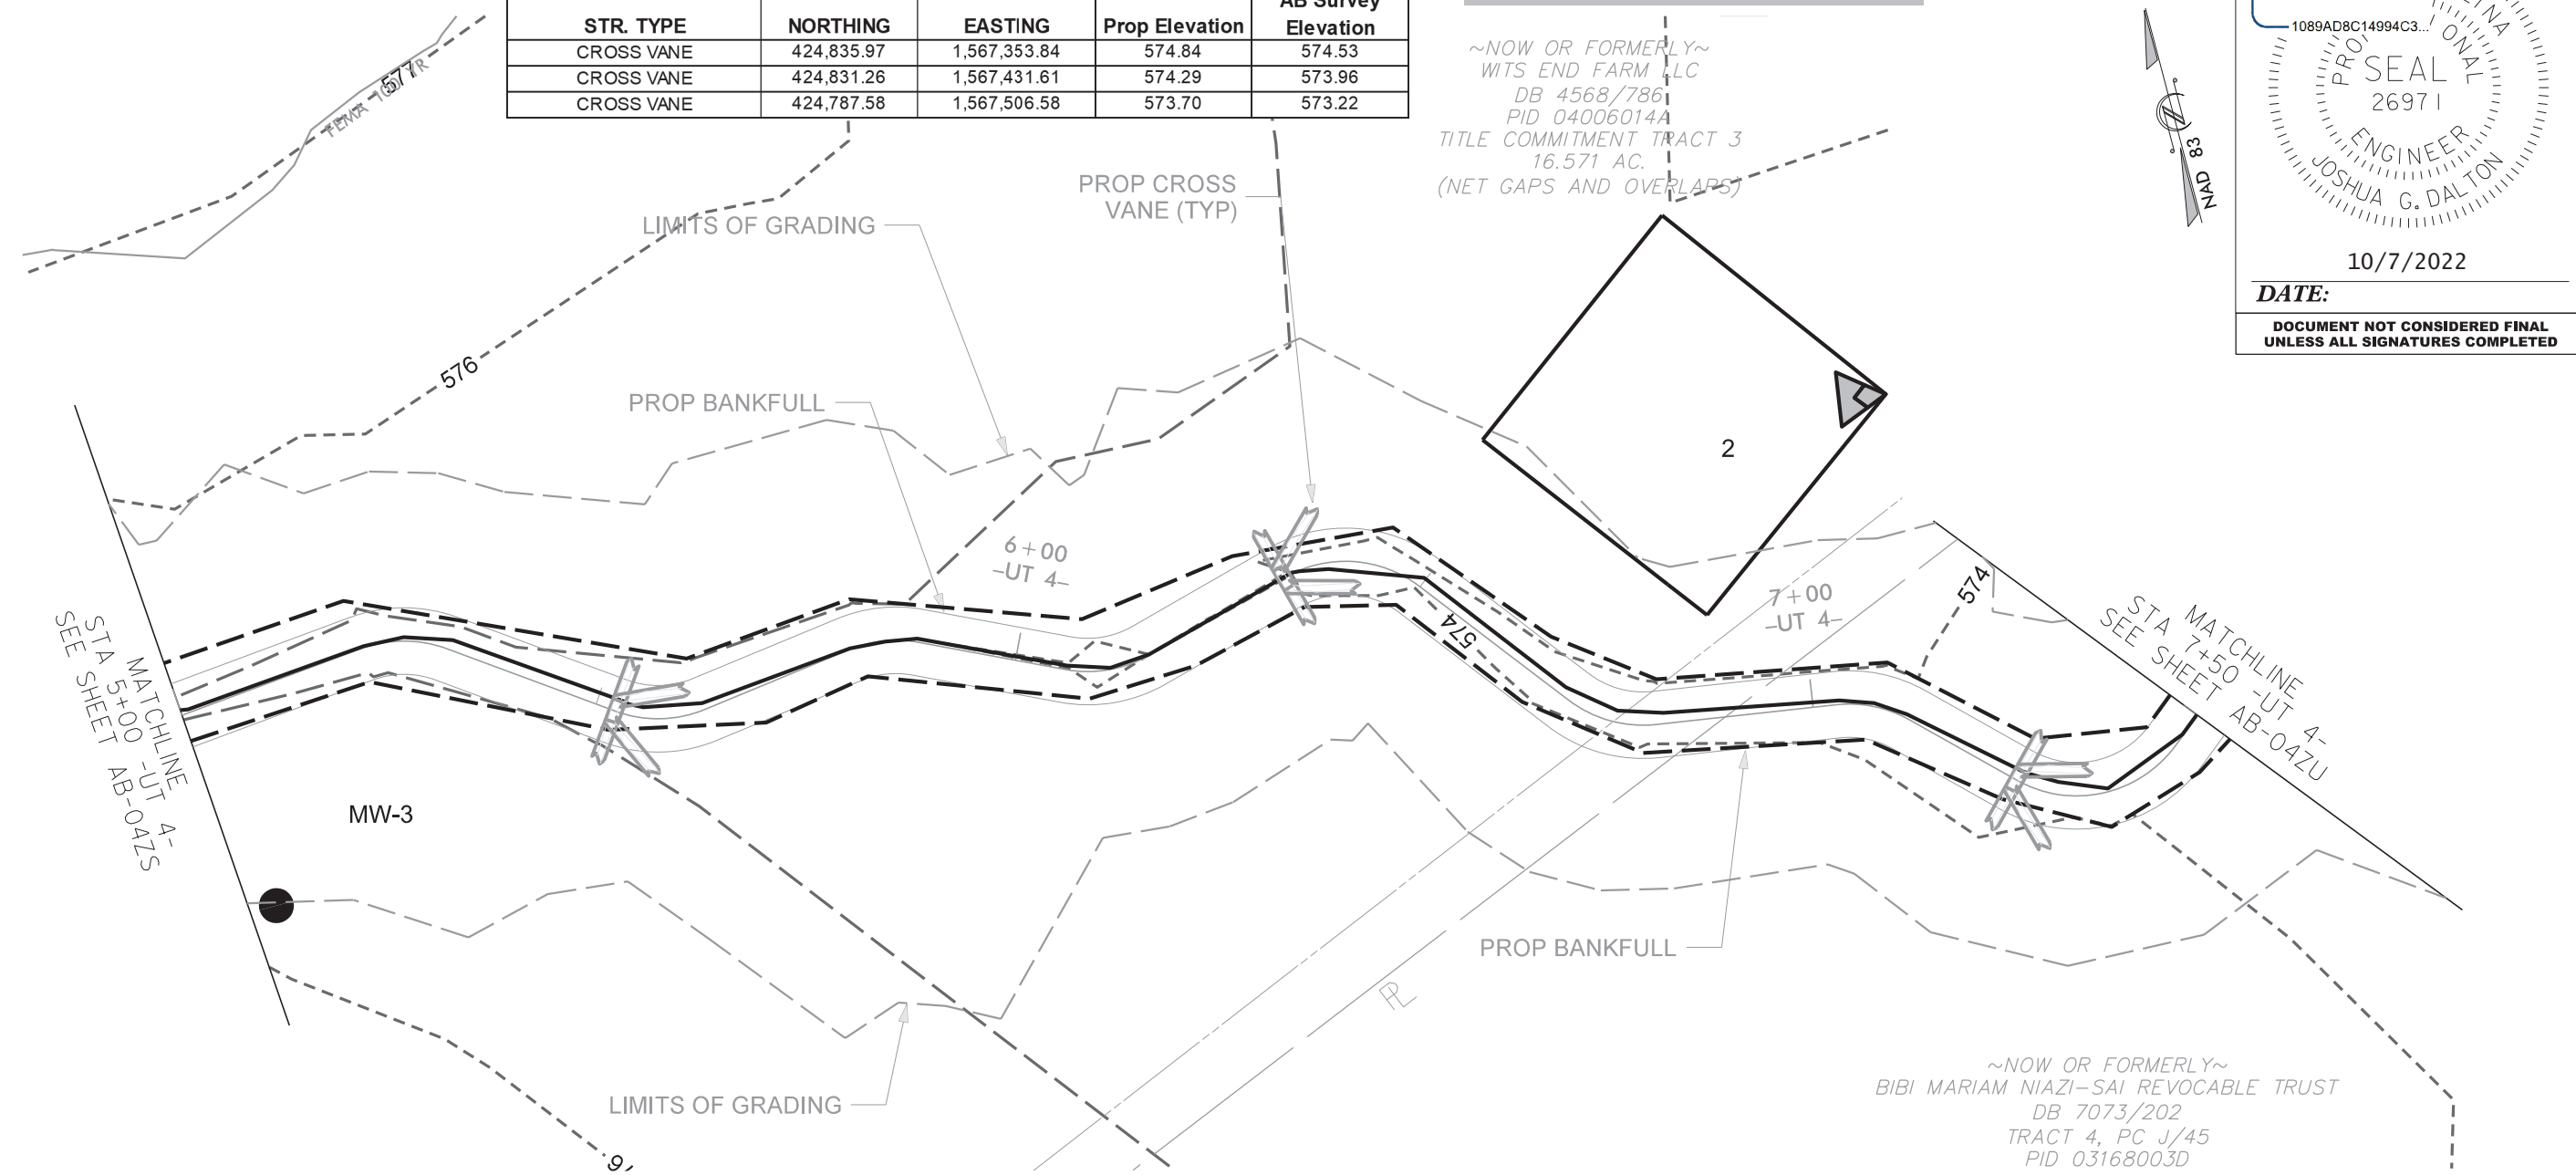

10/6/2022  
Wits\_End\_psh\_AB-04ZT.dgn

© 2022 SUNGATE DESIGN GROUP, P.A. THIS DRAWING AND ALL REPRODUCTIONS OF IT ARE THE SOLE PROPERTY OF SDG. REPRODUCTION OR OTHER USES OF THIS DRAWING WITHOUT WRITTEN CONSENT OF SDG IS NOT PERMITTED.



**WITS END**  
UNION COUNTY, NC

**AS-BUILT STRUCTURES**

PROJECT # : 1221-20024  
DRAWING NAME: WITS END PSH AB-04ZT  
DATE: 2022  
DRAWN BY: JRH  
REVIEWED BY: JGD  
REVISIONS:

SHEET NO.  
**AB-04ZT**


-UT 4- AS-BUILT STRUCTURE LOCATIONS				
STR. TYPE	NORTHING	EASTING	Prop Elevation	AB Survey Elevation
LOG VANE	424,791.43	1,567,652.04	572.87	572.47

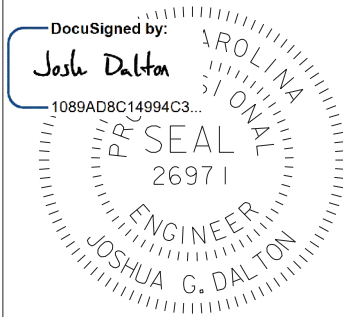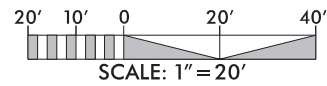


DATE: 10/7/2022

DOCUMENT NOT CONSIDERED FINAL UNLESS ALL SIGNATURES COMPLETED


**RECORD DRAWING**

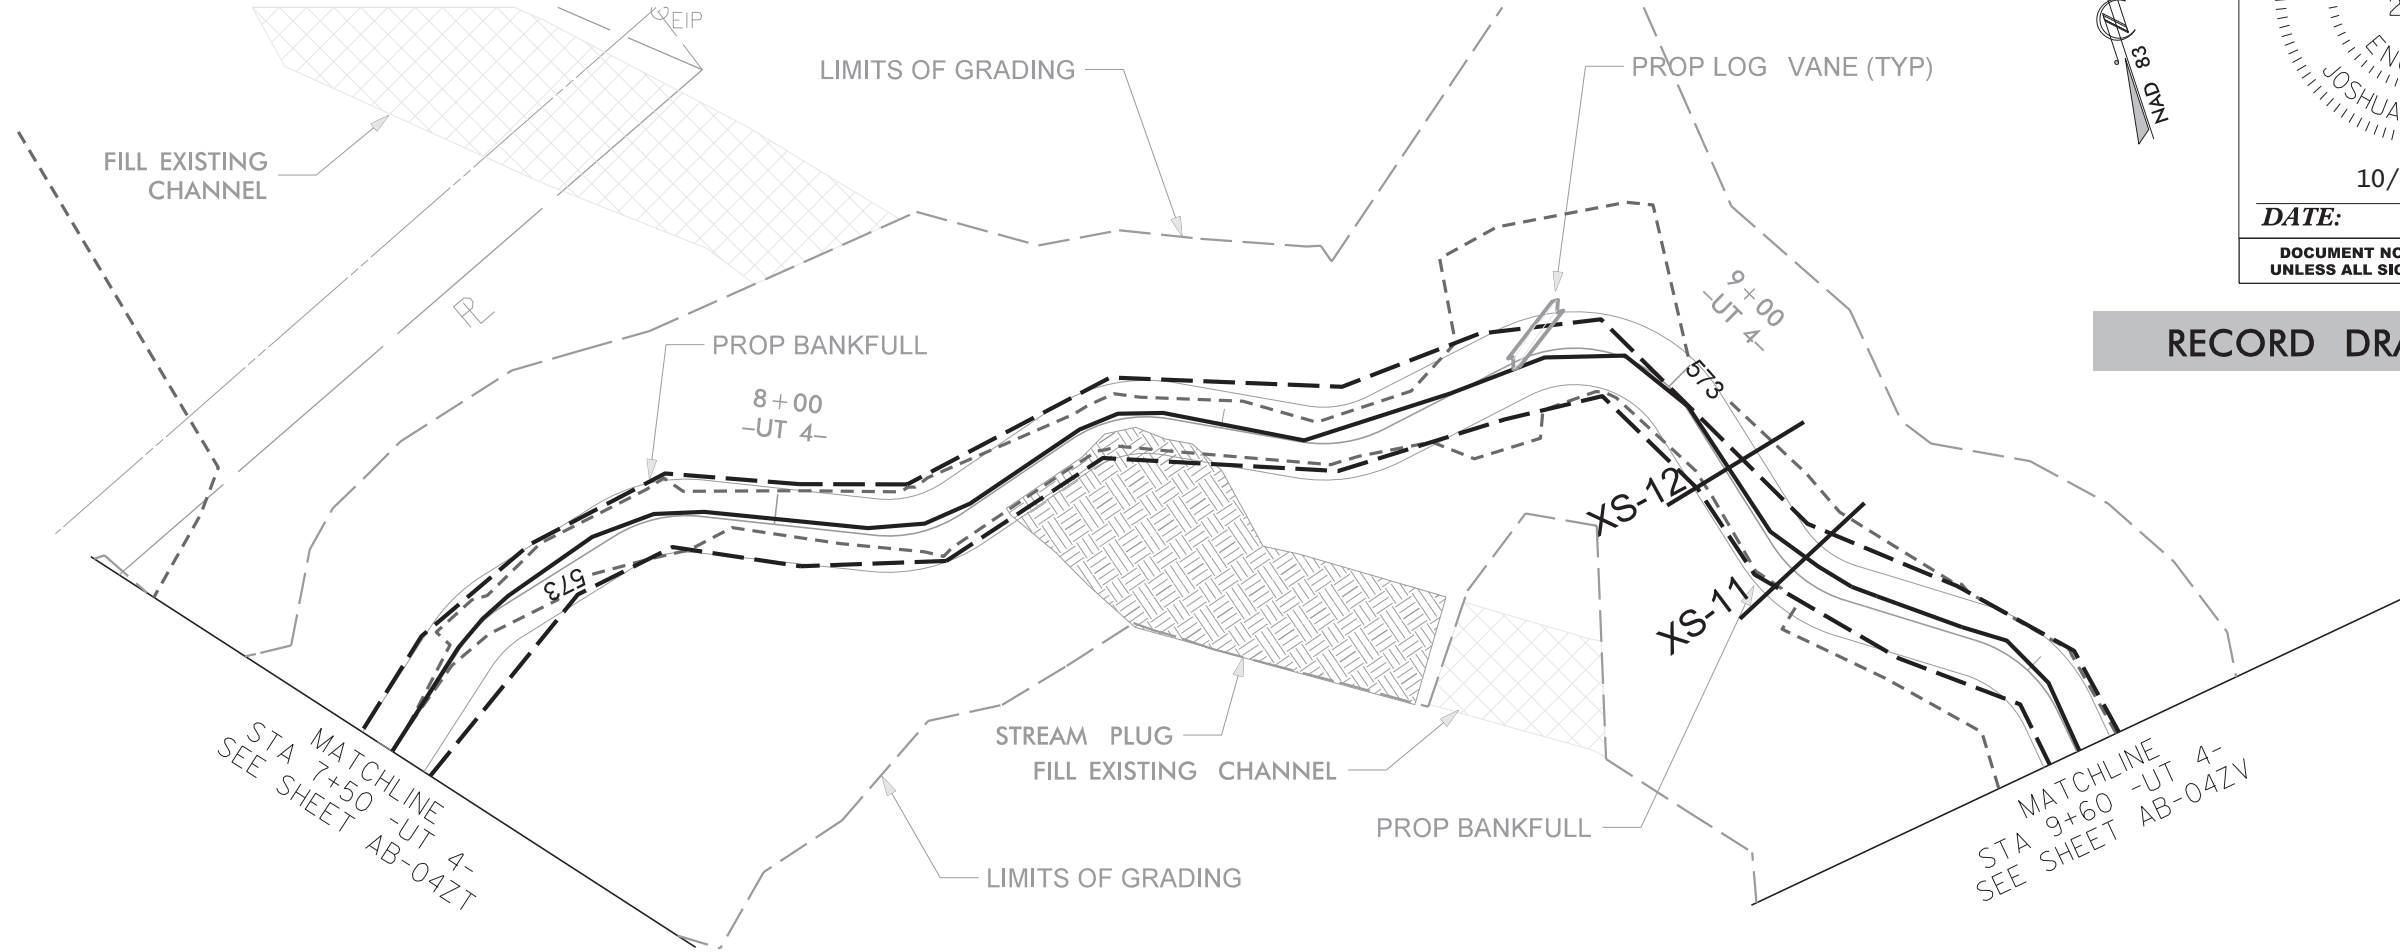

~NOW OR FORMERLY~  
 BIBI MARIAM NIAZI-SAI REVOCABLE TRUST  
 DB 7073/202  
 TRACT 4, PC J/45  
 PID 03168003D

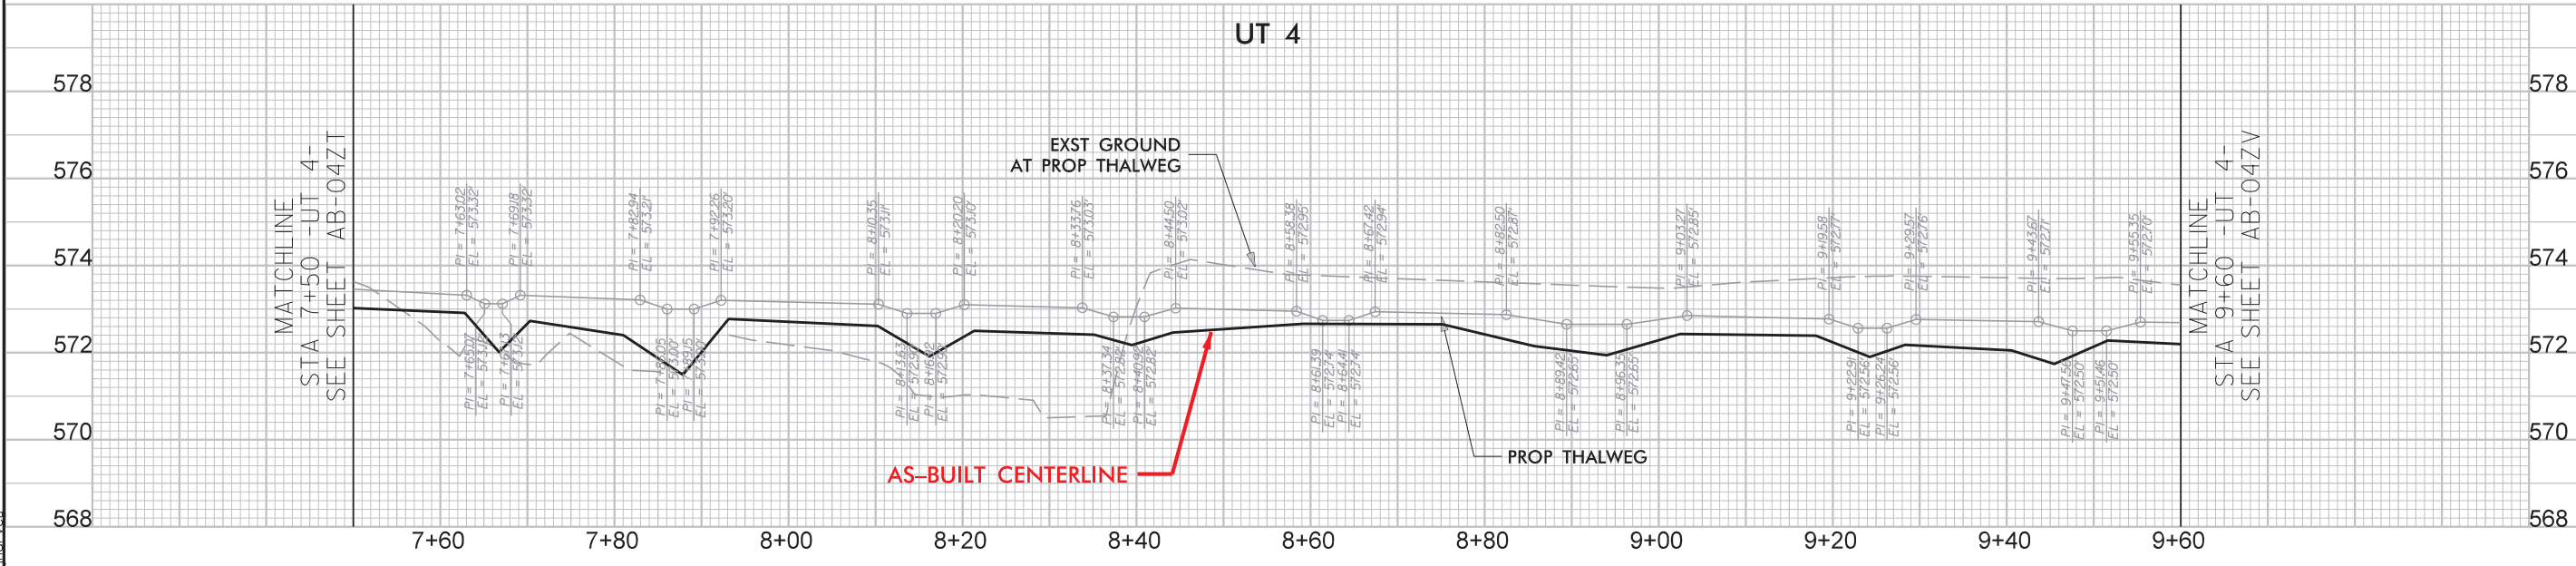

SUNGATE DESIGN GROUP, P.A.  
 8400 S. PARKWAY ROAD  
 SUITE 200  
 CHARLOTTE, NC 27866  
 TEL: (919) 855-2243  
 ENG FIRM LICENSE NO. C-980

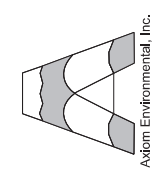

WITS END  
 UNION COUNTY, NC  
 AS-BUILT STRUCTURES

PROJECT # : 1221-20024  
 DRAWING NAME: WITS END PSH AB-04ZU  
 DATE: 2022  
 DRAWN BY: JRH  
 REVIEWED BY: JGD  
 REVISIONS:



SHEET NO. AB-04ZU

10/6/2022  
 Wits\_End\_Psh\_AB-04ZU.dgn

© 2022 SUNGATE DESIGN GROUP, P.A. THIS DRAWING AND ALL REPRODUCTIONS OF IT ARE THE SOLE PROPERTY OF SDG. REPRODUCTION OR OTHER USES OF THIS DRAWING WITHOUT WRITTEN CONSENT OF SDG IS NOT PERMITTED.




**RECORD DRAWING**

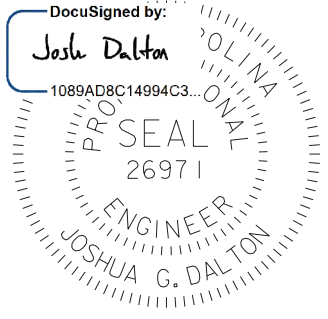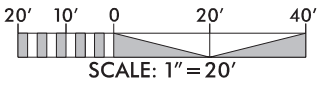

10/7/2022


**DATE:**  
DOCUMENT NOT CONSIDERED FINAL  
UNLESS ALL SIGNATURES COMPLETED

**SUNGATE DESIGN GROUP, P.A.**  
934 GILES FARM ROAD  
SUNGATE, NORTH CAROLINA 27866  
TEL: (919) 855-2243  
ENG. FIRM LICENSE NO. C-890

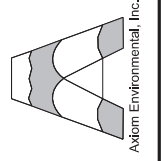


-UT 4- AS-BUILT STRUCTURE LOCATIONS				
STR. TYPE	NORTHING	EASTING	Prop Elevation	AB Survey Elevation
CROSS VANE	424,682.81	1,567,736.59	572.50	
CROSS VANE	424,657.89	1,567,828.54	572.01	

~NOW OR FORMERLY~  
BIBI MARIAM NIAZI-SAI REVOCABLE TRUST  
DB 7073/202  
TRACT 4, PC J/45  
PID 03168003D

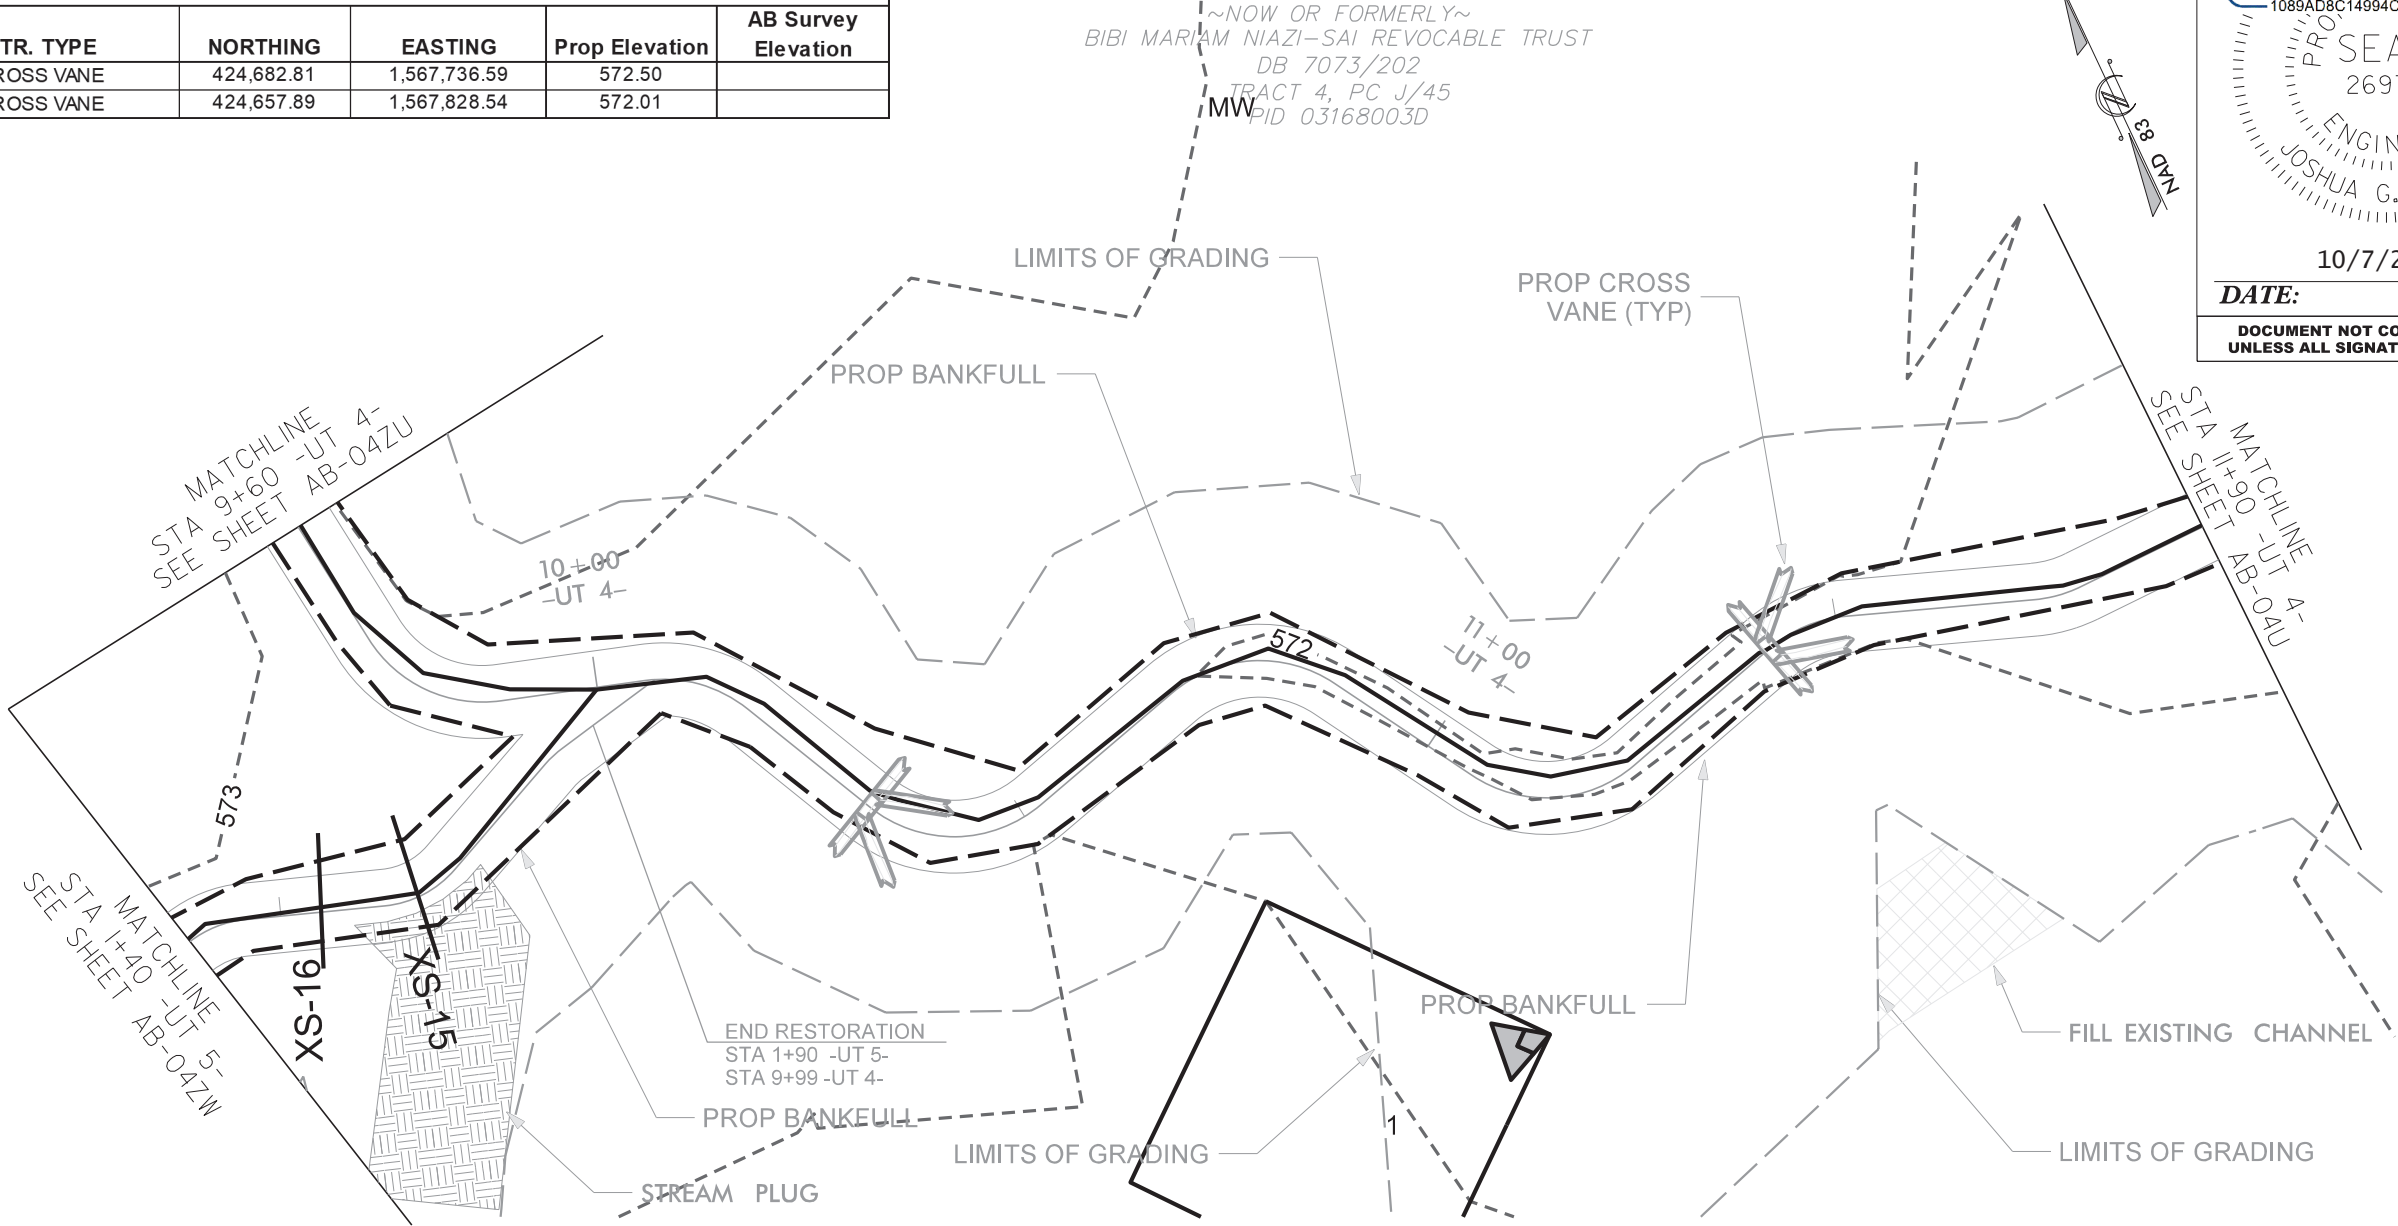

AS-BUILT CENTERLINE

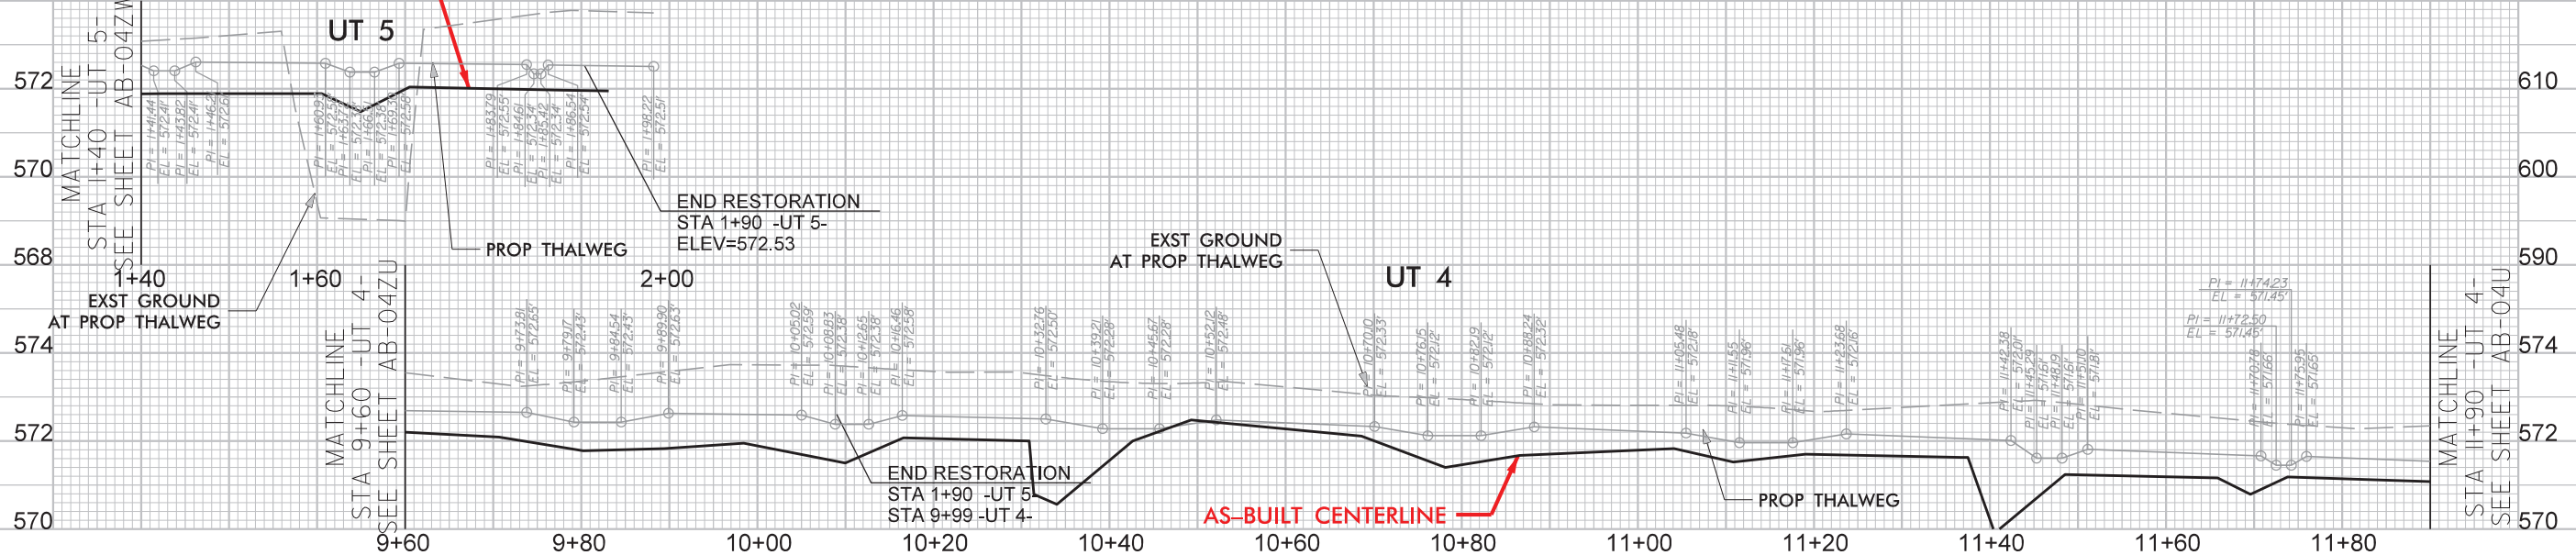

10/6/2022  
Wits\_End\_Psh\_AB-04ZV.dgn


© 2022 SUNGATE DESIGN GROUP, P.A. THIS DRAWING AND ALL REPRODUCTIONS OF IT ARE THE SOLE PROPERTY OF SDG. REPRODUCTION OR OTHER USES OF THIS DRAWING WITHOUT WRITTEN CONSENT OF SDG IS NOT PERMITTED.

**WITS END**  
UNION COUNTY, NC


**AS-BUILT STRUCTURES**

PROJECT # : 1221-20024  
DRAWING NAME: WITS END PSH AB-04ZV  
DATE: 2022  
DRAWN BY: JRH  
REVIEWED BY: JGD  
REVISIONS:

SHEET NO.  
**AB-04ZV**

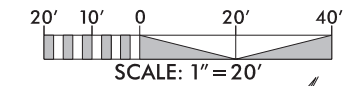




**RECORD DRAWING**

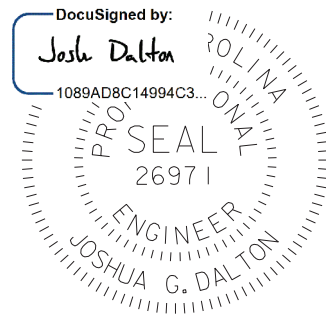

10/7/2022

**DATE:**  
**DOCUMENT NOT CONSIDERED FINAL**  
**UNLESS ALL SIGNATURES COMPLETED**

**SUNGATE DESIGN GROUP, P.A.**  
 800 GOLF COURSE ROAD  
 SUITE 1000  
 WILMINGTON, NC 27866  
 TEL: (919) 855-2243  
 FAX: (919) 855-2244  
 ENG. FIRM LICENSE NO. C-980

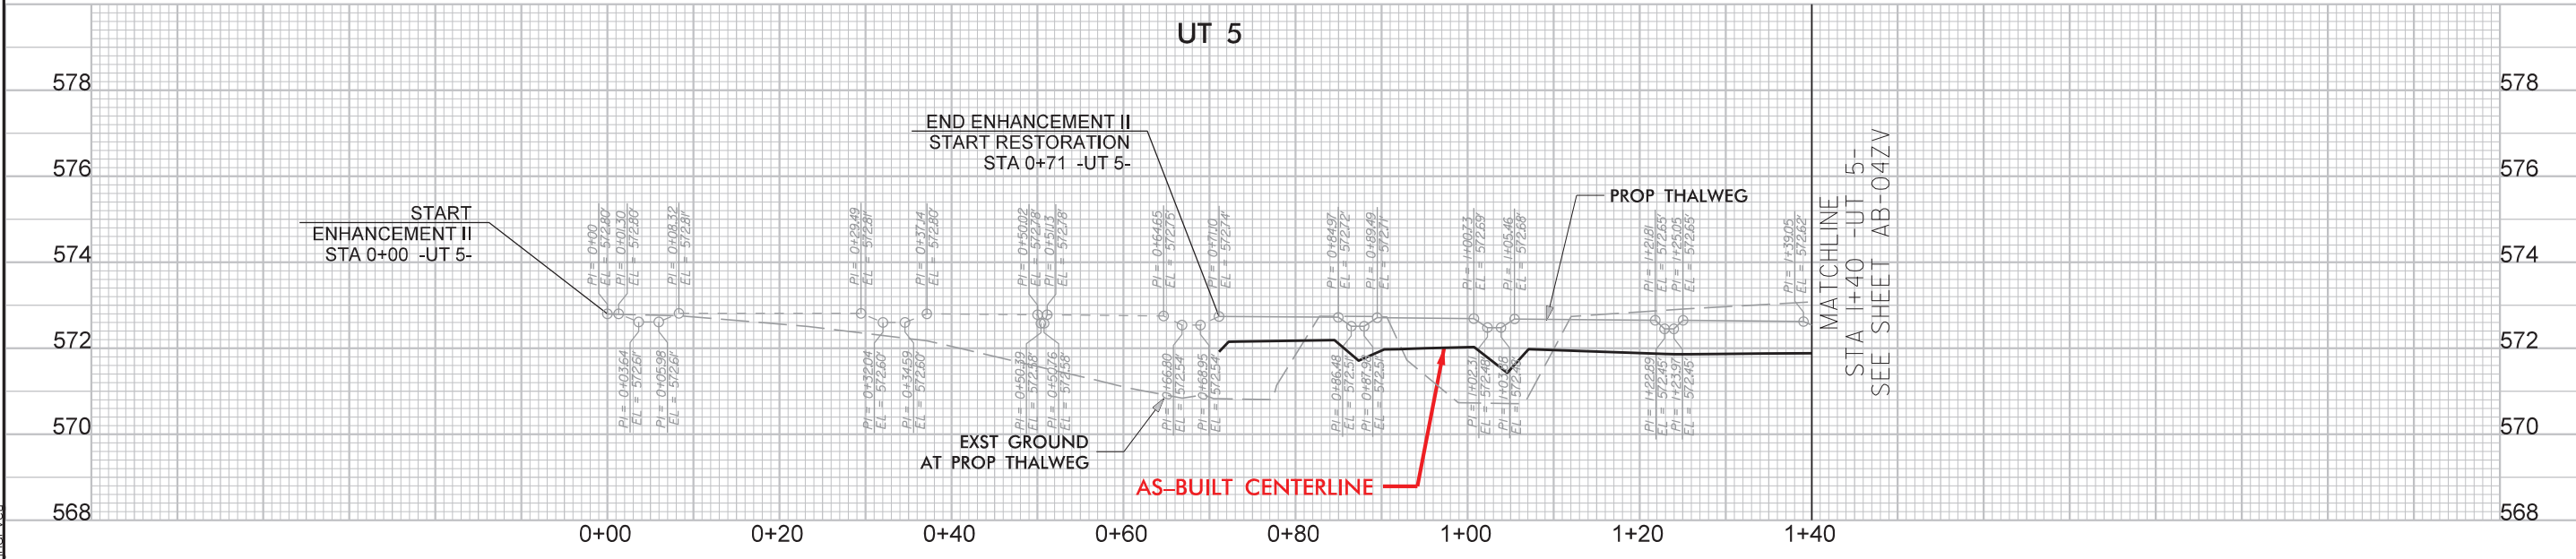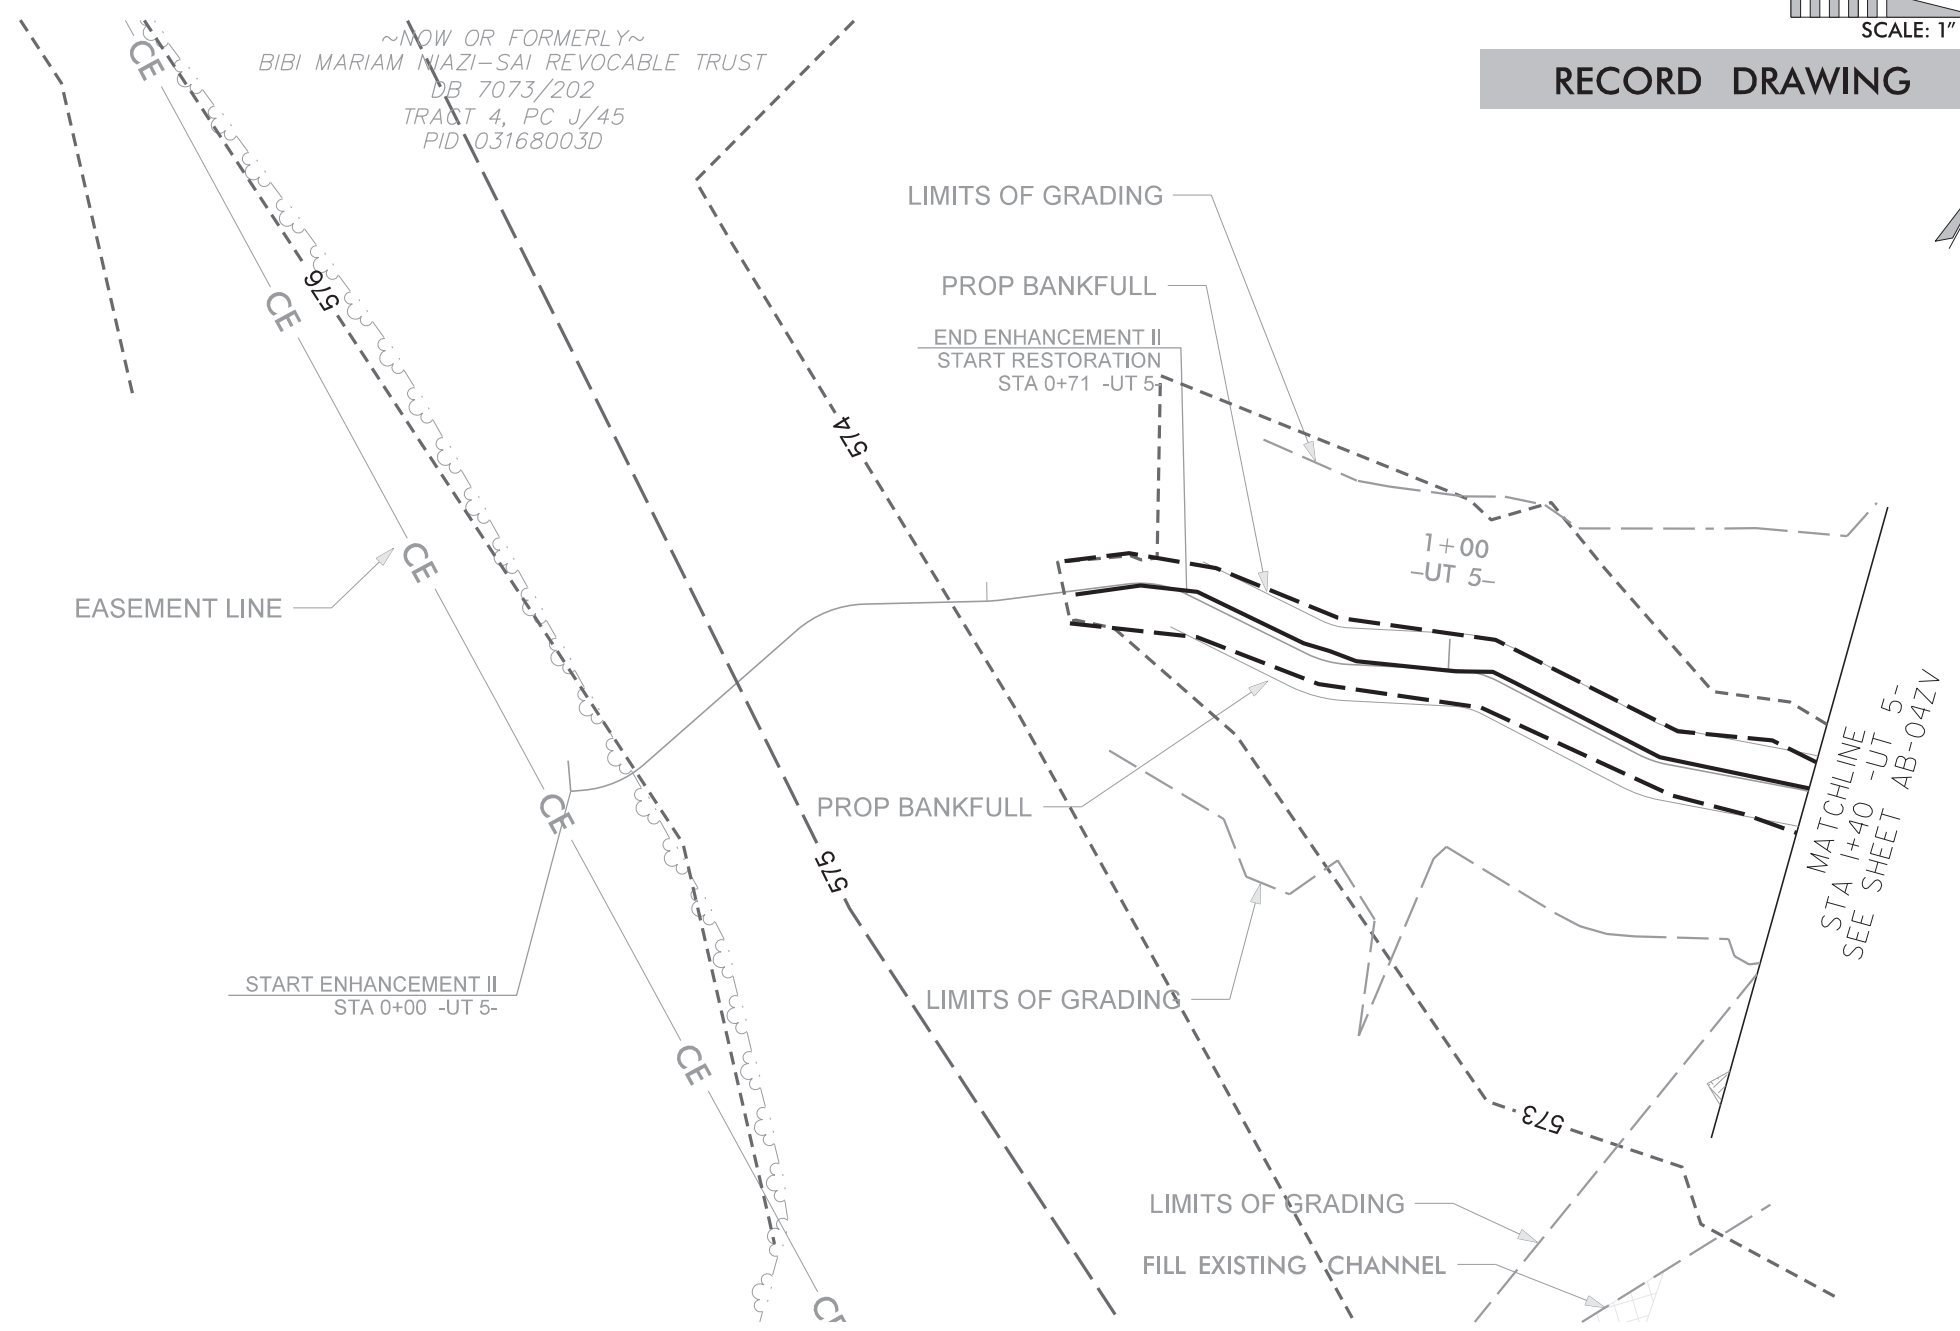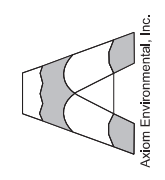

10/6/2022  
 Wits\_Endr\_psh\_AB-04Z.dgn  
 jgd

© 2022 SUNGATE DESIGN GROUP, P.A. THIS DRAWING AND ALL REPRODUCTIONS OF IT ARE THE SOLE PROPERTY OF SDG. REPRODUCTION OR OTHER USES OF THIS DRAWING WITHOUT WRITTEN CONSENT OF SDG IS NOT PERMITTED.

**WITS END**  
 UNION COUNTY, NC  
**AS-BUILT STRUCTURES**

PROJECT # : 1221-20024  
 DRAWING NAME: WITS END PSH AB-04ZW  
 DATE: 2022  
 DRAWN BY: JRH  
 REVIEWED BY: JGD  
 REVISIONS:  
 SHEET NO. **AB-04ZW**






## DESIGN PLANT LIST

Vegetation Association	Piedmont/Mountain Bottomland Forest*		Dry-Mesic Oak-Hickory Forest*		Stream-side Assemblage**		TOTAL
Area (acres)	7.2		5		3.8		16
Species	# planted*	% of total	# planted*	% of total	# planted**	% of total	# planted
River birch ( <i>Betula nigra</i> )	245	5	--	--	1550	15	1795
Bitternut hickory ( <i>Carya cordiformis</i> )	490	10	--	--	--	--	490
American elm ( <i>Ulmus americana</i> )	245	5	170	5	--	--	415
Red bud ( <i>Cercis canadensis</i> )	--	--	510	15	--	--	510
Silky dogwood ( <i>Cornus amomum</i> )	245	5	--	--	2067	20	2312
Persimmon ( <i>Diospyros virginiana</i> )	--	--	510	15	--	--	510
Hackberry ( <i>Celtis occidentalis</i> )	490	10	--	--	517	5	1006
Green ash ( <i>Fraxinus pennsylvanica</i> )	245	5	--	--	517	5	762
Tulip poplar ( <i>Liriodendron tulipifera</i> )	245	5	170	5	517	5	932
Sycamore ( <i>Platanus occidentalis</i> )	245	5	170	5	1550	15	1965
Red mulberry ( <i>Morus rubra</i> )	--	--	170	5	517	5	687
Water oak ( <i>Quercus nigra</i> )	734	15	680	20	--	--	1414
White oak ( <i>Quercus alba</i> )	490	10	680	20	1034	10	2203
Red oak ( <i>Quercus rubra</i> )	--	--	340	10	--	--	340
Black gum ( <i>Nyssa sylvatica</i> )	490	10	--	--	1034	10	1523
Willow oak ( <i>Quercus phellos</i> )	245	5	--	--	1034	10	1278
Shumard oak ( <i>Quercus shumardii</i> )	490	10	--	--	--	--	490
<b>TOTAL</b>	<b>4896</b>	<b>100</b>	<b>3400</b>	<b>100</b>	<b>10336</b>	<b>100</b>	<b>18632</b>
* Planted at a density of 680 stems/acre.							
** Planted at a density of 2720 stems/acre.							

## AS-BUILT PLANT LIST

Table 6A. Planted Woody Vegetation  
Wits End Stream and Wetland Mitigation Site

Bare-Root Planting		
Species	Total	Percent
<b>Acres</b>	<b>58</b>	<b>%</b>
American Elm ( <i>Ulmus americana</i> )	3,000	4.0
American Holly ( <i>Ilex opaca</i> )	2,220	2.9
Birch River ( <i>Betula nigra</i> )	6,300	8.3
Black Gum ( <i>Nyssa sylvatica</i> )	5,049	6.7
Hackberry ( <i>Celtis occidentalis</i> )	2,900	3.8
Hickory Mockernut ( <i>Carya tomentosa</i> )	1,500	2.0
Hickory Shagbark ( <i>Carya ovata</i> )	3,500	4.6
Oak Red ( <i>Quercus rubra</i> )	4,000	5.3
Oak Swamp Chestnut ( <i>Quercus michauxii</i> )	1,700	2.2
Oak Water ( <i>Quercus nigra</i> )	12,200	16.1
Oak White ( <i>Quercus alba</i> )	4,850	6.4
Oak Willow ( <i>Quercus phellos</i> )	1,400	1.8
Persimmon ( <i>Diospyras virginiana</i> )	4,250	5.6
Red Bud ( <i>Cercis canadensis</i> )	1,900	2.5
Silky Dogwood ( <i>Cornus amomum</i> )	7,550	10.0
Sycamore ( <i>Platanus occidentalis</i> )	7,900	10.4
Tulip Poplar ( <i>Liriodendron tulipifera</i> )	5,050	6.7
Tupelo Gum ( <i>Nyssa aquatica</i> )	500	0.7
<b>TOTALS</b>	<b>75,769</b>	<b>100</b>
<b>Average Stems/Acre</b>	<b>1306</b>	
1-Gallon Containerized Planting		
Species	Total	Percent
<b>Acres</b>	<b>1.5</b>	<b>%</b>
American Elm ( <i>Ulmus americana</i> )	40	7.7
Birch River ( <i>Betula nigra</i> )	40	7.7
Black Gum ( <i>Nyssa sylvatica</i> )	70	13.5
Oak Red ( <i>Quercus rubra</i> )	60	11.5
Oak Water ( <i>Quercus nigra</i> )	90	17.3
Oak White ( <i>Quercus alba</i> )	90	17.3
Red Bud ( <i>Cercis canadensis</i> )	60	11.5
Sycamore ( <i>Platanus occidentalis</i> )	30	5.8
Tulip Poplar ( <i>Liriodendron tulipifera</i> )	40	7.7
<b>TOTALS</b>	<b>520</b>	<b>100</b>
<b>Average Stems/Acre</b>	<b>347</b>	

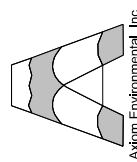

© 2022 SUNGATE DESIGN GROUP, P.A. THIS DRAWING AND ALL REPRODUCTIONS OF IT ARE THE SOLE PROPERTY OF SDG. REPRODUCTION OR OTHER USES OF THIS DRAWING WITHOUT WRITTEN CONSENT OF SDG IS NOT PERMITTED.


**WITS END  
UNION COUNTY, NC  
AS-BUILT PLANTING LIST**

PROJECT # :  
1221-20024  
DRAWING NAME:  
WITS END PSH AB-04ZY  
DATE:  
2021  
DRAWN BY:  
JRH  
REVIEWED BY:  
JGD  
REVISIONS:

STATE	STATE PROJECT REFERENCE NO.	SHEET NO.	TOTAL SHEETS
N.C.	WITS END SITE	1	

INDEX OF SHEETS

SHEET NUMBER	SHEET
AB-01	Title Sheet
AB-02	As-Built Symbolry
AB-03	As-Built Easement
AB-03A	Control Points
AB-03B	As-Built Site Overview
AB-C04 THRU AB-C53	As-Built Survey
AB-C54 THRU AB-C61	As-Built Cross Sections

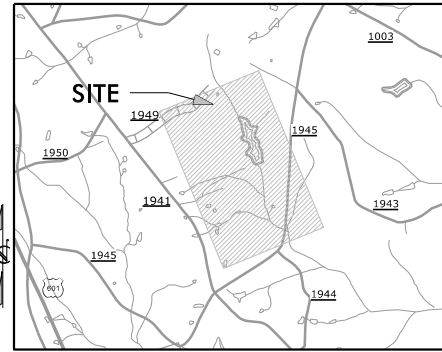


VICINITY MAP  
Not to Scale

# AS-BUILT SURVEY DRAWINGS FOR: RESTORATION SYSTEMS, LLC WITS END SITE

LOCATION: UNION COUNTY, NORTH CAROLINA

TYPE OF WORK: STREAM RESTORATION AND ENHANCEMENT (CLEARING,  
GRUBBING, GRADING, EROSION CONTROL AND PLANTING)

NOTE: WAXHAW BRANCH IS LOCATED IN A FEMA LIMITED DETAILED STUDY AREA. PROJECT TO BE CONSTRUCTED ACCORDING TO APPROVED CONSTRUCTION DOCUMENTS. ANY DEVIATIONS FROM THE PLANS WILL REQUIRE APPROVAL FROM THE ENGINEER AND FLOODPLAIN ADMINISTRATOR

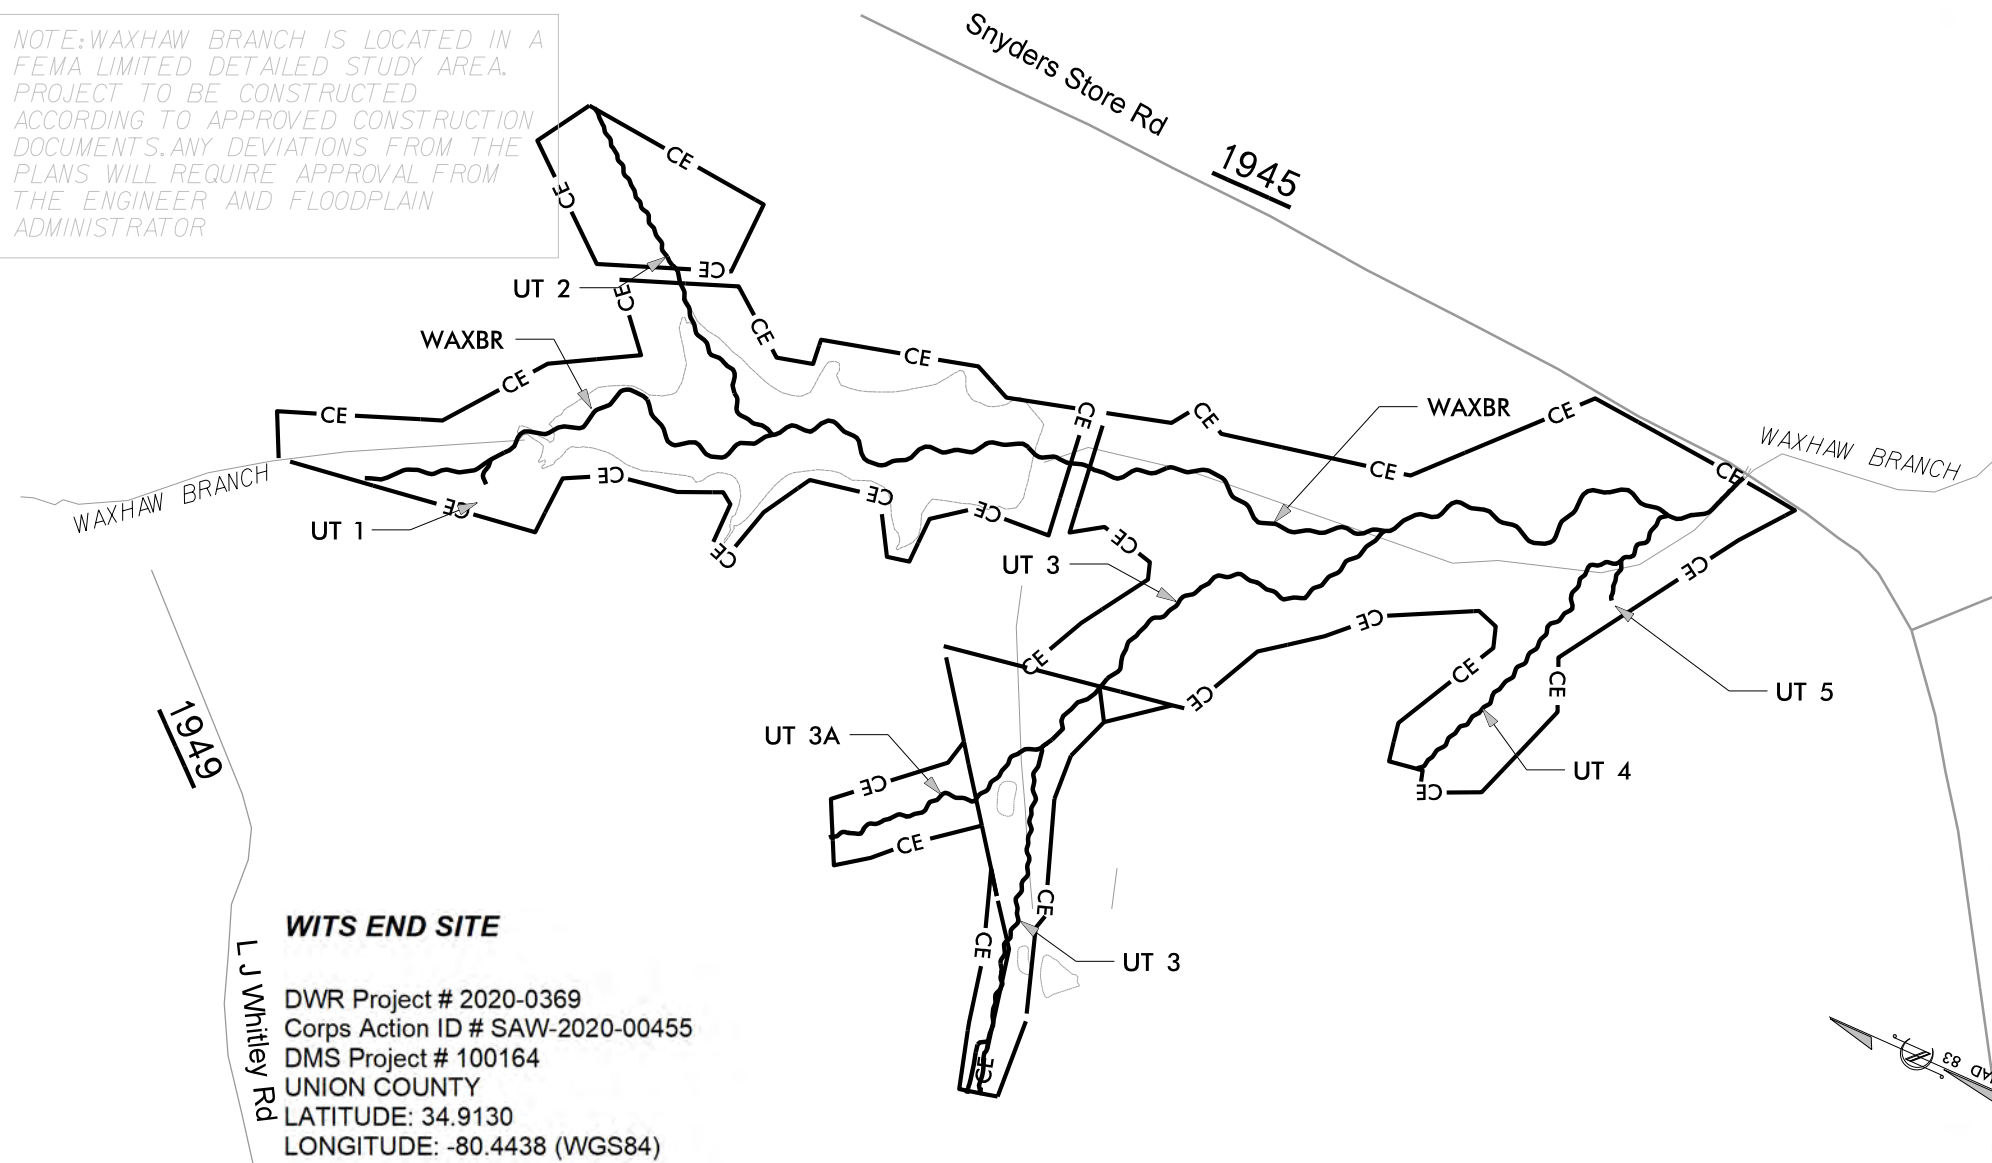

**WITS END SITE**

DWR Project # 2020-0369  
Corps Action ID # SAW-2020-00455  
DMS Project # 100164  
UNION COUNTY  
LATITUDE: 34.9130  
LONGITUDE: -80.4438 (WGS84)

**SURVEYORS CERTIFICATION(S)**

Surveyor's disclaimer: No attempt was made to locate any cemeteries, wetlands, hazardous material sites, underground utilities or any other features above, or below ground other than those shown. However, no visible evidence of cemeteries or utilities, aboveground or otherwise, was observed by the undersigned (other than those shown).

I certify that the survey is of an existing parcel or parcels of land or one or more existing easements and does not create a new street or change an existing street.


I JOHN A. RUDOLPH, certify that this plat was prepared under my supervision from an actual field survey made under my supervision, of as-built conditions.

That the boundaries not surveyed are clearly indicated as such and were plotted from information as referenced hereon; That the ratio of precision as calculated was 1:7,500+ and that the global navigational satellite system (GNSS) was used to perform this survey and the following information was used:

Class of Survey: CLASS B (HORIZONTAL) CLASS B (VERTICAL)  
Positional Accuracy: 0.12 feet (HORIZONTAL)  
Type of GPS field procedure: RTK  
Dates of survey: May and June 2022  
Datum/Epoch: NAD 1983(2011)  
Published/Fixed Control Use: OPUS  
Geoid Model: 2012B CONUS  
Combined Grid Factor: 0.99995565 GROUND TO GRID  
Units: US SURVEY FEET

That this plat meets the requirements of the standards of practice for land surveying in North Carolina. Witness my hand and seal this 29th day of July, 2022.

SEAL OR STAMP

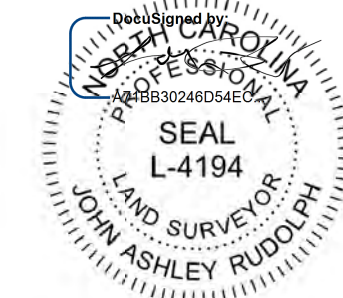

11/9/2022




Professional Land Surveyor

L-4194  
License Number



**CONTRACT: WITS END SITE**

**GRAPHIC SCALES**

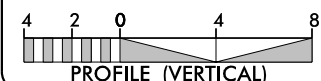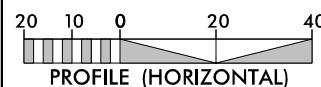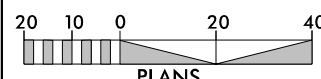


**Axiom Environmental**  
218 Snow Ave  
Raleigh, NC 27603

**GRANT LEWIS**  
PROJECT DESIGNER

**RESTORATION SYSTEMS, LLC**  
Restoration Systems  
1101 Haynes St.  
Suite 211  
Raleigh, NC 27604

**WORTH CREECH**  
SITE CONSTRUCTION MANAGER


DATE:

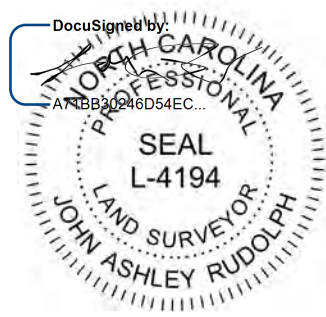

11/9/2022

DATE:

DOCUMENT NOT CONSIDERED FINAL  
UNLESS ALL SIGNATURES COMPLETED

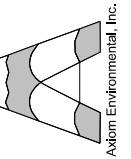








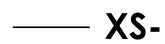

WITS END  
UNION COUNTY, NC  
AS-BUILT SYMBOLOGY

PROJECT # :  
1221-20024  
DRAWING NAME:  
WITS END PSH AB-C02  
DATE:  
2022  
DRAWN BY:  
JRH  
REVIEWED BY:  
JGD  
REVISIONS:



SHEET NO.  
AB-C02

© 2022 SUNGATE DESIGN GROUP, P.A. THIS DRAWING AND ALL REPRODUCTIONS OF IT ARE THE SOLE PROPERTY OF SDG. REPRODUCTION OR OTHER USES OF THIS DRAWING WITHOUT WRITTEN CONSENT OF SDG IS NOT PERMITTED.

**AS-BUILT:**

- Stream Centerline \_\_\_\_\_ 
- Stream Top of Bank \_\_\_\_\_ 
- Stream Gauge \_\_\_\_\_ 
- Groundwater Gauge \_\_\_\_\_ 
- Benthic & Water Quality Station \_\_\_\_\_ 
- Origin Point on CVS Plots \_\_\_\_\_ 
- CVS Plots \_\_\_\_\_ 
- Cross Section \_\_\_\_\_  **XS-10R**
- Adjusted Stream Structure \_\_\_\_\_ 



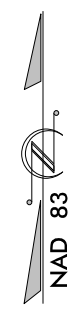
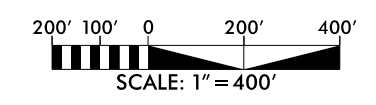


HORIZONTAL DATUM: NAD 83 (2011)  
VERTICAL DATUM: NAVD 1988

DocuSigned by:  
A71BB30246D54EC...

11/9/2022

**DATE:**  
**DOCUMENT NOT CONSIDERED FINAL  
UNLESS ALL SIGNATURES COMPLETED**

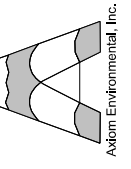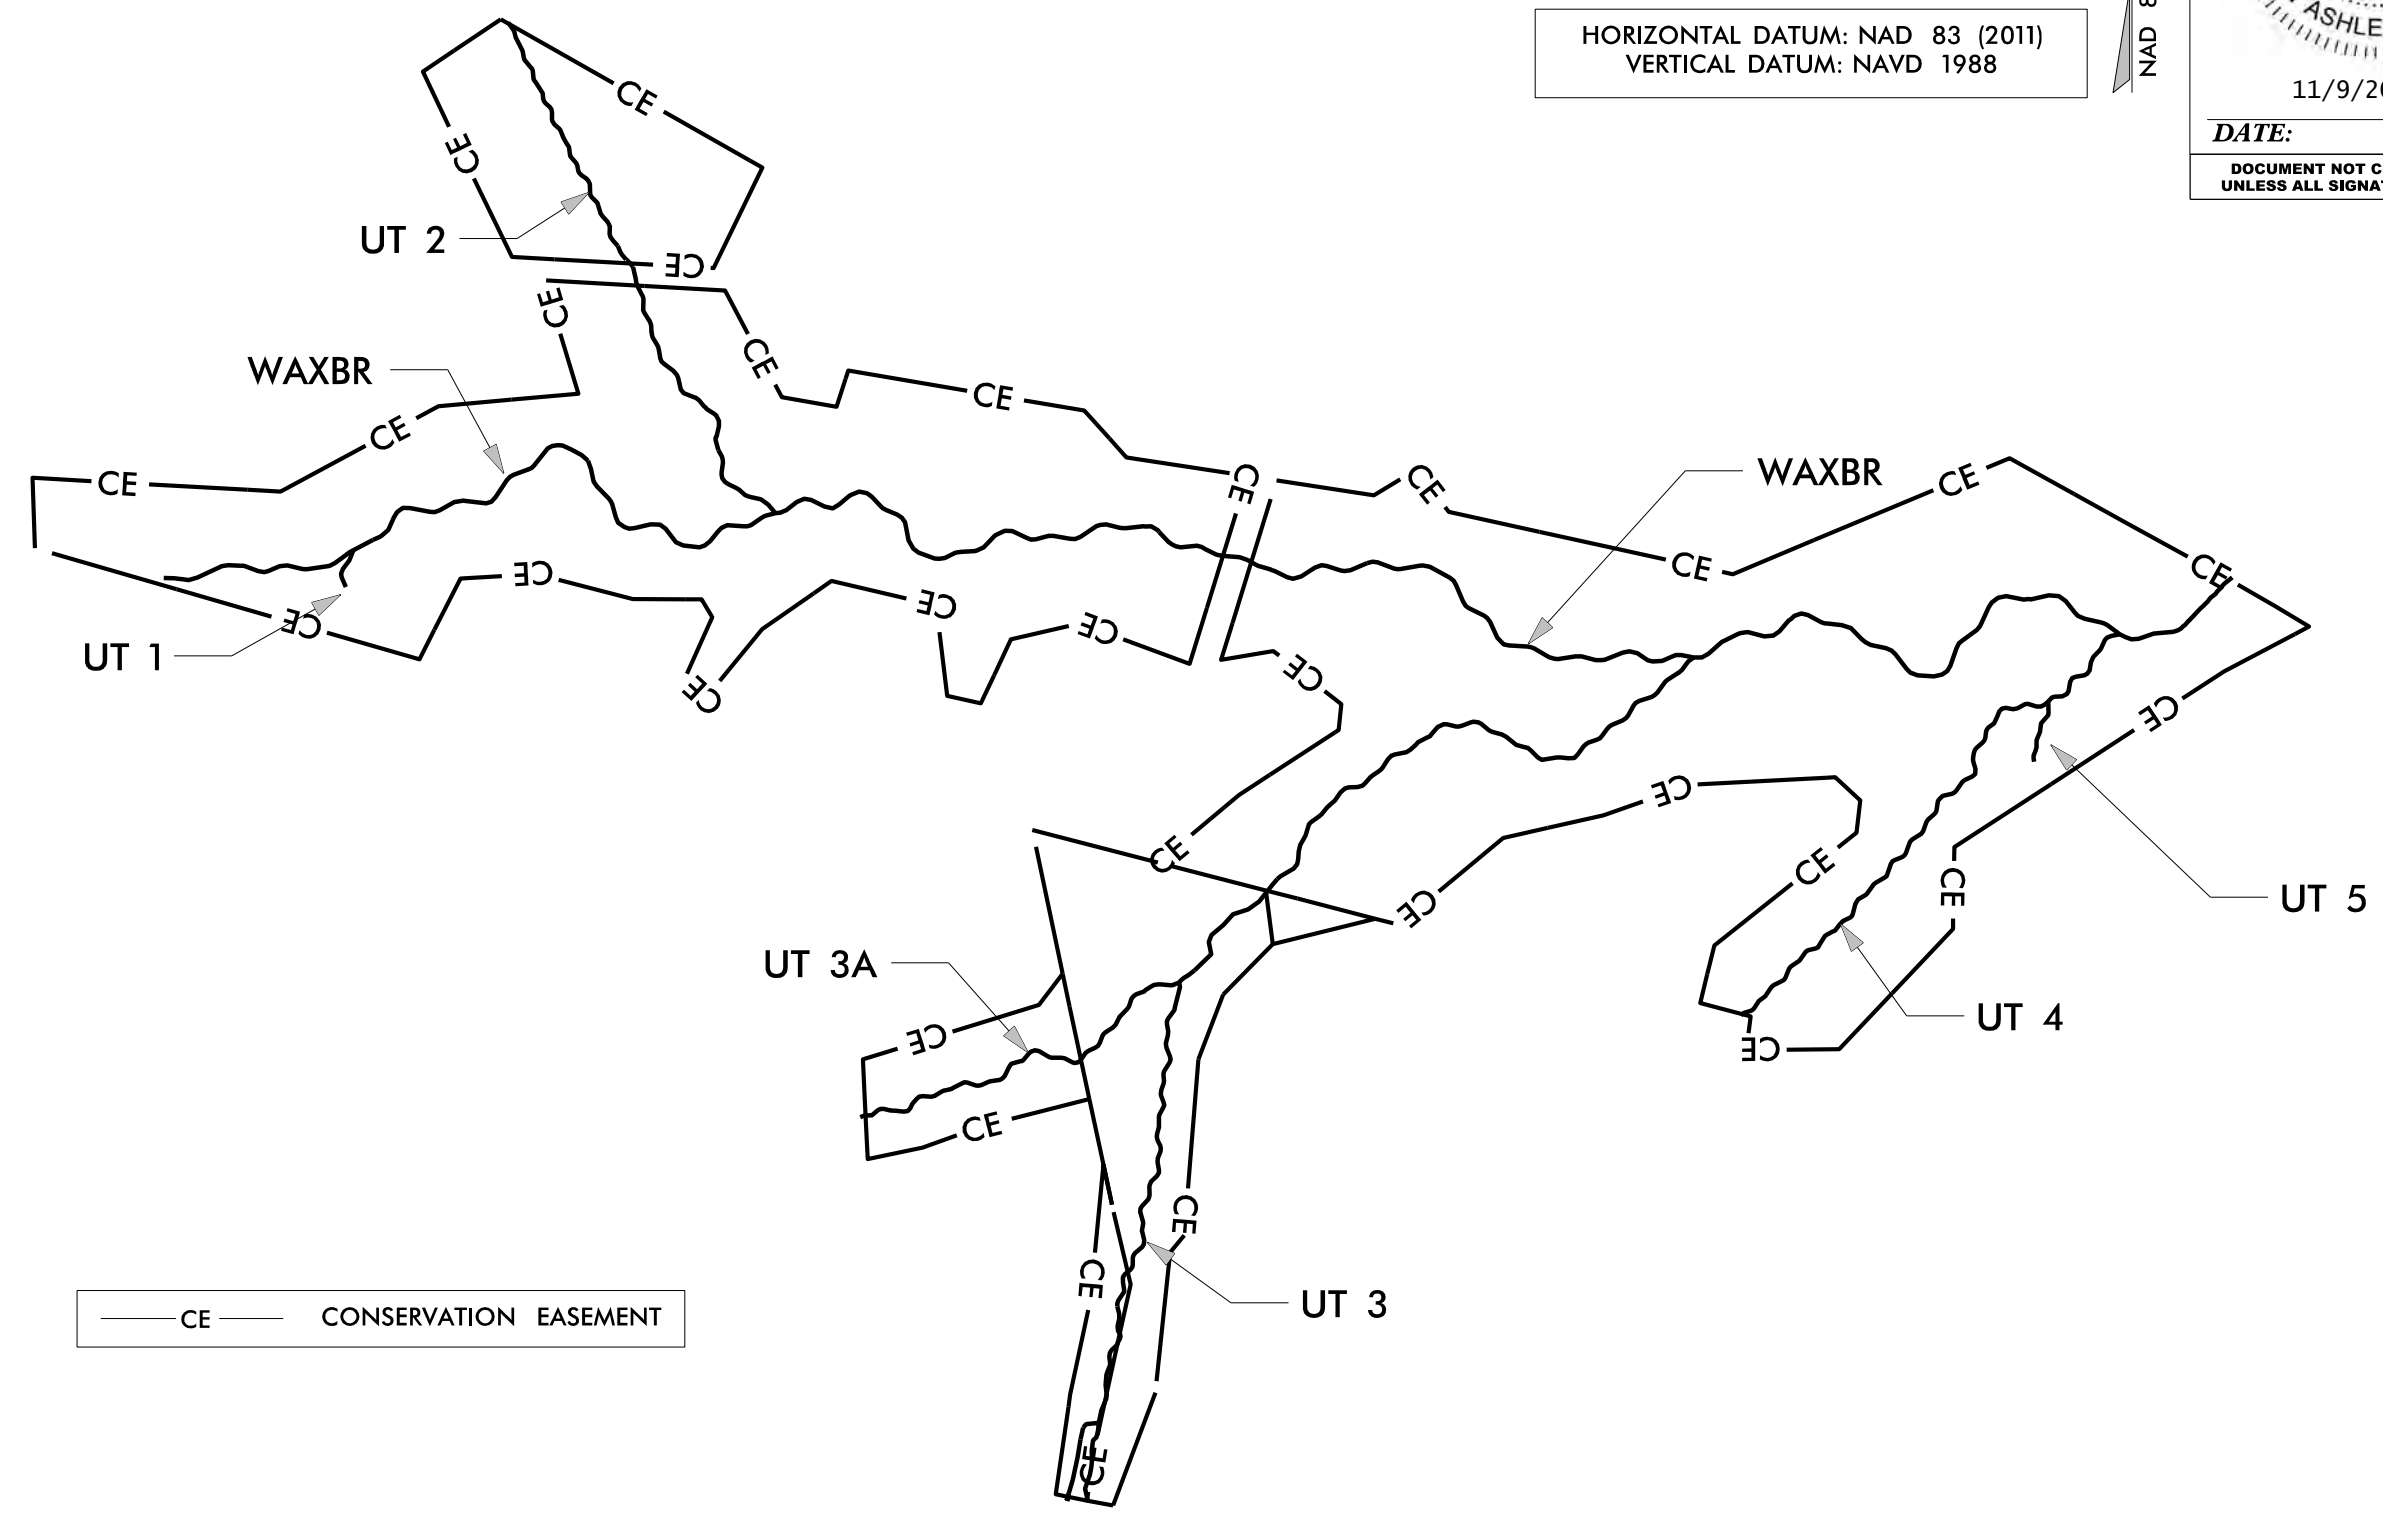


**WITS END**  
**UNION COUNTY, NC**  
**AS-BUILT EASEMENT**

PROJECT # :  
1221-20024  
DRAWING NAME:  
WITS END PSH AB-C03  
DATE:  
2022  
DRAWN BY:  
JRH  
REVIEWED BY:  
JGD  
REVISIONS:



SHEET NO.  
**AB-C03**

© 2022 SUNGATE DESIGN GROUP, P.A. THIS DRAWING AND ALL REPRODUCTIONS OF IT ARE THE SOLE PROPERTY OF SDG. REPRODUCTION OR OTHER USES OF THIS DRAWING WITHOUT WRITTEN CONSENT OF SDG IS NOT PERMITTED.


SURVEY INFORMATION PROPERTY/  
EASEMENT PROVIDED BY:  
CAROLINA SURVEYORS, INC.  
P.O. BOX 267  
PINEVILLE, NC 28134

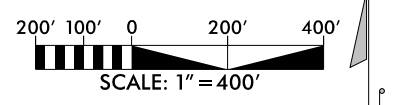

HORIZONTAL DATUM: NAD 83 (2011)  
VERTICAL DATUM: NAVD 1988

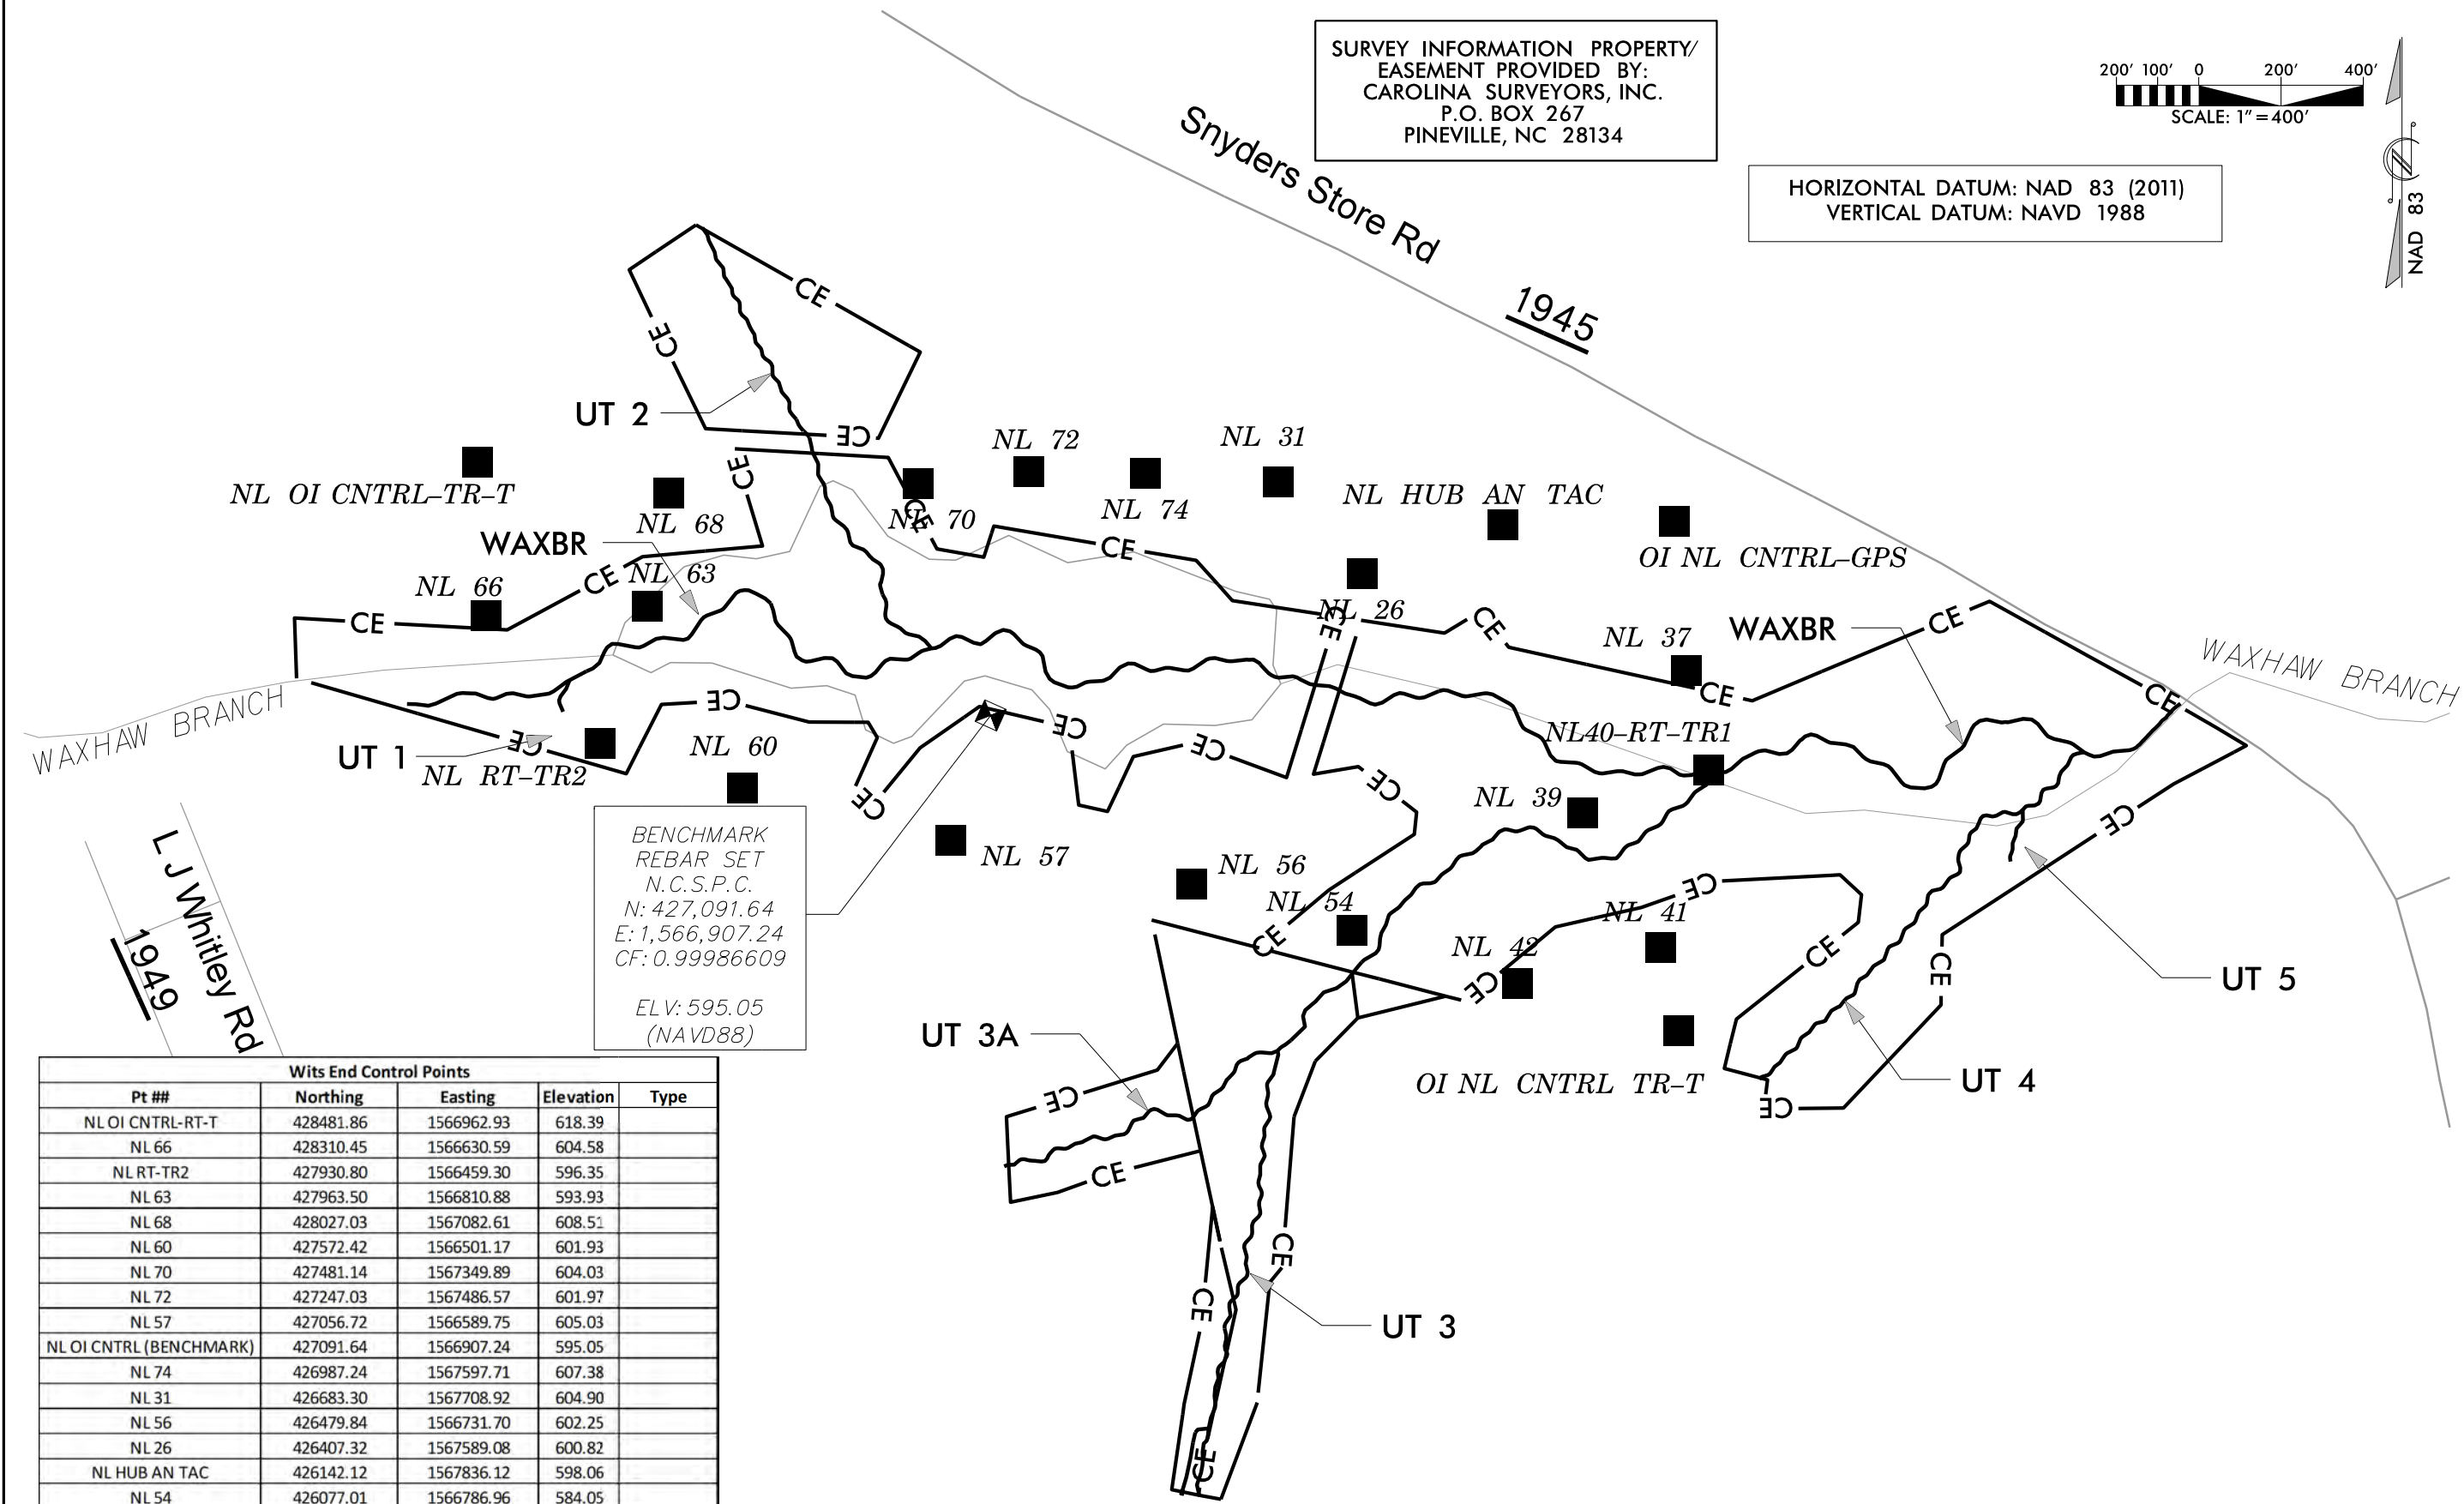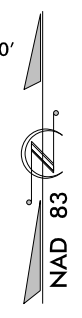

Wits End Control Points				
Pt ##	Northing	Easting	Elevation	Type
NLOI CNTRL-RT-T	428481.86	1566962.93	618.39	
NL 66	428310.45	1566630.59	604.58	
NL RT-TR2	427930.80	1566459.30	596.35	
NL 63	427963.50	1566810.88	593.93	
NL 68	428027.03	1567082.61	608.51	
NL 60	427572.42	1566501.17	601.93	
NL 70	427481.14	1567349.89	604.03	
NL 72	427247.03	1567486.57	601.97	
NL 57	427056.72	1566589.75	605.03	
NLOI CNTRL (BENCHMARK)	427091.64	1566907.24	595.05	
NL 74	426987.24	1567597.71	607.38	
NL 31	426683.30	1567708.92	604.90	
NL 56	426479.84	1566731.70	602.25	
NL 26	426407.32	1567589.08	600.82	
NL HUB AN TAC	426142.12	1567836.12	598.06	
NL 54	426077.01	1566786.96	584.05	
NL 42	425657.10	1566831.98	594.52	
NL 39	425679.88	1567275.35	579.53	
NL 37	425590.84	1567694.14	588.43	
OI NL CNTRL-GPS	425764.55	1568013.05	597.88	
NL 40-TR-TR1	425442.55	1567494.97	577.39	
OI NL CNTRL TR-T	425251.88	1566886.40	595.88	
NL 41	425375.02	1567052.63	593.65	

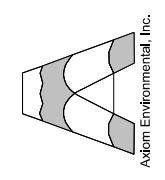



© 2022 SUNGATE DESIGN GROUP, P.A. THIS DRAWING AND ALL REPRODUCTIONS OF IT ARE THE SOLE PROPERTY OF SDG. REPRODUCTION OR OTHER USES OF THIS DRAWING WITHOUT WRITTEN CONSENT OF SDG IS NOT PERMITTED.

**WITS END**  
UNION COUNTY, NC  
**CONTROL POINTS**


PROJECT # : 1221-20024  
DRAWING NAME: WITS END PSH AB-C03A  
DATE: 2022  
DRAWN BY: JRH  
REVIEWED BY: JGD  
REVISIONS:

SHEET NO.  
**AB-C03A**

11/9/2022 Wits End\_psh\_AB-C03A.dgn

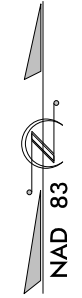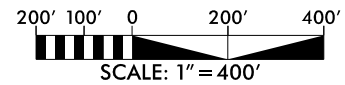


HORIZONTAL DATUM: NAD 83 (2011)  
VERTICAL DATUM: NAVD 1988

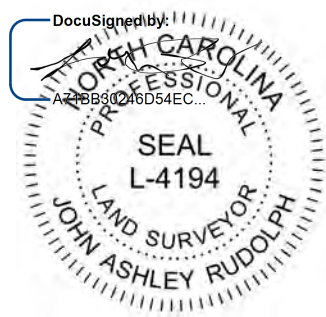


11/9/2022

**DATE:**  
**DOCUMENT NOT CONSIDERED FINAL  
UNLESS ALL SIGNATURES COMPLETED**

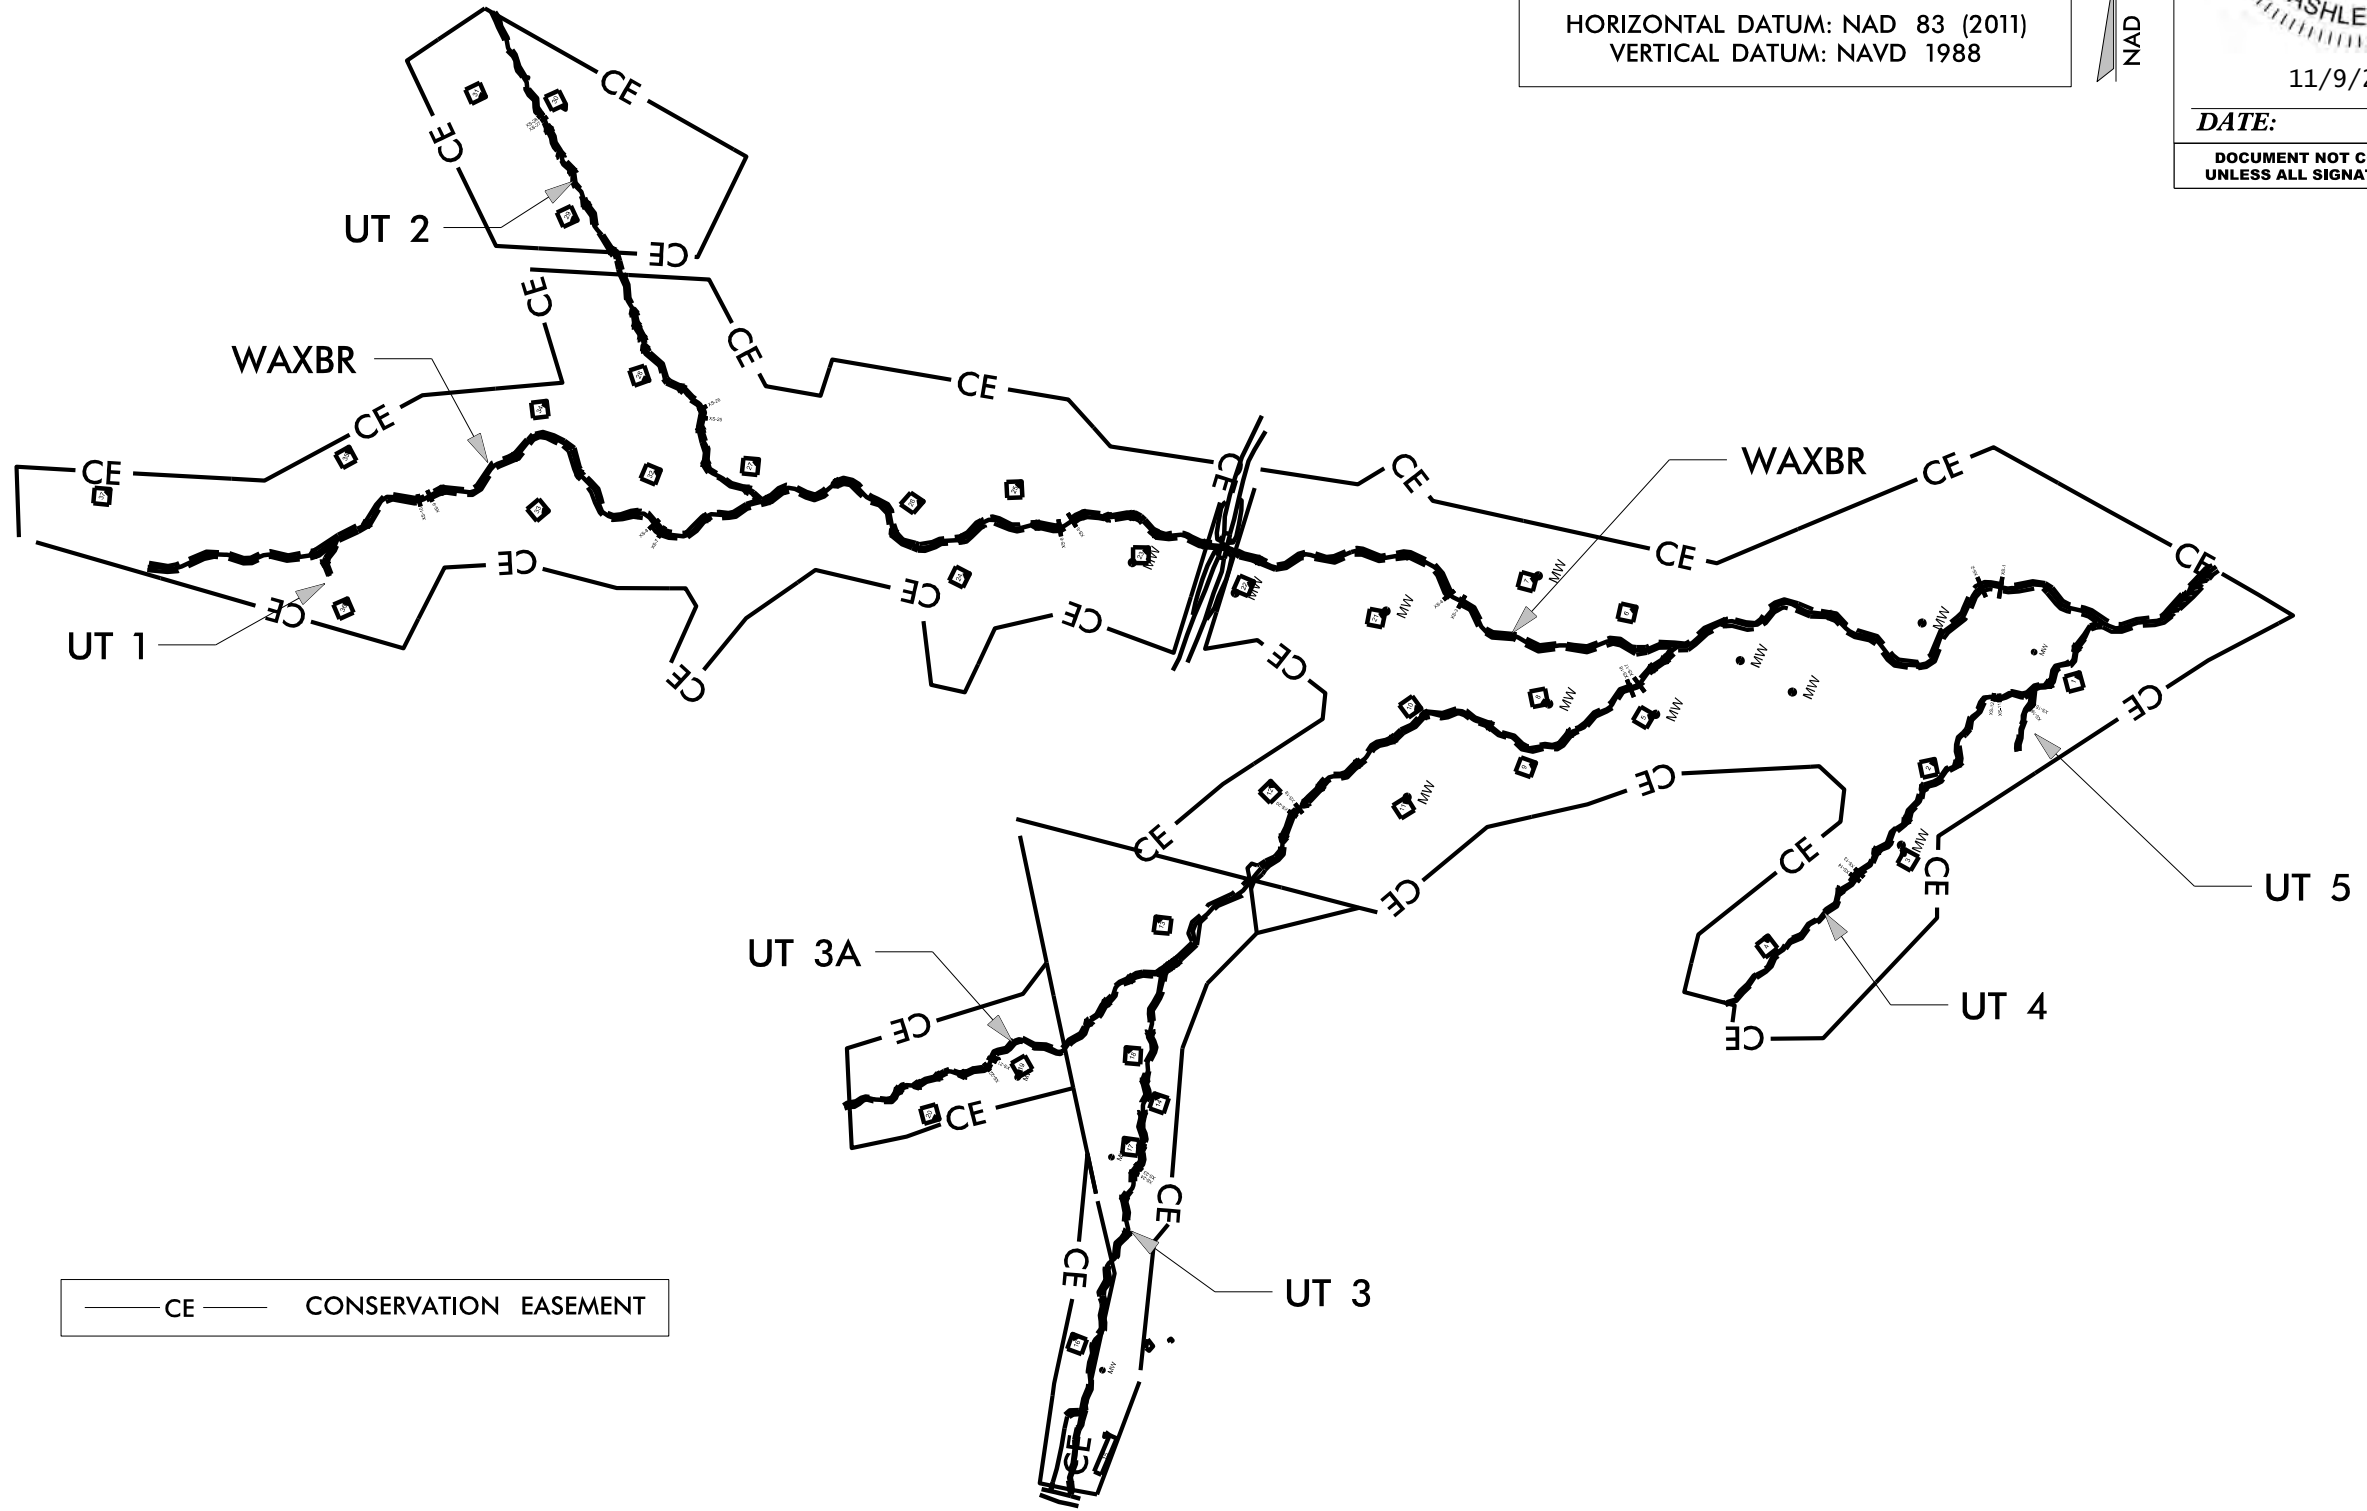

— CE — CONSERVATION EASEMENT

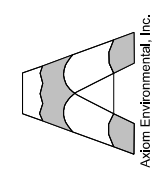




**WITS END**  
**UNION COUNTY, NC**  
**AS-BUILT SITE OVERVIEW**

PROJECT # :  
1221-20024  
DRAWING NAME:  
WITS END PSH AB-C03B  
DATE:  
2022  
DRAWN BY:  
JRH  
REVIEWED BY:  
JGD  
REVISIONS:

SHEET NO.  
**AB-C03B**


© 2022 SUNGATE DESIGN GROUP, P.A. THIS DRAWING AND ALL REPRODUCTIONS OF IT ARE THE SOLE PROPERTY OF SDG. REPRODUCTION OR OTHER USES OF THIS DRAWING WITHOUT WRITTEN CONSENT OF SDG IS NOT PERMITTED.



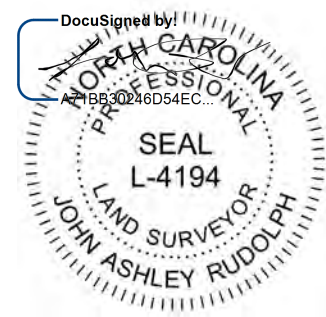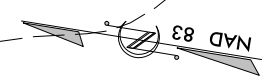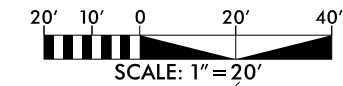


11/9/2022

DATE:  
DOCUMENT NOT CONSIDERED FINAL  
UNLESS ALL SIGNATURES COMPLETED

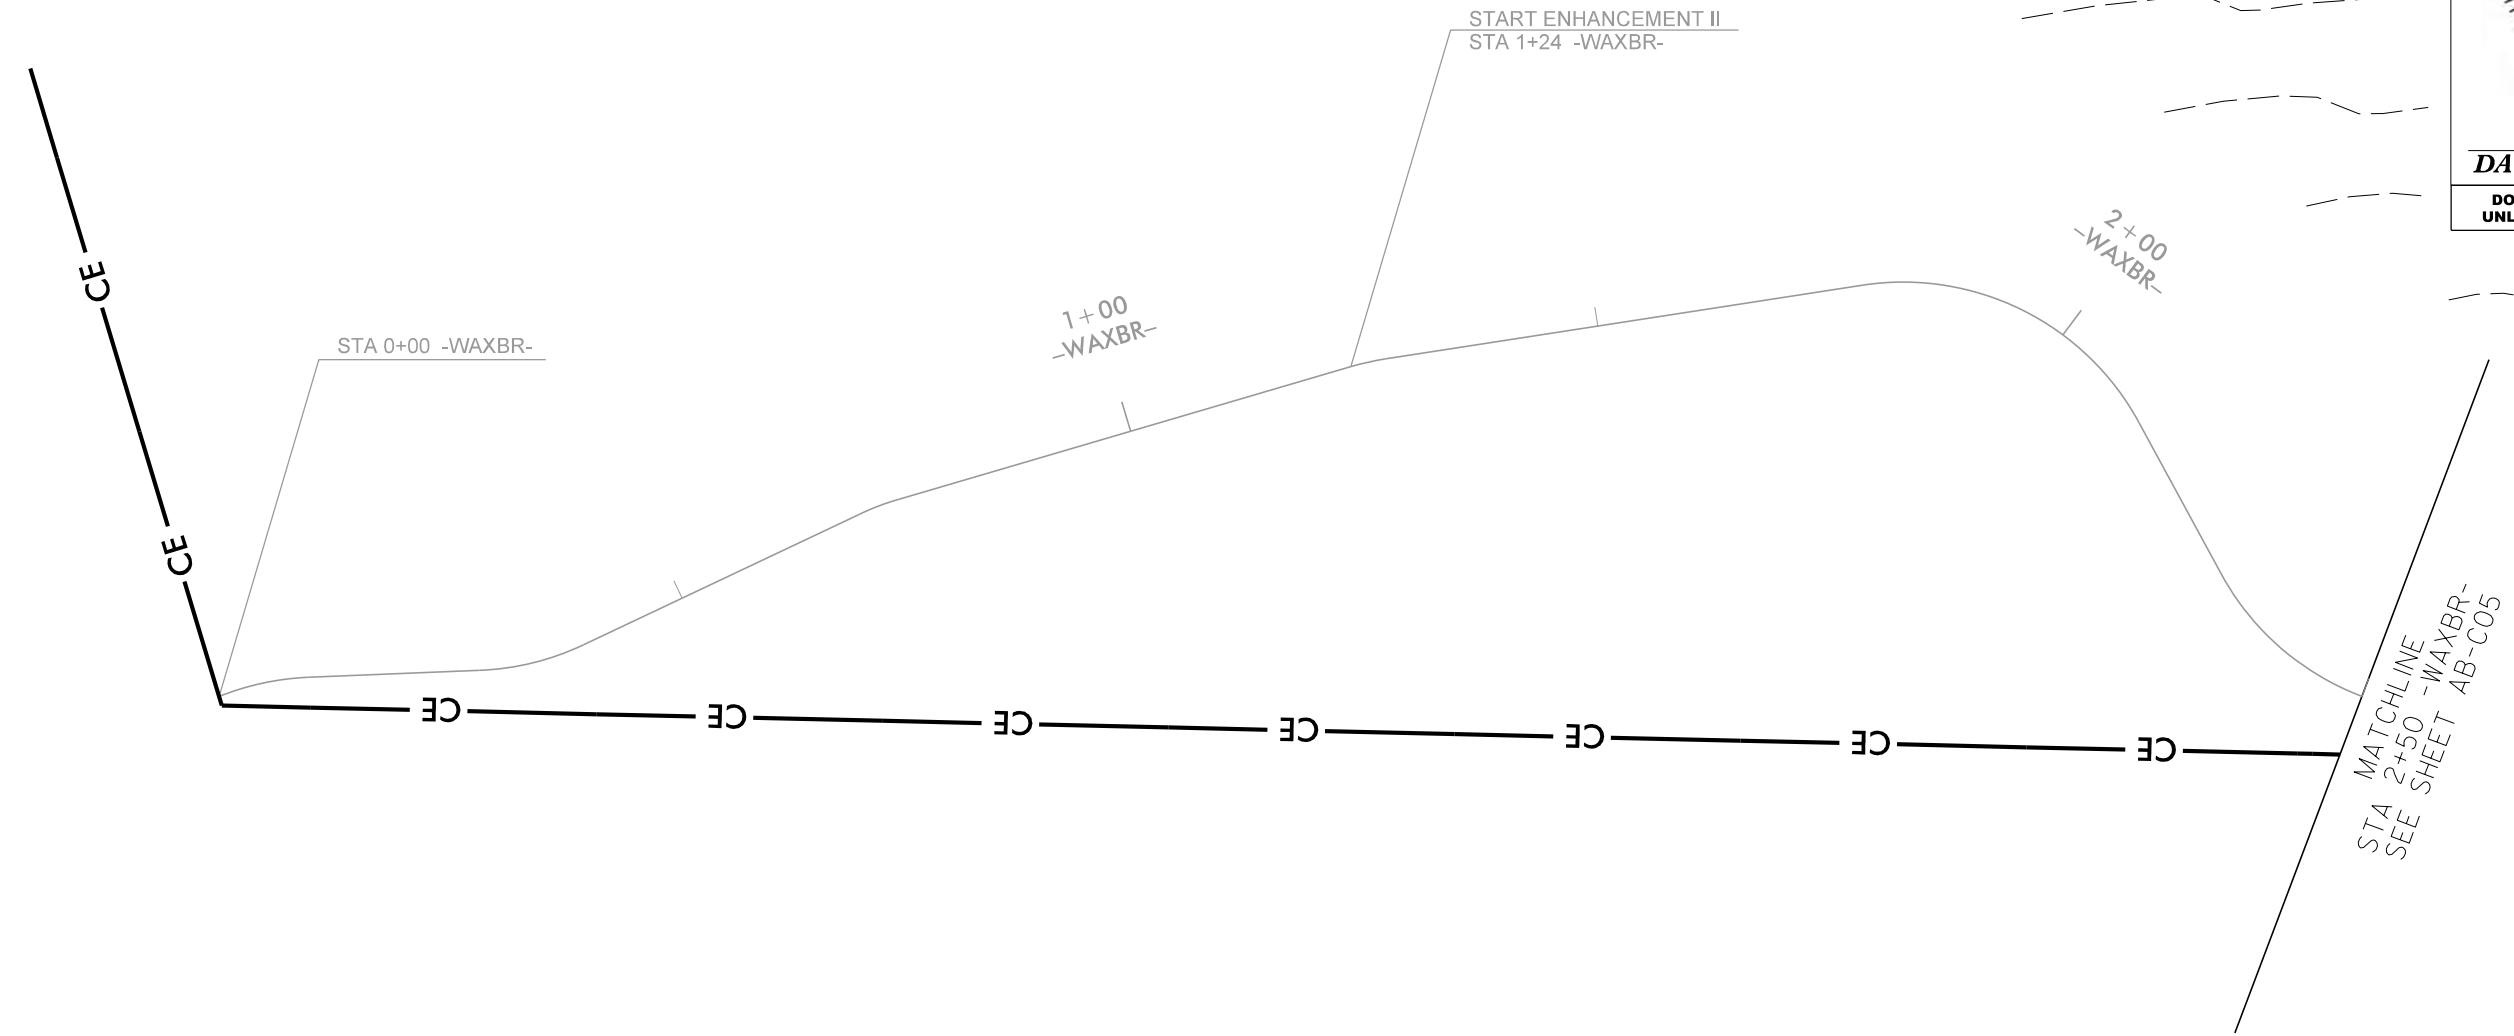

11/9/2022  
Wits\_End\_Psh\_AB-C04.dgn  
11/9/2022


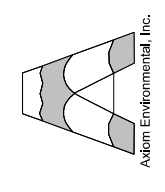


**WITS END**  
UNION COUNTY, NC  
**AS-BUILT SURVEY**

PROJECT # :  
1221-20024  
DRAWING NAME:  
WITS END PSH AB-C04  
DATE:  
2022  
DRAWN BY:  
JRH  
REVIEWED BY:  
JGD  
REVISIONS:



SHEET NO.  
**AB-C04**

© 2022 SUNGATE DESIGN GROUP, P.A. THIS DRAWING AND ALL REPRODUCTIONS OF IT ARE THE SOLE PROPERTY OF SDG. REPRODUCTION OR OTHER USES OF THIS DRAWING WITHOUT WRITTEN CONSENT OF SDG IS NOT PERMITTED.

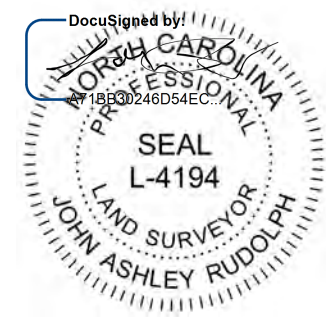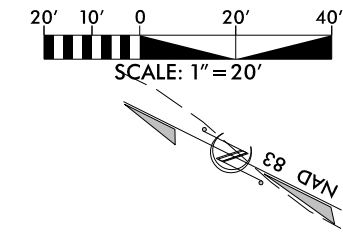


11/9/2022

**DATE:**  
**DOCUMENT NOT CONSIDERED FINAL UNLESS ALL SIGNATURES COMPLETED**

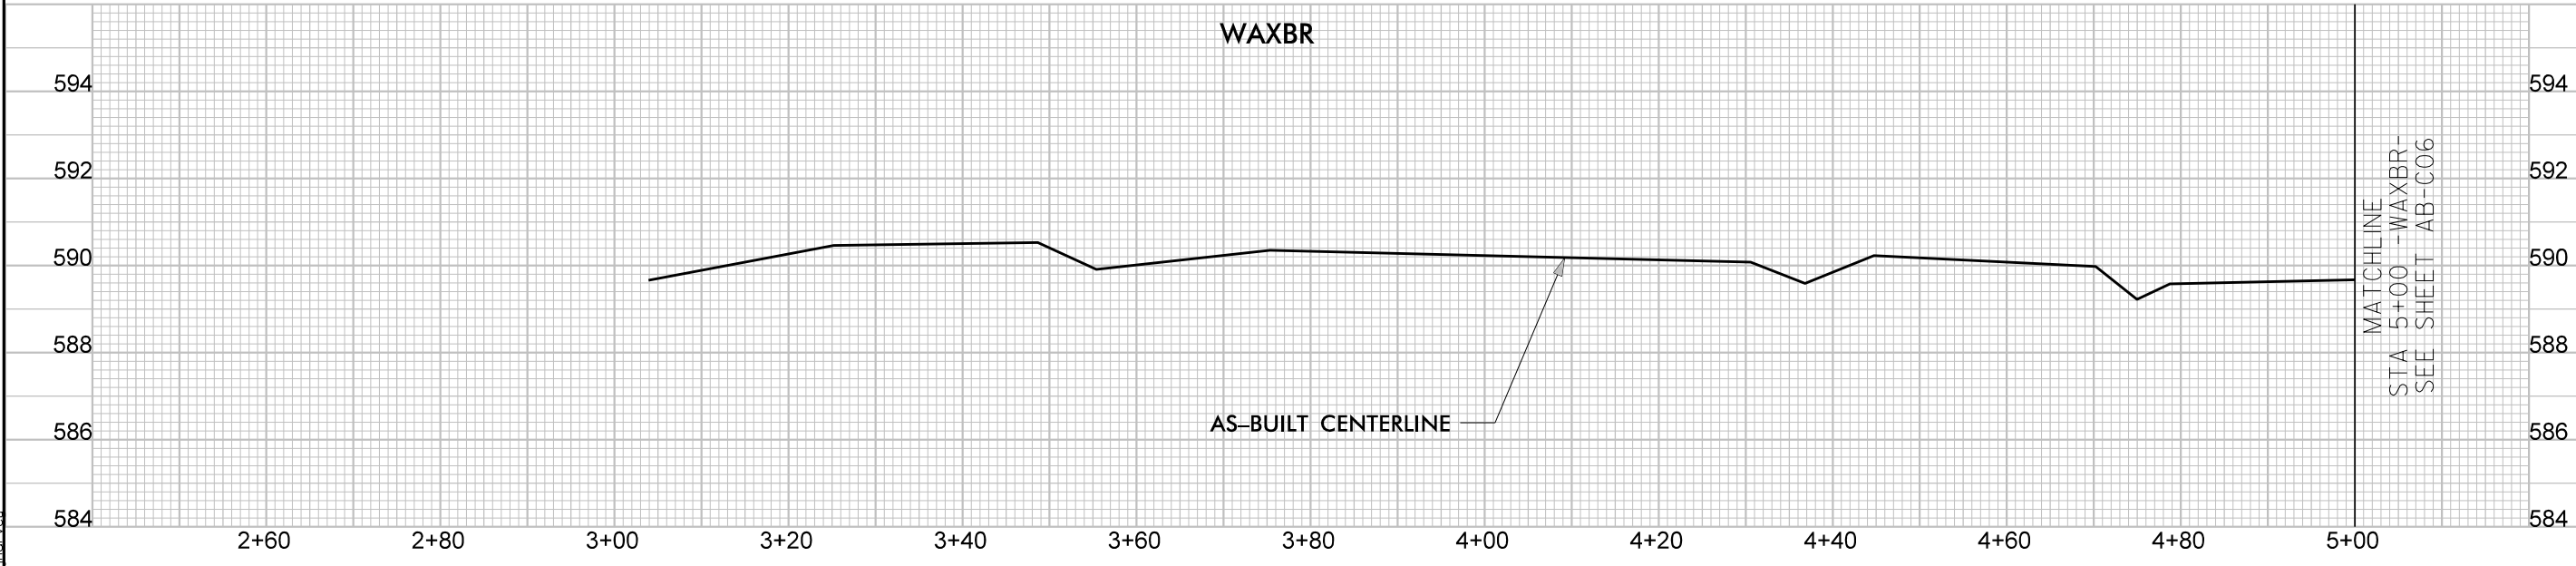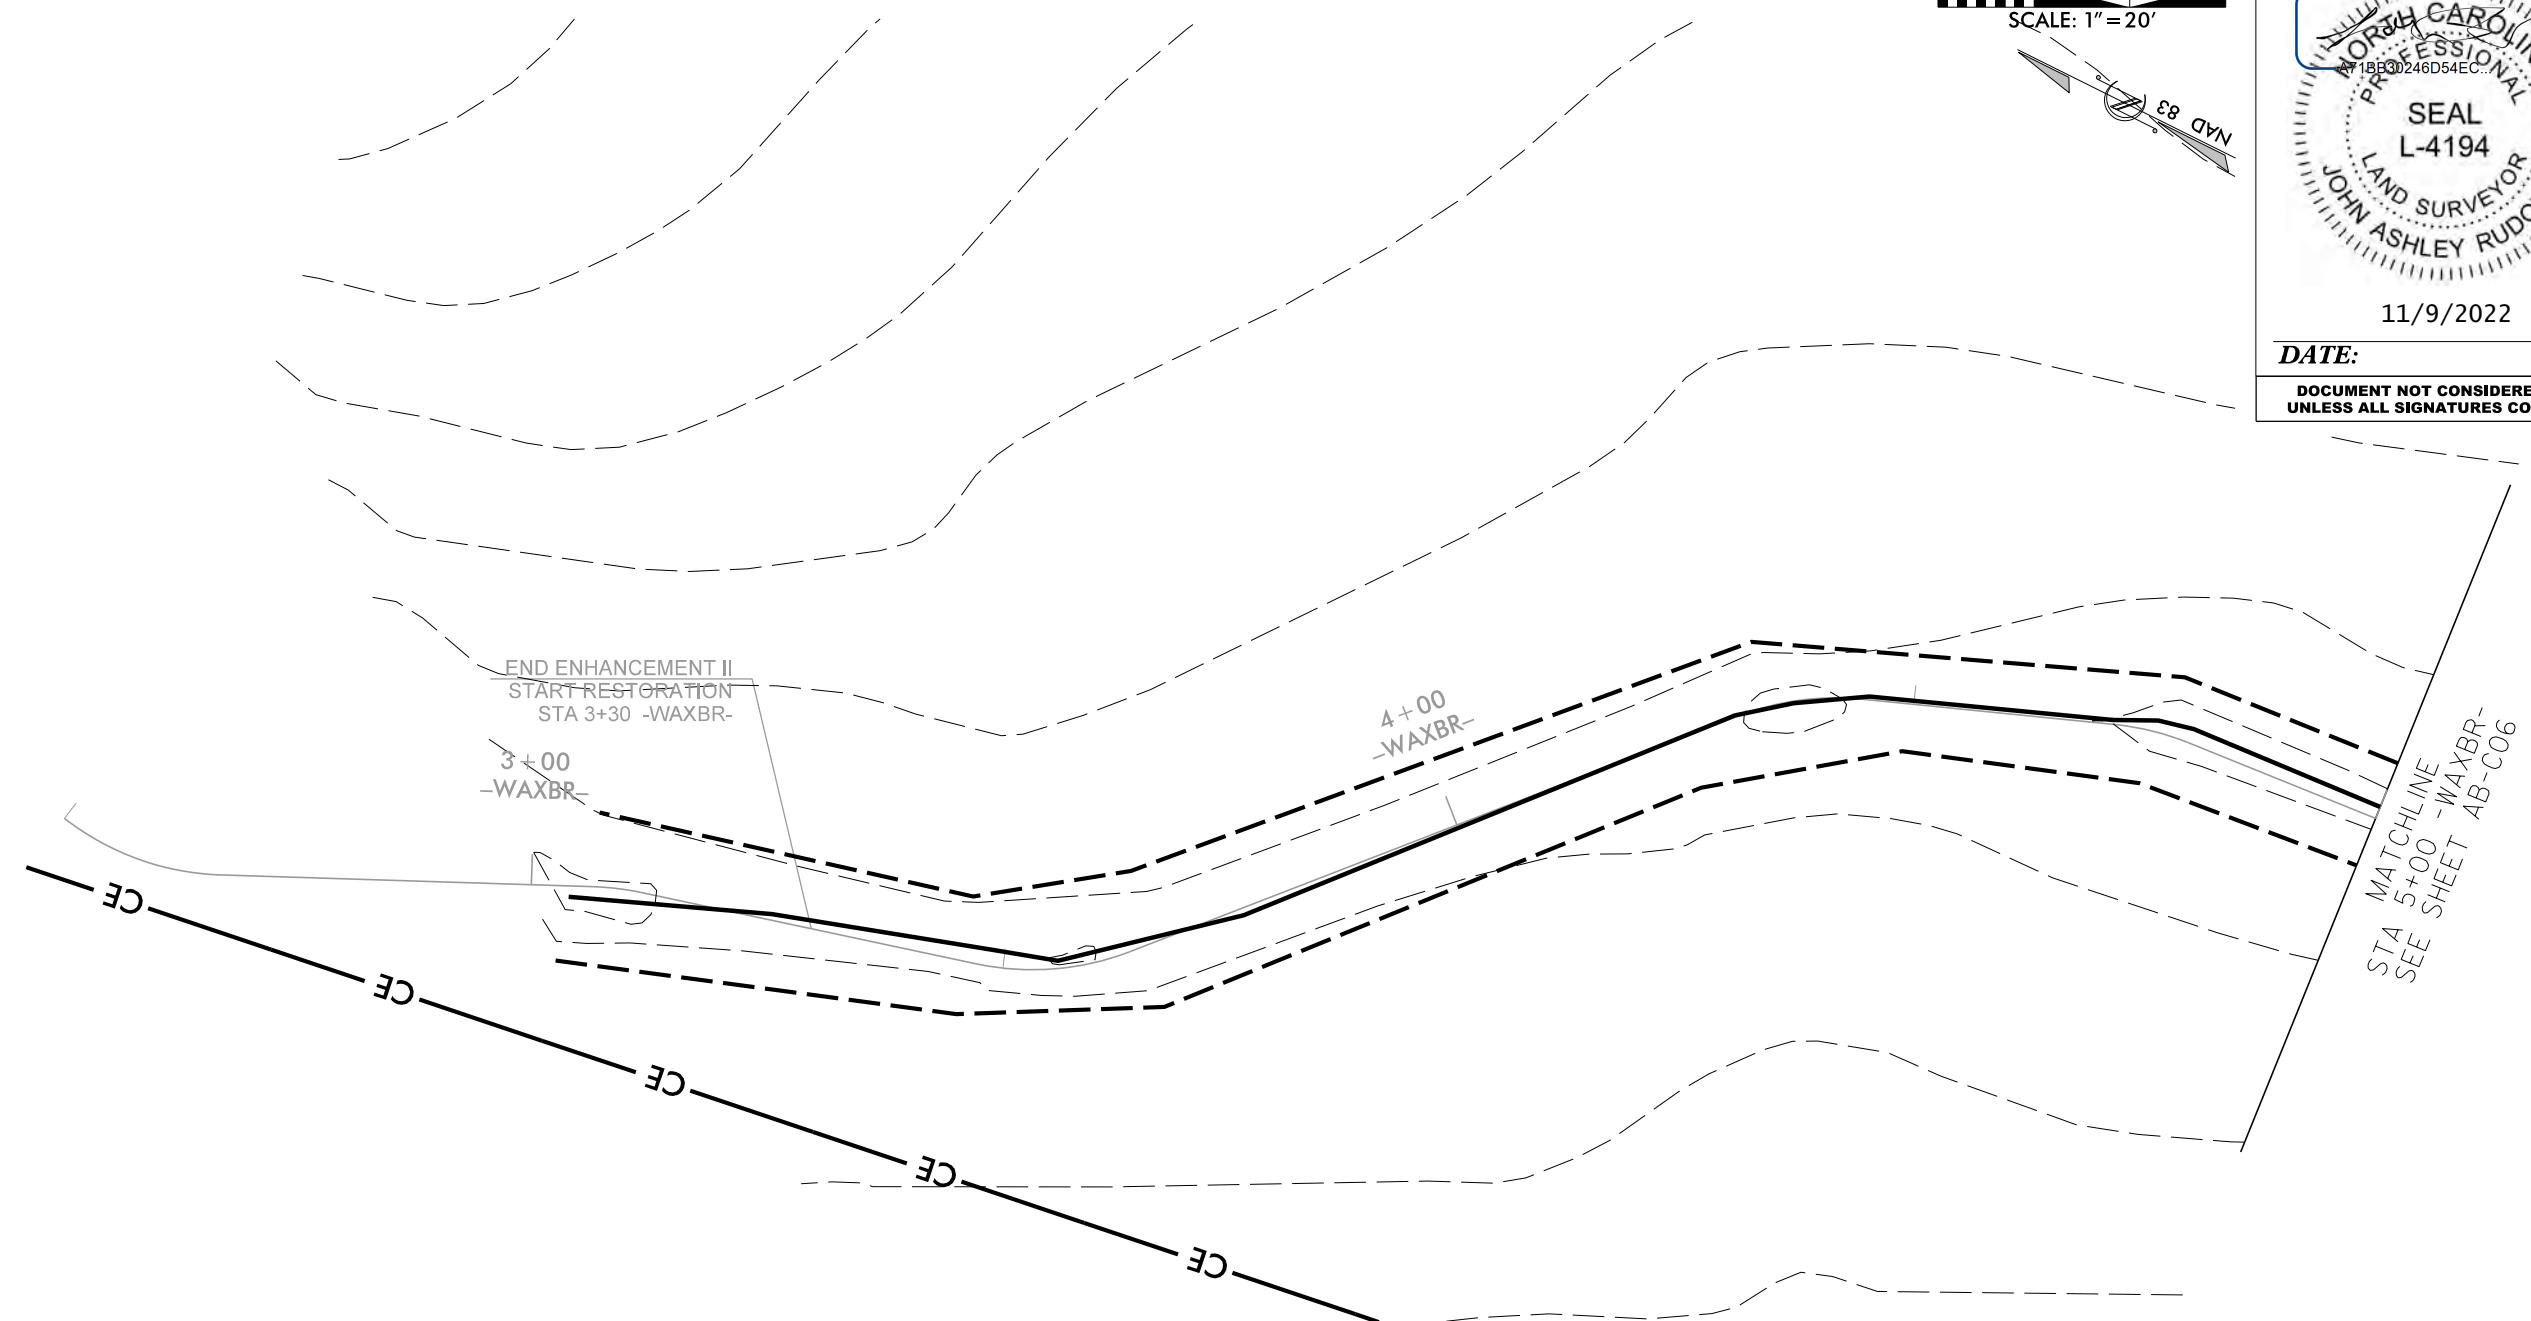

11/9/2022 Wits\_End\_Psh\_AB-C05.dgn


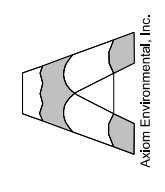


**WITS END**  
 UNION COUNTY, NC  
**AS-BUILT SURVEY**

PROJECT # : 1221-20024  
 DRAWING NAME: WITS END PSH AB-C05  
 DATE: 2022  
 DRAWN BY: JRH  
 REVIEWED BY: JGD  
 REVISIONS:


SHEET NO.  
**AB-C05**

© 2022 SUNGATE DESIGN GROUP, P.A. THIS DRAWING AND ALL REPRODUCTIONS OF IT ARE THE SOLE PROPERTY OF SDG. REPRODUCTION OR OTHER USES OF THIS DRAWING WITHOUT WRITTEN CONSENT OF SDG IS NOT PERMITTED.

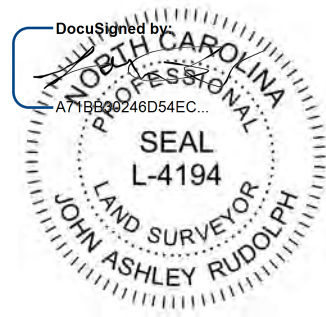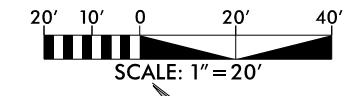



11/9/2022

DATE:  
DOCUMENT NOT CONSIDERED FINAL  
UNLESS ALL SIGNATURES COMPLETED

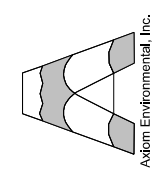

WITS END  
UNION COUNTY, NC  
AS-BUILT SURVEY


PROJECT # :  
1221-20024  
DRAWING NAME:  
WITS END PSH AB-C06  
DATE:  
2022  
DRAWN BY:  
JRH  
REVIEWED BY:  
JGD  
REVISIONS:  
SHEET NO.  
**AB-C06**

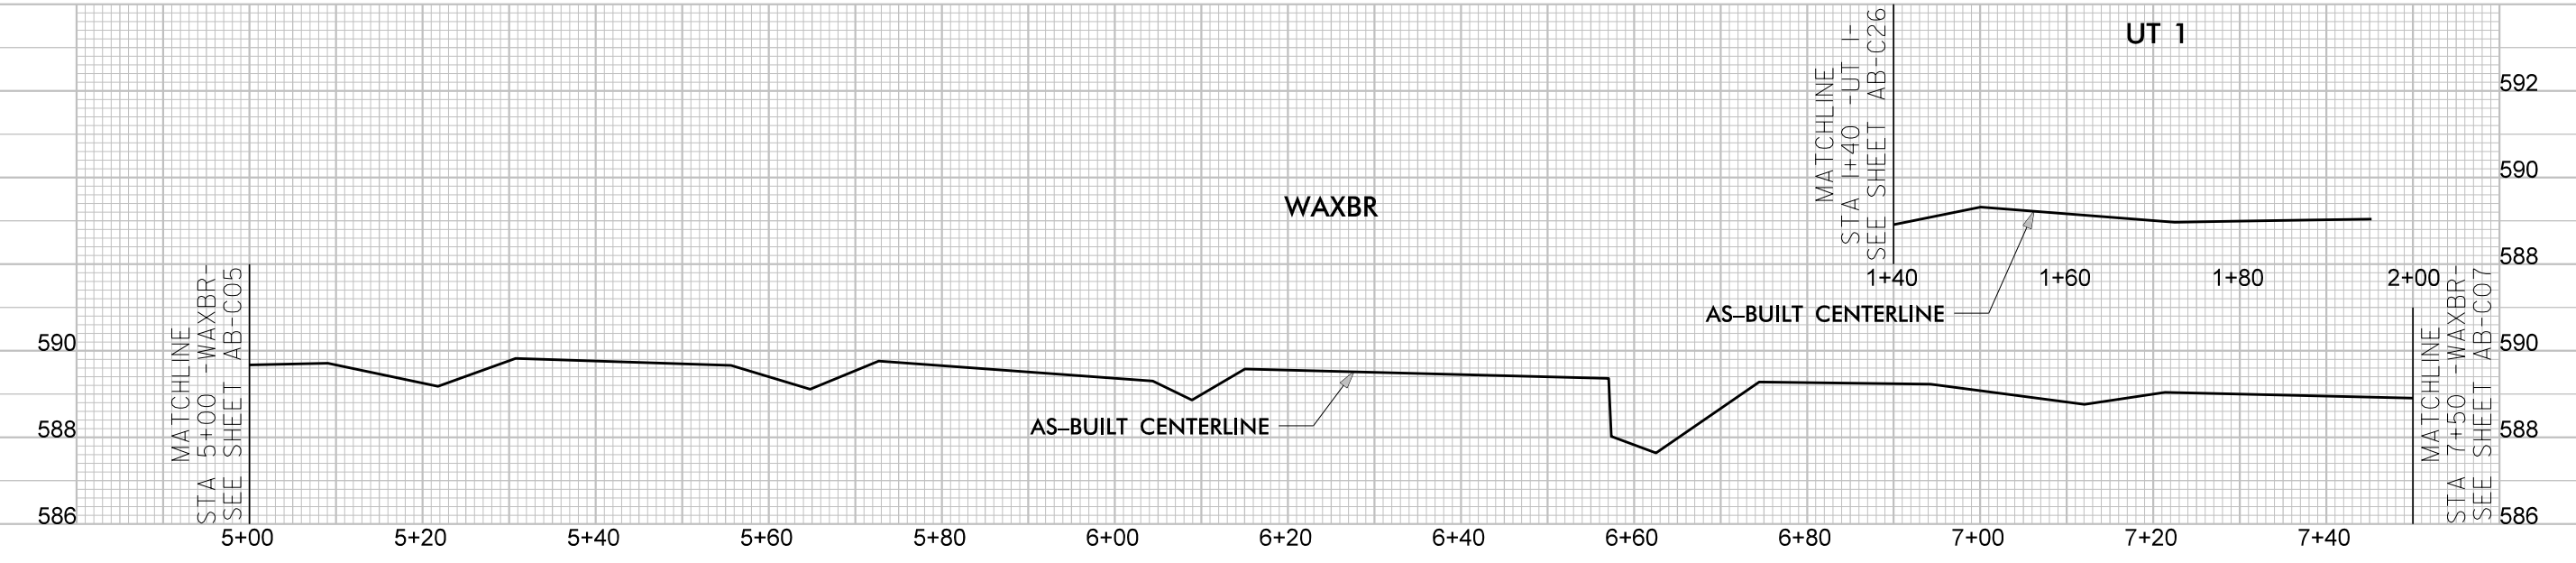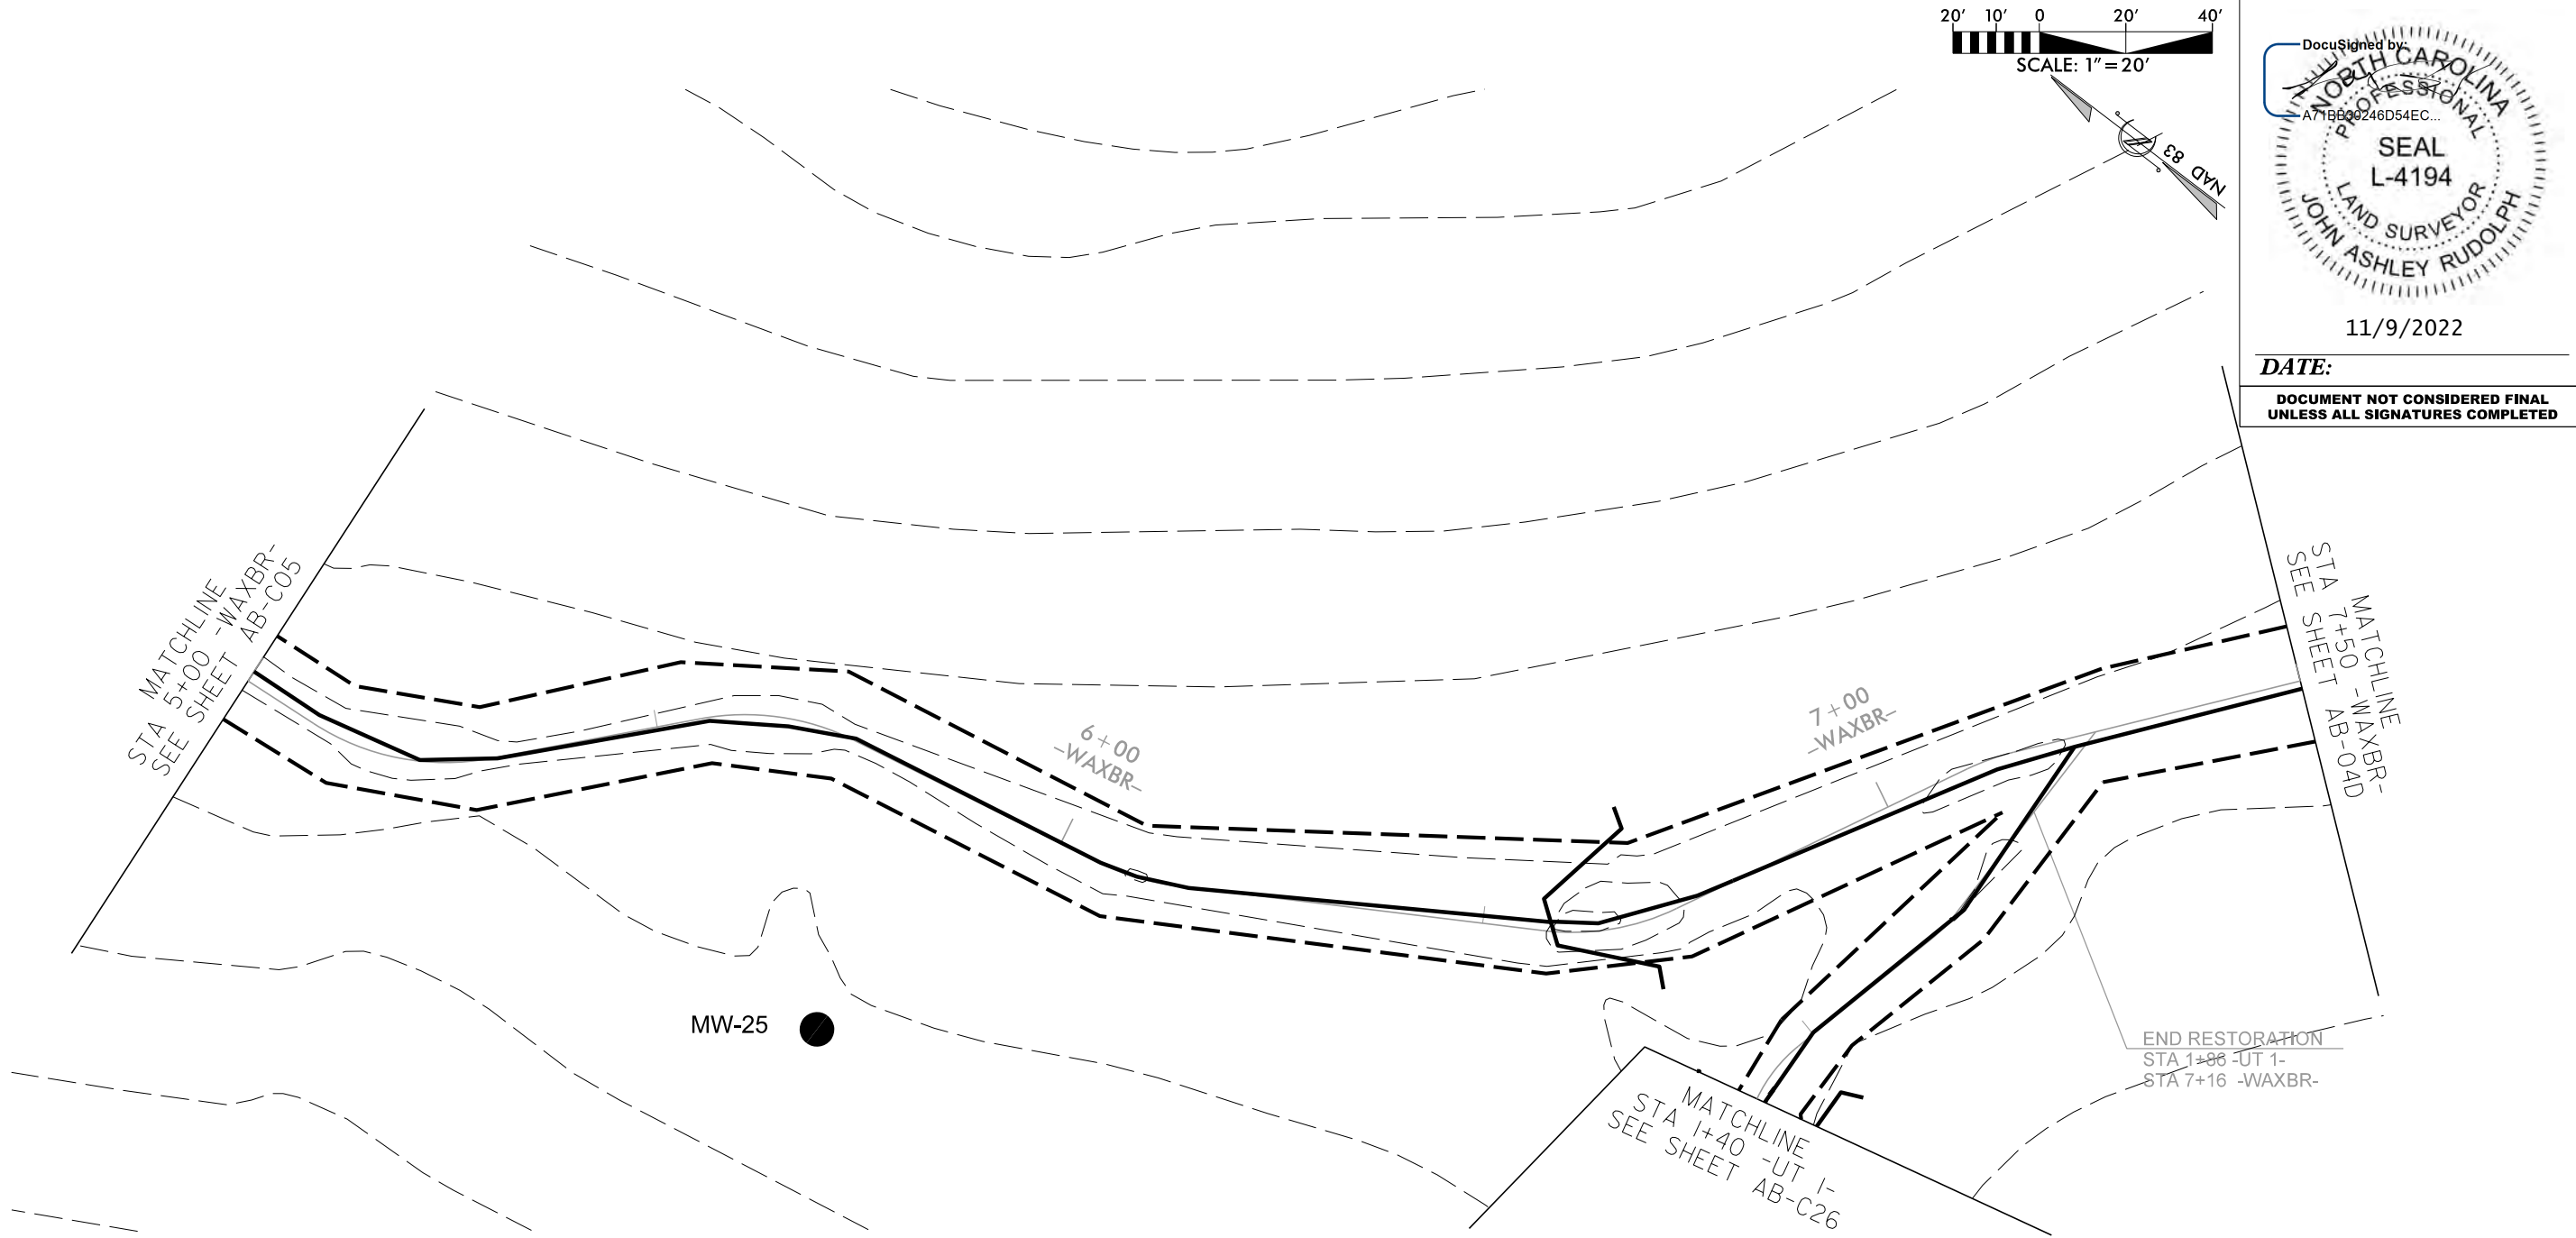

11/9/2022  
Wits\_End\_Psh\_AB-C06.dgn  
10:00 AM


© 2022 SUNGATE DESIGN GROUP, P.A. THIS DRAWING AND ALL REPRODUCTIONS OF IT ARE THE SOLE PROPERTY OF SDG. REPRODUCTION OR OTHER USES OF THIS DRAWING WITHOUT WRITTEN CONSENT OF SDG IS NOT PERMITTED.



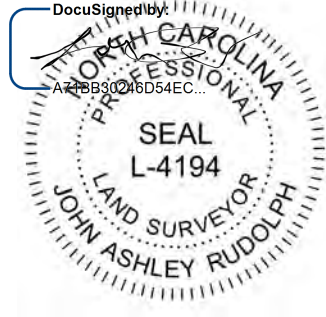

DATE: 11/9/2022

DOCUMENT NOT CONSIDERED FINAL UNLESS ALL SIGNATURES COMPLETED


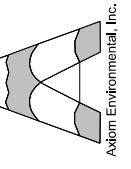


© 2022 SUNGATE DESIGN GROUP, P.A. THIS DRAWING AND ALL REPRODUCTIONS OF IT ARE THE SOLE PROPERTY OF SDG. REPRODUCTION OR OTHER USES OF THIS DRAWING WITHOUT WRITTEN CONSENT OF SDG IS NOT PERMITTED.




WITS END UNION COUNTY, NC AS-BUILT SURVEY

PROJECT #: 1221-20024  
DRAWING NAME: WITS END PSH AB-C07  
DATE: 2022  
DRAWN BY: JRH  
REVIEWED BY: JGD  
REVISIONS:

SHEET NO. AB-C07

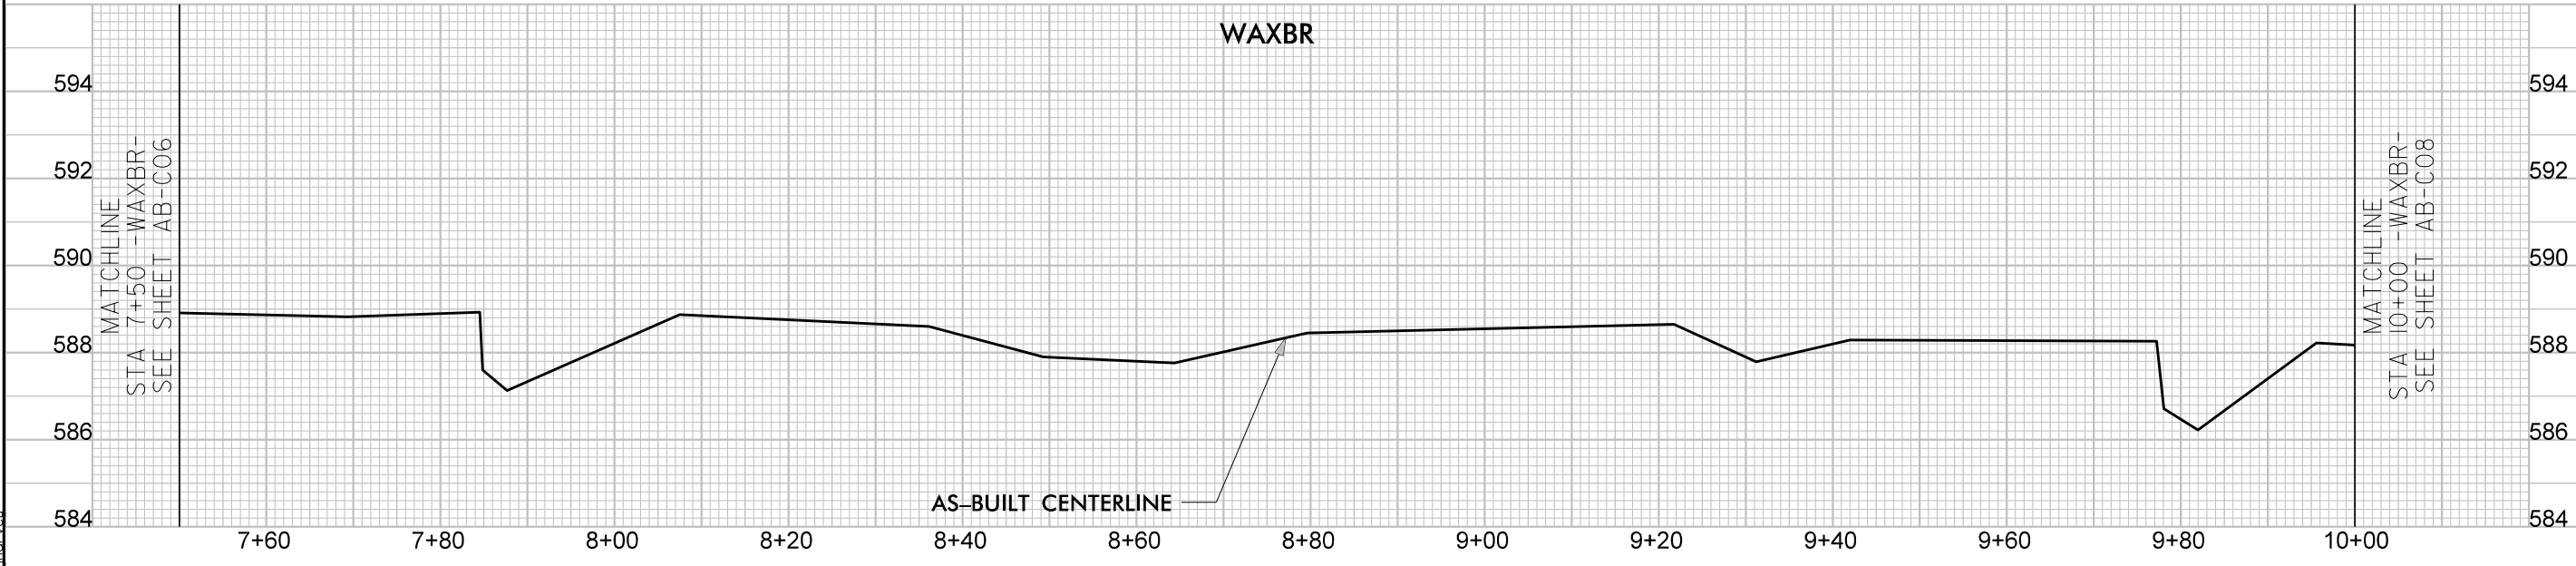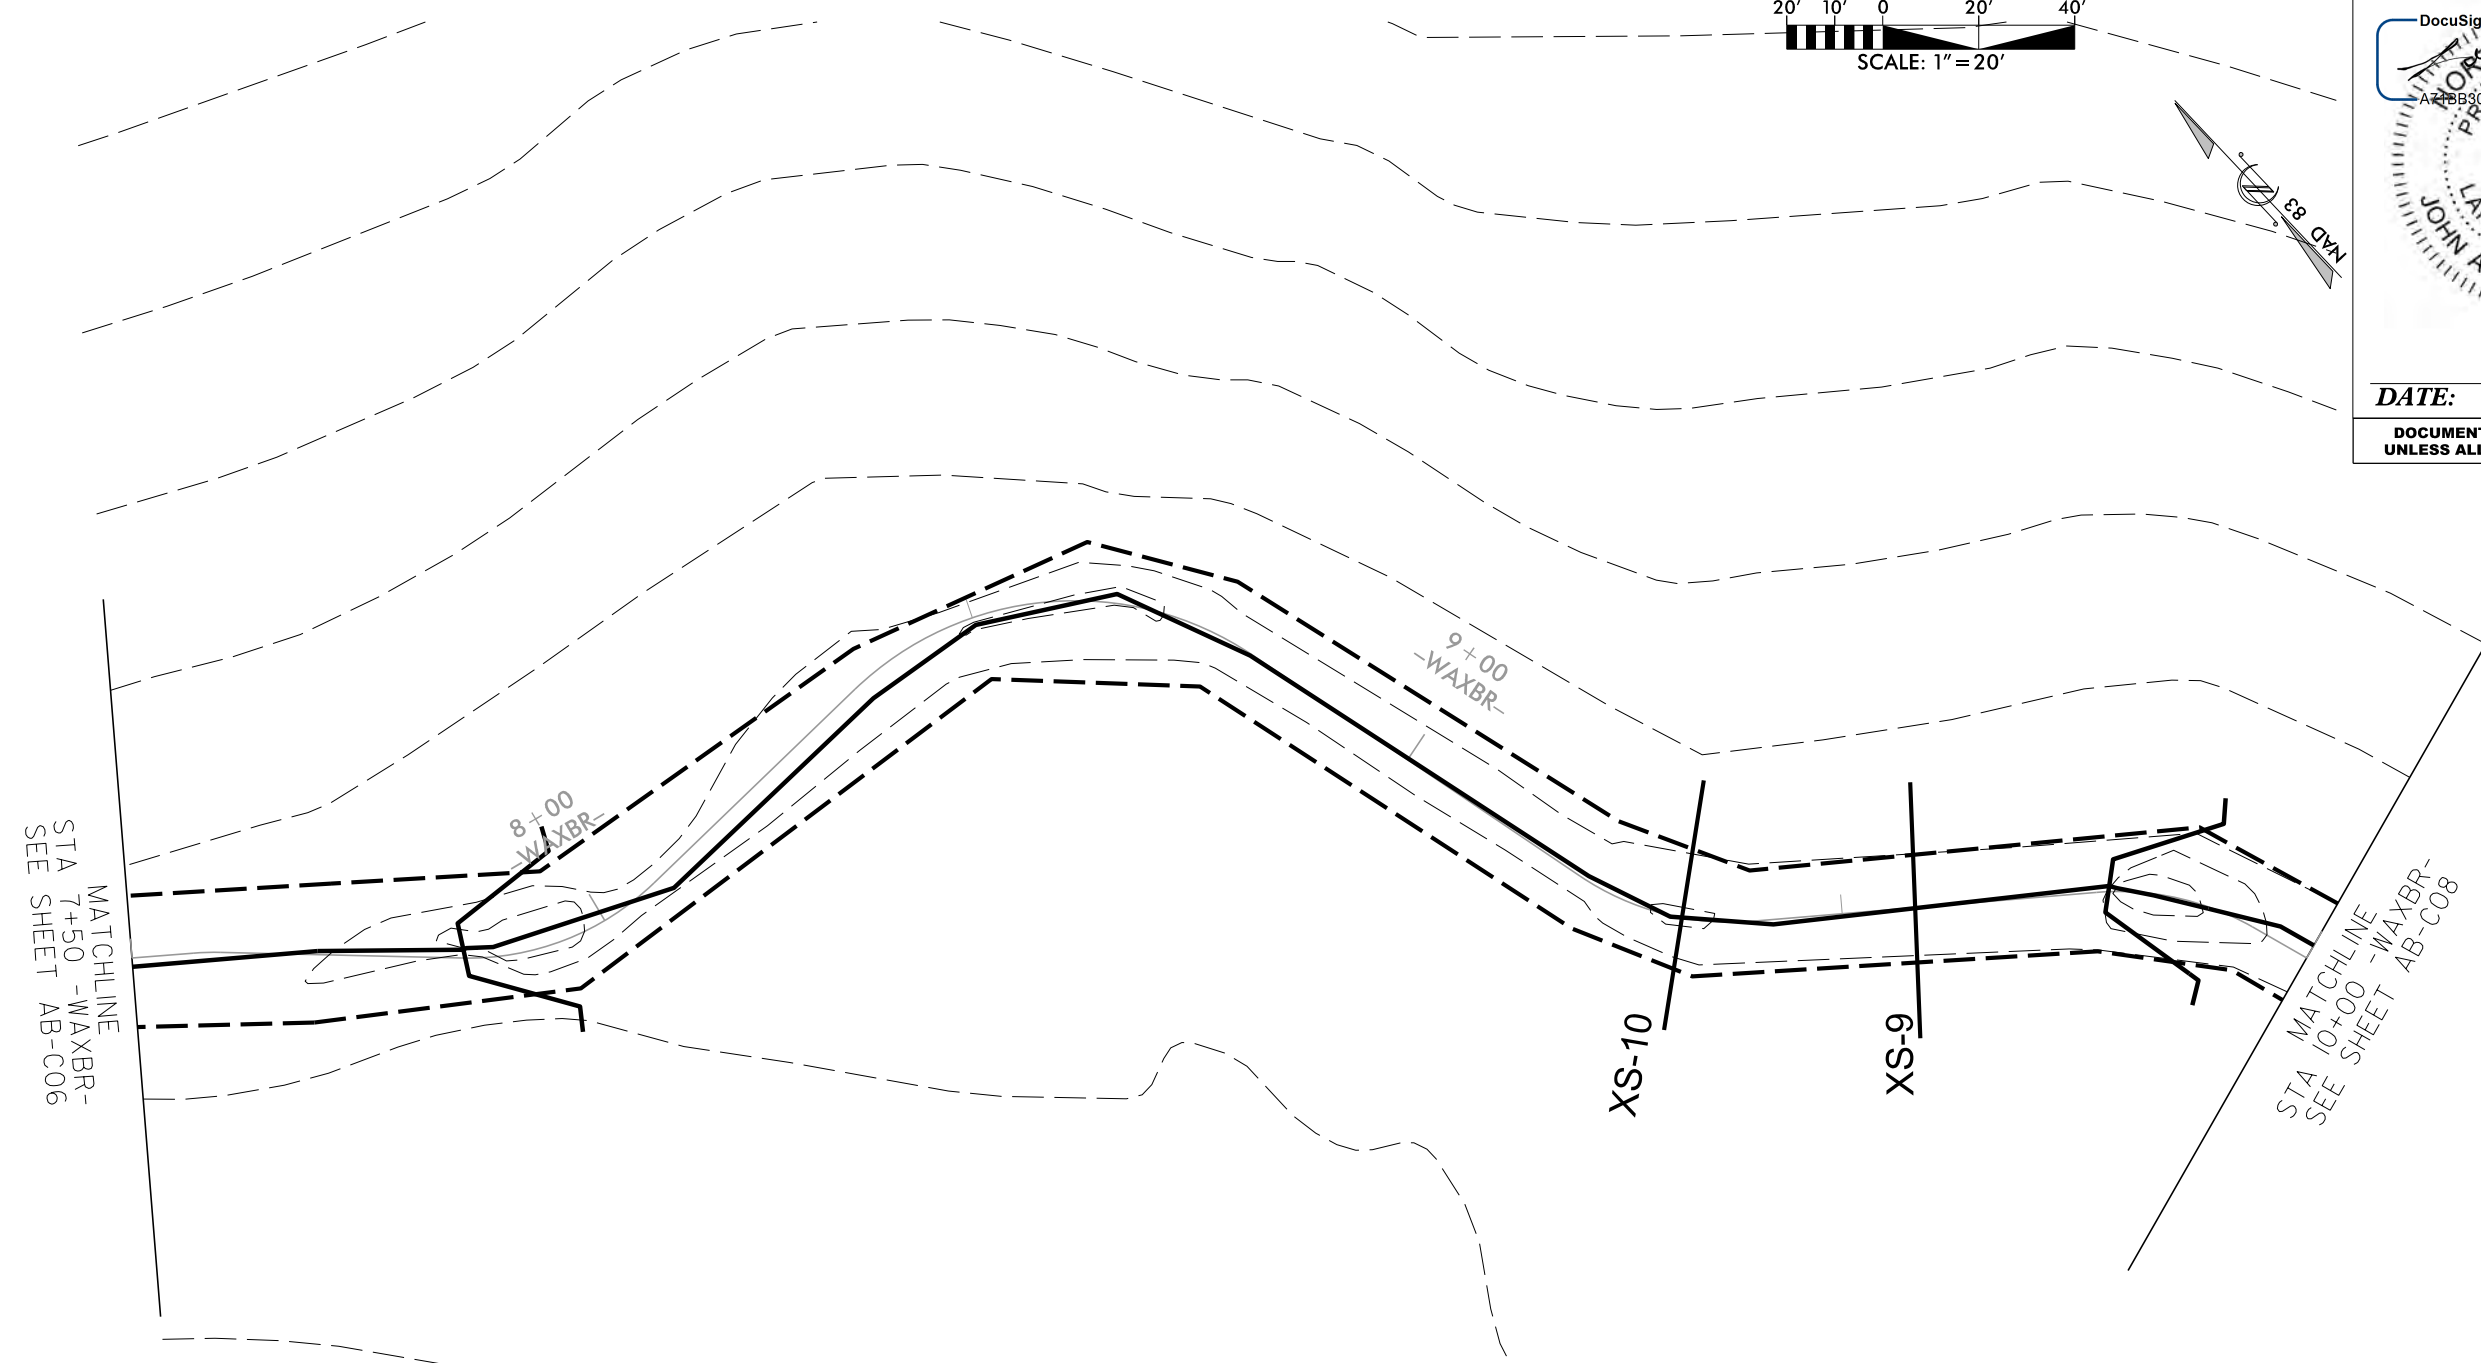


11/9/2022  
Wits\_End\_Psh\_AB-C07.dgn  
10:00 AM

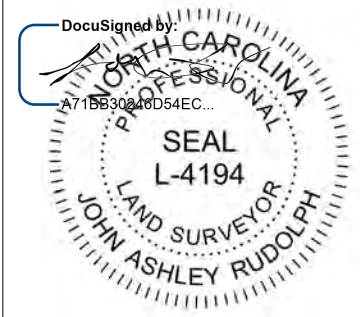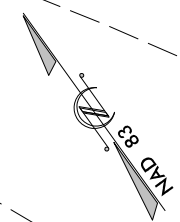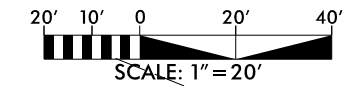

11/9/2022

DATE:  
DOCUMENT NOT CONSIDERED FINAL  
UNLESS ALL SIGNATURES COMPLETED


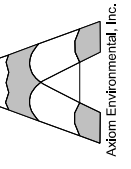


© 2021 SUNGATE DESIGN GROUP, P.A. THIS DRAWING AND ALL REPRODUCTIONS OF IT ARE THE SOLE PROPERTY OF SDG. REPRODUCTION OR OTHER USES OF THIS DRAWING WITHOUT WRITTEN CONSENT OF SDG IS NOT PERMITTED.



WITS END  
UNION COUNTY, NC  
AS-BUILT SURVEY

PROJECT # :  
1221-20024  
DRAWING NAME:  
WITS END PSH AB-C08  
DATE:  
2022  
DRAWN BY:  
JRH  
REVIEWED BY:  
JGD  
REVISIONS:

SHEET NO.  
AB-C08

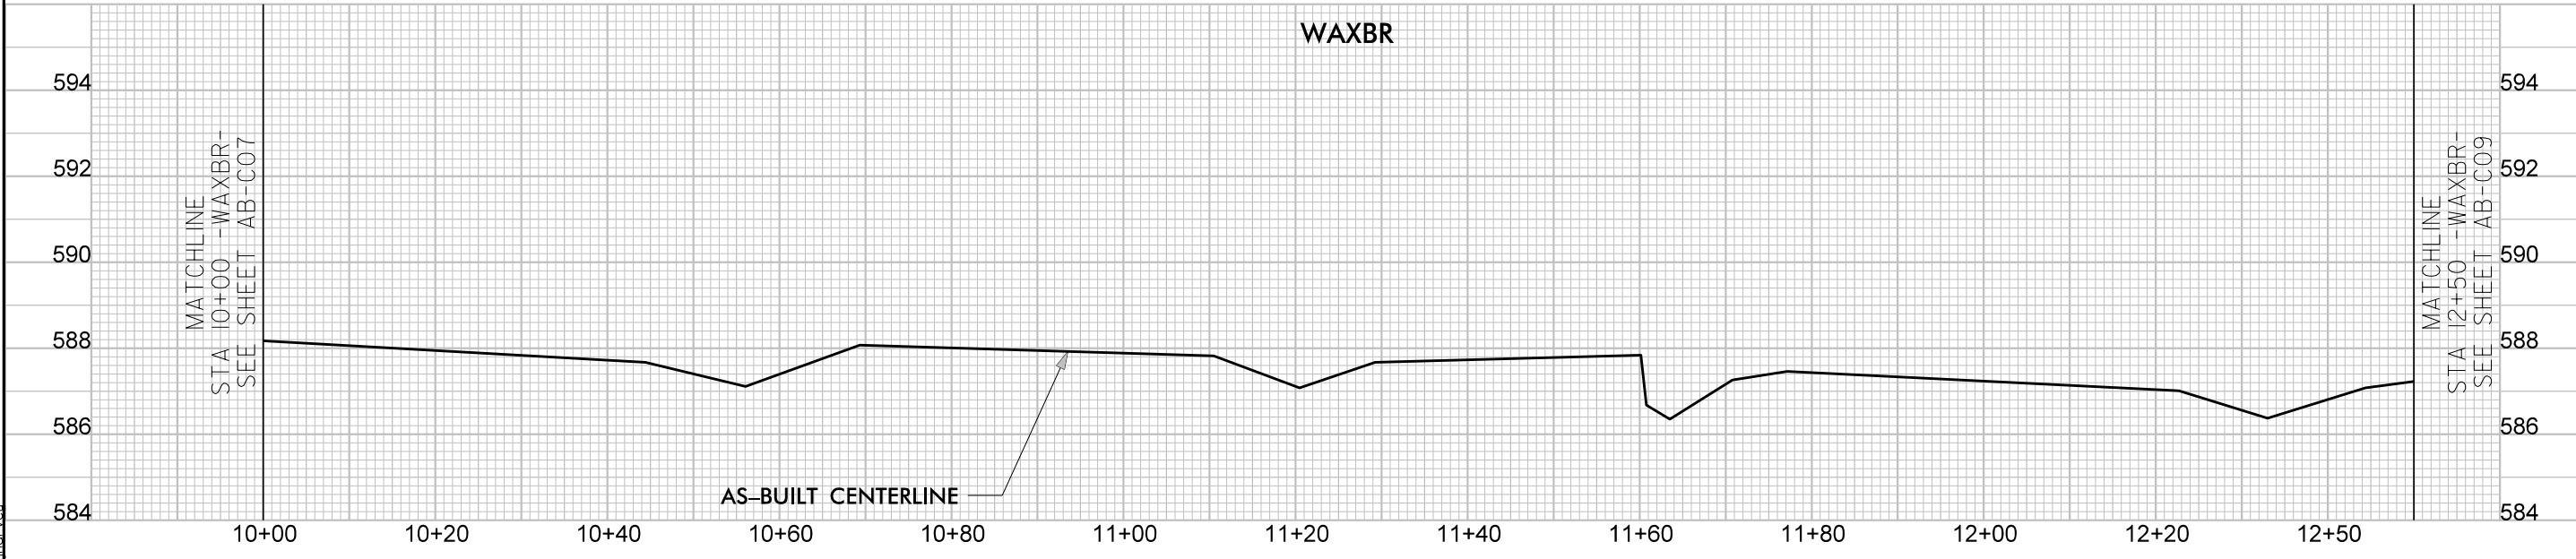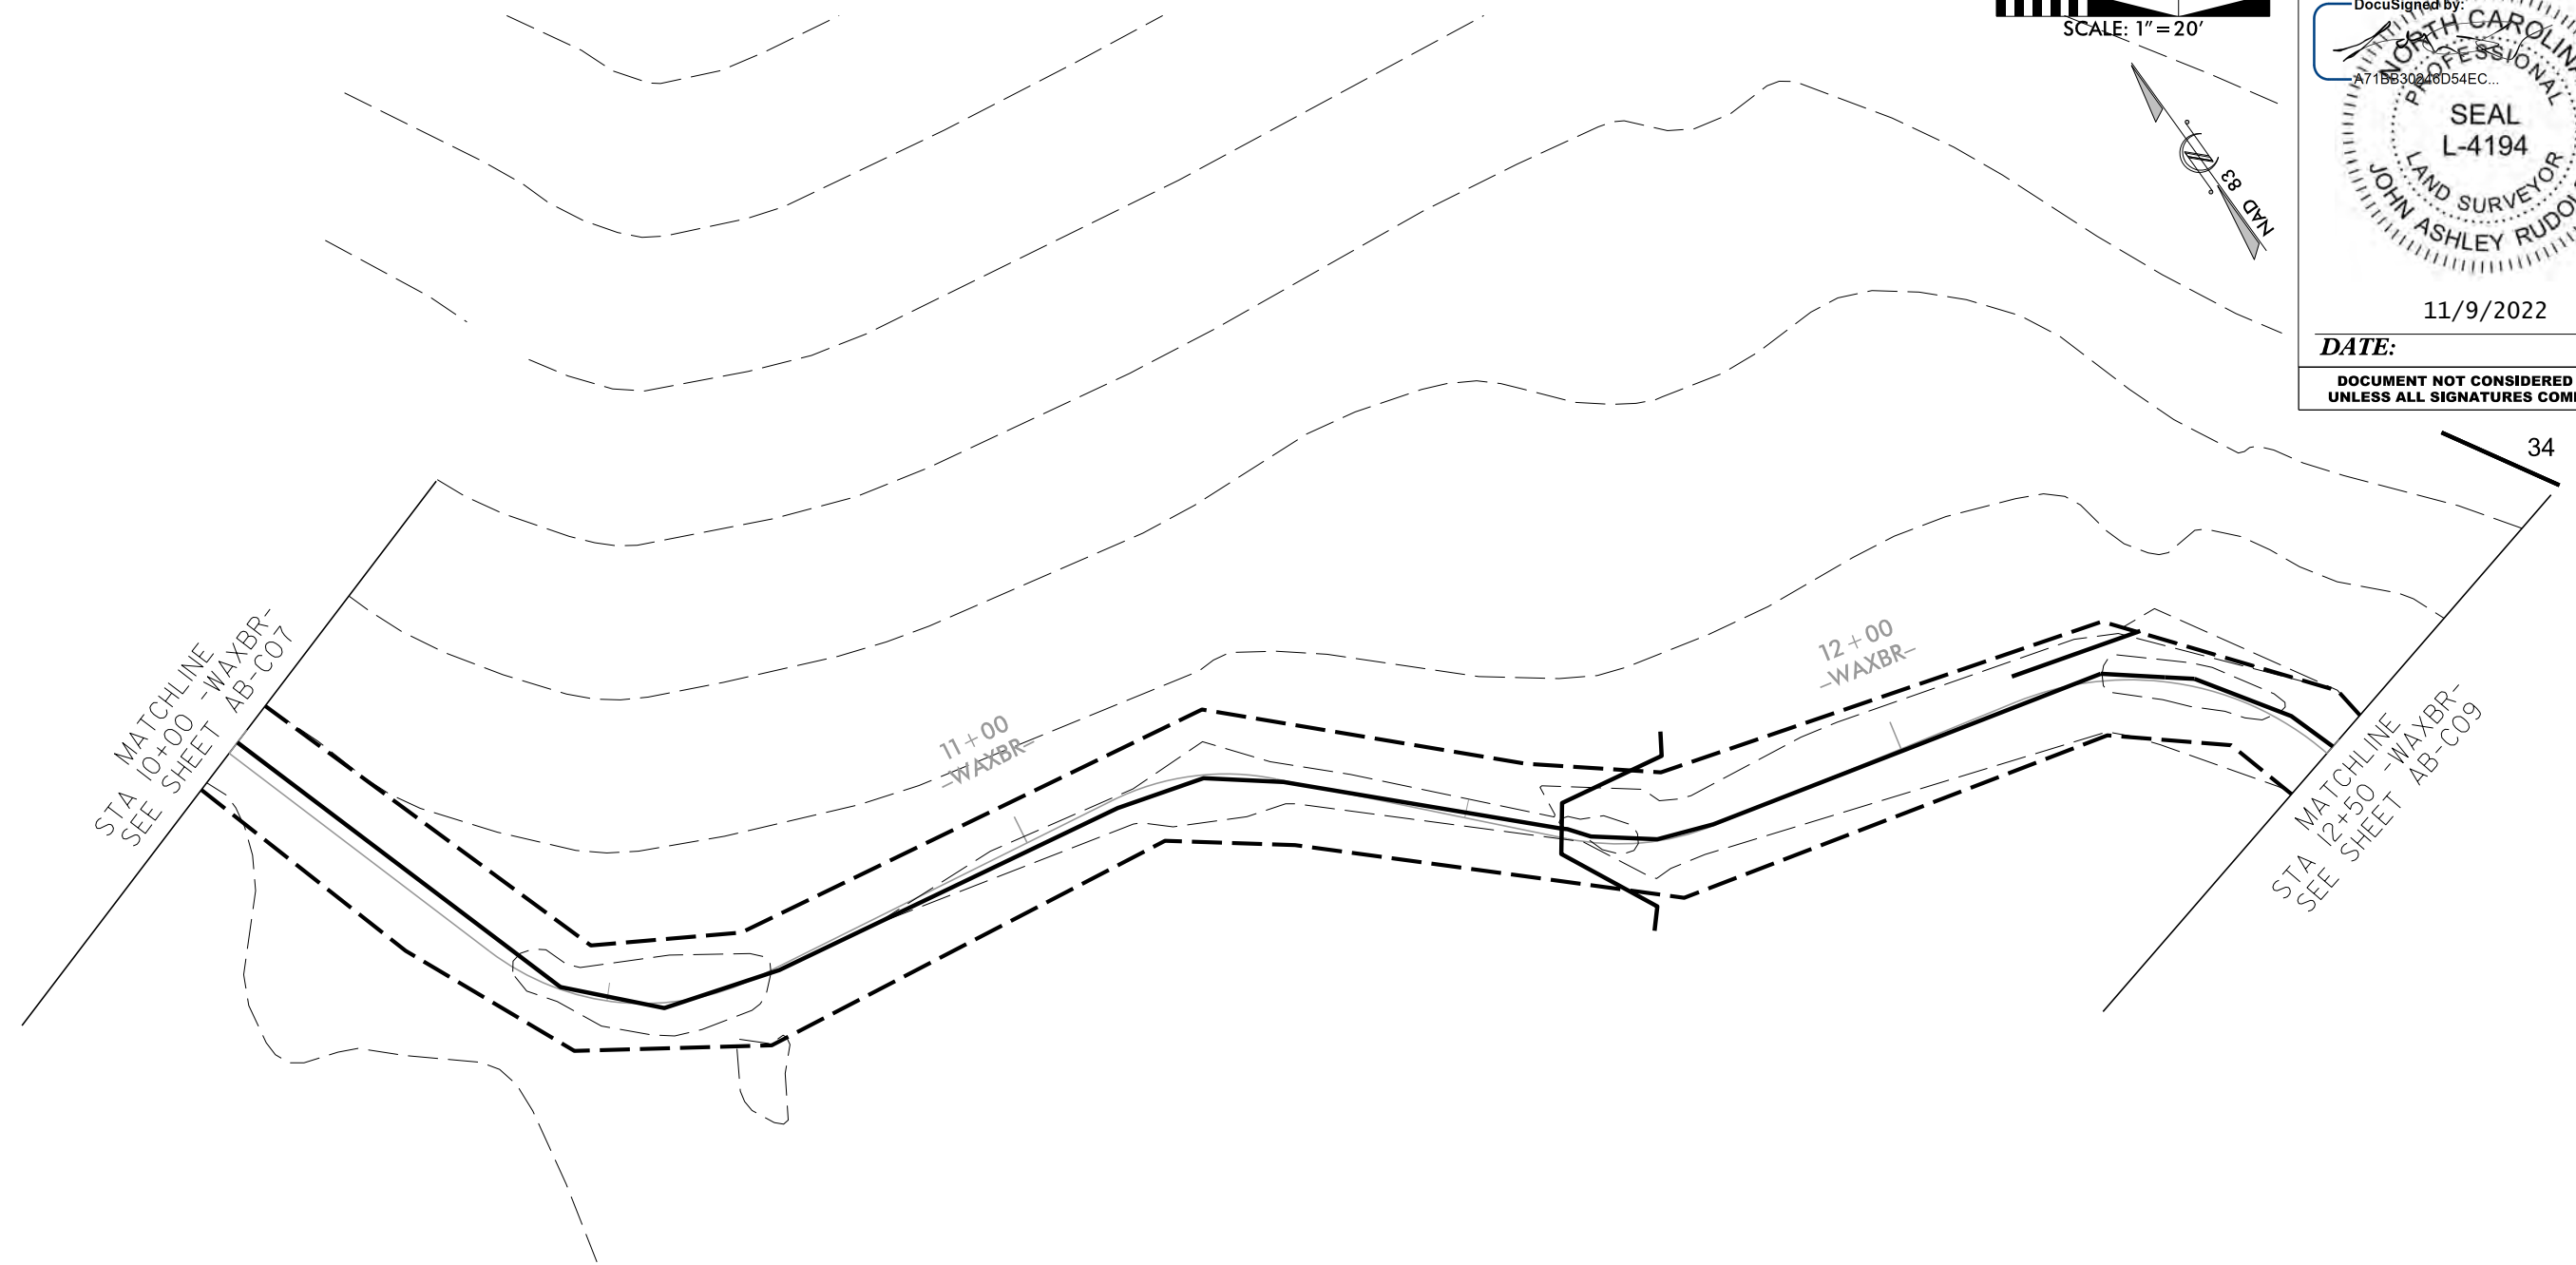


11/9/2022  
Wits\_End\_Psh\_AB-C08.dgn  
jrh

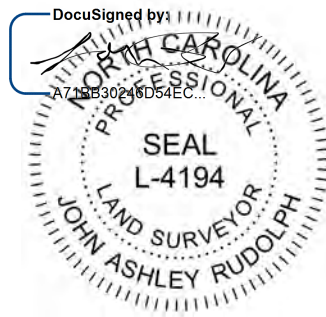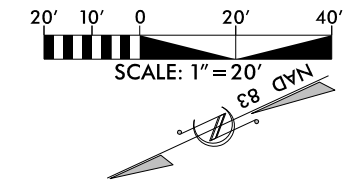

11/9/2022

**DATE:**  
**DOCUMENT NOT CONSIDERED FINAL  
UNLESS ALL SIGNATURES COMPLETED**


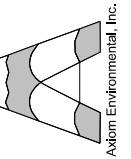


© 2022 SUNGATE DESIGN GROUP, P.A. THIS DRAWING AND ALL REPRODUCTIONS OF IT ARE THE SOLE PROPERTY OF SDG. REPRODUCTION OR OTHER USES OF THIS DRAWING WITHOUT WRITTEN CONSENT OF SDG IS NOT PERMITTED.

**WITS END**  
**UNION COUNTY, NC**  
**AS-BUILT SURVEY**




PROJECT # :  
1221-20024  
DRAWING NAME:  
WITS END PSH AB-C09  
DATE:  
2022  
DRAWN BY:  
JRH  
REVIEWED BY:  
JGD  
REVISIONS:

SHEET NO.  
**AB-C09**

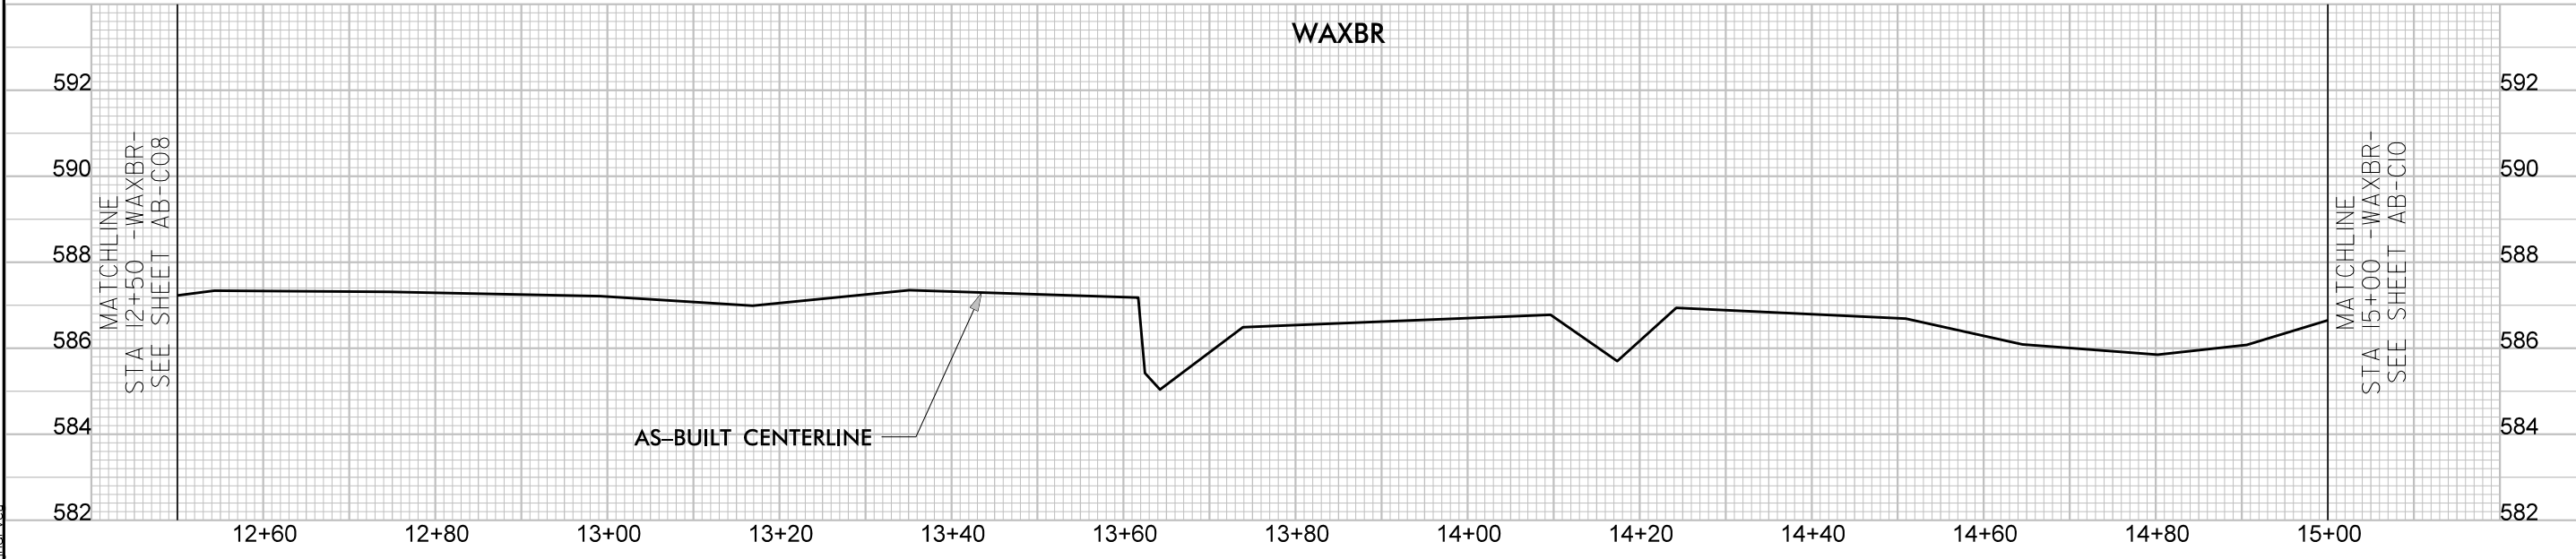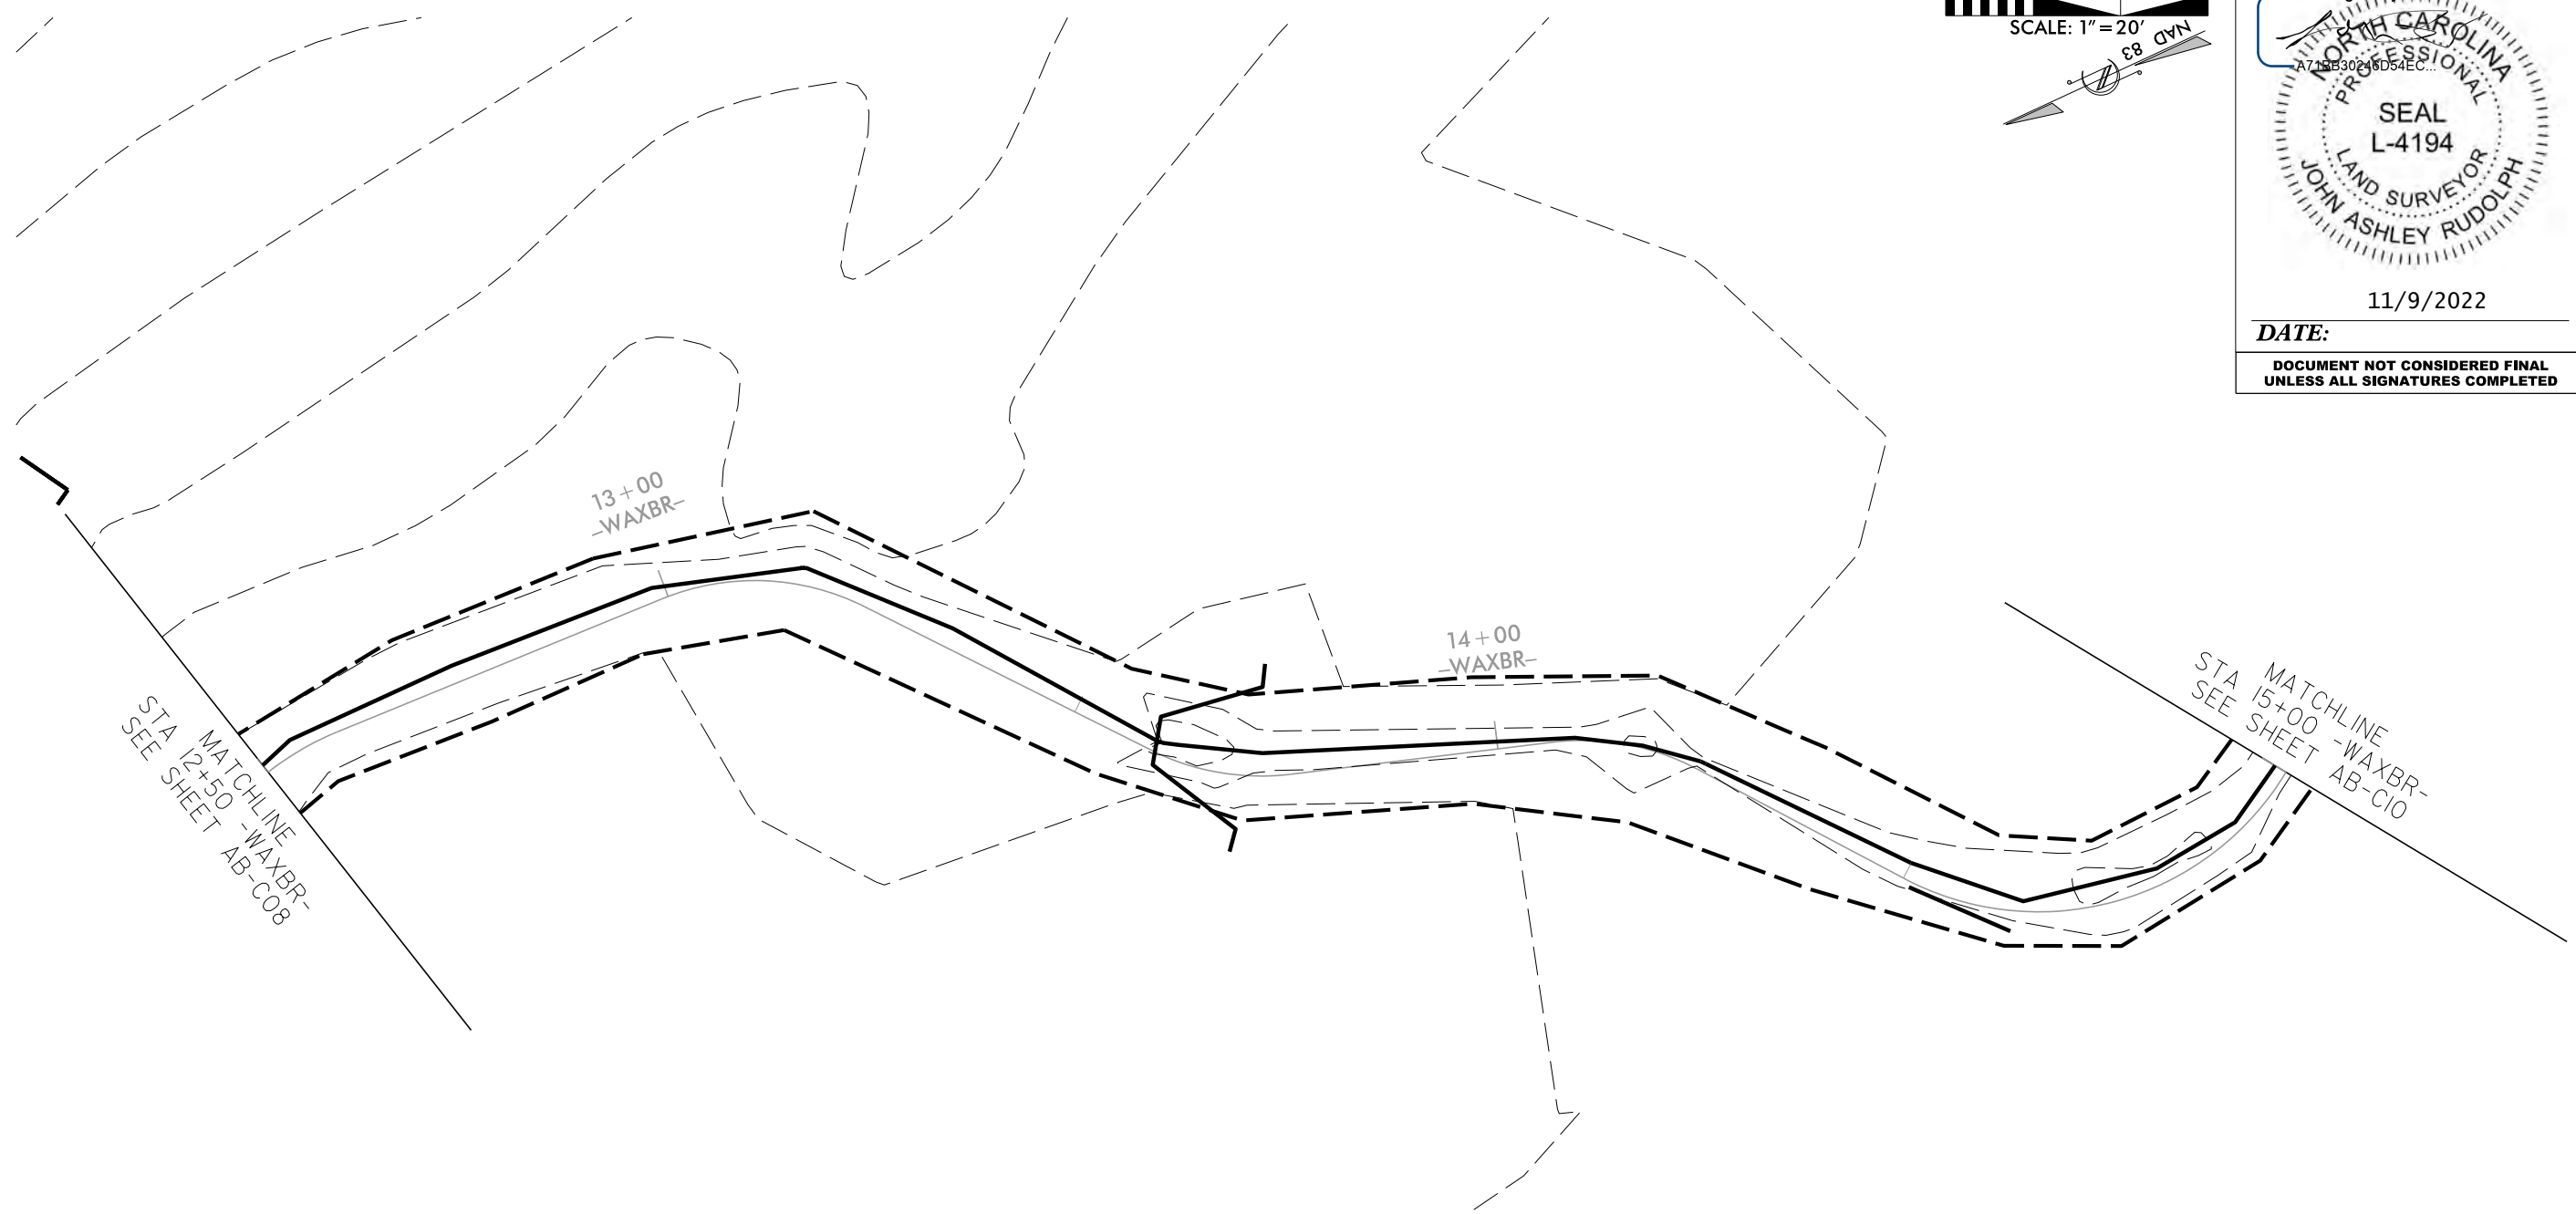


11/9/2022  
Wits\_End\_Psh\_AB-C09.dgn  
jrh



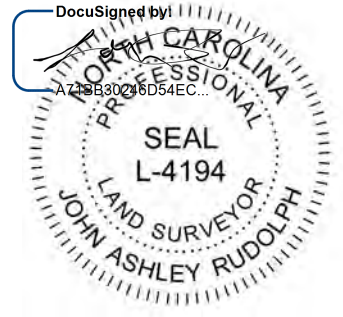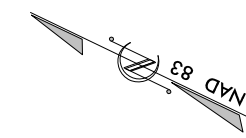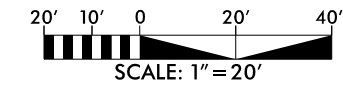

11/9/2022



DATE:  
DOCUMENT NOT CONSIDERED FINAL  
UNLESS ALL SIGNATURES COMPLETED

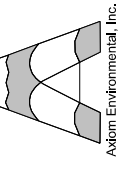



© 2022 SUNGATE DESIGN GROUP, P.A. THIS DRAWING AND ALL REPRODUCTIONS OF IT ARE THE SOLE PROPERTY OF SDG. REPRODUCTION OR OTHER USES OF THIS DRAWING WITHOUT WRITTEN CONSENT OF SDG IS NOT PERMITTED.

PROJECT # :  
1221-20024  
DRAWING NAME:  
WITS END PSH AB-04G  
DATE:  
2022  
DRAWN BY:  
JRH  
REVIEWED BY:  
JGD  
REVISIONS:

SHEET NO.  
**AB-C10**

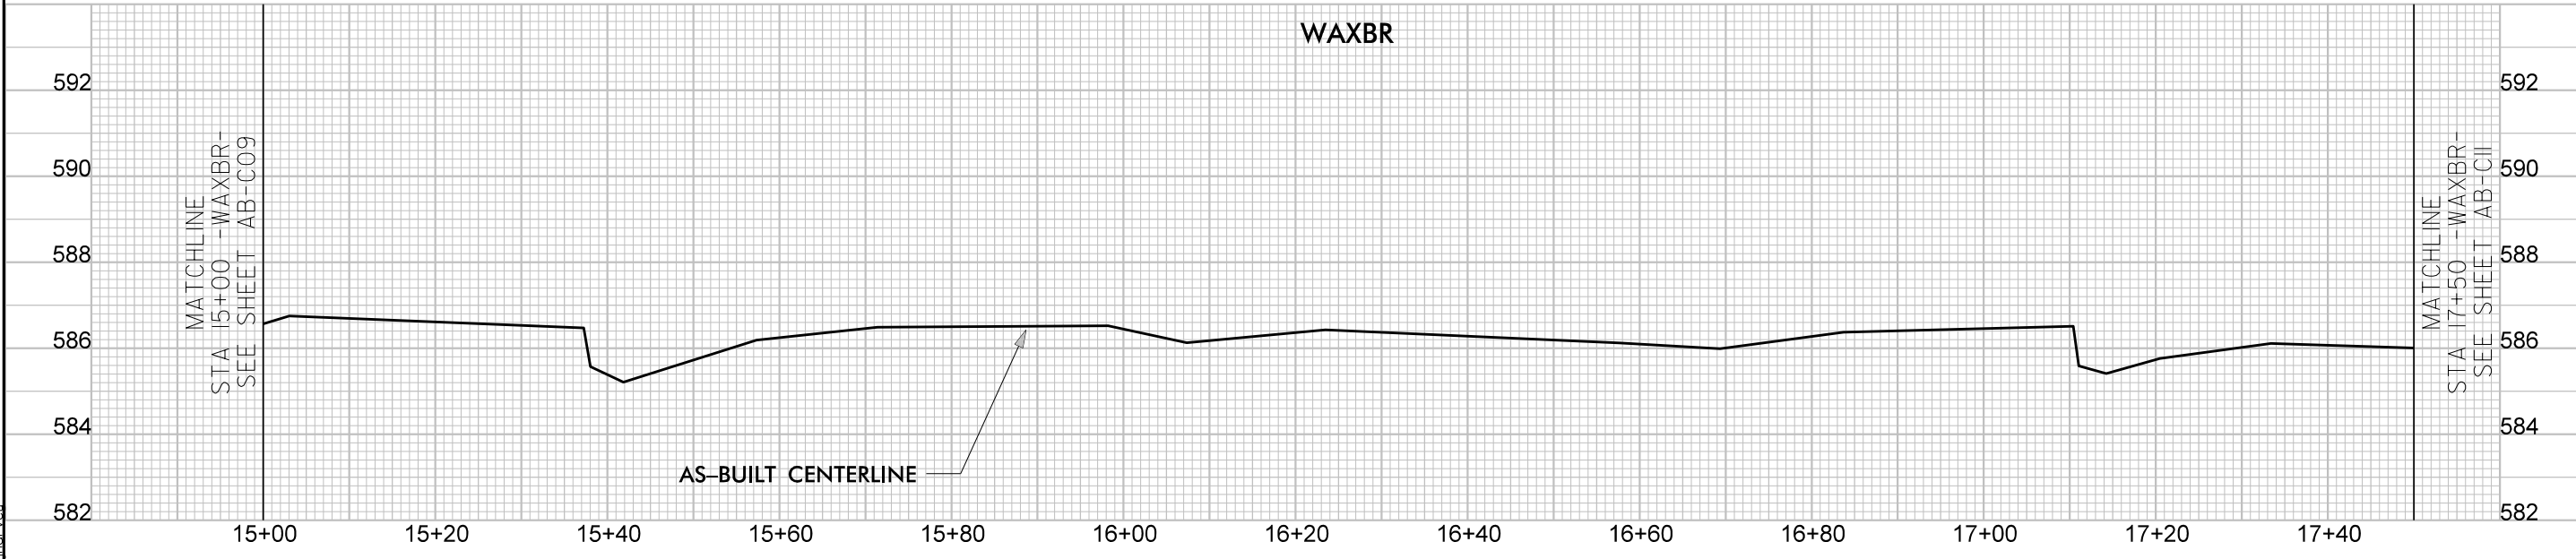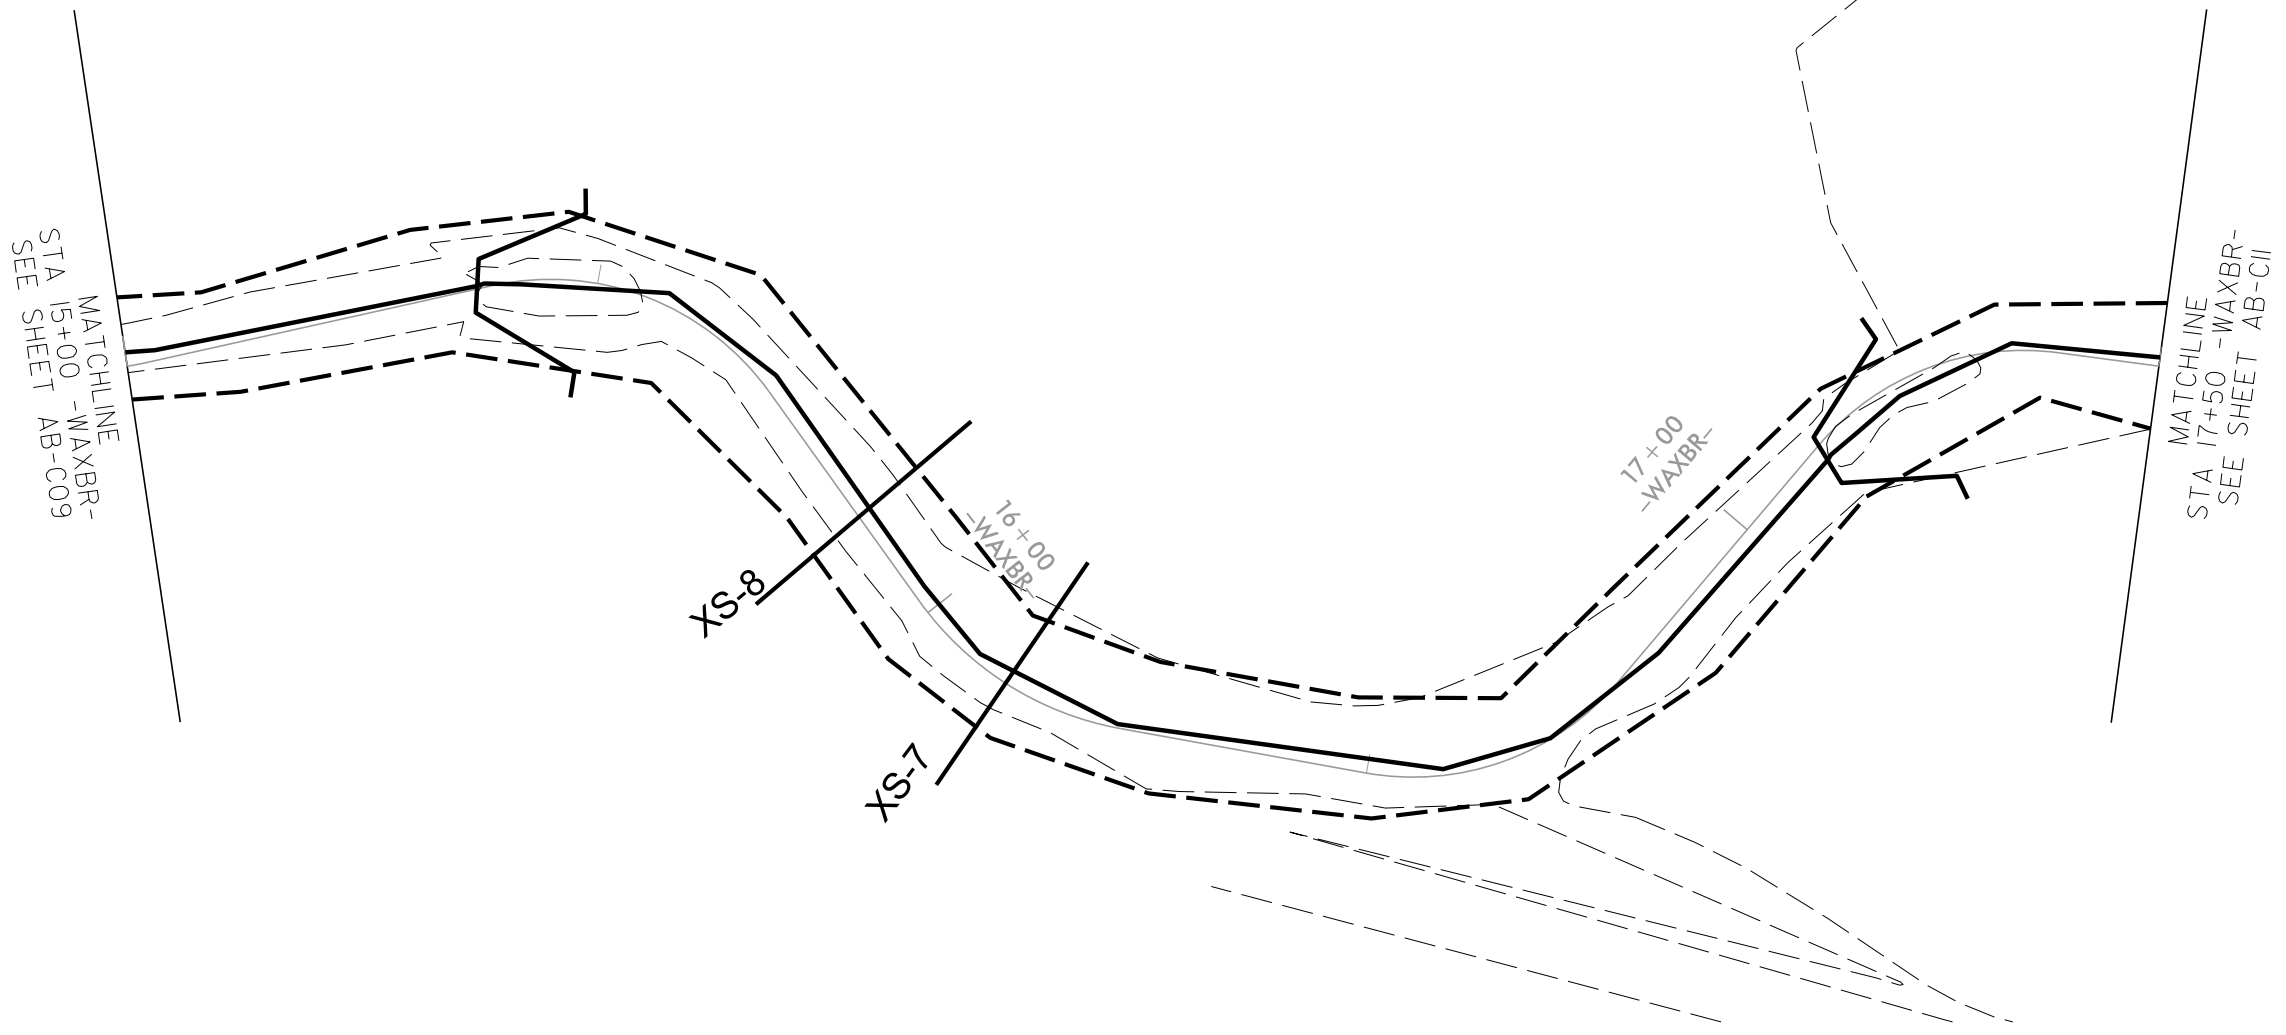


11/9/2022  
Wits\_End\_Psh\_AB-C10.dgn  
jrh

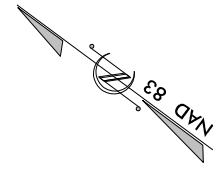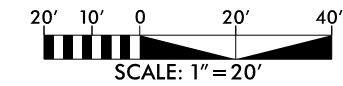

DocuSigned By:  
 PROFESSIONAL SEAL  
 L-4194  
 LAND SURVEYOR  
 JOHN ASHLEY RUDOLPH  
 11/9/2022



**DATE:**  
**DOCUMENT NOT CONSIDERED FINAL  
 UNLESS ALL SIGNATURES COMPLETED**

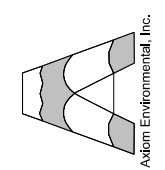


**WITS END**  
 UNION COUNTY, NC  
**AS-BUILT SURVEY**

PROJECT # :  
 1221-20024  
 DRAWING NAME:  
 WITS END PSH AB-C11  
 DATE:  
 2022  
 DRAWN BY:  
 JRH  
 REVIEWED BY:  
 JGD  
 REVISIONS:  
 SHEET NO.  
**AB-C11**

© 2021 SUNGATE DESIGN GROUP, P.A. THIS DRAWING AND ALL REPRODUCTIONS OF IT ARE THE SOLE PROPERTY OF SDG. REPRODUCTION OR OTHER USES OF THIS DRAWING WITHOUT WRITTEN CONSENT OF SDG IS NOT PERMITTED.

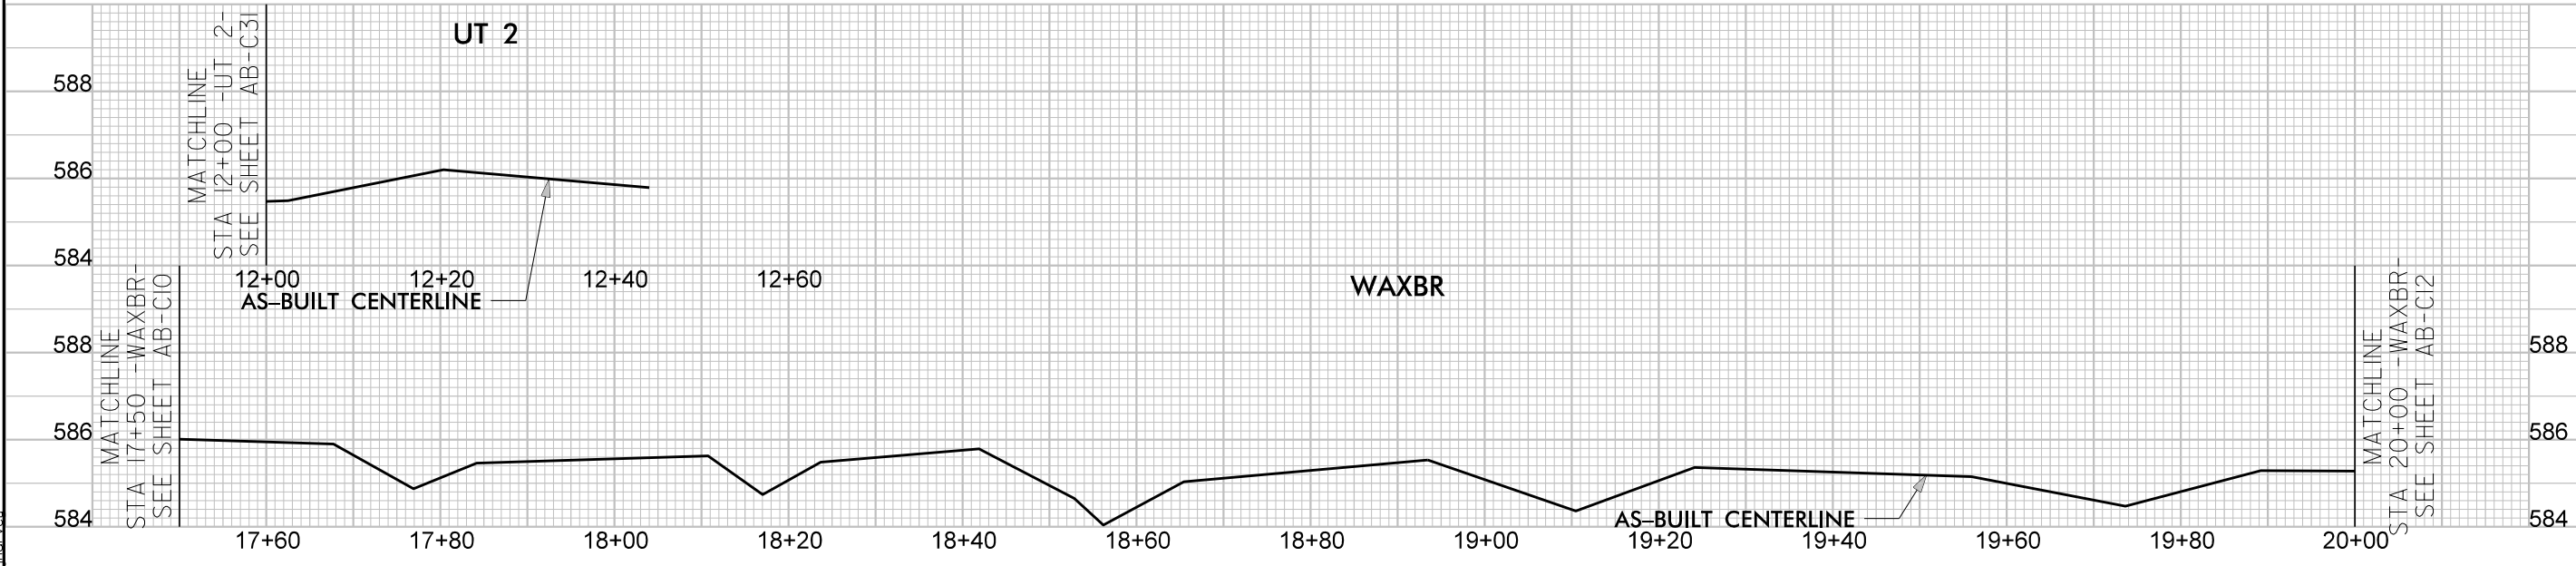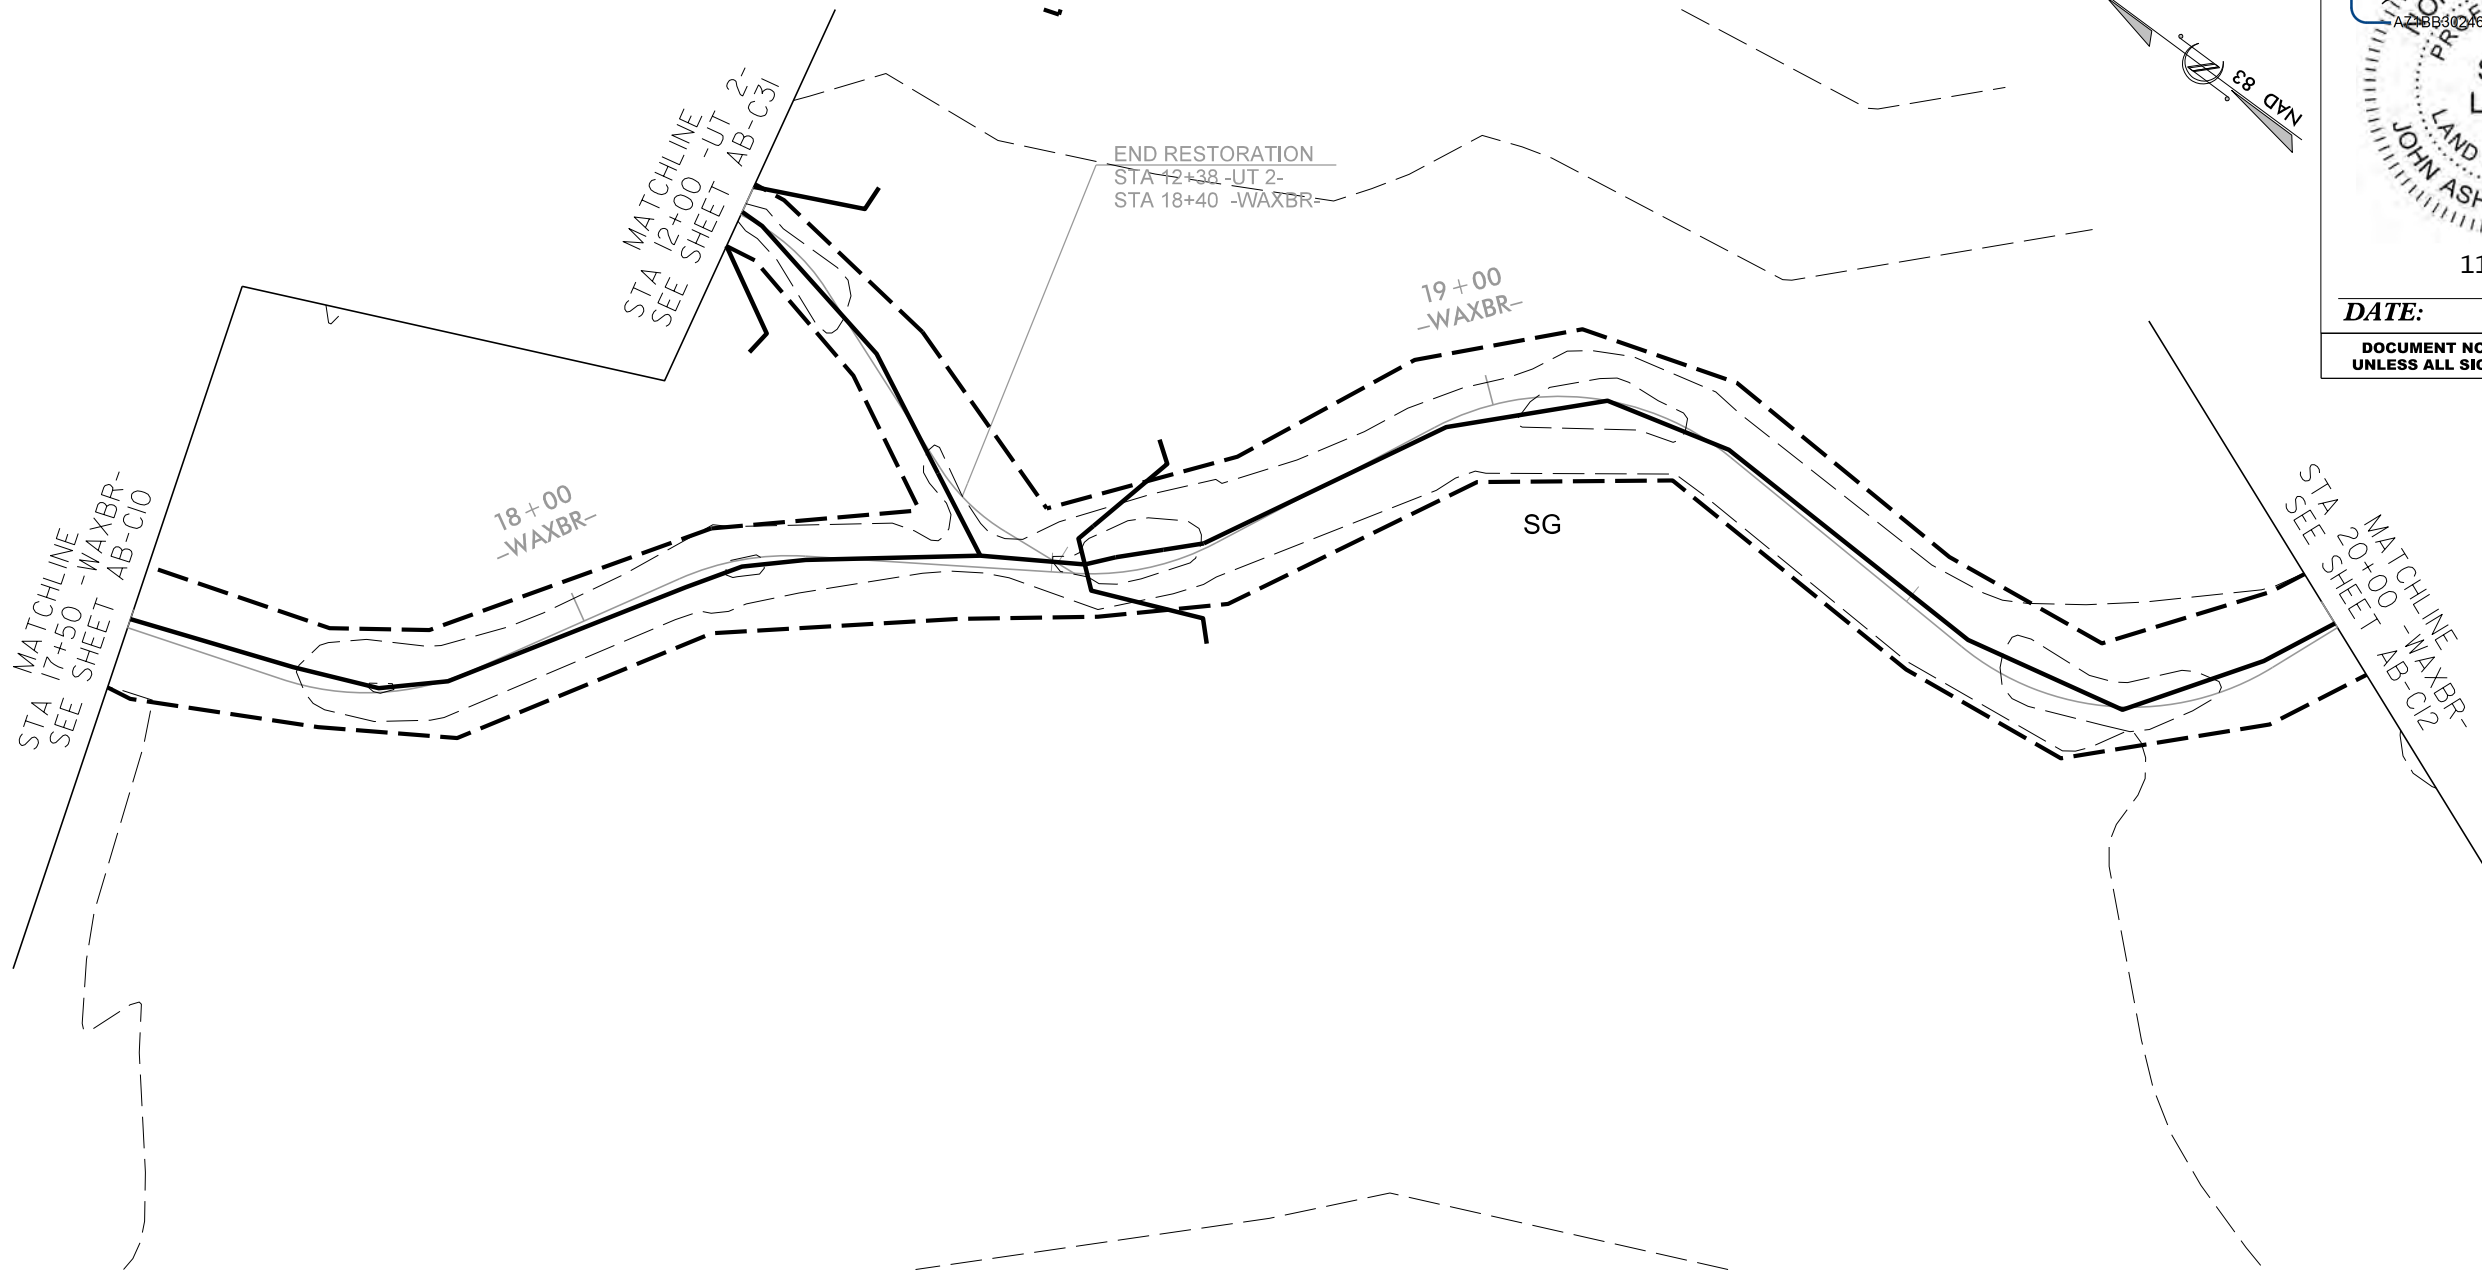

11/9/2022  
 Wits\_End\_Psh\_AB-C11.dgn  
 jrh

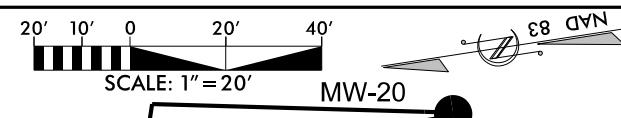


DocuSigned by:  
24BB30246D54E0...

SEAL  
L-4194  
JOHN ASHLEY RUDOLPH  
PROFESSIONAL LAND SURVEYOR

DATE: 11/9/2022



**DOCUMENT NOT CONSIDERED FINAL  
UNLESS ALL SIGNATURES COMPLETED**

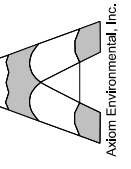

**WITS END**  
UNION COUNTY, NC  
**AS-BUILT SURVEY**

PROJECT # : 1221-20024  
DRAWING NAME: WITS END PSH AB-C12  
DATE: 2022  
DRAWN BY: JRH  
REVIEWED BY: JGD  
REVISIONS:



SHEET NO.  
**AB-C12**

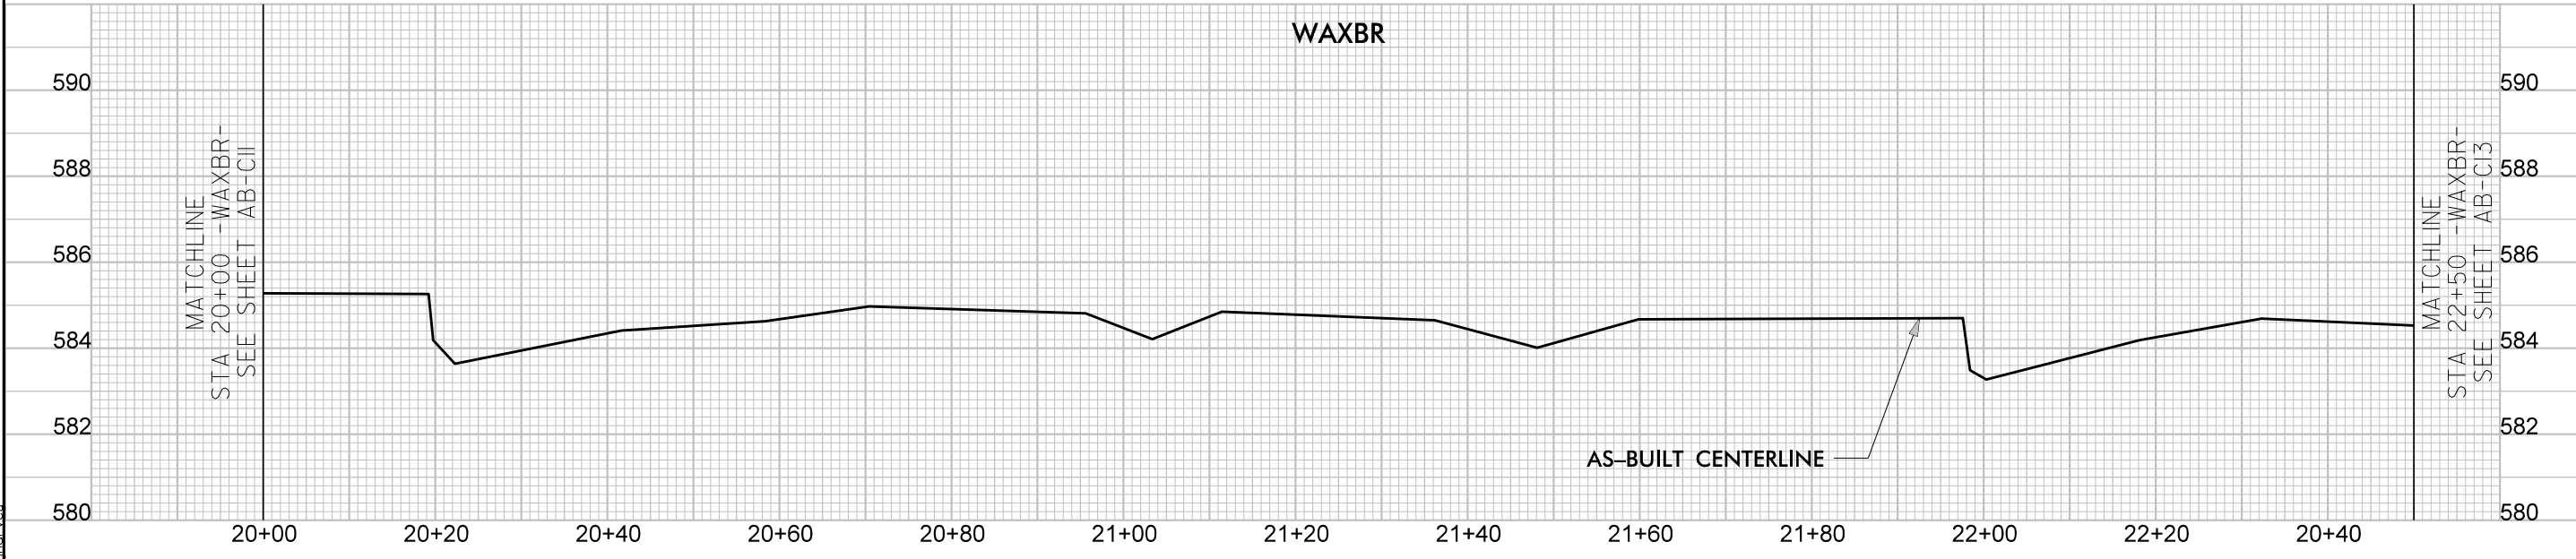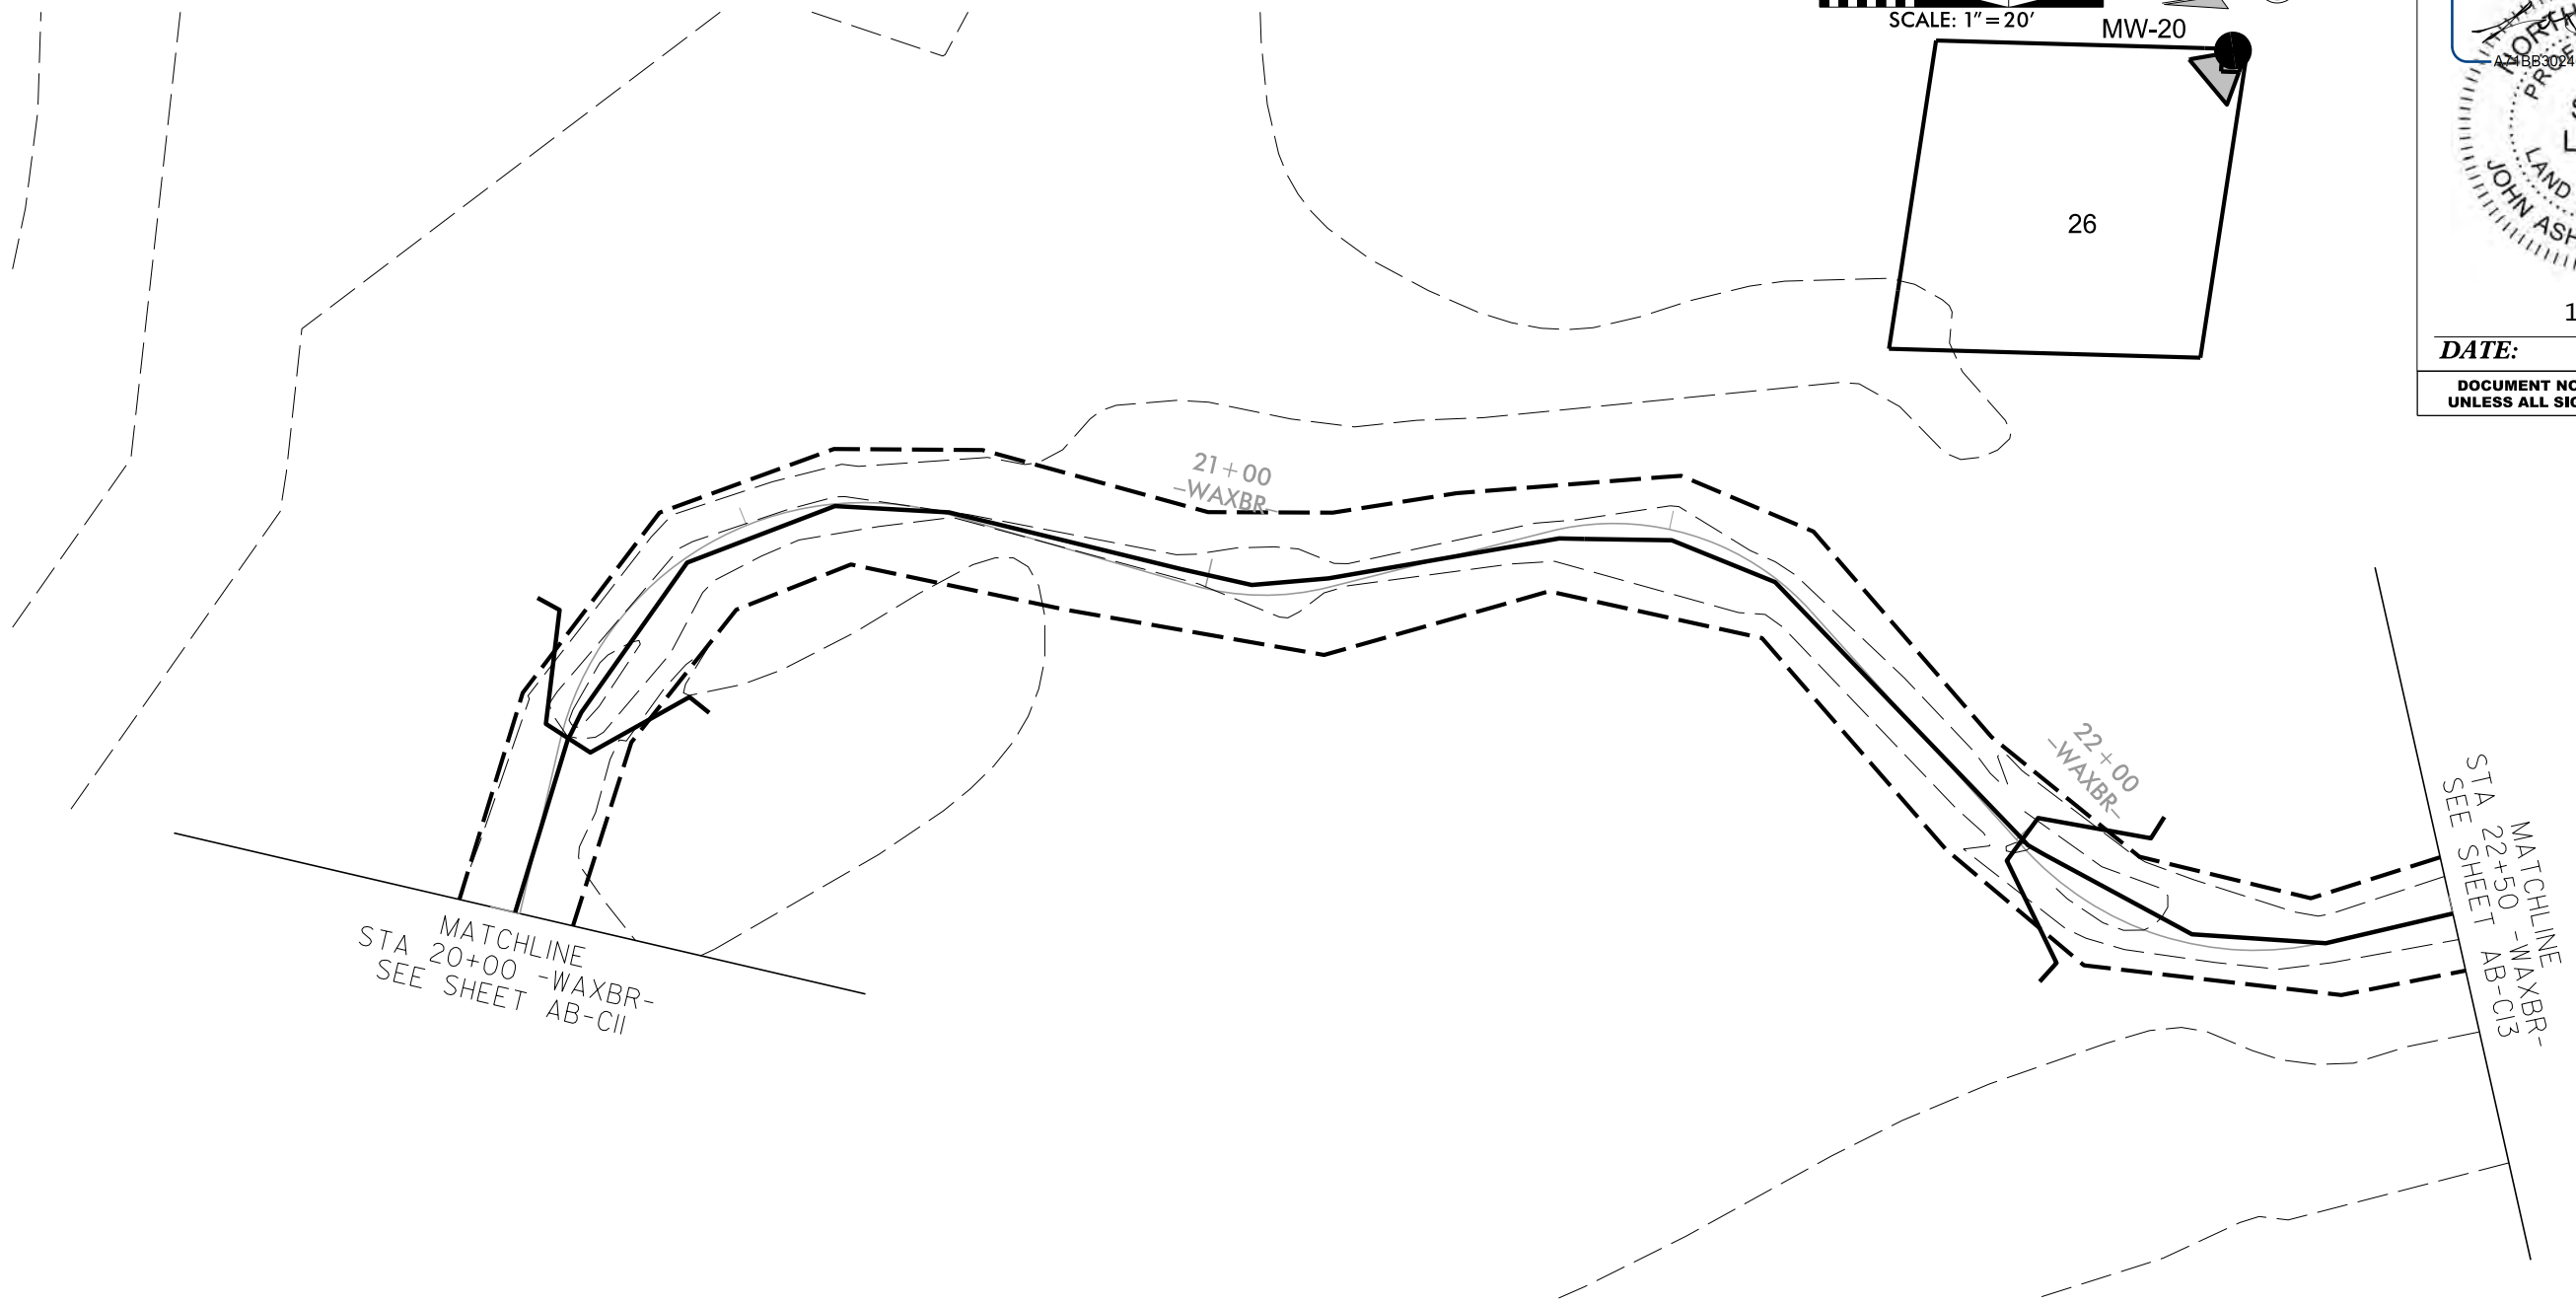

11/9/2022  
Wits\_End\_Psh\_AB-C12.dgn  
jrh


© 2022 SUNGATE DESIGN GROUP, P.A. THIS DRAWING AND ALL REPRODUCTIONS OF IT ARE THE SOLE PROPERTY OF SDG. REPRODUCTION OR OTHER USES OF THIS DRAWING WITHOUT WRITTEN CONSENT OF SDG IS NOT PERMITTED.



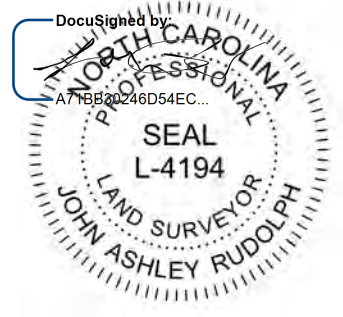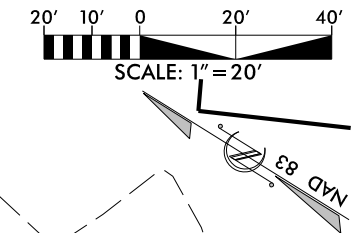


DATE: 11/9/2022


**DOCUMENT NOT CONSIDERED FINAL  
UNLESS ALL SIGNATURES COMPLETED**

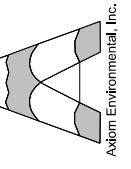

© 2022 SUNGATE DESIGN GROUP, P.A. THIS DRAWING AND ALL REPRODUCTIONS OF IT ARE THE SOLE PROPERTY OF SDG. REPRODUCTION OR OTHER USES OF THIS DRAWING WITHOUT WRITTEN CONSENT OF SDG IS NOT PERMITTED.

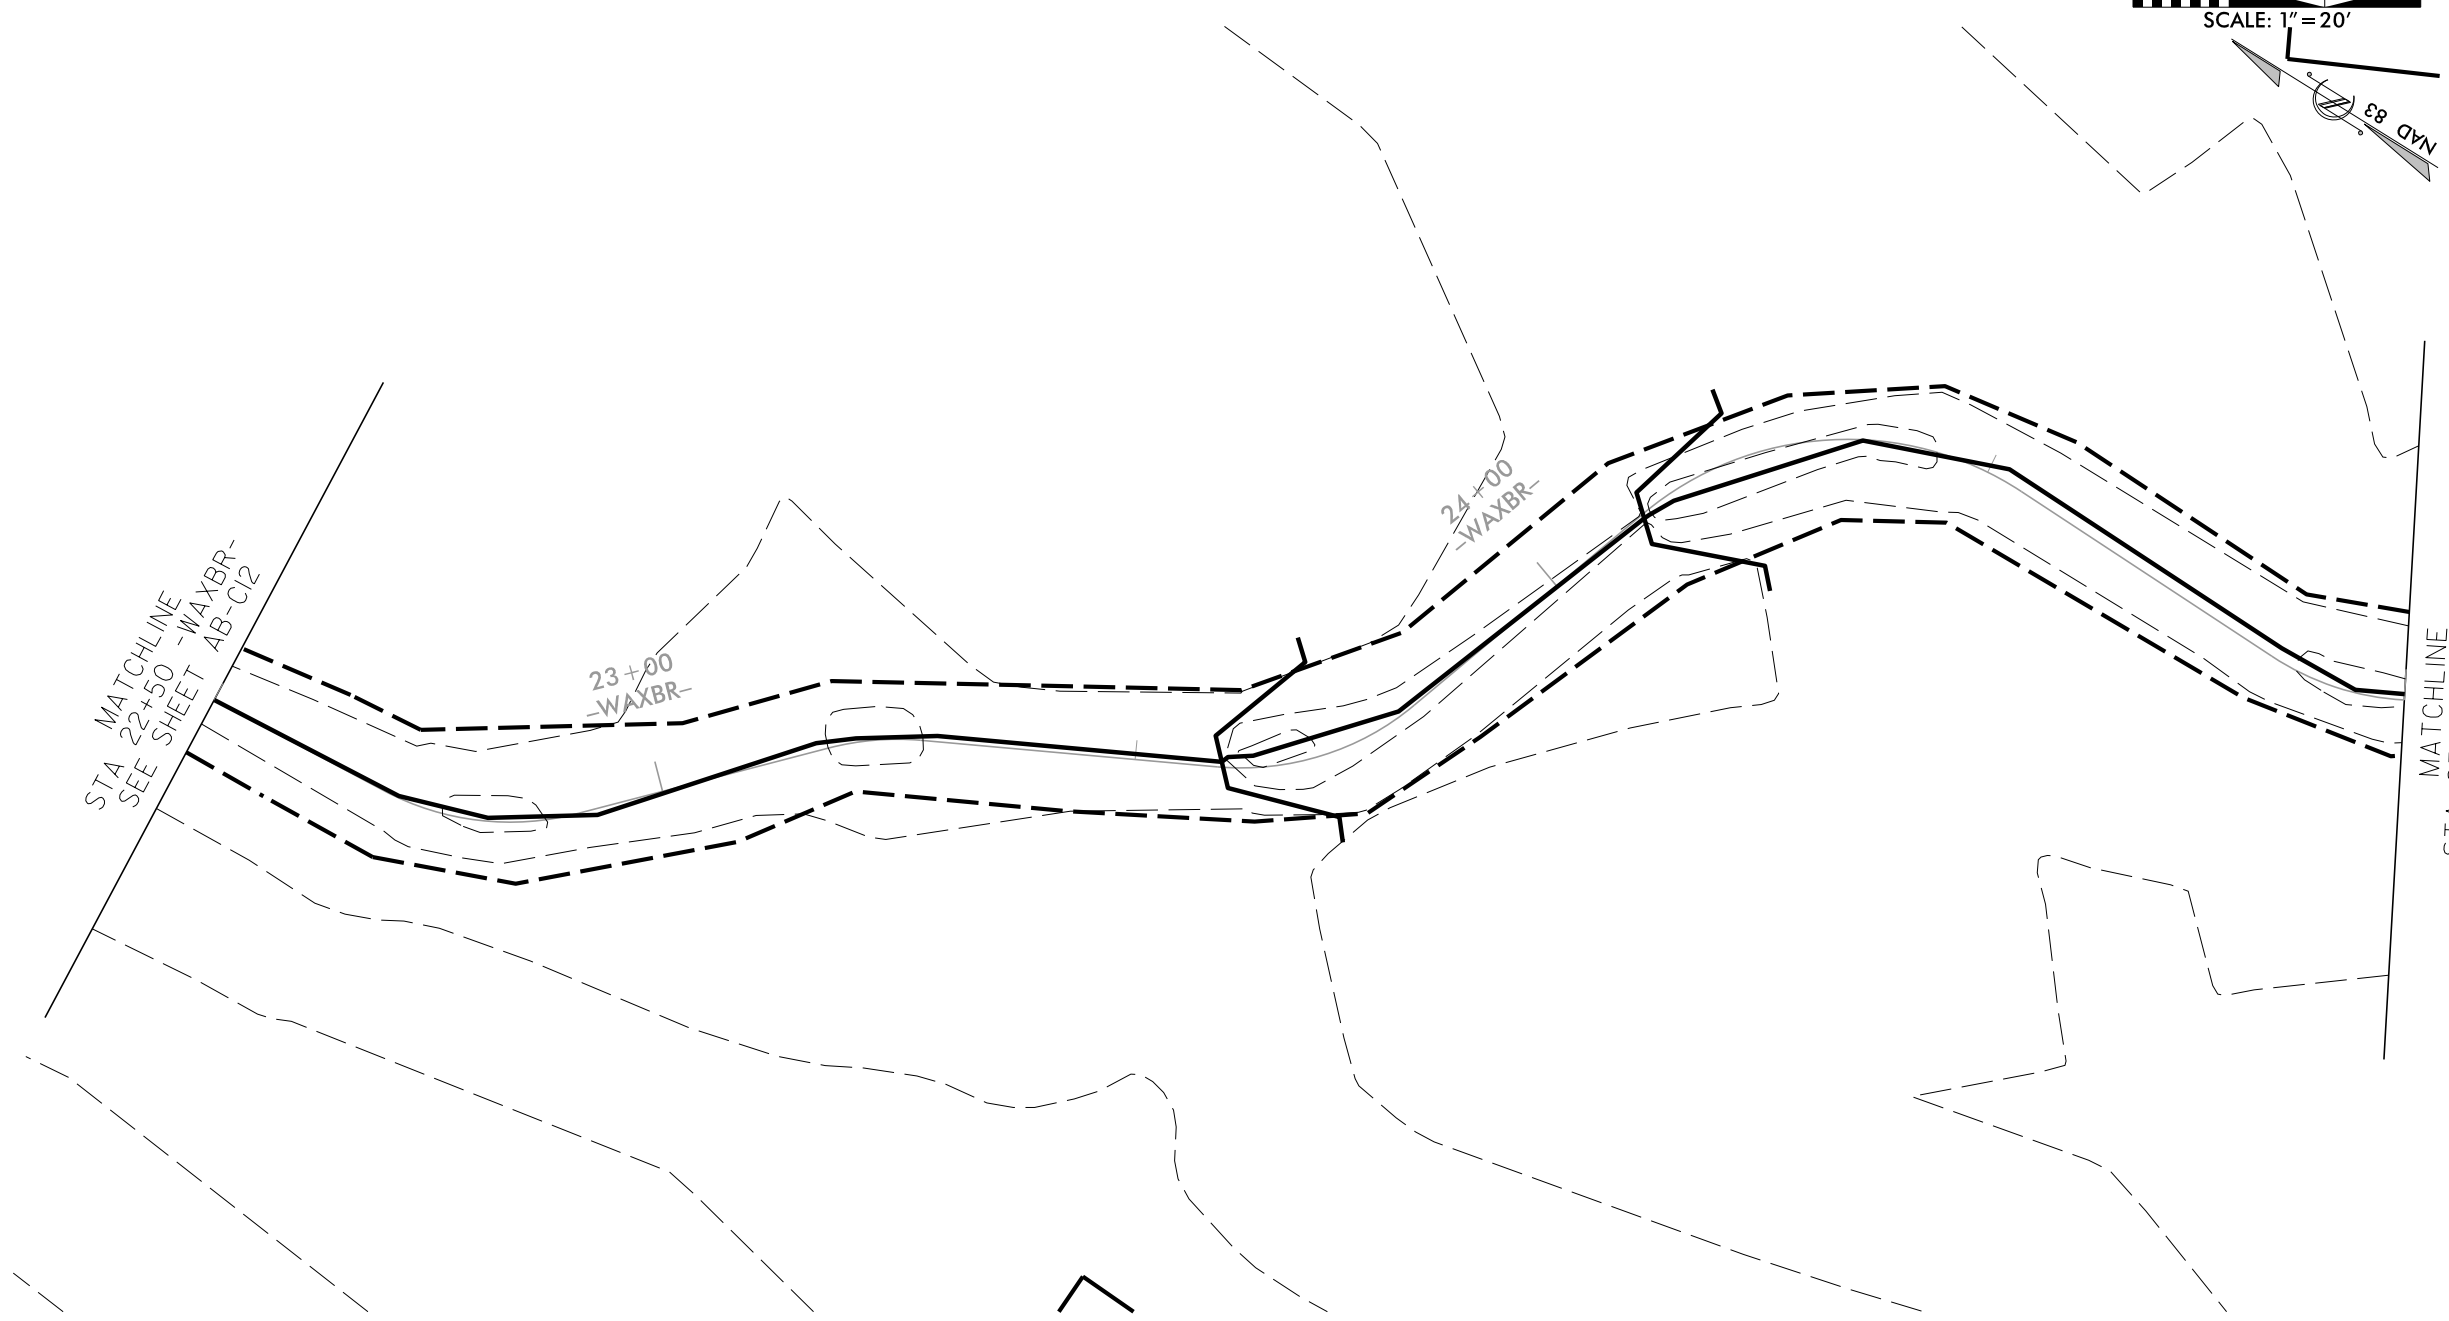

WAXBR

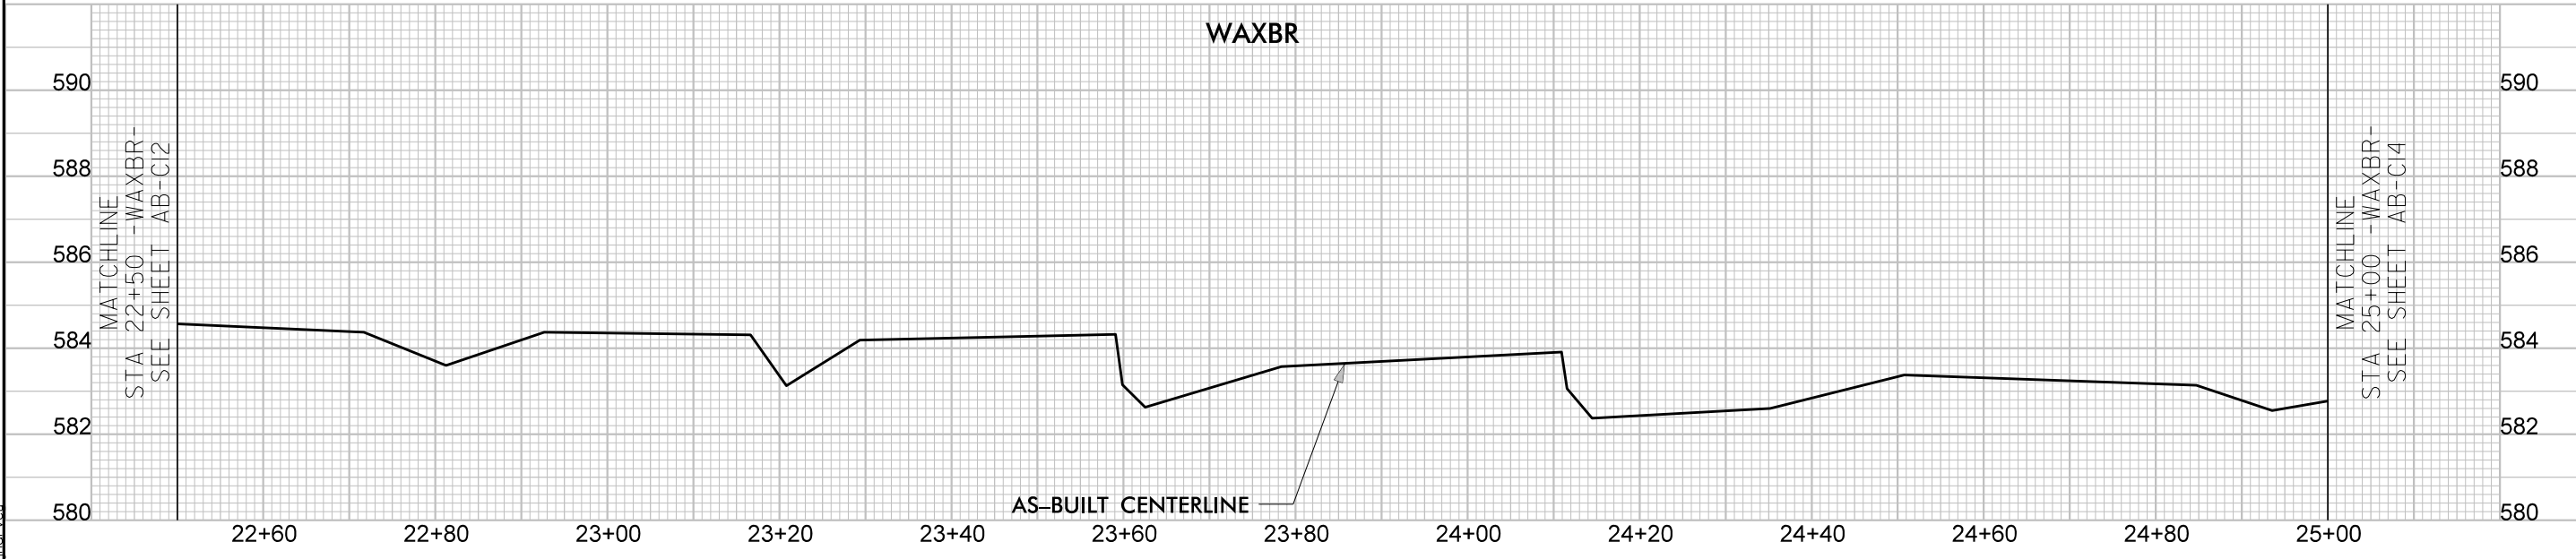




AS-BUILT CENTERLINE

**WITS END  
UNION COUNTY, NC  
AS-BUILT SURVEY**

PROJECT # : 1221-20024  
 DRAWING NAME: WITS END PSH AB-C13  
 DATE: 2022  
 DRAWN BY: JRH  
 REVIEWED BY: JGD  
 REVISIONS:


SHEET NO. **AB-C13**

11/9/2022  
Wits\_End\_Psh\_AB-C13.dgn  
10:40:40 AM

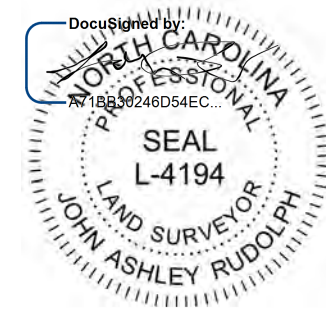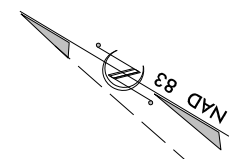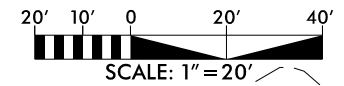

11/9/2022

DATE:  
DOCUMENT NOT CONSIDERED FINAL  
UNLESS ALL SIGNATURES COMPLETED


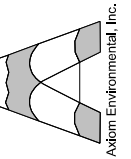


© 2022 SUNGATE DESIGN GROUP, P.A. THIS DRAWING AND ALL REPRODUCTIONS OF IT ARE THE SOLE PROPERTY OF SDG. REPRODUCTION OR OTHER USES OF THIS DRAWING WITHOUT WRITTEN CONSENT OF SDG IS NOT PERMITTED.



**WITS END**  
UNION COUNTY, NC  
**AS-BUILT SURVEY**

PROJECT # :  
1221-20024  
DRAWING NAME:  
WITS END PSH AB-C14  
DATE:  
2022  
DRAWN BY:  
JRH  
REVIEWED BY:  
JGD  
REVISIONS:


SHEET NO.  
**AB-C14**

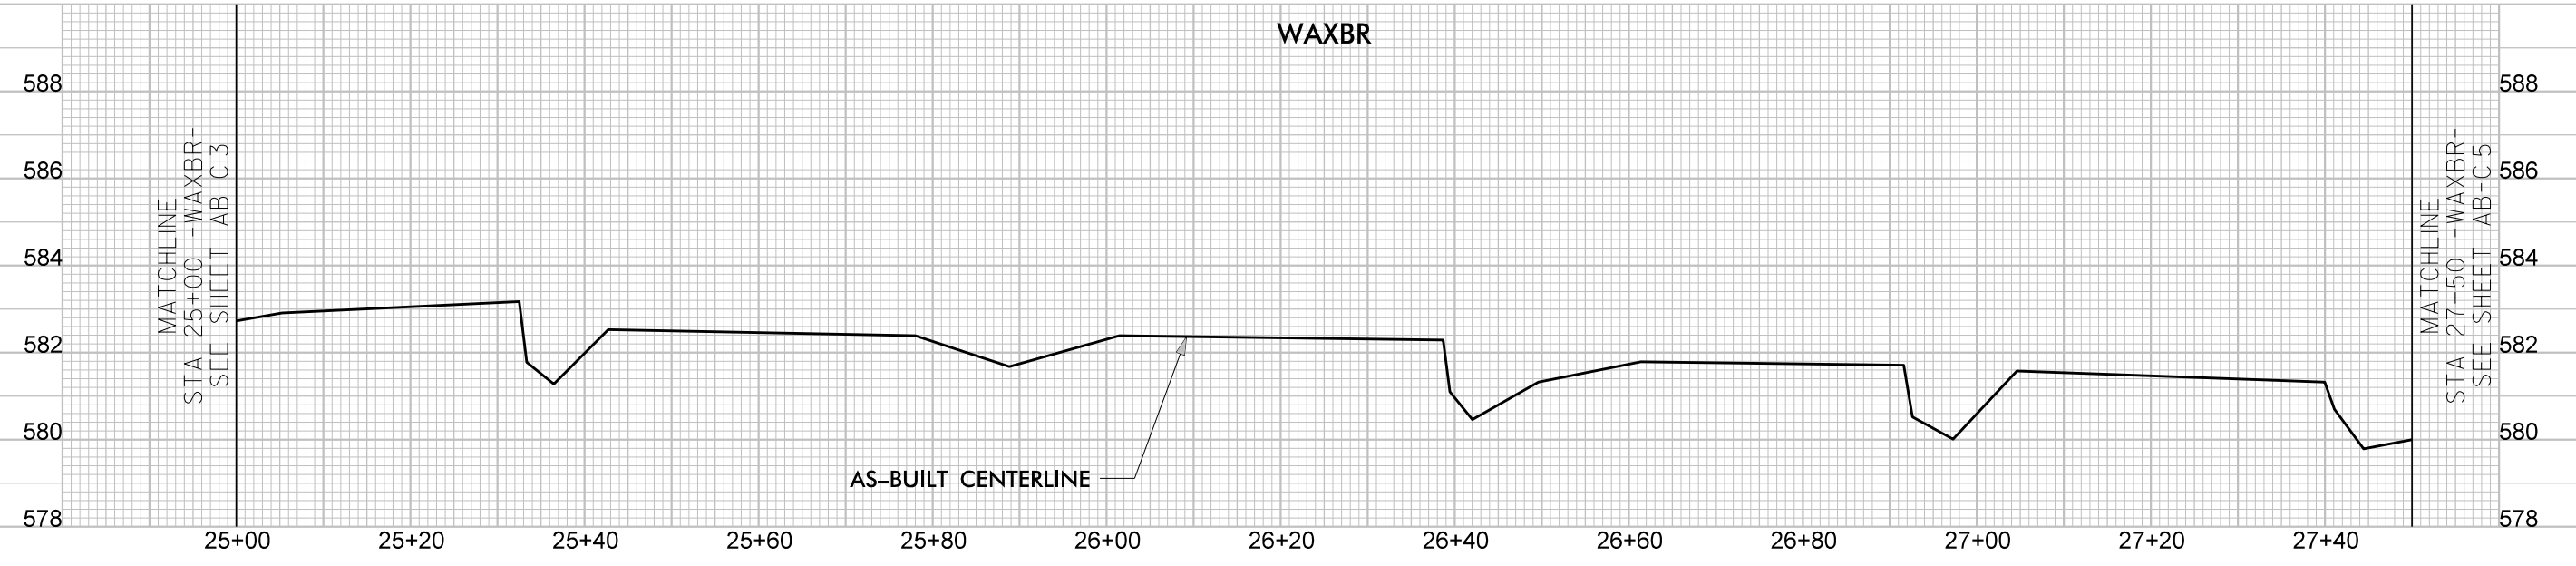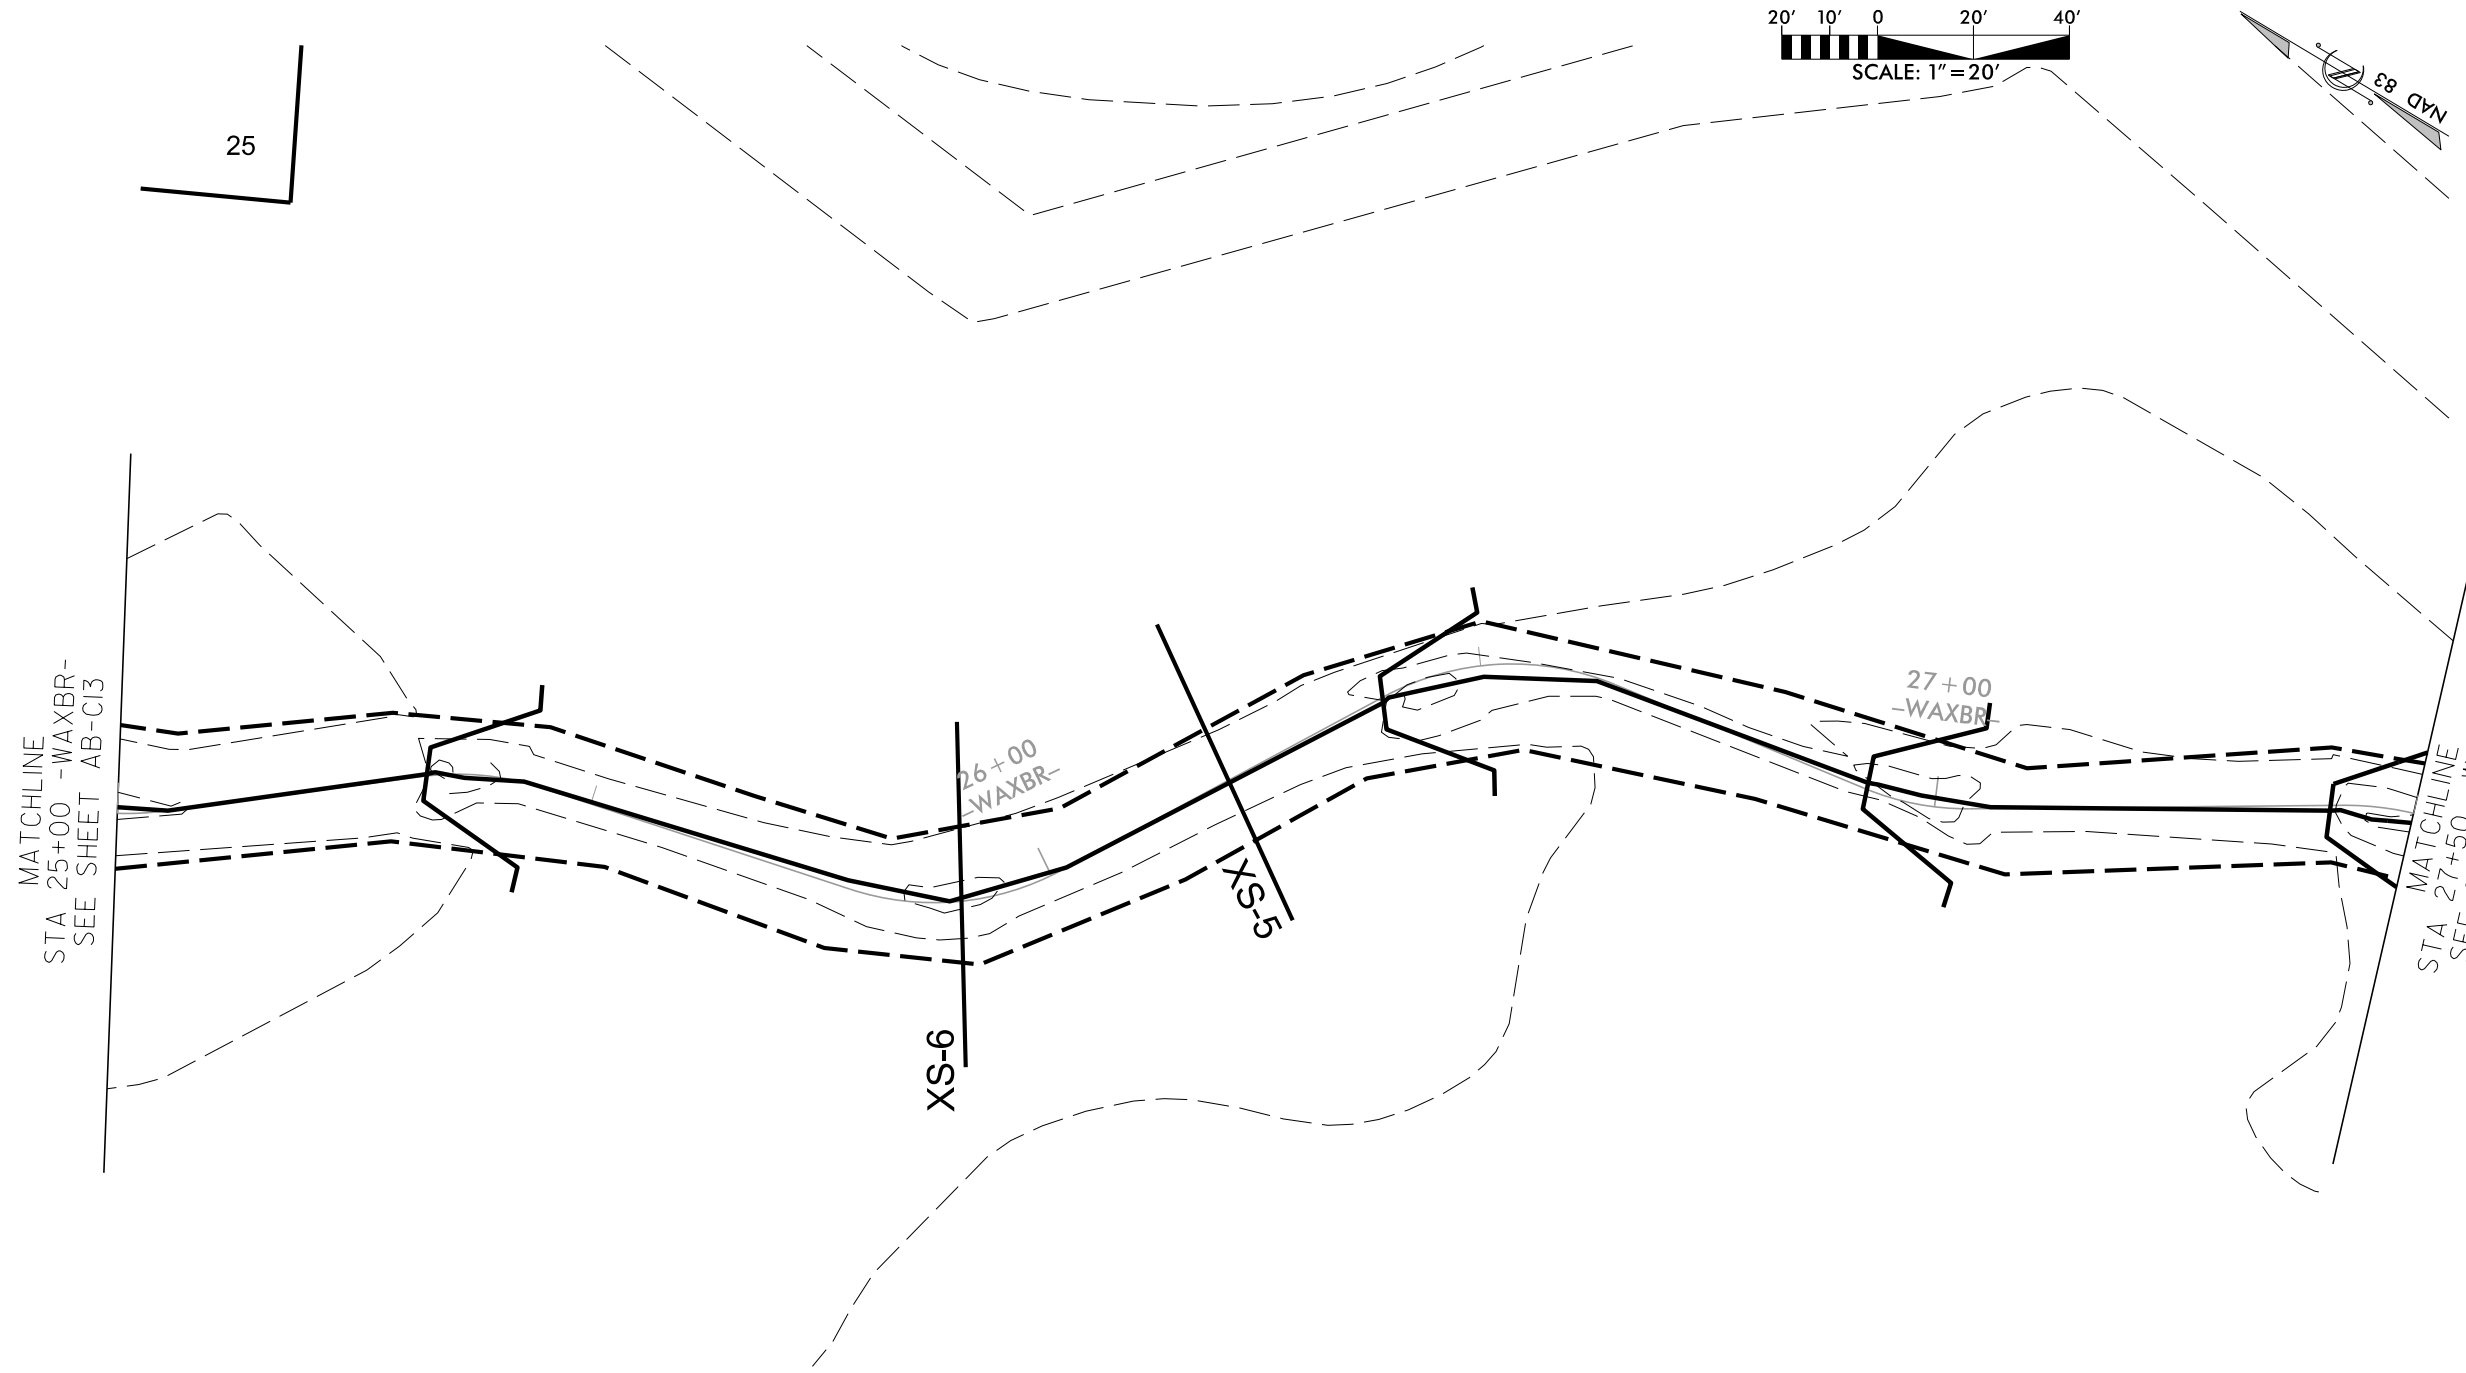

11/9/2022  
Wits\_End\_Psh\_AB-C14.dgn  
10:00 AM

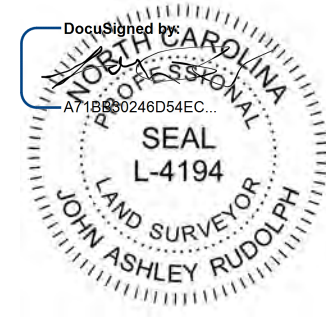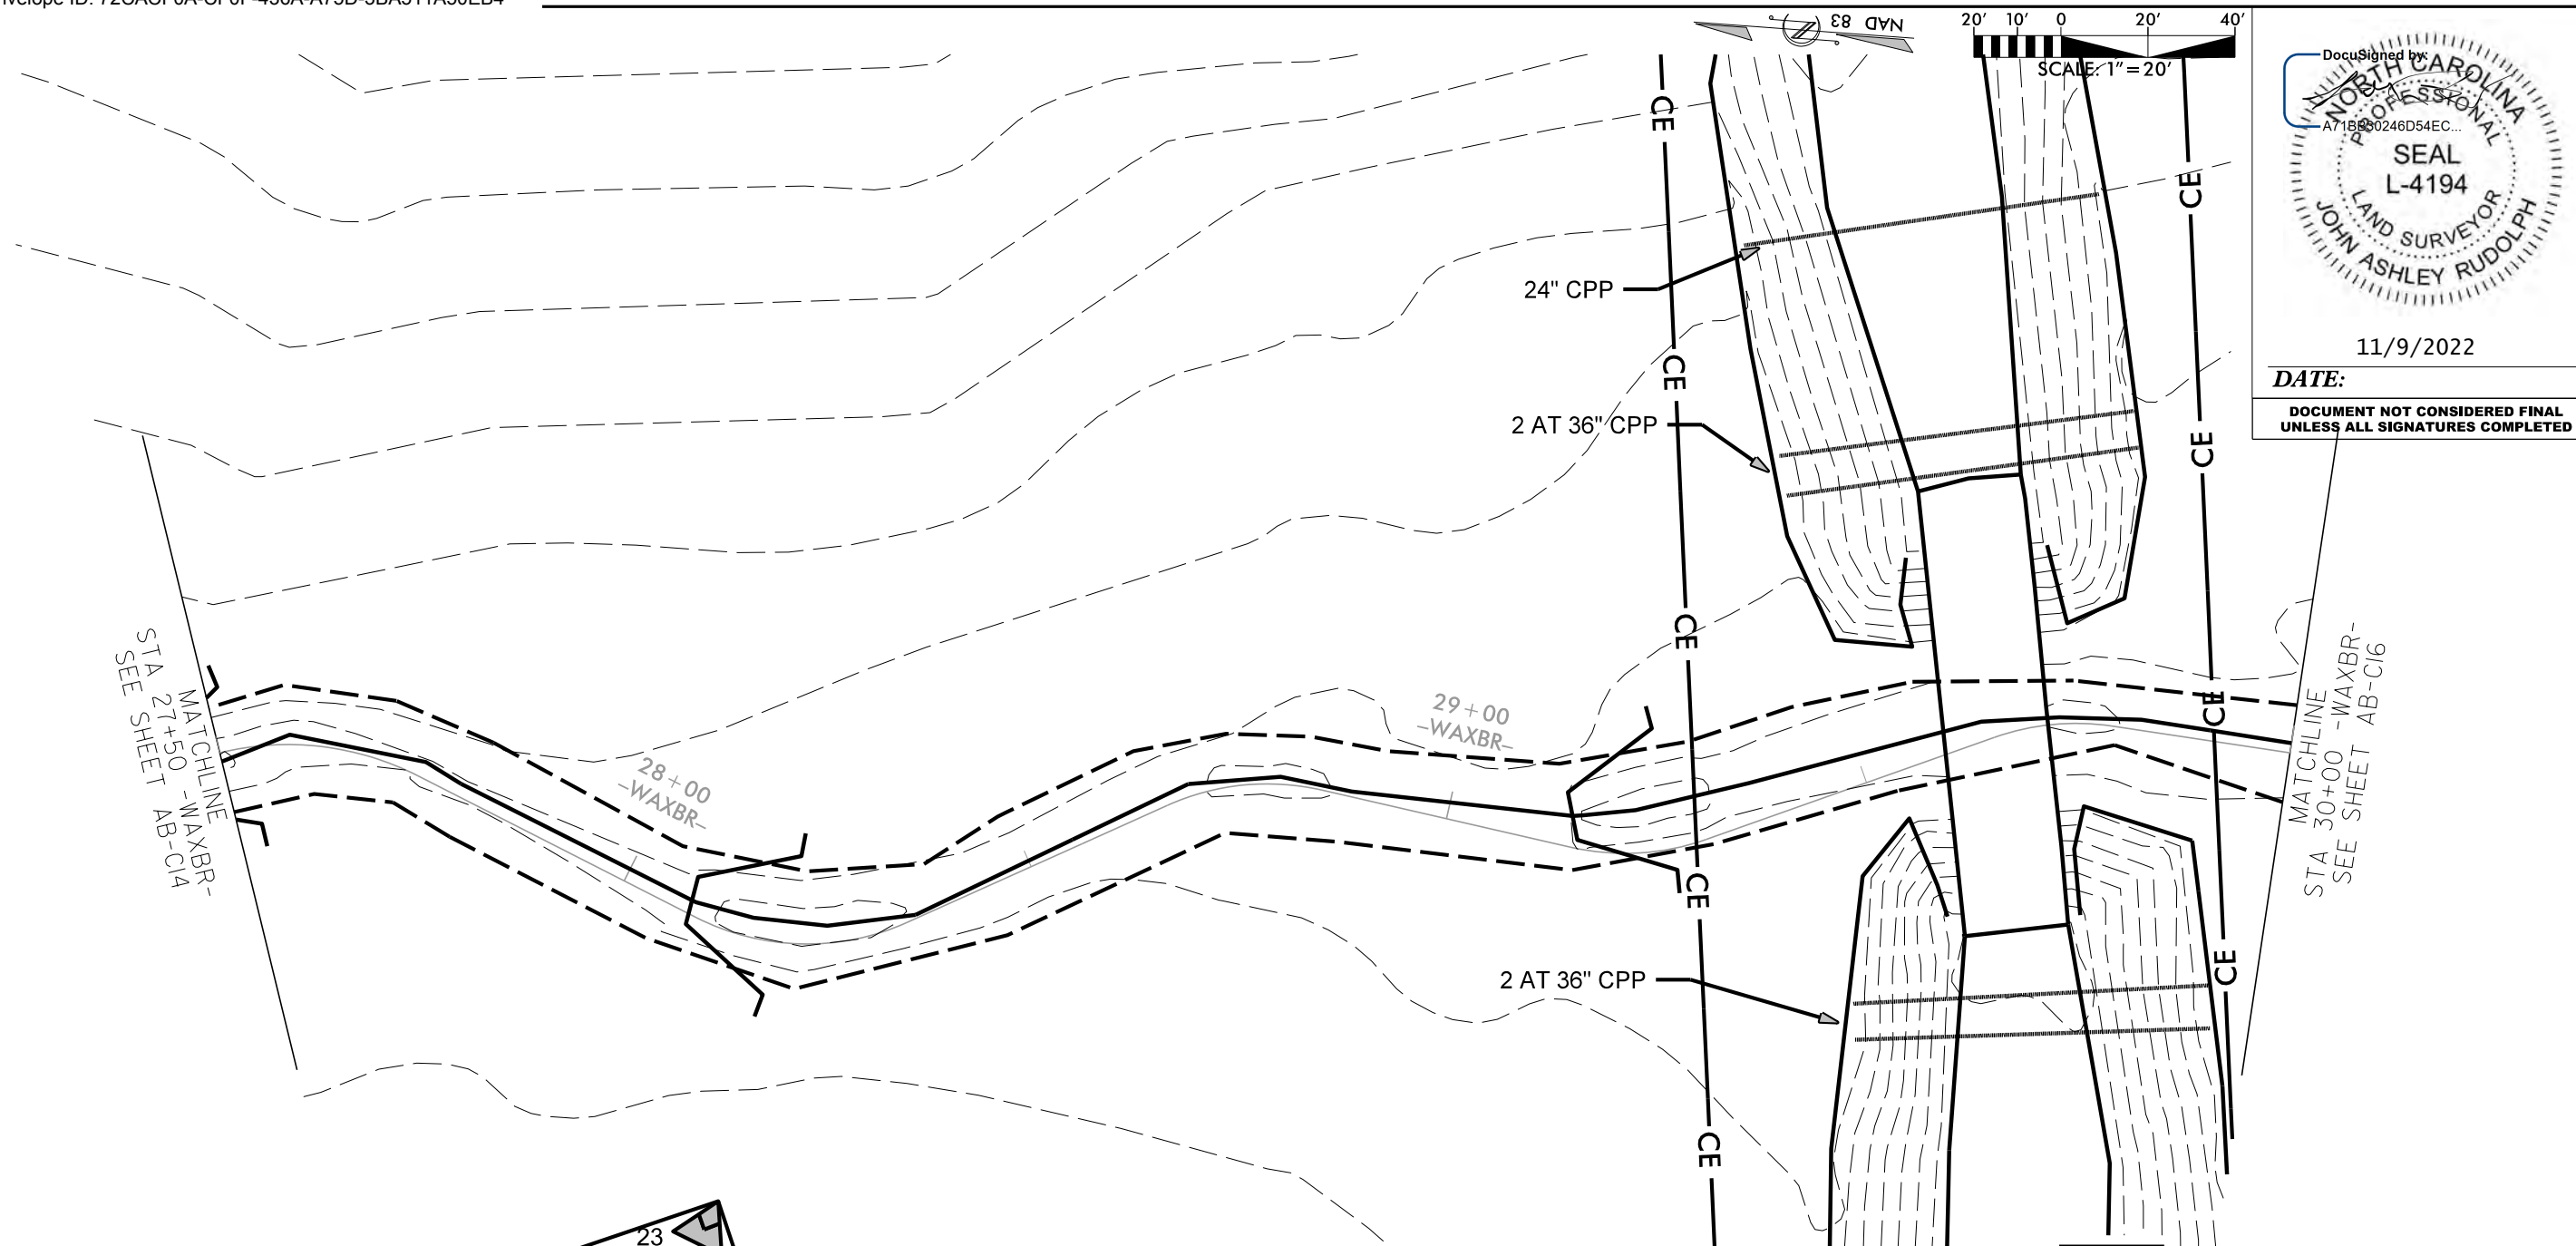


DATE: 11/9/2022  
 DOCUMENT NOT CONSIDERED FINAL  
 UNLESS ALL SIGNATURES COMPLETED

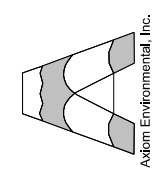

**WITS END**  
 UNION COUNTY, NC  
**AS-BUILT SURVEY**



PROJECT # :	1221-20024
DRAWING NAME:	WITS END PSH AB-C15
DATE:	2022
DRAWN BY:	JRH
REVIEWED BY:	JGD
REVISIONS:	
SHEET NO.	<b>AB-C15</b>

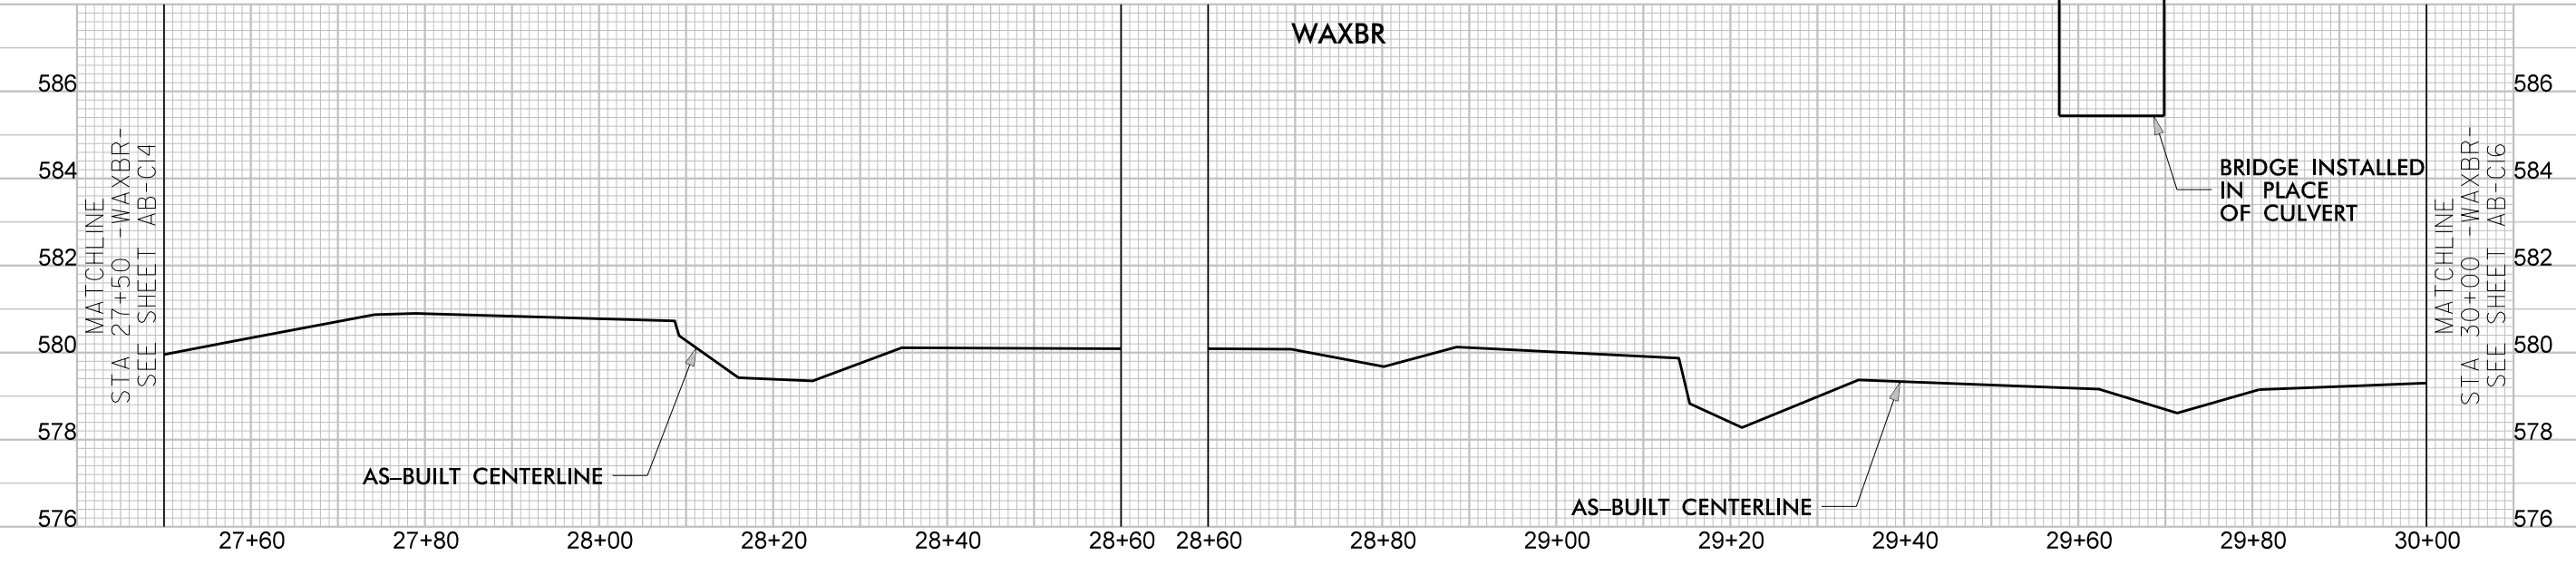

11/9/2022 Wits\_End\_Psh\_AB-C15.dgn


© 2022 SUNGATE DESIGN GROUP, P.A. THIS DRAWING AND ALL REPRODUCTIONS OF IT ARE THE SOLE PROPERTY OF SDG. REPRODUCTION OR OTHER USES OF THIS DRAWING WITHOUT WRITTEN CONSENT OF SDG IS NOT PERMITTED.



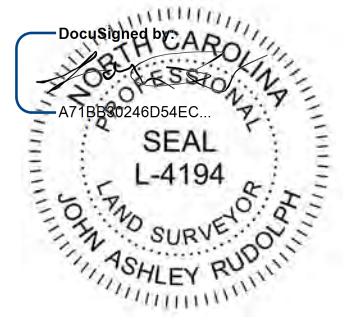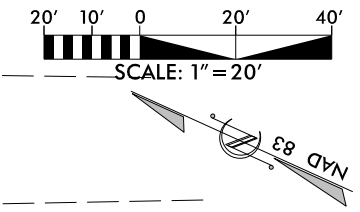

11/9/2022

**DATE:**  
**DOCUMENT NOT CONSIDERED FINAL  
UNLESS ALL SIGNATURES COMPLETED**


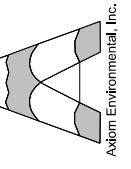


© 2022 SUNGATE DESIGN GROUP, P.A. THIS DRAWING AND ALL REPRODUCTIONS OF IT ARE THE SOLE PROPERTY OF SDG. REPRODUCTION OR OTHER USES OF THIS DRAWING WITHOUT WRITTEN CONSENT OF SDG IS NOT PERMITTED.



**WITS END**  
**UNION COUNTY, NC**  
**AS-BUILT SURVEY**

PROJECT # :  
1221-20024  
DRAWING NAME:  
WITS END PSH AB-C16  
DATE:  
2022  
DRAWN BY:  
JRH  
REVIEWED BY:  
JGD  
REVISIONS:

SHEET NO.  
**AB-C16**

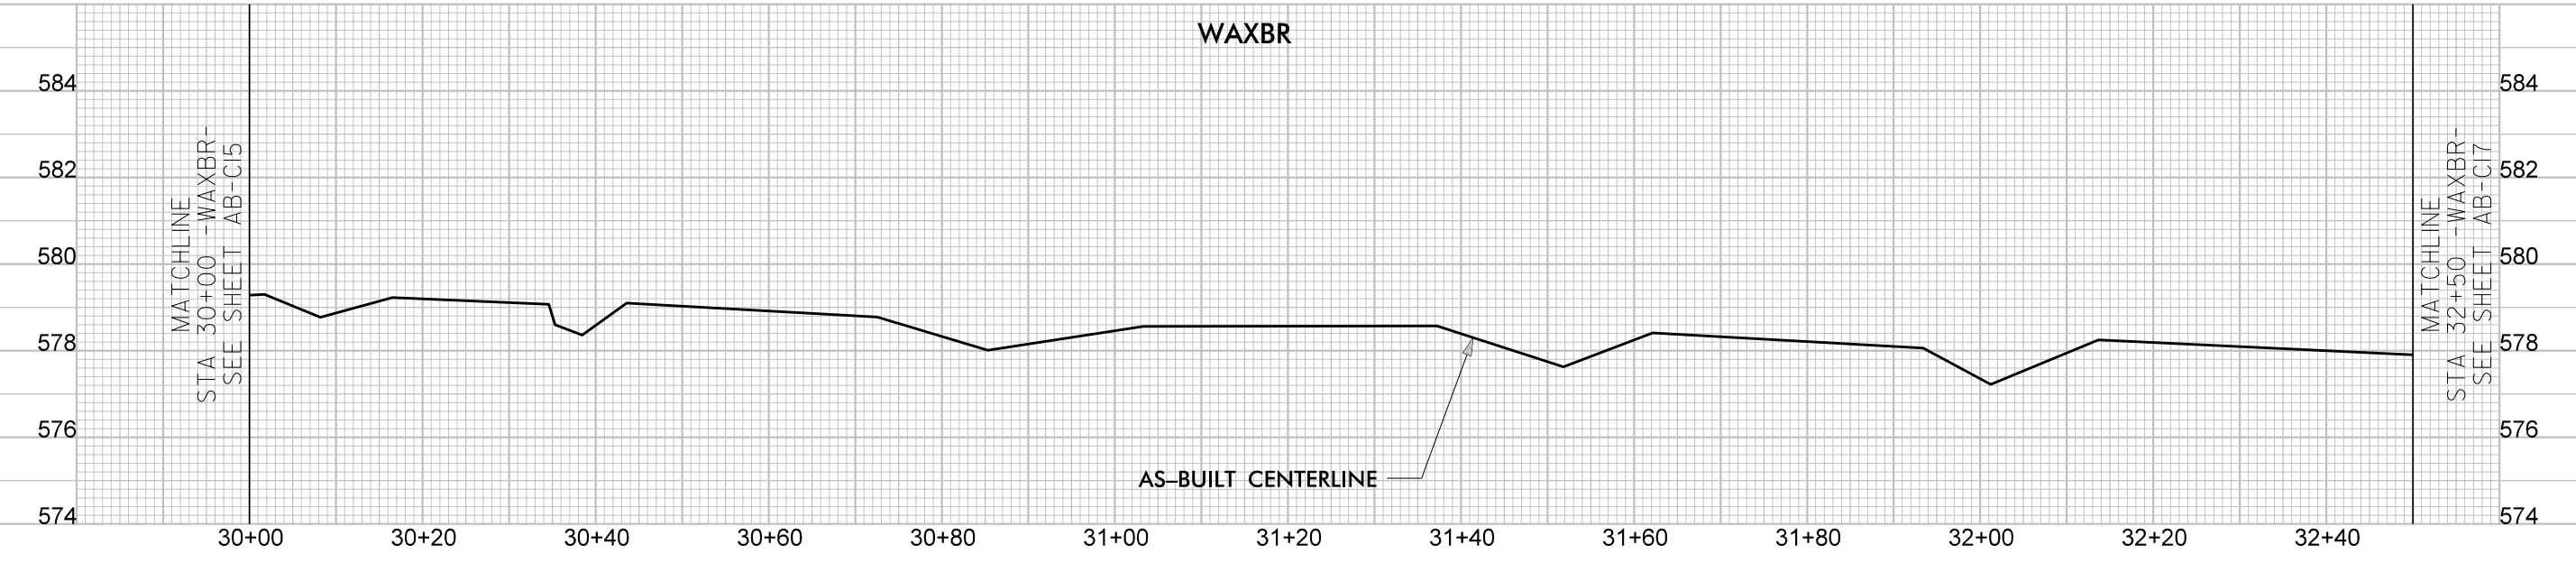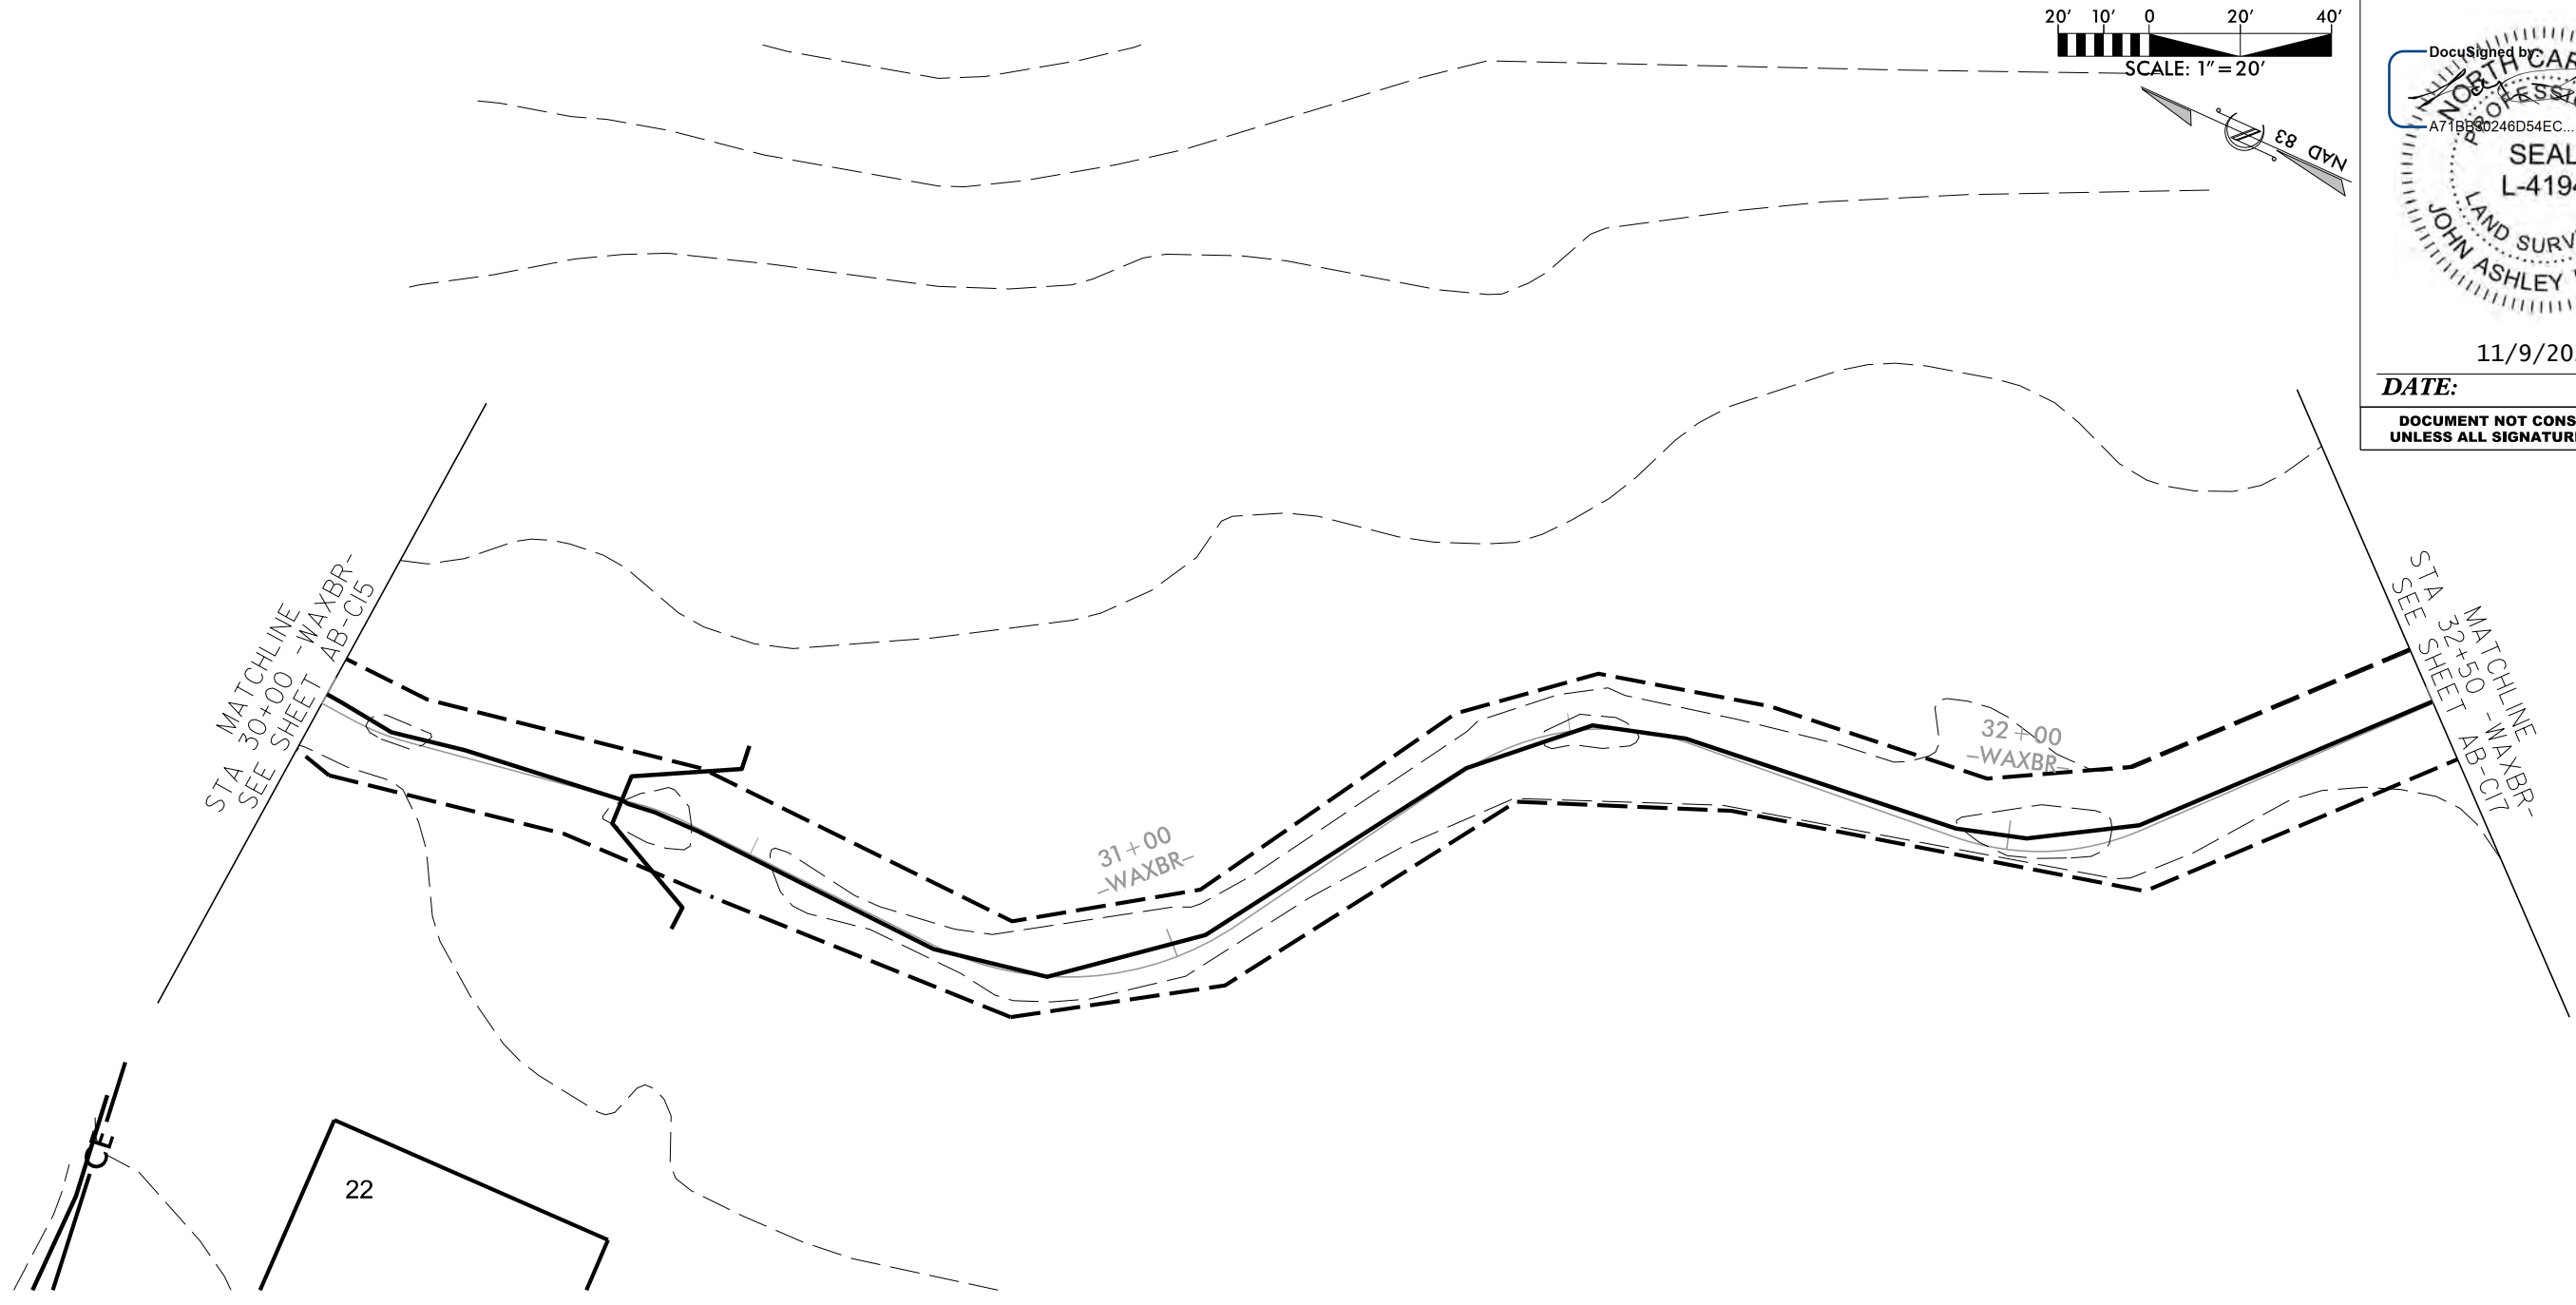


11/9/2022  
Wits\_End\_Psh\_AB-C16.dgn  
jrh

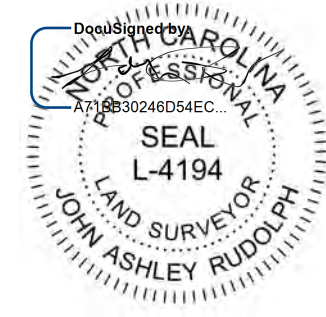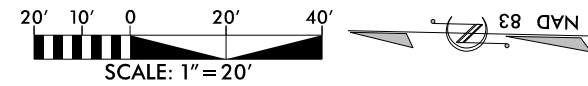

11/9/2022

**DATE:**  
**DOCUMENT NOT CONSIDERED FINAL  
UNLESS ALL SIGNATURES COMPLETED**


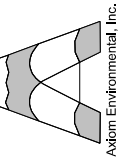


© 2022 SUNGATE DESIGN GROUP, P.A. THIS DRAWING AND ALL REPRODUCTIONS OF IT ARE THE SOLE PROPERTY OF SDG. REPRODUCTION OR OTHER USES OF THIS DRAWING WITHOUT WRITTEN CONSENT OF SDG IS NOT PERMITTED.



**WITS END**  
**UNION COUNTY, NC**  
**AS-BUILT SURVEY**

PROJECT # : 1221-20024  
DRAWING NAME: WITS END PSH AB-C17  
DATE: 2022  
DRAWN BY: JRH  
REVIEWED BY: JGD  
REVISIONS:

SHEET NO.  
**AB-C17**

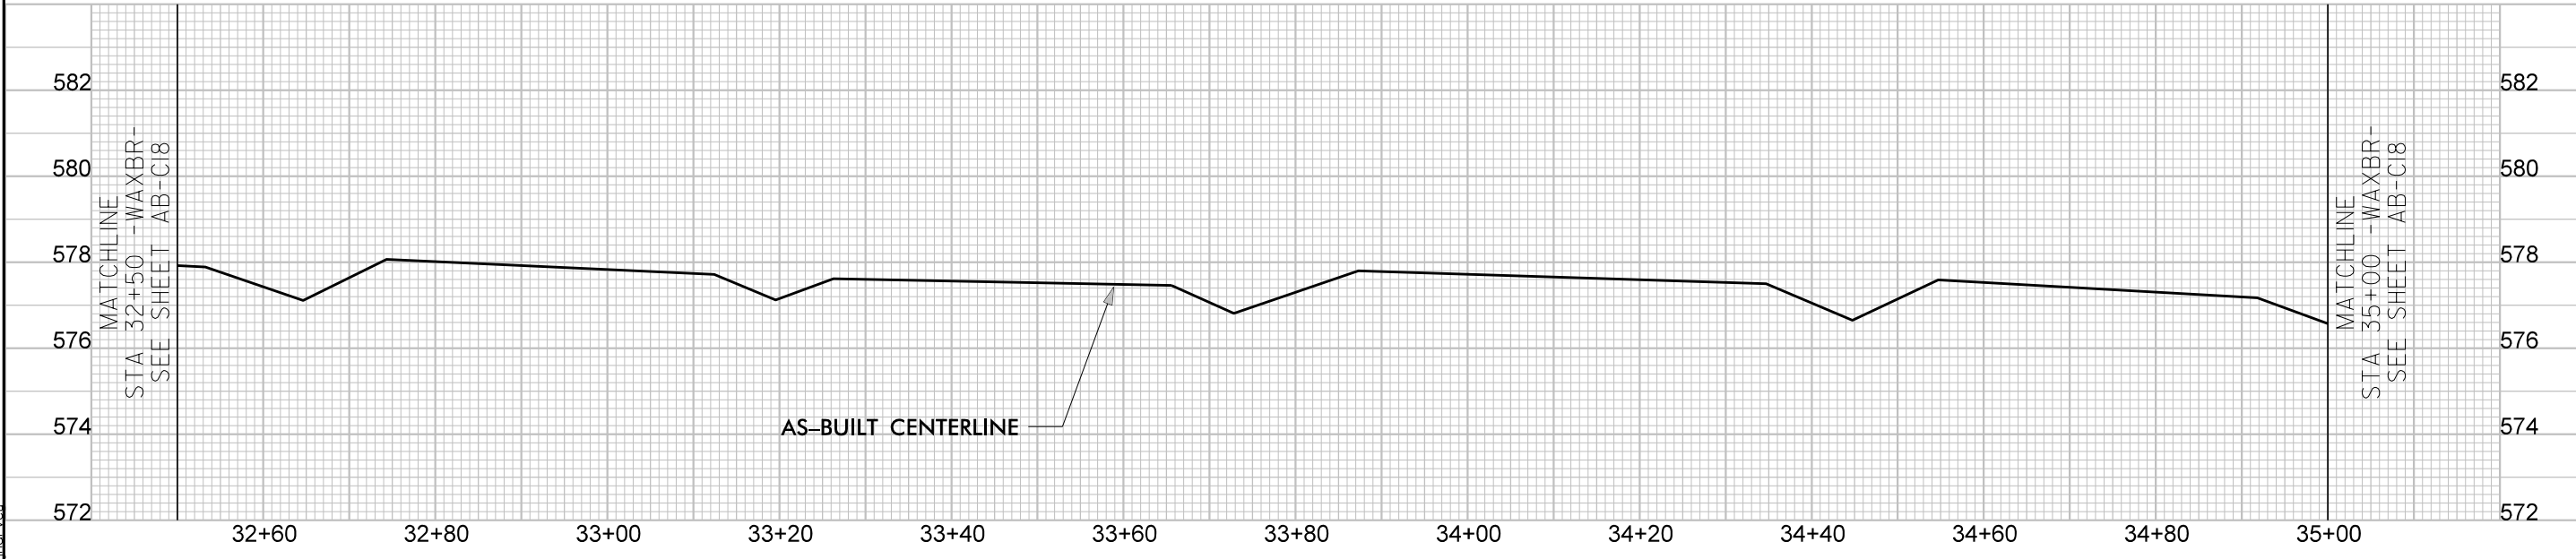
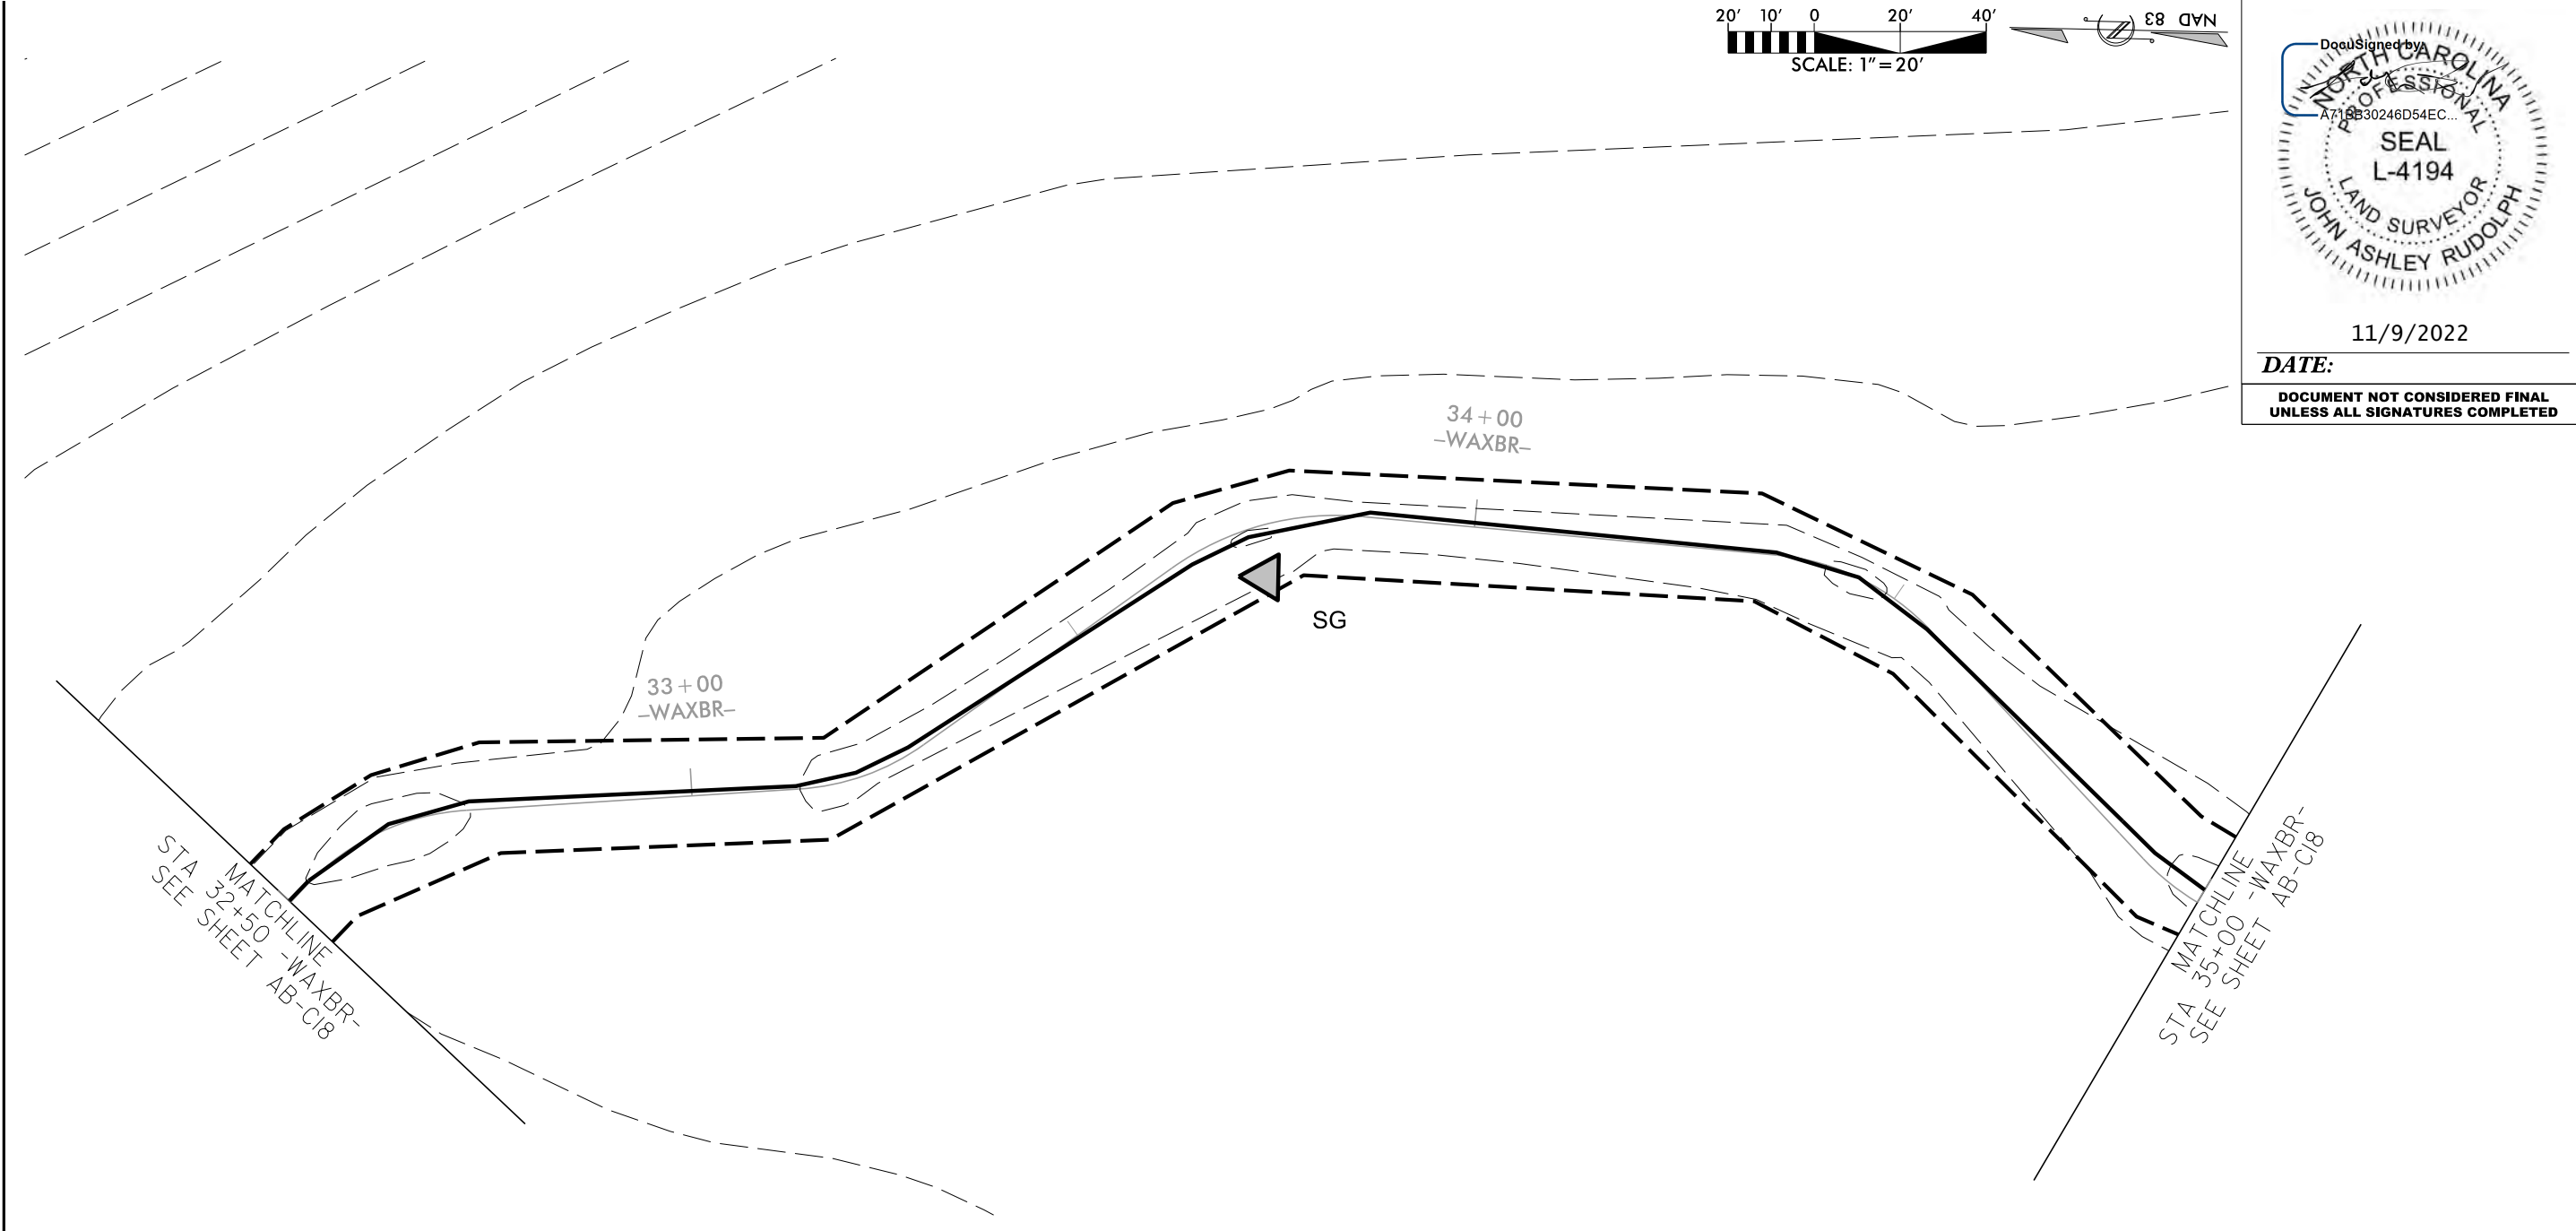


11/9/2022  
Wits\_End\_Psh\_AB-C17.dgn  
jrh

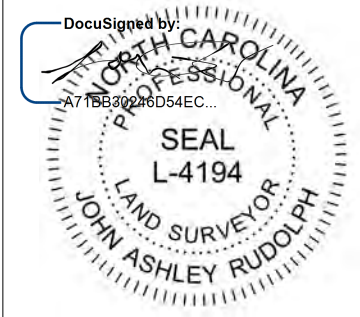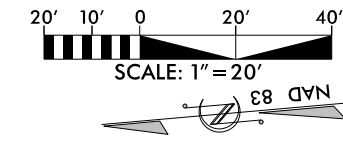


11/9/2022

**DATE:**  
**DOCUMENT NOT CONSIDERED FINAL**  
**UNLESS ALL SIGNATURES COMPLETED**

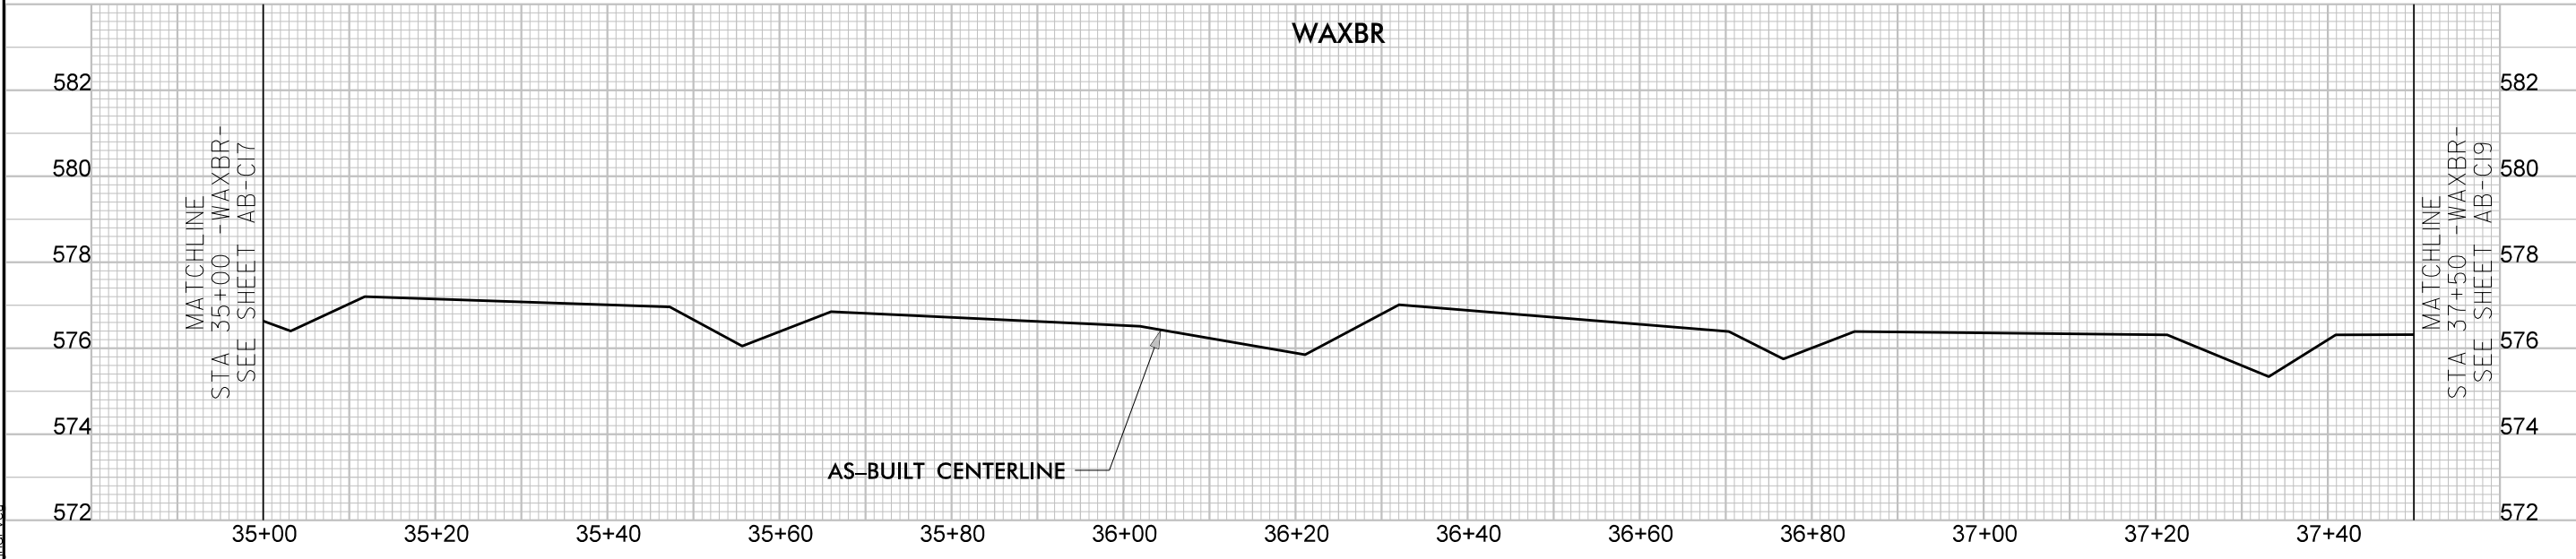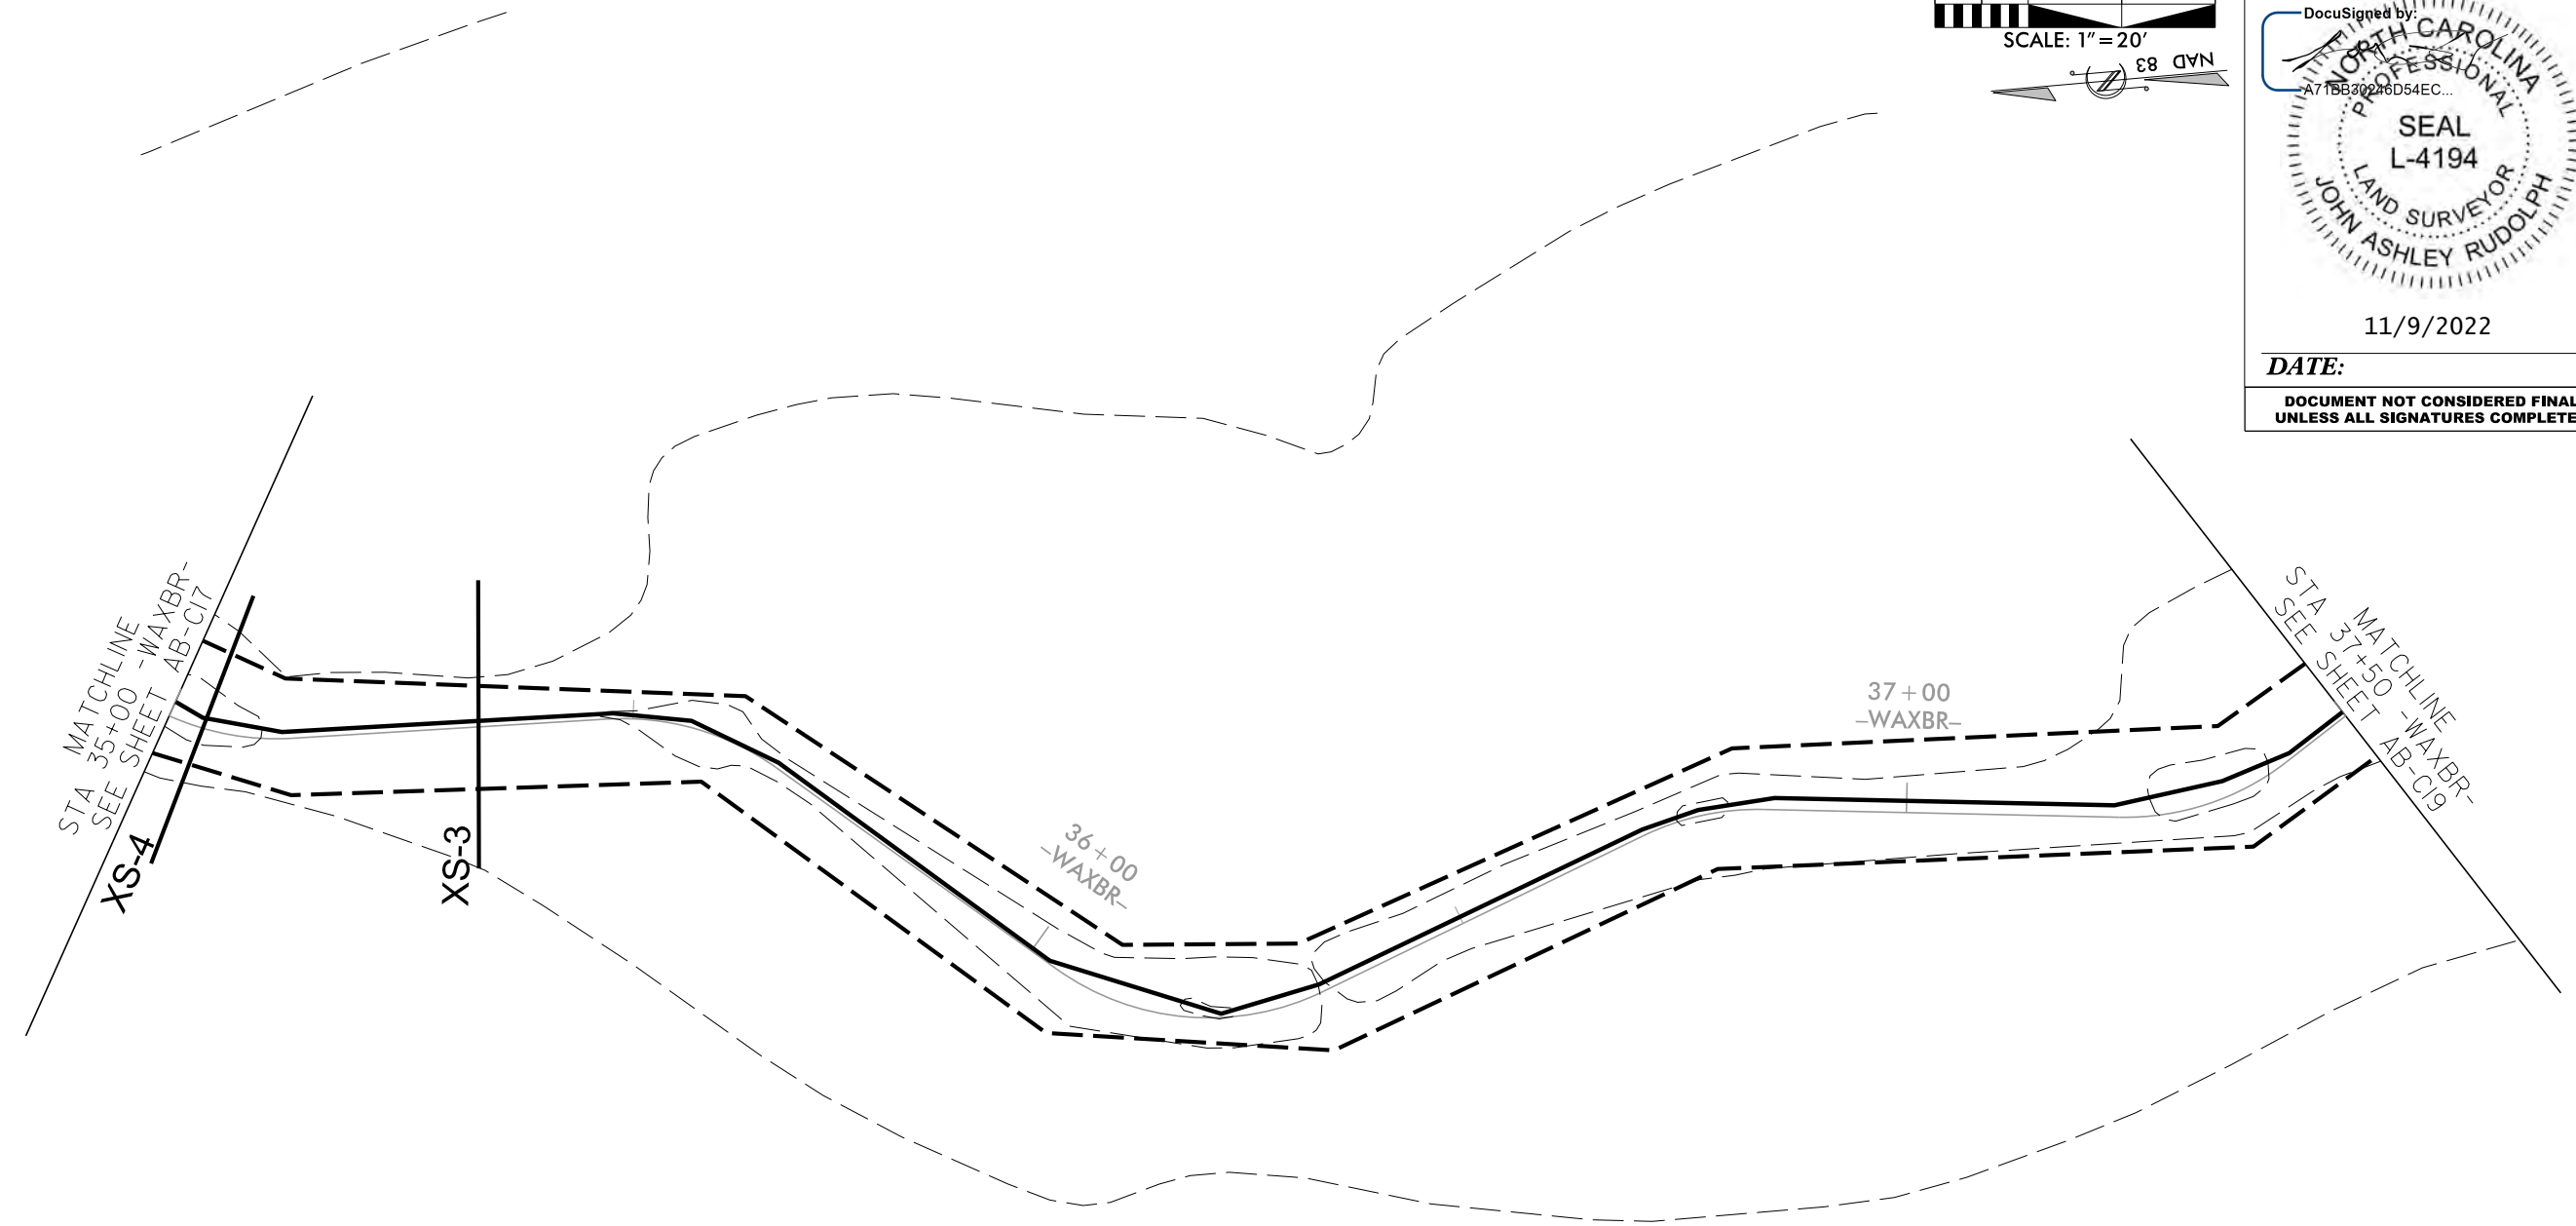

11/9/2022  
Wits\_End\_Psh\_AB-C18.dgn  
jrh

© 2022 SUNGATE DESIGN GROUP, P.A. THIS DRAWING AND ALL REPRODUCTIONS OF IT ARE THE SOLE PROPERTY OF SDG. REPRODUCTION OR OTHER USES OF THIS DRAWING WITHOUT WRITTEN CONSENT OF SDG IS NOT PERMITTED.


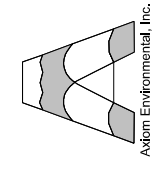


**WITS END**  
 UNION COUNTY, NC  
**AS-BUILT SURVEY**

PROJECT # :  
1221-20024  
 DRAWING NAME:  
WITS END PSH AB-C18  
 DATE:  
2022  
 DRAWN BY:  
JRH  
 REVIEWED BY:  
JGD  
 REVISIONS:


SHEET NO.  
**AB-C18**



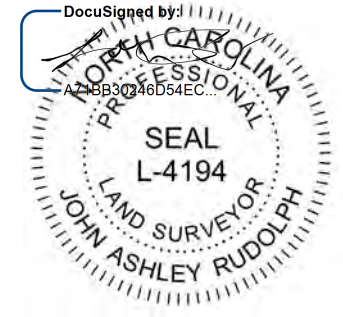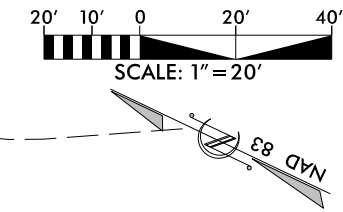

11/9/2022

**DATE:**  
**DOCUMENT NOT CONSIDERED FINAL  
UNLESS ALL SIGNATURES COMPLETED**


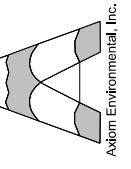


© 2022 SUNGATE DESIGN GROUP, P.A. THIS DRAWING AND ALL REPRODUCTIONS OF IT ARE THE SOLE PROPERTY OF SDG. REPRODUCTION OR OTHER USES OF THIS DRAWING WITHOUT WRITTEN CONSENT OF SDG IS NOT PERMITTED.




**WITS END  
UNION COUNTY, NC  
AS-BUILT SURVEY**

PROJECT # : 1221-20024  
 DRAWING NAME: WITS END PSH AB-C19  
 DATE: 2022  
 DRAWN BY: JRH  
 REVIEWED BY: JGD  
 REVISIONS:

SHEET NO.  
**AB-C19**


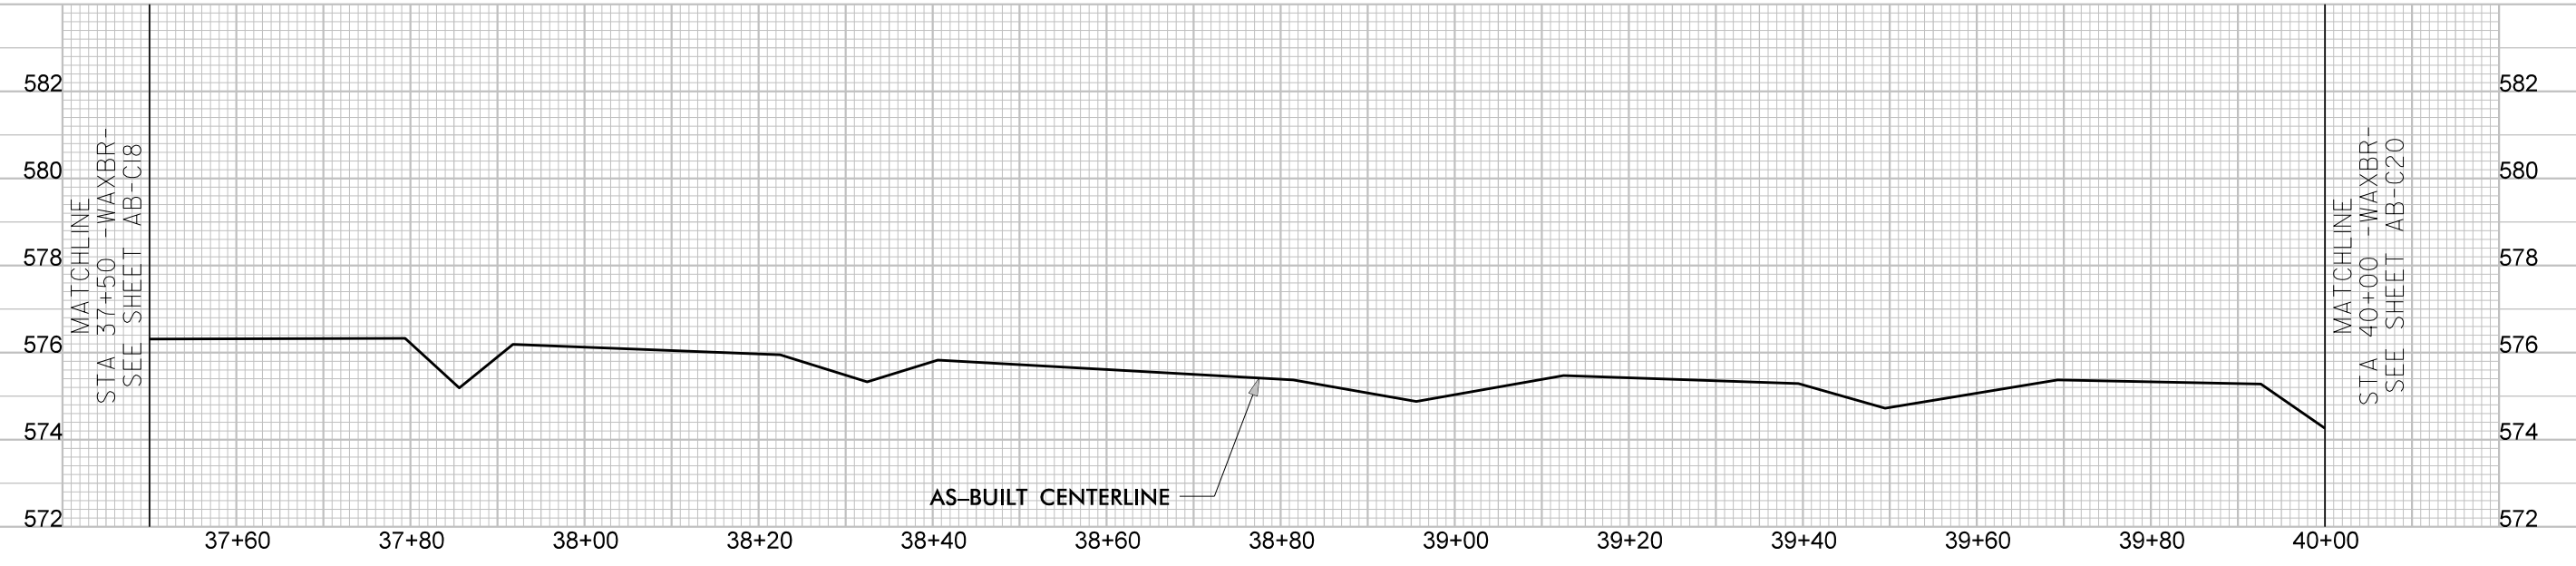
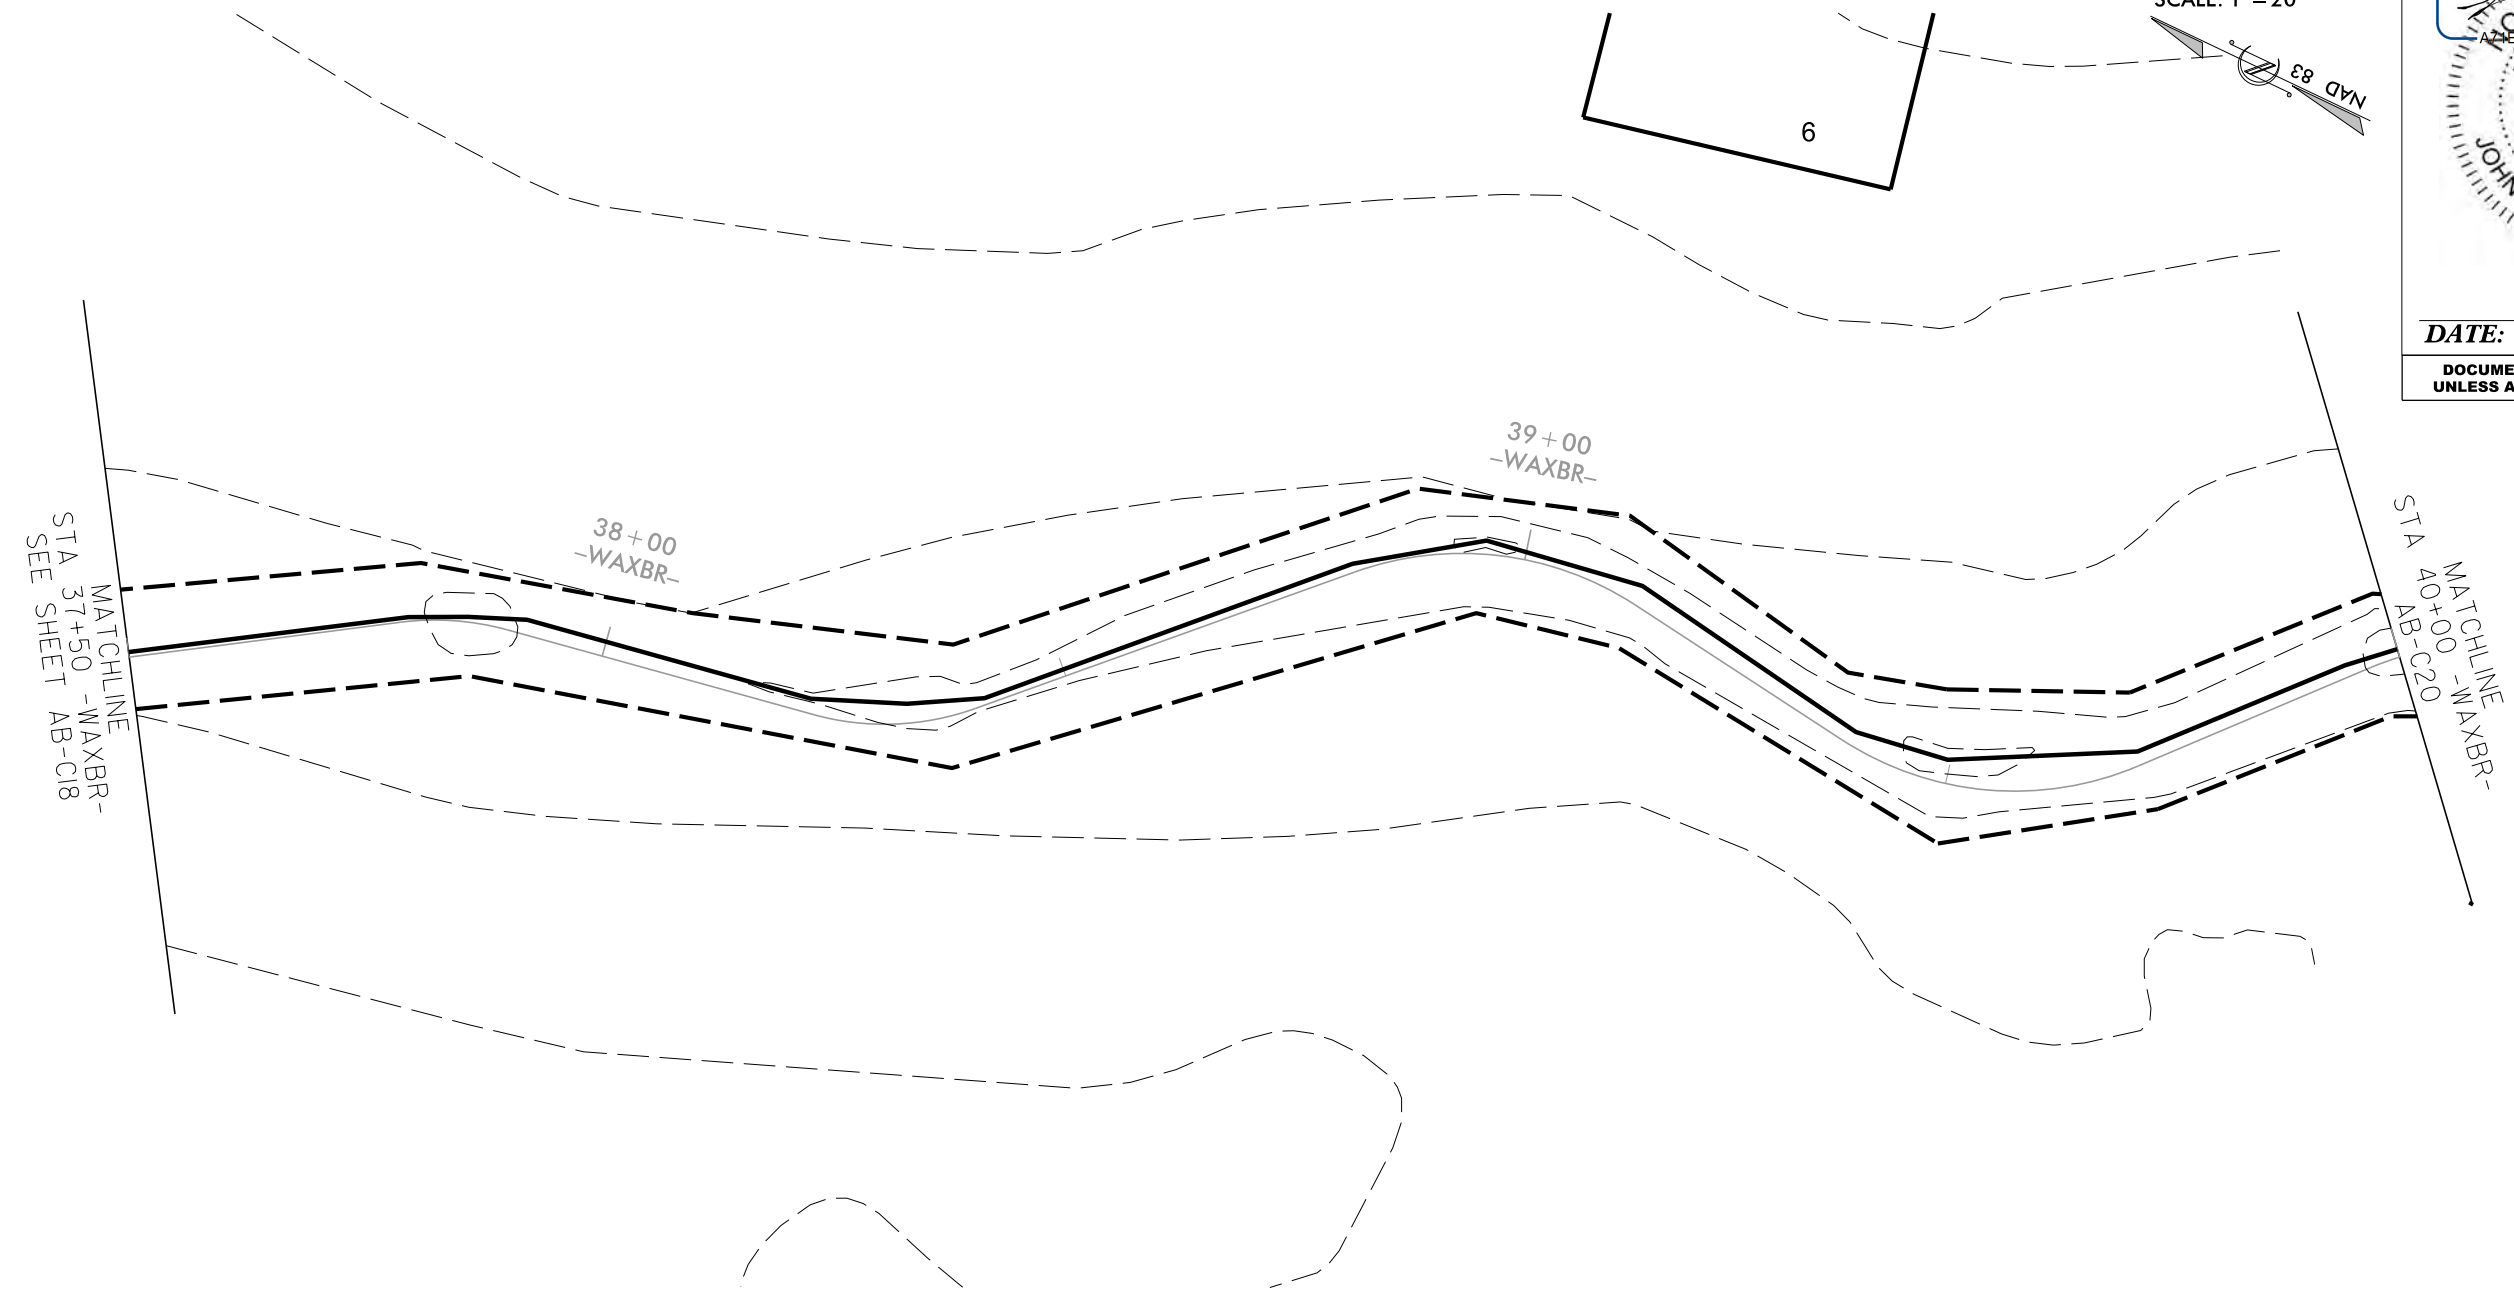


11/9/2022  
Wits\_End\_Psh\_AB-C19.dgn  
jrh

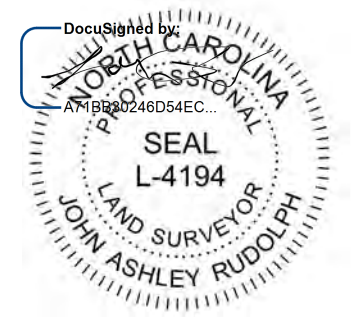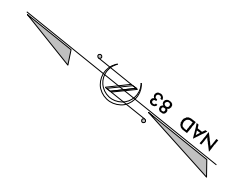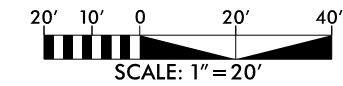

DATE: 11/9/2022

DOCUMENT NOT CONSIDERED FINAL UNLESS ALL SIGNATURES COMPLETED

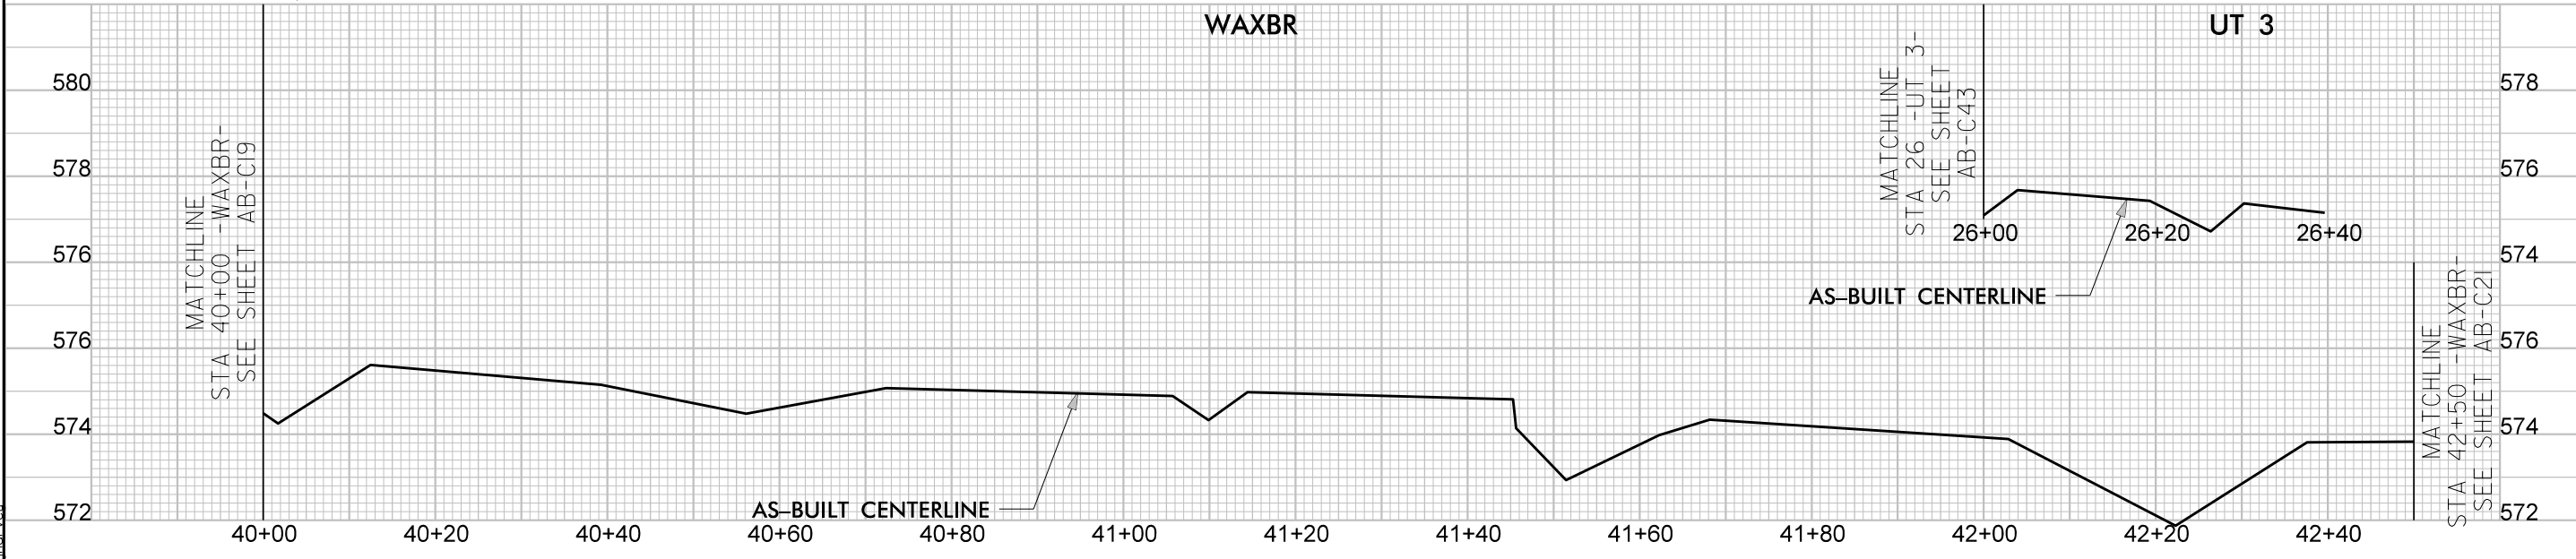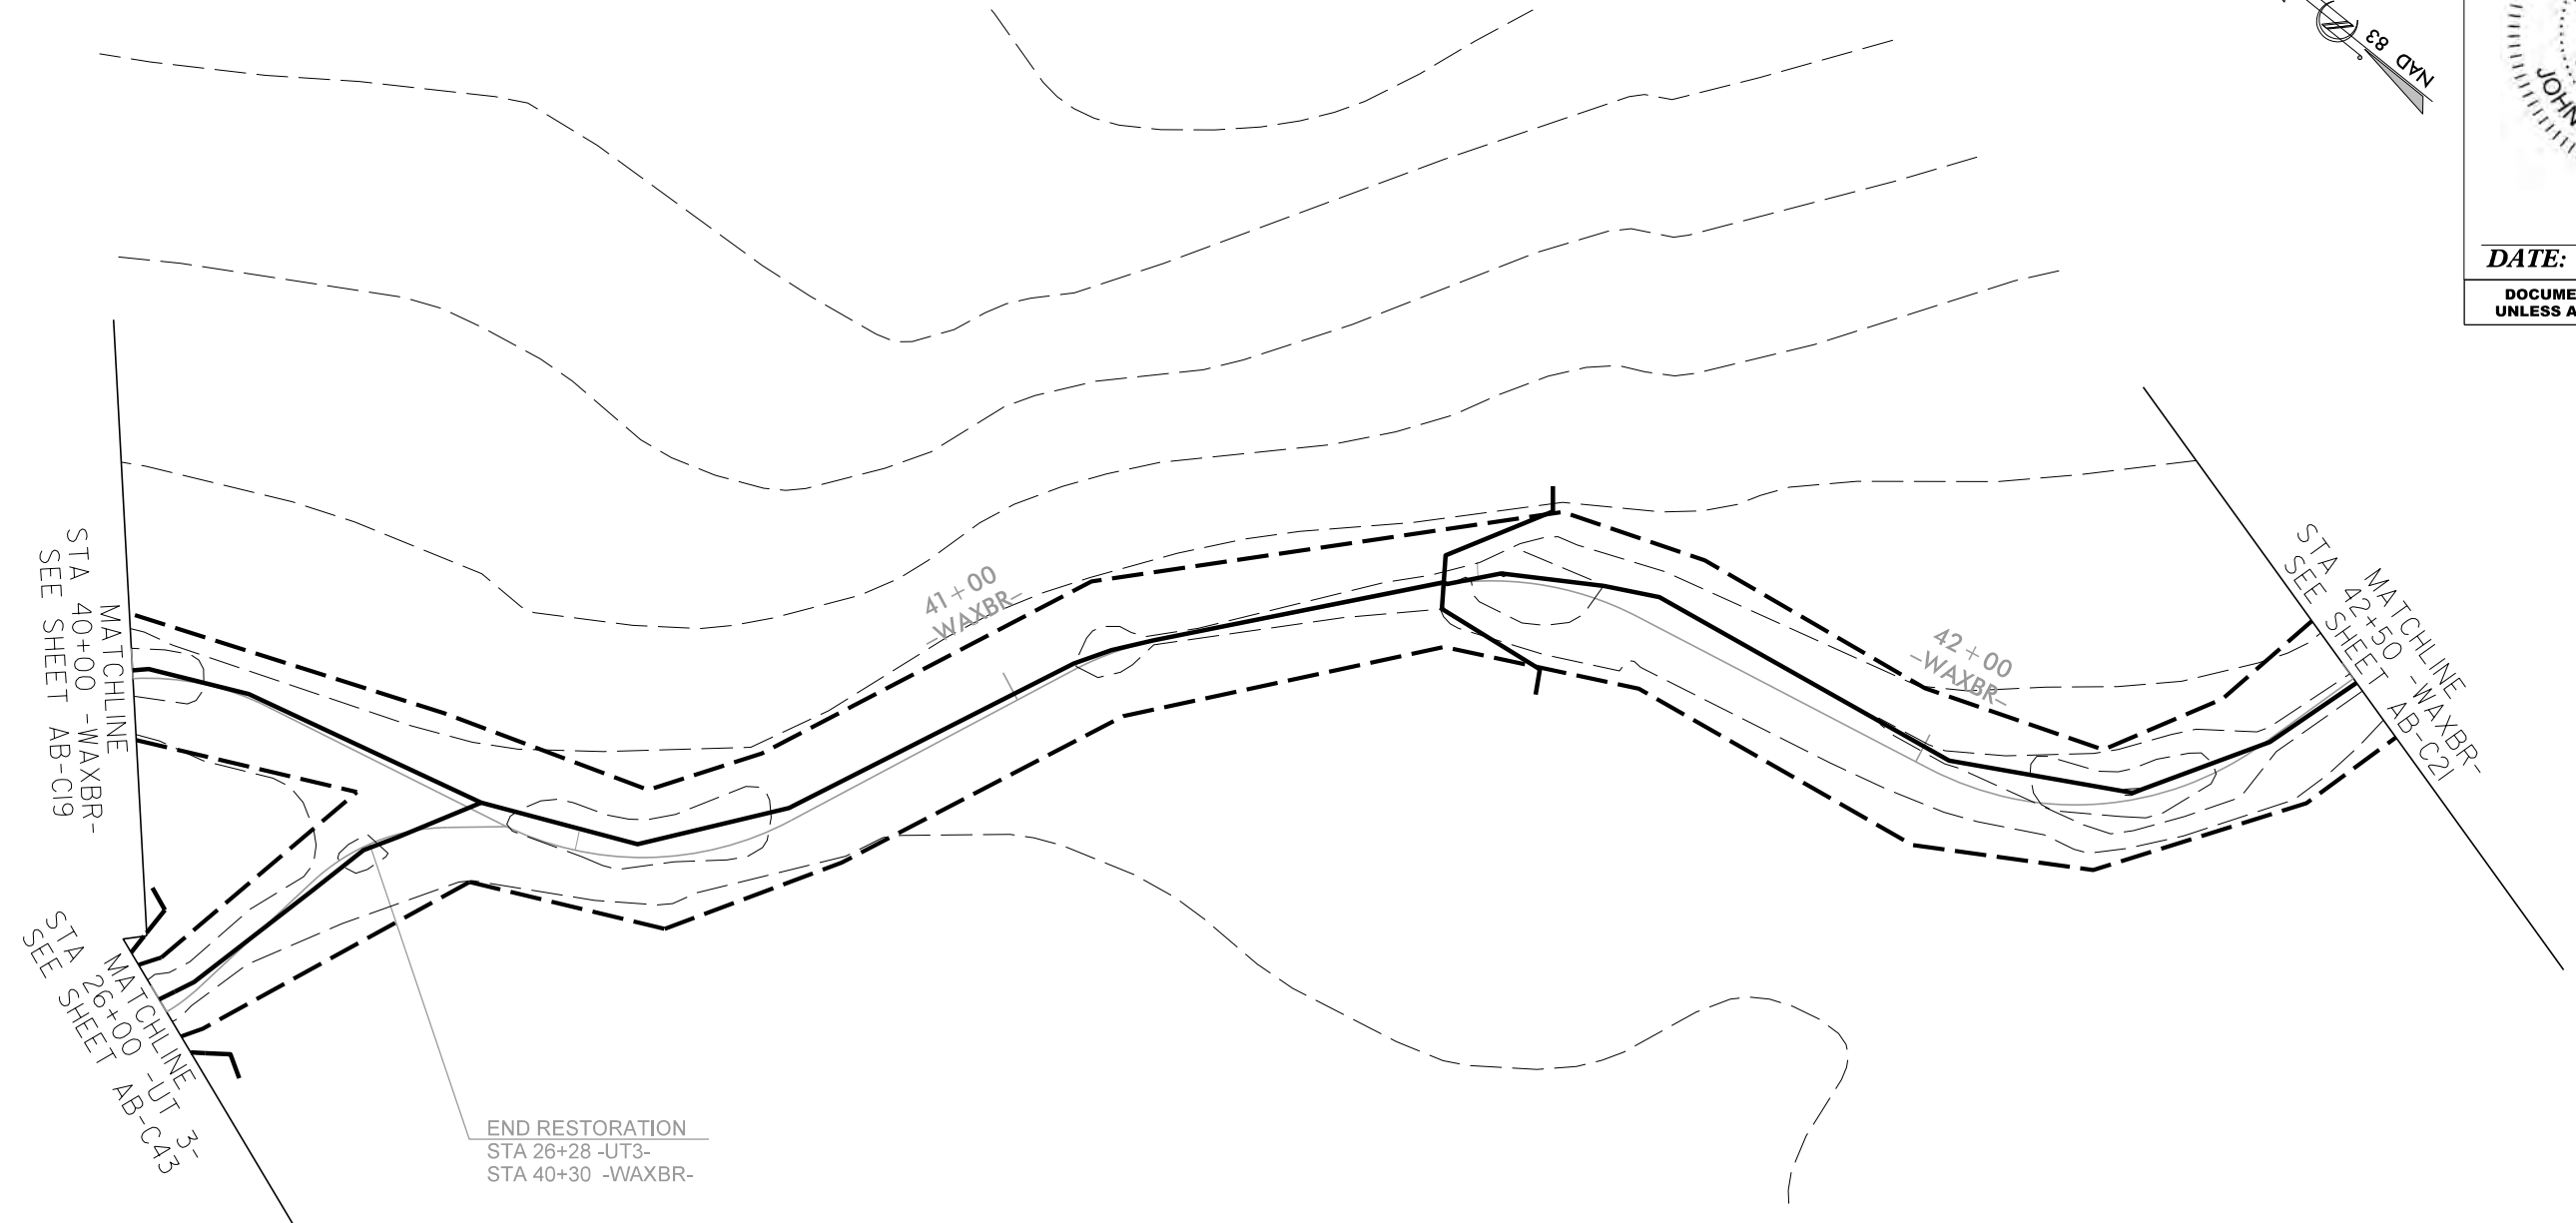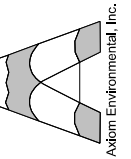



11/9/2022 Wits\_End\_psh\_AB-C20.dgn

© 2022 SUNGATE DESIGN GROUP, P.A. THIS DRAWING AND ALL REPRODUCTIONS OF IT ARE THE SOLE PROPERTY OF SDG. REPRODUCTION OR OTHER USES OF THIS DRAWING WITHOUT WRITTEN CONSENT OF SDG IS NOT PERMITTED.




WITS END UNION COUNTY, NC AS-BUILT SURVEY

PROJECT #: 1221-20024  
DRAWING NAME: WITS END PSH AB-C20  
DATE: 2022  
DRAWN BY: JRH  
REVIEWED BY: JGD  
REVISIONS:

SHEET NO. AB-C20

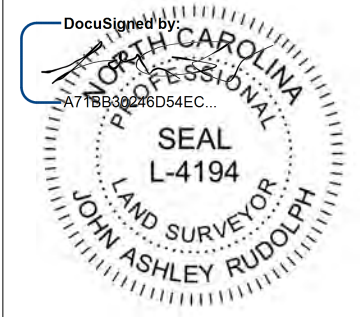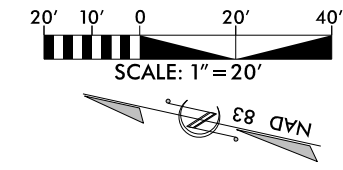

DATE: 11/9/2022  
 DOCUMENT NOT CONSIDERED FINAL  
 UNLESS ALL SIGNATURES COMPLETED

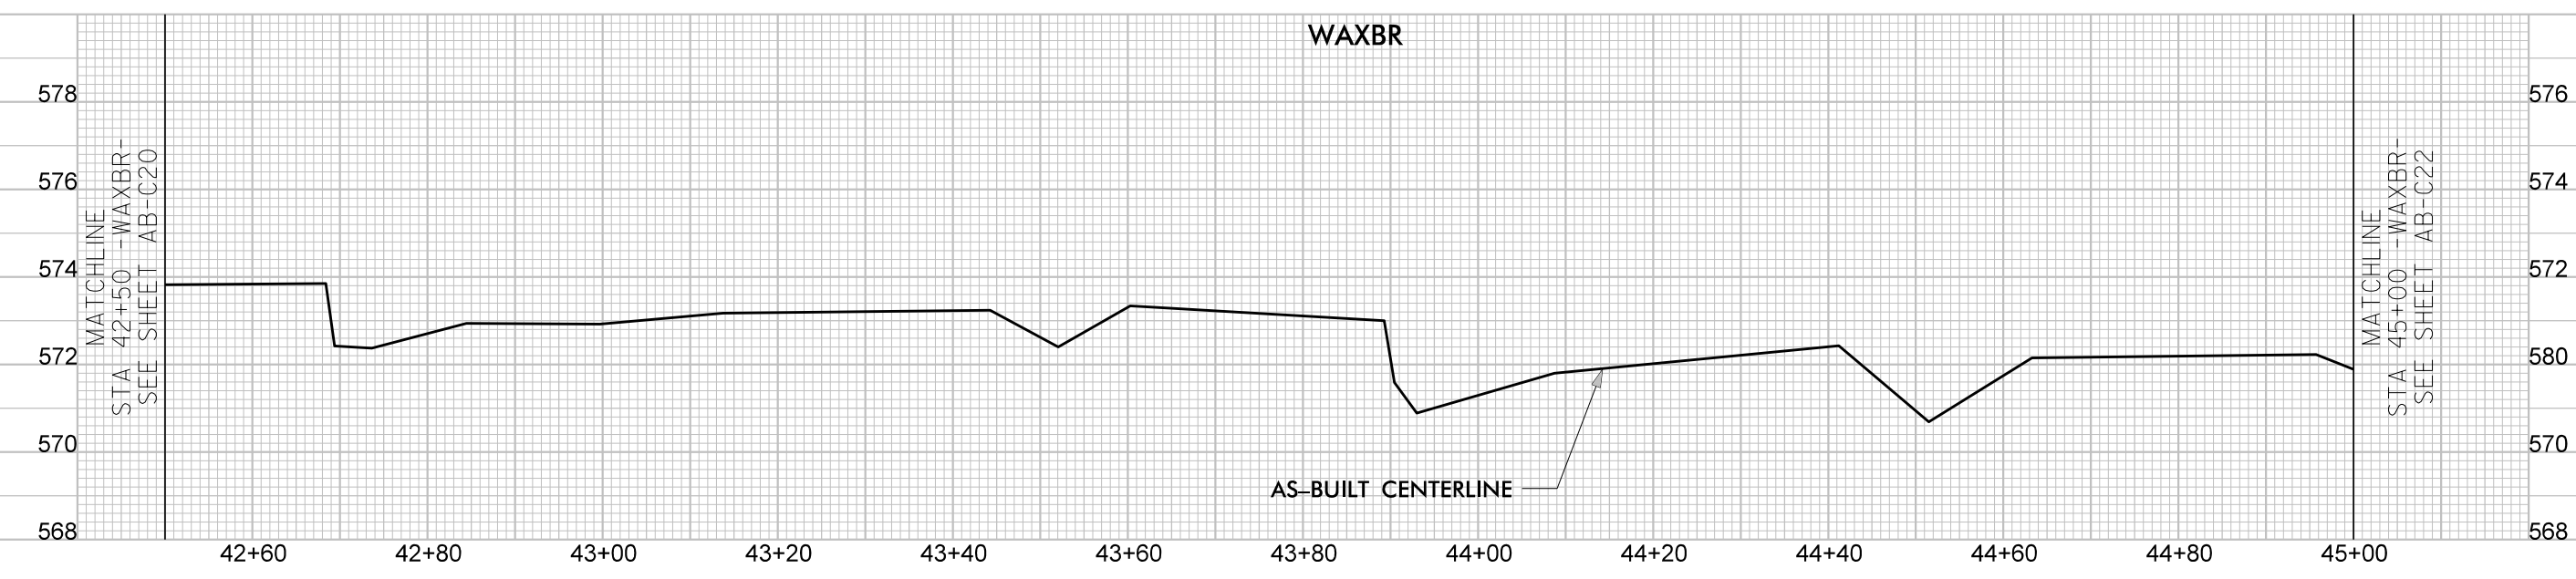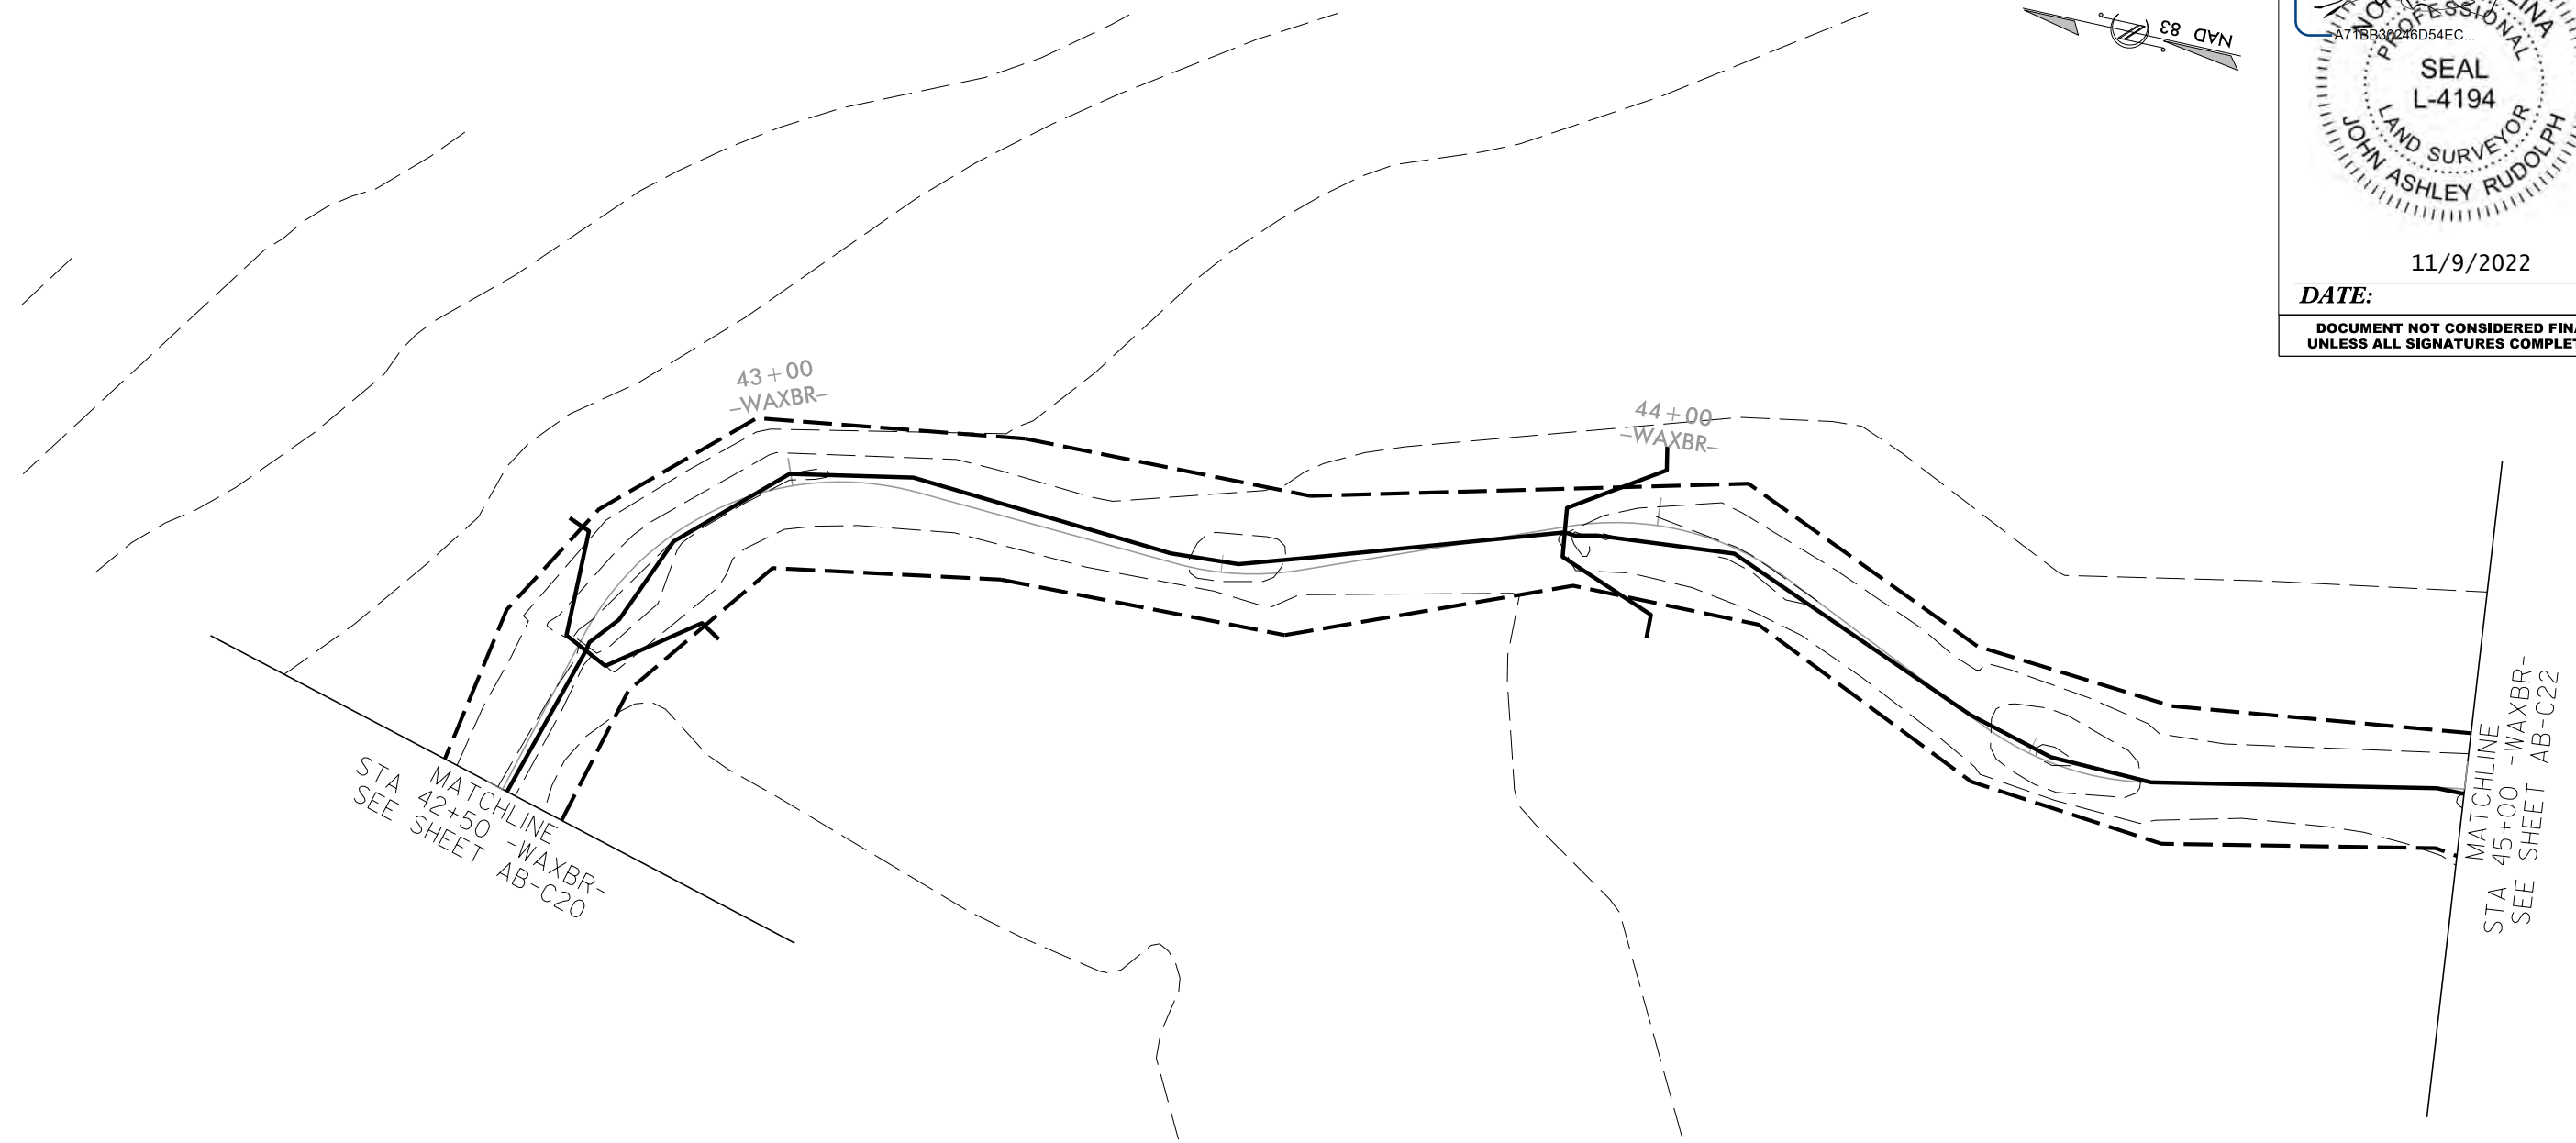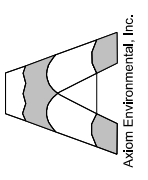

11/9/2022  
 Wits\_End\_Psh\_AB-C21.dgn  
 jrb




© 2022 SUNGATE DESIGN GROUP, P.A. THIS DRAWING AND ALL REPRODUCTIONS OF IT ARE THE SOLE PROPERTY OF SDG. REPRODUCTION OR OTHER USES OF THIS DRAWING WITHOUT WRITTEN CONSENT OF SDG IS NOT PERMITTED.

**WITS END**  
 UNION COUNTY, NC  
**AS-BUILT SURVEY**

PROJECT # : 1221-20024  
 DRAWING NAME: WITS END PSH AB-C21  
 DATE: 2022  
 DRAWN BY: JRH  
 REVIEWED BY: JGD  
 REVISIONS:


SHEET NO.  
**AB-C21**



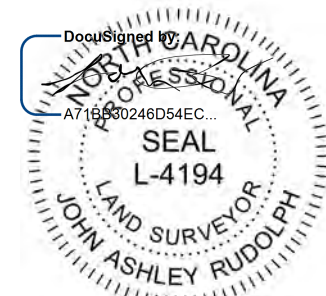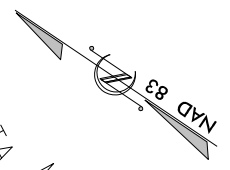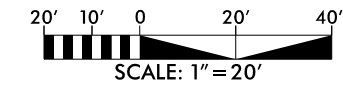

11/9/2022

DATE:  
DOCUMENT NOT CONSIDERED FINAL  
UNLESS ALL SIGNATURES COMPLETED


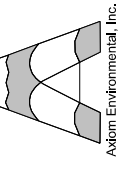


© 2022 SUNGATE DESIGN GROUP, P.A. THIS DRAWING AND ALL REPRODUCTIONS OF IT ARE THE SOLE PROPERTY OF SDG. REPRODUCTION OR OTHER USES OF THIS DRAWING WITHOUT WRITTEN CONSENT OF SDG IS NOT PERMITTED.



WITS END  
UNION COUNTY, NC  
AS-BUILT SURVEY

PROJECT # :  
1221-20024  
DRAWING NAME:  
WITS END PSH AB-C22  
DATE:  
2022  
DRAWN BY:  
JRH  
REVIEWED BY:  
JGD  
REVISIONS:

SHEET NO.  
**AB-C22**

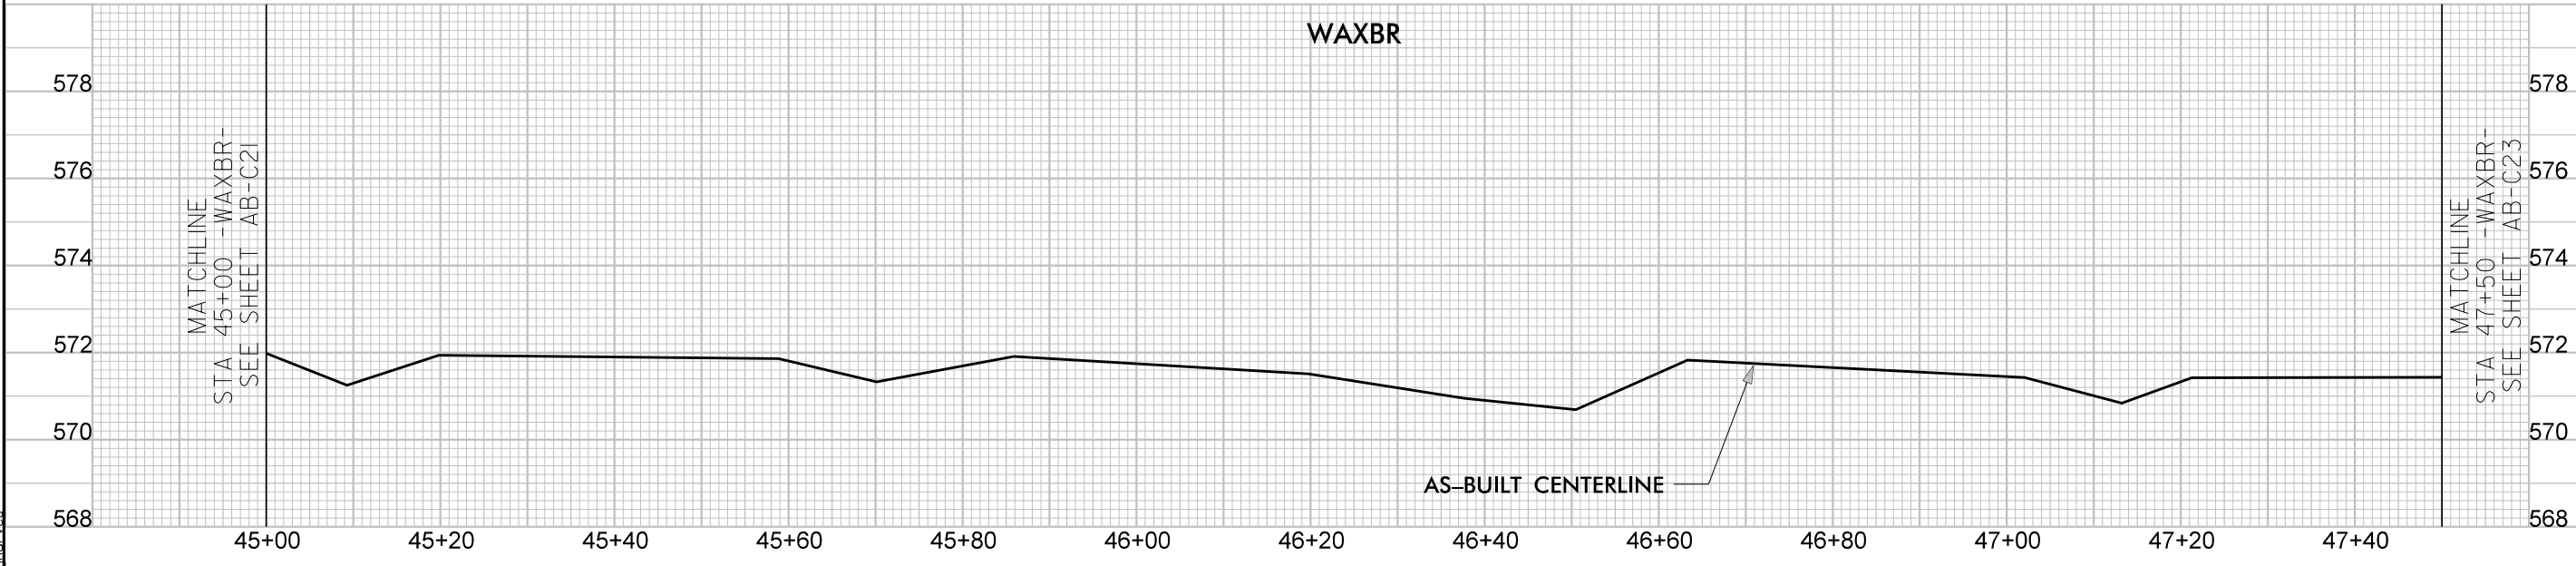
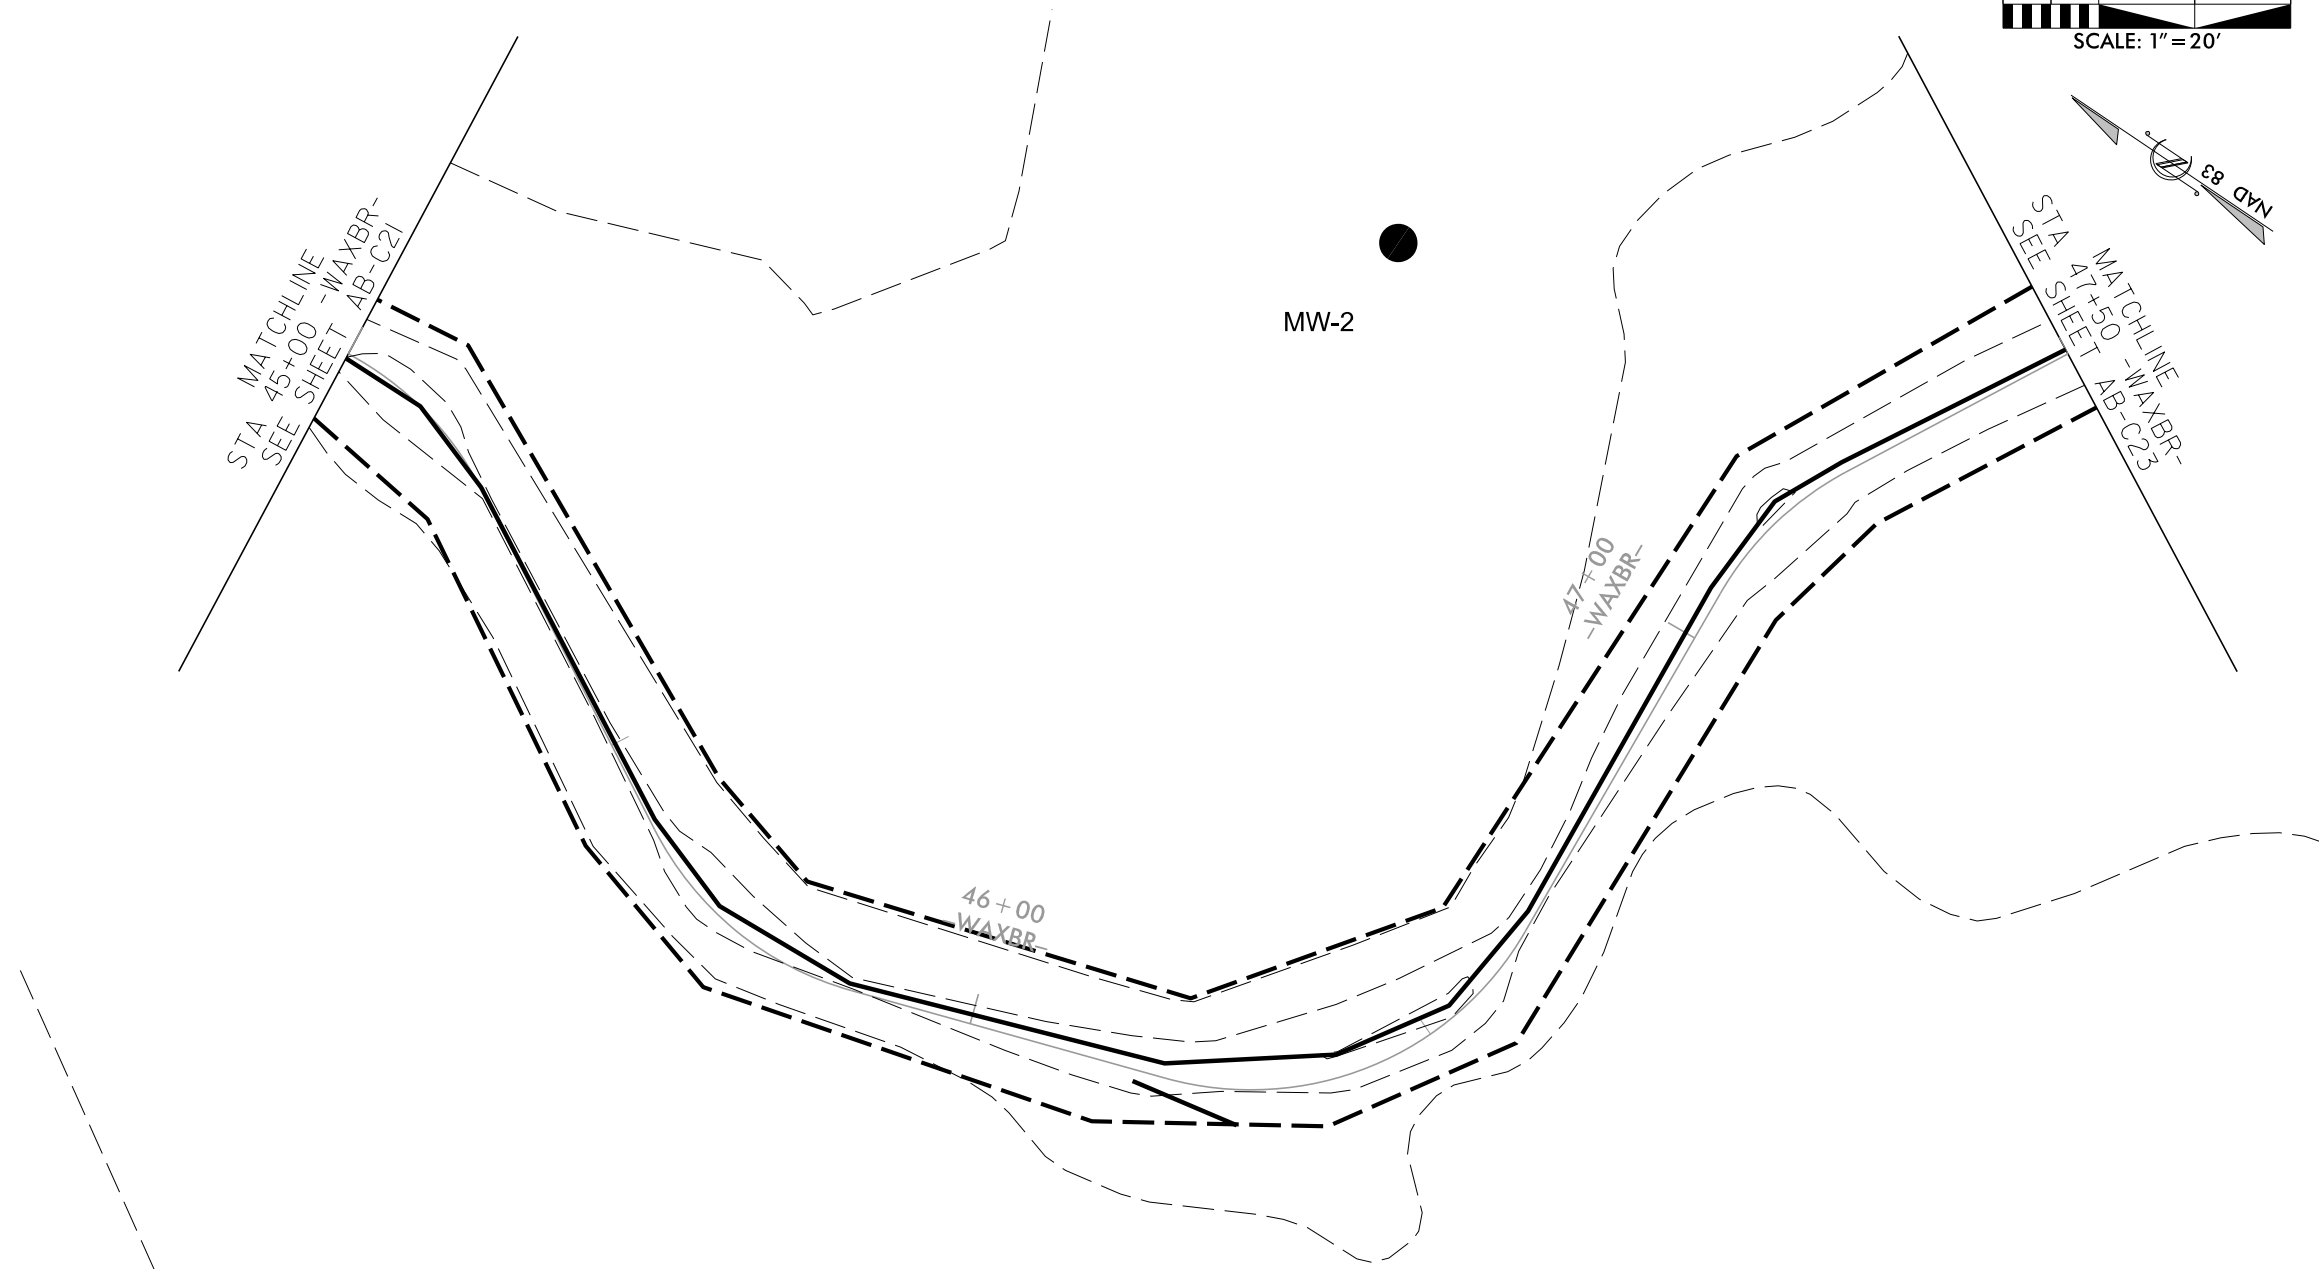


11/9/2022  
Wits\_End\_Psh\_AB-C22.dgn  
10:00 AM

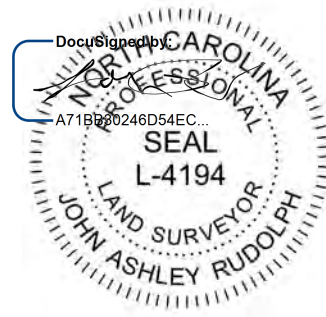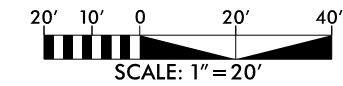


11/9/2022

DATE:  
DOCUMENT NOT CONSIDERED FINAL  
UNLESS ALL SIGNATURES COMPLETED

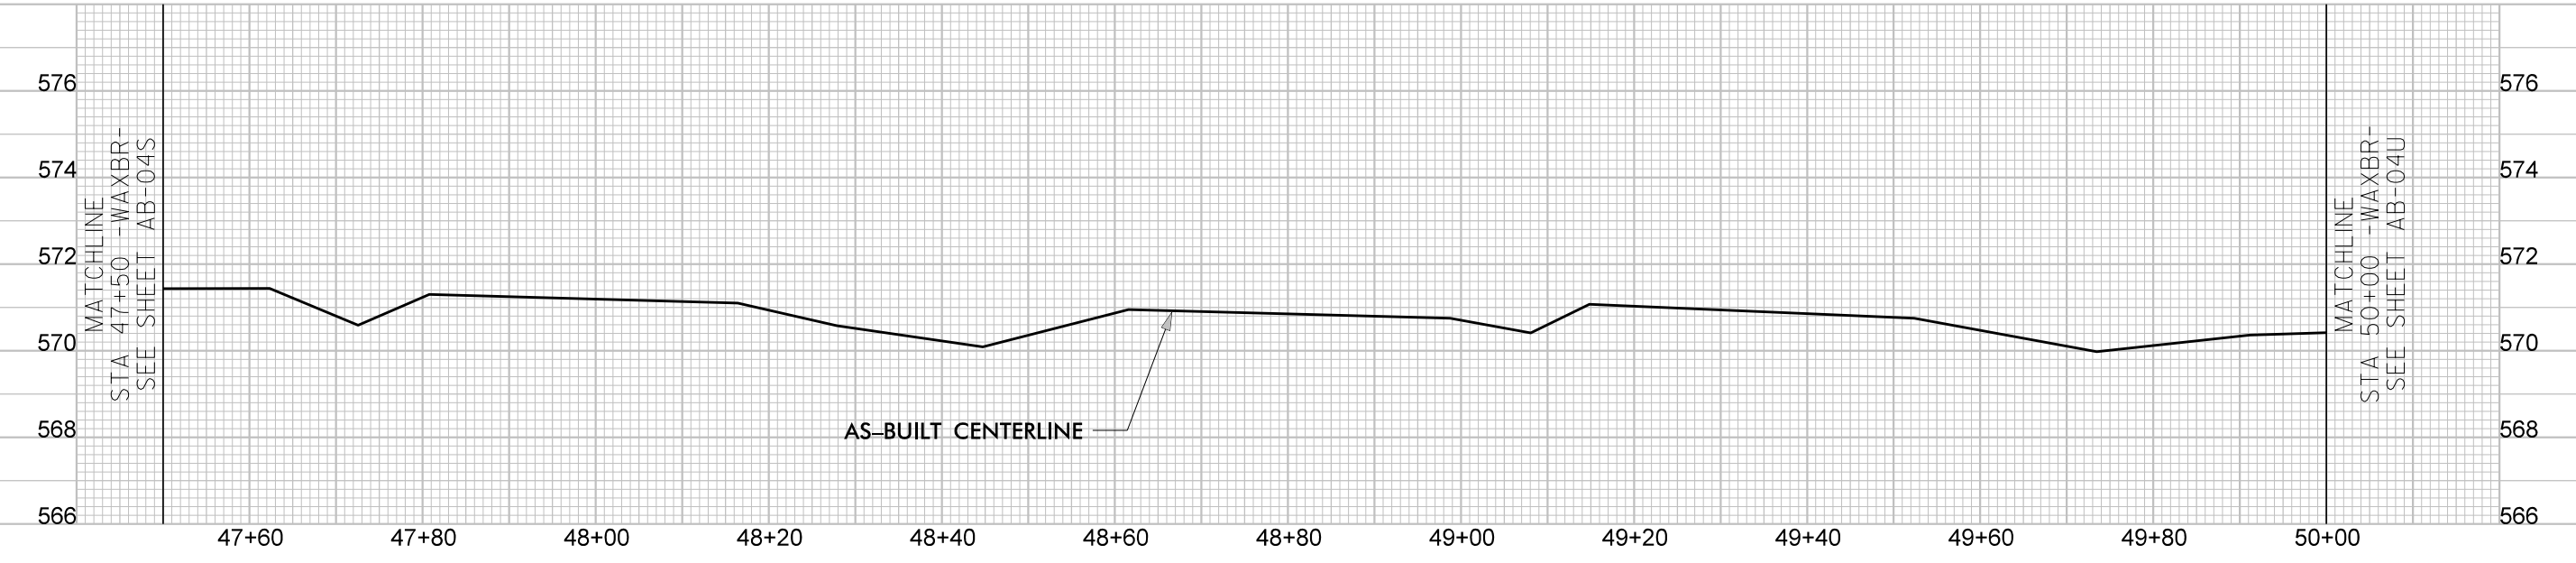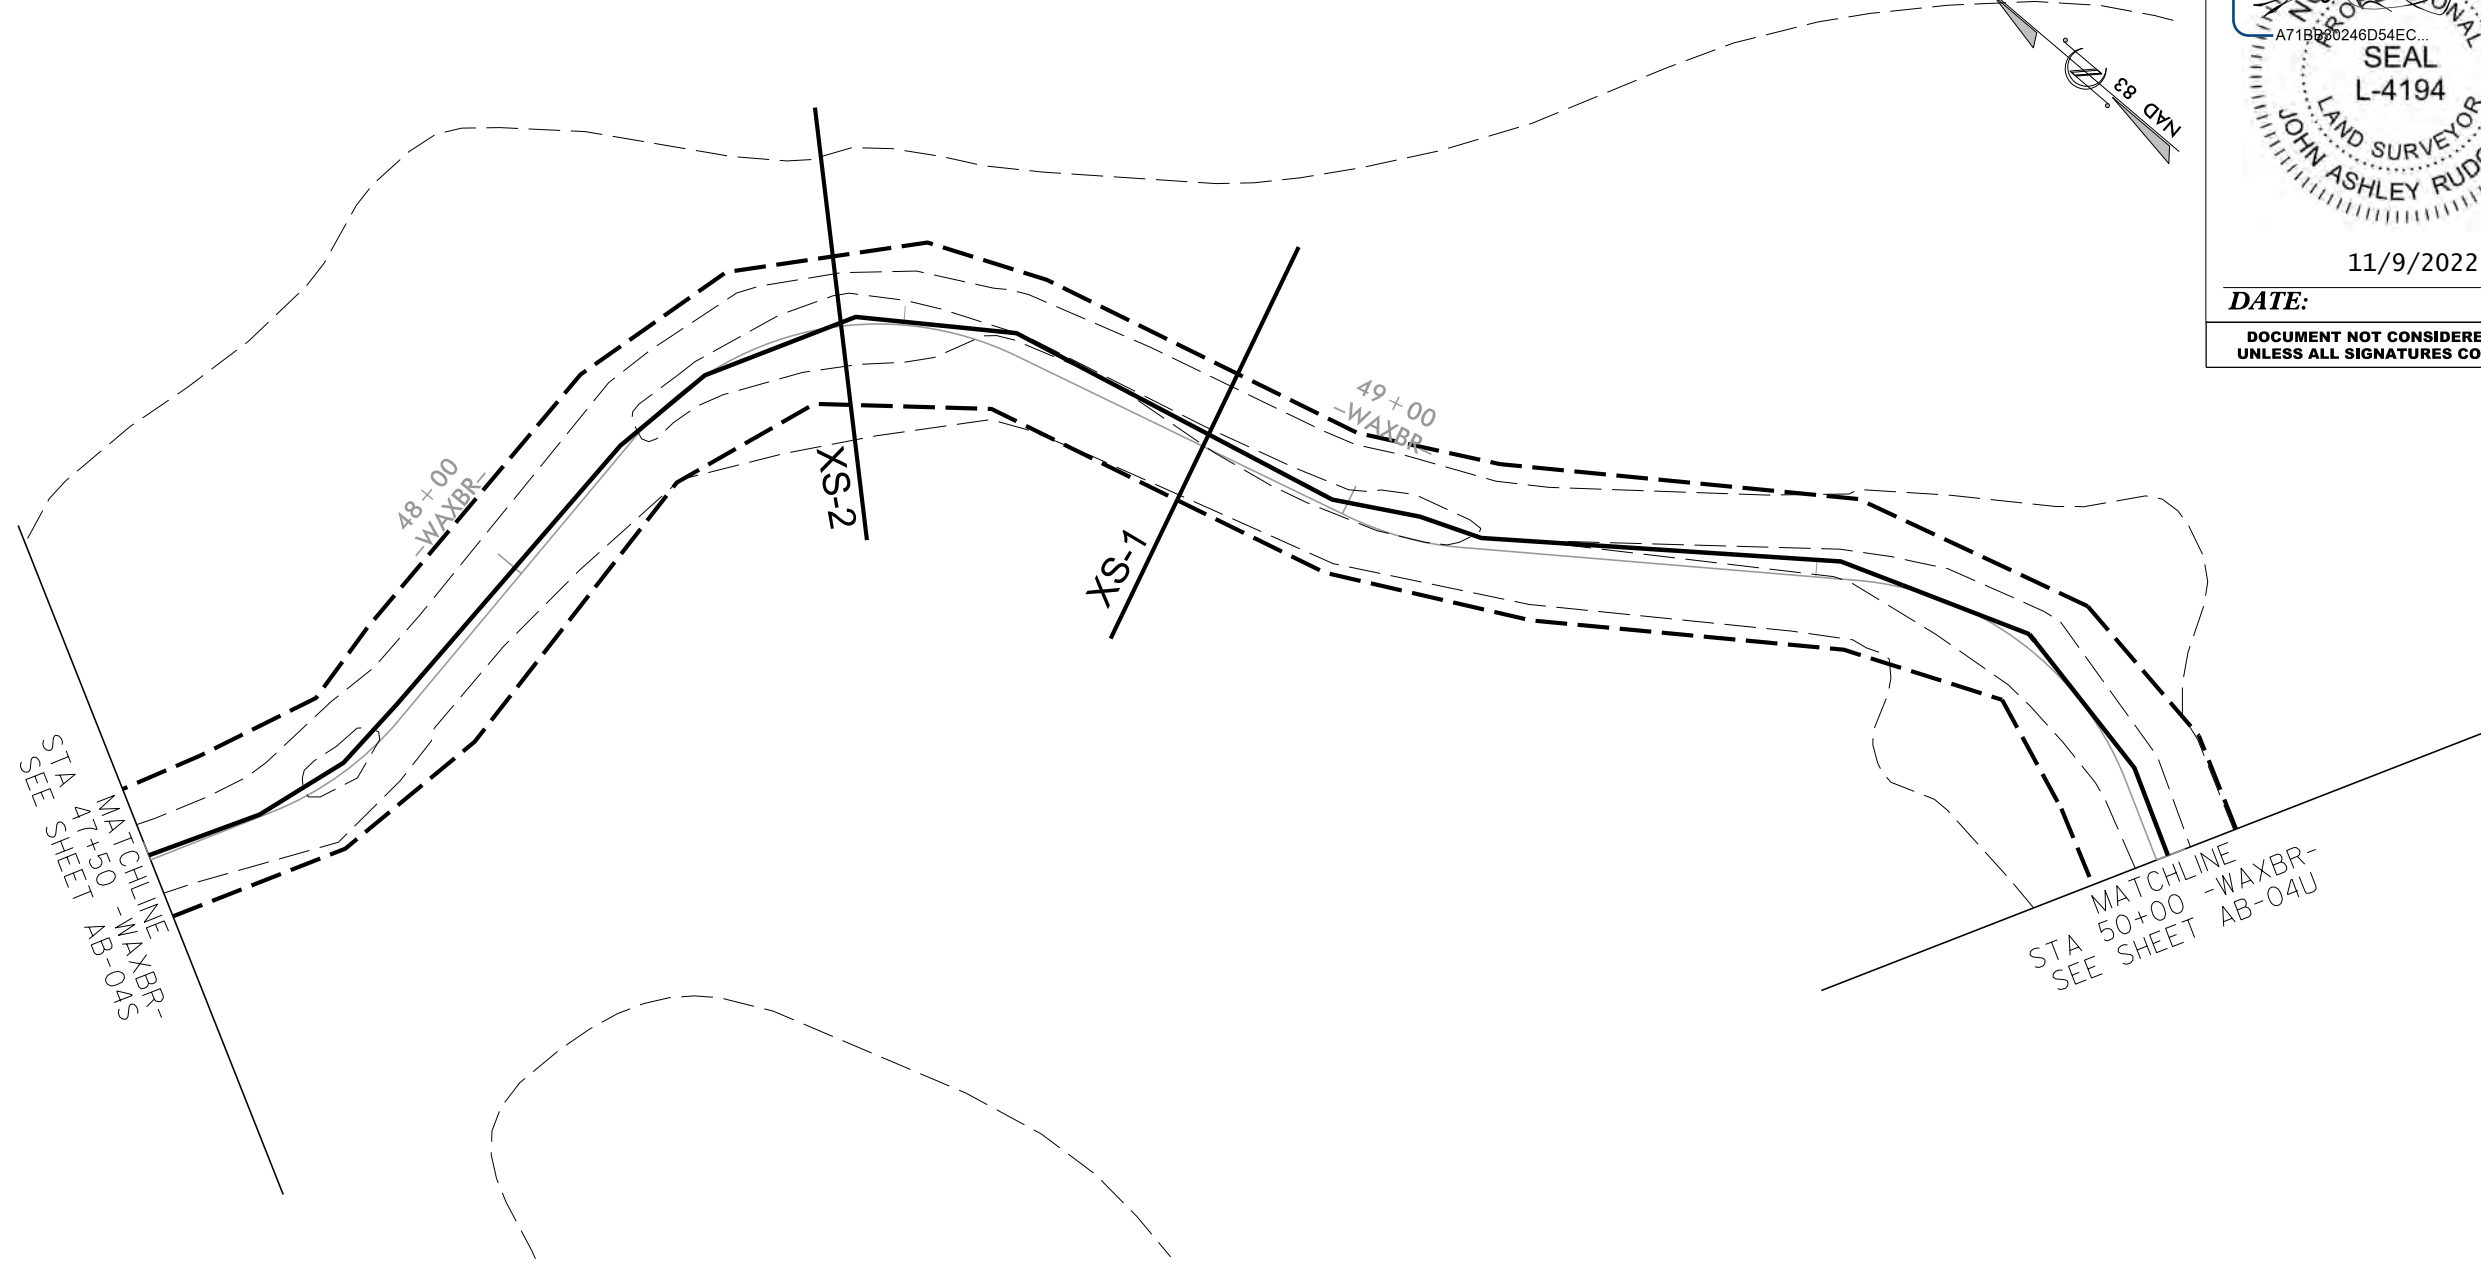

11/9/2022  
Wits\_End\_Psh\_AB-C23.dgn  
10:00 AM



© 2022 SUNGATE DESIGN GROUP, P.A. THIS DRAWING AND ALL REPRODUCTIONS OF IT ARE THE SOLE PROPERTY OF SDG. REPRODUCTION OR OTHER USES OF THIS DRAWING WITHOUT WRITTEN CONSENT OF SDG IS NOT PERMITTED.

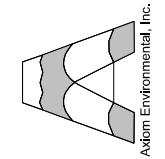

WITS END  
UNION COUNTY, NC  
AS-BUILT SURVEY


PROJECT # :  
1221-20024  
DRAWING NAME:  
WITS END PSH AB-C23  
DATE:  
2022  
DRAWN BY:  
JRH  
REVIEWED BY:  
JGD  
REVISIONS:

SHEET NO.  
**AB-C23**

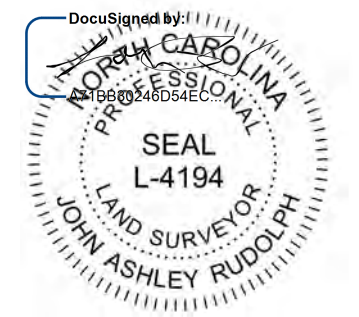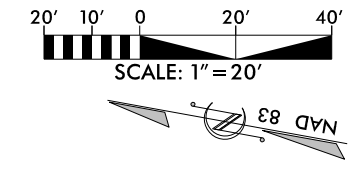

DATE: 11/9/2022

DOCUMENT NOT CONSIDERED FINAL UNLESS ALL SIGNATURES COMPLETED


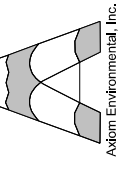


© 2022 SUNGATE DESIGN GROUP, P.A. THIS DRAWING AND ALL REPRODUCTIONS OF IT ARE THE SOLE PROPERTY OF SDG. REPRODUCTION OR OTHER USES OF THIS DRAWING WITHOUT WRITTEN CONSENT OF SDG IS NOT PERMITTED.

WITS END UNION COUNTY, NC AS-BUILT SURVEY




PROJECT #: 1221-20024  
DRAWING NAME: WITS END PSH AB-C24  
DATE: 2022  
DRAWN BY: JRH  
REVIEWED BY: JGD  
REVISIONS:

SHEET NO. AB-C24

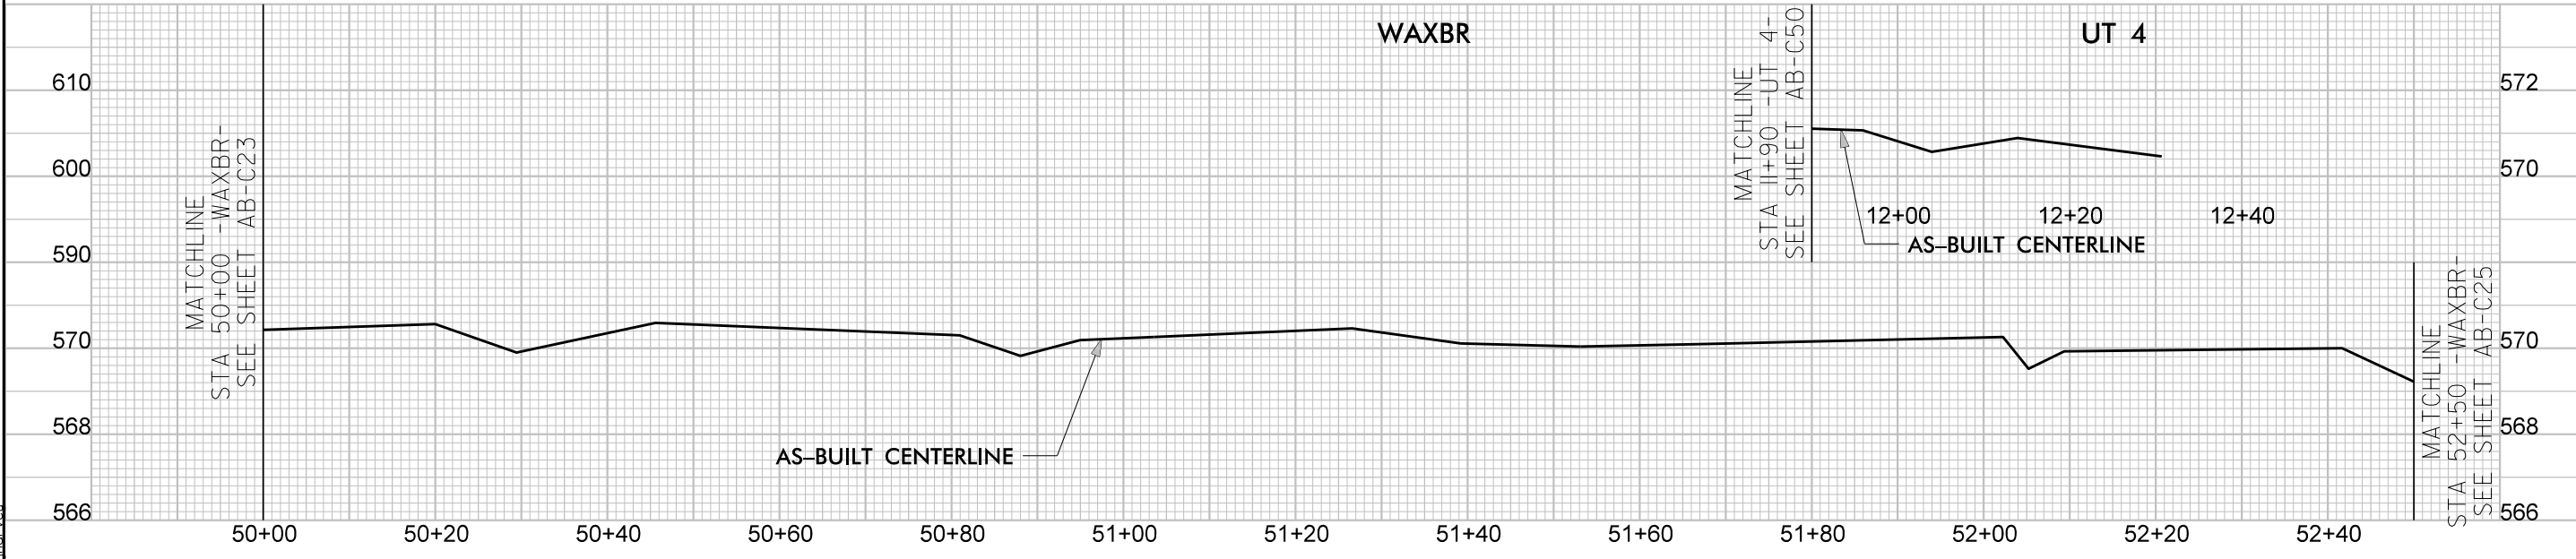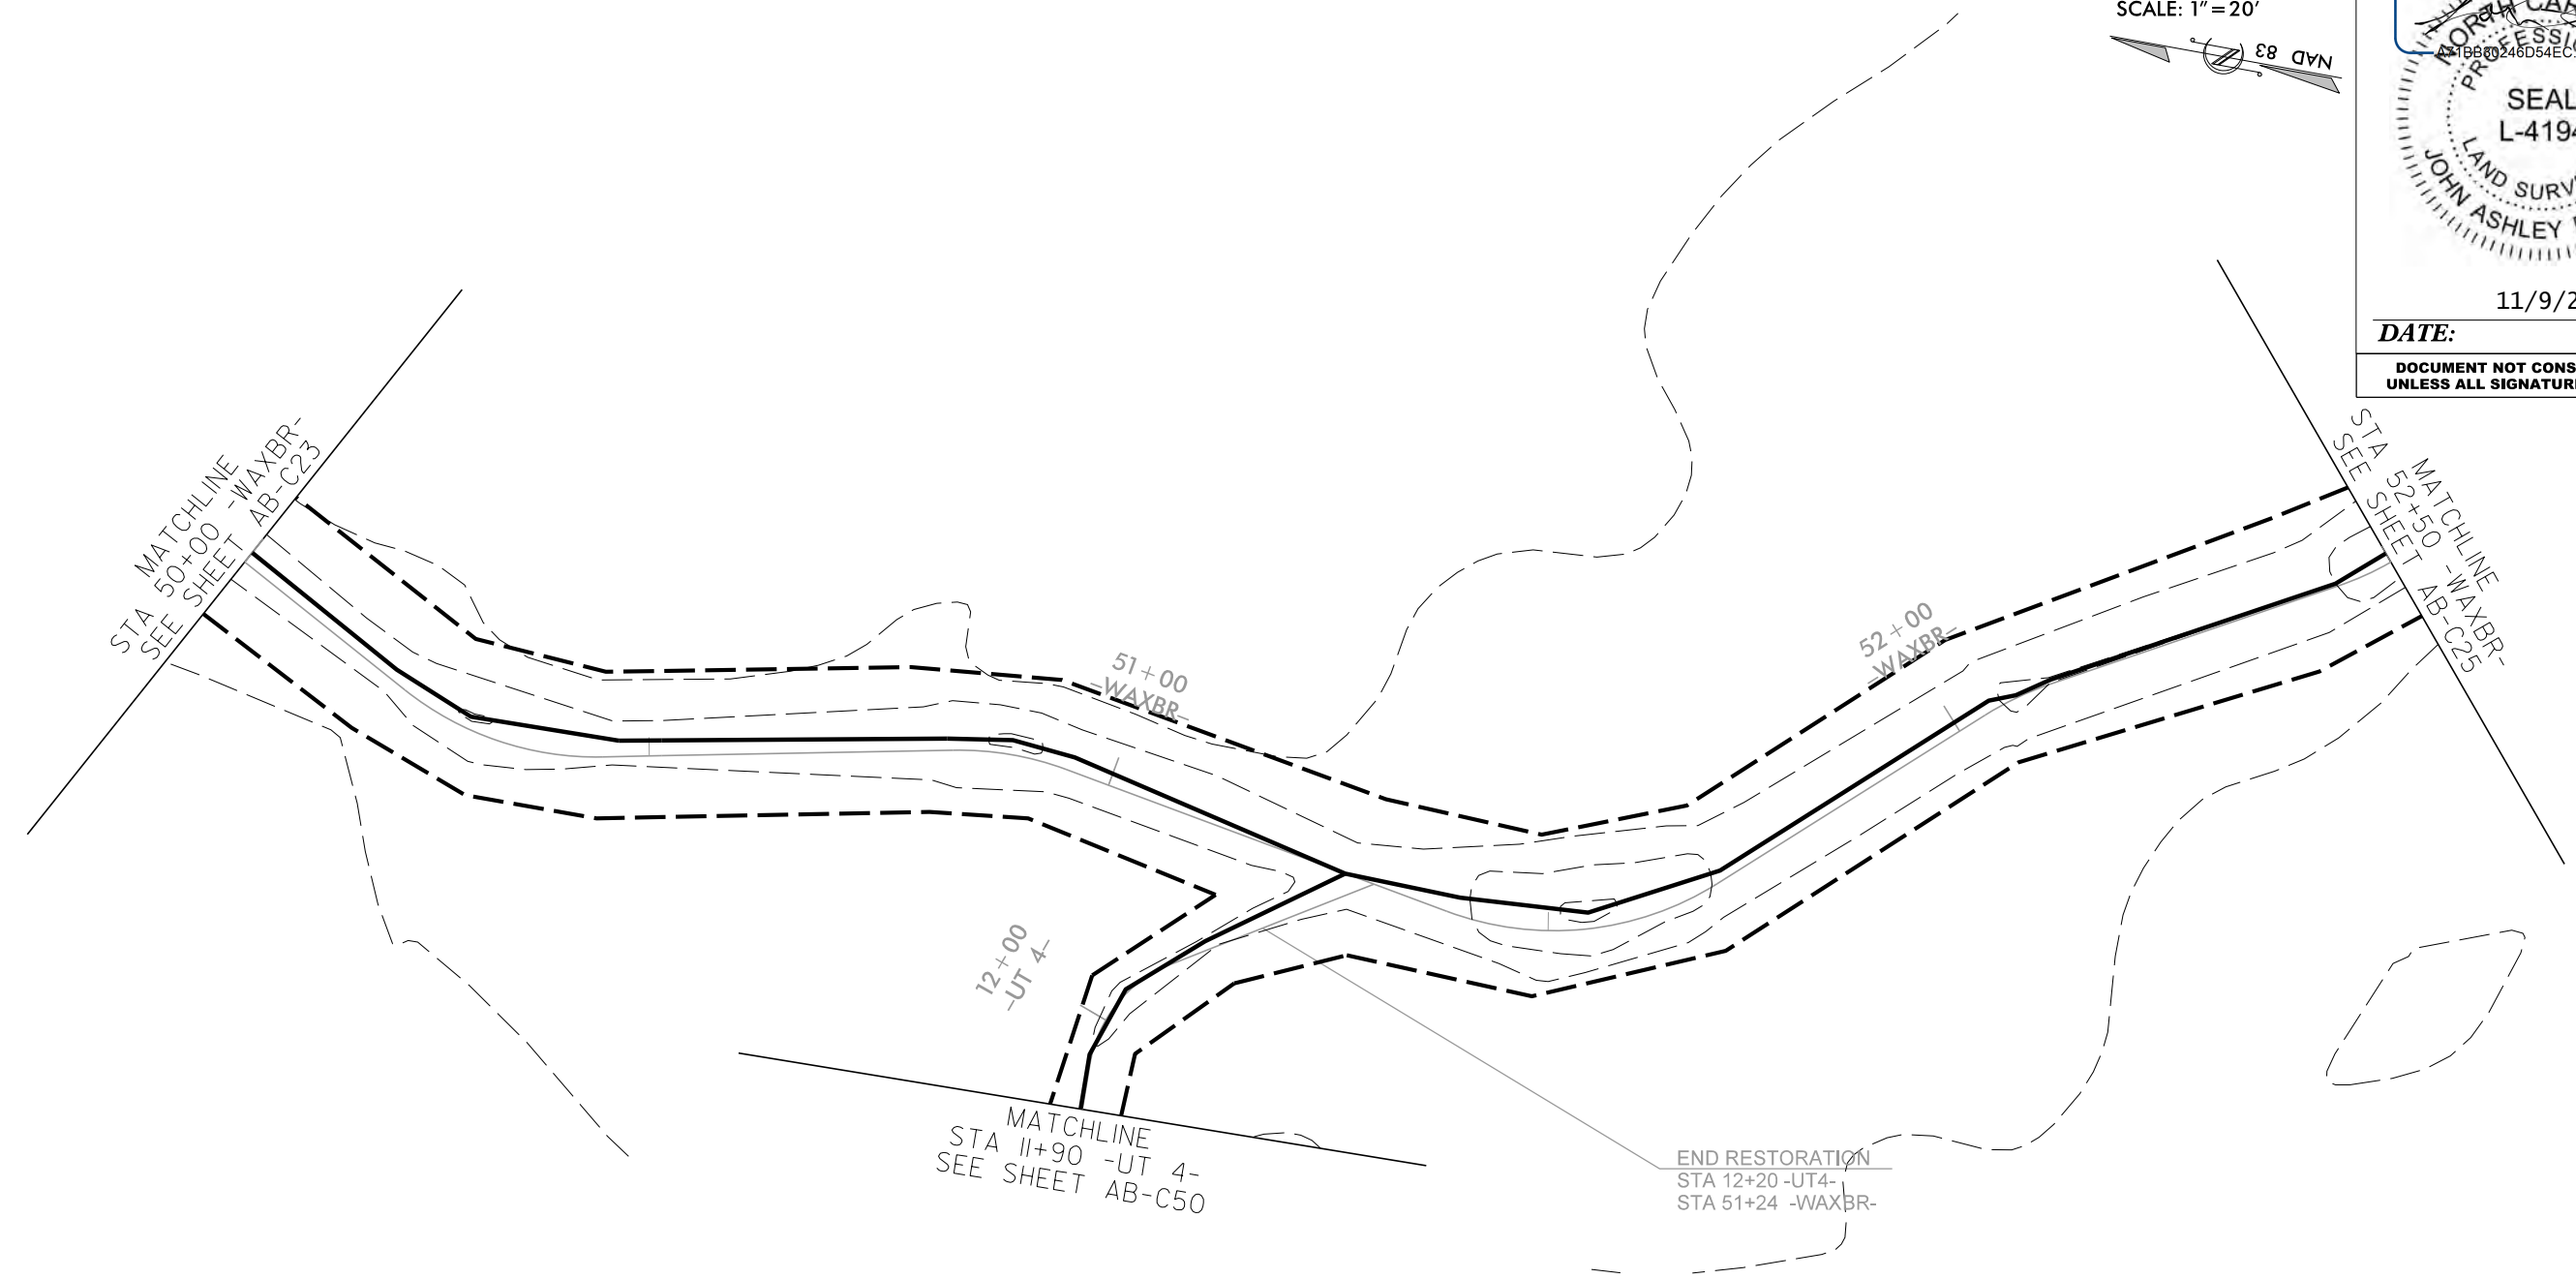




11/9/2022  
Wits\_End\_Psh\_AB-C24.dgn  
jrh



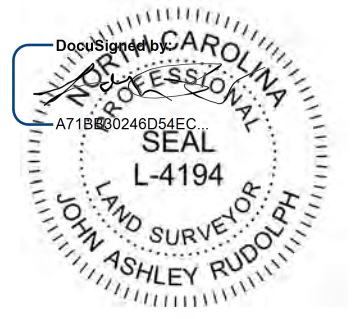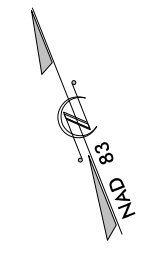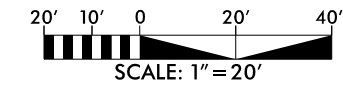

11/9/2022

DATE:  
DOCUMENT NOT CONSIDERED FINAL  
UNLESS ALL SIGNATURES COMPLETED

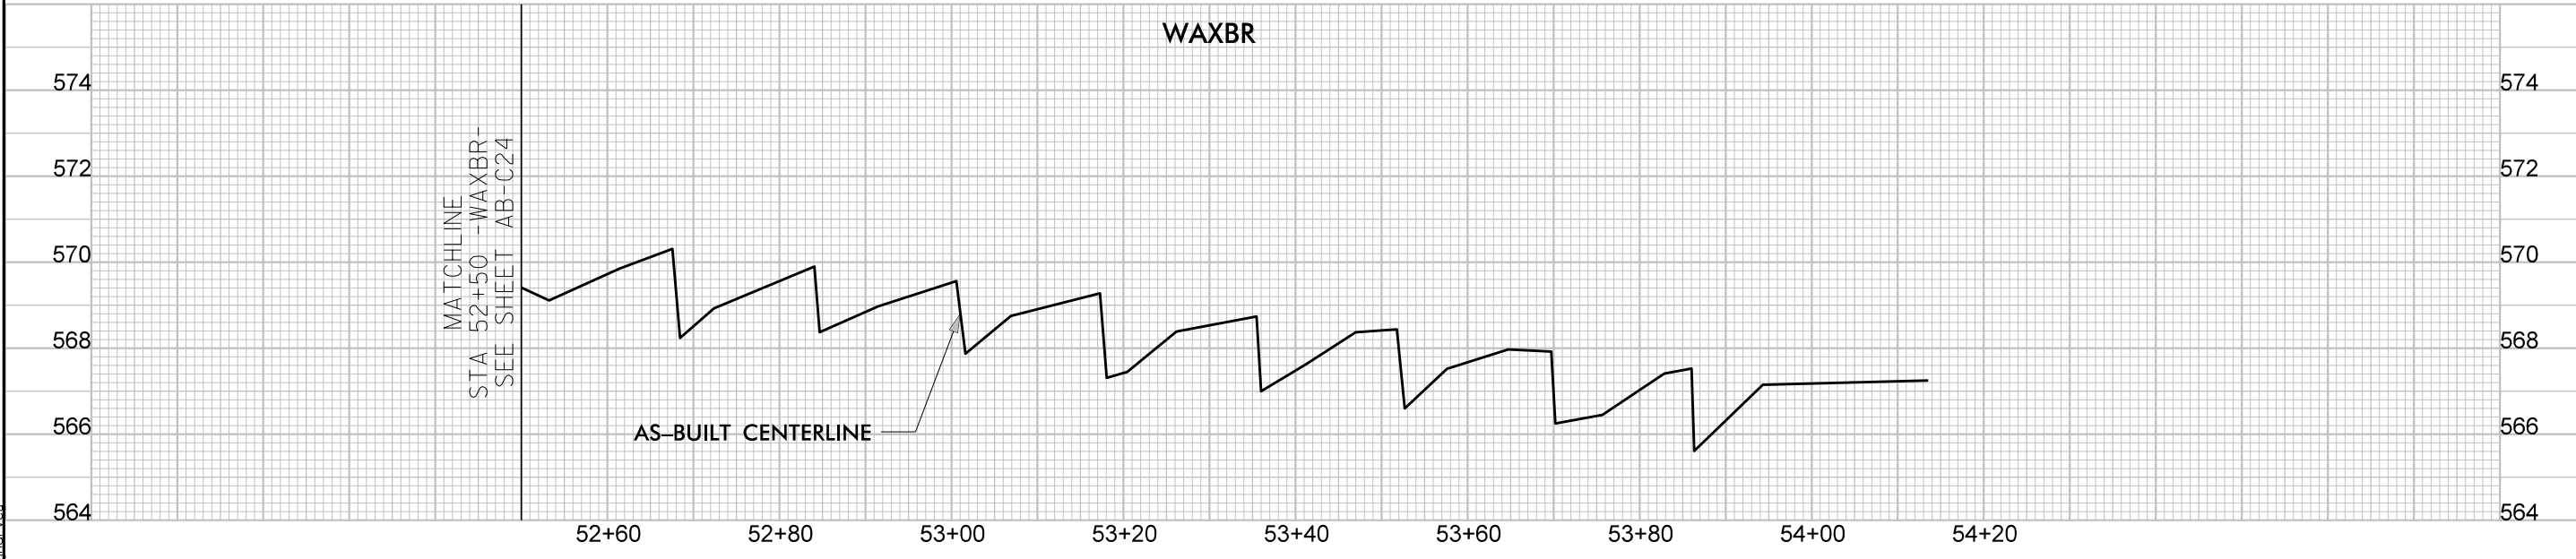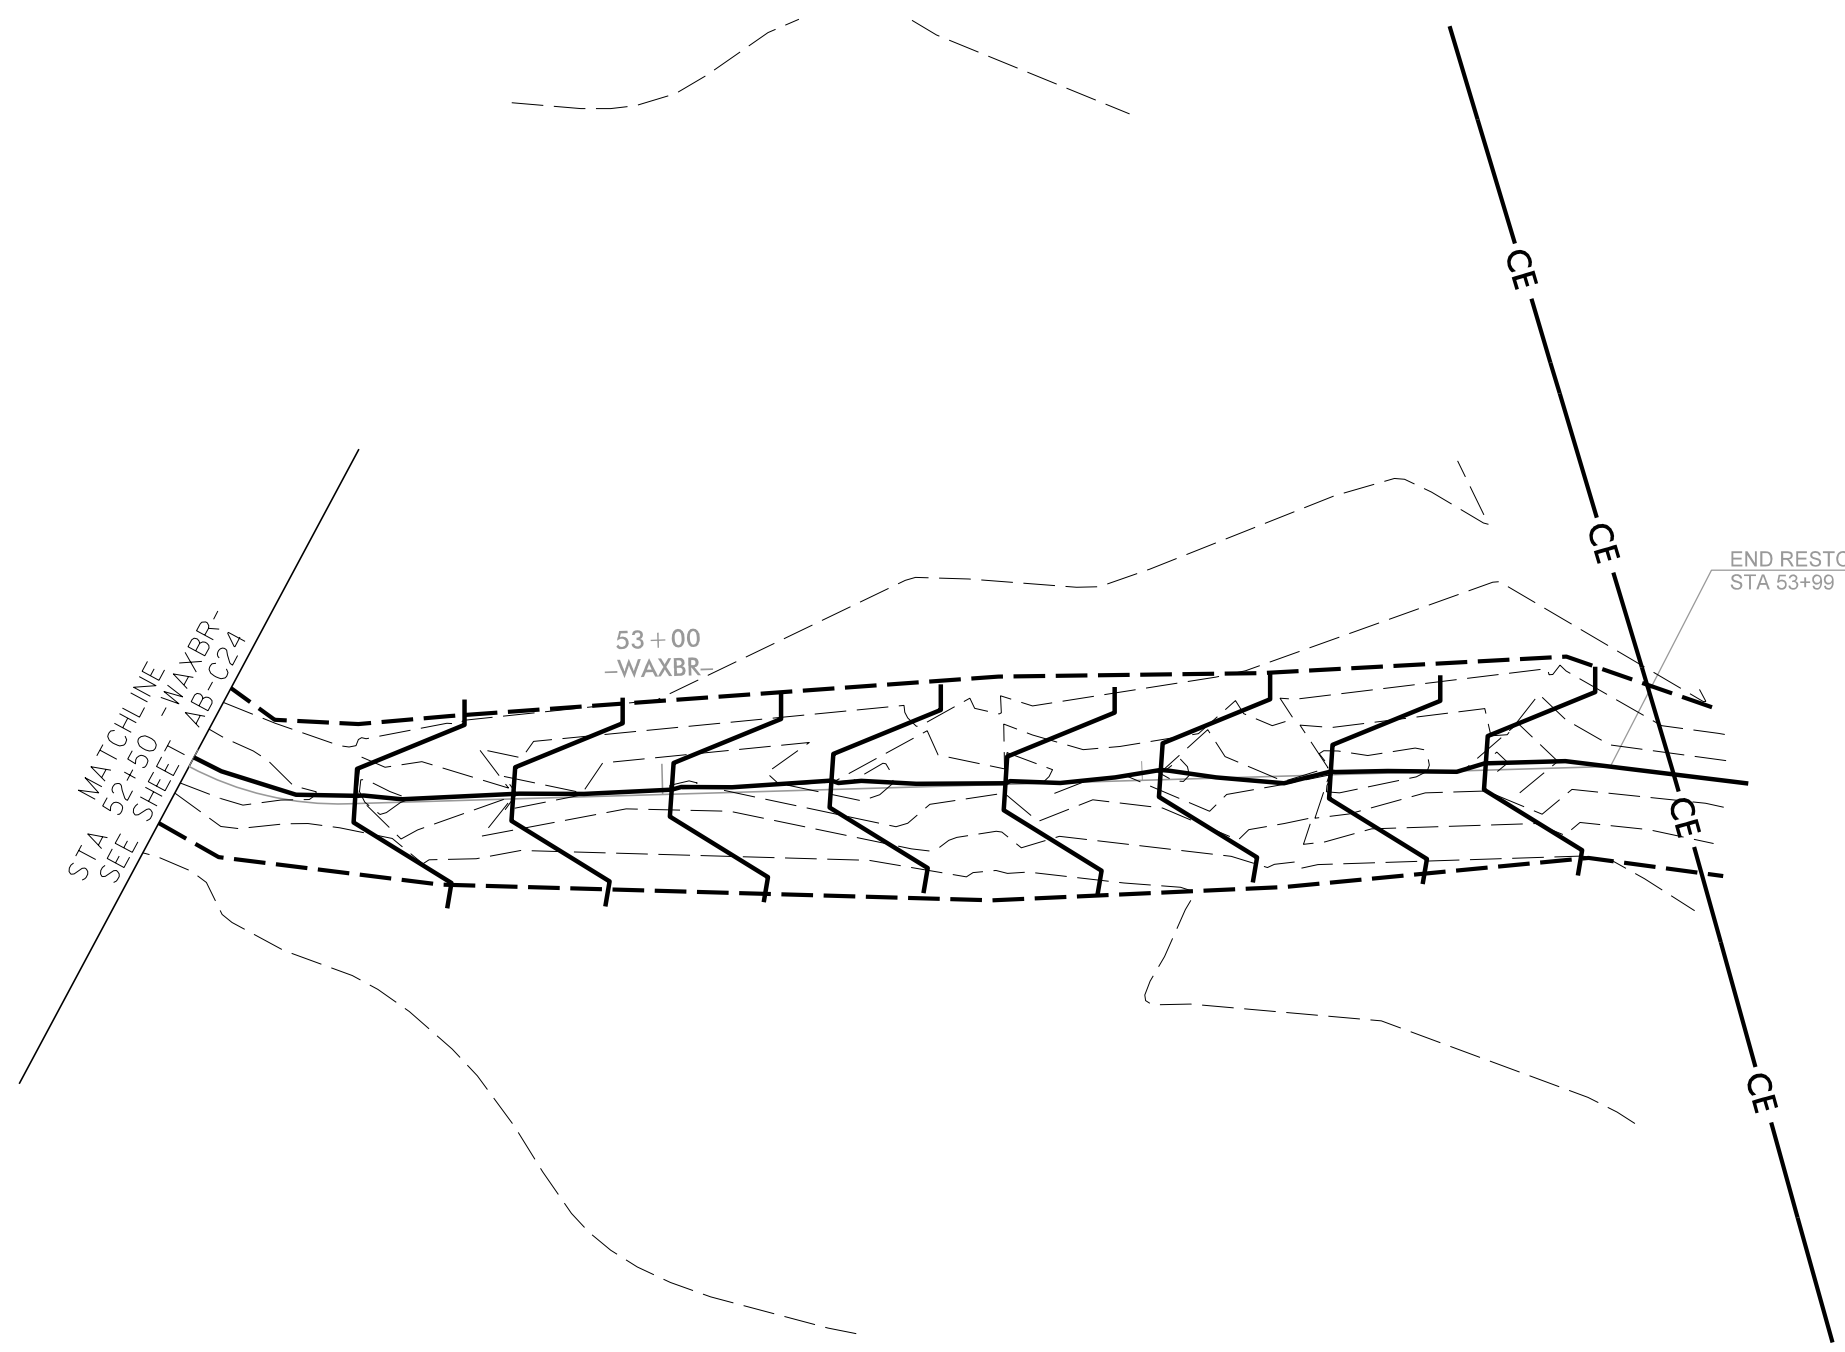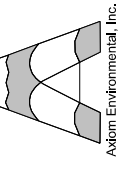




11/9/2022  
Wits\_End\_PSH\_AB-C25.dgn  
10:00 AM

© 2022 SUNGATE DESIGN GROUP, P.A. THIS DRAWING AND ALL REPRODUCTIONS OF IT ARE THE SOLE PROPERTY OF SDG. REPRODUCTION OR OTHER USES OF THIS DRAWING WITHOUT WRITTEN CONSENT OF SDG IS NOT PERMITTED.

WITS END  
UNION COUNTY, NC  
AS-BUILT SURVEY




PROJECT # :  
1221-20024  
DRAWING NAME:  
WITS END PSH AB-C25  
DATE:  
2022  
DRAWN BY:  
JRH  
REVIEWED BY:  
JGD  
REVISIONS:

SHEET NO.  
**AB-C25**

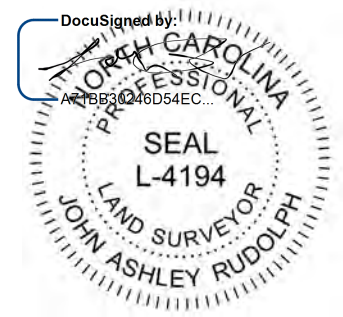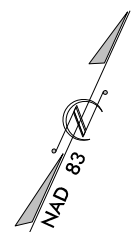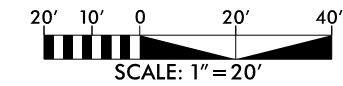

11/9/2022

DATE:  
DOCUMENT NOT CONSIDERED FINAL  
UNLESS ALL SIGNATURES COMPLETED

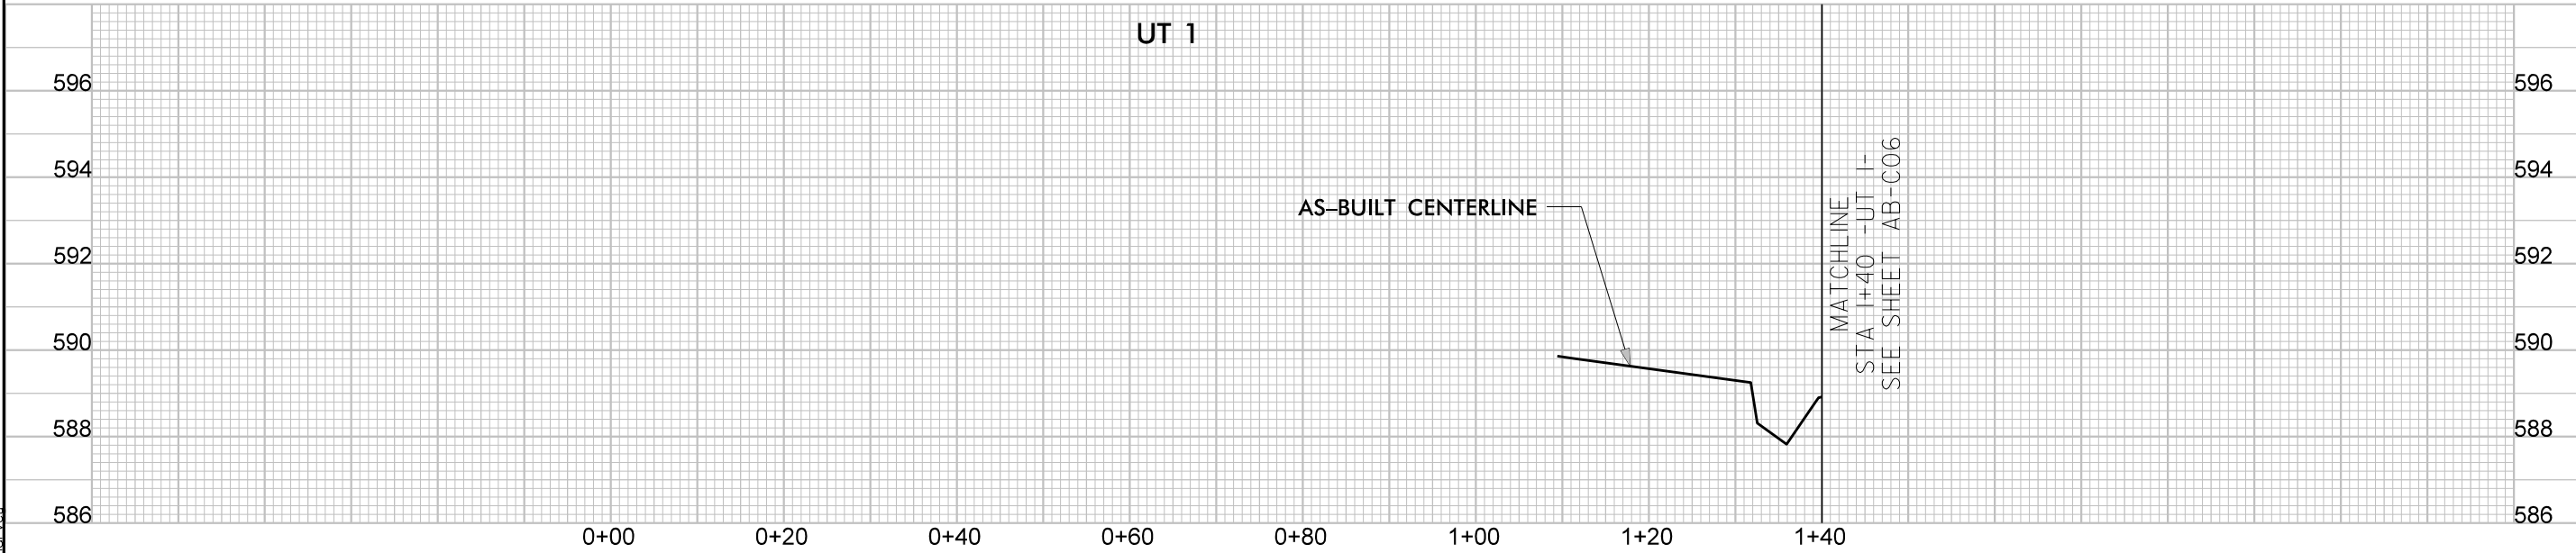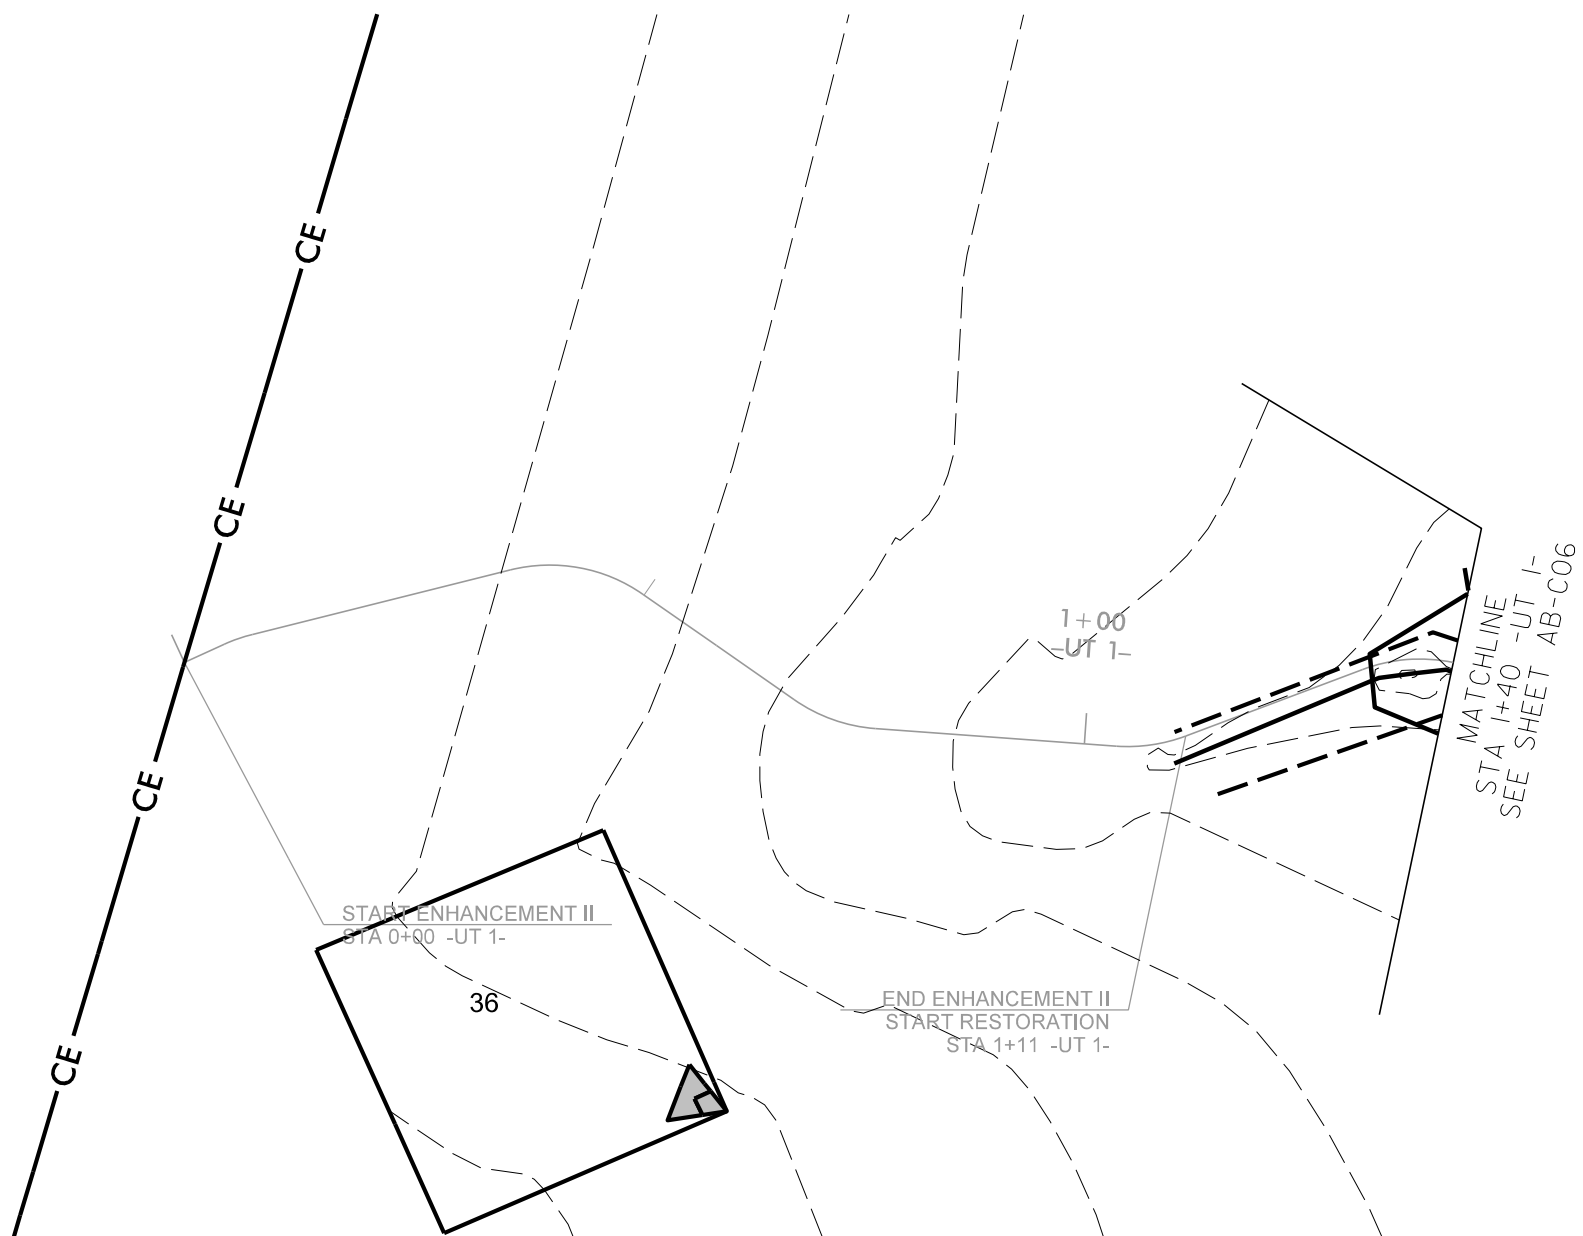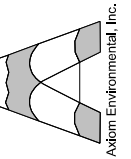




11/9/2022  
Wits\_End\_psh\_AB-C26.dgn  
10:00 AM

© 2022 SUNGATE DESIGN GROUP, P.A. THIS DRAWING AND ALL REPRODUCTIONS OF IT ARE THE SOLE PROPERTY OF SDG. REPRODUCTION OR OTHER USES OF THIS DRAWING WITHOUT WRITTEN CONSENT OF SDG IS NOT PERMITTED.


**WITS END**  
UNION COUNTY, NC  
**AS-BUILT SURVEY**

PROJECT # :  
1221-20024  
DRAWING NAME:  
WITS END PSH AB-C26  
DATE:  
2022  
DRAWN BY:  
JRH  
REVIEWED BY:  
JGD  
REVISIONS:

SHEET NO.  
**AB-C26**

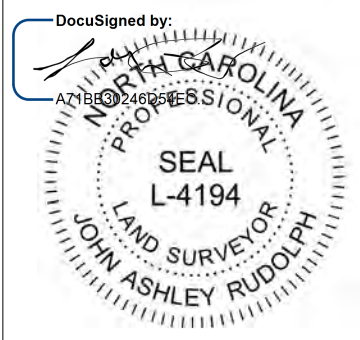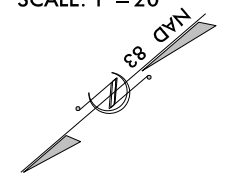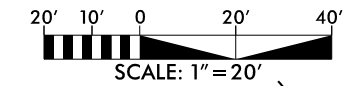


DocuSigned by:  
AZ1BE3246251E6  
DATE: 11/9/2022  
DOCUMENT NOT CONSIDERED FINAL  
UNLESS ALL SIGNATURES COMPLETED

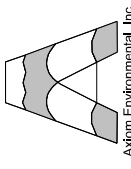

WITS END  
UNION COUNTY, NC  
AS-BUILT SURVEY

PROJECT # : 1221-20024  
DRAWING NAME: WITS END PSH AB-C27  
DATE: 2022  
DRAWN BY: JRH  
REVIEWED BY: JGD  
REVISIONS:



SHEET NO.  
**AB-C27**

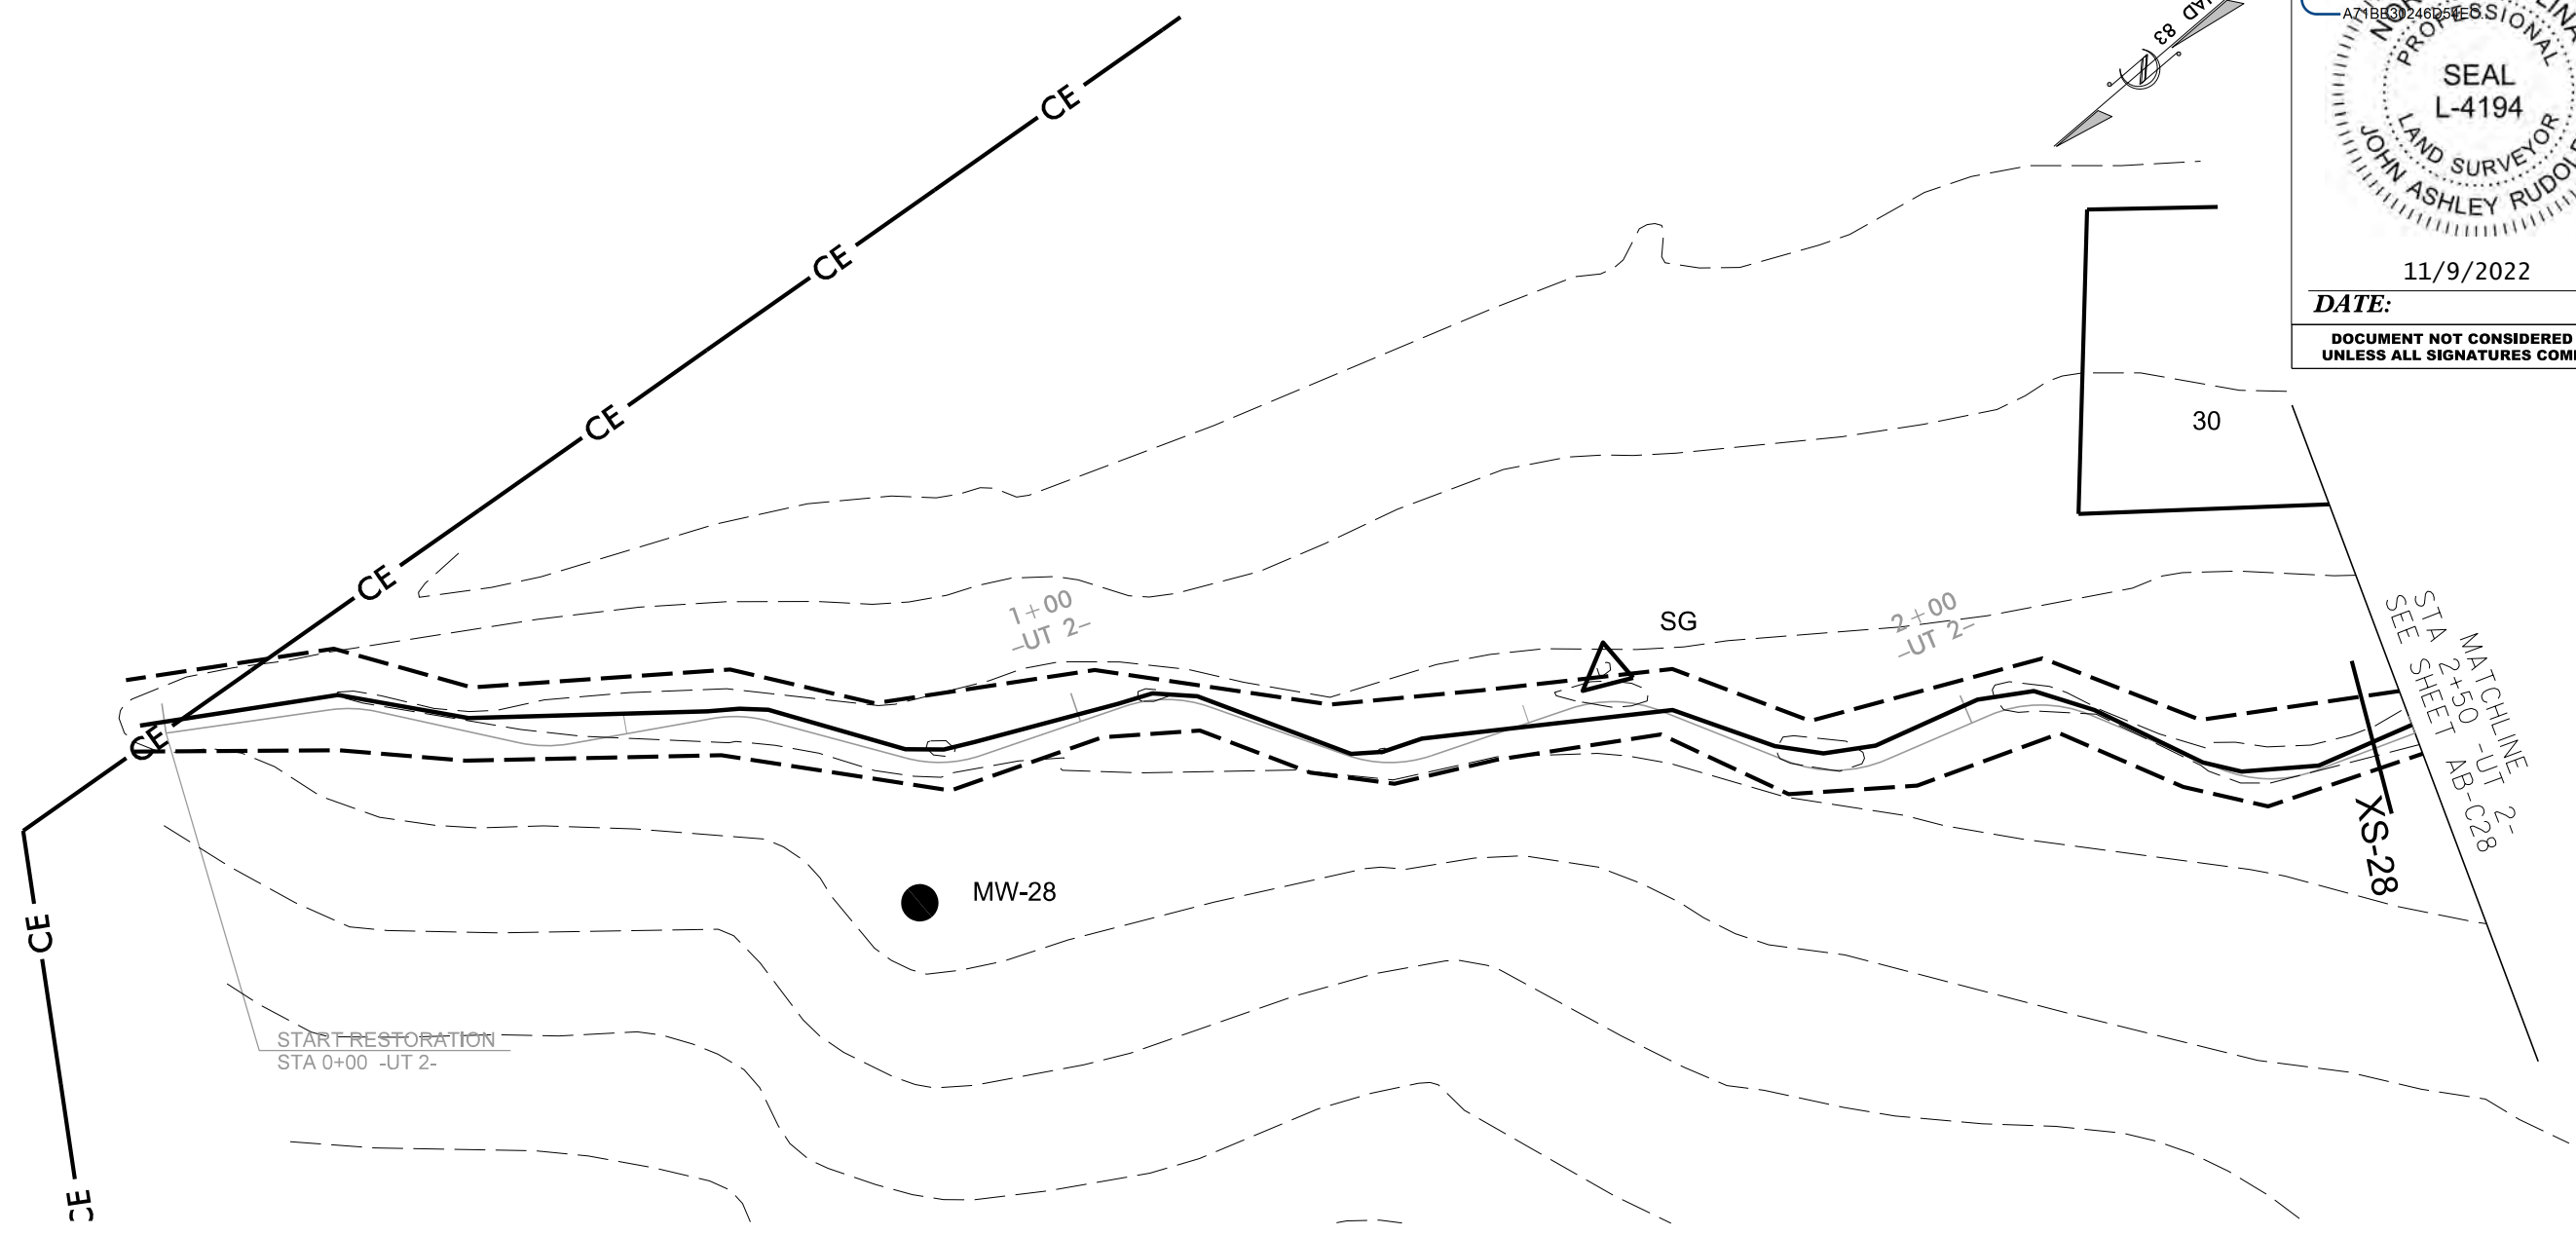

11/9/2022  
Wits\_End\_Psh\_AB-C27.dgn  
10:00 AM


© 2022 SUNGATE DESIGN GROUP, P.A. THIS DRAWING AND ALL REPRODUCTIONS OF IT ARE THE SOLE PROPERTY OF SDG. REPRODUCTION OR OTHER USES OF THIS DRAWING WITHOUT WRITTEN CONSENT OF SDG IS NOT PERMITTED.



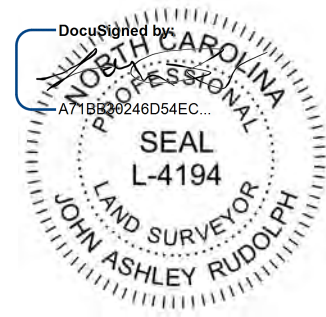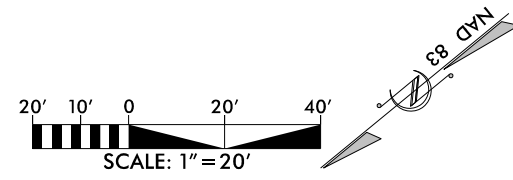

11/9/2022

**DATE:**  
**DOCUMENT NOT CONSIDERED FINAL  
UNLESS ALL SIGNATURES COMPLETED**


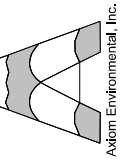


© 2022 SUNGATE DESIGN GROUP, P.A. THIS DRAWING AND ALL REPRODUCTIONS OF IT ARE THE SOLE PROPERTY OF SDG. REPRODUCTION OR OTHER USES OF THIS DRAWING WITHOUT WRITTEN CONSENT OF SDG IS NOT PERMITTED.




**WITS END**  
**UNION COUNTY, NC**  
**AS-BUILT SURVEY**

PROJECT # :  
1221-20024  
DRAWING NAME:  
WITS END PSH AB-C28  
DATE:  
2022  
DRAWN BY:  
JRH  
REVIEWED BY:  
JGD  
REVISIONS:

SHEET NO.  
**AB-C28**

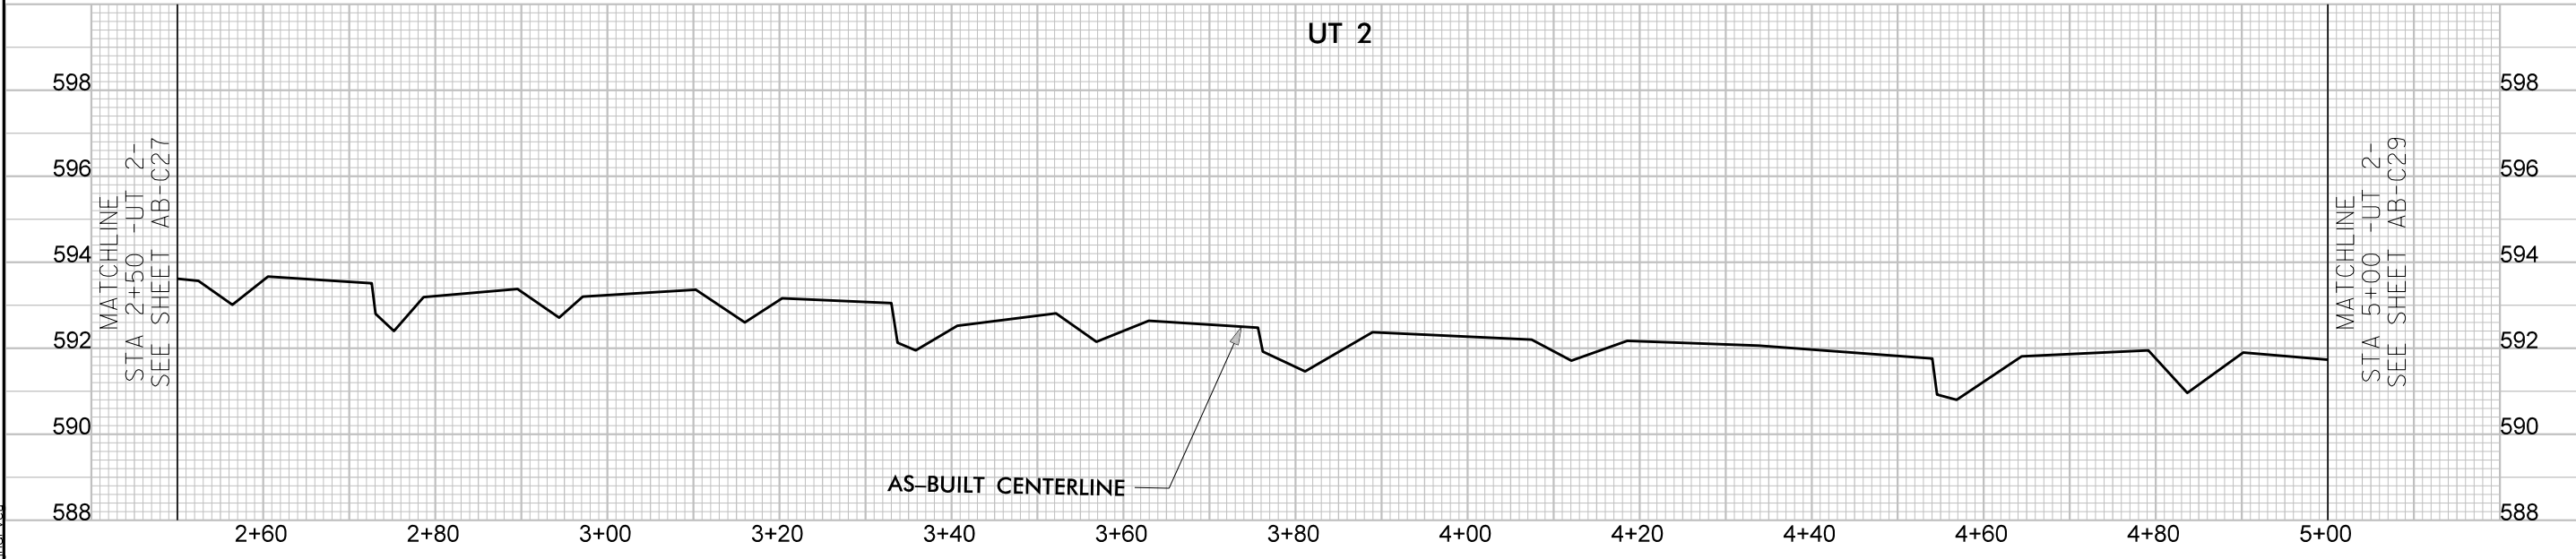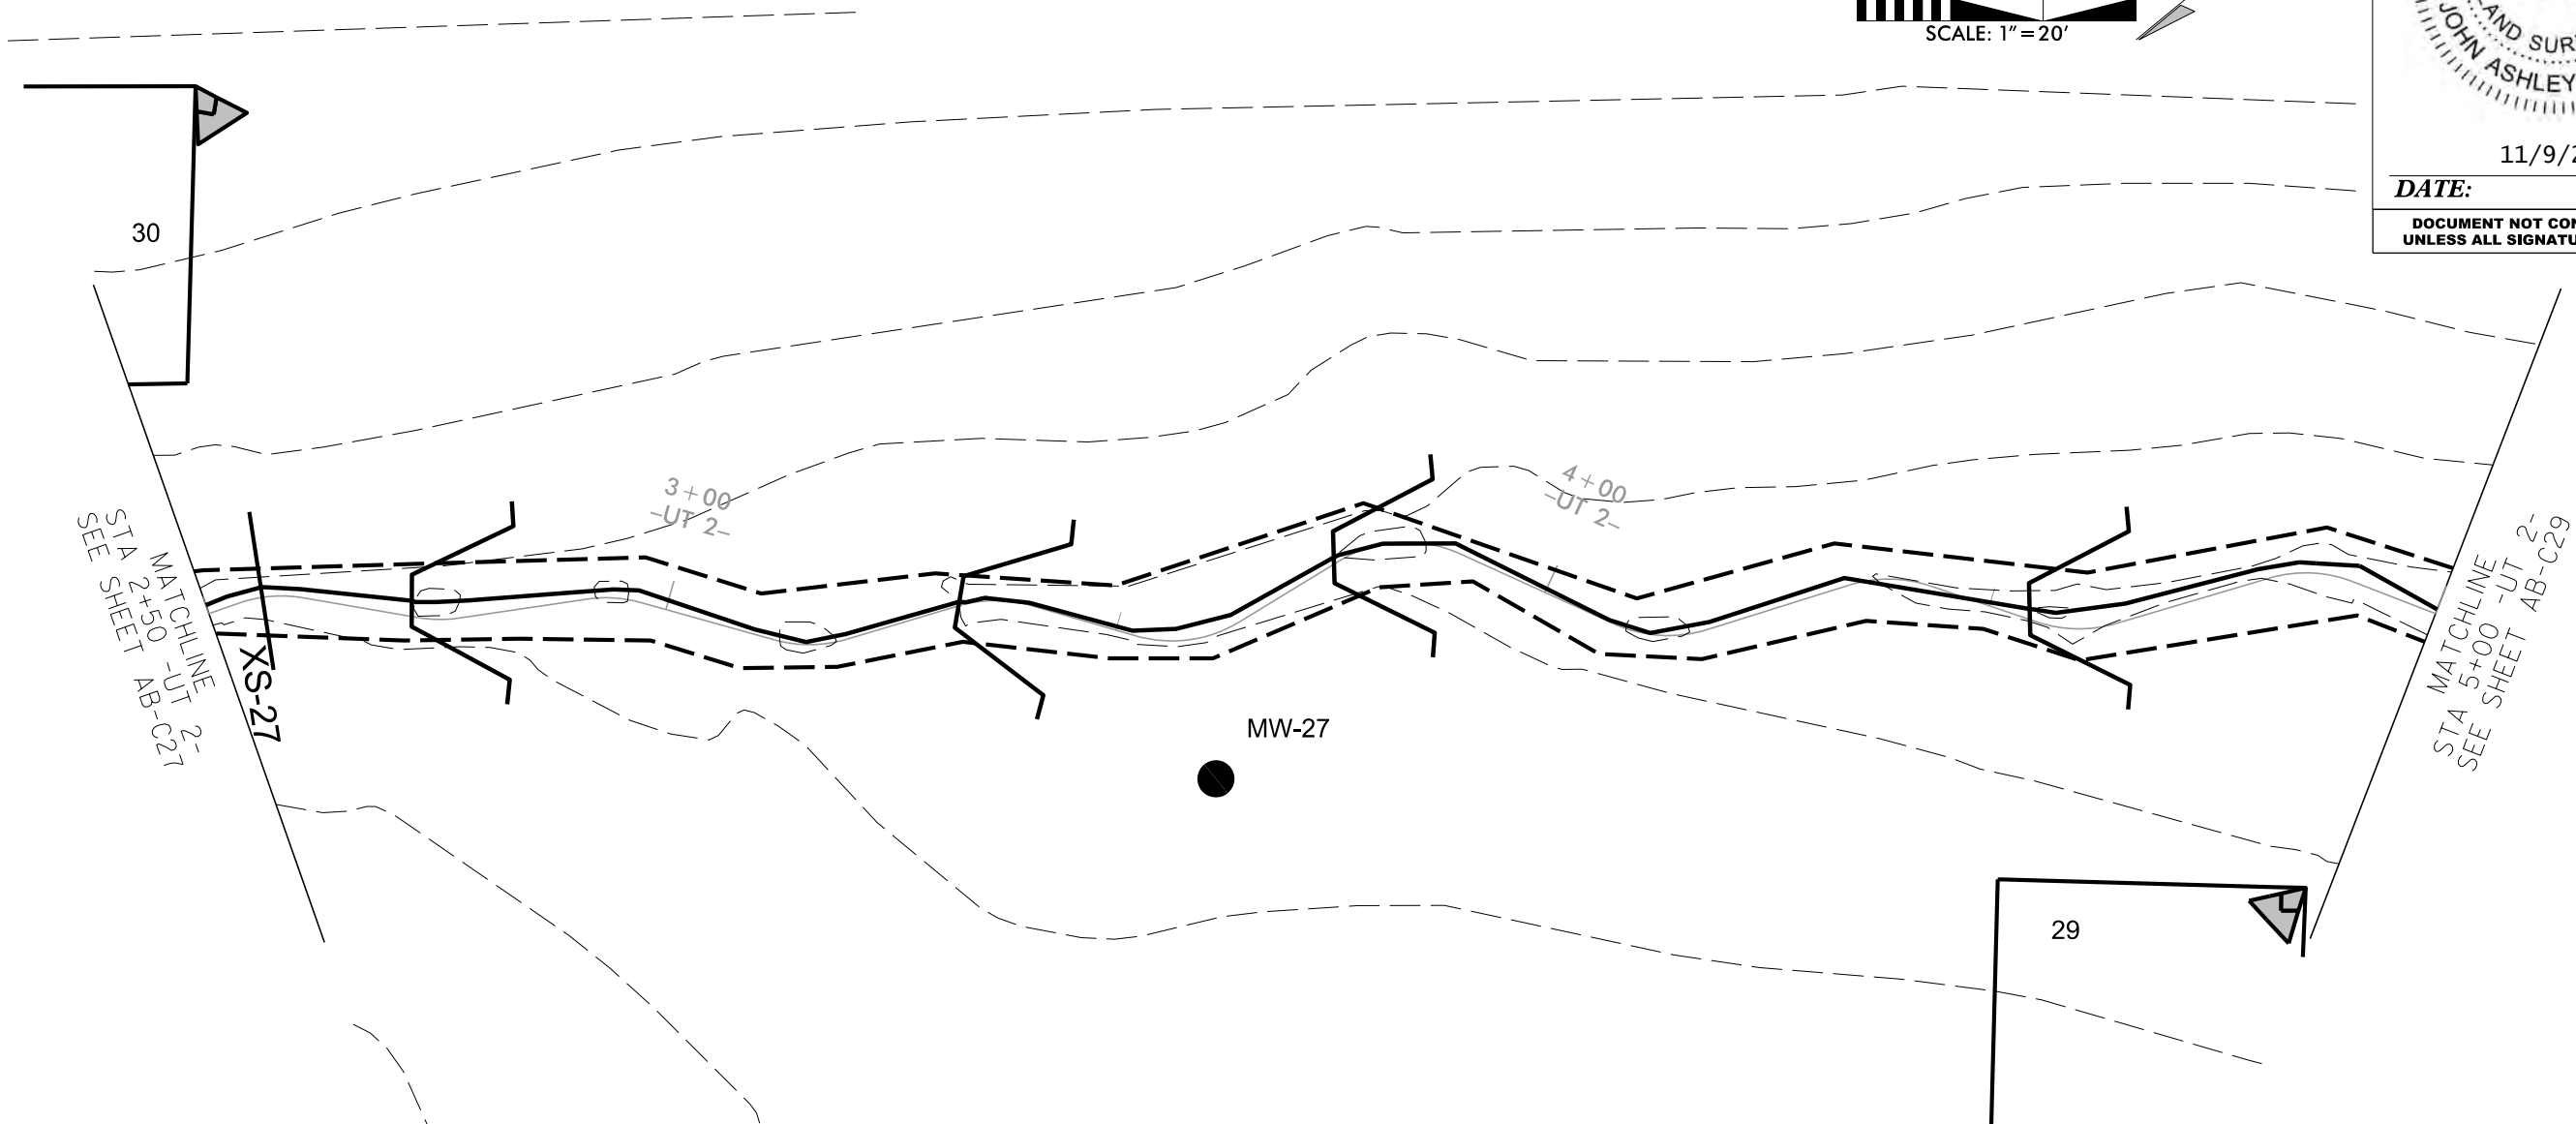


11/9/2022  
Wits\_End\_Psh\_AB-C28.dgn  
jrh

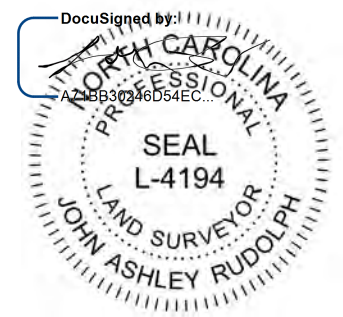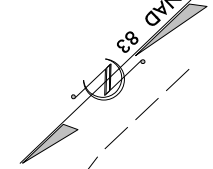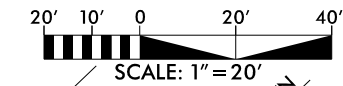

11/9/2022

**DATE:**  
**DOCUMENT NOT CONSIDERED FINAL UNLESS ALL SIGNATURES COMPLETED**

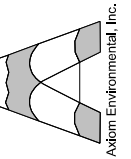


© 2022 SUNGATE DESIGN GROUP, P.A. THIS DRAWING AND ALL REPRODUCTIONS OF IT ARE THE SOLE PROPERTY OF SDG. REPRODUCTION OR OTHER USES OF THIS DRAWING WITHOUT WRITTEN CONSENT OF SDG IS NOT PERMITTED.




**WITS END**  
 UNION COUNTY, NC  
**AS-BUILT SURVEY**

PROJECT # : 1221-20024  
 DRAWING NAME: WITS END PSH AB-C29  
 DATE: 2022  
 DRAWN BY: JRH  
 REVIEWED BY: JGD  
 REVISIONS:

SHEET NO.  
**AB-C29**



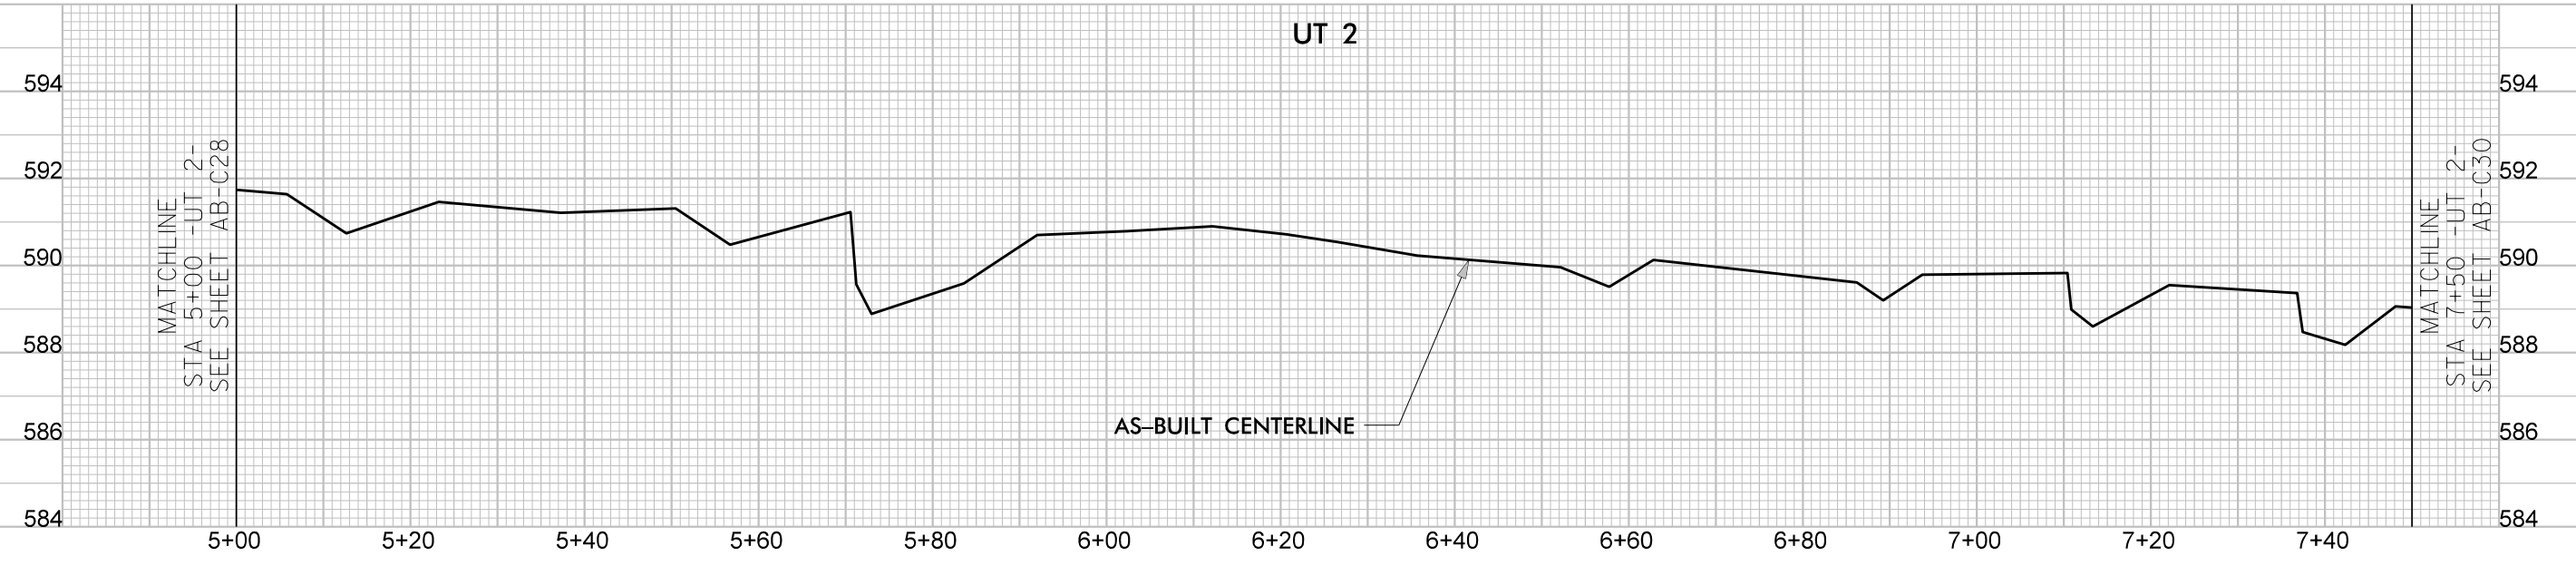


11/9/2022 Wits\_End\_Psh\_AB-C29.dgn

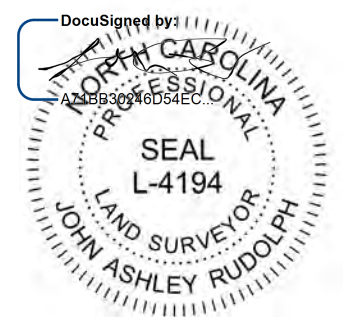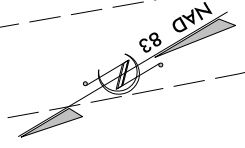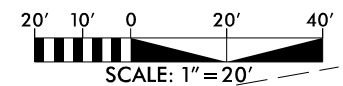

11/9/2022

**DATE:**  
**DOCUMENT NOT CONSIDERED FINAL**  
**UNLESS ALL SIGNATURES COMPLETED**

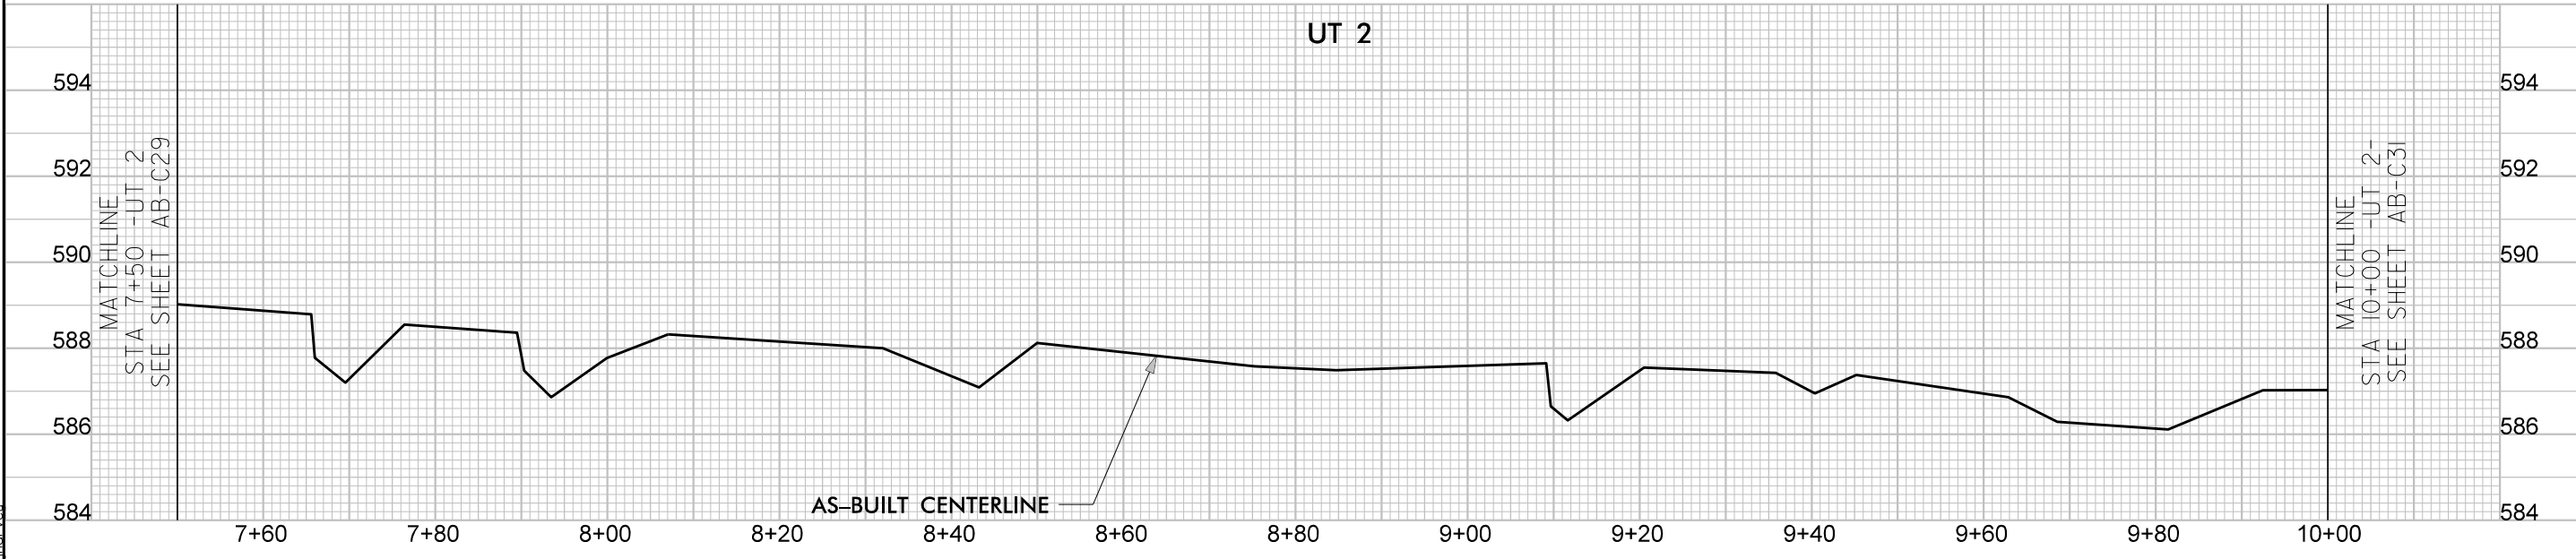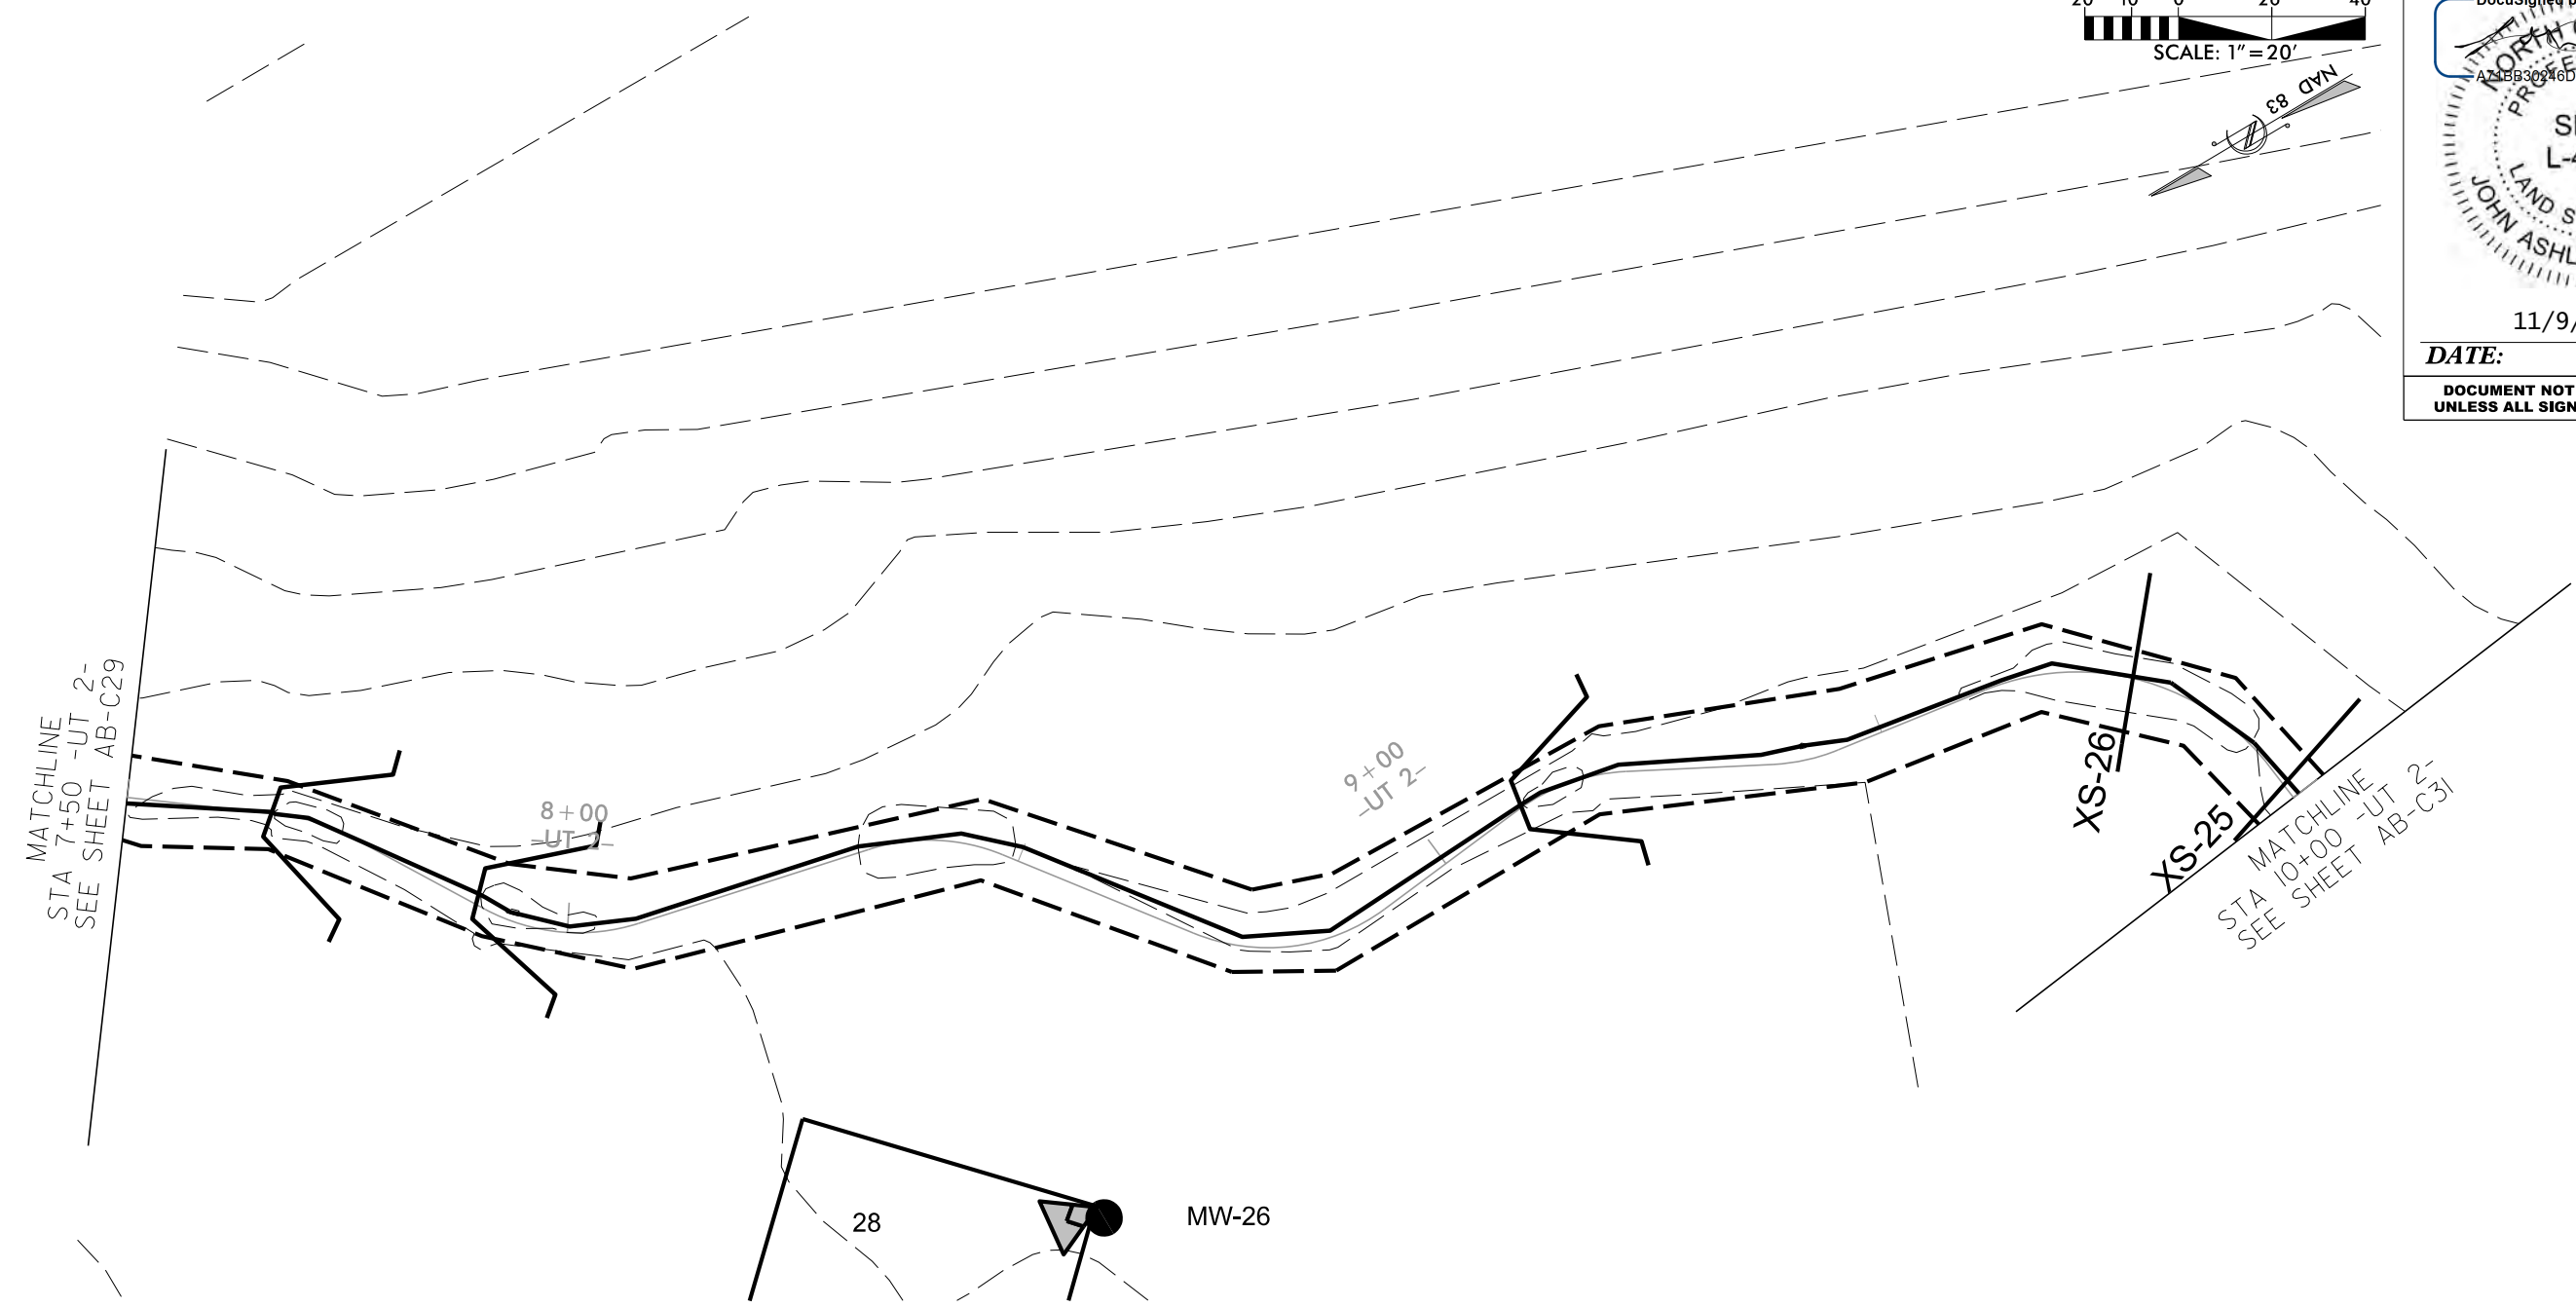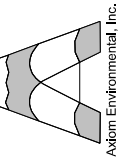

11/9/2022 Wits\_End\_psh\_AB-C30.dgn



© 2022 SUNGATE DESIGN GROUP, P.A. THIS DRAWING AND ALL REPRODUCTIONS OF IT ARE THE SOLE PROPERTY OF SDG. REPRODUCTION OR OTHER USES OF THIS DRAWING WITHOUT WRITTEN CONSENT OF SDG IS NOT PERMITTED.

**WITS END**  
**UNION COUNTY, NC**  
**AS-BUILT SURVEY**


PROJECT # :  
 1221-20024  
 DRAWING NAME:  
 WITS END PSH AB-C30  
 DATE:  
 2021  
 DRAWN BY:  
 JRH  
 REVIEWED BY:  
 JGD  
 REVISIONS:

SHEET NO.  
**AB-C30**



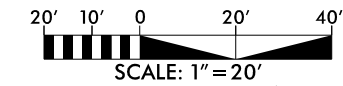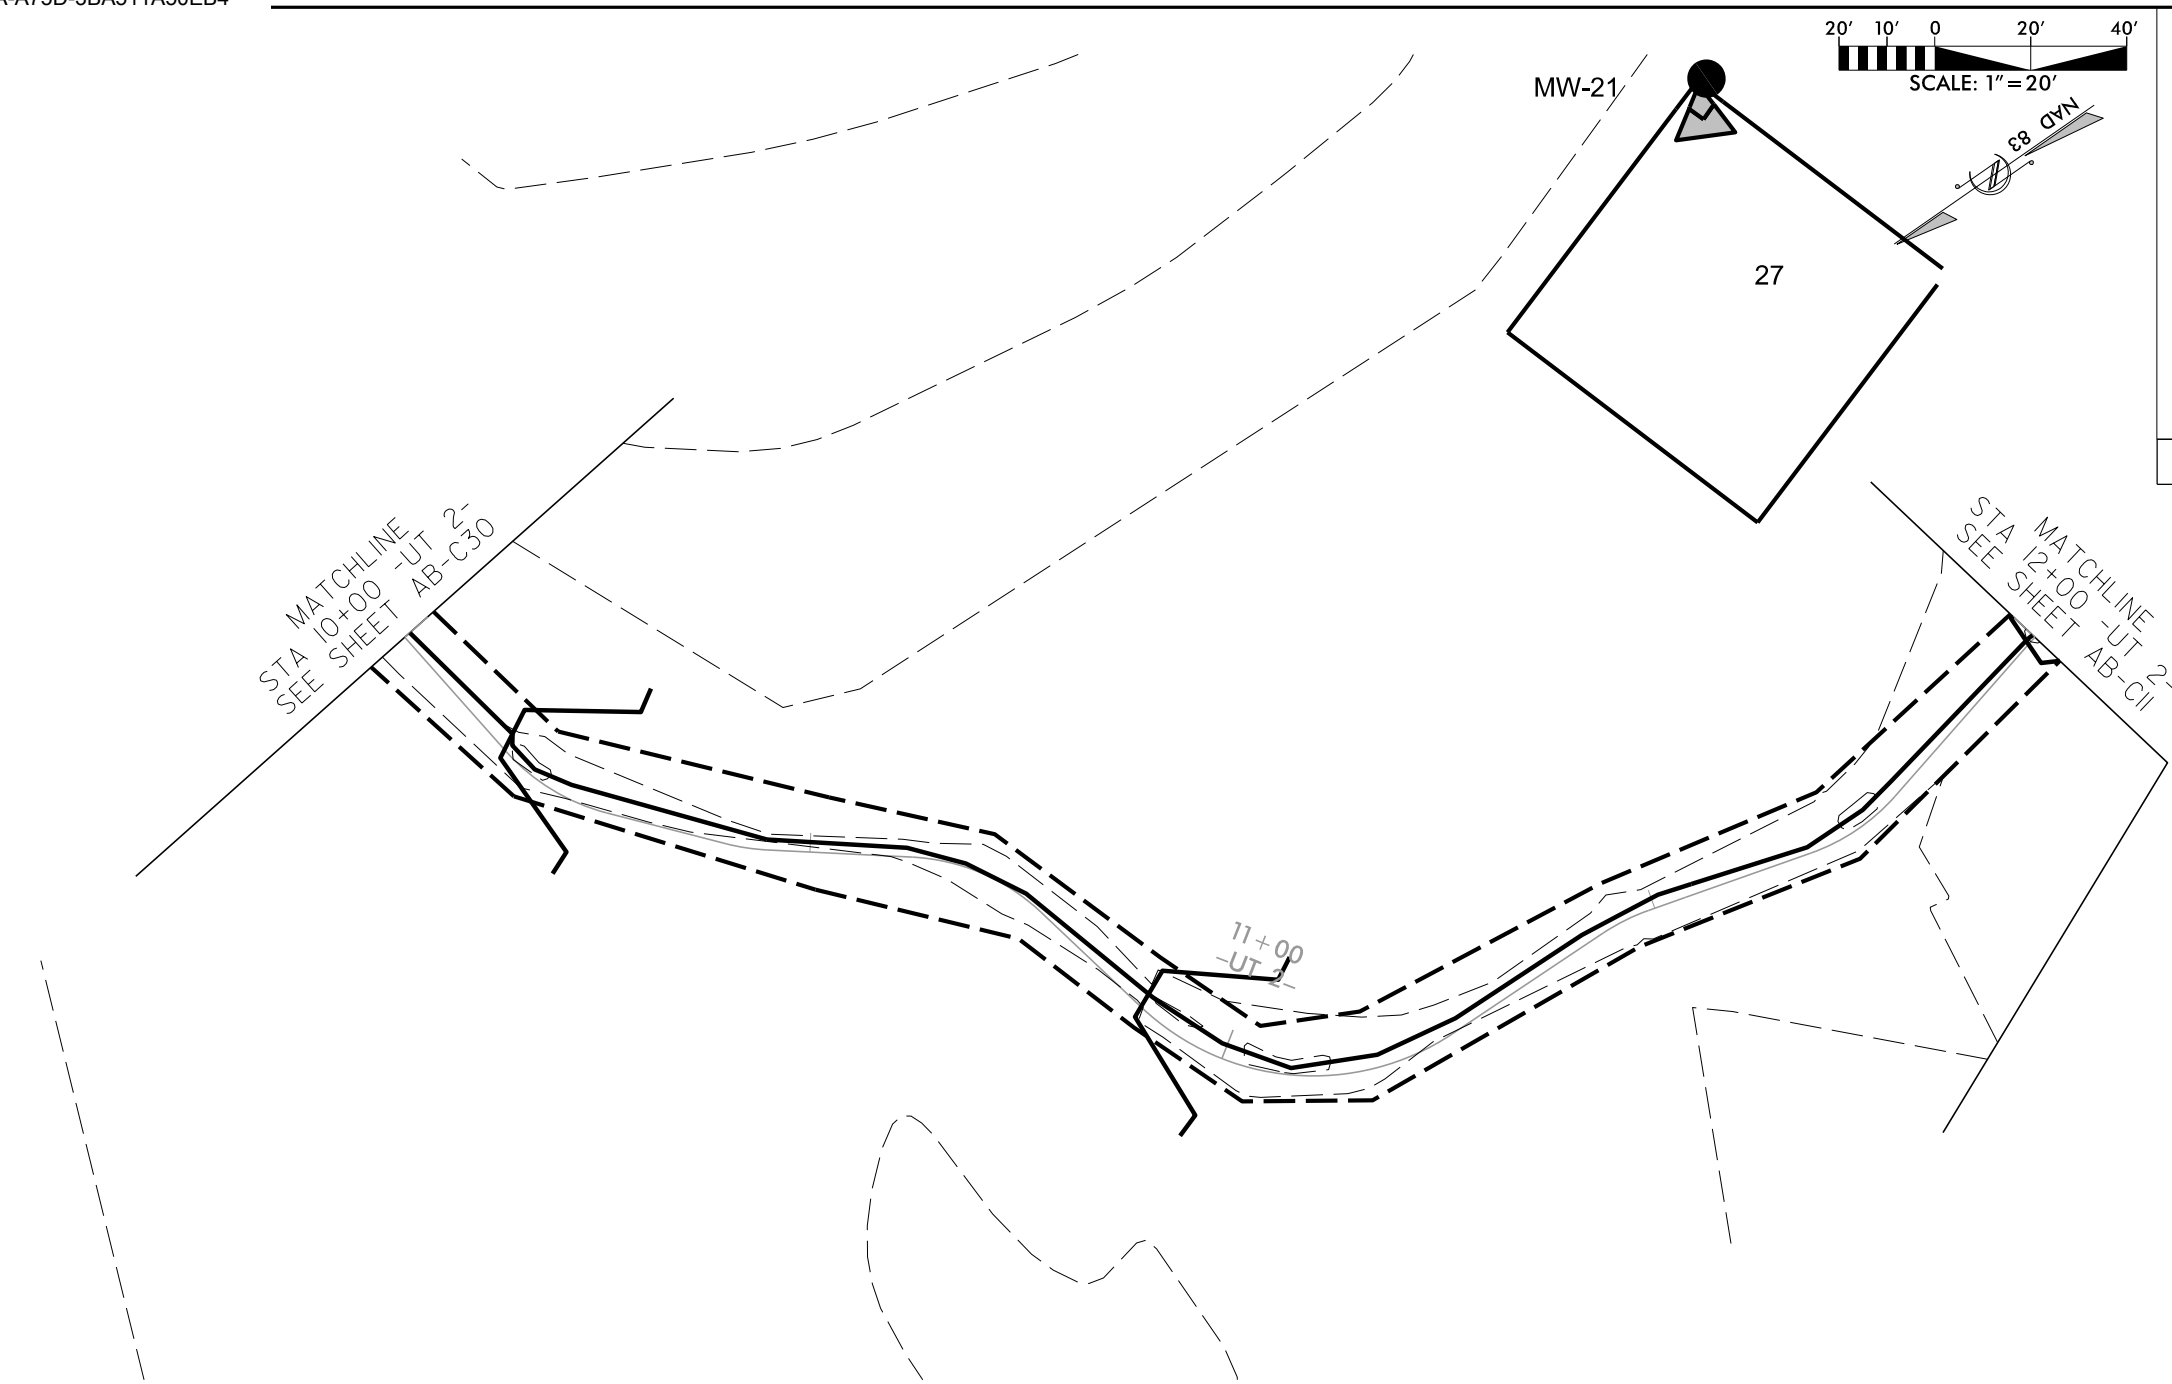

DocuSigned by:  
  
 DATE:  
**DOCUMENT NOT CONSIDERED FINAL  
 UNLESS ALL SIGNATURES COMPLETED**

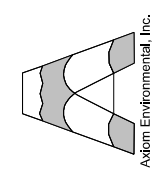


**WITS END**  
 UNION COUNTY, NC  
**AS-BUILT SURVEY**




PROJECT # :  
 1221-20024  
 DRAWING NAME:  
 WITS END PSH AB-C31  
 DATE:  
 2022  
 DRAWN BY:  
 JRH  
 REVIEWED BY:  
 JGD  
 REVISIONS:

SHEET NO.  
**AB-C31**

11/9/2022  
 Wits\_End\_Psh\_AB-C31.dgn  
 jrh

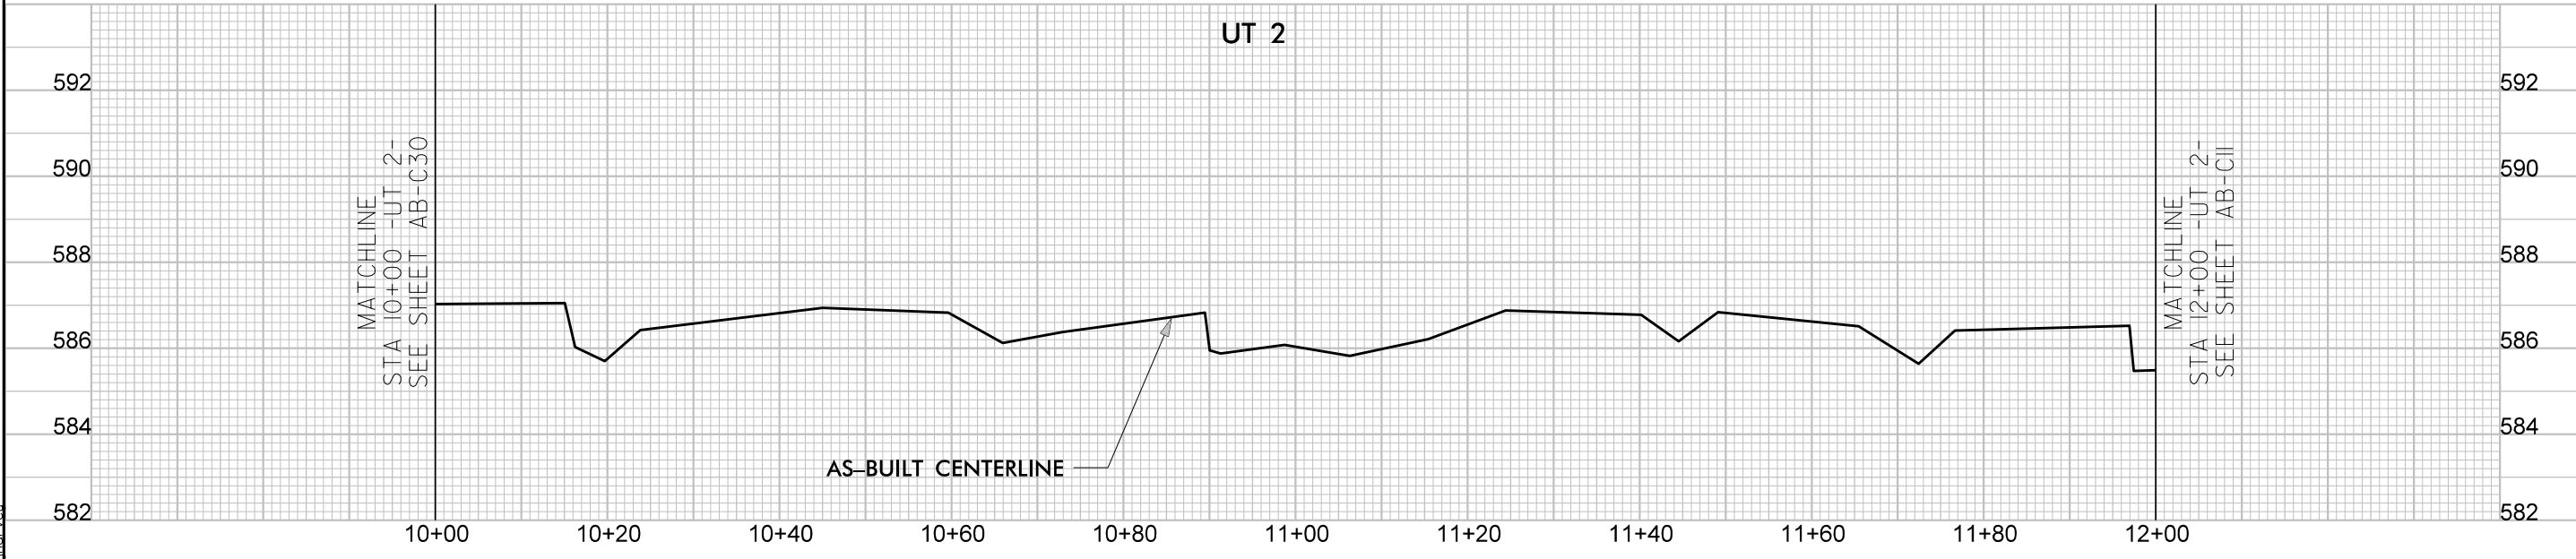


© 2022 SUNGATE DESIGN GROUP, P.A. THIS DRAWING AND ALL REPRODUCTIONS OF IT ARE THE SOLE PROPERTY OF SDG. REPRODUCTION OR OTHER USES OF THIS DRAWING WITHOUT WRITTEN CONSENT OF SDG IS NOT PERMITTED.

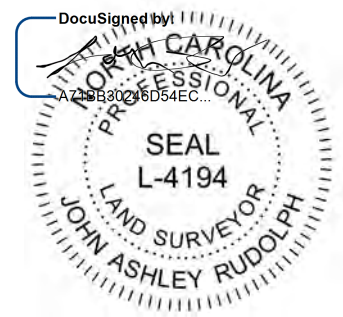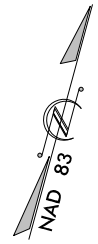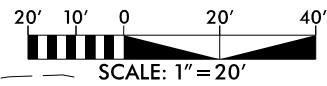

11/9/2022



DATE:  
DOCUMENT NOT CONSIDERED FINAL  
UNLESS ALL SIGNATURES COMPLETED

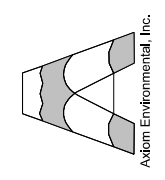

**WITS END**  
UNION COUNTY, NC  
**AS-BUILT SURVEY**




PROJECT # :  
1221-20024  
DRAWING NAME:  
WITS END PSH AB-C32  
DATE:  
2022  
DRAWN BY:  
JRH  
REVIEWED BY:  
JGD  
REVISIONS:

SHEET NO.  
**AB-C32**

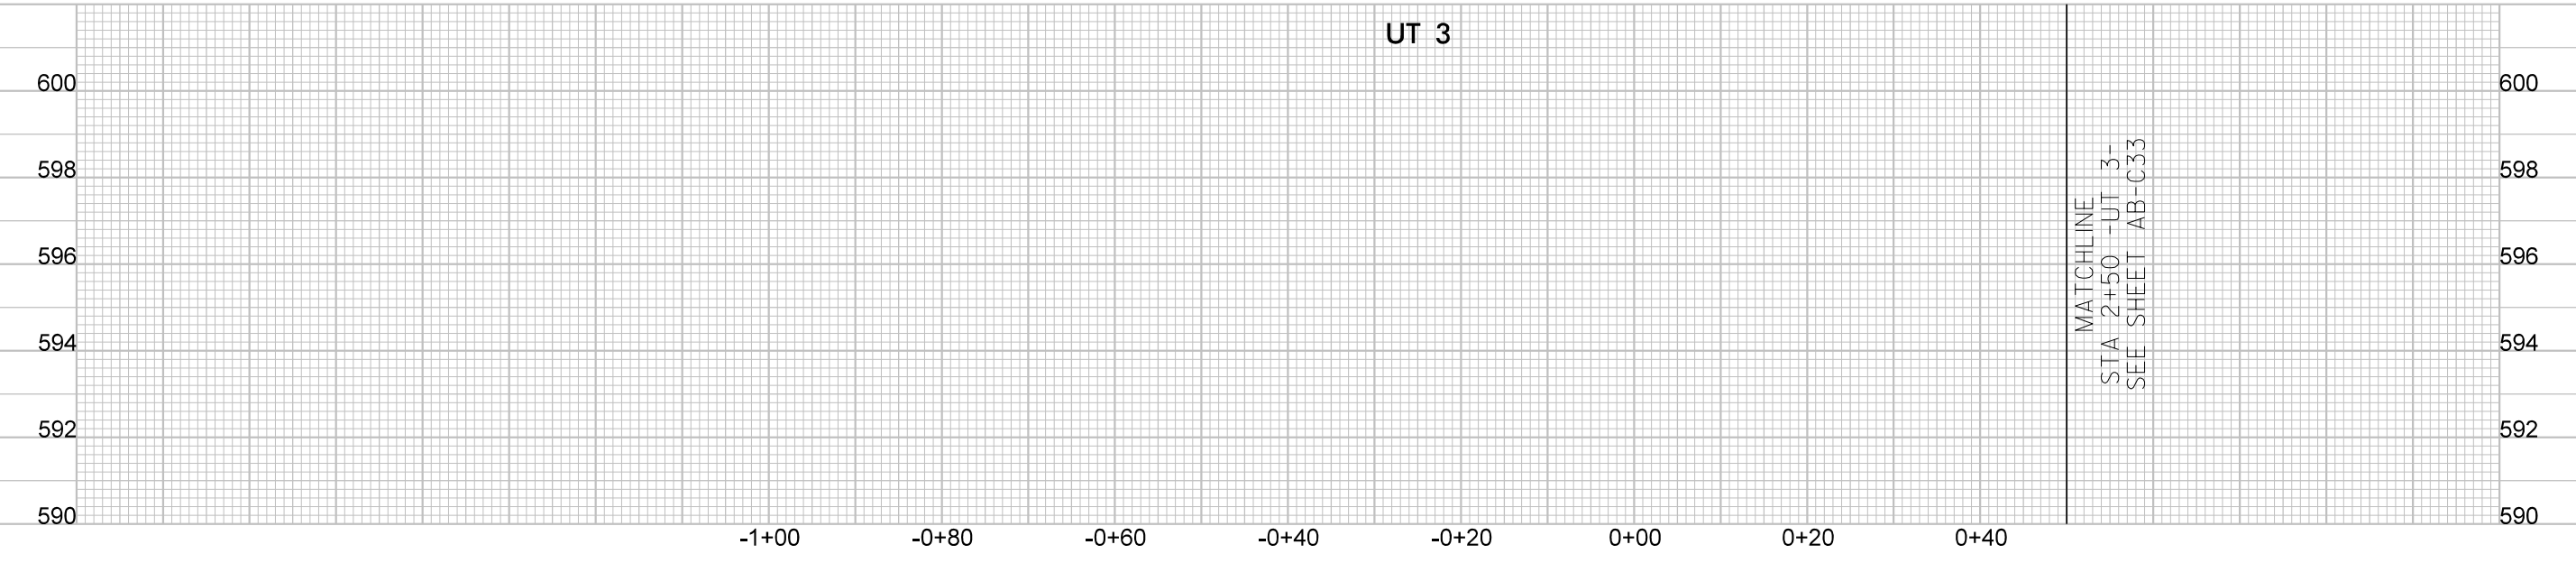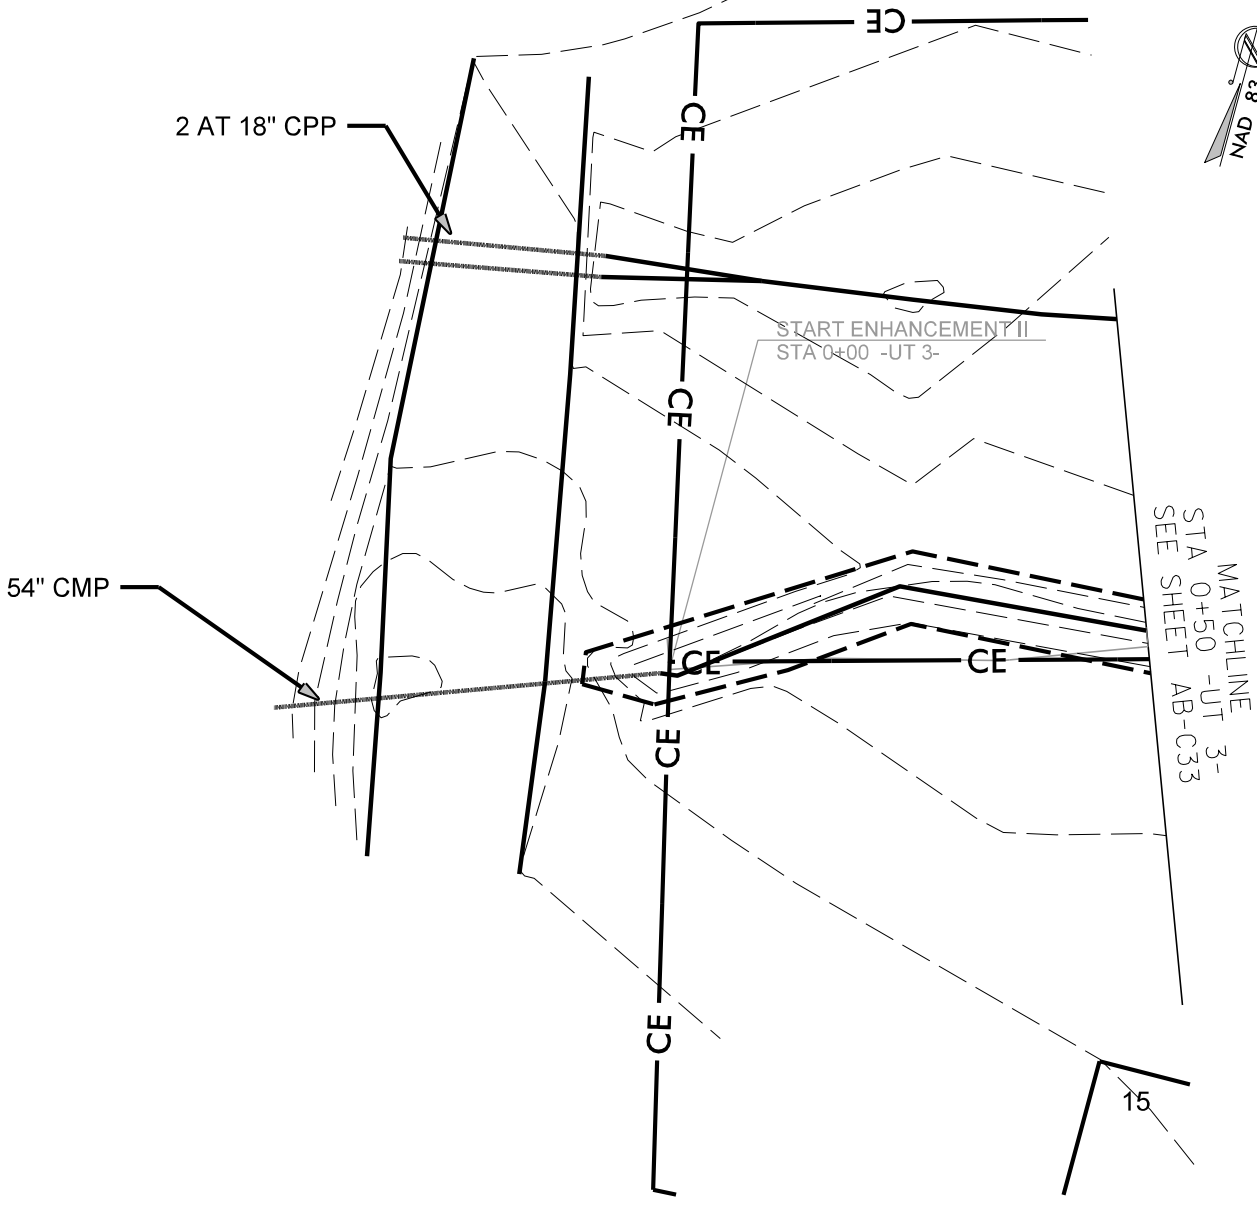


11/9/2022  
Wits\_End\_Psh\_AB-C32.dgn  
jrh

© 2022 SUNGATE DESIGN GROUP, P.A. THIS DRAWING AND ALL REPRODUCTIONS OF IT ARE THE SOLE PROPERTY OF SDG. REPRODUCTION OR OTHER USES OF THIS DRAWING WITHOUT WRITTEN CONSENT OF SDG IS NOT PERMITTED.

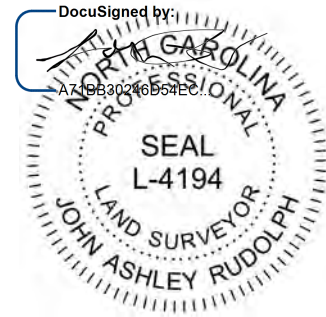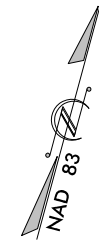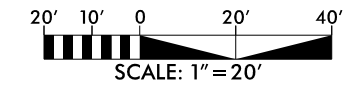

11/9/2022



DATE:  
DOCUMENT NOT CONSIDERED FINAL  
UNLESS ALL SIGNATURES COMPLETED

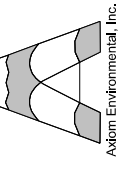

**WITS END**  
UNION COUNTY, NC  
**AS-BUILT SURVEY**

PROJECT # :  
1221-20024  
DRAWING NAME:  
WITS END PSH AB-C33  
DATE:  
2022  
DRAWN BY:  
JRH  
REVIEWED BY:  
JGD  
REVISIONS:


SHEET NO.  
**AB-C33**

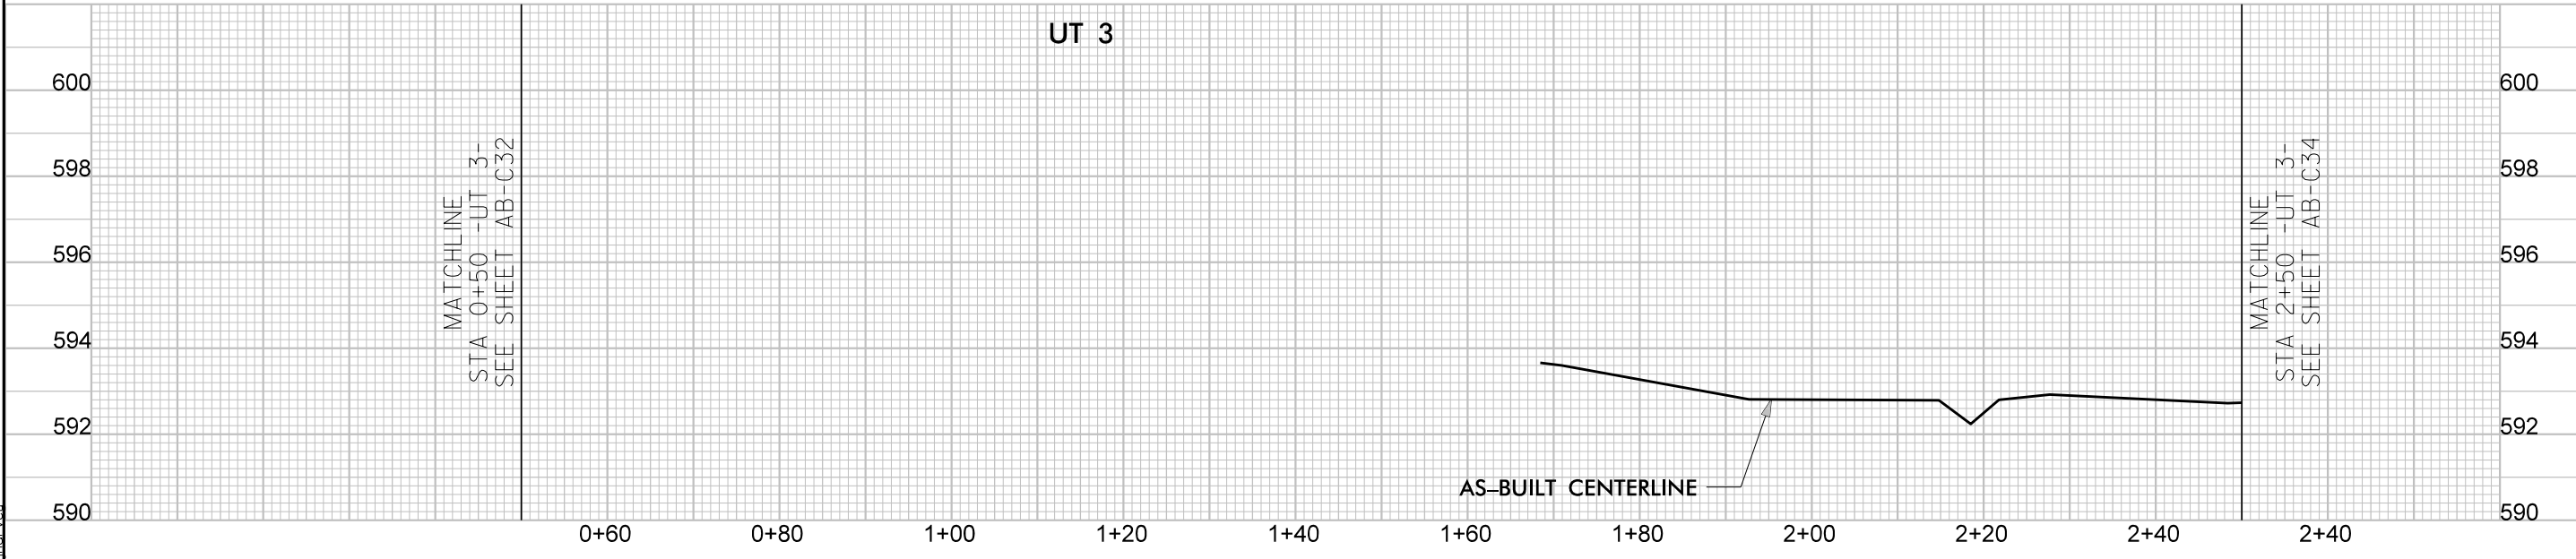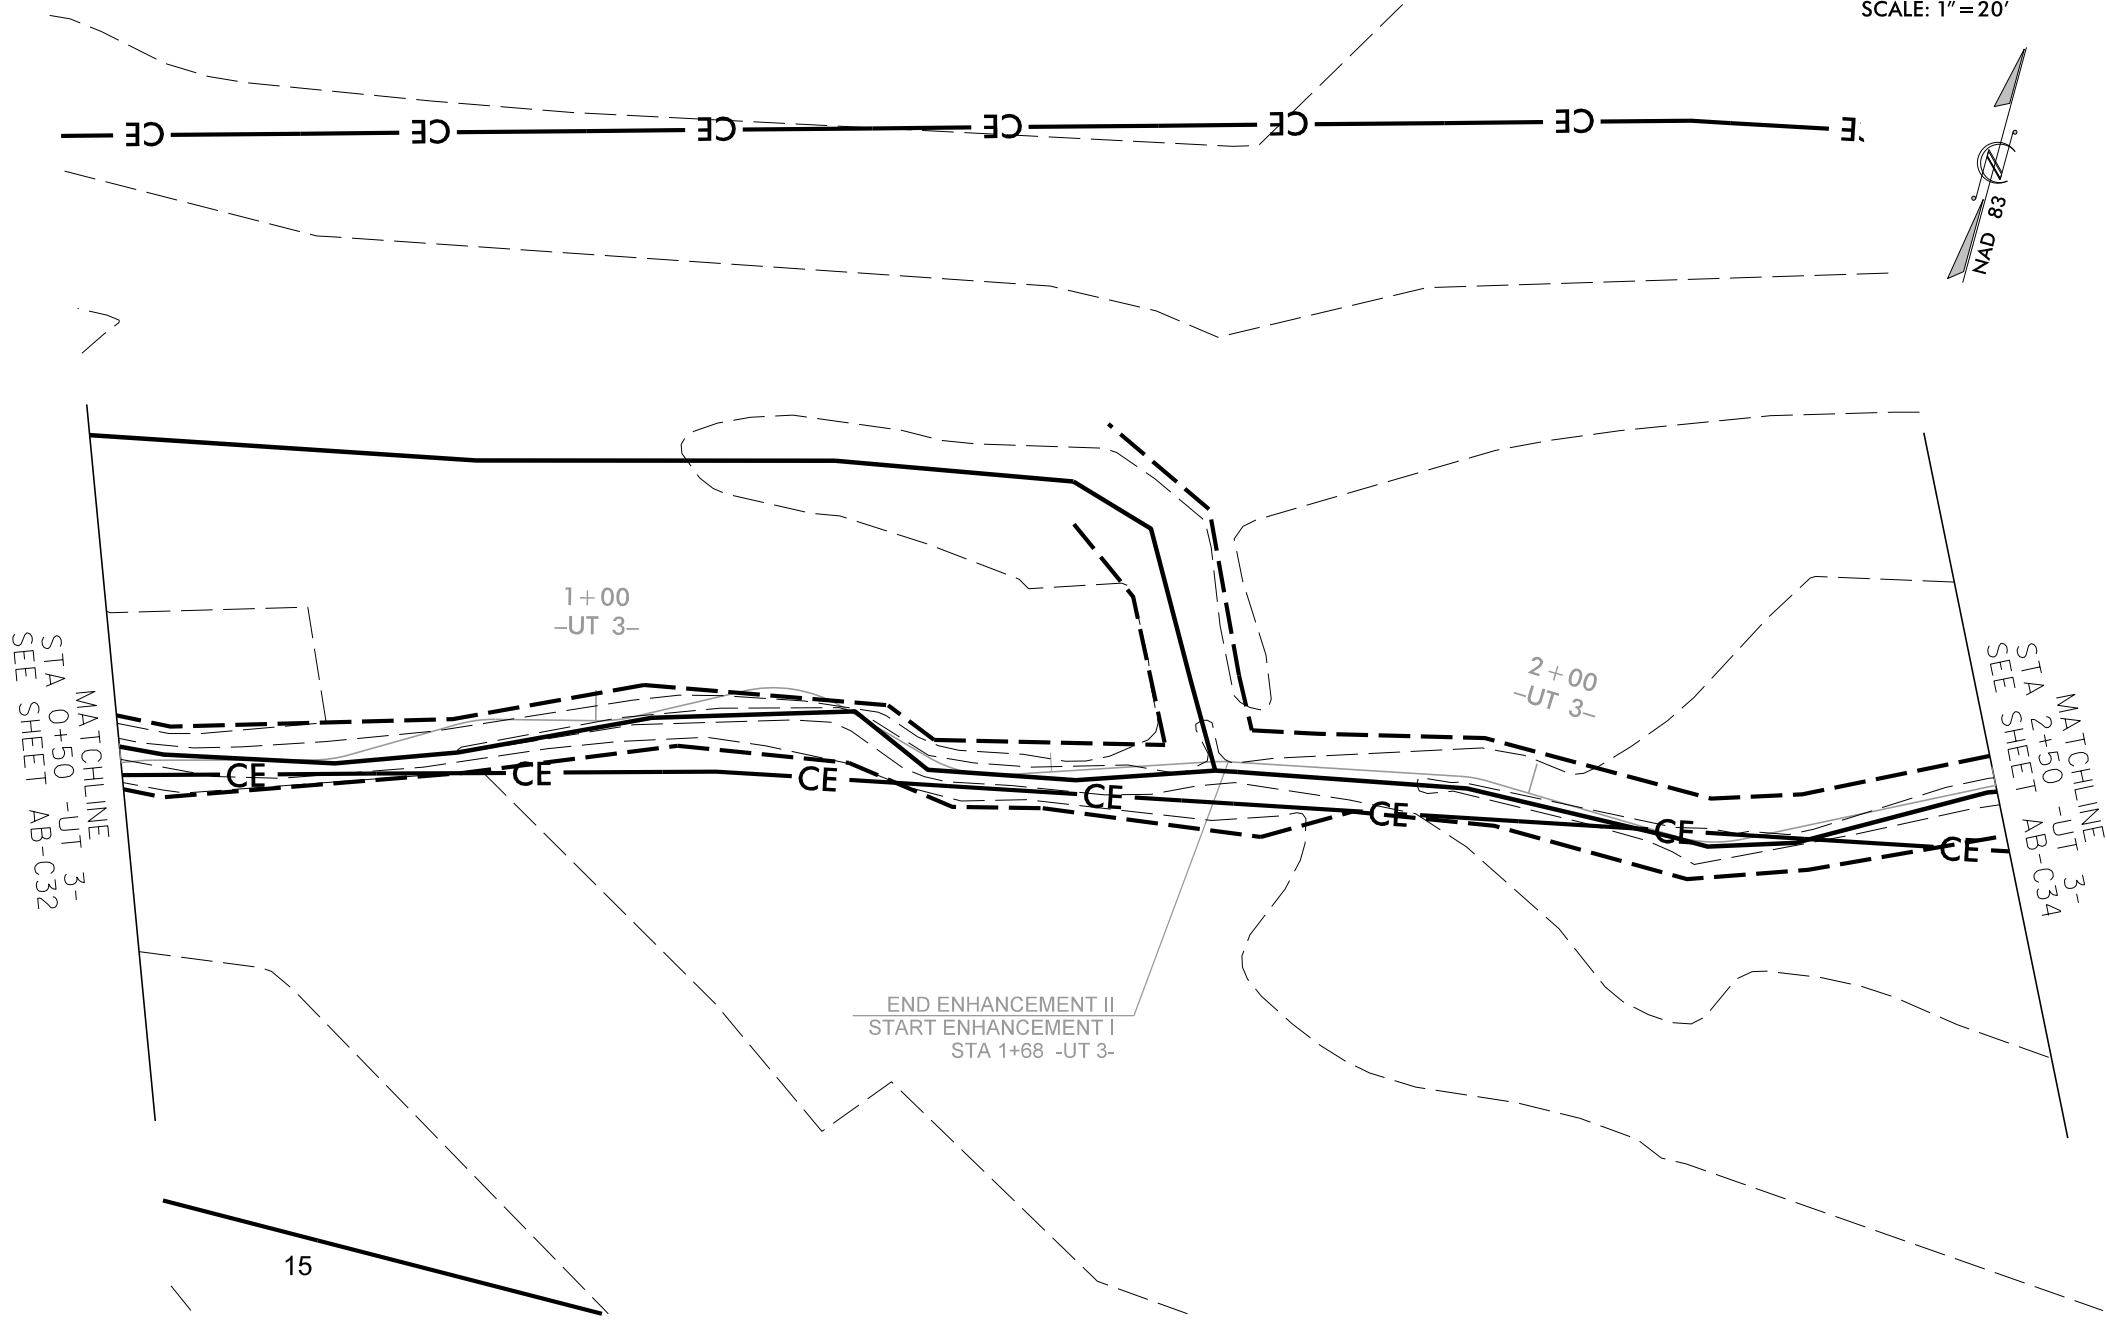

11/9/2022  
Wits\_End\_Psh\_AB-C33.dgn  
jrh


© 2022 SUNGATE DESIGN GROUP, P.A. THIS DRAWING AND ALL REPRODUCTIONS OF IT ARE THE SOLE PROPERTY OF SDG. REPRODUCTION OR OTHER USES OF THIS DRAWING WITHOUT WRITTEN CONSENT OF SDG IS NOT PERMITTED.



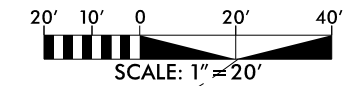

DocuSigned by:  
  
 SEAL  
 L-4194  
 JOHN ASHLEY RUDOLPH  
 11/9/2022

DATE:  
 DOCUMENT NOT CONSIDERED FINAL  
 UNLESS ALL SIGNATURES COMPLETED

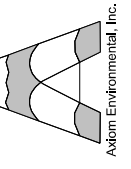


© 2022 SUNGATE DESIGN GROUP, P.A. THIS DRAWING AND ALL REPRODUCTIONS OF IT ARE THE SOLE PROPERTY OF SDG. REPRODUCTION OR OTHER USES OF THIS DRAWING WITHOUT WRITTEN CONSENT OF SDG IS NOT PERMITTED.

**WITS END**  
 UNION COUNTY, NC  
**AS-BUILT SURVEY**

PROJECT # :  
 1221-20024  
 DRAWING NAME:  
 WITS END PSH AB-C34  
 DATE:  
 2022  
 DRAWN BY:  
 JRH  
 REVIEWED BY:  
 JGD  
 REVISIONS:

SHEET NO.  
**AB-C34**

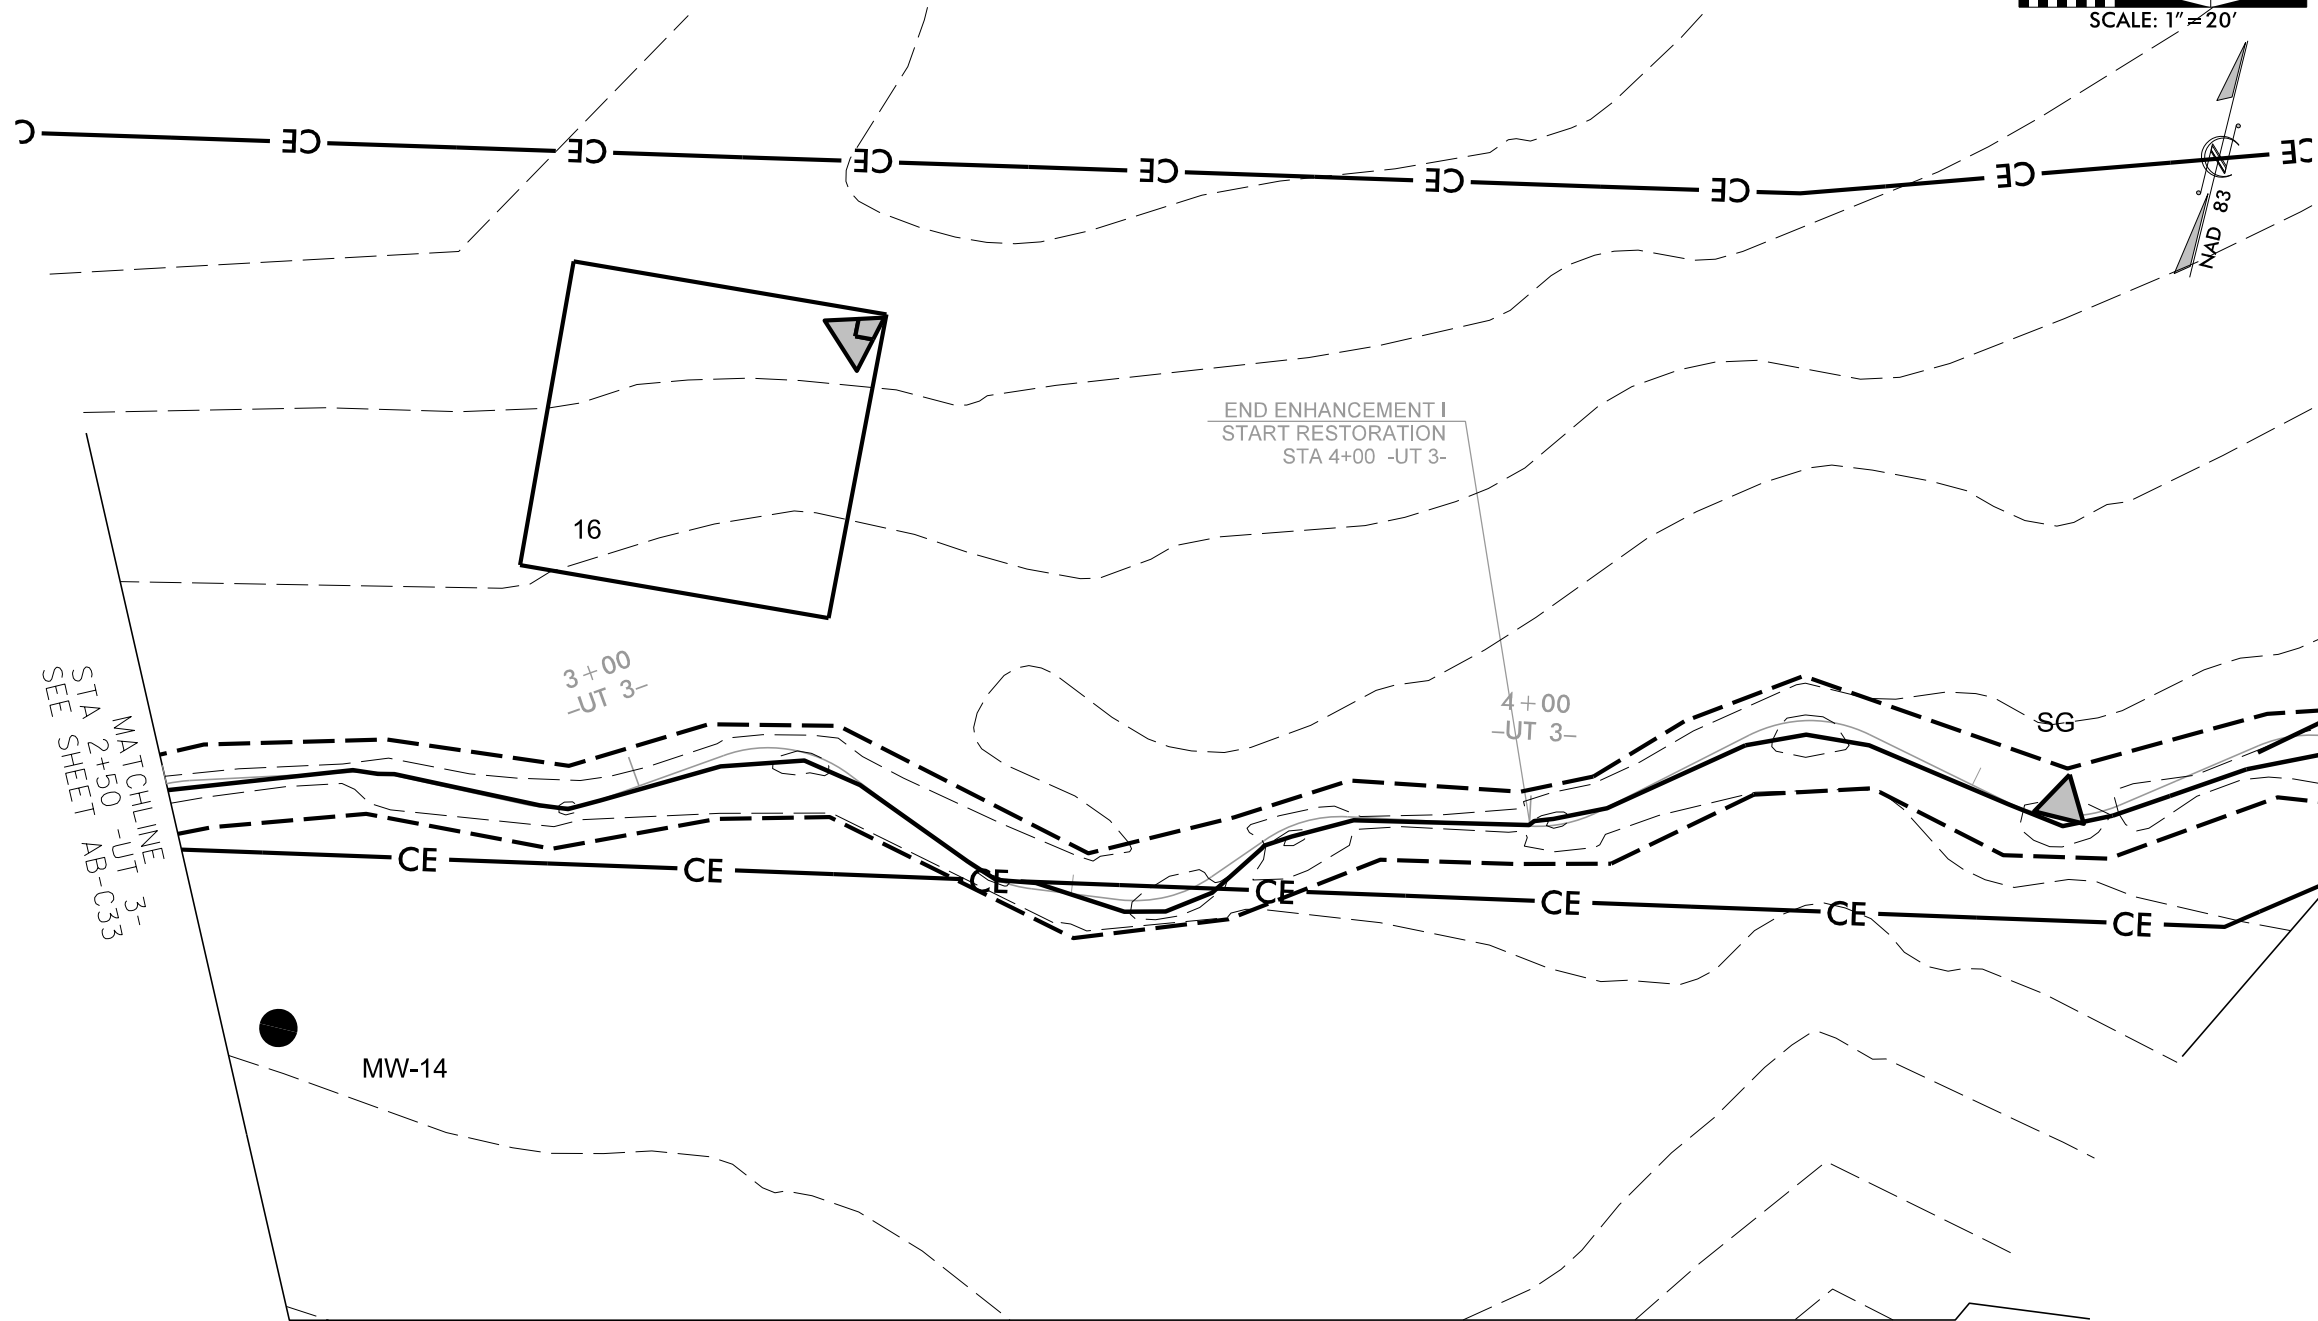


END ENHANCEMENT I  
 START RESTORATION  
 STA 4+00 -UT 3-



MATCHLINE  
 STA 2+50 -UT 3-  
 SEE SHEET AB-C33

MATCHLINE  
 STA 5+00 -UT 3-  
 SEE SHEET AB-C35

MATCHLINE SEE SHEET AB-C53  
 UT 3

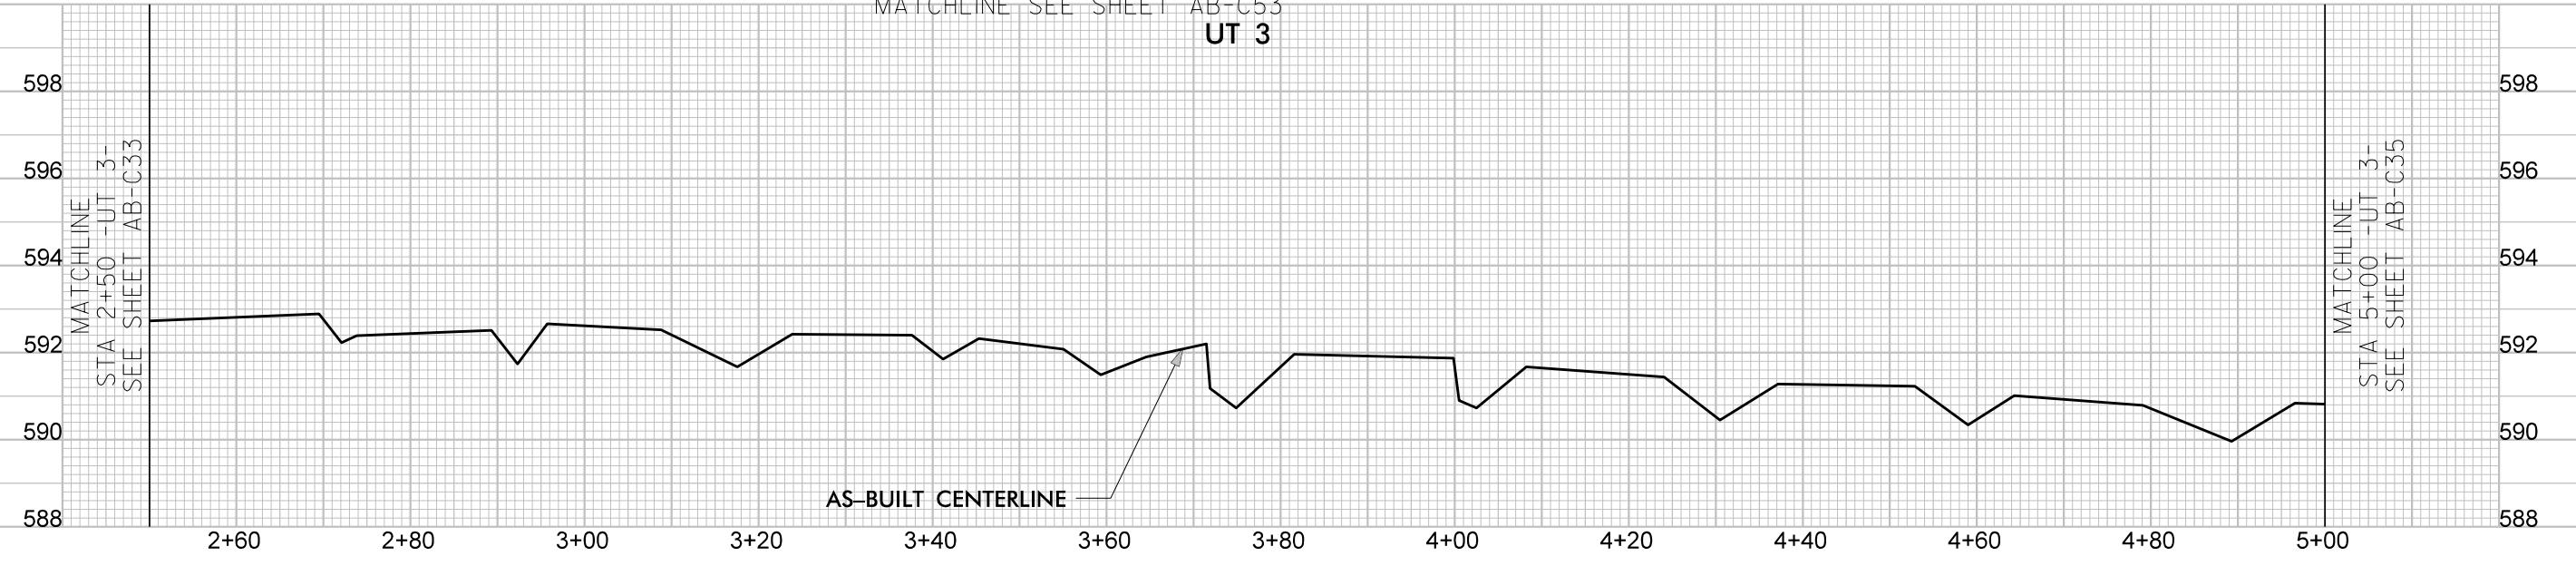


11/9/2022  
 Wits\_End\_Psh\_AB-C34.dgn  
 jrh

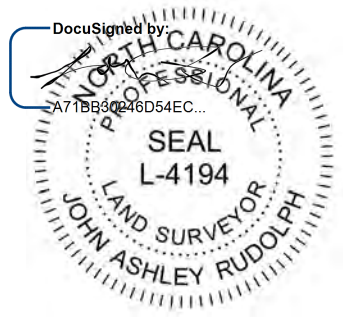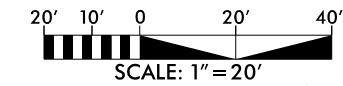

DATE: 11/9/2022

DOCUMENT NOT CONSIDERED FINAL UNLESS ALL SIGNATURES COMPLETED


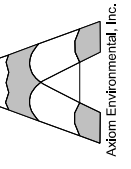


© 2022 SUNGATE DESIGN GROUP, P.A. THIS DRAWING AND ALL REPRODUCTIONS OF IT ARE THE SOLE PROPERTY OF SDG. REPRODUCTION OR OTHER USES OF THIS DRAWING WITHOUT WRITTEN CONSENT OF SDG IS NOT PERMITTED.



WITS END UNION COUNTY, NC AS-BUILT SURVEY

PROJECT #: 1221-20024  
DRAWING NAME: WITS END PSH AB-C35  
DATE: 2022  
DRAWN BY: JRH  
REVIEWED BY: JGD  
REVISIONS:

SHEET NO. AB-C35

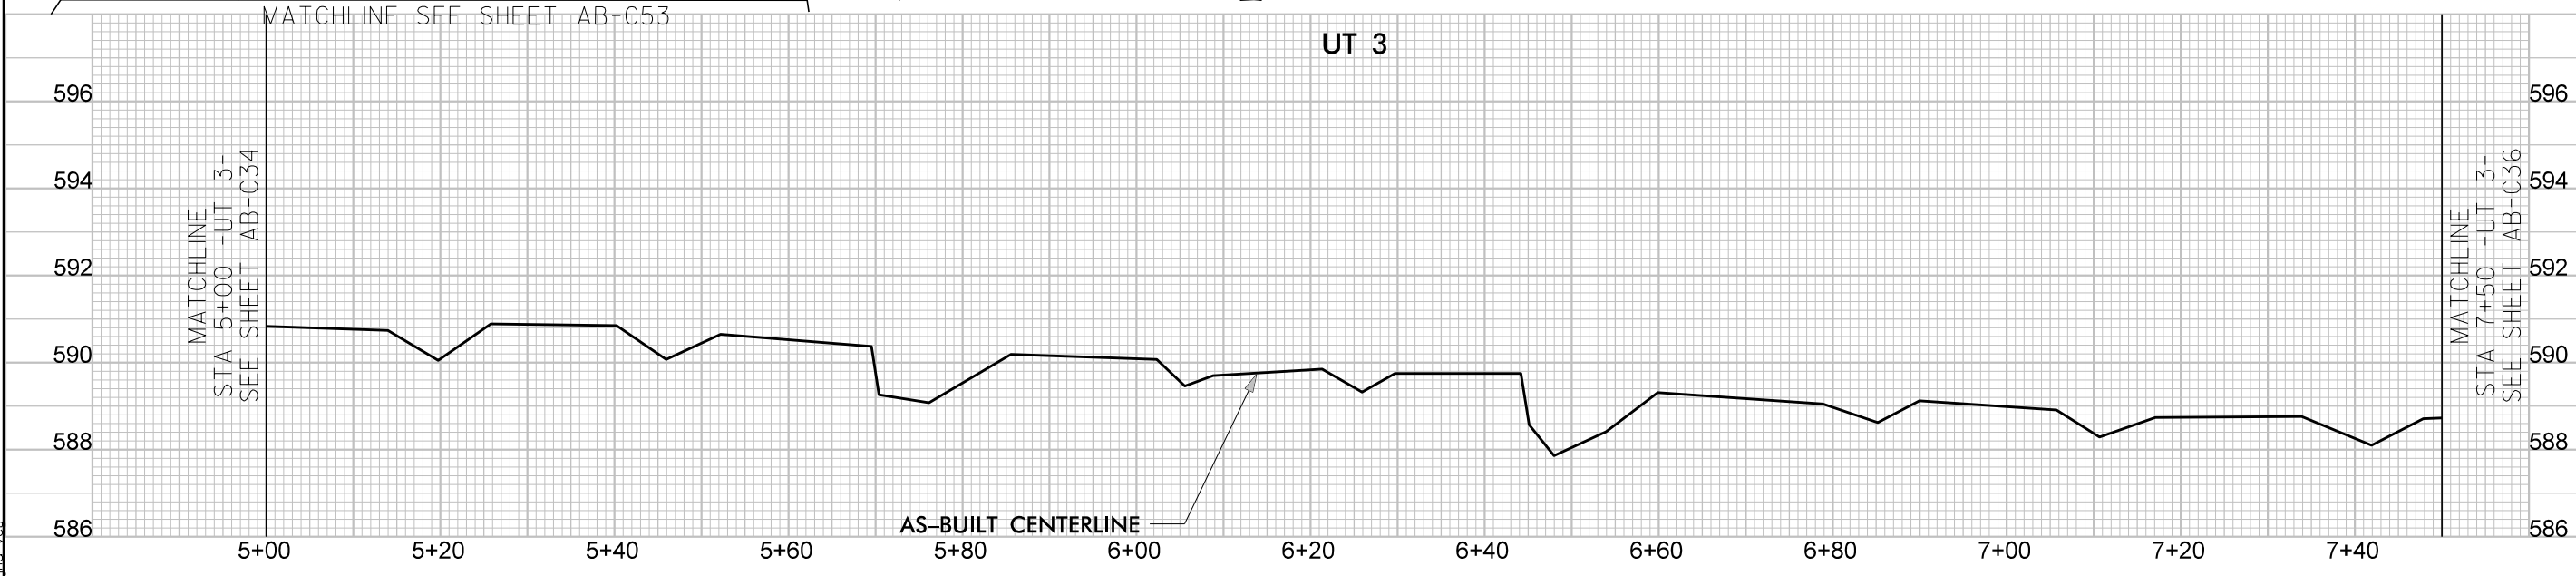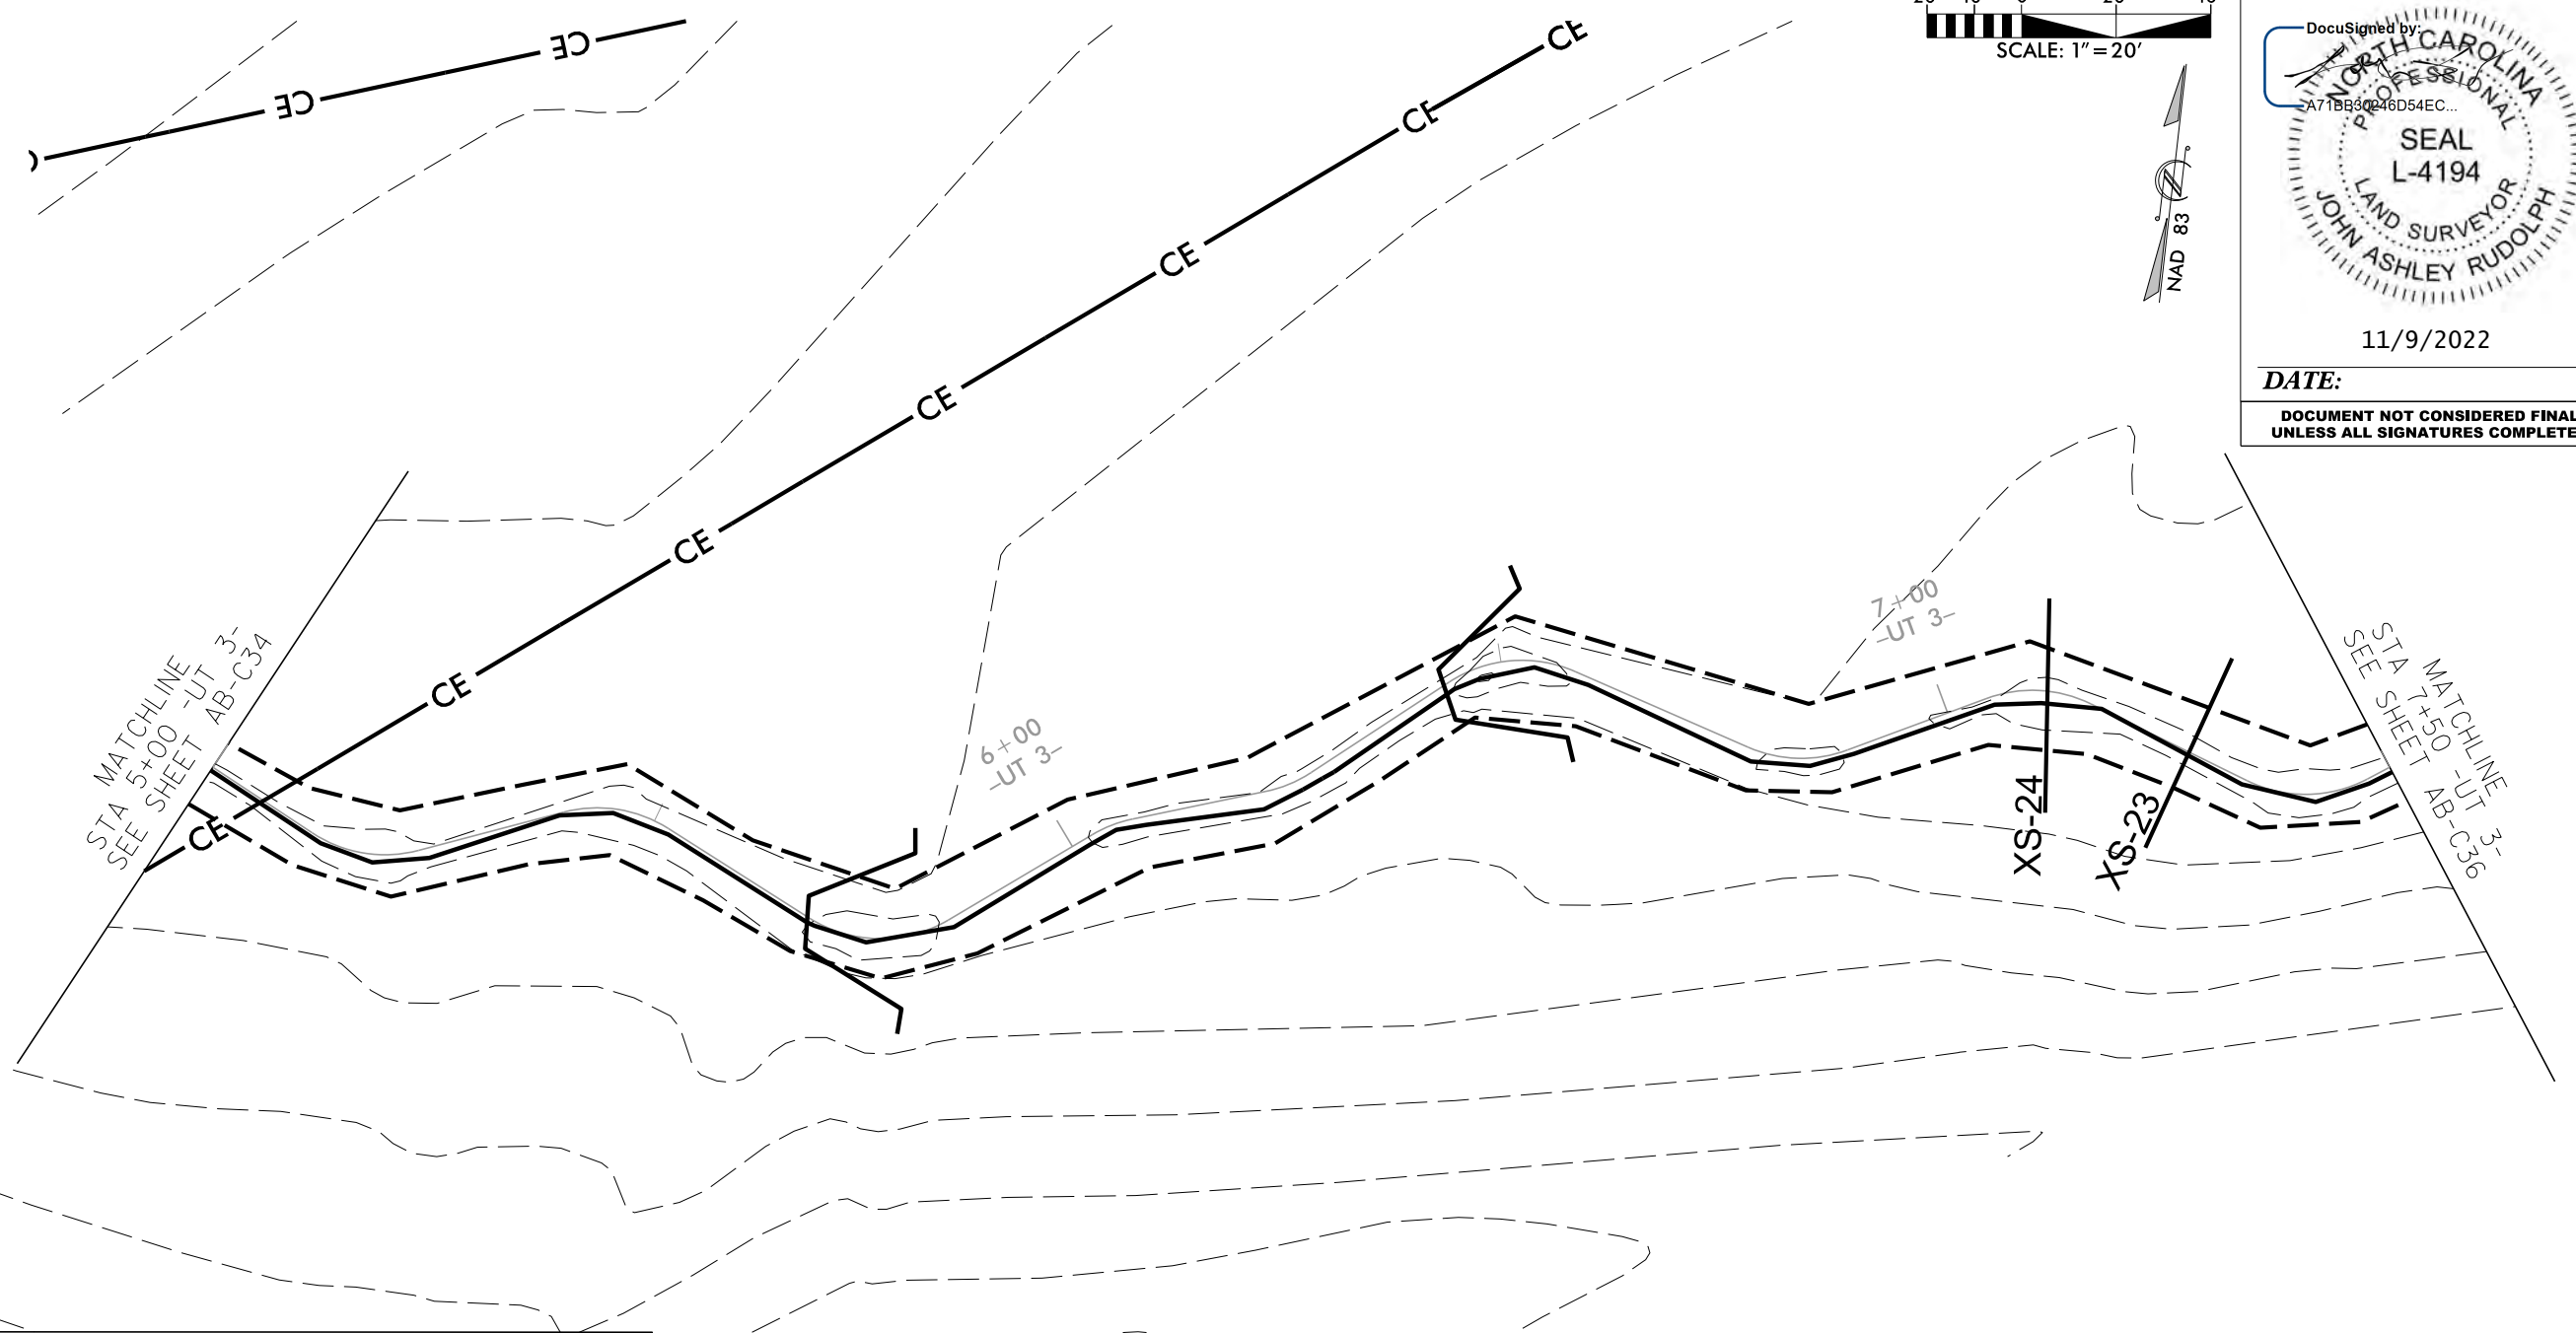


11/9/2022  
Wits\_End\_Psh\_AB-C35.dgn  
jrh




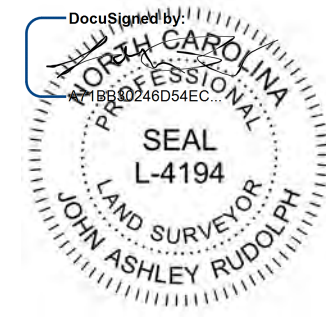
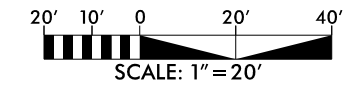


DATE: 11/9/2022

DOCUMENT NOT CONSIDERED FINAL UNLESS ALL SIGNATURES COMPLETED

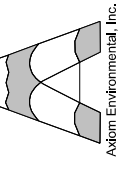

MW-13

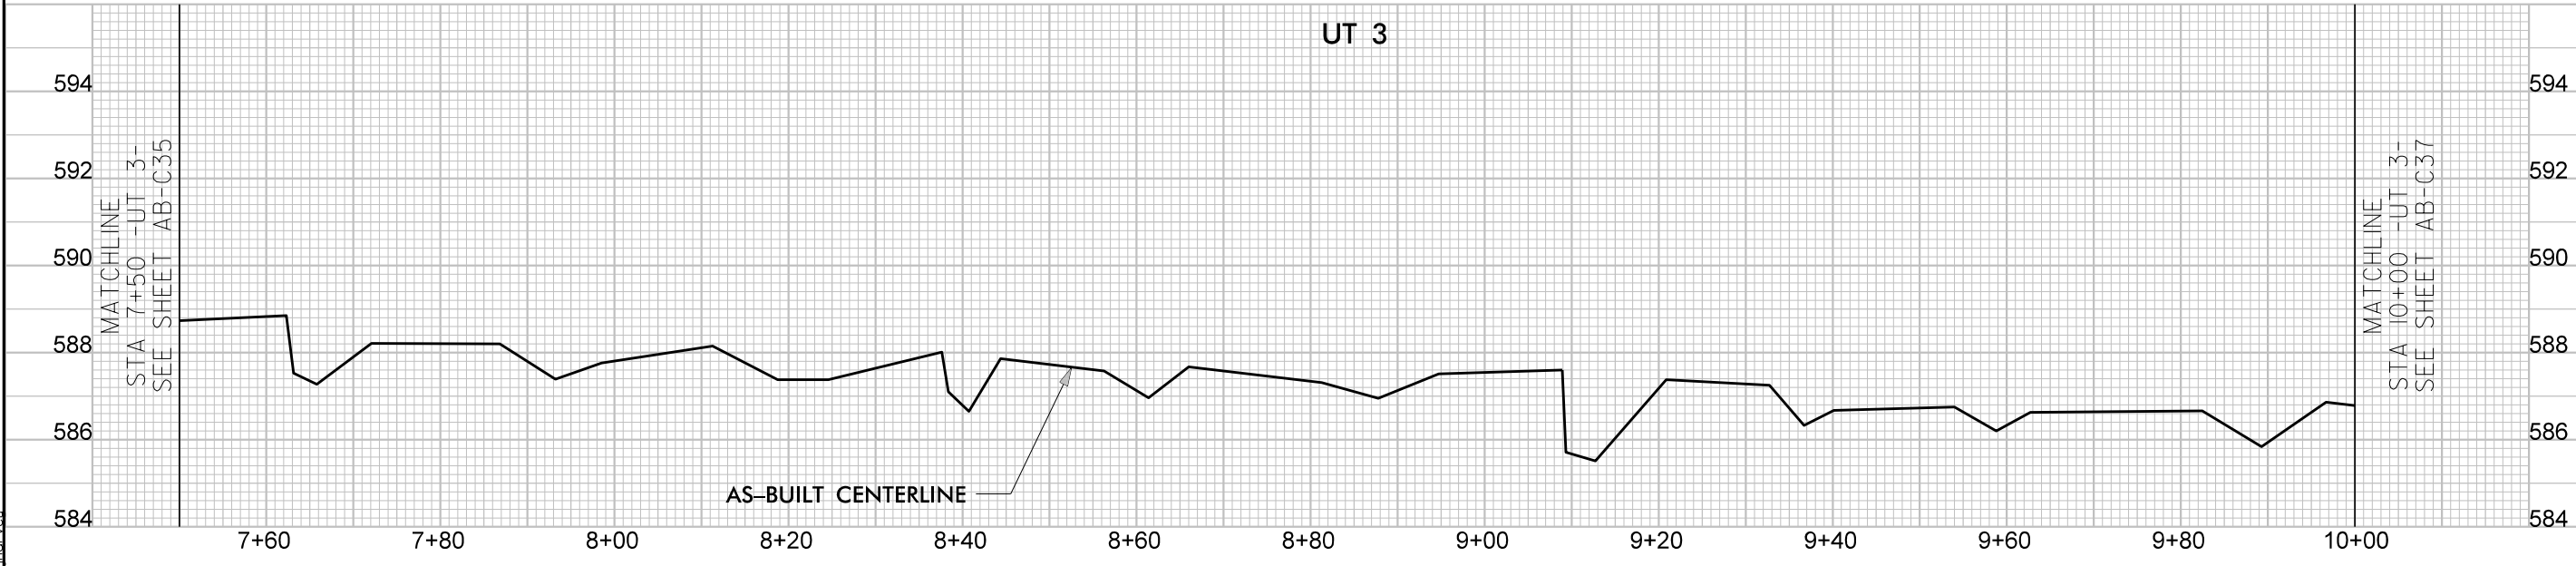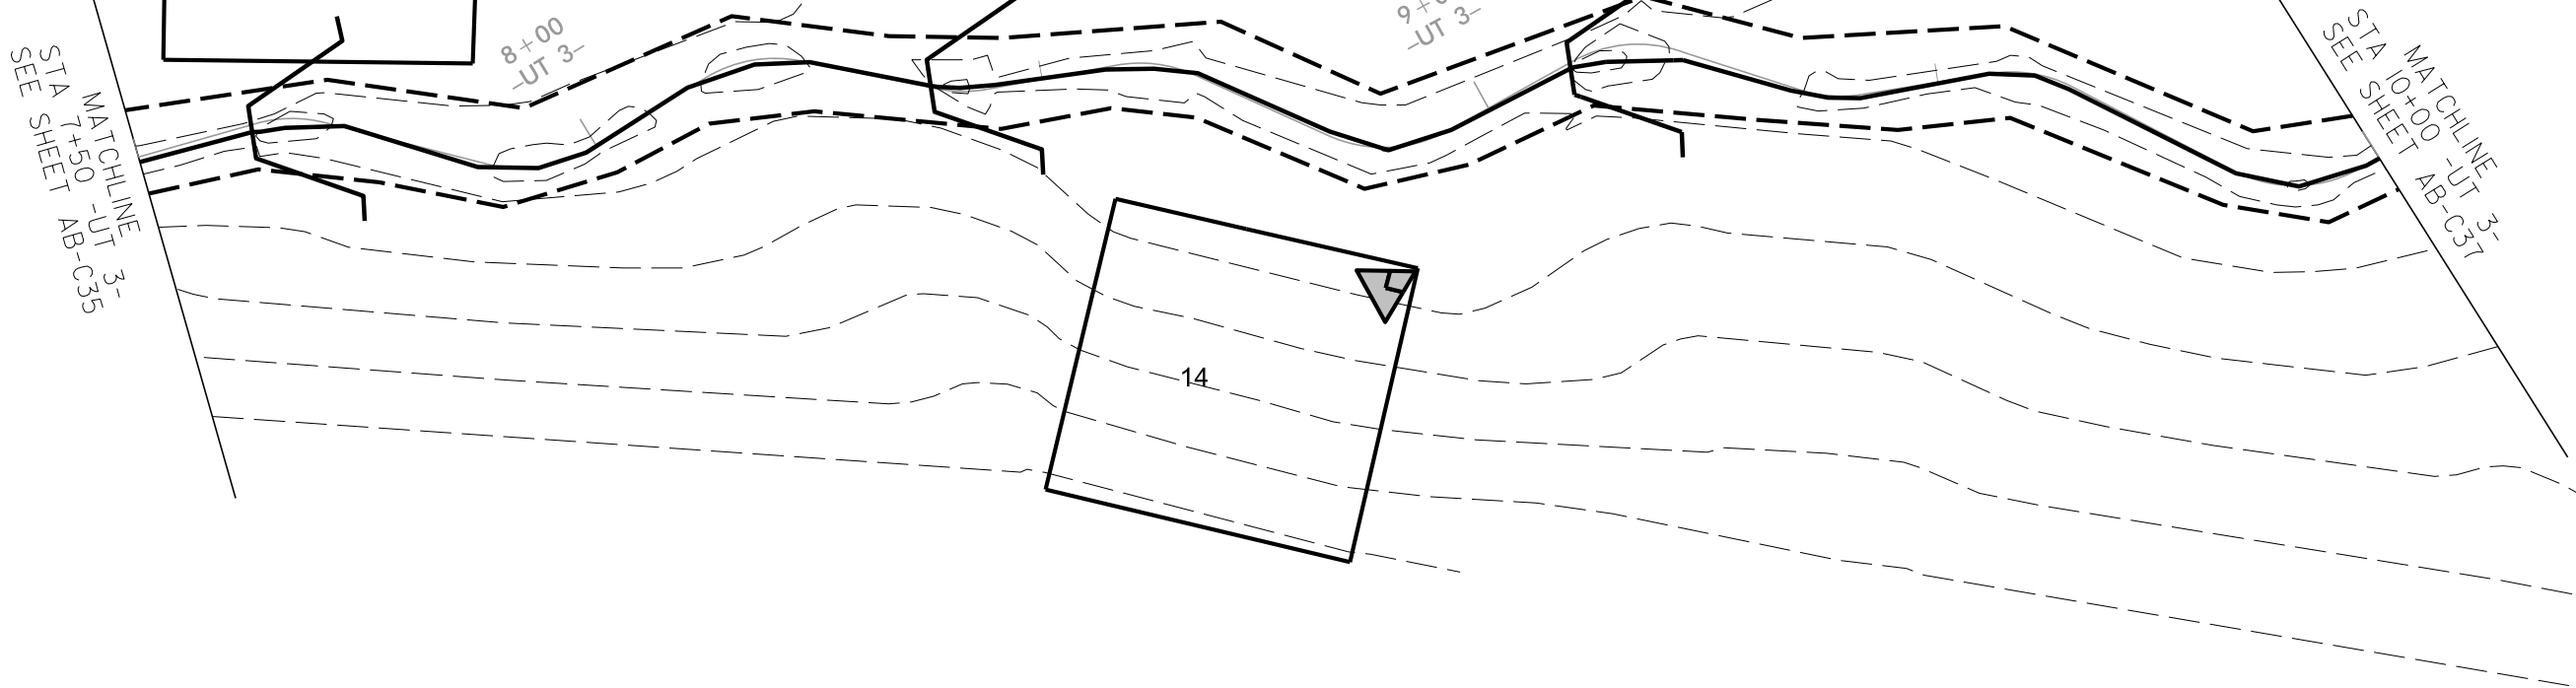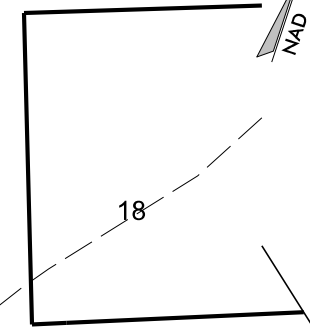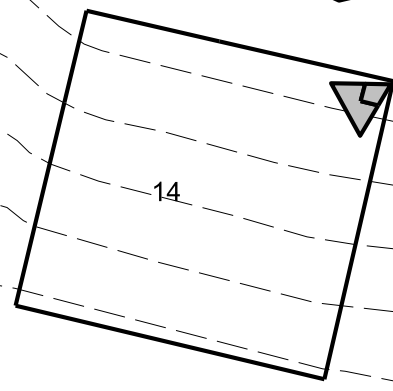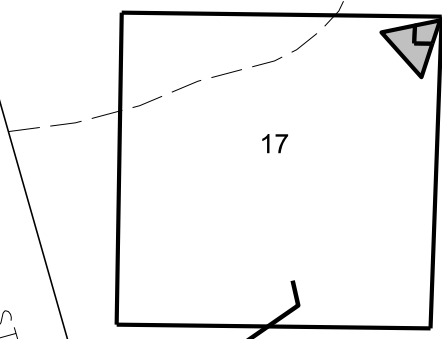

11/9/2022 Wits\_End\_psh\_AB-C36.dgn


© 2022 SUNGATE DESIGN GROUP, P.A. THIS DRAWING AND ALL REPRODUCTIONS OF IT ARE THE SOLE PROPERTY OF SDG. REPRODUCTION OR OTHER USES OF THIS DRAWING WITHOUT WRITTEN CONSENT OF SDG IS NOT PERMITTED.

WITS END UNION COUNTY, NC AS-BUILT SURVEY

PROJECT #: 1221-20024  
DRAWING NAME: WITS END PSH AB-C36  
DATE: 2022  
DRAWN BY: JRH  
REVIEWED BY: JGD  
REVISIONS:


SHEET NO. AB-C36



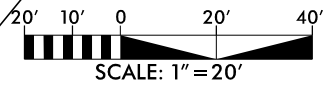

DocuSigned by:  
 JOHN ASHLEY RUDOLPH  
 SEAL  
 L-4194  
 LAND SURVEYOR  
 JOHN ASHLEY RUDOLPH  
 11/9/2022

**DATE:**  
 DOCUMENT NOT CONSIDERED FINAL  
 UNLESS ALL SIGNATURES COMPLETED


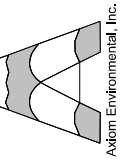


© 2021 SUNGATE DESIGN GROUP, P.A. THIS DRAWING AND ALL REPRODUCTIONS OF IT ARE THE SOLE PROPERTY OF SDG. REPRODUCTION OR OTHER USES OF THIS DRAWING WITHOUT WRITTEN CONSENT OF SDG IS NOT PERMITTED.


**WITS END  
 UNION COUNTY, NC  
 AS-BUILT SURVEY**

PROJECT # :  
 1221-20024  
 DRAWING NAME:  
 WITS END PSH AB-C37  
 DATE:  
 2022  
 DRAWN BY:  
 JRH  
 REVIEWED BY:  
 JGD  
 REVISIONS:

SHEET NO.  
**AB-C37**

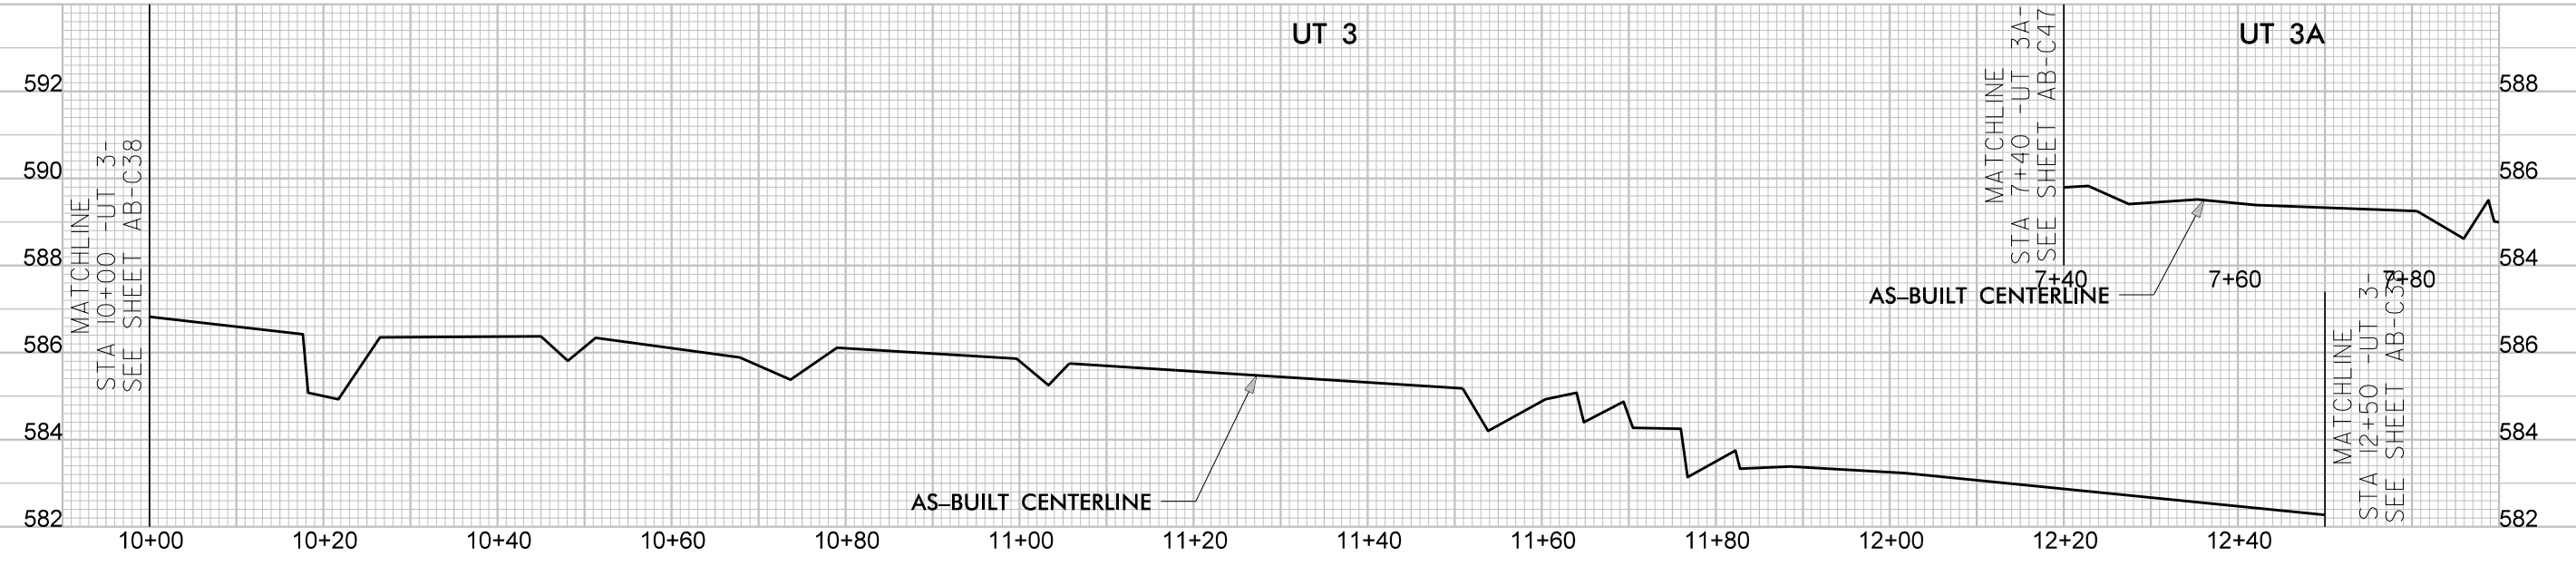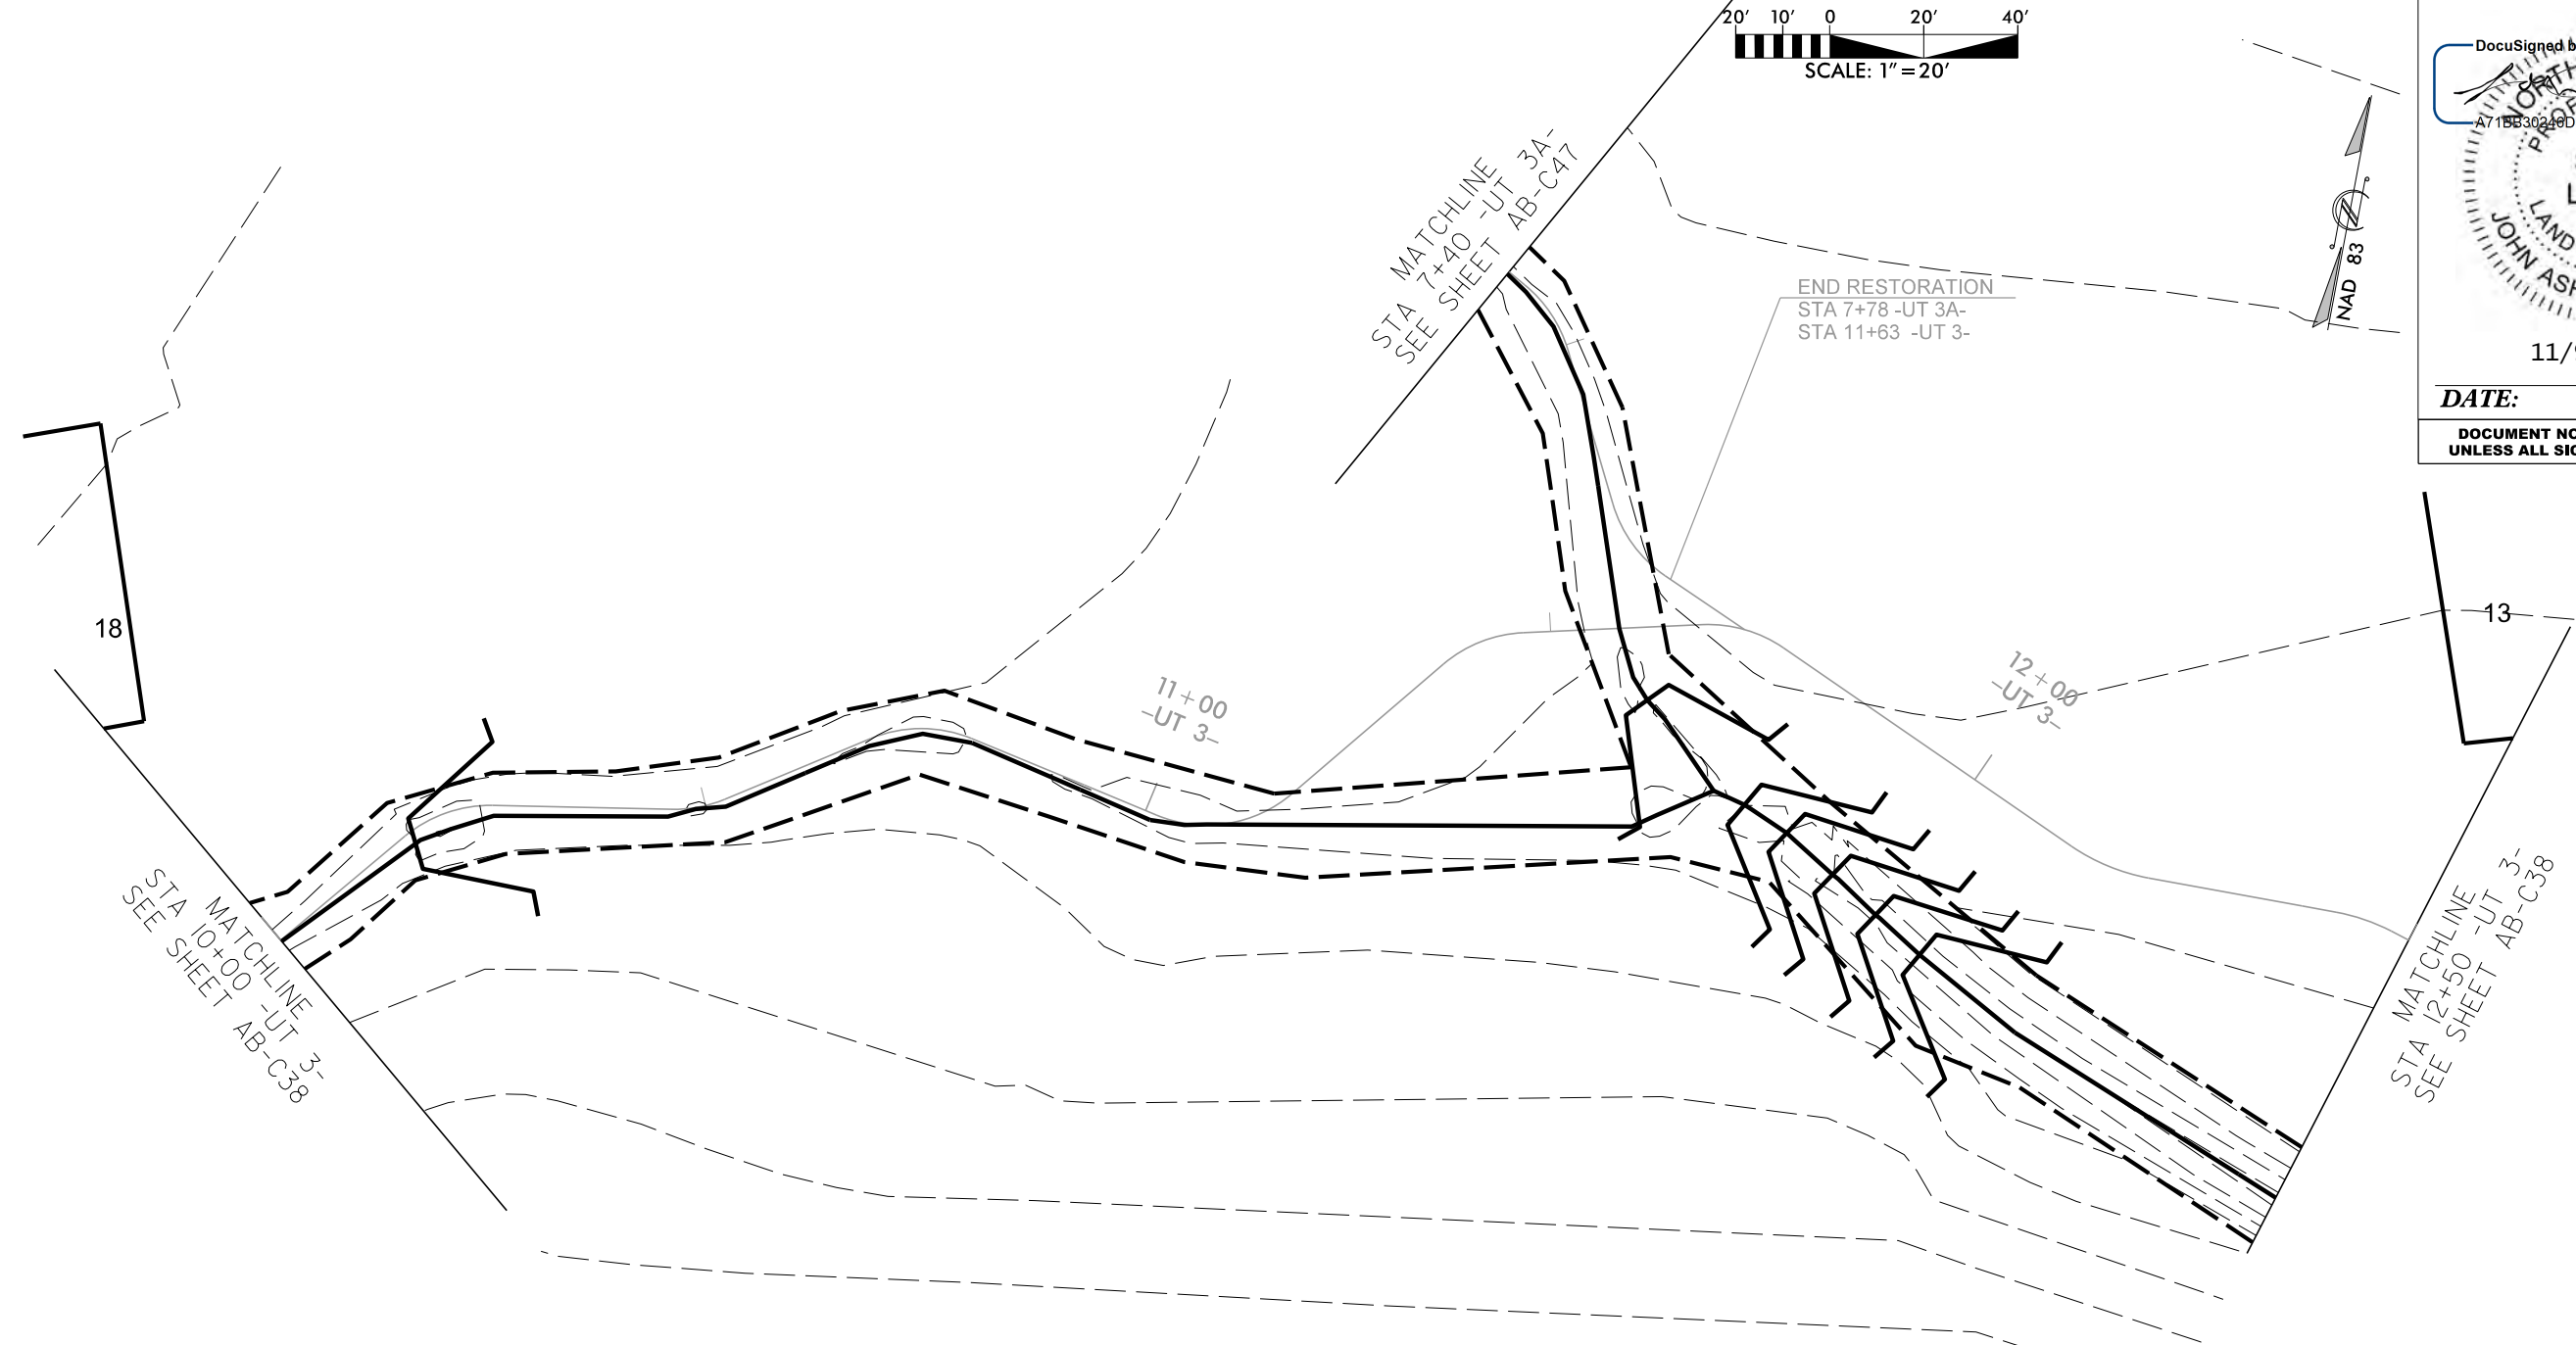


11/9/2022  
 Wits\_End\_Psh\_AB-C37.dgn  
 jrh

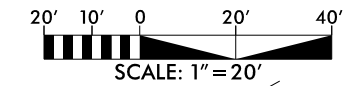

DocuSigned by:  
 218830246054EC...



DATE: 11/9/2022

**DOCUMENT NOT CONSIDERED FINAL  
 UNLESS ALL SIGNATURES COMPLETED**

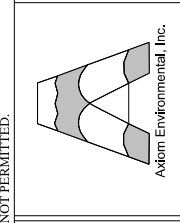



**WITS END**  
 UNION COUNTY, NC  
**AS-BUILT SURVEY**

PROJECT # :	1221-20024
DRAWING NAME:	WITS END PSH AB-C38
DATE:	2022
DRAWN BY:	JRH
REVIEWED BY:	JGD
REVISIONS:	
SHEET NO.	<b>AB-C38</b>

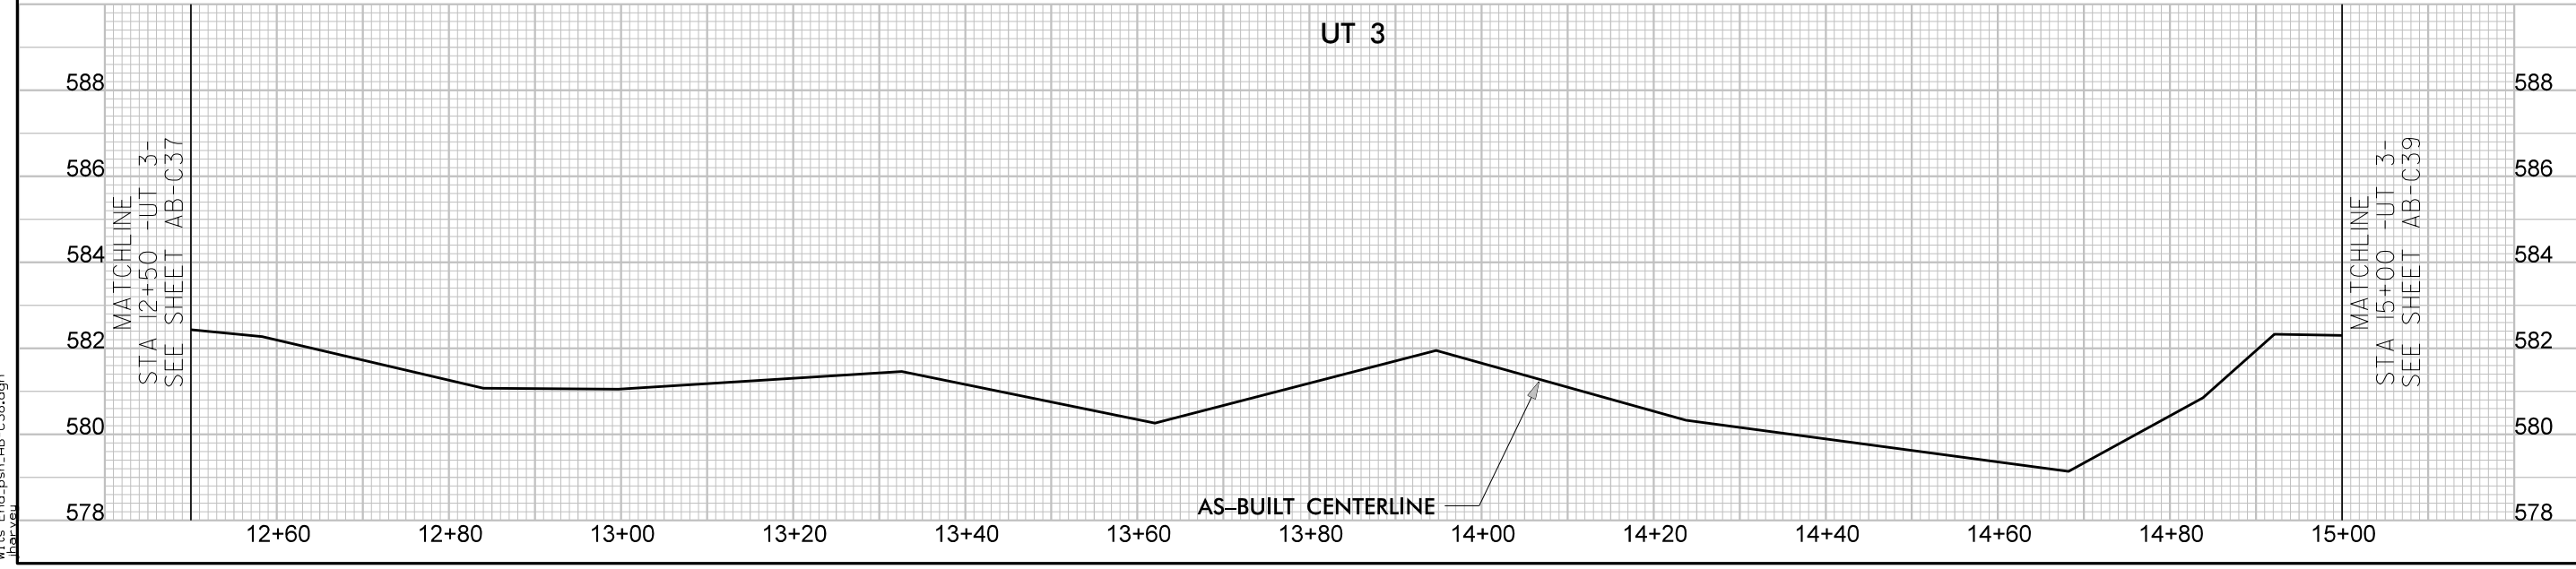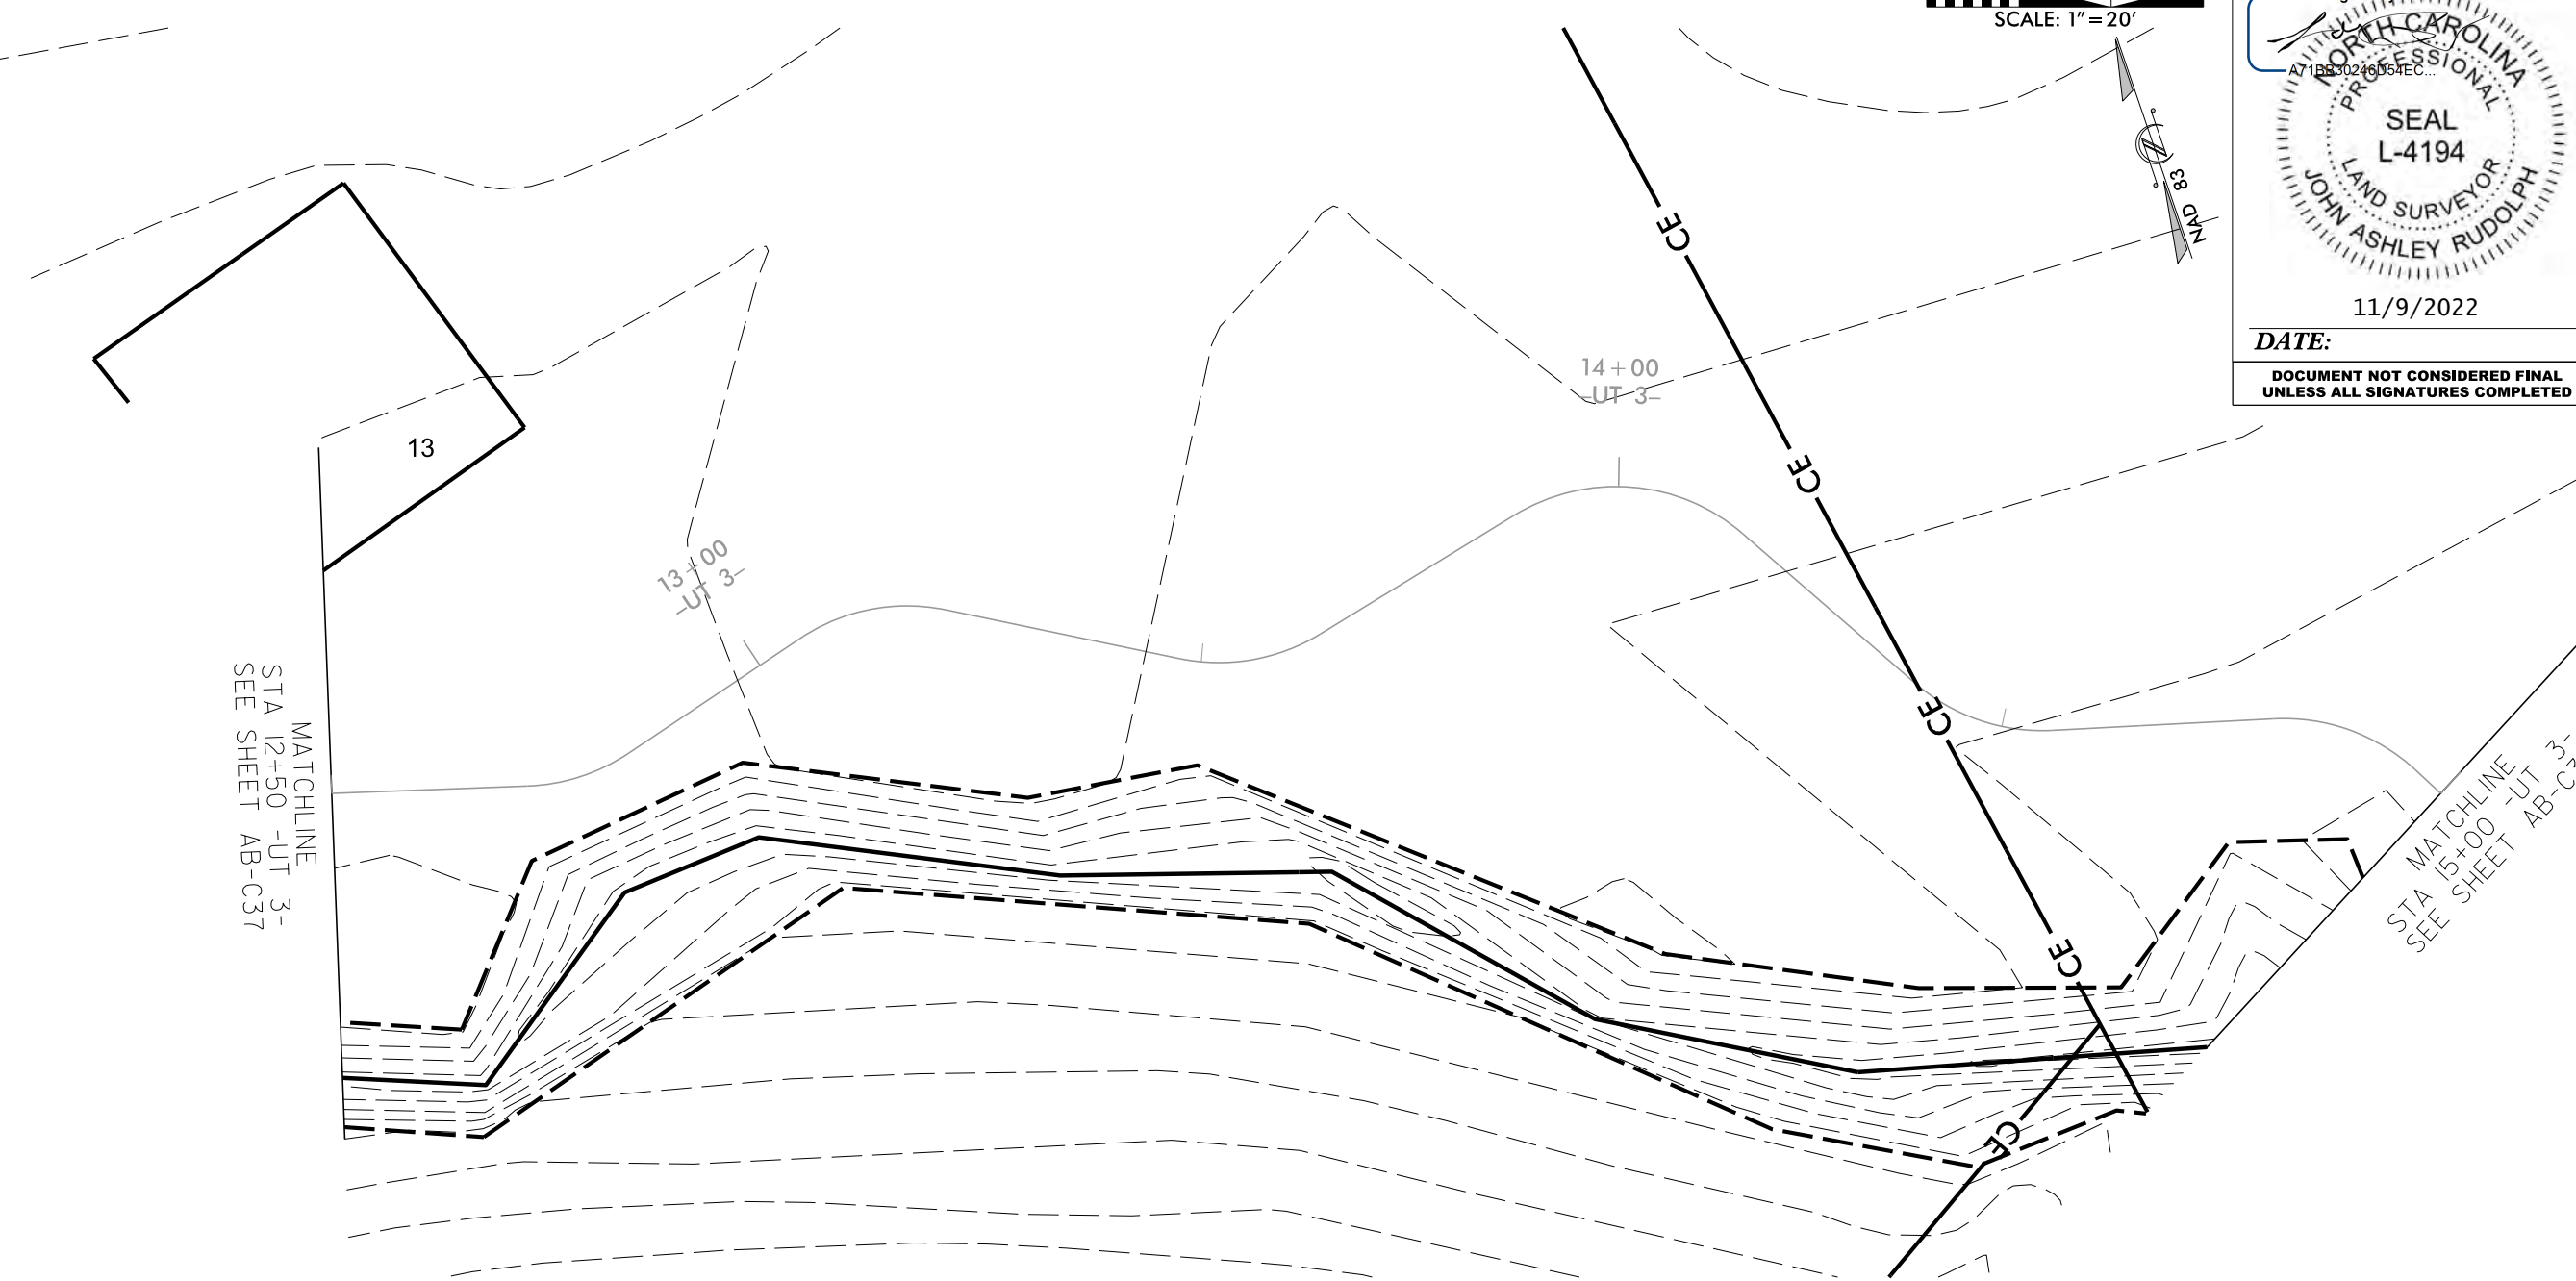




11/9/2022  
Wits\_End\_Psh\_AB-C38.dgn

© 2022 SUNGATE DESIGN GROUP, P.A. THIS DRAWING AND ALL REPRODUCTIONS OF IT ARE THE SOLE PROPERTY OF SDG. REPRODUCTION OR OTHER USES OF THIS DRAWING WITHOUT WRITTEN CONSENT OF SDG IS NOT PERMITTED.

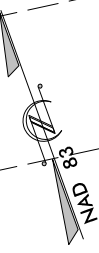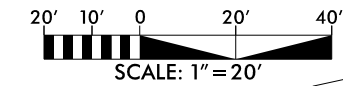


DocuSigned by:  
 718E30246D54EC...  
  
 SEAL  
 L-4194  
 JOHN ASHLEY RUDOLPH  
 11/9/2022

**DATE:**  
**DOCUMENT NOT CONSIDERED FINAL  
 UNLESS ALL SIGNATURES COMPLETED**

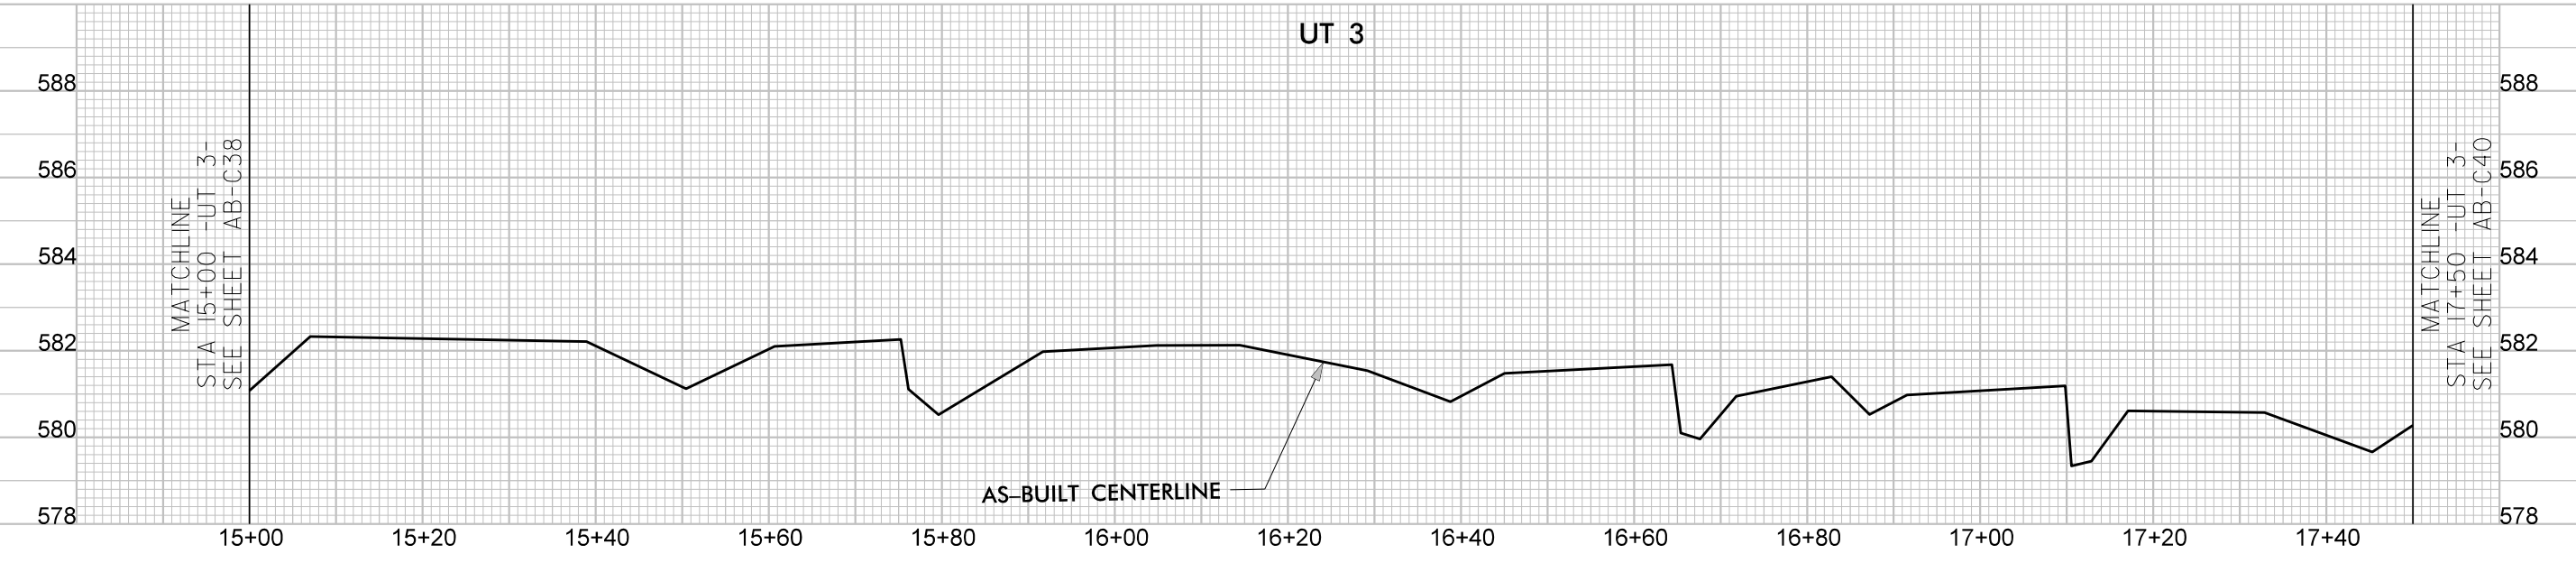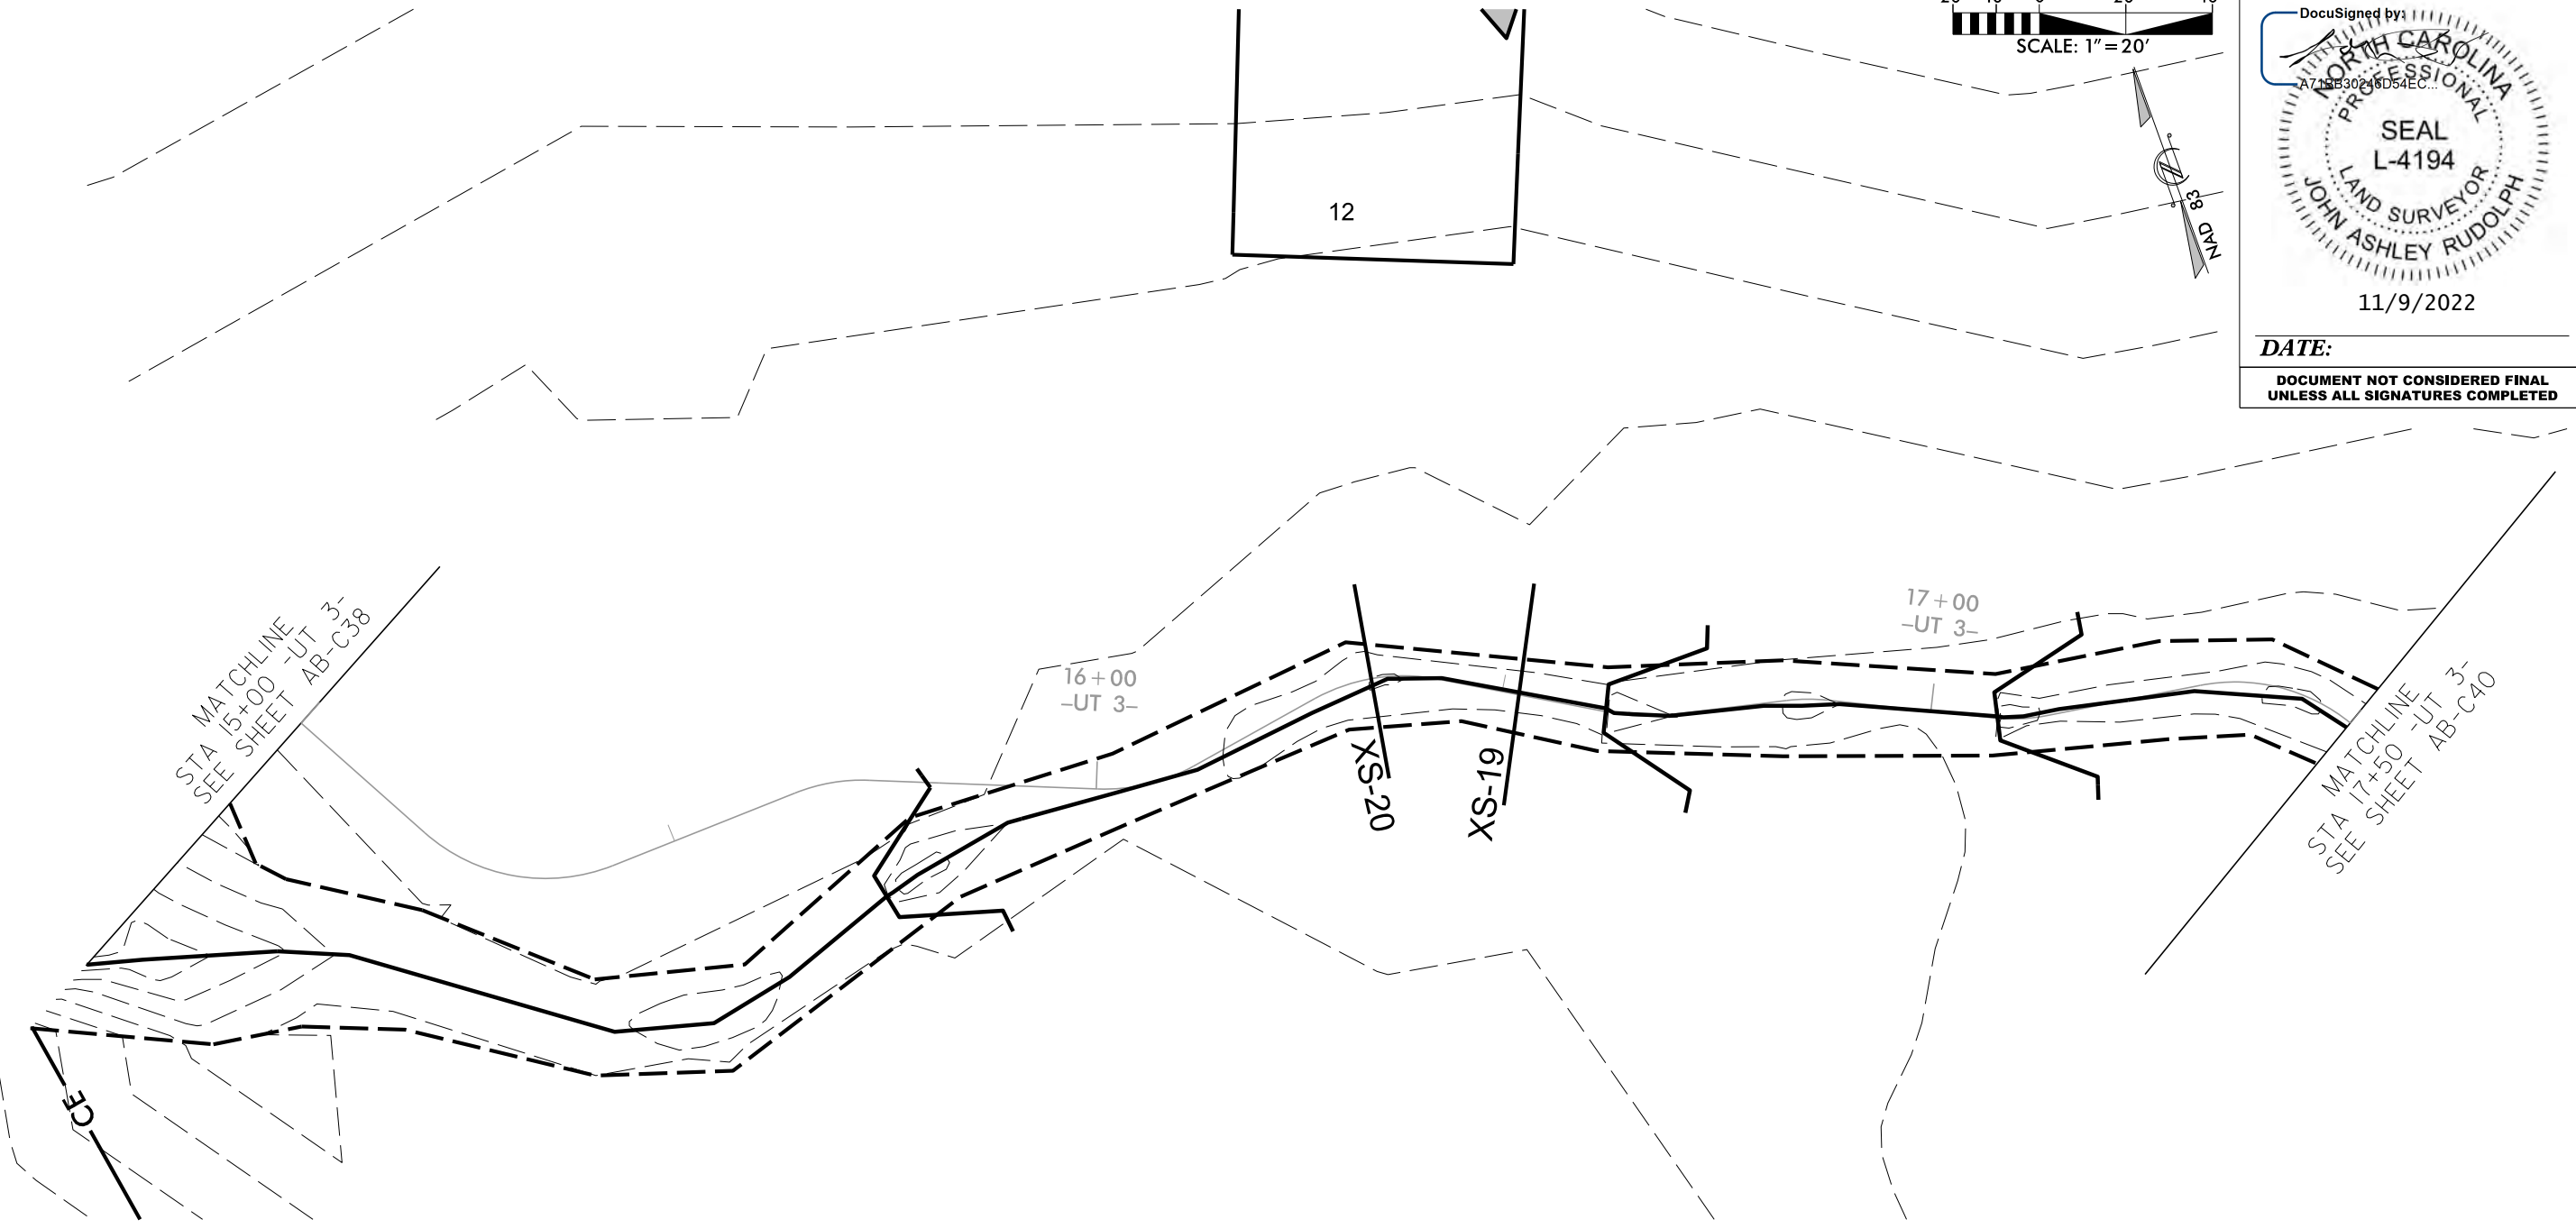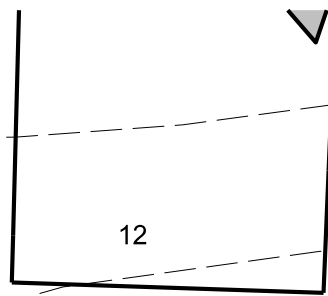

11/9/2022  
 Wits\_End\_psh\_AB-C39.dgn  
 jrd

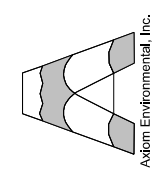




**WITS END**  
 UNION COUNTY, NC  
**AS-BUILT SURVEY**

PROJECT # :  
 1221-20024  
 DRAWING NAME:  
 WITS END PSH AB-C39  
 DATE:  
 2022  
 DRAWN BY:  
 JRH  
 REVIEWED BY:  
 JGD  
 REVISIONS:

SHEET NO.  
**AB-C39**


© 2022 SUNGATE DESIGN GROUP, P.A. THIS DRAWING AND ALL REPRODUCTIONS OF IT ARE THE SOLE PROPERTY OF SDG. REPRODUCTION OR OTHER USES OF THIS DRAWING WITHOUT WRITTEN CONSENT OF SDG IS NOT PERMITTED.



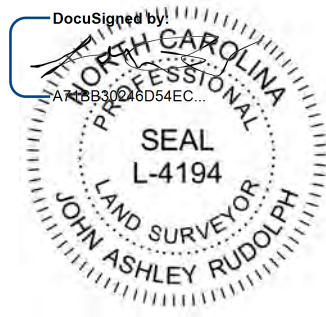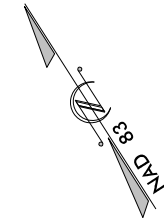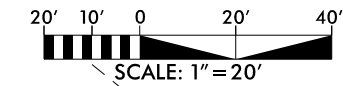

11/9/2022

DATE:  
DOCUMENT NOT CONSIDERED FINAL  
UNLESS ALL SIGNATURES COMPLETED

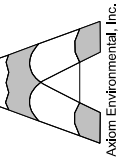

MATCHLINE  
STA 17+50 -UT 3-  
SEE SHEET AB-C39


SG

18+00  
-UT 3-

19+00  
-UT 3-

MATCHLINE  
STA 20+00 -UT 3-  
SEE SHEET AB-C41

UT 3

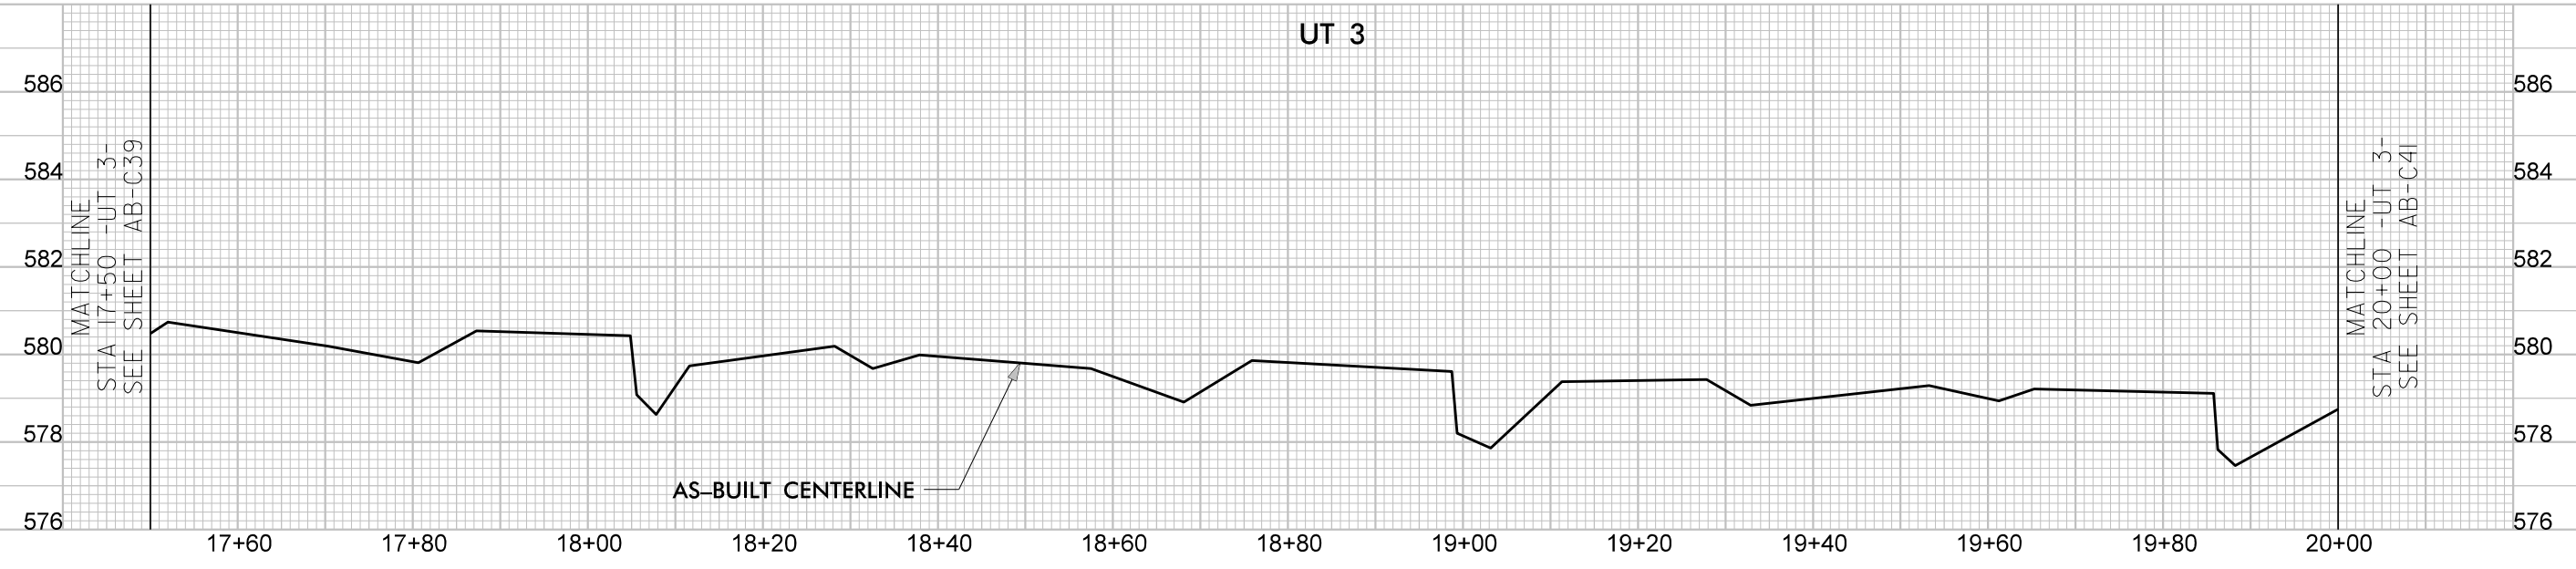



11/9/2022  
Wits\_End\_Psh\_AB-C40.dgn  
10:00 AM

© 2022 SUNGATE DESIGN GROUP, P.A. THIS DRAWING AND ALL REPRODUCTIONS OF IT ARE THE SOLE PROPERTY OF SDG. REPRODUCTION OR OTHER USES OF THIS DRAWING WITHOUT WRITTEN CONSENT OF SDG IS NOT PERMITTED.

WITS END  
UNION COUNTY, NC  
AS-BUILT SURVEY


PROJECT # :  
1221-20024  
DRAWING NAME:  
WITS END PSH AB-C40  
DATE:  
2022  
DRAWN BY:  
JRH  
REVIEWED BY:  
JGD  
REVISIONS:

SHEET NO.  
**AB-C40**

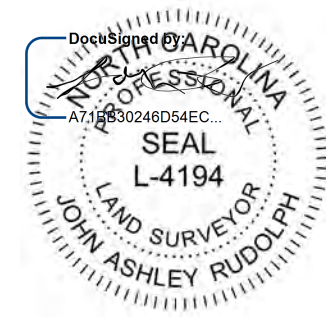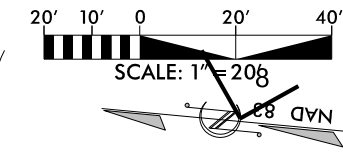

11/9/2022

**DATE:**  
**DOCUMENT NOT CONSIDERED FINAL UNLESS ALL SIGNATURES COMPLETED**


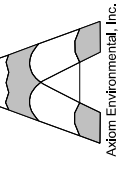


© 2022 SUNGATE DESIGN GROUP, P.A. THIS DRAWING AND ALL REPRODUCTIONS OF IT ARE THE SOLE PROPERTY OF SDG. REPRODUCTION OR OTHER USES OF THIS DRAWING WITHOUT WRITTEN CONSENT OF SDG IS NOT PERMITTED.


**WITS END**  
**UNION COUNTY, NC**  
**AS-BUILT SURVEY**

PROJECT # : 1221-20024  
DRAWING NAME: WITS END PSH AB-C41  
DATE: 2022  
DRAWN BY: JRH  
REVIEWED BY: JGD  
REVISIONS:

SHEET NO.  
**AB-C41**

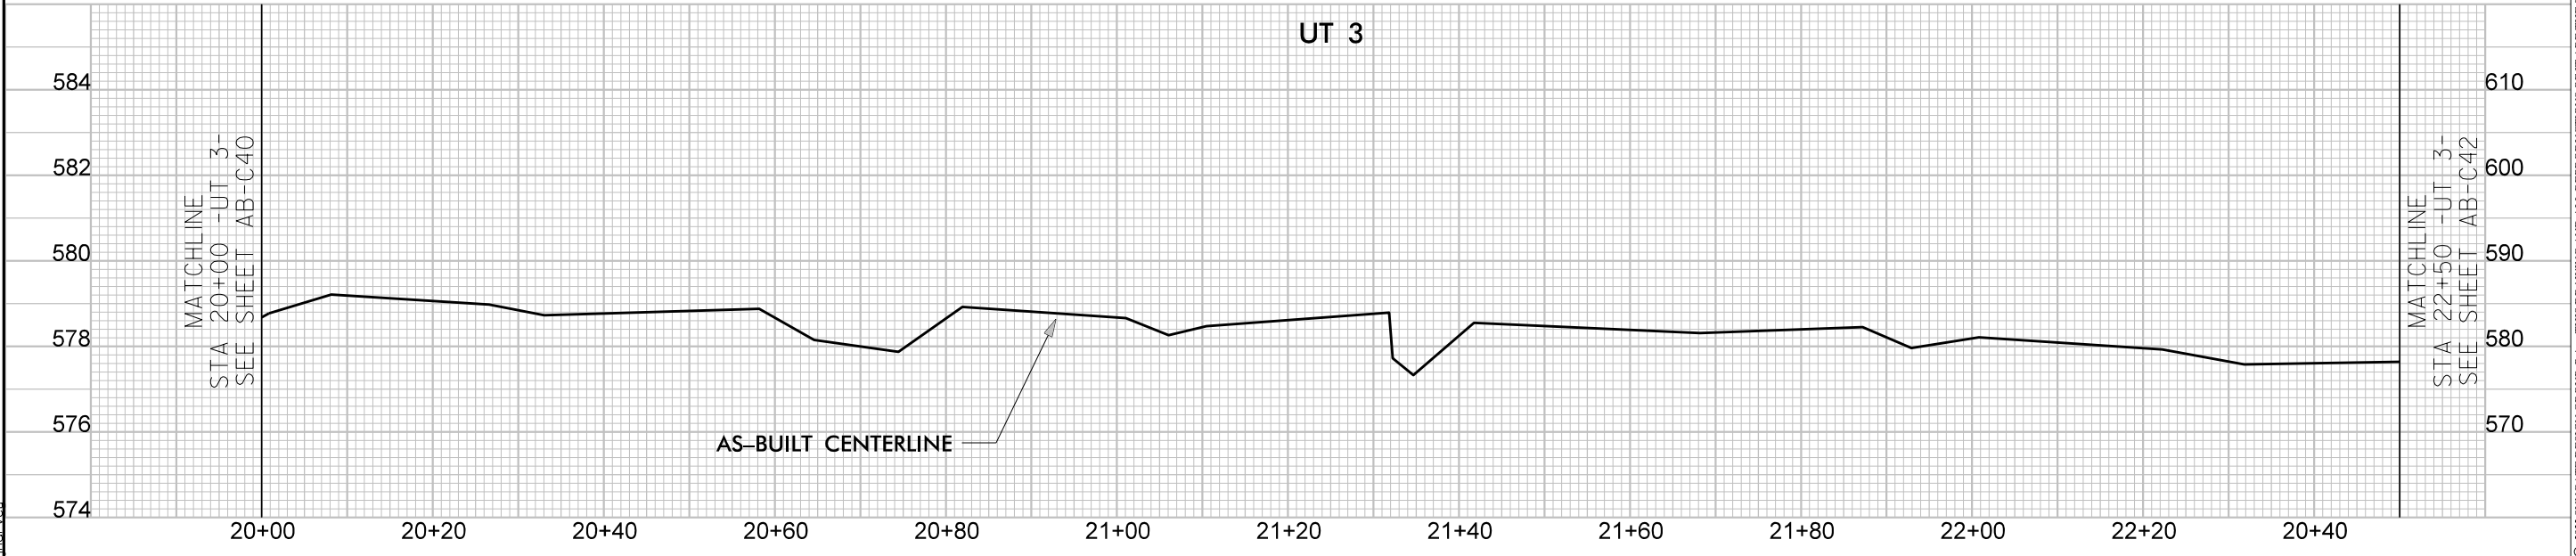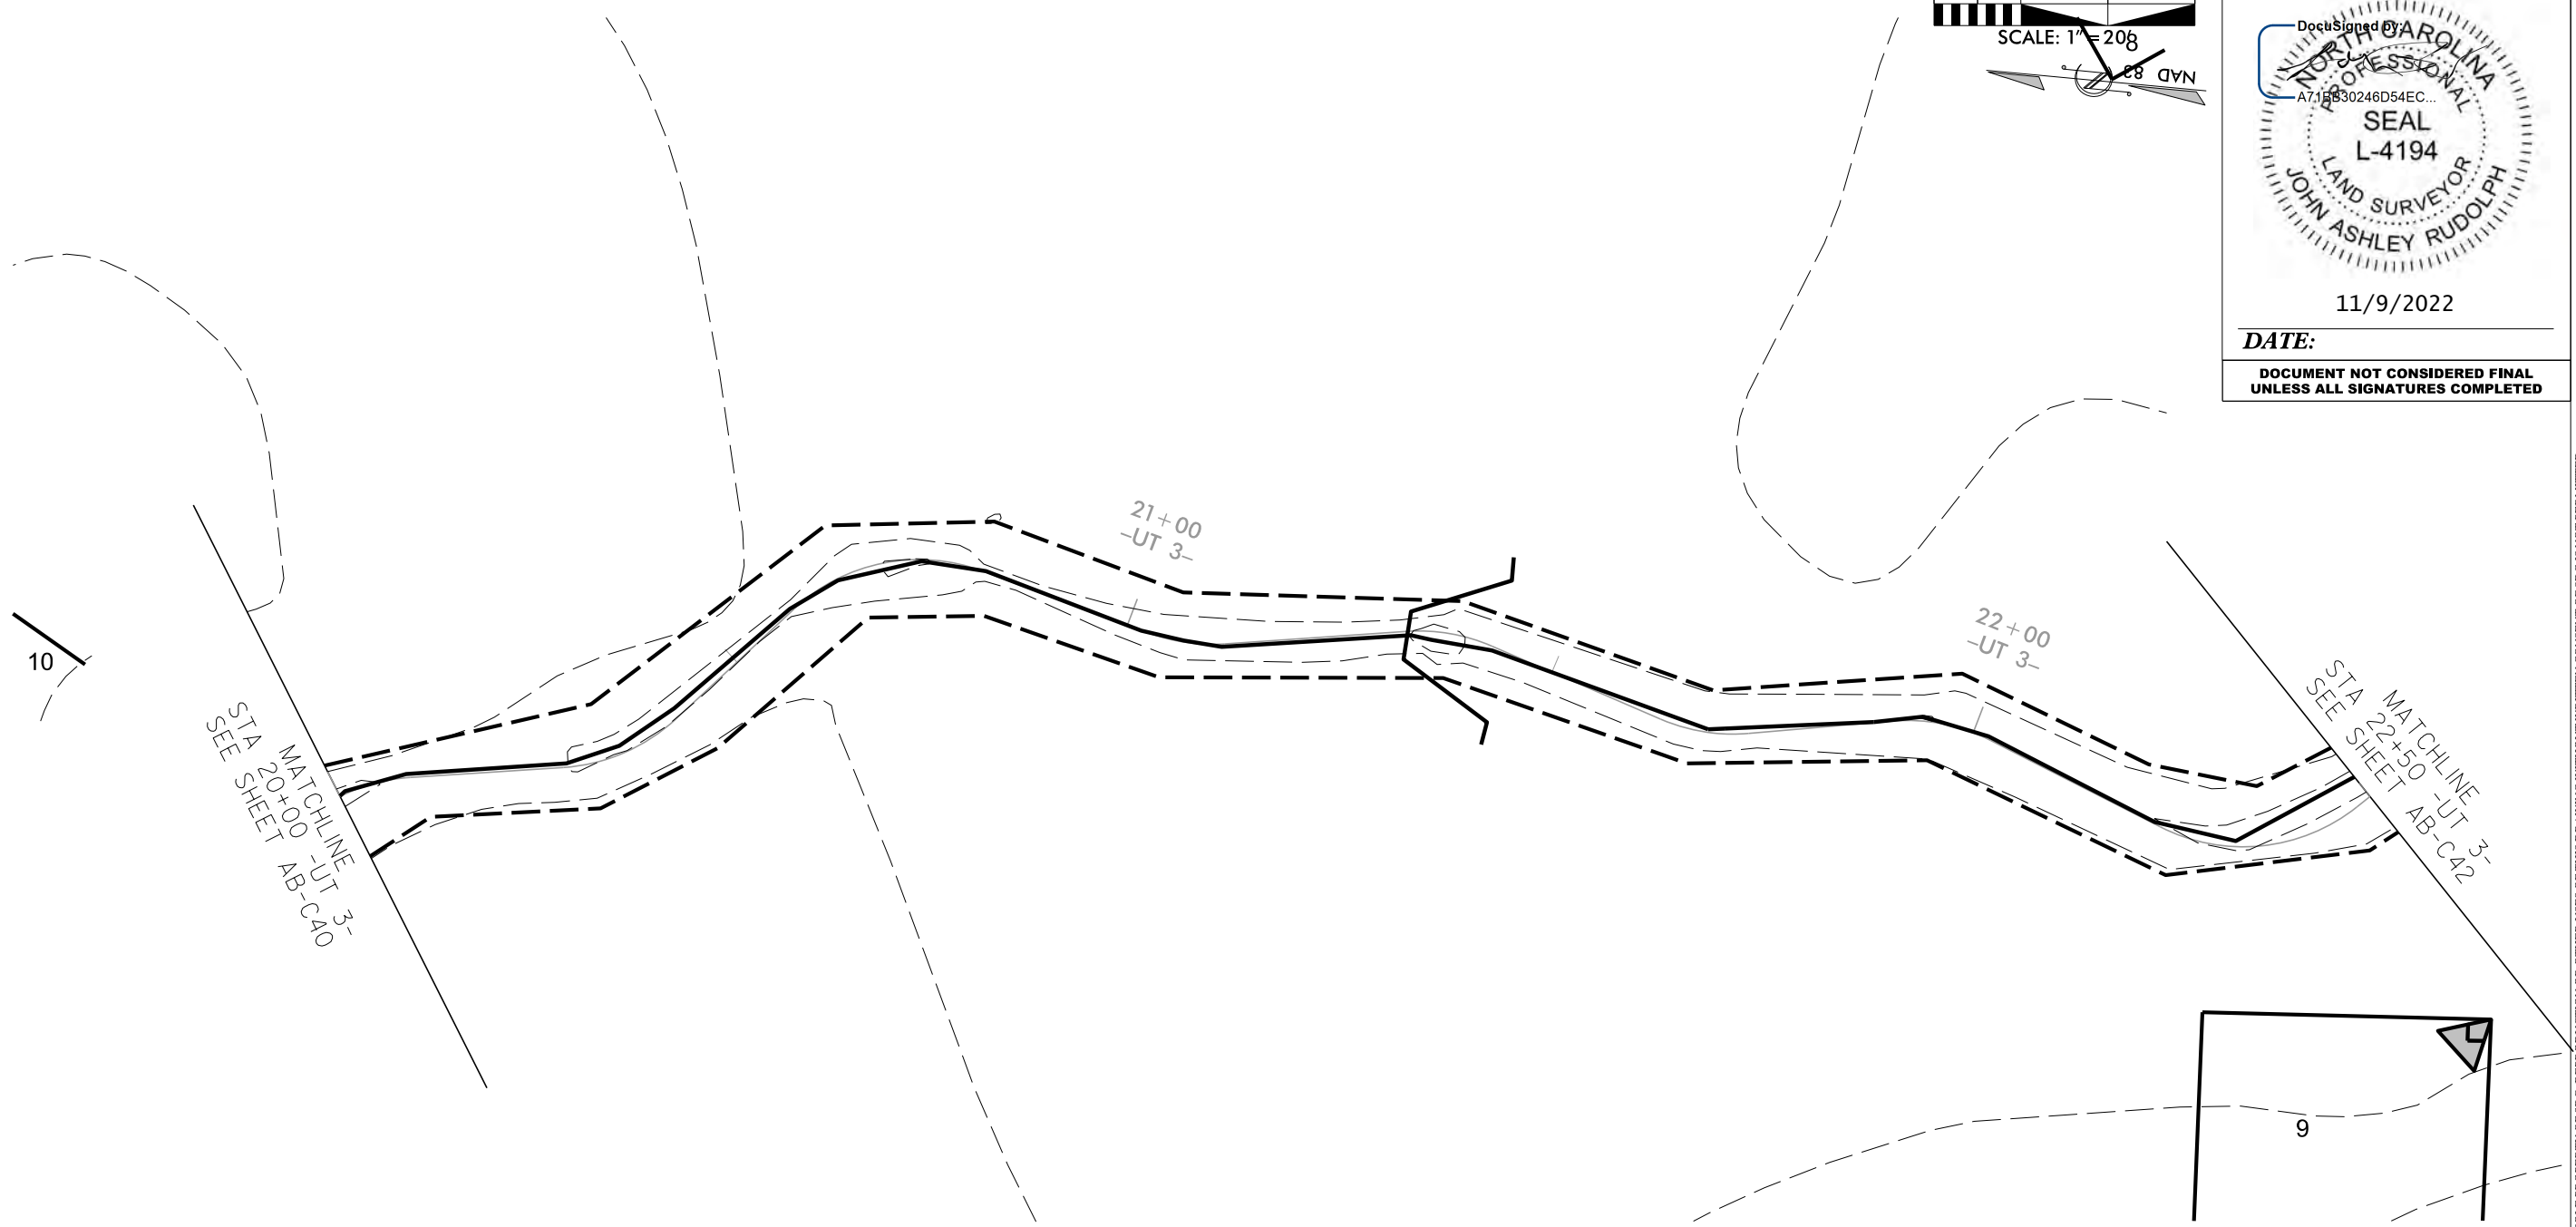

11/9/2022  
Wits\_End\_Psh\_AB-C41.dgn  
jrh

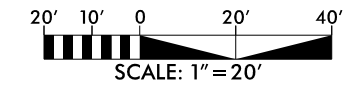



DocuSigned by:  
A71B830241D054EC...

11/9/2022


**DATE:**

**DOCUMENT NOT CONSIDERED FINAL  
UNLESS ALL SIGNATURES COMPLETED**

MW-8

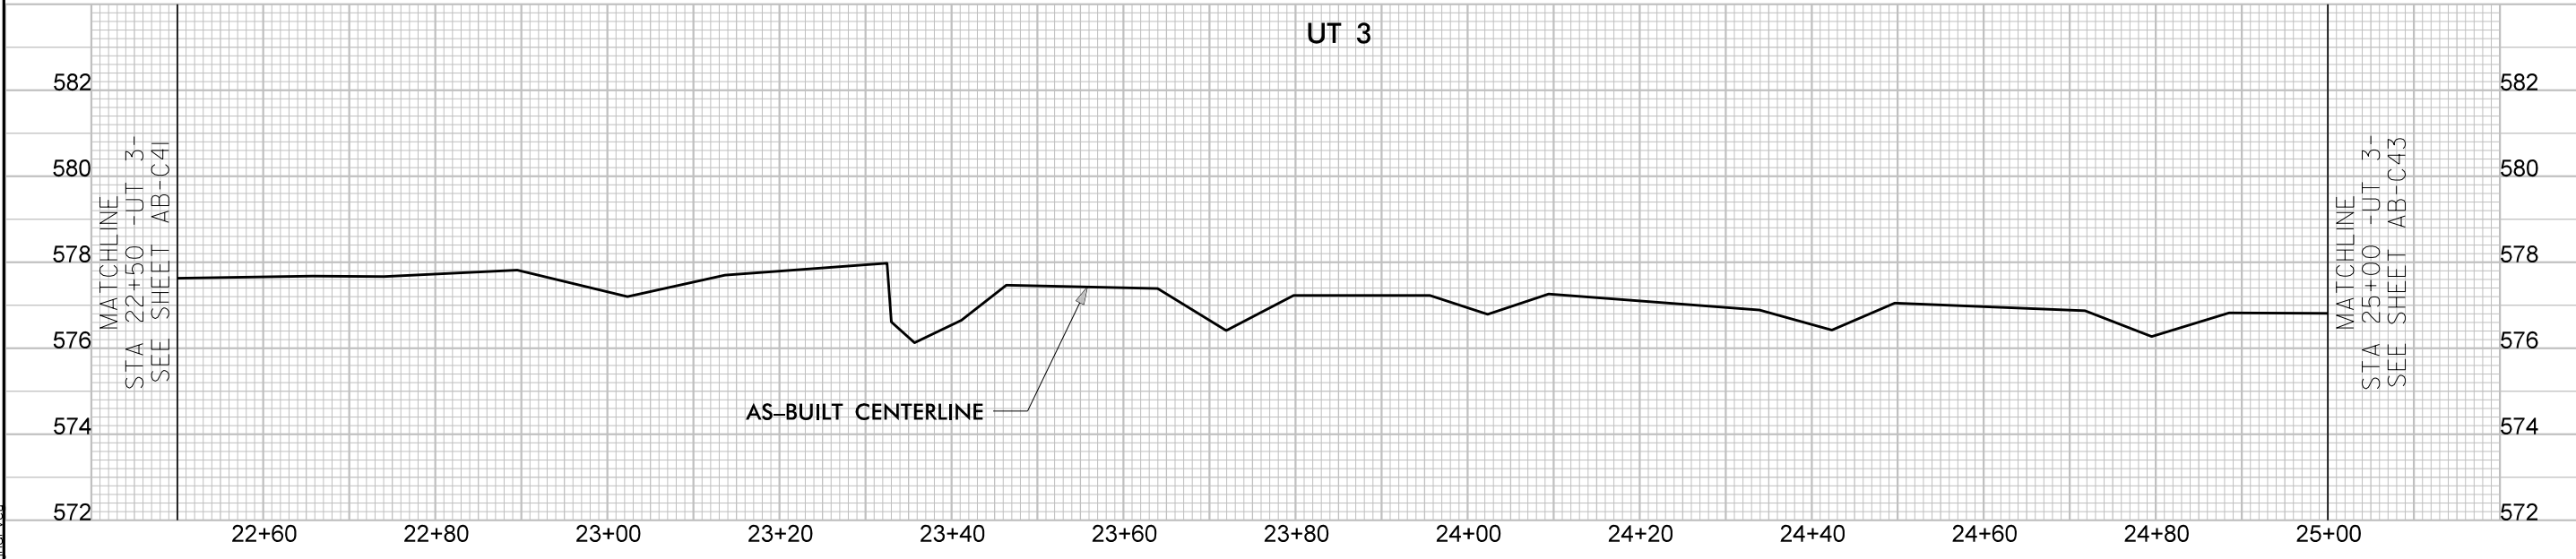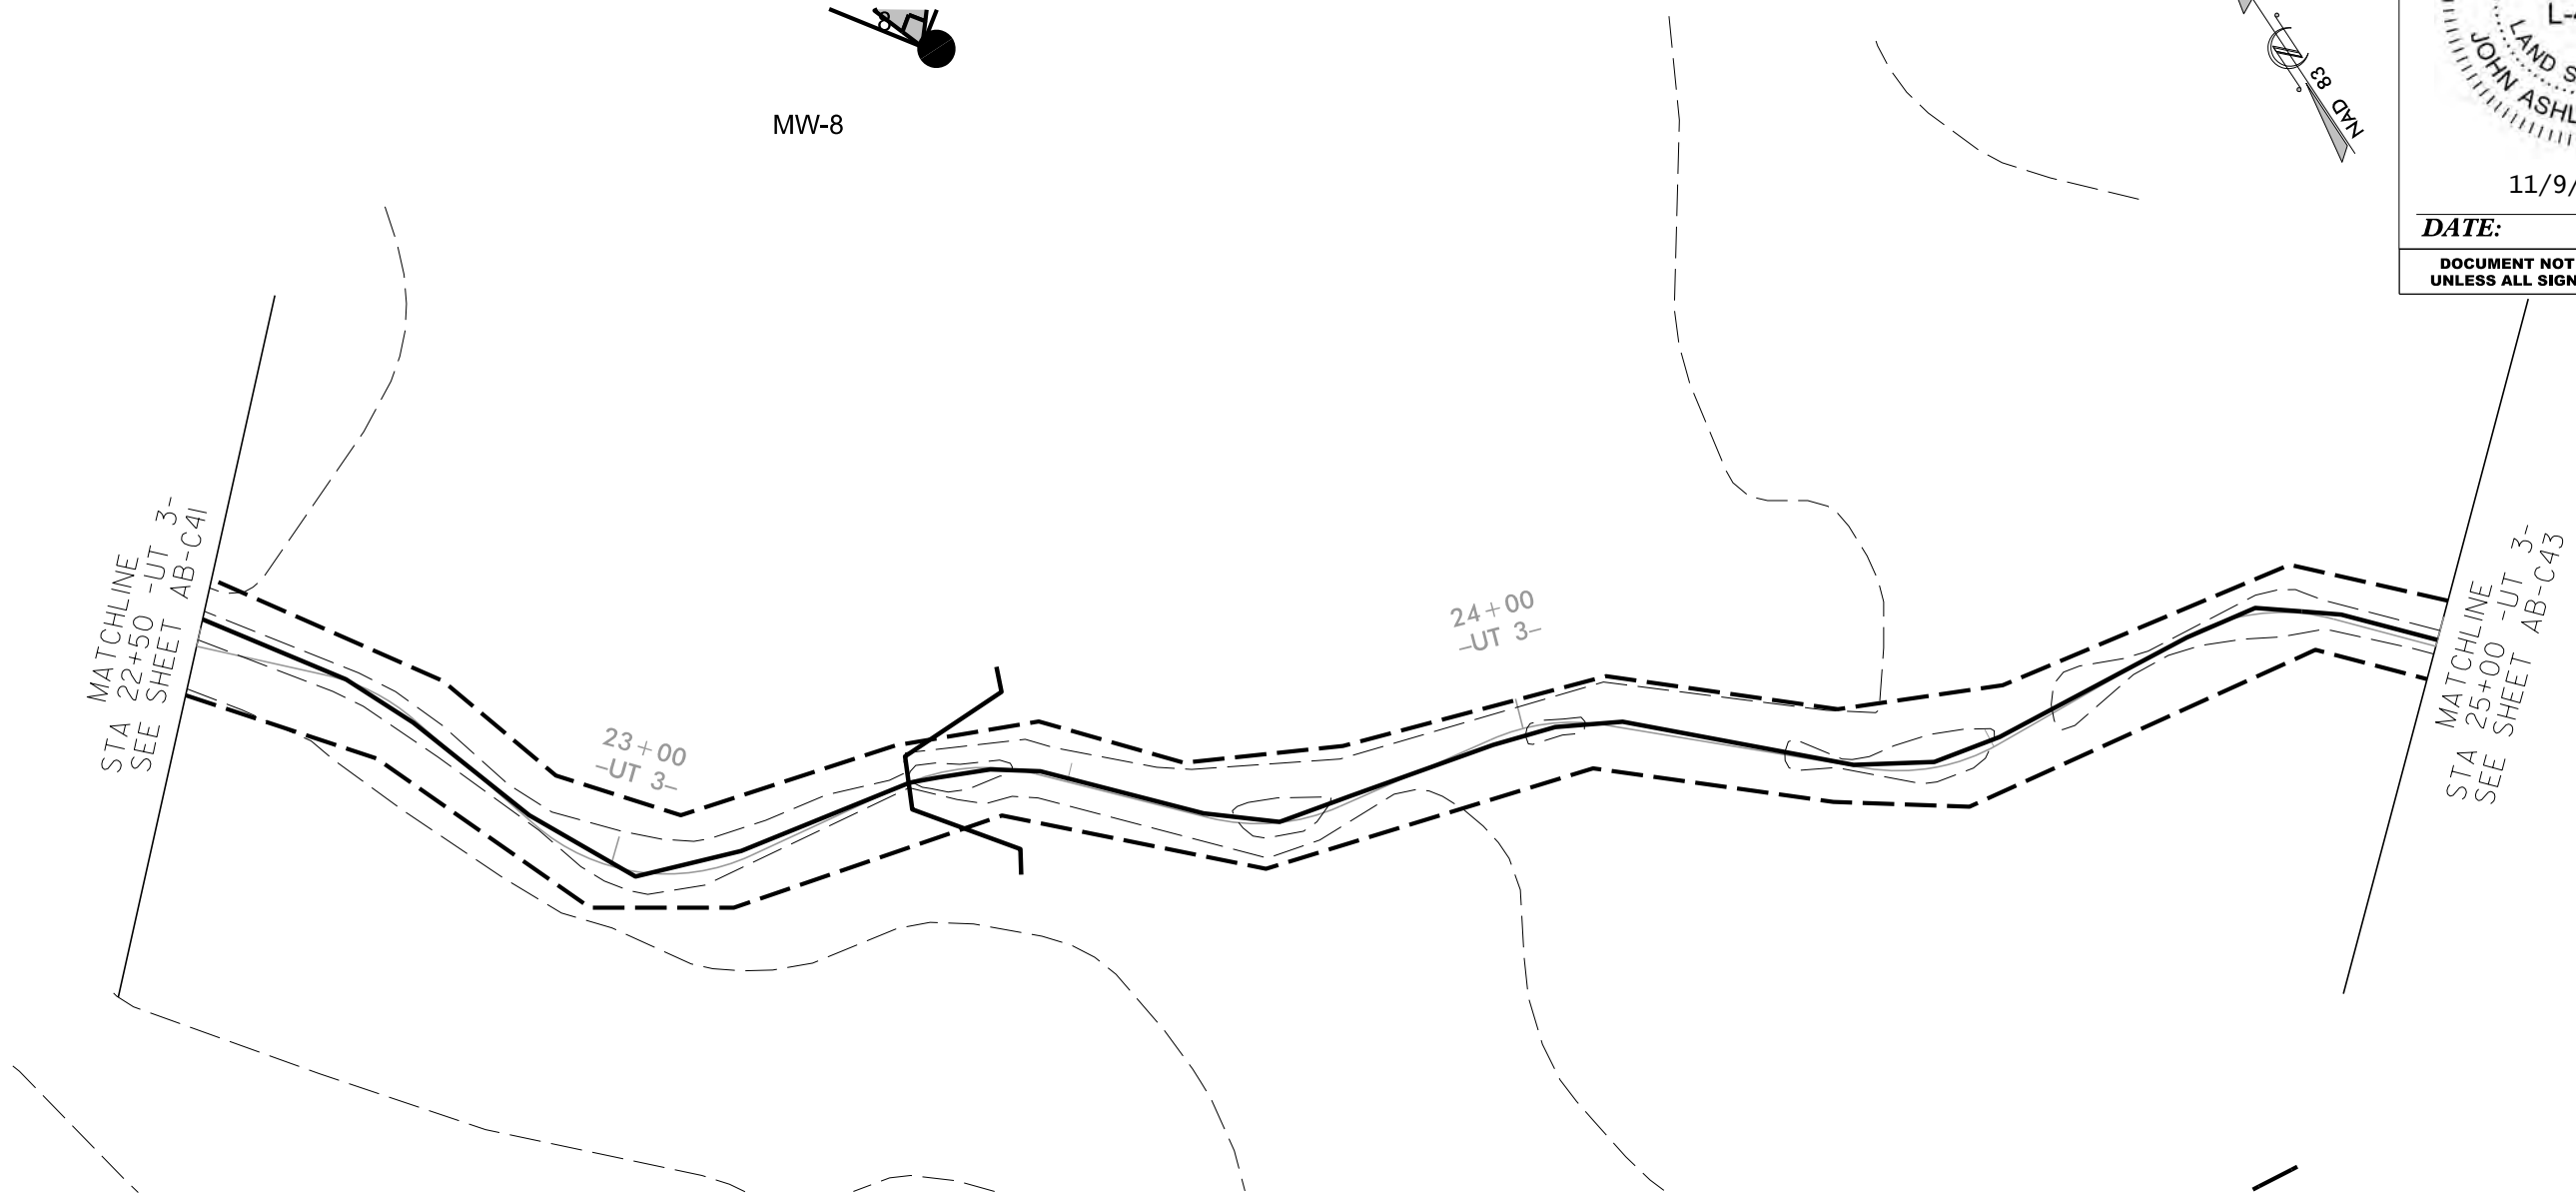

11/9/2022  
Wits\_End\_Psh\_AB-C42.dgn

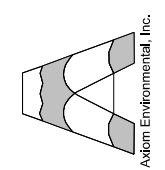

**WITS END**  
UNION COUNTY, NC

**AS-BUILT SURVEY**

PROJECT # :  
1221-20024

DRAWING NAME:  
WITS END PSH AB-C42

DATE:  
2023

DRAWN BY:  
JRH




REVIEWED BY:  
JGD

REVISIONS:

SHEET NO.  
**AB-C42**



© 2022 SUNGATE DESIGN GROUP, P.A. THIS DRAWING AND ALL REPRODUCTIONS OF IT ARE THE SOLE PROPERTY OF SDG. REPRODUCTION OR OTHER USES OF THIS DRAWING WITHOUT WRITTEN CONSENT OF SDG IS NOT PERMITTED.



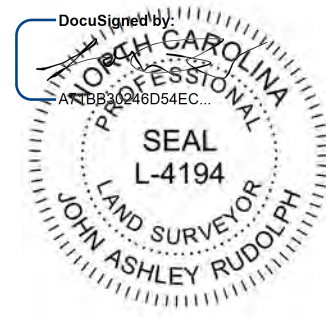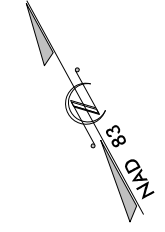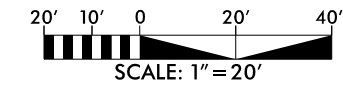


11/9/2022

DATE:  
DOCUMENT NOT CONSIDERED FINAL  
UNLESS ALL SIGNATURES COMPLETED

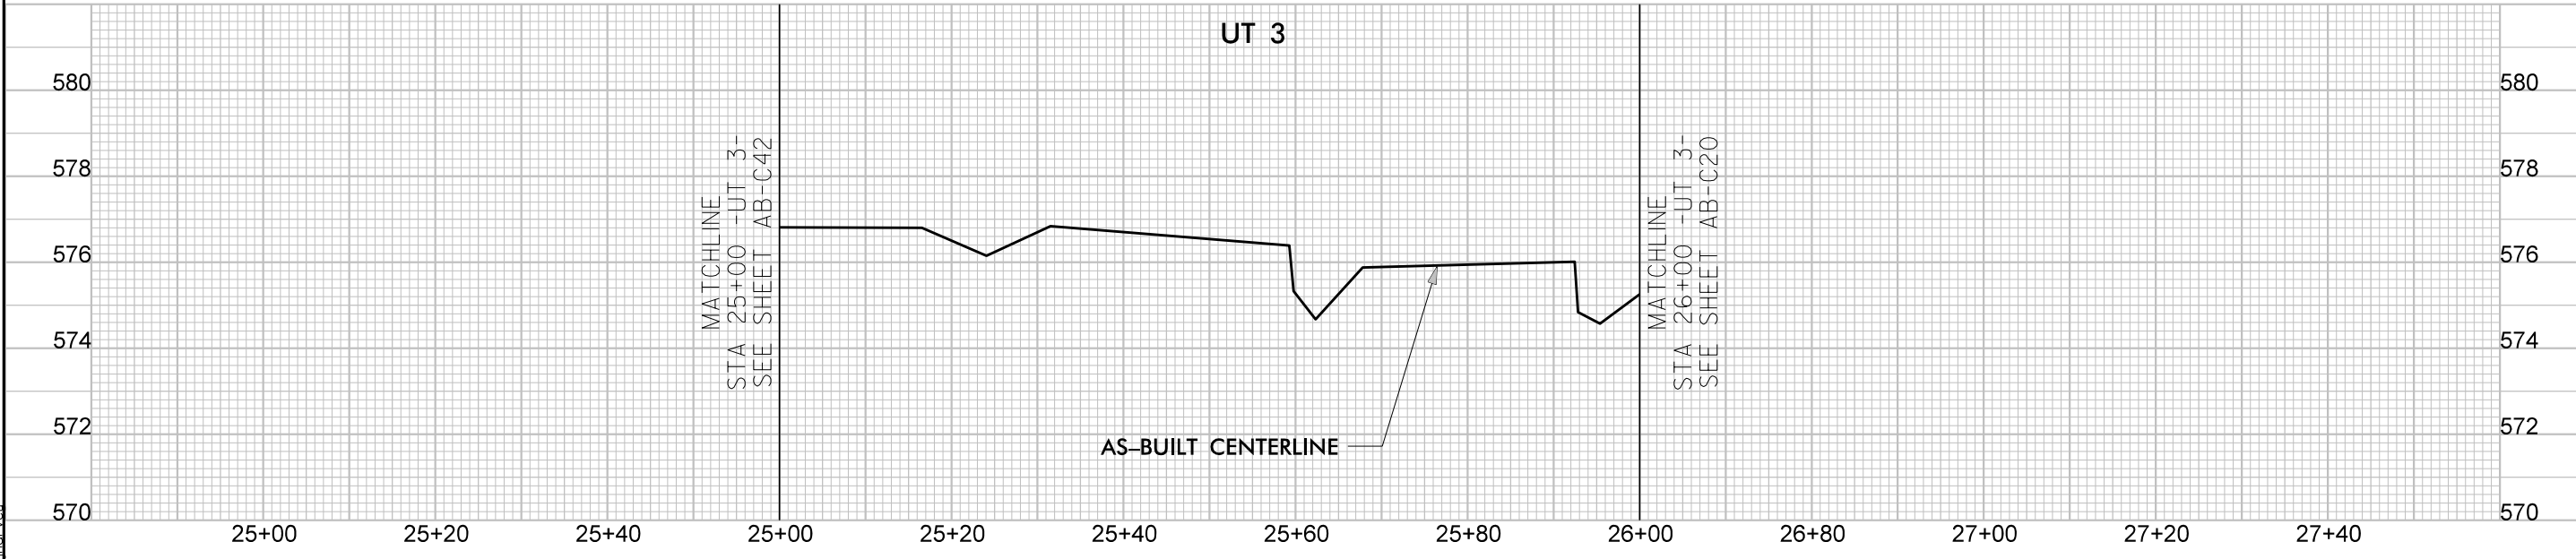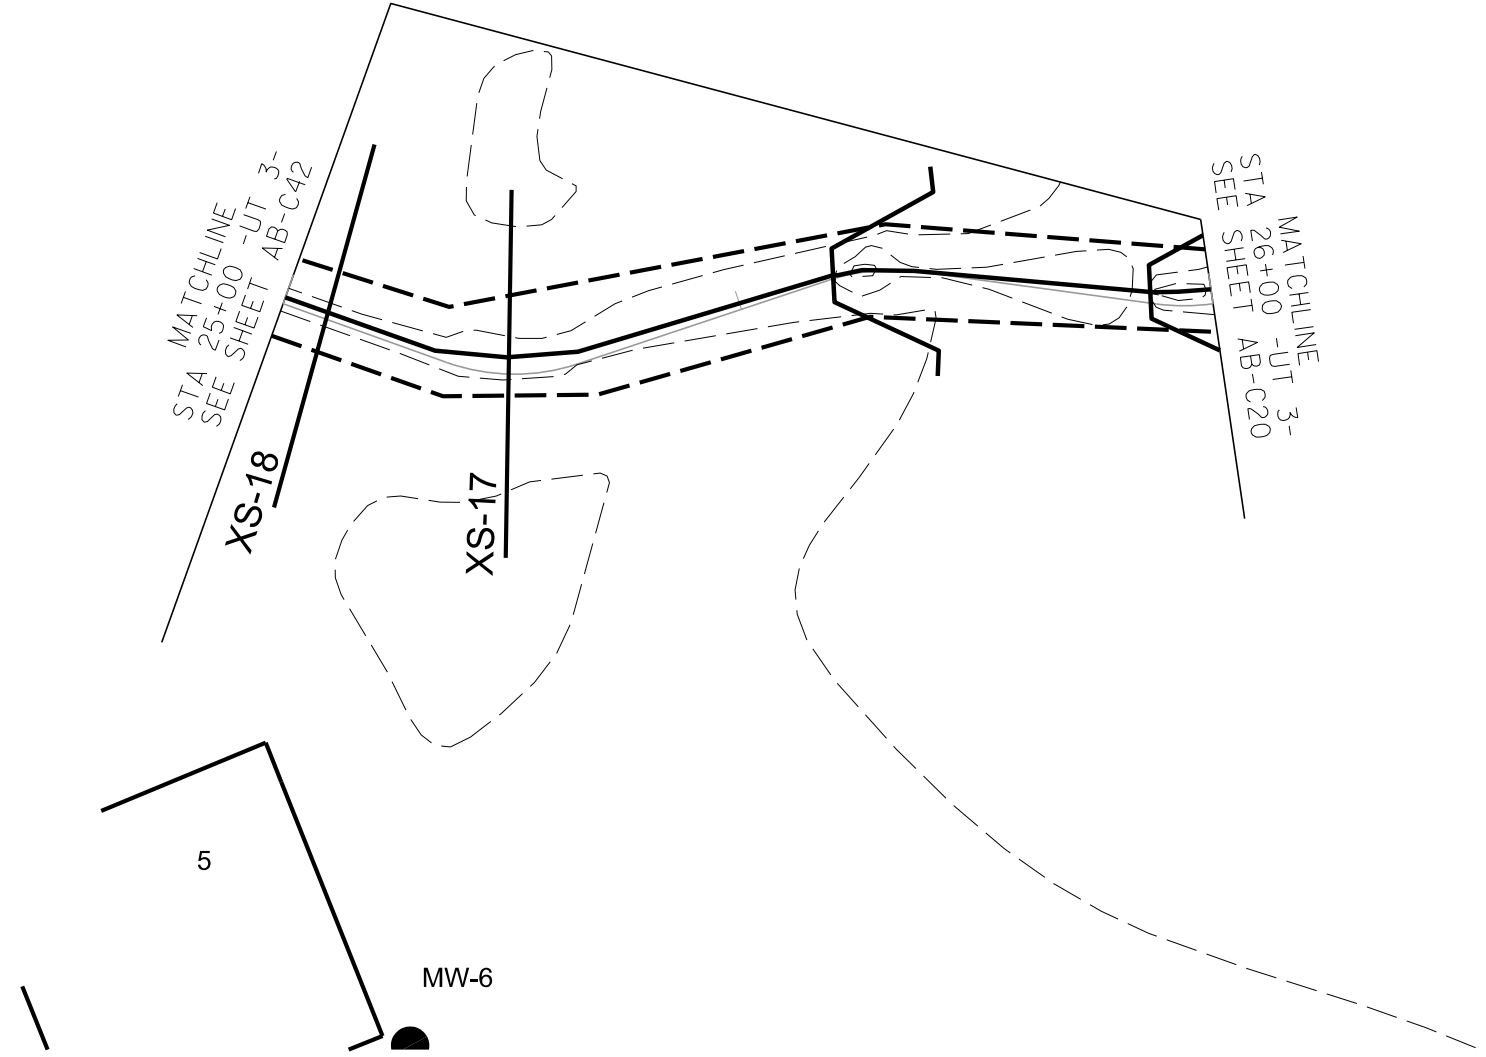

11/9/2022  
Wits\_End\_Psh\_AB-C43.dgn  
jrd



© 2022 SUNGATE DESIGN GROUP, P.A. THIS DRAWING AND ALL REPRODUCTIONS OF IT ARE THE SOLE PROPERTY OF SDG. REPRODUCTION OR OTHER USES OF THIS DRAWING WITHOUT WRITTEN CONSENT OF SDG IS NOT PERMITTED.

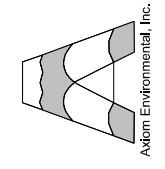

WITS END  
UNION COUNTY, NC  
AS-BUILT SURVEY



PROJECT # :  
1221-20024  
DRAWING NAME:  
WITS END PSH AB-C43  
DATE:  
2022  
DRAWN BY:  
JRH  
REVIEWED BY:  
JGD  
REVISIONS:

SHEET NO.  
**AB-C43**

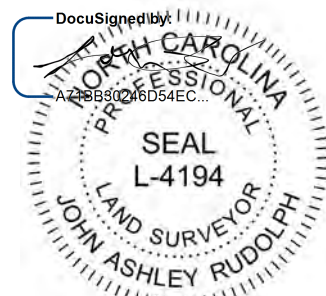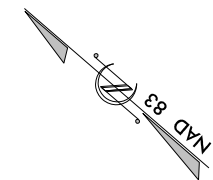

11/9/2022

DATE:  
DOCUMENT NOT CONSIDERED FINAL  
UNLESS ALL SIGNATURES COMPLETED

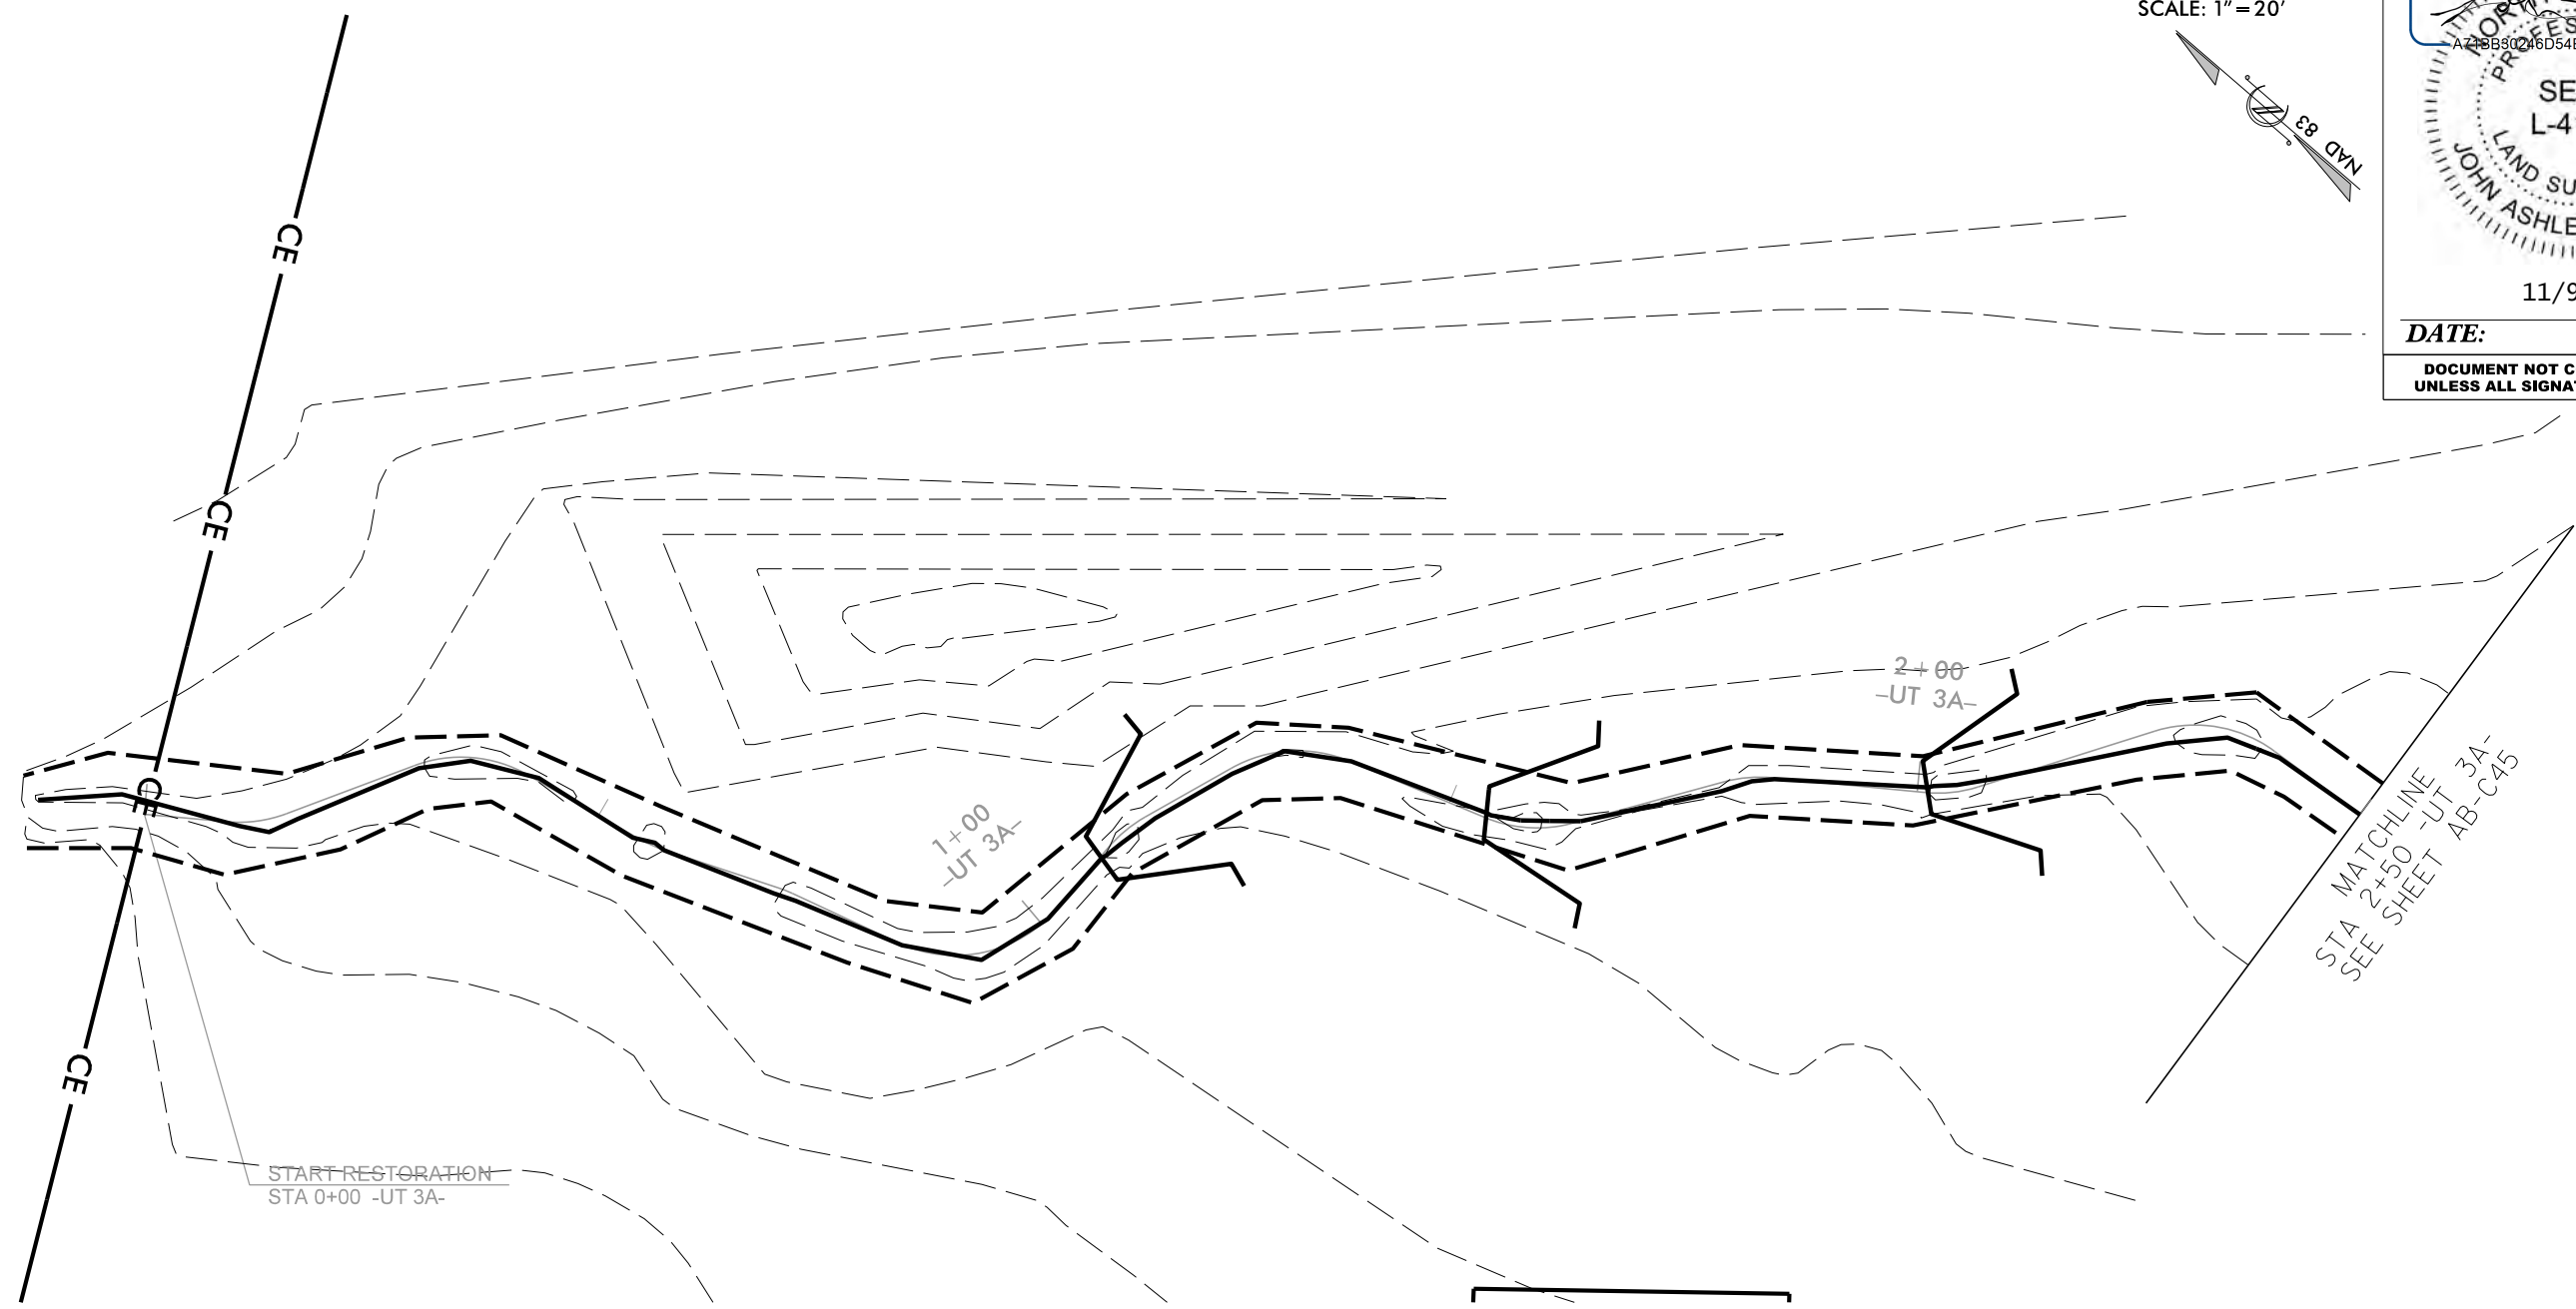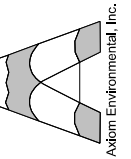

START RESTORATION  
STA 0+00 -UT 3A-


1+00  
-UT 3A-

2+00  
-UT 3A-

STA MATCHLINE  
STA 2+50 -UT 3A-  
SEE SHEET AB-C45

UT 3A

AS-BUILT CENTERLINE

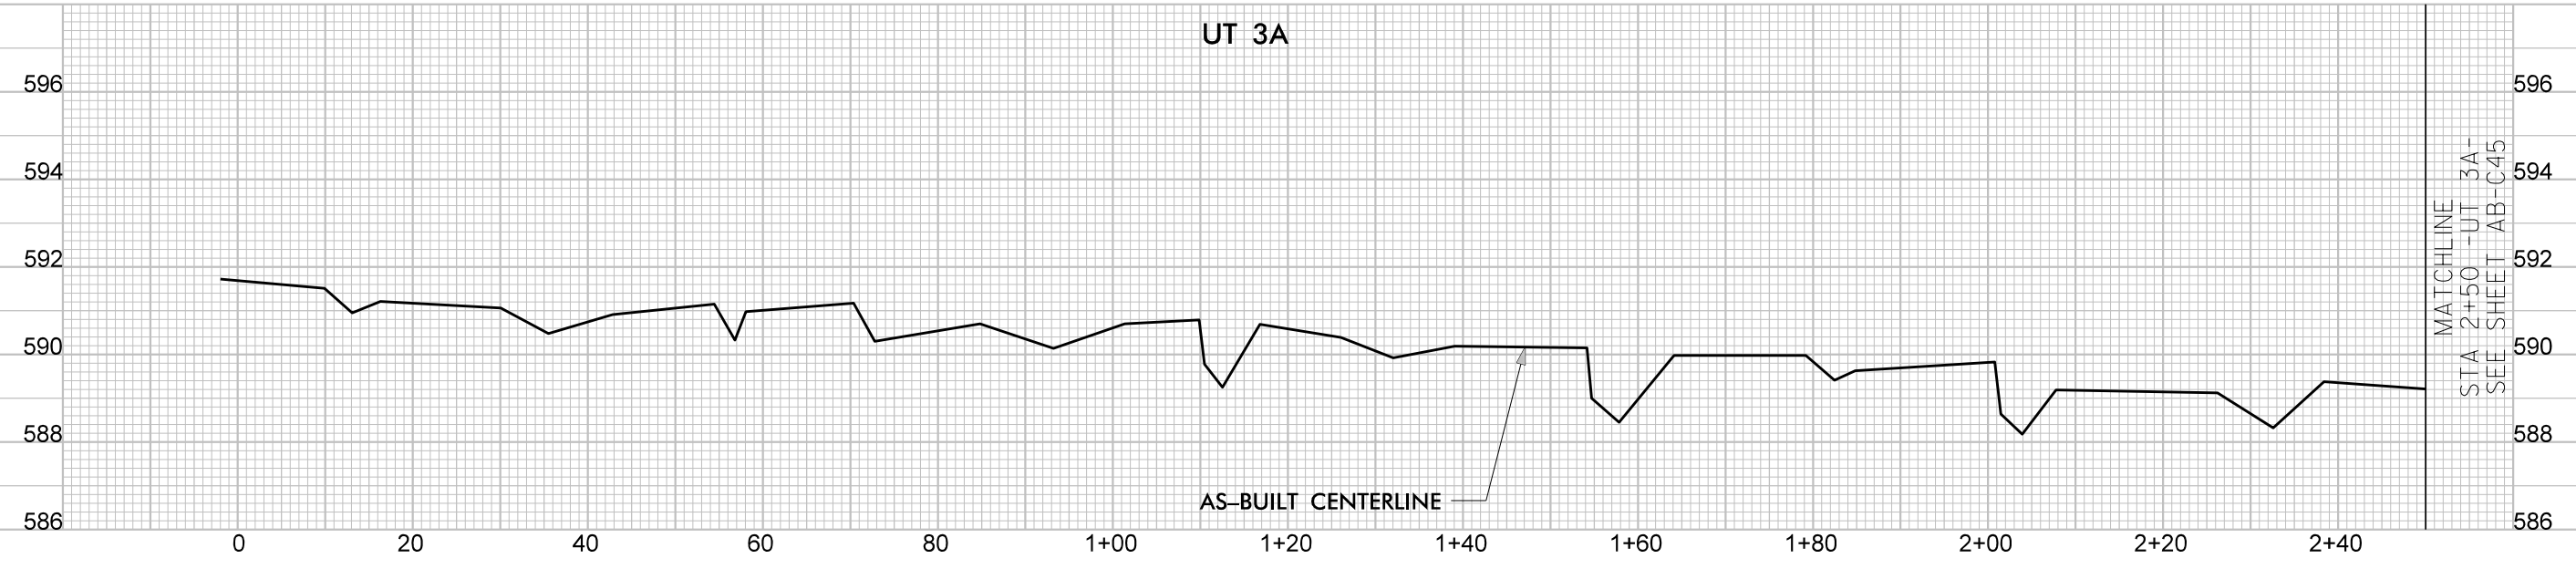

MATCHLINE  
STA 2+50 -UT 3A-  
SEE SHEET AB-C45




WITS END  
UNION COUNTY, NC  
AS-BUILT SURVEY

PROJECT # :  
1221-20024  
DRAWING NAME:  
WITS END PSH AB-C44  
DATE:  
2022  
DRAWN BY:  
JRH  
REVIEWED BY:  
JGD  
REVISIONS:




SHEET NO.  
**AB-C44**

11/9/2022  
Wits\_End\_Psh\_AB-C44.dgn  
10:00 AM

© 2022 SUNGATE DESIGN GROUP, P.A. THIS DRAWING AND ALL REPRODUCTIONS OF IT ARE THE SOLE PROPERTY OF SDG. REPRODUCTION OR OTHER USES OF THIS DRAWING WITHOUT WRITTEN CONSENT OF SDG IS NOT PERMITTED.

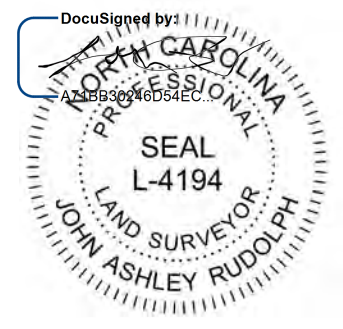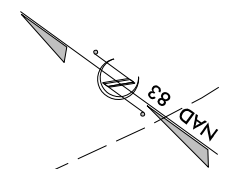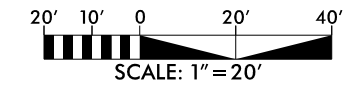

DATE: 11/9/2022  
DOCUMENT NOT CONSIDERED FINAL  
UNLESS ALL SIGNATURES COMPLETED

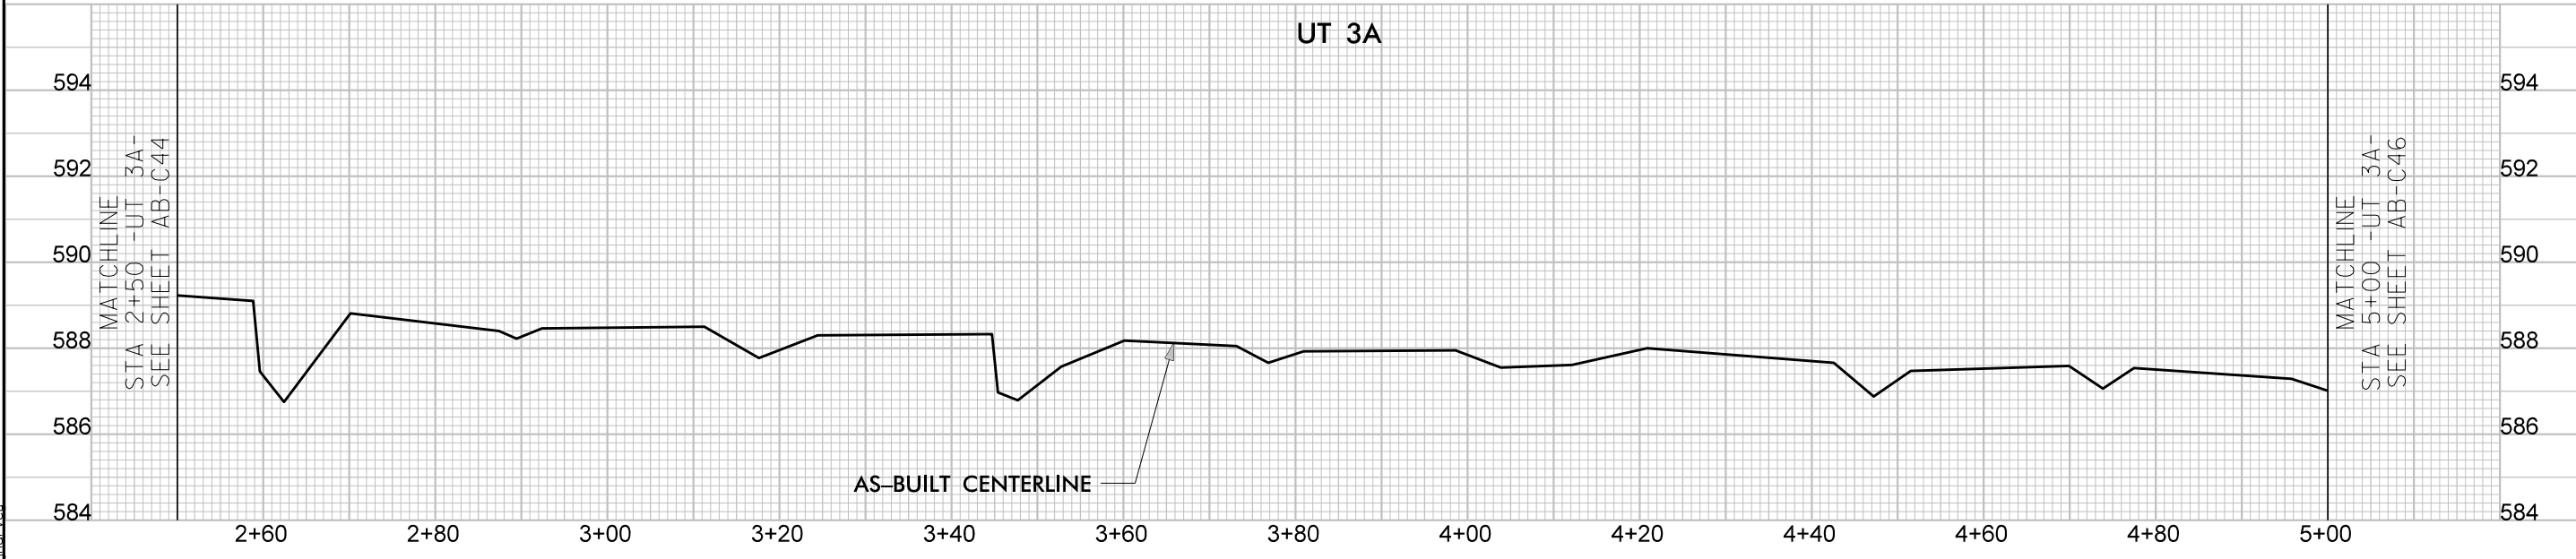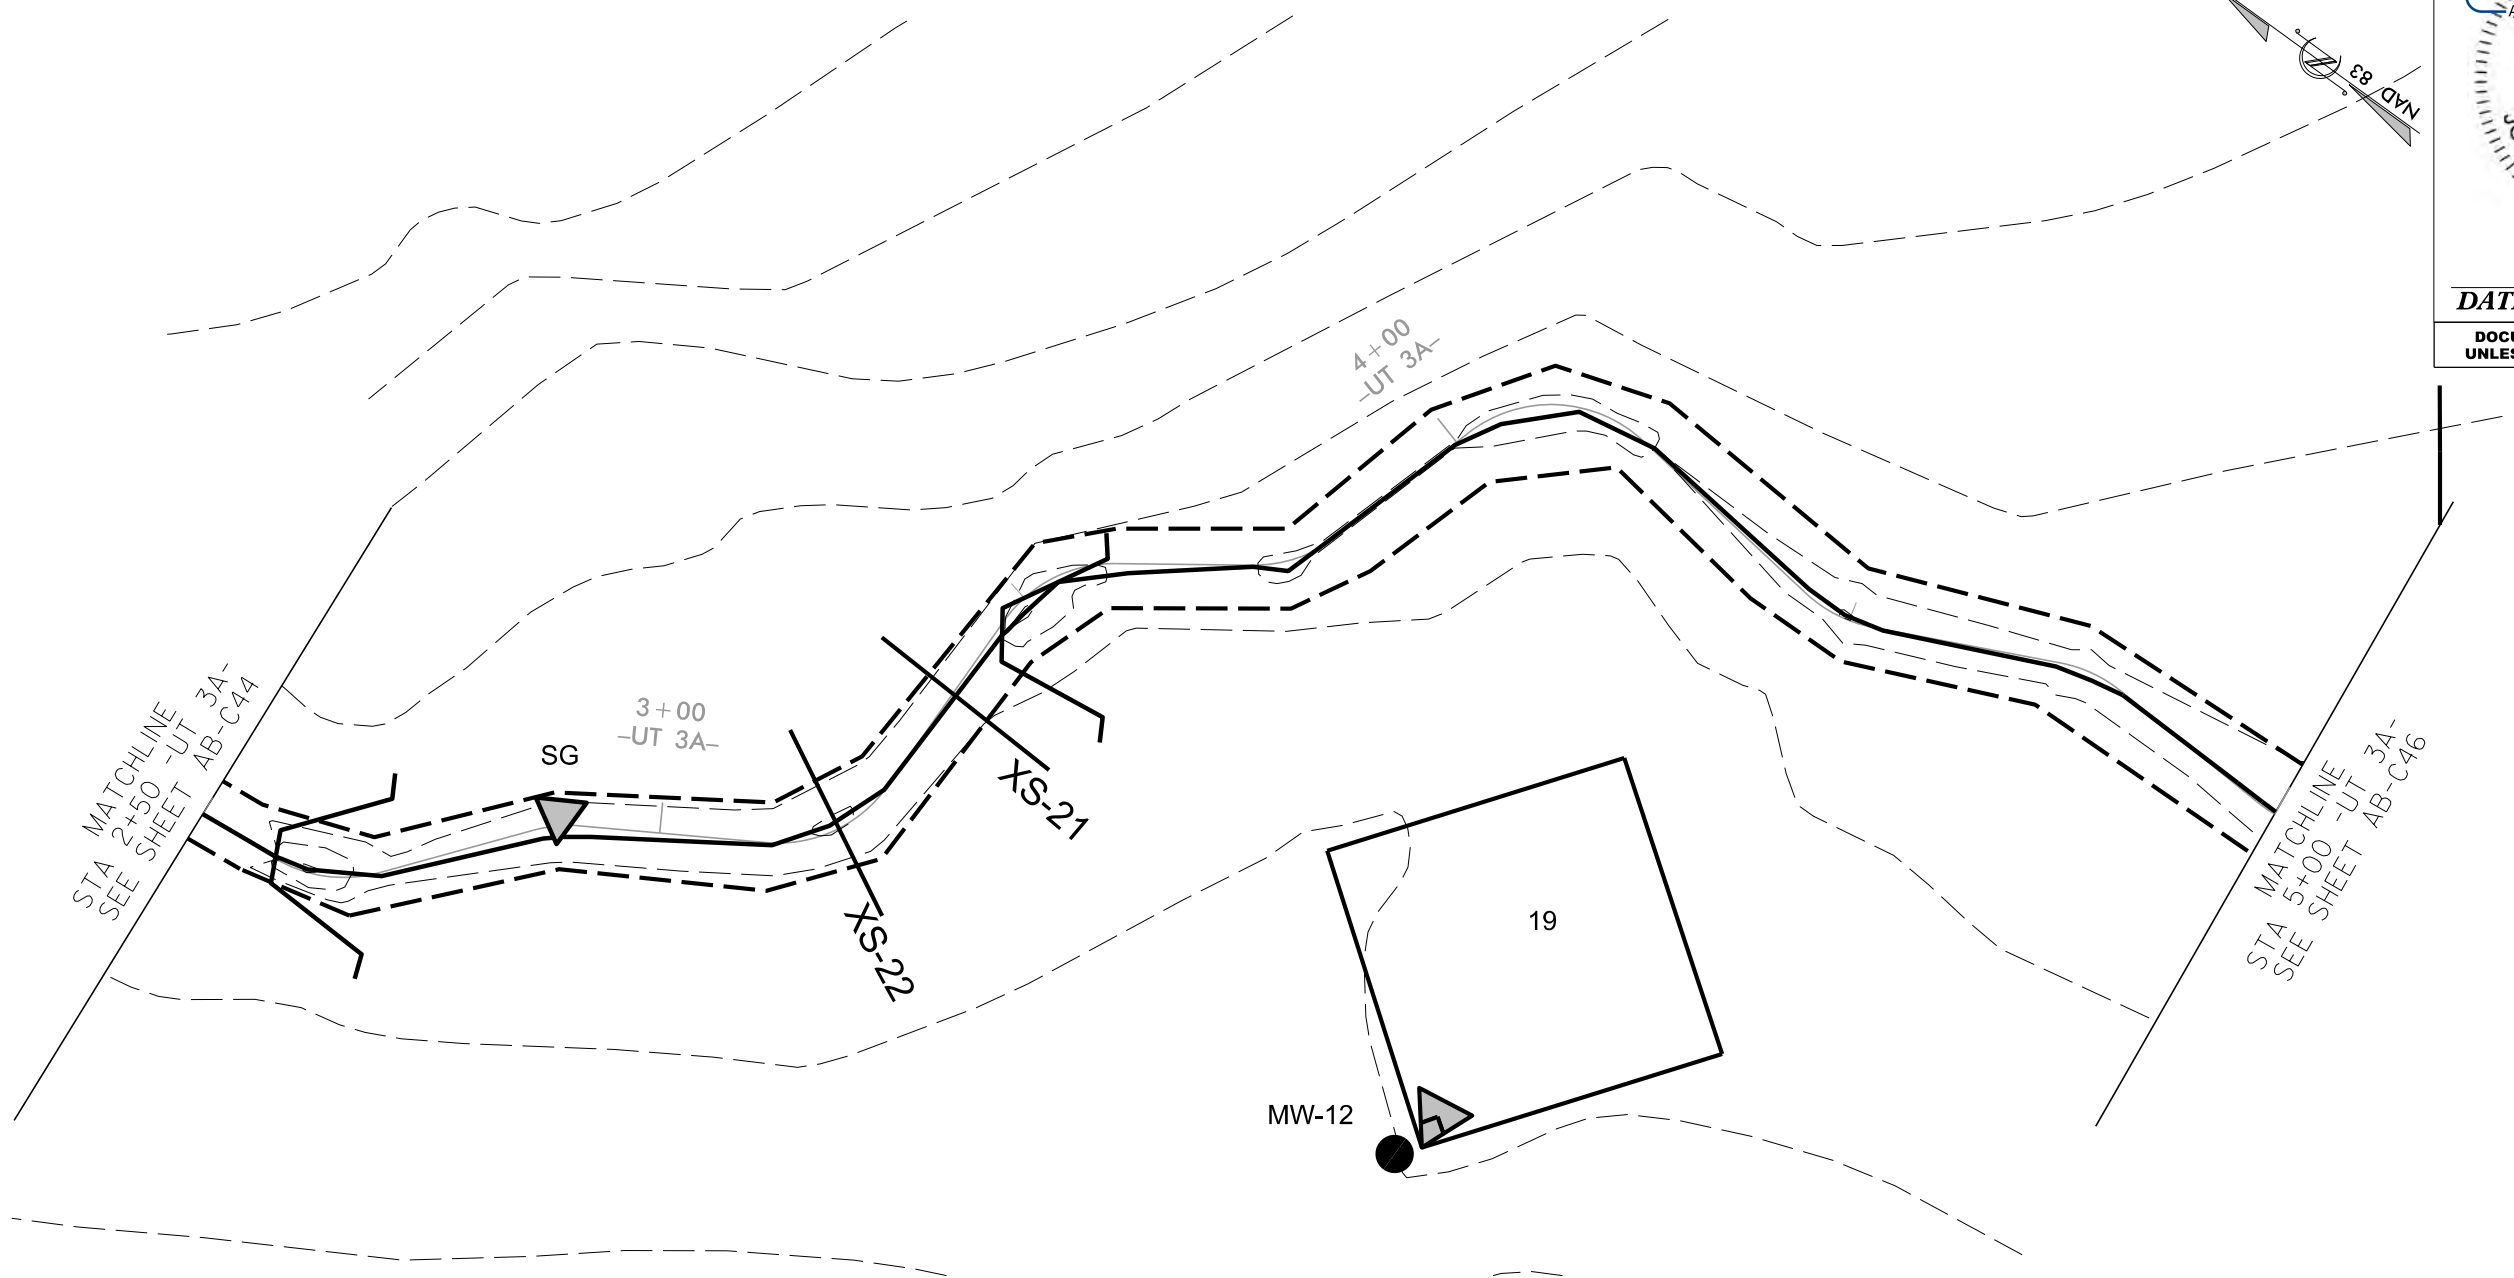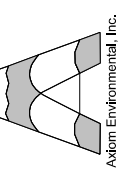

11/9/2022  
Wits\_End\_Psh\_AB-C45.dgn  
jrh



© 2022 SUNGATE DESIGN GROUP, P.A. THIS DRAWING AND ALL REPRODUCTIONS OF IT ARE THE SOLE PROPERTY OF SDG. REPRODUCTION OR OTHER USES OF THIS DRAWING WITHOUT WRITTEN CONSENT OF SDG IS NOT PERMITTED.

**WITS END**  
UNION COUNTY, NC  
**AS-BUILT SURVEY**

PROJECT # : 1221-20024  
DRAWING NAME: WITS END PSH AB-C45  
DATE: 2022  
DRAWN BY: JRH  
REVIEWED BY: JGD  
REVISIONS:


SHEET NO.  
**AB-C45**



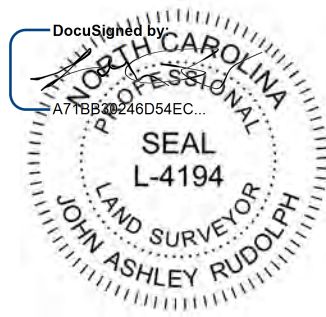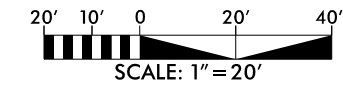

11/9/2022

DATE:  
DOCUMENT NOT CONSIDERED FINAL  
UNLESS ALL SIGNATURES COMPLETED


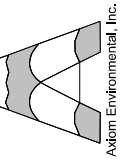


© 2022 SUNGATE DESIGN GROUP, P.A. THIS DRAWING AND ALL REPRODUCTIONS OF IT ARE THE SOLE PROPERTY OF SDG. REPRODUCTION OR OTHER USES OF THIS DRAWING WITHOUT WRITTEN CONSENT OF SDG IS NOT PERMITTED.




WITS END  
UNION COUNTY, NC  
AS-BUILT SURVEY

PROJECT # :  
1221-20024  
DRAWING NAME:  
WITS END PSH AB-C46  
DATE:  
2022  
DRAWN BY:  
JRH  
REVIEWED BY:  
JGD  
REVISIONS:

SHEET NO.  
**AB-C46**

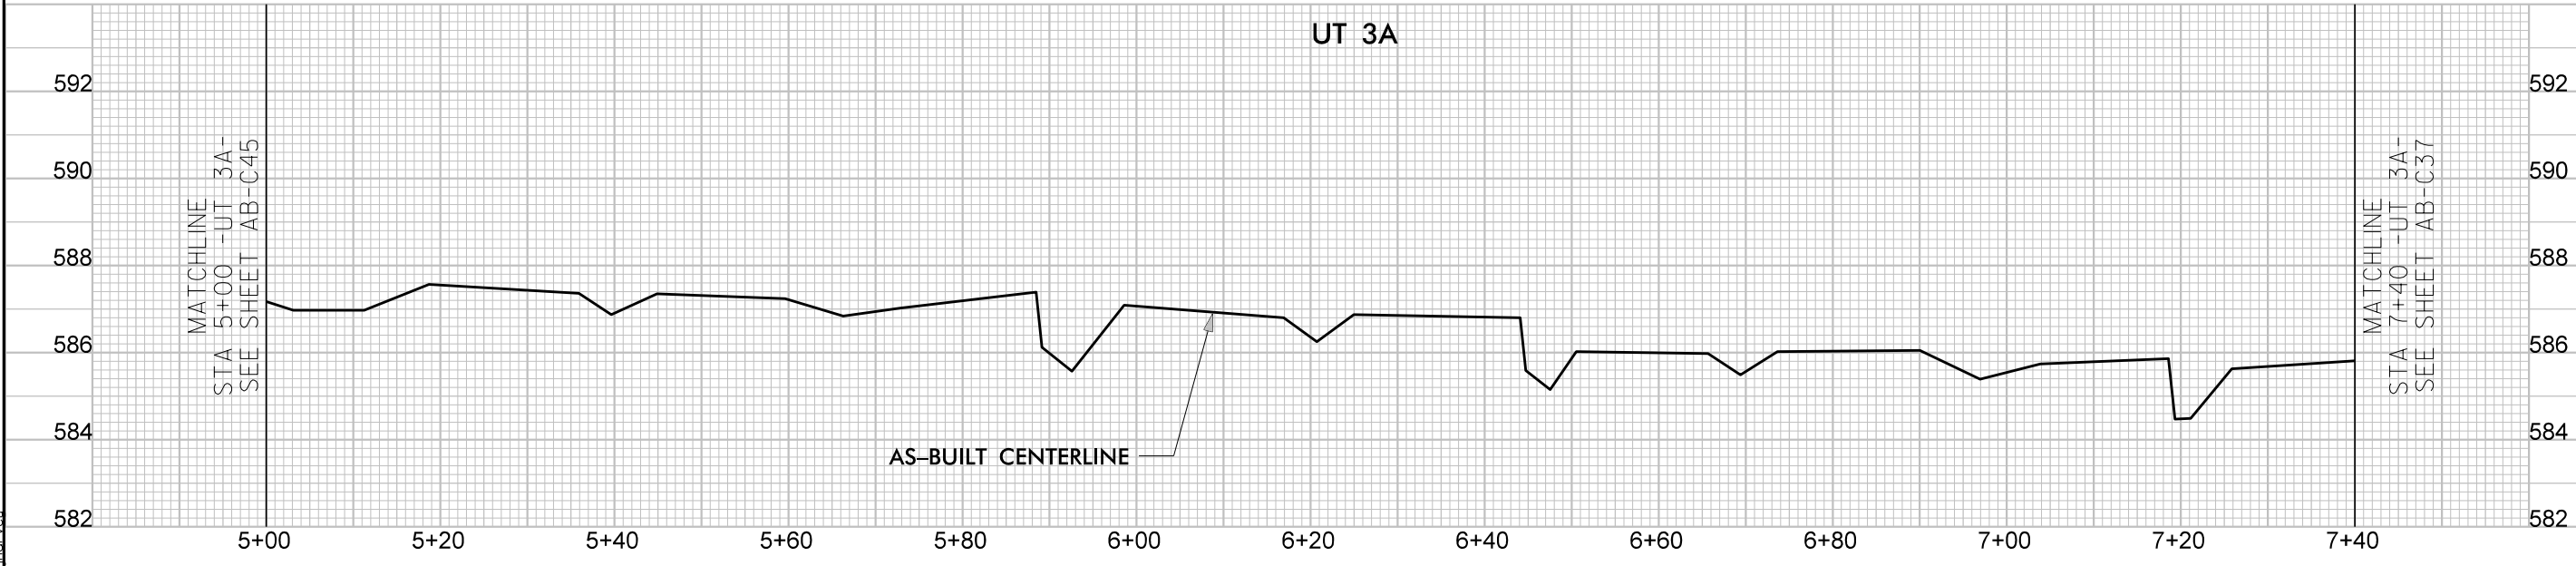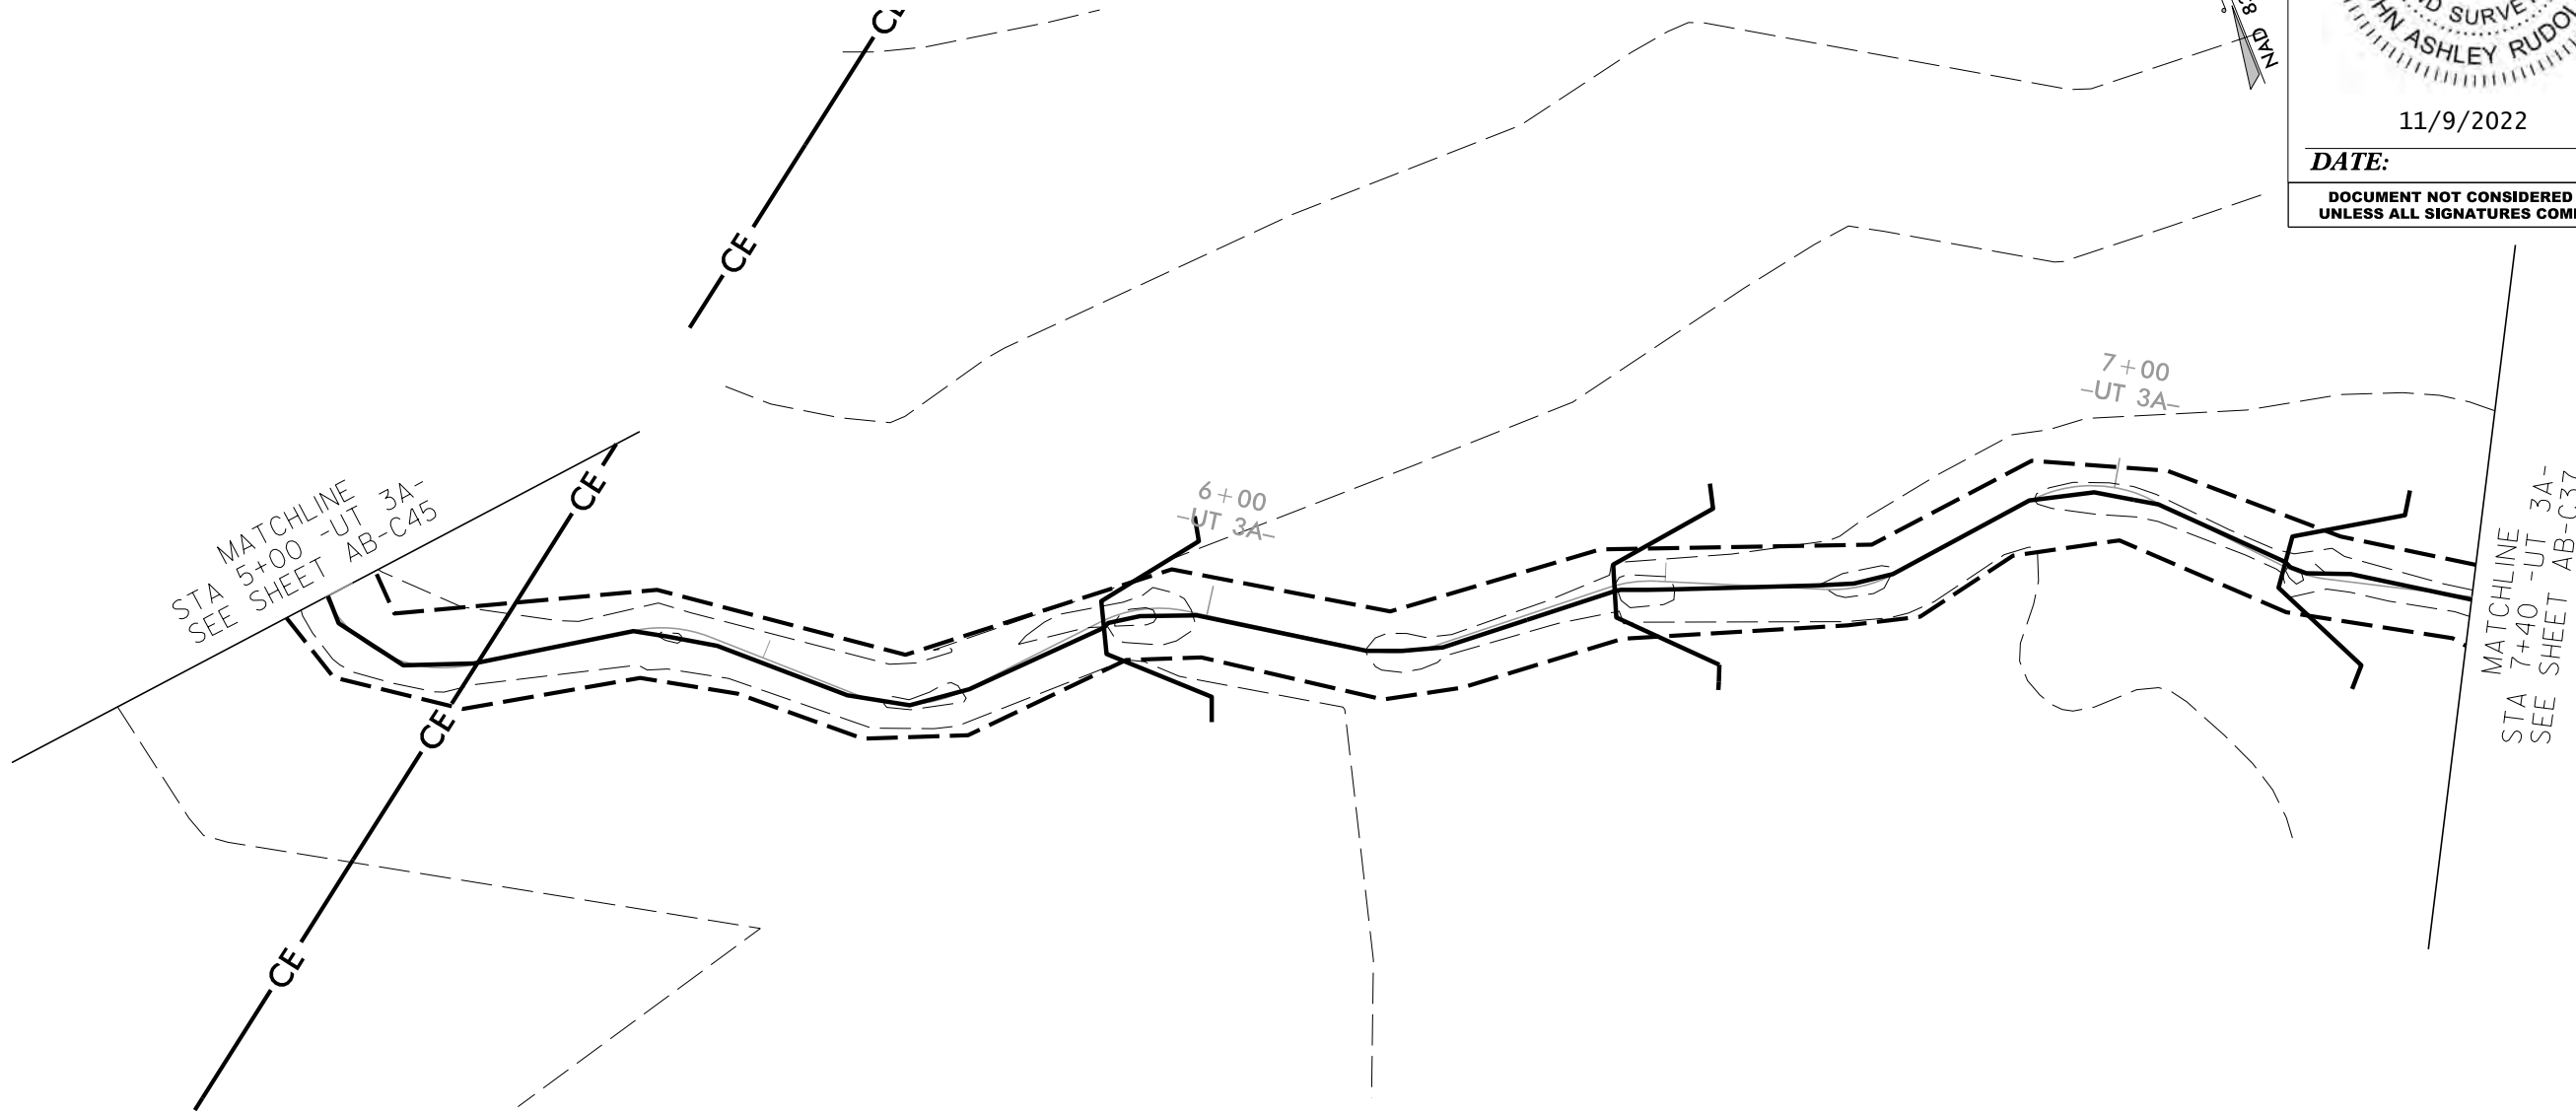


11/9/2022  
Wits\_End\_Psh\_AB-C46.dgn  
jrh

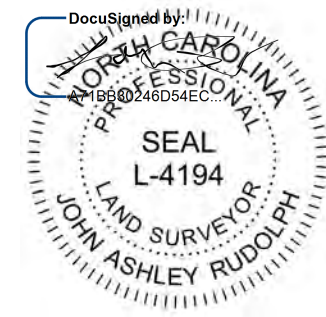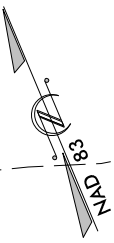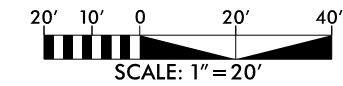

DATE: 11/9/2022



DOCUMENT NOT CONSIDERED FINAL UNLESS ALL SIGNATURES COMPLETED

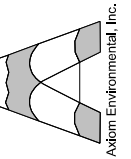

WITS END UNION COUNTY, NC AB-BUILT SURVEY



PROJECT #: 1221-20024  
DRAWING NAME: WITS END PSH AB-C47  
DATE: 2022  
DRAWN BY: JRH  
REVIEWED BY: JGD  
REVISIONS:

SHEET NO. AB-C47

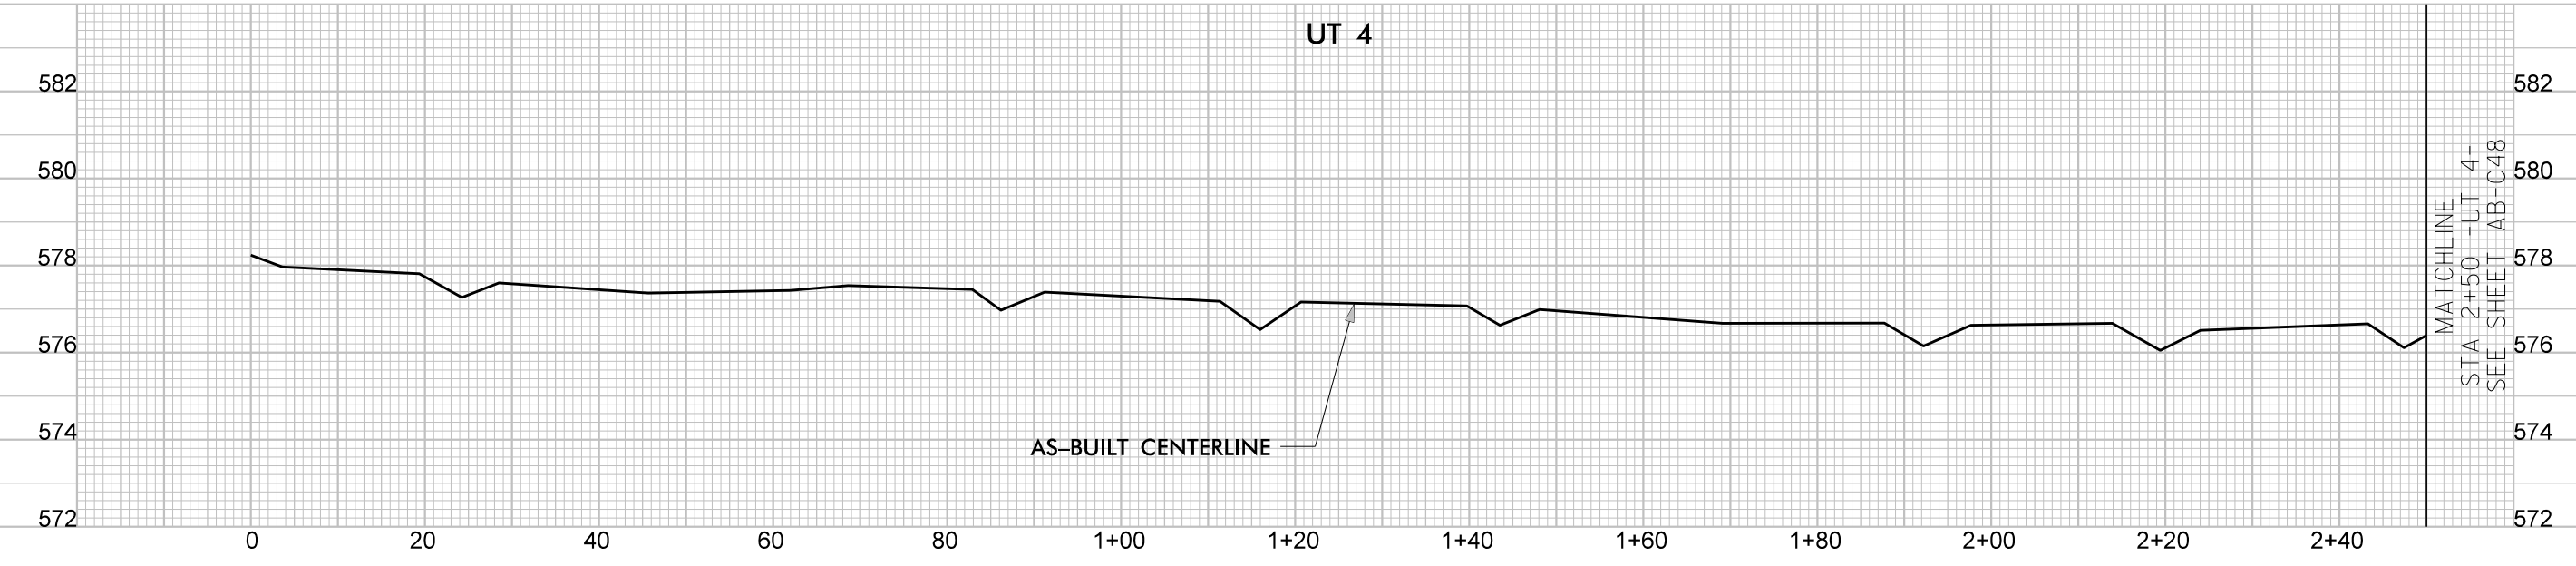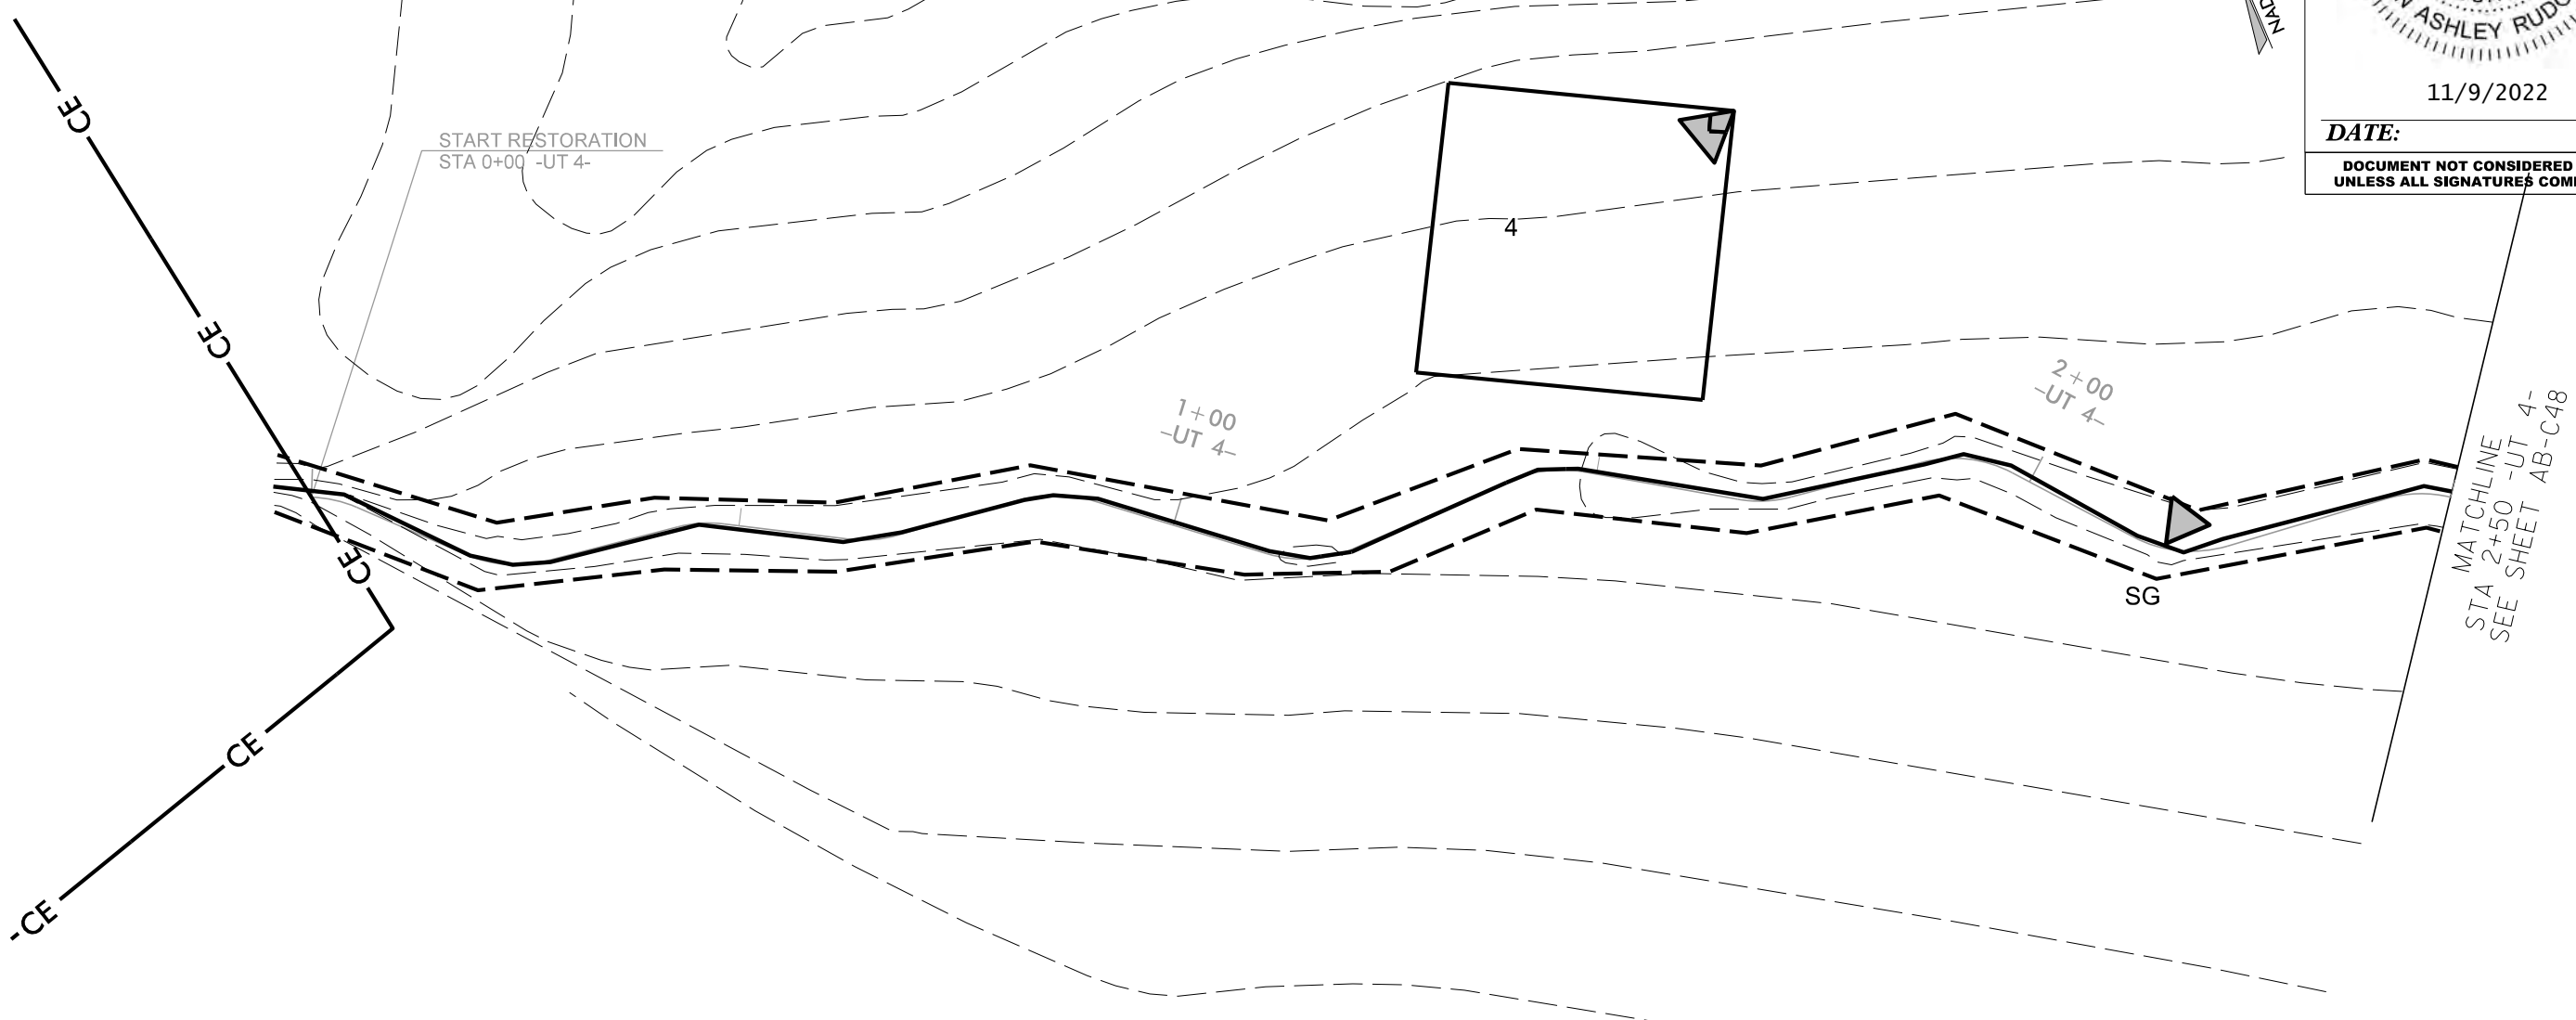


11/9/2022 Wits\_End\_Psh\_AB-C47.dgn

© 2022 SUNGATE DESIGN GROUP, P.A. THIS DRAWING AND ALL REPRODUCTIONS OF IT ARE THE SOLE PROPERTY OF SDG. REPRODUCTION OR OTHER USES OF THIS DRAWING WITHOUT WRITTEN CONSENT OF SDG IS NOT PERMITTED.

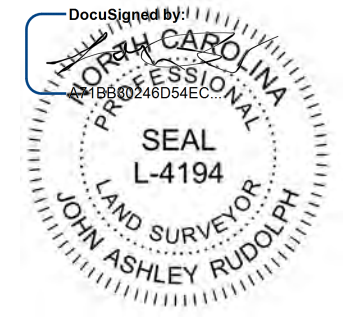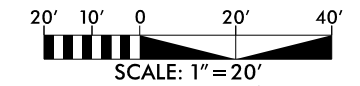

DATE: 11/9/2022

DOCUMENT NOT CONSIDERED FINAL  
UNLESS ALL SIGNATURES COMPLETED

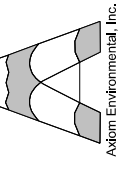

11/9/2022 Wits\_End\_psh\_AB-C48.dgn



© 2022 SUNGATE DESIGN GROUP, P.A. THIS DRAWING AND ALL REPRODUCTIONS OF IT ARE THE SOLE PROPERTY OF SDG. REPRODUCTION OR OTHER USES OF THIS DRAWING WITHOUT WRITTEN CONSENT OF SDG IS NOT PERMITTED.

**WITS END**  
UNION COUNTY, NC  
**AS-BUILT SURVEY**

PROJECT # : 1221-20024  
DRAWING NAME: WITS END PSH AB-C48  
DATE: 2022  
DRAWN BY: JRH  
REVIEWED BY: JGD  
REVISIONS:


SHEET NO.  
**AB-C48**



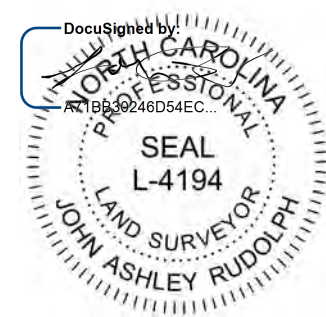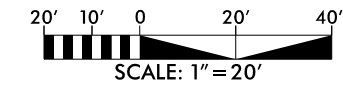

DATE: 11/9/2022



DOCUMENT NOT CONSIDERED FINAL UNLESS ALL SIGNATURES COMPLETED

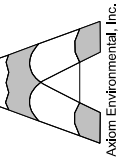

WITS END UNION COUNTY, NC AS-BUILT SURVEY




PROJECT #: 1221-20024  
DRAWING NAME: WITS END PSH AB-C49  
DATE: 2022  
DRAWN BY: JRH  
REVIEWED BY: JGD  
REVISIONS:

SHEET NO. AB-C49

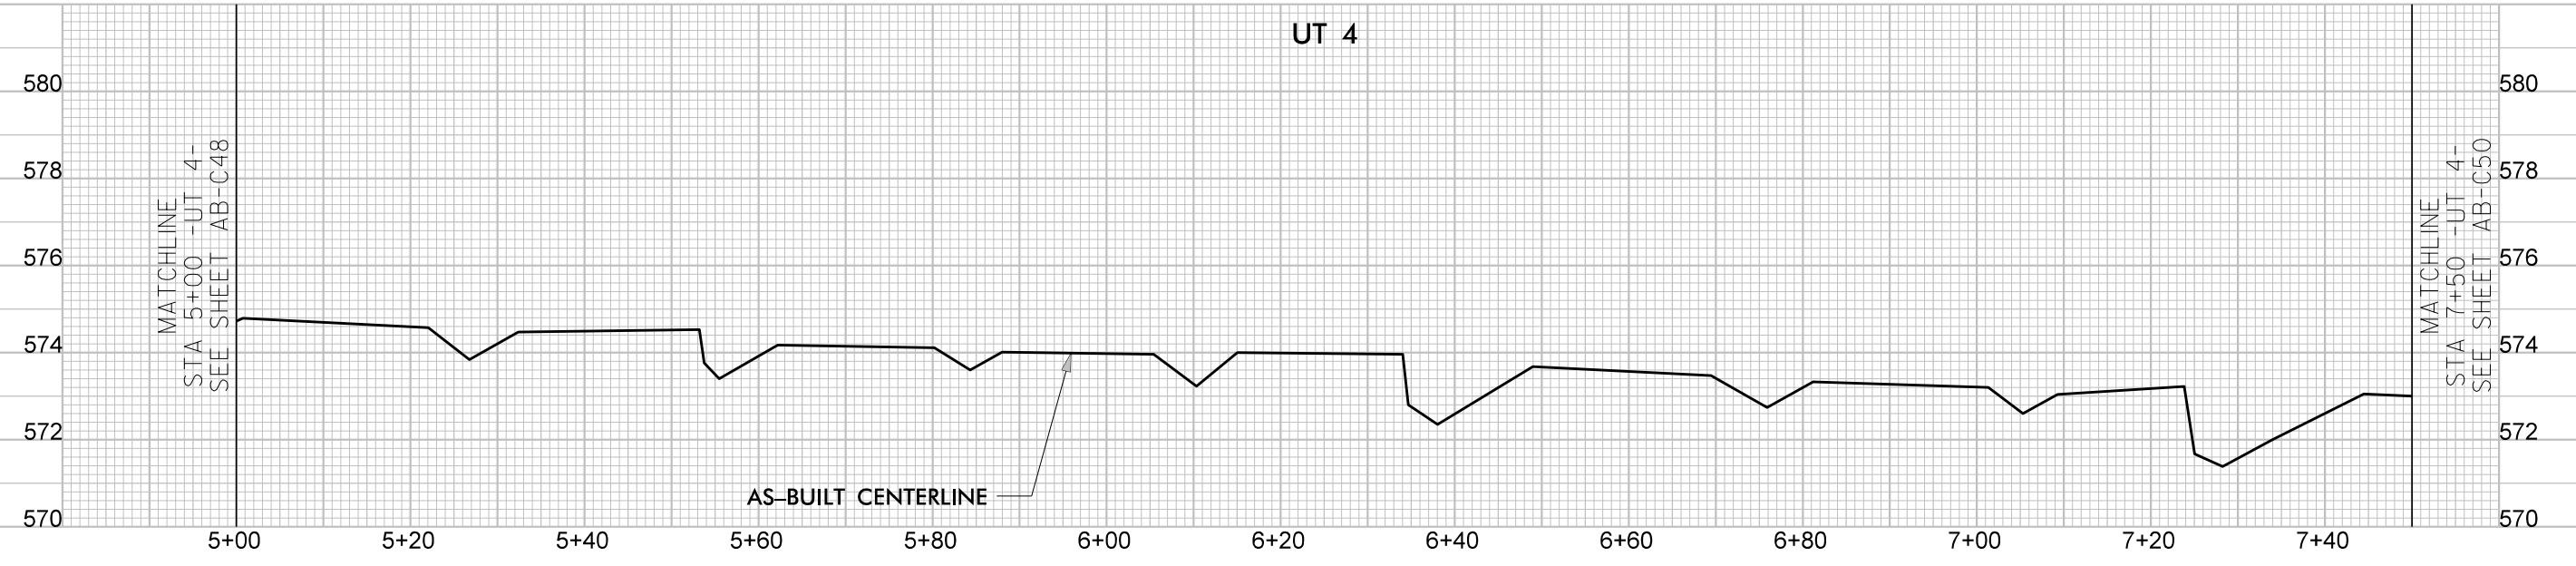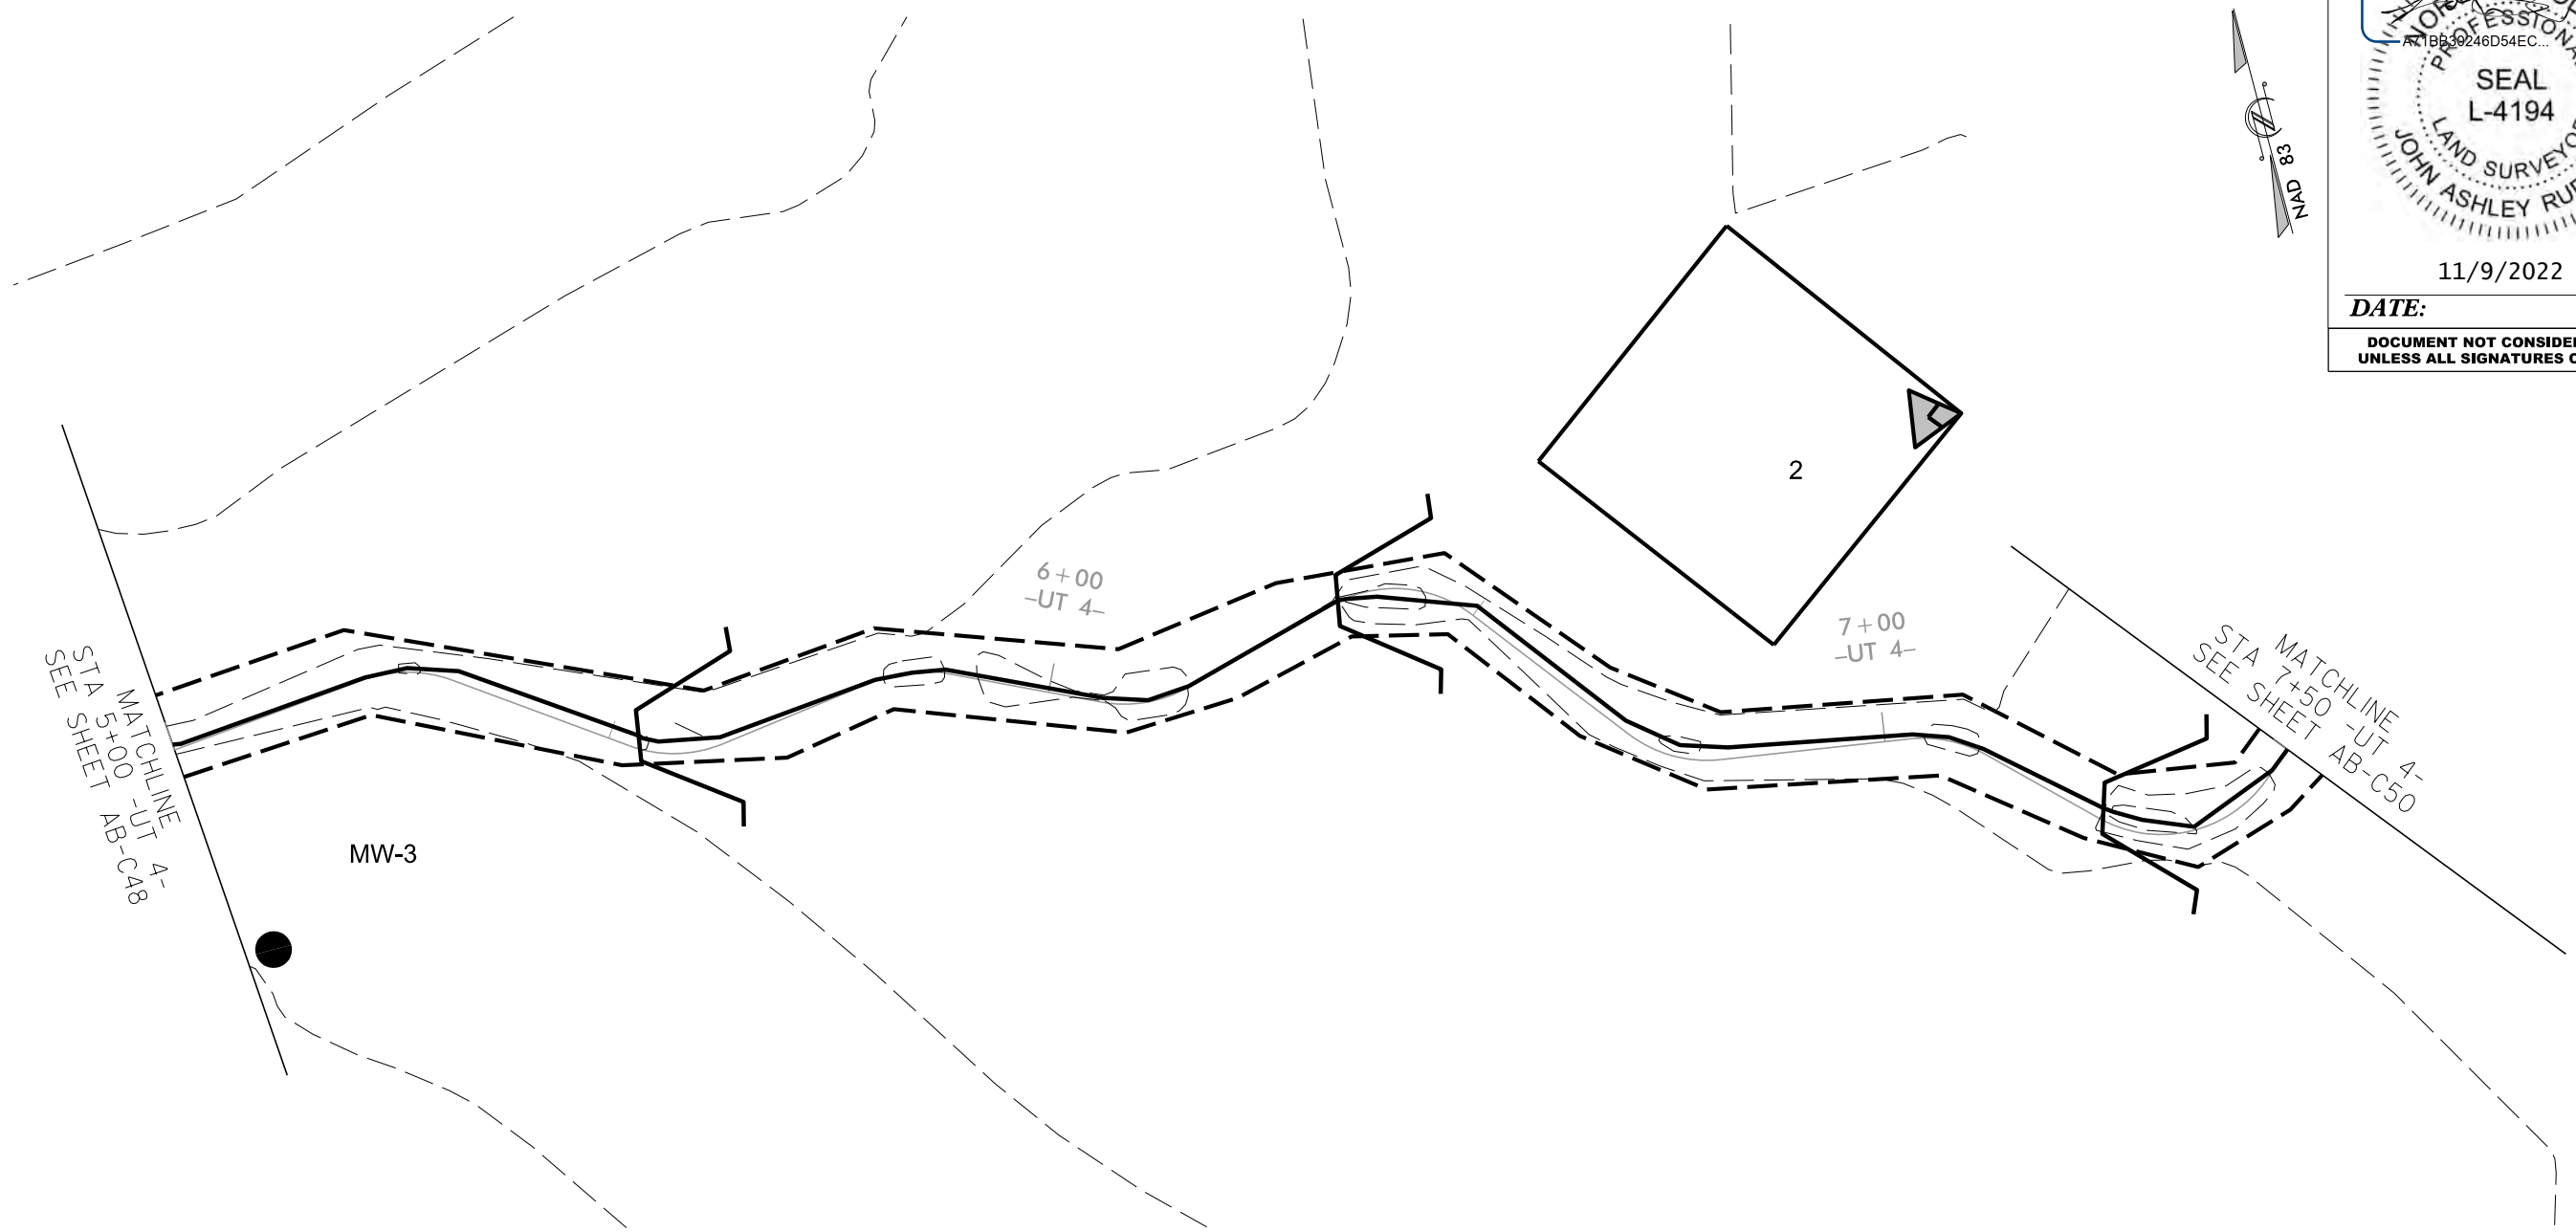

11/9/2022  
Wits\_End\_Psh\_AB-C49.dgn  
jrh



© 2022 SUNGATE DESIGN GROUP, P.A. THIS DRAWING AND ALL REPRODUCTIONS OF IT ARE THE SOLE PROPERTY OF SDG. REPRODUCTION OR OTHER USES OF THIS DRAWING WITHOUT WRITTEN CONSENT OF SDG IS NOT PERMITTED.

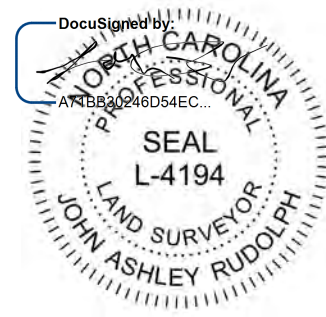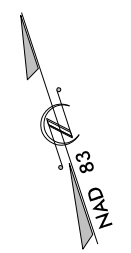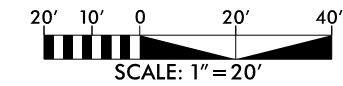


11/9/2022

DATE:

DOCUMENT NOT CONSIDERED FINAL  
UNLESS ALL SIGNATURES COMPLETED

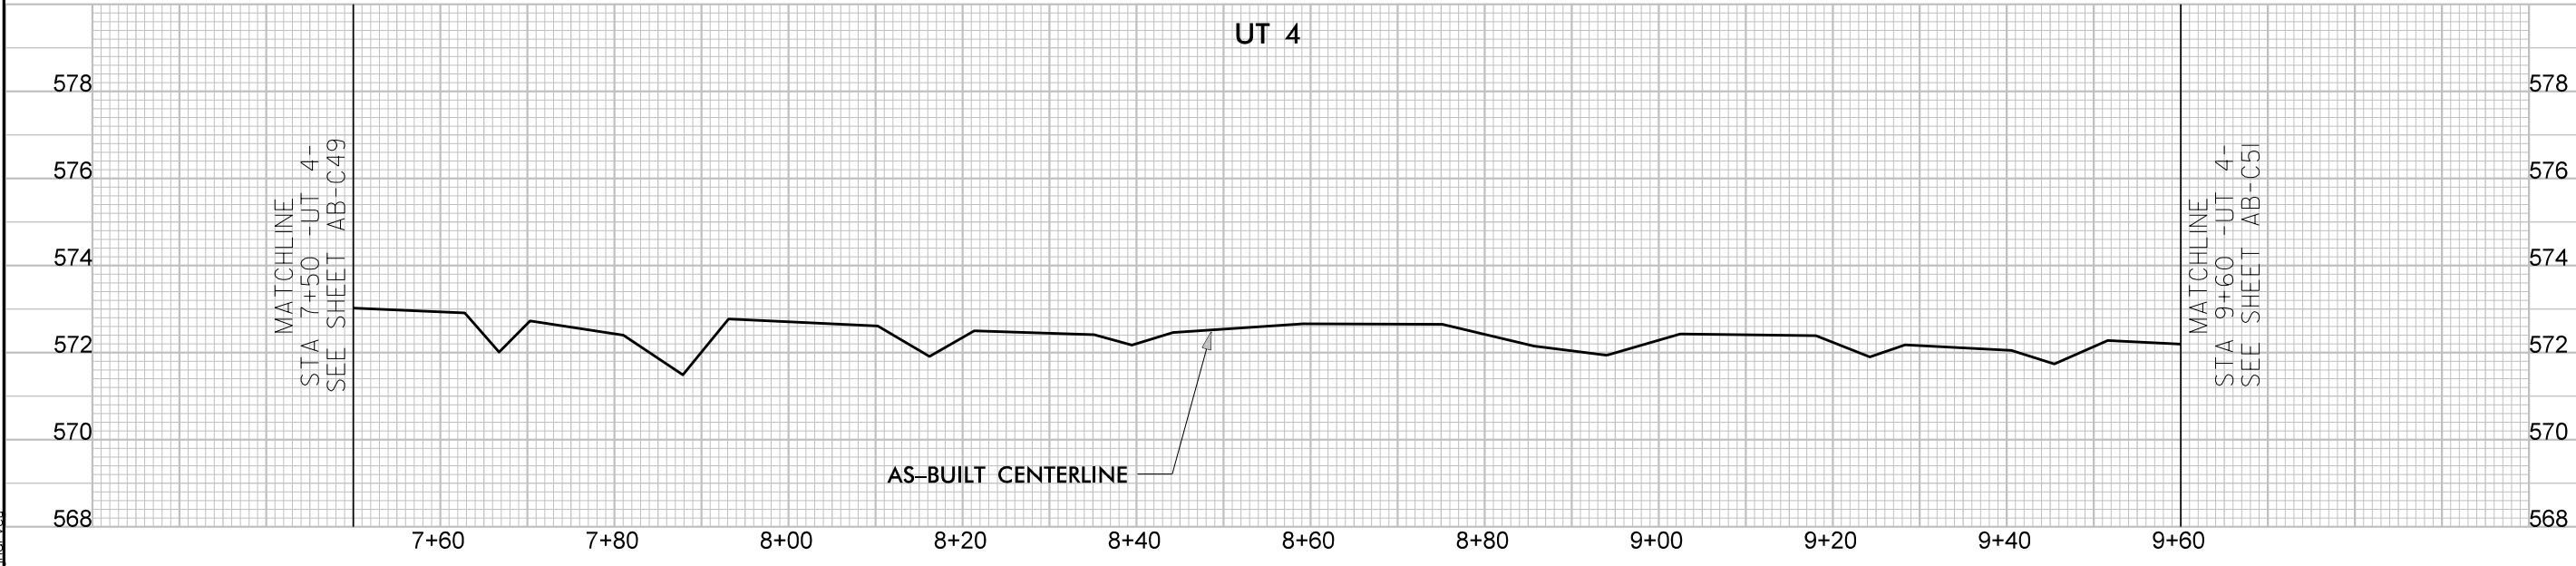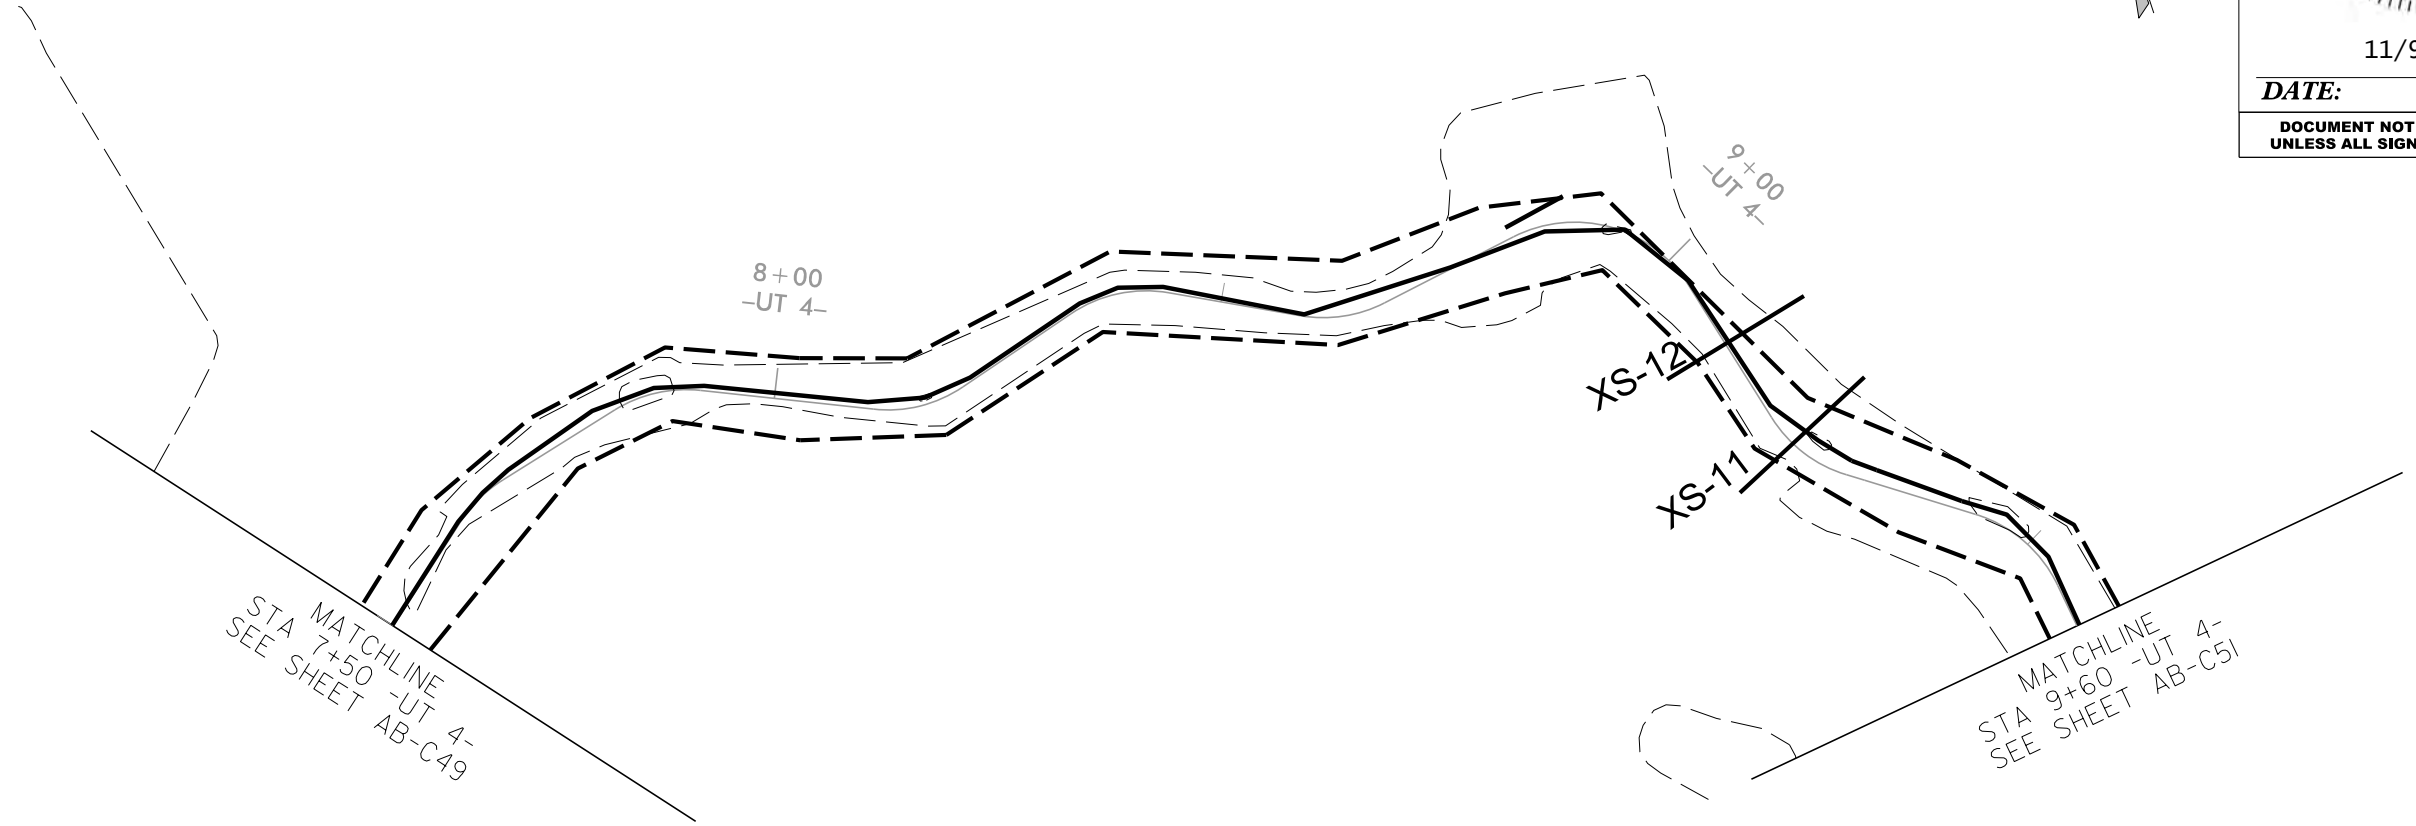

11/9/2022 Wits\_End\_Psh\_AB-C50.dgn


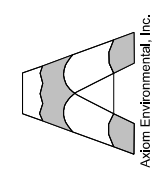


**WITS END**  
 UNION COUNTY, NC  
**AS-BUILT SURVEY**

PROJECT # : 1221-20024  
 DRAWING NAME: WITS END PSH AB-C50  
 DATE: 2022  
 DRAWN BY: JRH  
 REVIEWED BY: JGD  
 REVISIONS:



SHEET NO.  
**AB-C50**

© 2022 SUNGATE DESIGN GROUP, P.A. THIS DRAWING AND ALL REPRODUCTIONS OF IT ARE THE SOLE PROPERTY OF SDG. REPRODUCTION OR OTHER USES OF THIS DRAWING WITHOUT WRITTEN CONSENT OF SDG IS NOT PERMITTED.

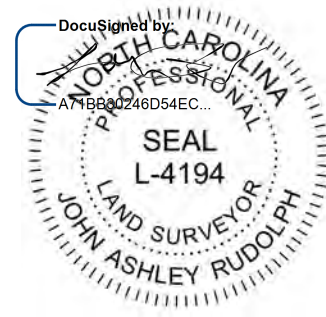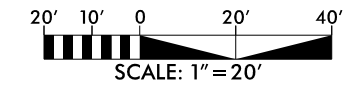


DATE: 11/9/2022

DOCUMENT NOT CONSIDERED FINAL  
UNLESS ALL SIGNATURES COMPLETED

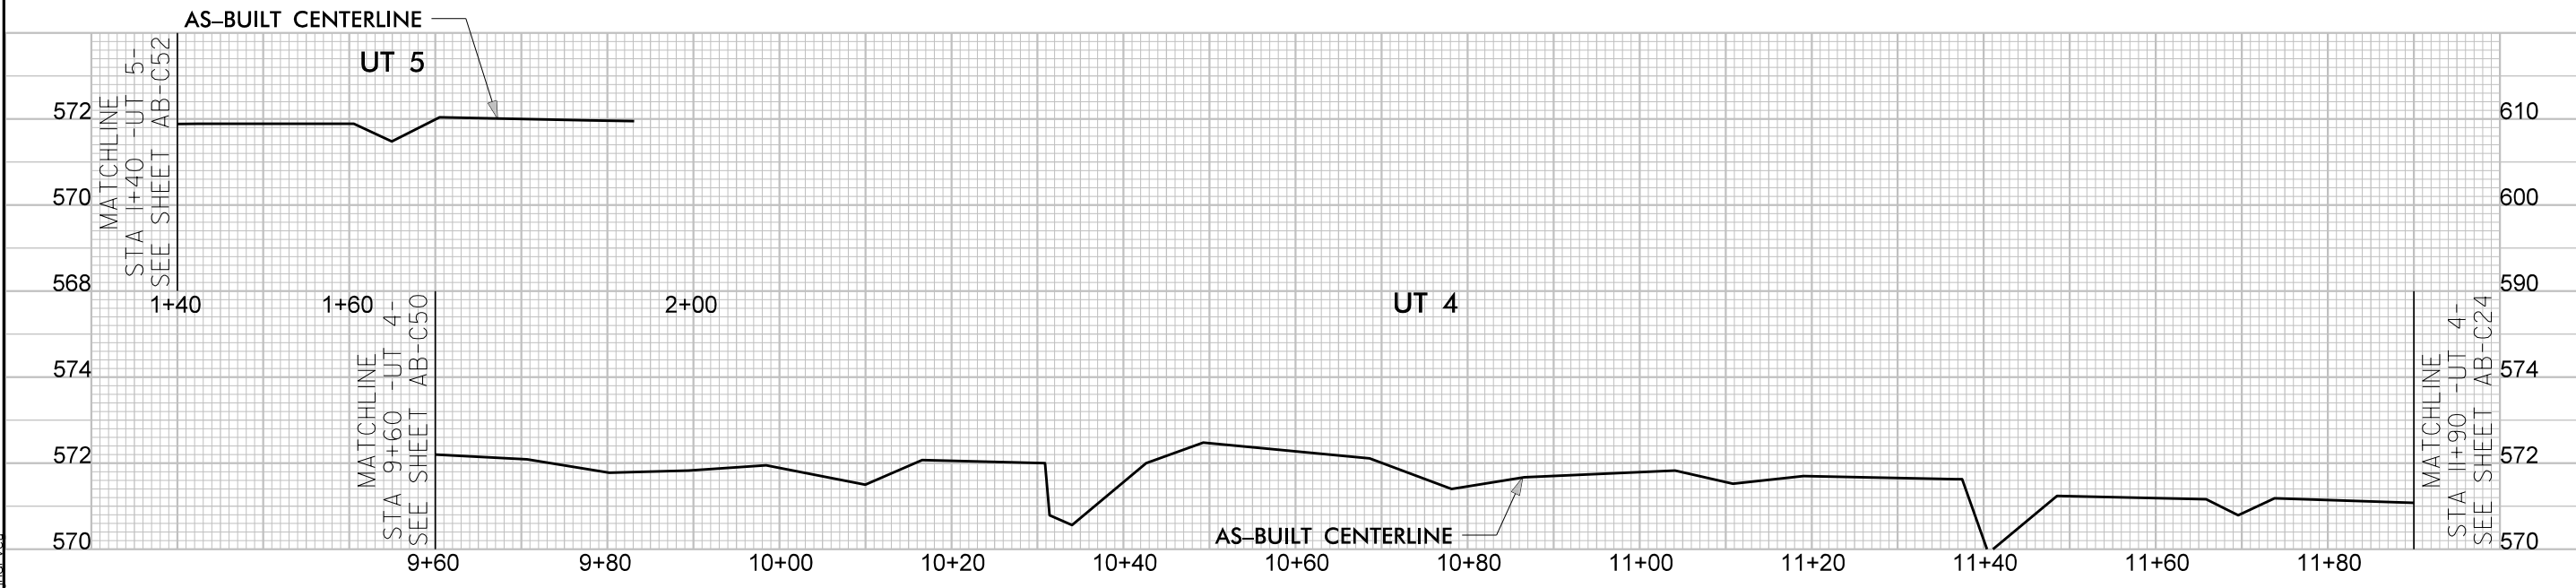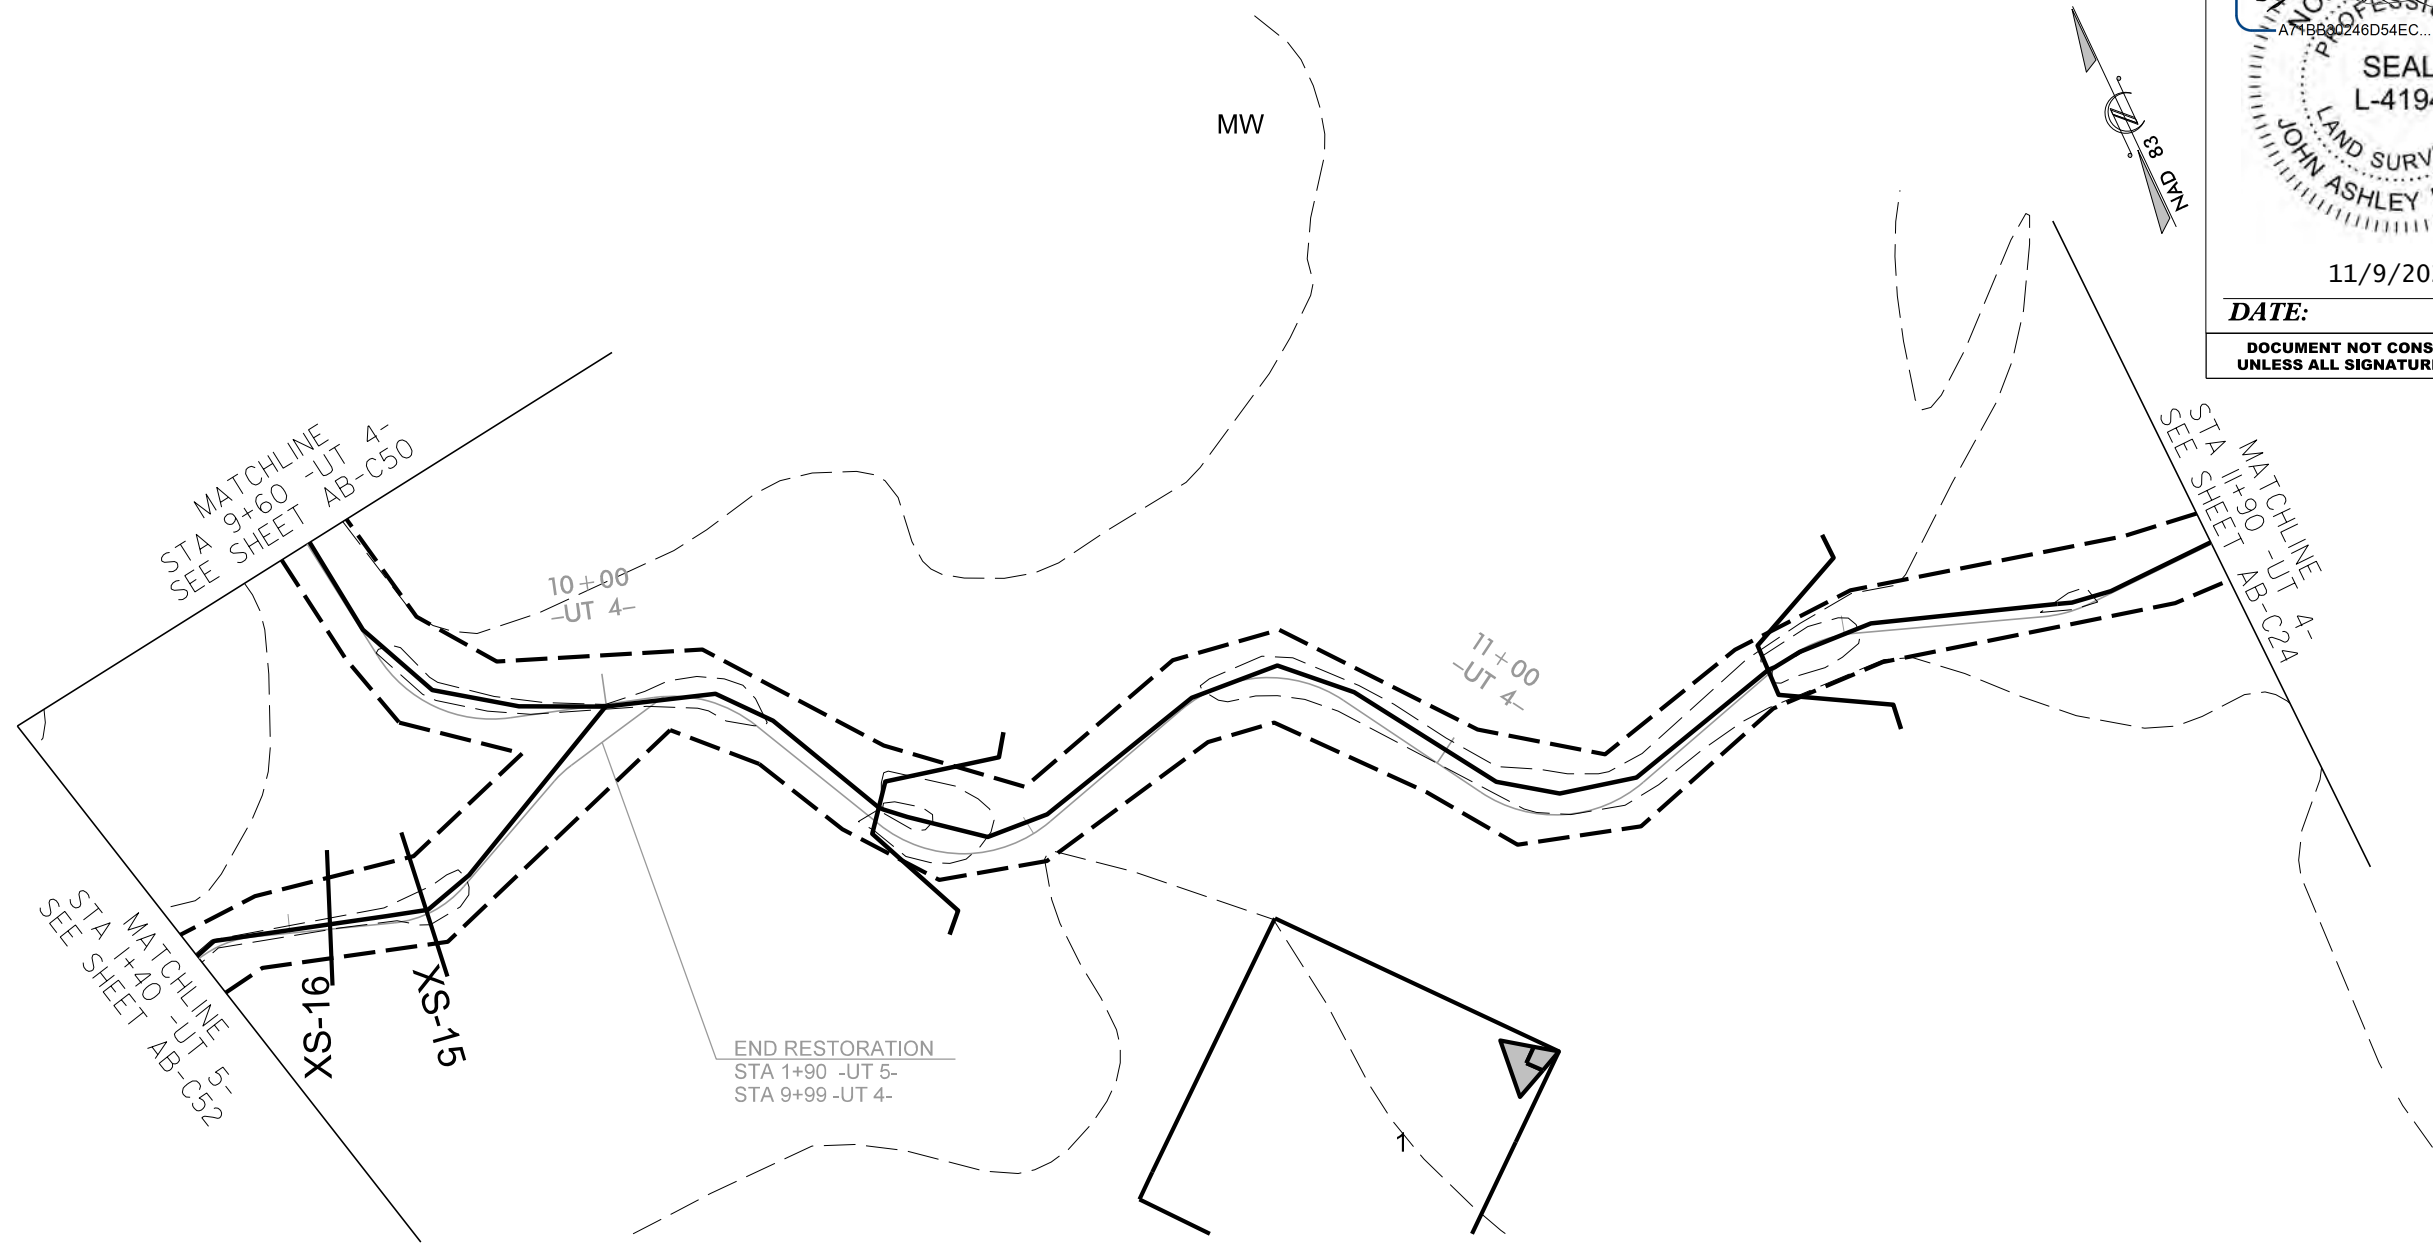

11/9/2022 Wits\_End\_psh\_AB-C51.dgn

© 2022 SUNGATE DESIGN GROUP, P.A. THIS DRAWING AND ALL REPRODUCTIONS OF IT ARE THE SOLE PROPERTY OF SDG. REPRODUCTION OR OTHER USES OF THIS DRAWING WITHOUT WRITTEN CONSENT OF SDG IS NOT PERMITTED.



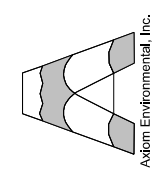


**WITS END**  
UNION COUNTY, NC  
**AS-BUILT SURVEY**

PROJECT # : 1221-20024  
DRAWING NAME: WITS END PSH AB-C51  
DATE: 2022  
DRAWN BY: JRH  
REVIEWED BY: JGD  
REVISIONS:


SHEET NO.  
**AB-C51**



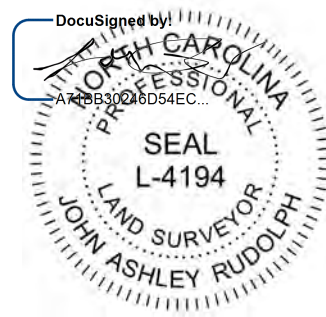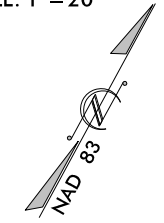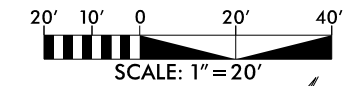

11/9/2022


DATE:  
DOCUMENT NOT CONSIDERED FINAL  
UNLESS ALL SIGNATURES COMPLETED

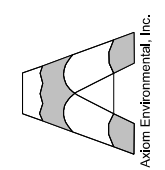

**WITS END**  
UNION COUNTY, NC  
**AS-BUILT SURVEY**

PROJECT # :  
1221-20024  
DRAWING NAME:  
WITS END PSH AB-C52  
DATE:  
2022  
DRAWN BY:  
JRH  
REVIEWED BY:  
JGD  
REVISIONS:

SHEET NO.  
**AB-C52**

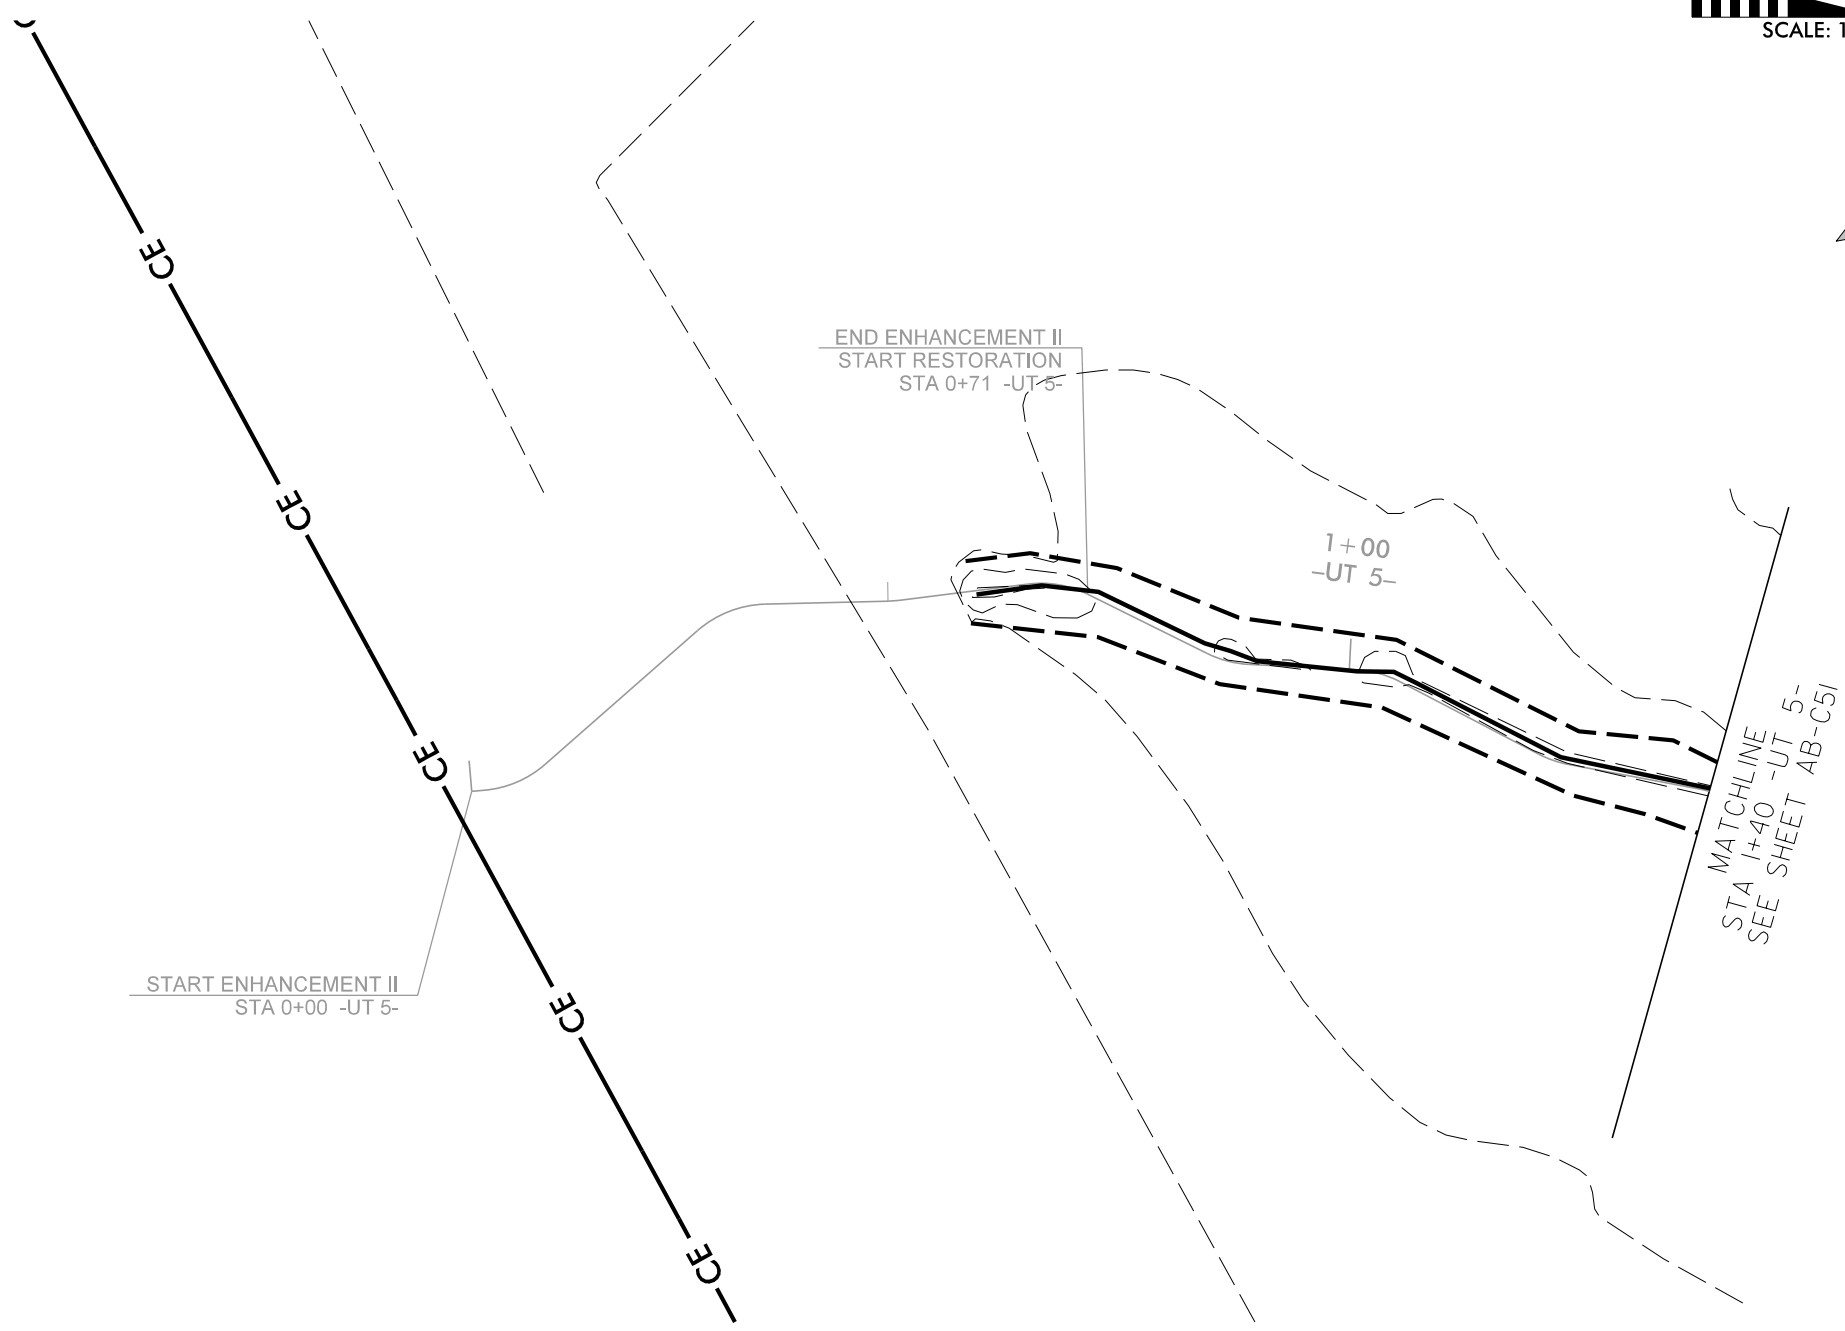


END ENHANCEMENT II  
START RESTORATION  
STA 0+71 -UT 5-

START ENHANCEMENT II  
STA 0+00 -UT 5-

1+00  
-UT 5-

MATCHLINE  
STA 1+40 -UT 5-  
SEE SHEET AB-C51

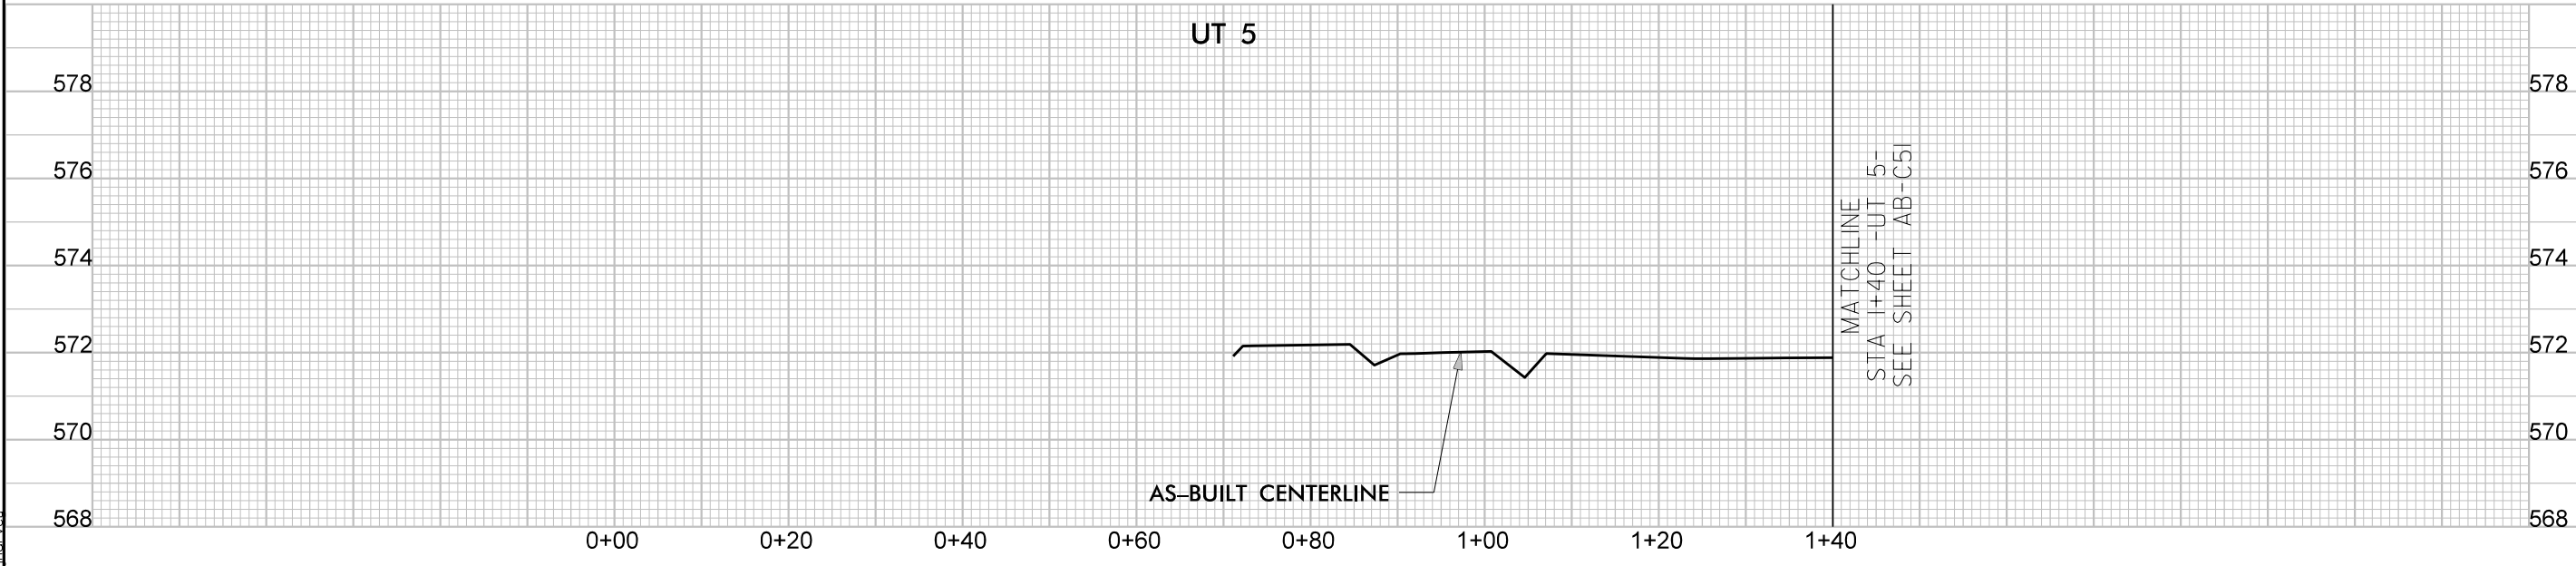



UT 5

AS-BUILT CENTERLINE

MATCHLINE  
STA 1+40 -UT 5-  
SEE SHEET AB-C51



11/9/2022  
Wits\_End\_Psh\_AB-C52.dgn  
10:00 AM

© 2022 SUNGATE DESIGN GROUP, P.A. THIS DRAWING AND ALL REPRODUCTIONS OF IT ARE THE SOLE PROPERTY OF SDG. REPRODUCTION OR OTHER USES OF THIS DRAWING WITHOUT WRITTEN CONSENT OF SDG IS NOT PERMITTED.

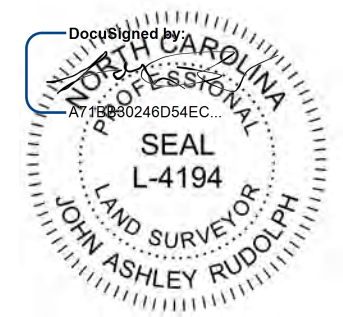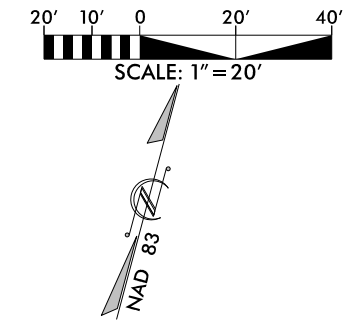

11/9/2022

**DATE:**  
**DOCUMENT NOT CONSIDERED FINAL**  
**UNLESS ALL SIGNATURES COMPLETED**

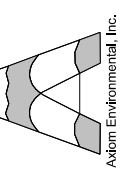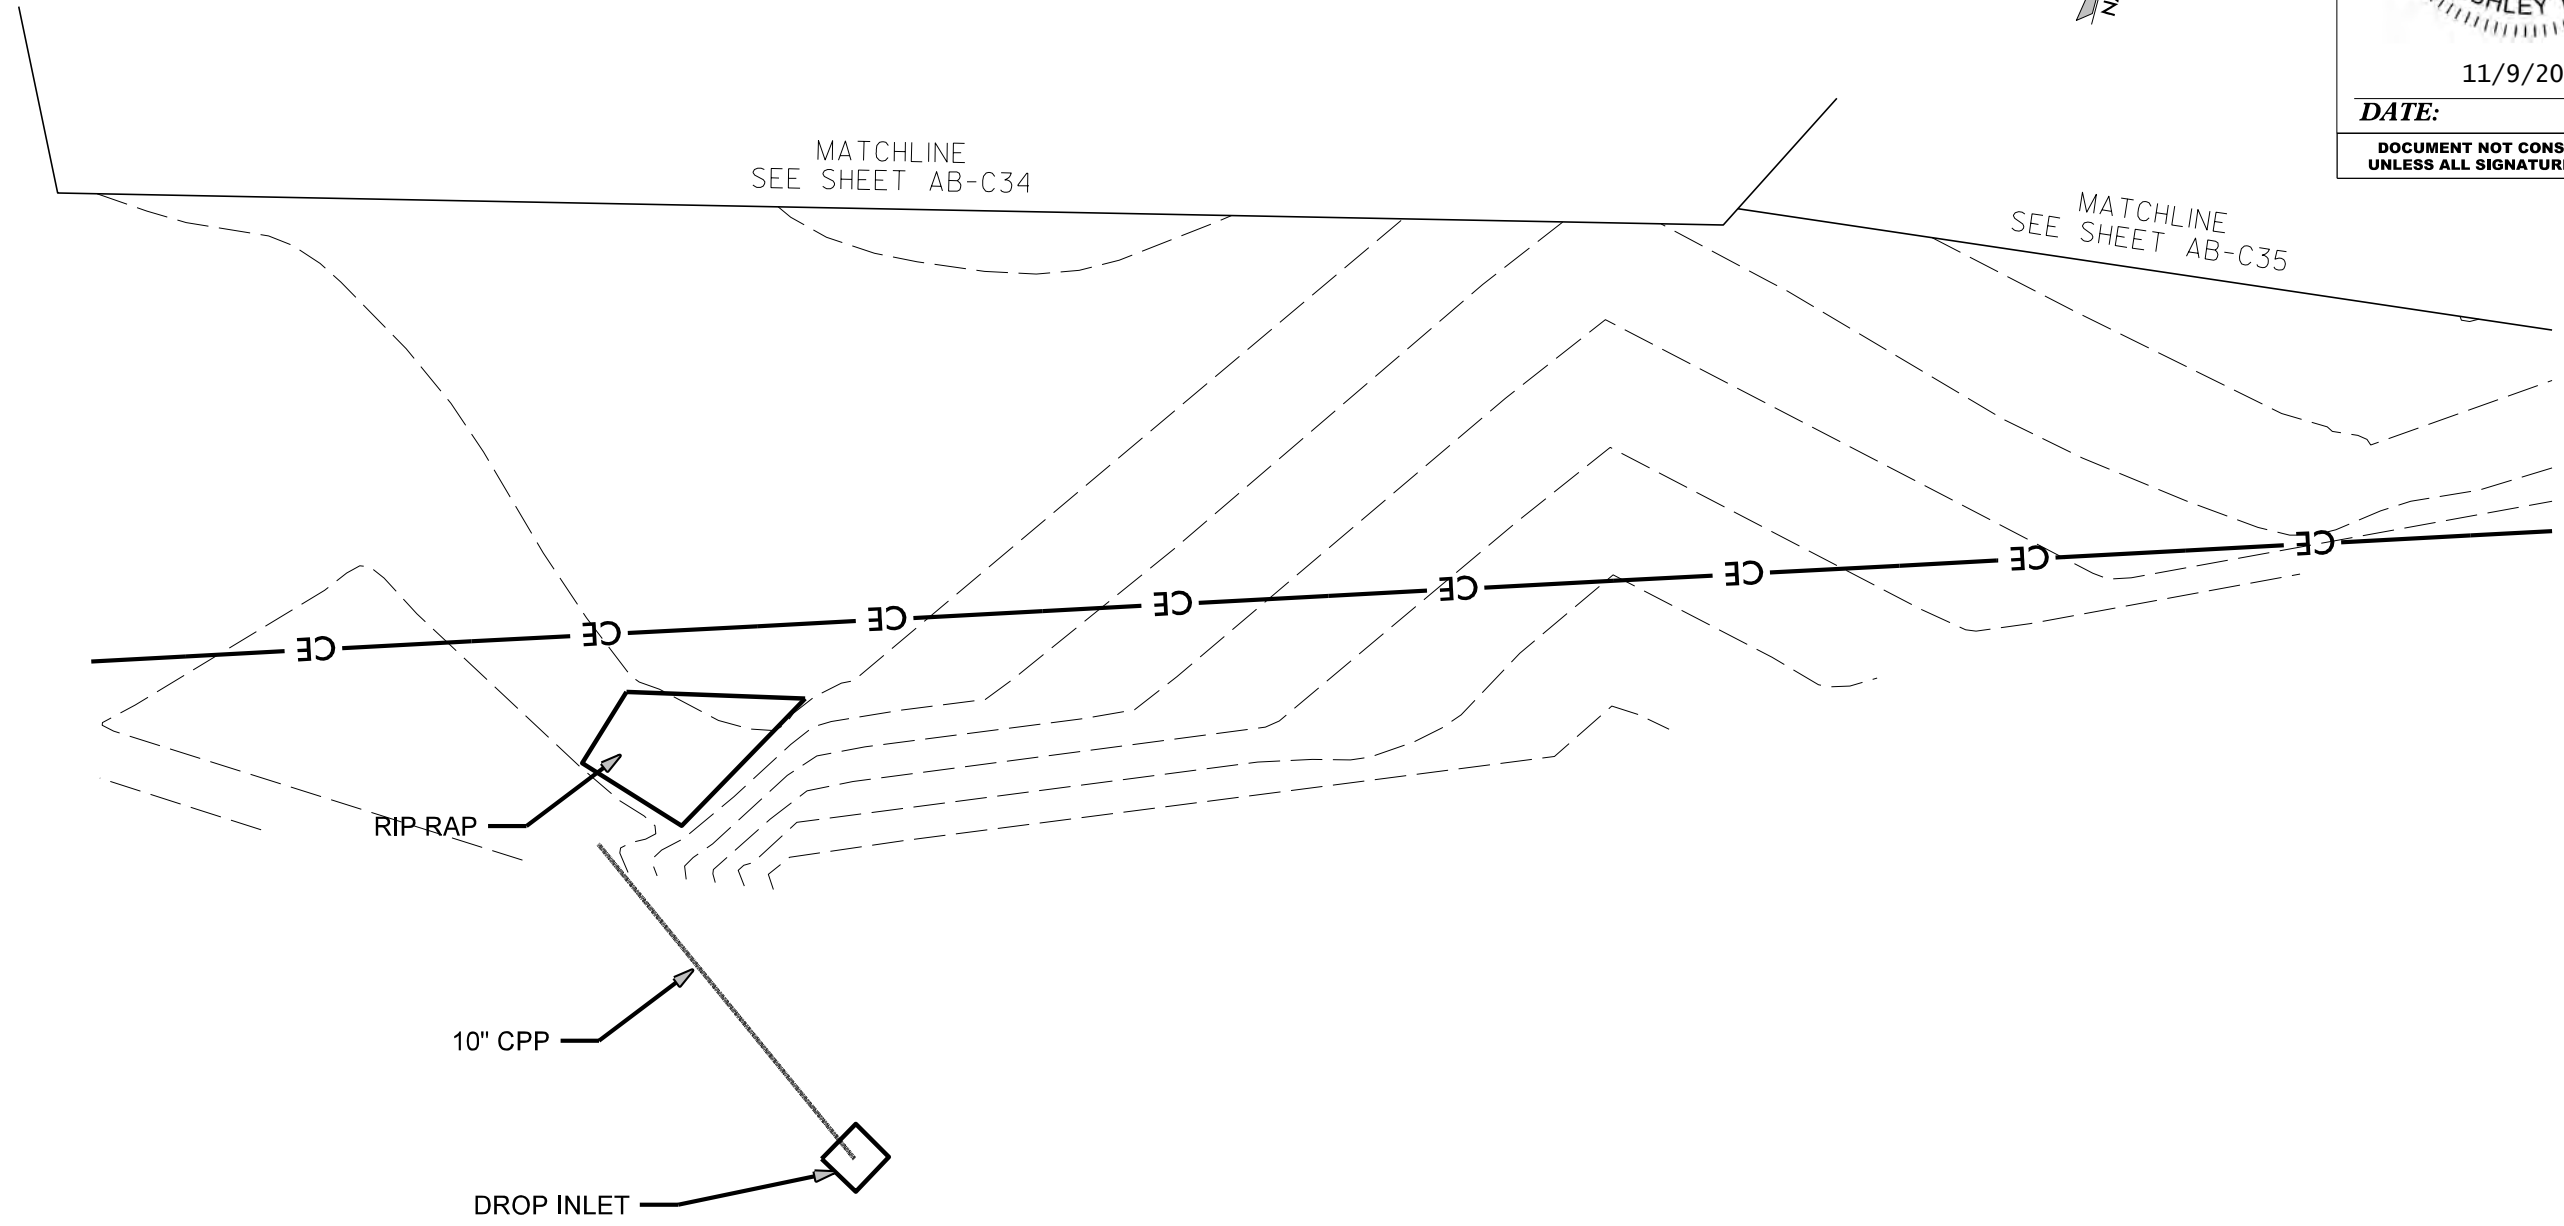

**WITS END**  
**UNION COUNTY, NC**  
**AS-BUILT SURVEY**

PROJECT # :  
1221-20024  
DRAWING NAME:  
WITS END PSH AB-C53  
DATE:  
2022  
DRAWN BY:  
JRH  
REVIEWED BY:  
JGD  
REVISIONS:

SHEET NO.  
**AB-C53**

11/9/2022  
Wits\_End\_Psh\_AB-C53.dgn  
10:48:48 AM

© 2022 SUNGATE DESIGN GROUP, P.A. THIS DRAWING AND ALL REPRODUCTIONS OF IT ARE THE SOLE PROPERTY OF SDG. REPRODUCTION OR OTHER USES OF THIS DRAWING WITHOUT WRITTEN CONSENT OF SDG IS NOT PERMITTED.

11/9/2022  
Wits\_End\_Psh\_AB-C54.dgn  
10:08:58 AM



Site	Wits End Site
Watershed:	Yadkin River Basin, 03040105
XS ID	Waxhaw Br, XS -1
Feature	Riffle
Date:	6/2/2022
Field Crew:	Perkinson

Station	Elevation
0.0	573.0
2.9	573.0
8.9	573.0
12.8	572.9
13.7	572.6
14.5	572.2
15.0	572.1
16.0	572.0
16.7	571.8
17.5	571.6
18.4	571.4
19.5	571.4
21.1	571.3
22.6	571.4
24.0	571.3
26.1	571.3
27.5	571.6
28.4	571.8
29.2	572.0
30.0	572.3
30.7	572.66
31.2	572.8
34.8	572.9
38.5	572.9
41.8	573.1
45.5	572.9

SUMMARY DATA	
Bankfull Elevation:	572.78
Bank Height Ratio:	1.00
Thalweg Elevation:	571.33
LTOB Elevation:	572.78
LTOB Max Depth:	1.45
LTOB Cross Sectional Area:	19.0




Stream Type	E/C
-------------	-----

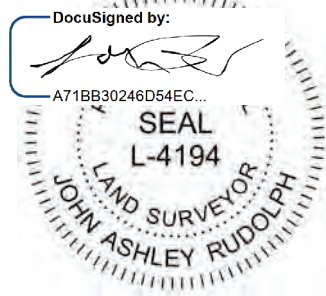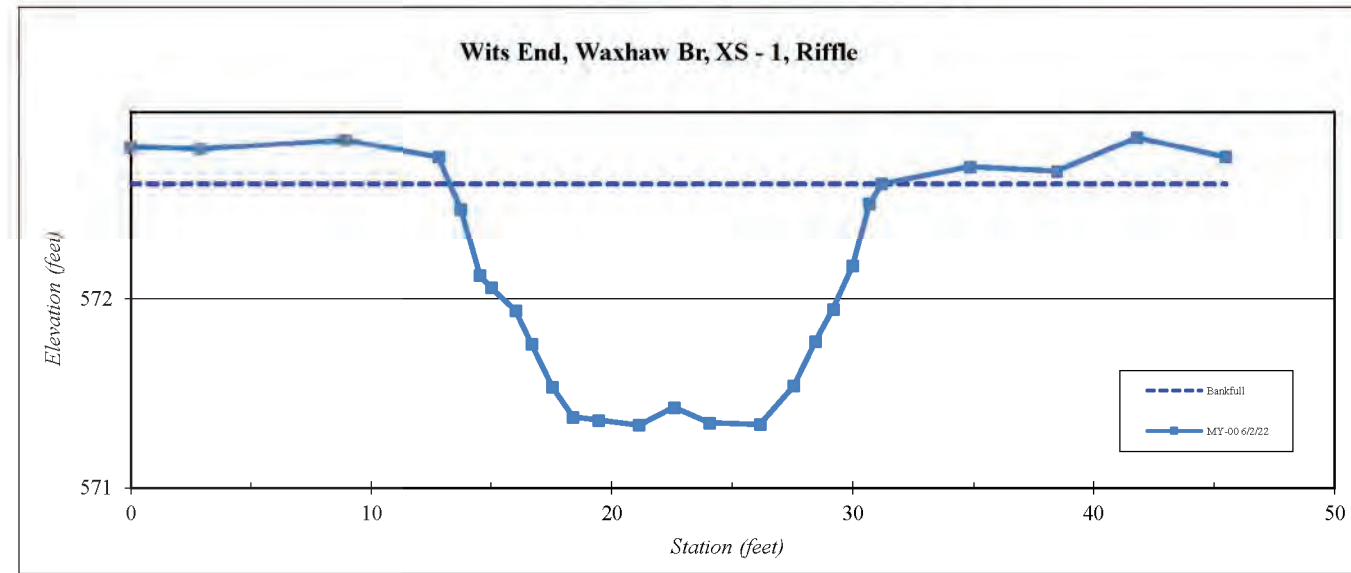

11/9/2022

DATE:

**DOCUMENT NOT CONSIDERED FINAL UNLESS ALL SIGNATURES COMPLETED**

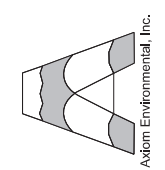

**WITS END**  
UNION COUNTY, NC

---

**AS-BUILT CROSS SECTIONS**

PROJECT # :	1221-20024
DRAWING NAME:	WITS END PSH AB-C54
DATE:	2022
DRAWN BY:	JRH
REVIEWED BY:	JGD
REVISIONS:	

SHEET NO.  
**AB-C54**

© 2022 SUNGATE DESIGN GROUP, P.A. THIS DRAWING AND ALL REPRODUCTIONS OF IT ARE THE SOLE PROPERTY OF SDG. REPRODUCTION OR OTHER USES OF THIS DRAWING WITHOUT WRITTEN CONSENT OF SDG IS NOT PERMITTED.
































































































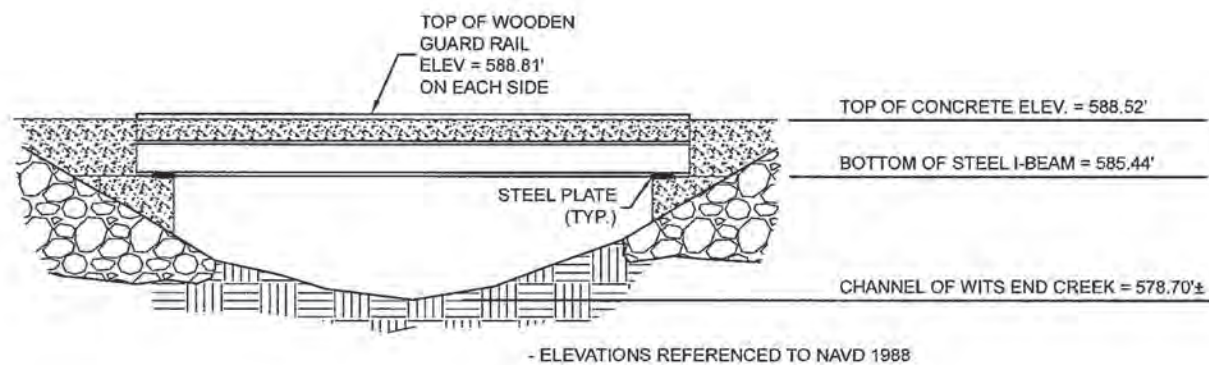


**EXISTING BRIDGE**  
SEPTEMBER 2022

**LONGITUDINAL SECTION**

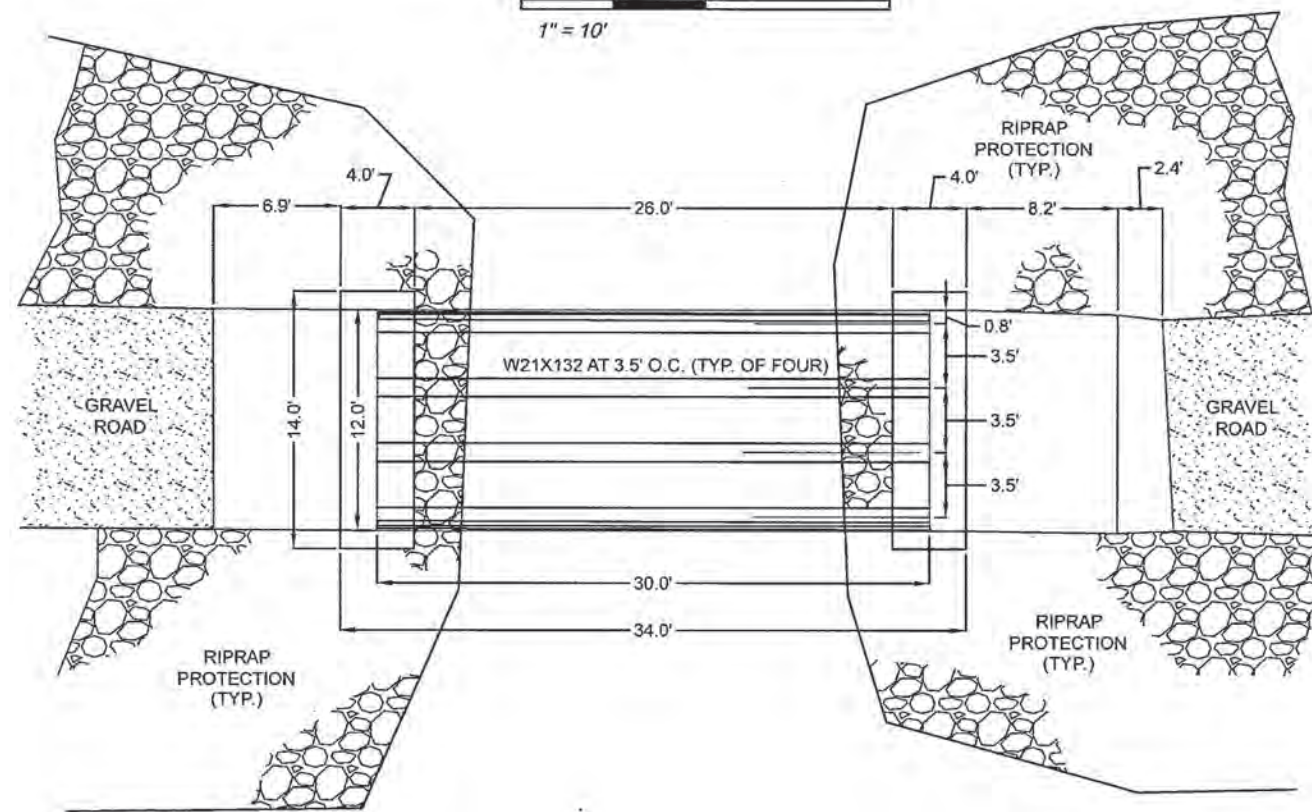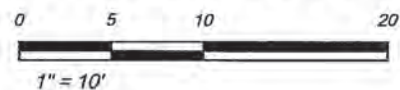

**PLAN VIEW**

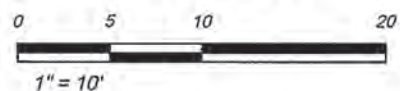

**ENGINEERS CERTIFICATION(S)**

Witness my original signature, registration number and seal this 26th day of September, A.D., 2022

Seal or Stamp



*D. Carter Moore III*  
9/26/22

*D. Carter Moore III*  
Professional Engineer

**SURVEYORS CERTIFICATION(S)**

Witness my original signature, registration number and seal this 26th day of September, A.D., 2022

Seal or Stamp



Digitally signed by JOHN A RUDOLPH  
Date: 2022.09.26 14:08:25 -04'00'  
Professional Land Surveyor

774 S. Beston Road  
La Grange, NC 28651  
252.582.3097  
www.k2designgroup.com  
Firm license no.: C-2111



**RESTORATION SYSTEMS, LLC**  
1101 HAYNES STREET  
SUITE 211  
RALEIGH, NC 27604



Client

WITS END SITE  
Union County,  
North Carolina

BRIDGE AS-BUILT  
Plan View and  
Longitudinal view

Project

Title

DRAWN BY: FGR

DATE: 9/23/22

SURVEYED BY: J.A.R.

DWG. NO.  
RSS580AB22

SHEET  
1 OF 1